

ITEM	STATION AND OFFSET	NORTHING	EASTING	ELEVATION	DESCRIPTION
CP-5	20+99.98, 52' LT	7,017,034.11	2,603,380.86	574.33	"X" CUT IN SIDEWALK
CP-6	27+44.84, 51' RT	7,016,433.61	2,603,140.94	580.66	"X" CUT IN SIDEWALK

**LEGEND**

- PROPOSED TOP OF CURB
- EXISTING GROUND AT C
- EXISTING GROUND AT LEFT R.O.W.
- EXISTING GROUND AT RIGHT R.O.W.


STA 24+92.31  
 END PROFILE OF LT.  
 AND RT. OUTSIDE  
 TOP OF CURB AND  
 BEGIN PROFILE OF  
 LT. OUTSIDE TOP OF  
 CURB ONLY. TC=577.40

STA 21+00  
 BEGIN PROFILE OF  
 LT. AND RT. OUTSIDE  
 TOP OF CURB

PVI STA = 21+00  
 PVI ELEV = 573.92

PVI STA = 23+00  
 PVI ELEV = 575.19

SCALE:  
 HORIZ: 1"=20'  
 VERT: 1"=5'

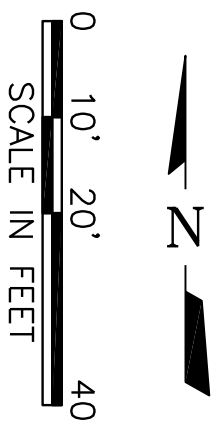

This Record Drawing is a combination of the sealed engineering contract drawings for this project, modified by information furnished by the contractor reflecting changes in the Project made during construction. The original sealed drawings are on file at the offices of  
**FREESSE AND NICHOLS, INC.**  
 4055 INTERNATIONAL PLAZA, SUITE 200  
 FORT WORTH, TEXAS 76109-4895  
 (817) 735-3300  
 RECORD DRAWINGS PREPARED ON: 3/13/2009

NO.	ISSUE	BY	DATE	F&N JOB NO.
1	RECORD DRAWINGS	CJP	5/12/09	ROK06114

VERIFIED SCALE: Bar is one inch on original drawing. If not one inch on this sheet, adjust scale.

CITY OF ROCKWALL, TEXAS  
**205 BYPASS CONSTRUCTION**  
 CIVIL  
**PAVING PLAN AND PROFILE**  
 STA 21+00 TO 26+00



THE SEAL THAT ORIGINALLY APPEARED ON THIS DOCUMENT WAS AUTHORIZED BY KEVIN R. JOHNSON, P.E., TEXAS NO. 83888, ON 2/27/2009. ALTERATION OF A SEALED DOCUMENT WITHOUT PROPER NOTIFICATION OF THE RESPONSIBLE ENGINEER IS AN OFFENSE UNDER THE TEXAS ENGINEERING PRACTICE ACT.