




1 TRANSVERSE CONSTRUCTION JOINT
NOT TO SCALE

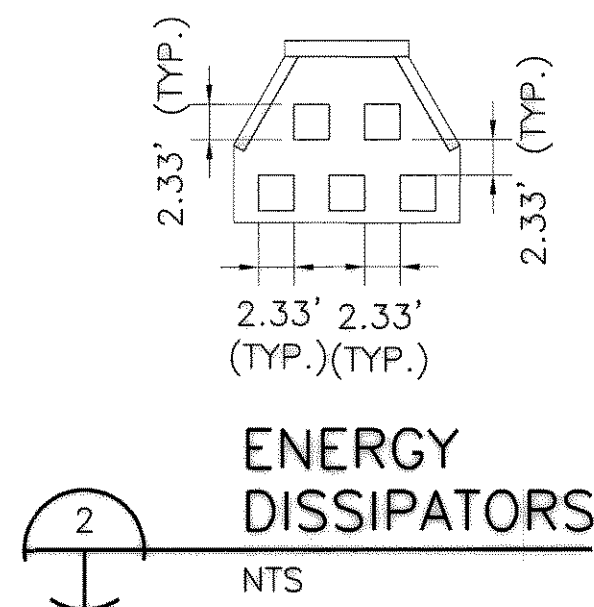

2 ENERGY DISSIPATORS
NTS

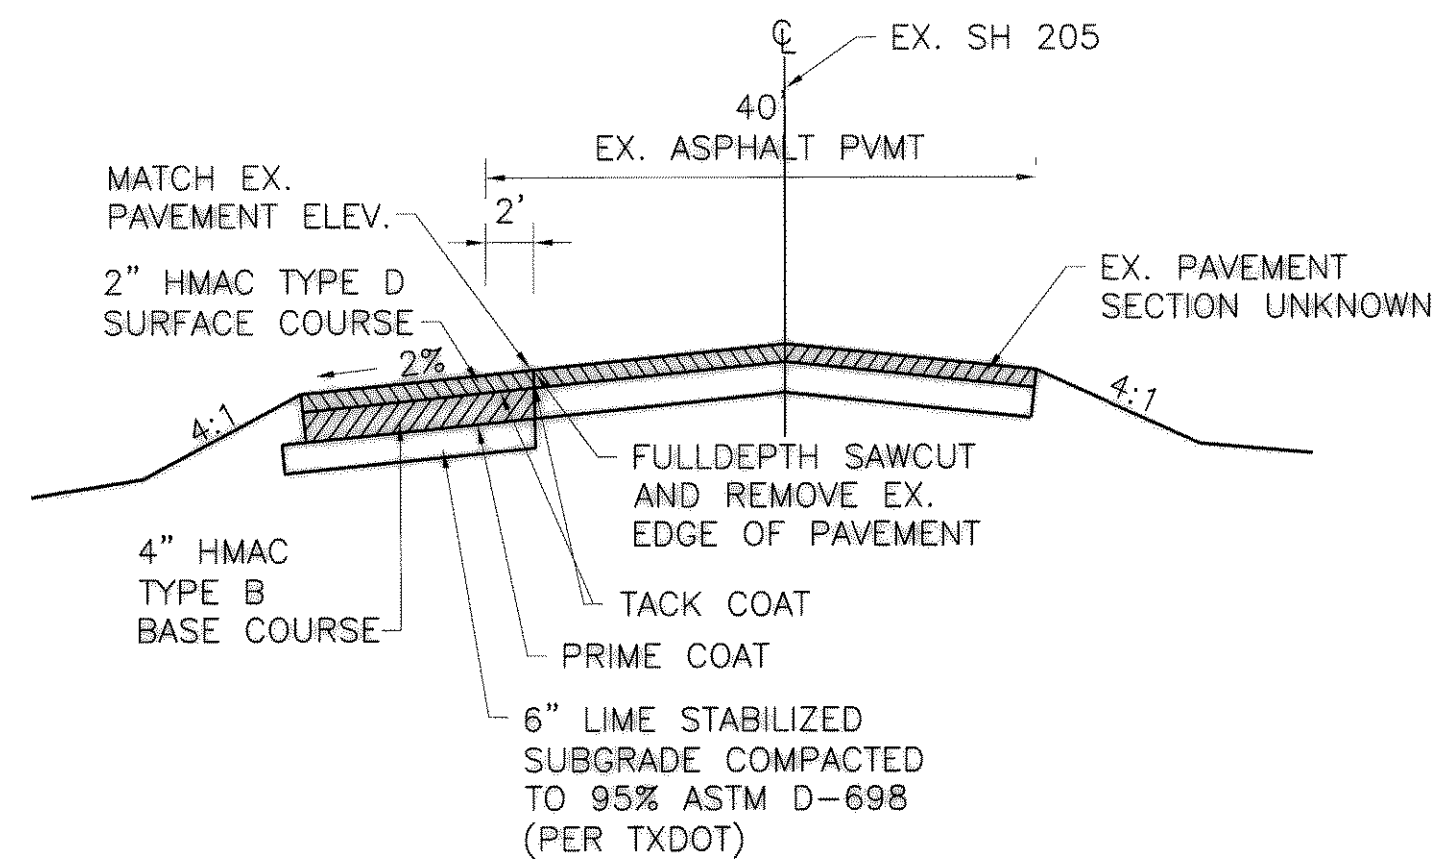


3 ASPHALT SECTION
NOT TO SCALE

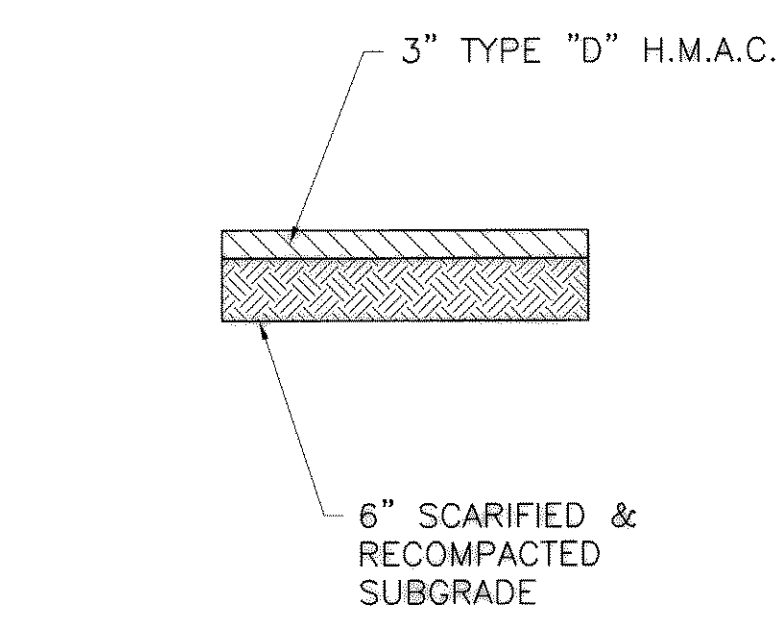

4 TEMPORARY ASPHALT PAVEMENT SECTION
NOT TO SCALE

This Record Drawing is a combination of the sealed engineering contract drawings and the sealed drawings of the contractor. The original sealed drawings are on file at the offices of FREESE AND NICHOLS, INC. 1701 N. Market Street, Suite 500, LB 51 Dallas, Texas 75202-2001 Phone - (214) 920-2500 Fax - (214) 920-2565 RECORD DRAWINGS PREPARED ON: 3/16/2009


THIS SHEET WAS ORIGINALLY APPEARED ON THIS DOCUMENT WAS: 1701 N. MARKET STREET, SUITE 500, LB 51 DALLAS, TEXAS 75202-2001 PHONE - (214) 920-2500 FAX - (214) 920-2565

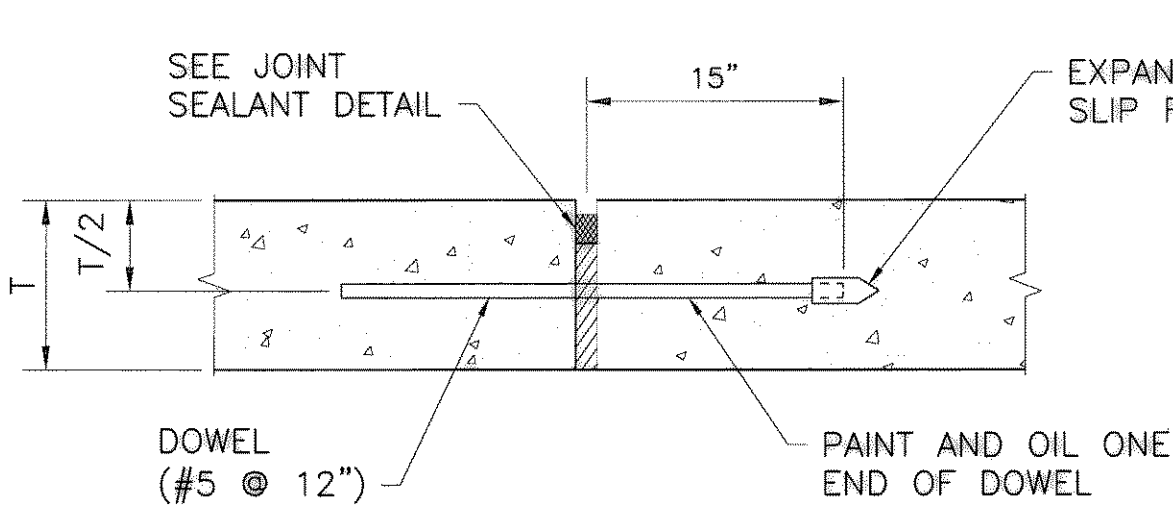


5 DOWEL DETAIL
NOT TO SCALE

JOINT SPACING NOTES:

1. THE CONTRACTOR SHALL SUBMIT A DETAILED PAVEMENT JOINT PLAN TO THE ENGINEER FOR REVIEW AND APPROVAL PRIOR TO PLACEMENT OF PAVEMENT ON THE SITE. ANY DEVIATIONS FROM THE FOLLOWING GUIDELINES MUST BE APPROVED BY THE ENGINEER PRIOR TO CONSTRUCTION.
2. EXPANSION JOINTS SHALL BE AT A MAXIMUM SPACING OF 300 FEET AND AT PC, PT, HORIZONTAL AND VERTICAL ANGLES GREATER THEN 5', AND INTERSECTIONS.
3. LONGITUDINAL AND TRANSVERSE SAW CUT JOINTS SHALL BE AT A MAXIMUM OF 15' INTERVALS.
4. SPACING VARIATIONS SHALL BE MADE AT BLOCKOUTS, CONSTRUCTION JOINTS AND STREET INTERSECTIONS TO LINE UP WITH EXISTING PAVING JOINTS AS DIRECTED BY THE CITY. ALL JOINTS WILL BE SAWED NO LATER THAN 12 HOURS AFTER THE PLACEMENT OF THE PAVEMENT AS DIRECTED BY THE CITY.

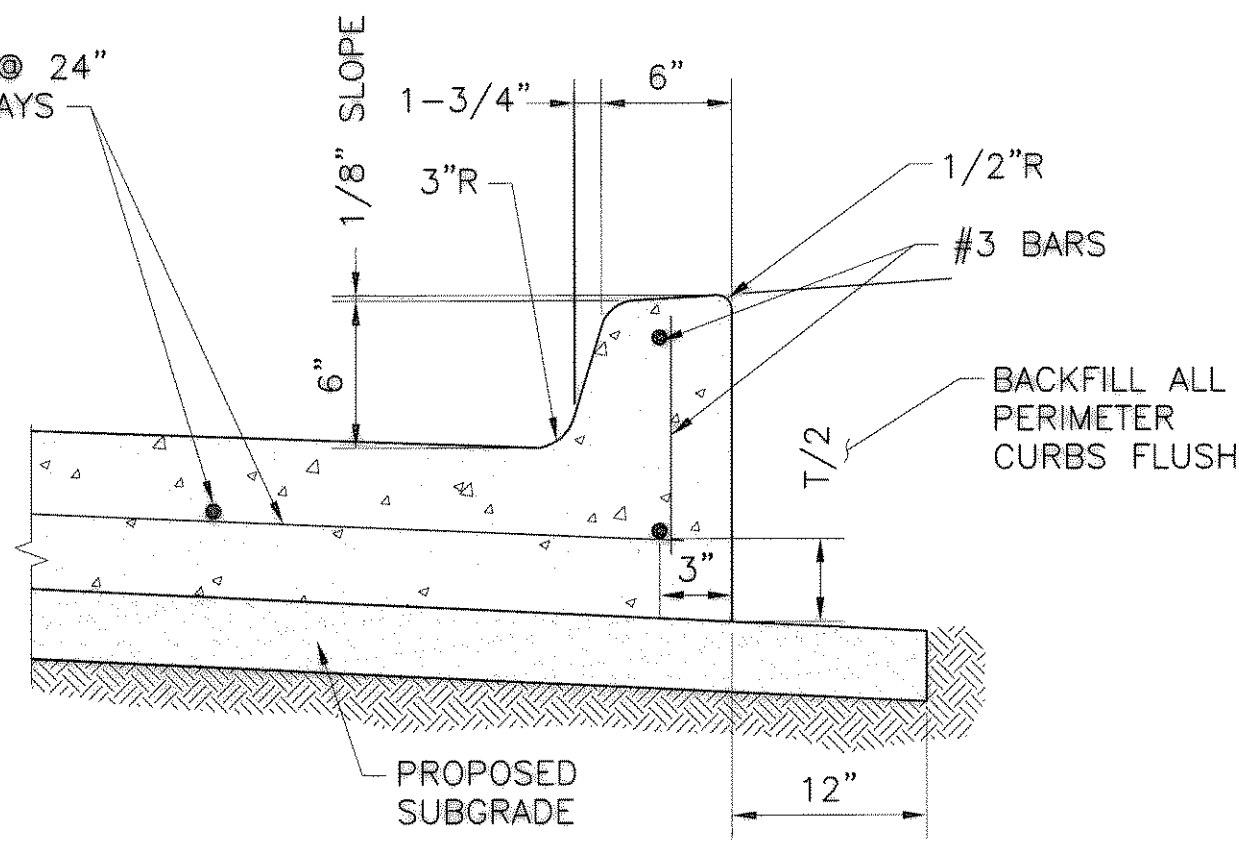


6 MONOLITHIC CURB DETAIL
NOT TO SCALE

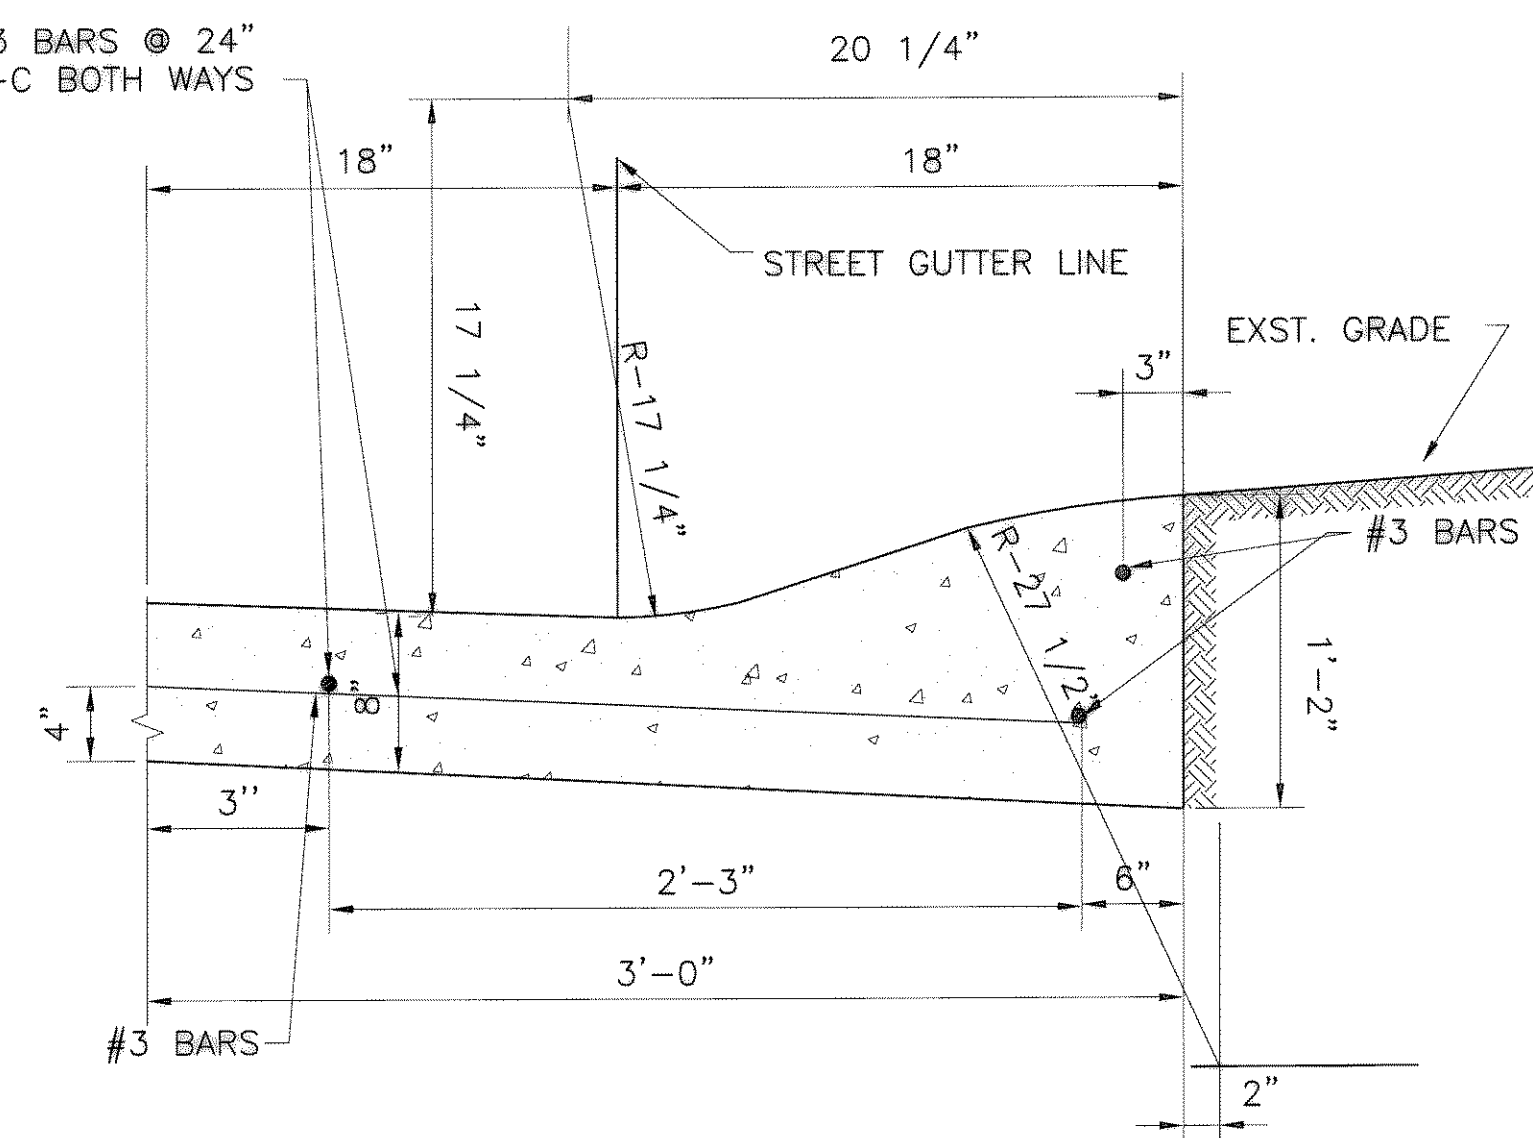


7 MOUNTABLE CURB SECTION
NOT TO SCALE

MEDIAN PAVING STONE DETAIL:


PAVING STONE SHALL BE PAVESTONE HOLLAND STONE RIVER RED COLOR.

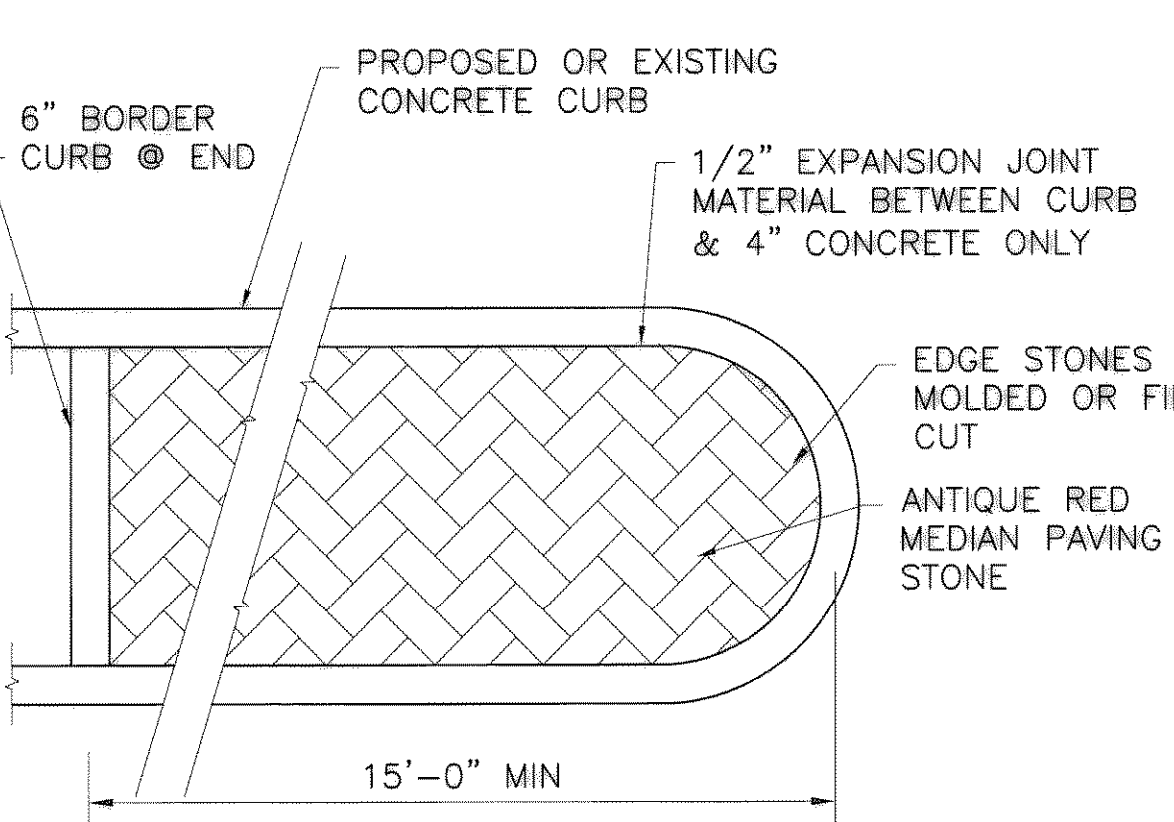


10 MEDIAN PAVING NOSE DETAIL
NOT TO SCALE

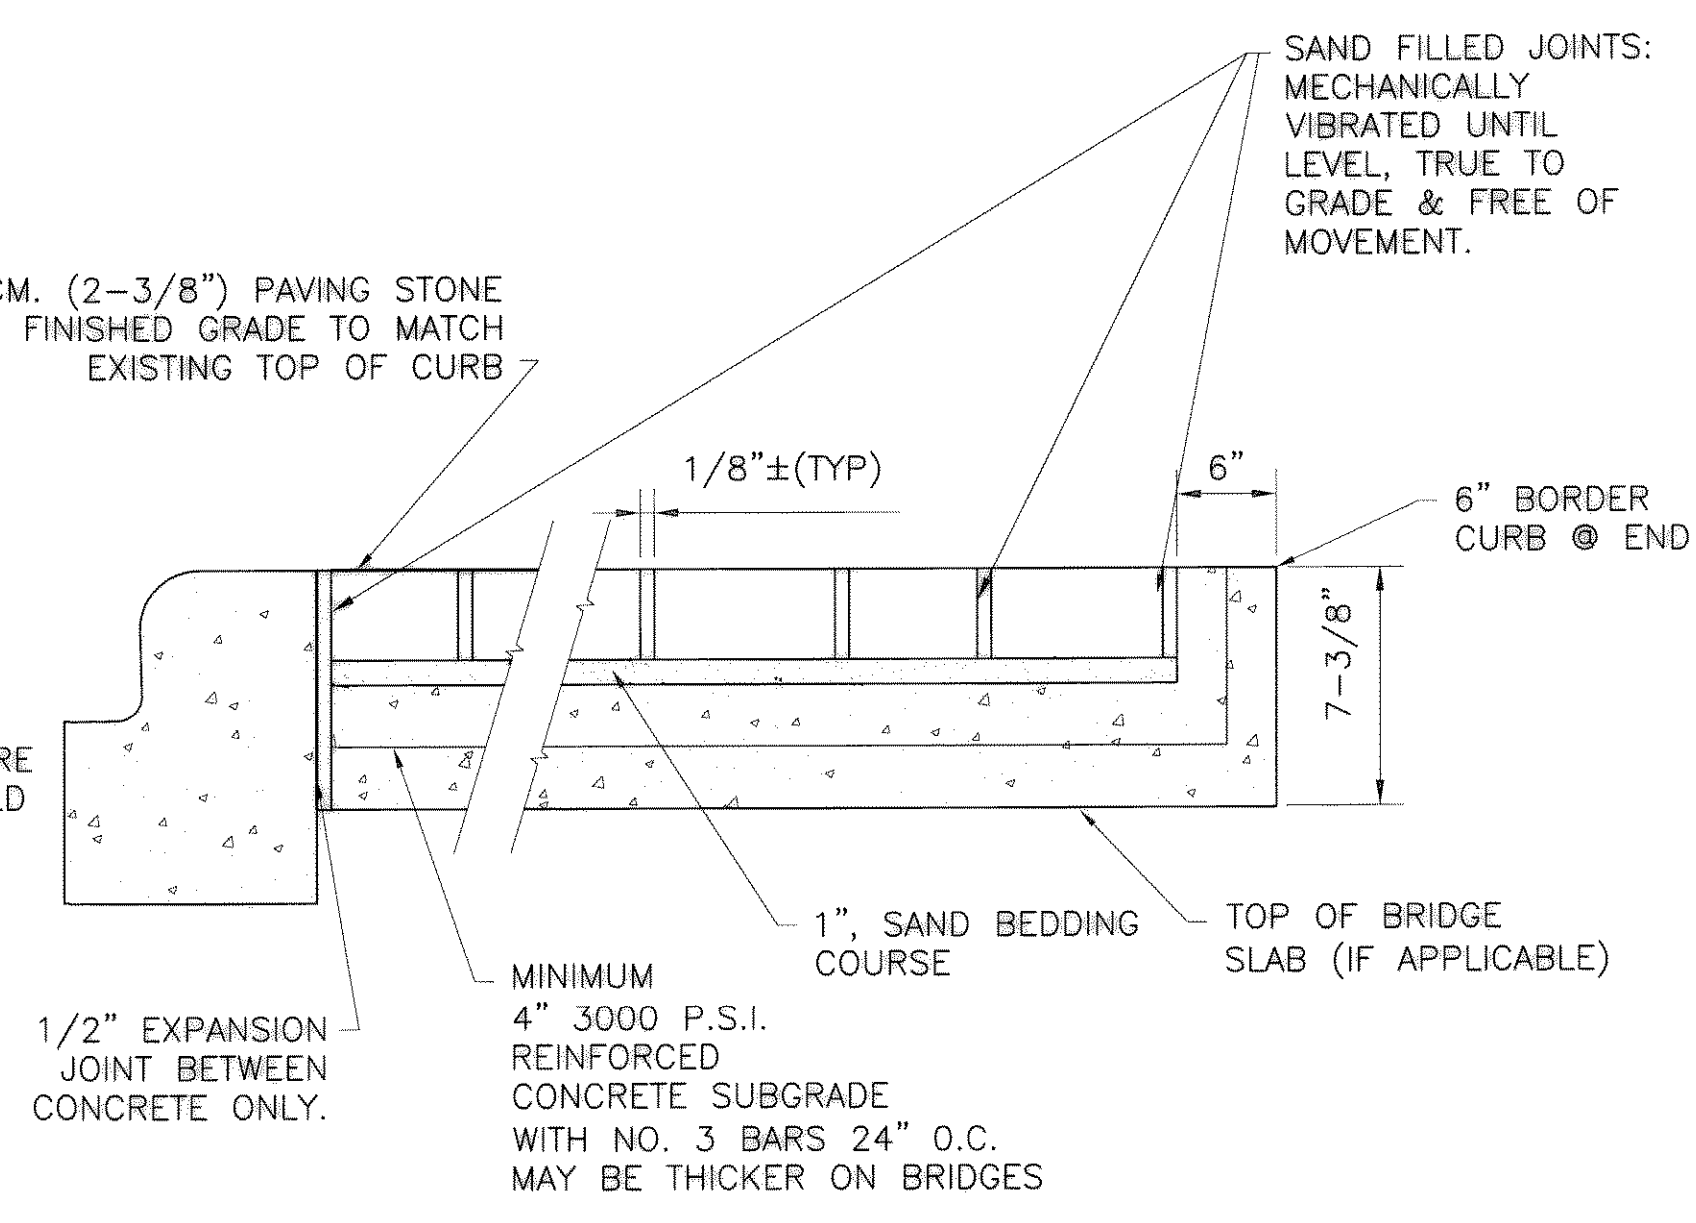

11 MEDIAN PAVING NOSE DETAIL
NOT TO SCALE

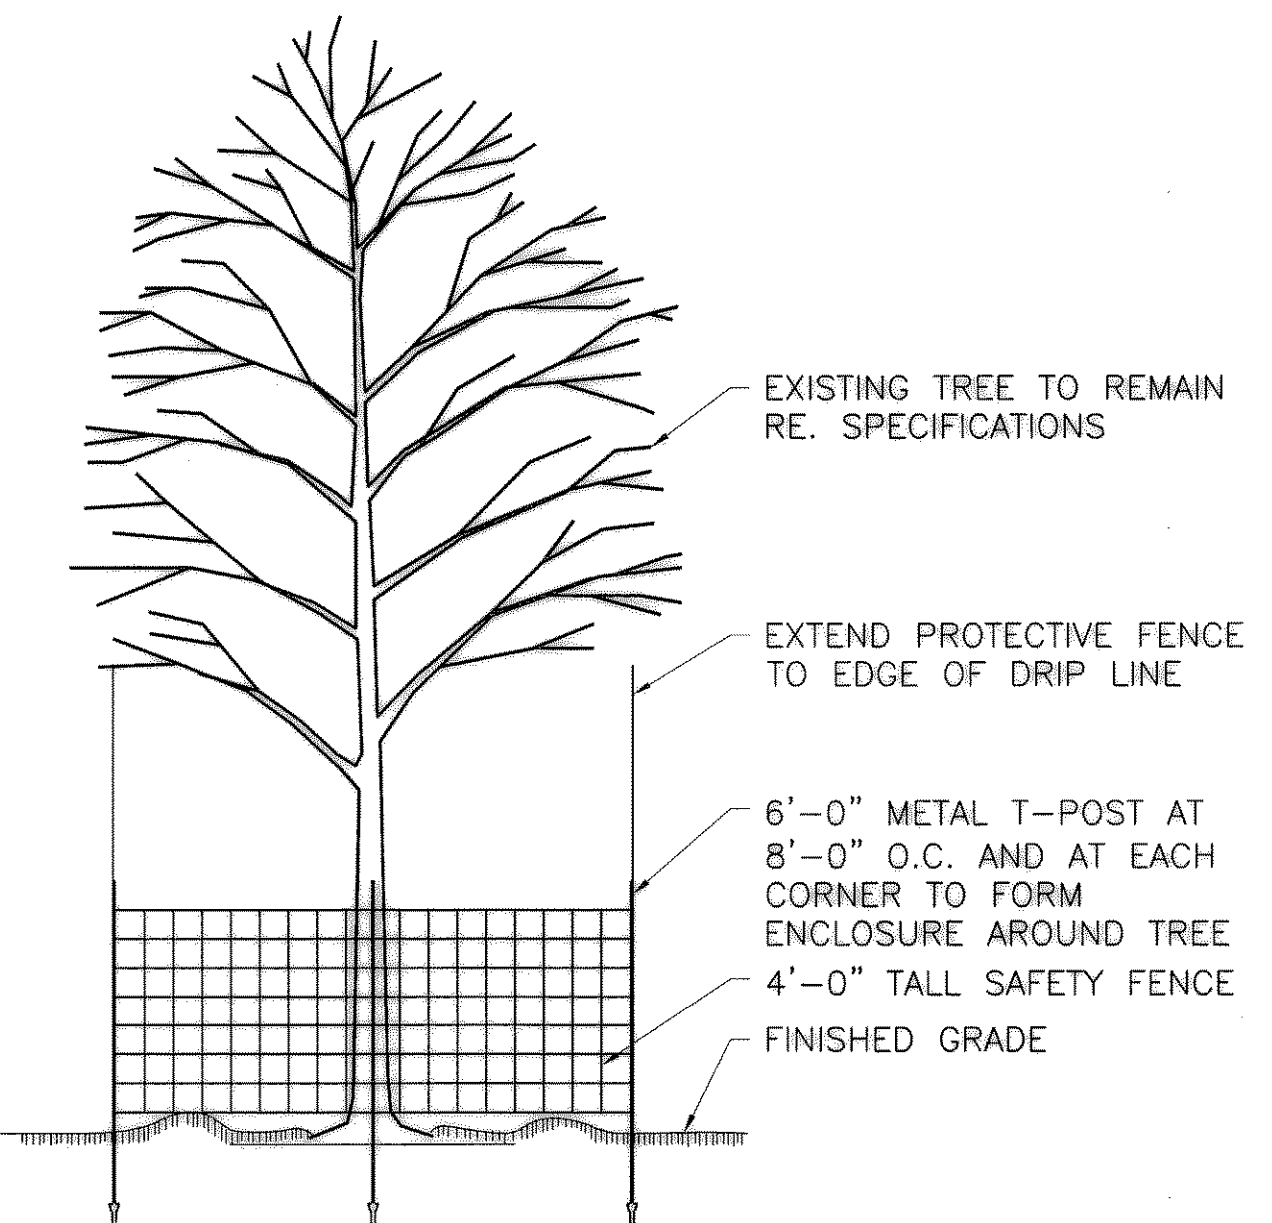

8 TREE PROTECTION DETAIL
NOT TO SCALE

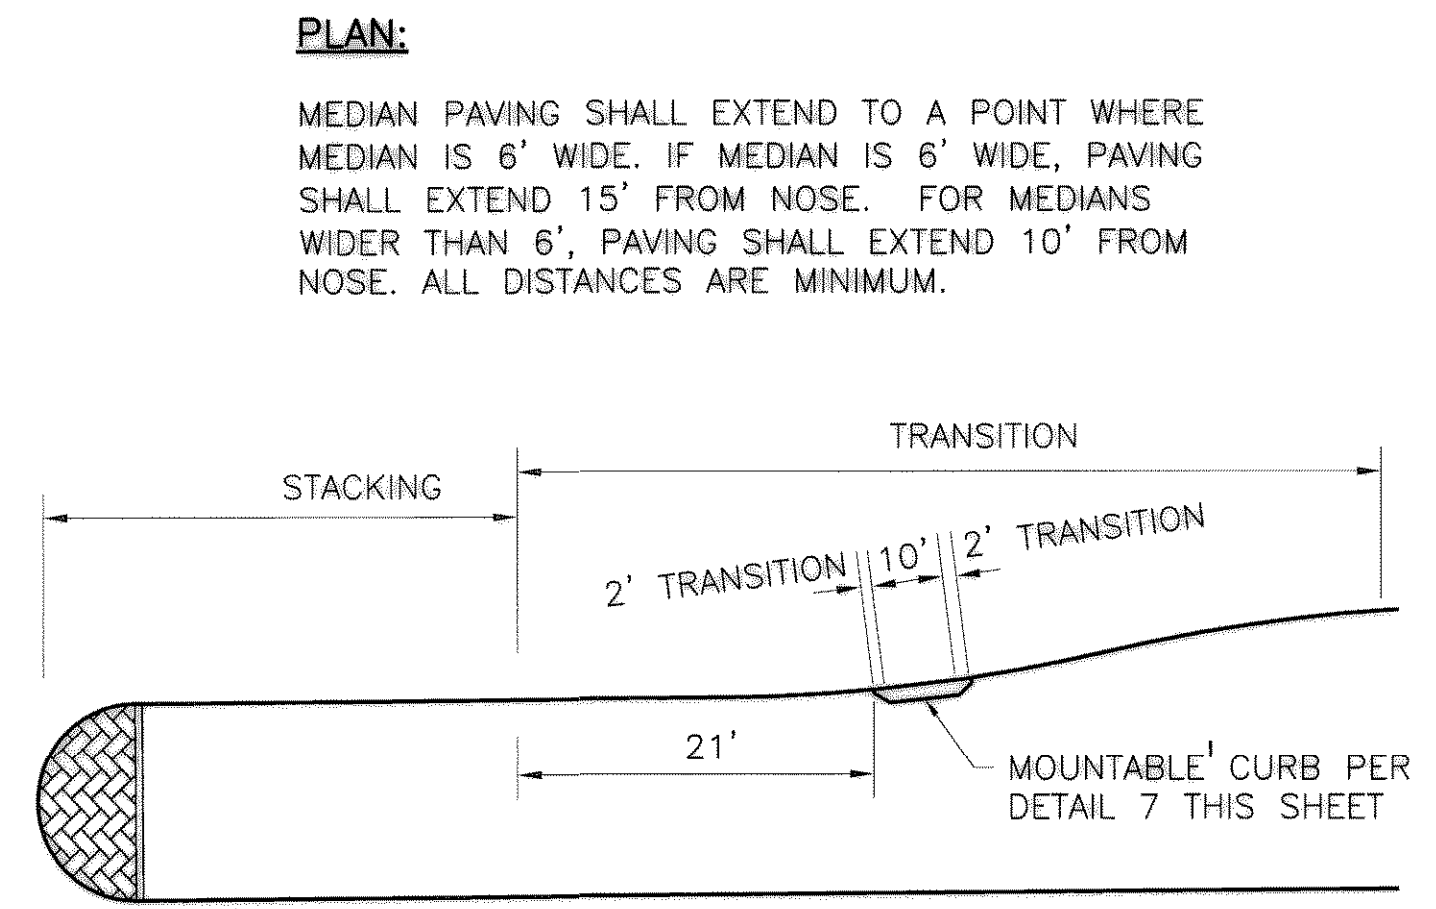

9 LANDSCAPE ACCESS RAMP
NOT TO SCALE

CITY OF ROCKWALL, TEXAS
205 BYPASS CONSTRUCTION
CIVIL
STANDARD DETAILS

NO.	ISSUE	DATE	BY	CHKD	APP'D	FILE NAME
1	ISSUE	05/12/09				CV-RDS-DT-PAVE01.dwg
RECORD DRAWINGS						
Bar is one inch on original drawing. If not one inch on this sheet, adjust scale.						
VERIFY SCALE						
CITY OF ROCKWALL, TEXAS						
DT-1						
SEQ. 42 OF 86						

ACAD: Rel 17.0s (LMS Tech) User: KAS
[R:\06114\DRAWINGS\CV-RDS-DT-PAVE01.DWG LAYOUT: Layout1
D:\06114\DRAWINGS\CV-RDS-DT-PAVE01.DWG LAYOUT: Layout1
DEC 21, 2006 3:32:01 P.M. LTS: 1.00 PLS: 1
2 REFERENCE FILES: N:\205 DALLAS N DRIVE\STANDARD\34BORDER