


205 BYPASS CONSTRUCTION

FROM SH-276 TO SH-205

FEBRUARY 2008

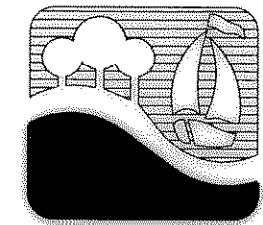

CITY OF ROCKWALL

"THE NEW HORIZON"


MAYOR:
BILL CECIL

MAYOR PRO-TEM:
BOB COTTI

CITY COUNCIL:
STEPHEN STRAUGHAN
MATT SCOTT
TIM MCCALLUM
CLIFF SEVIER
MARGO NIELSON

CITY MANAGER:
JULIE COUCH

DIRECTOR OF PUBLIC WORKS:
CHUCK TODD, P.E.

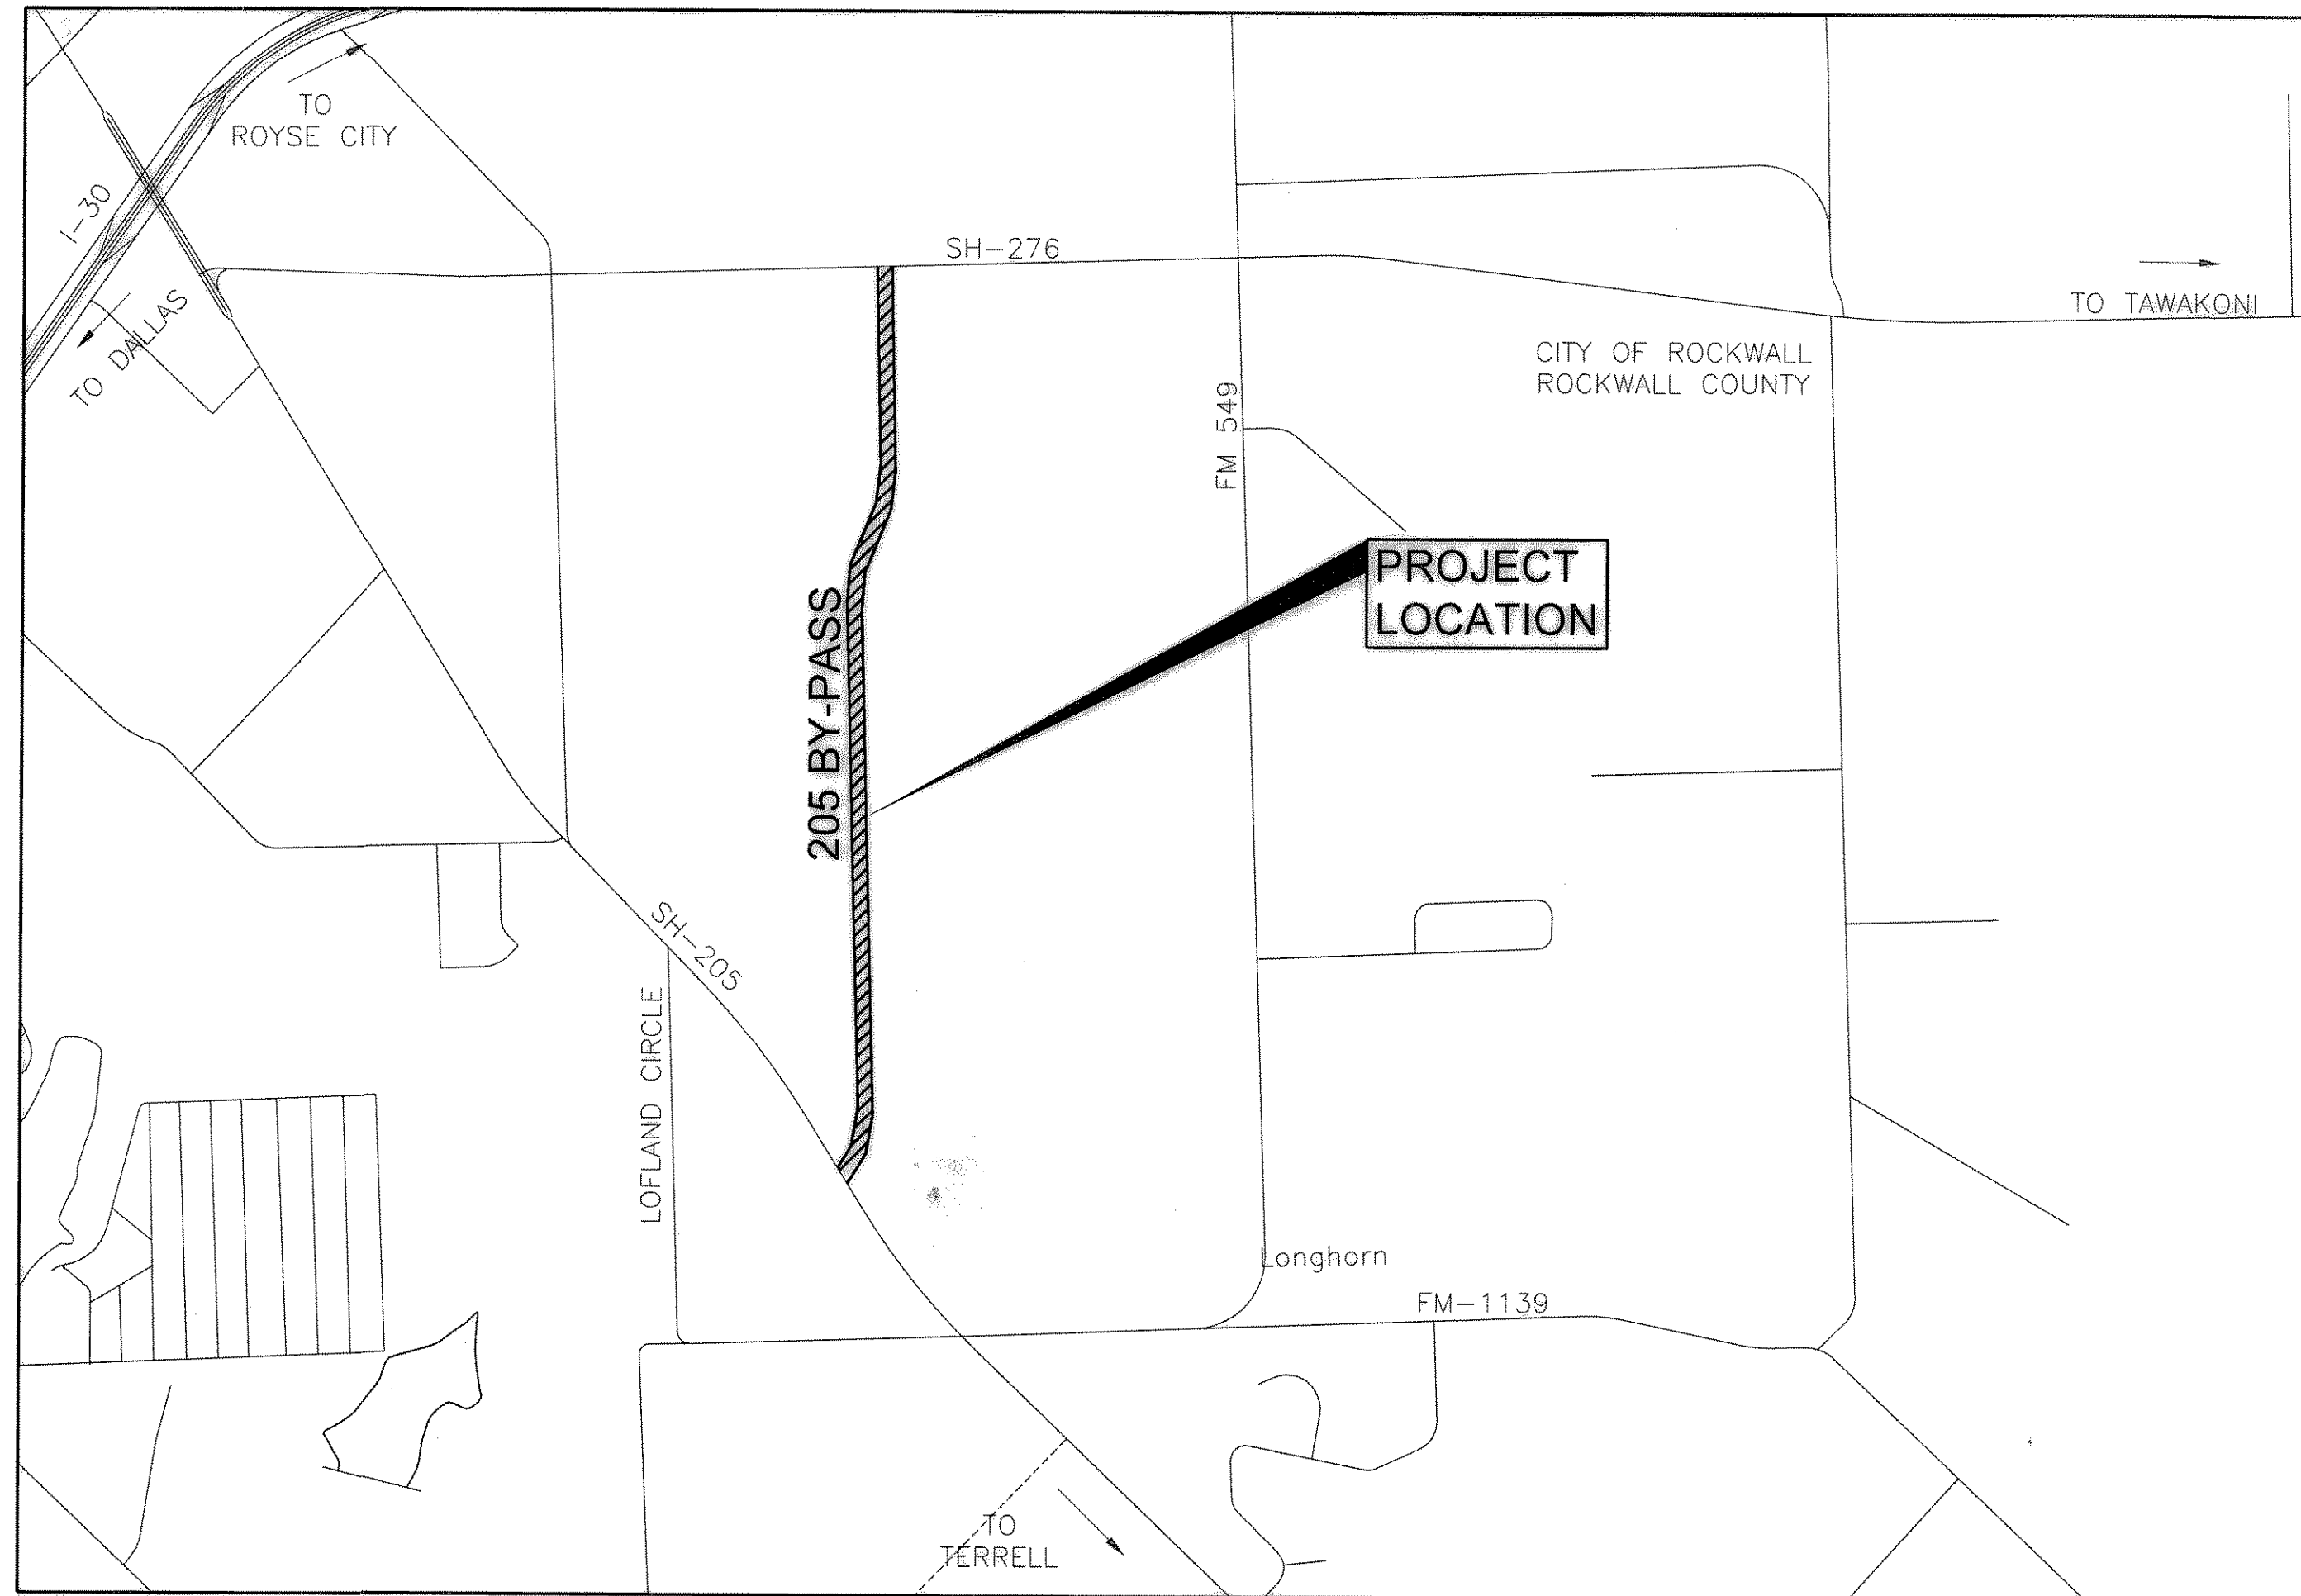

VICINITY MAP
N.T.S.

ROK06114



This Record Drawing is a combination of the sealed engineering contract drawings for this project, modified by information furnished by the contractor reflecting changes in the Project made during construction. The original sealed drawings are on file at the offices of
FREESE AND NICHOLS, INC.
4055 INTERNATIONAL PLAZA, SUITE 200
FORT WORTH, TEXAS 76109-4895
(817) 735-7300
RECORD DRAWINGS PREPARED ON:
3/13/2009

This Record Drawing is a combination of the sealed engineering contract drawings for this project, modified by information furnished by the contractor reflecting changes in the Project made during construction. The original sealed drawings are on file at the offices of
FREESE AND NICHOLS, INC.
4055 INTERNATIONAL PLAZA, SUITE 200
FORT WORTH, TEXAS 76109-4895
(817) 735-7300
RECORD DRAWINGS PREPARED ON:
3/13/2009

THE SEAL THAT ORIGINALLY APPEARED ON THIS DOCUMENT WAS AUTHORIZED BY KEVIN R. JOHNSON P.E. ON 2/25/2008 TEXAS NO. 83882 ALTERATION OF A SEALED DOCUMENT WITHOUT PROPER NOTIFICATION OF THE RESPONSIBLE ENGINEER IS AN OFFENSE UNDER THE TEXAS ENGINEERING PRACTICE ACT

THE SEAL THAT ORIGINALLY APPEARED ON THIS DOCUMENT WAS AUTHORIZED BY TRICIA H. HUBLEY P.E. ON 2/25/2008 TEXAS NO. 83882 ALTERATION OF A SEALED DOCUMENT WITHOUT PROPER NOTIFICATION OF THE RESPONSIBLE ENGINEER IS AN OFFENSE UNDER THE TEXAS ENGINEERING PRACTICE ACT

SHEET INDEX

SHT. NO.	DESCRIPTION:
GN-1	COVER
GN-2	GENERAL NOTES
GN-3	QUANTITY SUMMARY
HC-1	TYPICAL SECTIONS AND LEGEND
PV-1	HORIZONTAL CONTROL SHEETS
PV-2	PAVING PLAN & PROFILE STA 1+00 TO 6+00
PV-3	PAVING PLAN & PROFILE STA 6+00 TO 11+00
PV-4	PAVING PLAN & PROFILE STA 11+00 TO 16+00
PV-5	PAVING PLAN & PROFILE STA 16+00 TO 21+00
PV-6	PAVING PLAN & PROFILE STA 21+00 TO 26+00
PV-7	PAVING PLAN & PROFILE STA 26+00 TO 31+00
PV-8	PAVING PLAN & PROFILE STA 31+00 TO 36+00
PV-9	PAVING PLAN & PROFILE STA 36+00 TO 41+00
PV-10	PAVING PLAN & PROFILE STA 41+00 TO 46+00
PV-11	PAVING PLAN & PROFILE STA 46+00 TO 51+00
PV-12	PAVING PLAN & PROFILE STA 51+00 TO 56+00
PV-13	PAVING PLAN & PROFILE STA 56+00 TO 61+00
PV-14	PAVING PLAN & PROFILE STA 61+00 TO 66+00
PV-15	PAVING PLAN & PROFILE STA 66+00 TO 71+00
PV-16	PAVING PLAN & PROFILE STA 71+00 TO END
DA-1-3	INTERSECTION DIAGRAM: 205 BYPASS AND SH 205
DA-4	DRAINAGE AREA MAP
DA-5	STORM SEWER INLET AND PIPE CALCULATIONS
SD-1	STORM SEWER PLAN AND PROFILE CULVERT A AND LATERAL A6
SD-2	STORM SEWER PLAN AND PROFILE LINE D, LINE A1
SD-3	STORM SEWER PLAN AND PROFILE LATERALS A1-A3
SD-4	STORM SEWER PLAN AND PROFILE LINE A, LATERAL A7
SD-5	STORM SEWER PLAN AND PROFILE LATERALS A8 AND B3
SD-6	STORM SEWER PLAN AND PROFILE CULVERT B STA. 1+00-6+00
SD-7	STORM SEWER PLAN AND PROFILE CULVERT B STA. 6+00-7+50 AND LINE C
SD-8	STORM SEWER PLAN AND PROFILE CULVERT B STA 7+50-END
SD-9	STORM SEWER PLAN AND PROFILE LATERALS A0, B1 & B2 AND LINE B
ER-1	EROSION CONTROL
ER-2	EROSION CONTROL
TR-1	PAVEMENT PERMANENT MARKING/SIGNAGE PLANS
TR-2	PAVEMENT PERMANENT MARKING/SIGNAGE PLANS
TR-3	PAVEMENT PERMANENT MARKING/SIGNAGE PLANS
TR-4	PAVEMENT PERMANENT MARKING/SIGNAGE PLANS
DT-1	STANDARD DETAILS
DT-2	STANDARD DETAILS (CONT.)
DT-3	STREET LIGHT DETAIL
TXDOT DETAILS	
DT-4	CURB INLET ON BOX CULVERT
DT-5	CONCRETE HEADWALLS WITH PARRALLEL WINGS
DT-6	CONCRETE HEADWALLS WITH FLARED WINGS
DT-7	MULTIPLE BOX CULVERTS CAST-IN-PLACE 8' SPAN
DT-8	MULTIPLE BOX CULVERTS CAST-IN-PLACE 10' SPAN
DT-9	CONCRETE WINGWALLS WITH PARRALLEL WINGS (RCB)
DT-10	CONCRETE WINGWALLS WITH FLARED WINGS (RCB)
DT-11	MULTIPLE BOX CULVERT MISC. DETAILS
DT-12	BOX CULVERTS PRECAST MISC. DETAILS
DT-13	STOCK PASS
DT-14-15	RAIL ANCHORAGE CURB (RAC)
DT-16-17	COMBINATION RAIL
DT-18	METAL BEAM GUARD FENCE
DT-19	TRAFFIC RAIL TYPE T101
DT-20	SINGLE GUARDRAIL TERMINAL
DT-21	STANDARD PAVEMENT MARKINGS (ARROWS)
XS1-24	PAVING CROSS SECTIONS

DOCUMENTS ISSUED FOR CONSTRUCTION

These "Issued for Construction" Contract Documents have been prepared by revising the Bidding Documents to record references to addenda, field orders or change orders issued as of 5/20/2008. The Bidding Documents may have been revised to incorporate these revisions directly into the "Issued for Construction" Contract Documents. Contractor is responsible for determining that these documents are consistent with their understanding of the Bidding Documents as modified per the appropriate provisions of the Contract Documents. The Bidding Documents, as modified per the appropriate provisions of the Contract Documents, take precedence over these "Issued for Construction" documents.

THE TXDOT STANDARDS SHEETS SPECIFICALLY IDENTIFIED ON THIS SHEET HAVE BEEN SELECTED BY ME OR MY RESPONSIBLE SUPERVISION AS BEING APPLICABLE TO THIS PROJECT

NAME _____, P.E. DATE _____

ACAD: Rel 17.1s (LWS Tech) User: IS
 FROK06114.DWG ON NETWORK\\JN\B\CORP\WORK\GEN-ALL-COVER\DWG_LAYOUT: Layout1
 MAR 13 2009 1:54:07 P.M. LWS: 300.00 PPS(LTS: 0 TMSIT: 0.0
 2 REFERENCE FILES: \\SEALS\83282.dwg \\SEALS\93882