


TIME: 8:59 FILE: I:\04141-DAMAP-Phase1.dwg

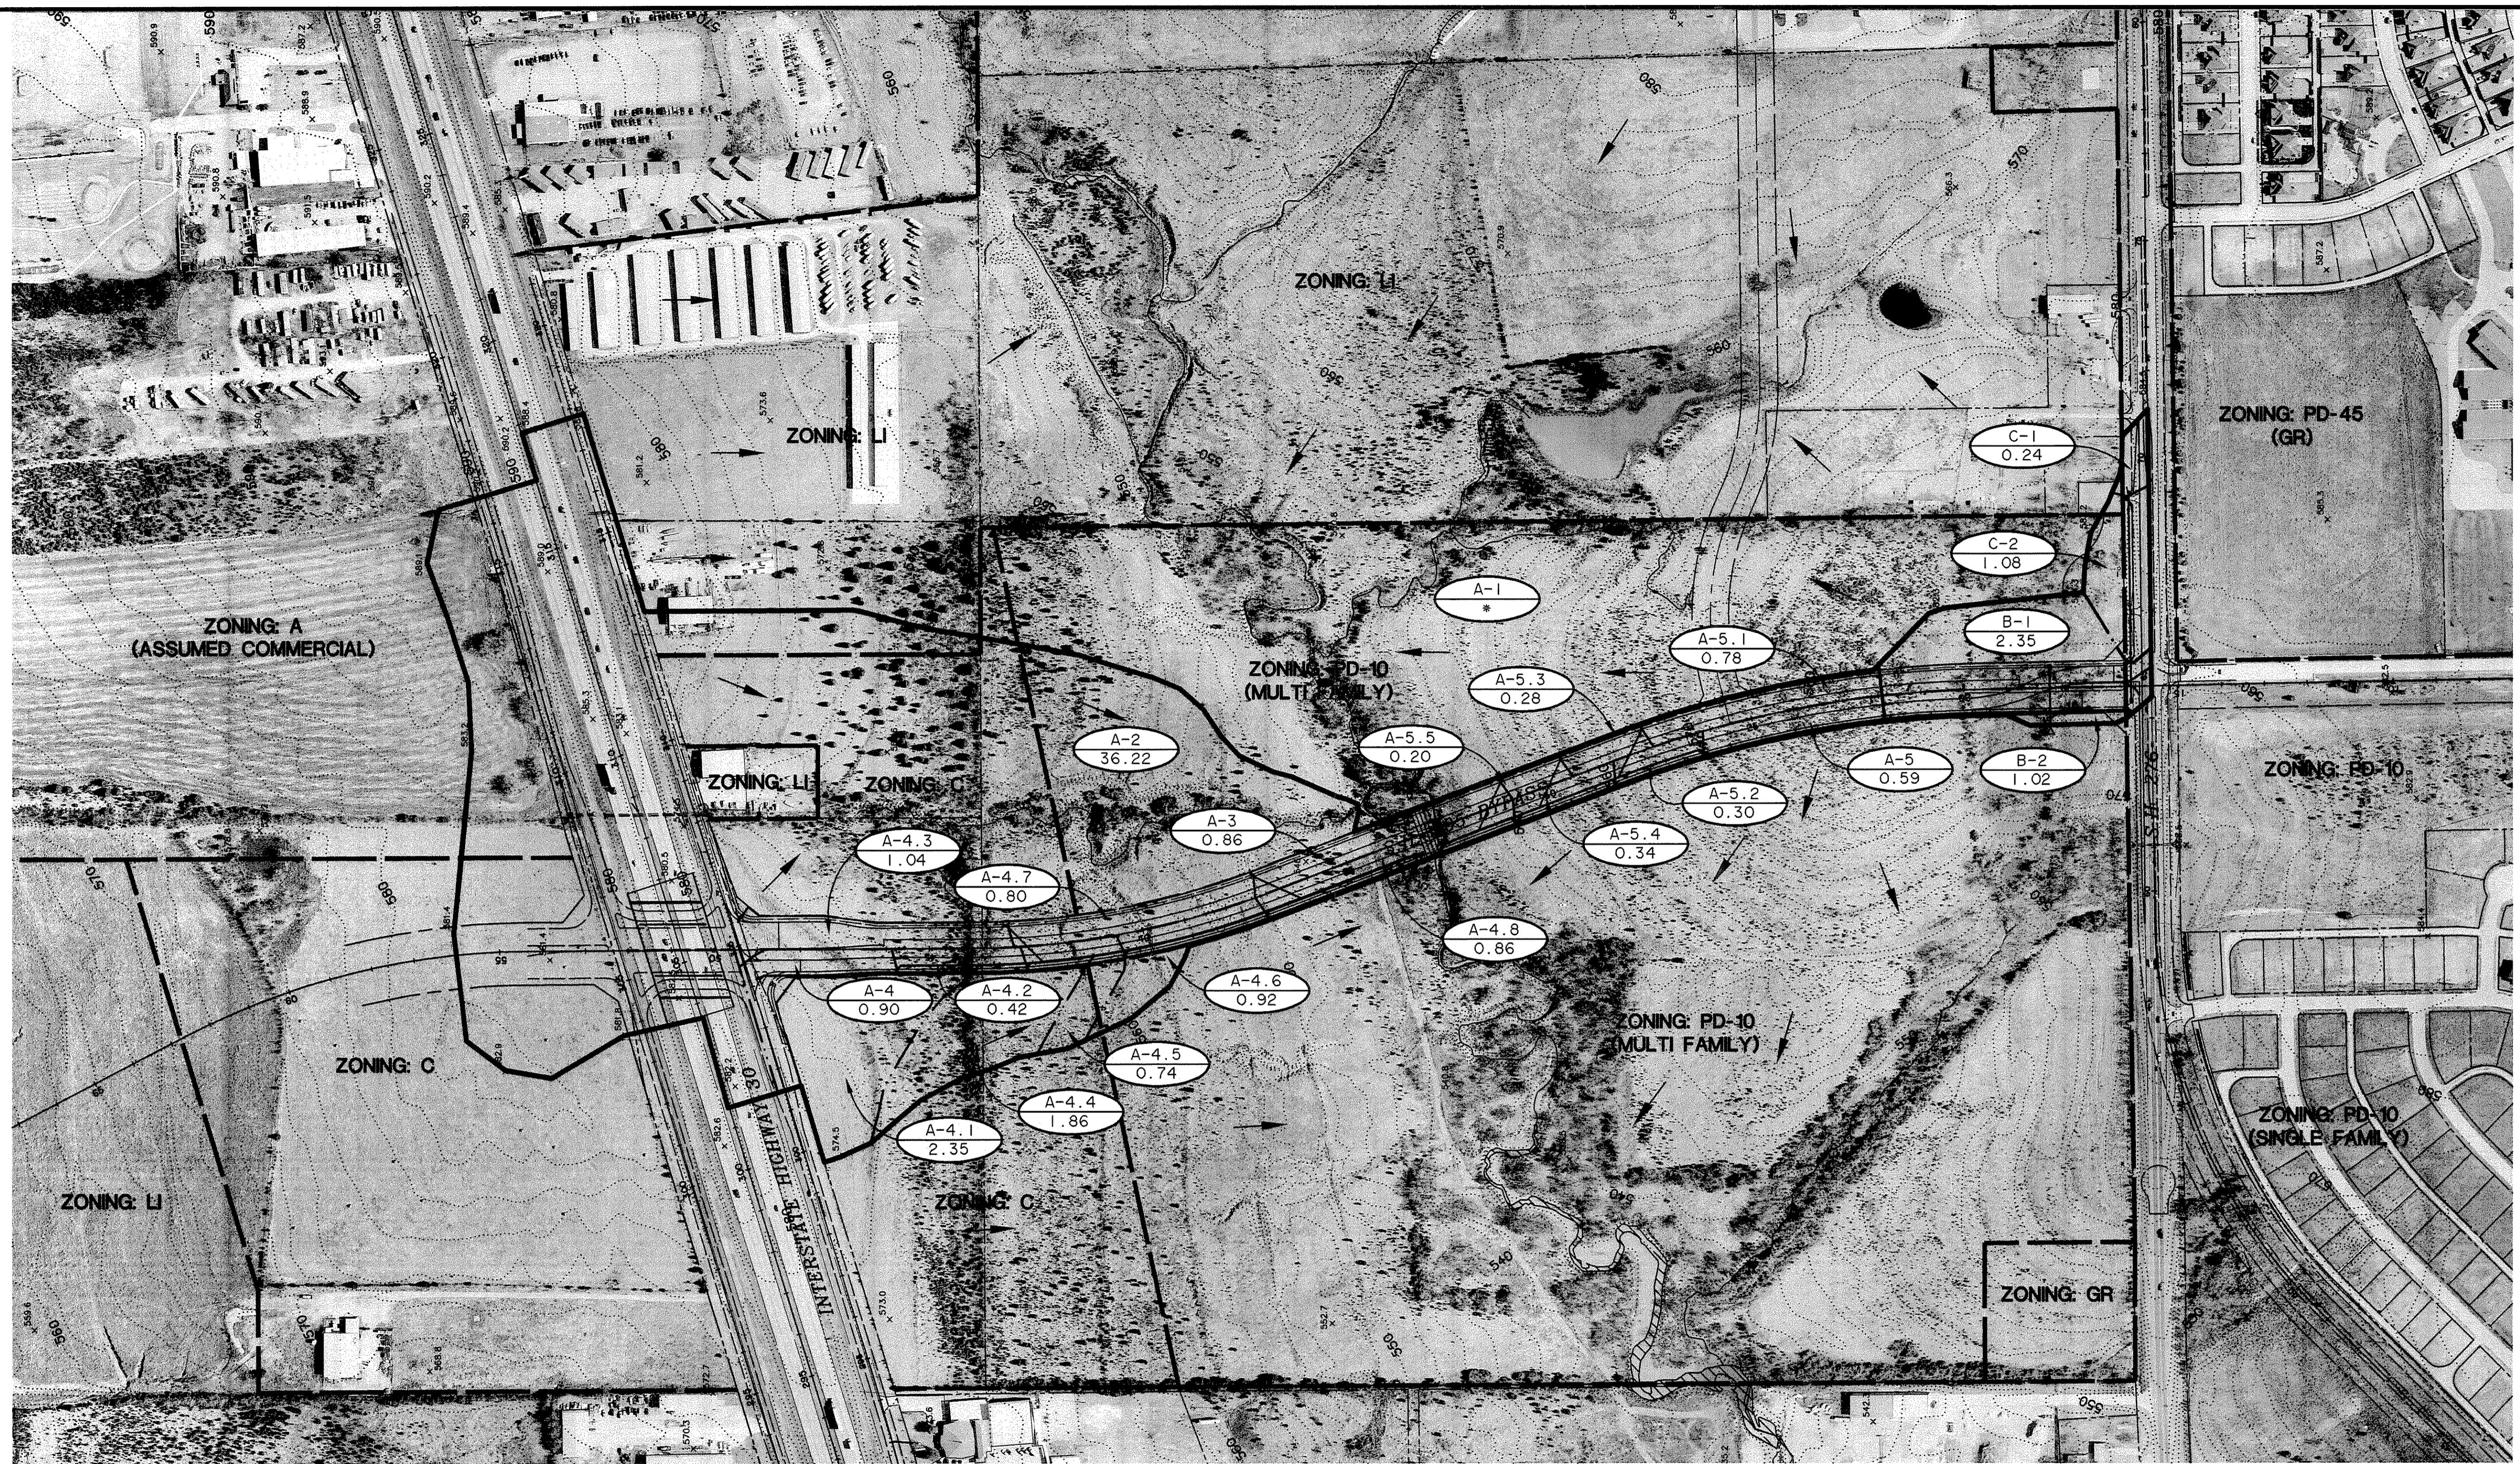


LEGEND

- | | | | |
|--|---|--|----------------------|
| | DENOTES WATERSHED BOUNDARY | | ZONING BOUNDARY LINE |
| | DENOTES MAJOR DRAINAGE AREA DIVIDE | | EXISTING CONTOUR |
| | DENOTES MAJOR DRAINAGE AREA SUBDIVIDE | | PROPOSED CONTOUR |
| | DRAINAGE AREA DESIGNATION DRAINAGE AREA ACRES | | DESIGN POINT |
| | PROPOSED STORM DRAIN & INLET | | |

*A-1 REFER TO FLOOD STUDY PREPARED BY NATIONWIDE WATER RESOURCE SERVICES, INC. FOR DRAINAGE AREA A-1 Q₁₀₀ = 2841 cfs.


RECORD PLANS
MARCH 28, 2008

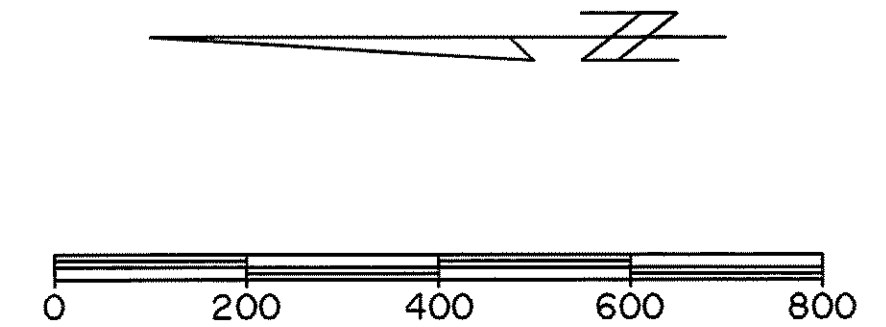

PREPARED BY:
VIA WIER & ASSOCIATES, INC.
ENGINEERS SURVEYORS LAND PLANNERS
4300 BELTWAY PLACE SUITE 130 ARLINGTON, TEXAS 76018 METRO (817)467-7700
1380 U.S. HIGHWAY 287 N. SUITE 101 MANSTED, TEXAS 76063 METRO (817)477-8700
6849 ELM STREET FRISCO, TEXAS 75034 METRO (214)387-8000
www.wierassociates.com



S.H. No. 205 BYPASS
I.H. Mo. 30 TO S.H. No. 276
PHASE I
DRAINAGE AREA MAP

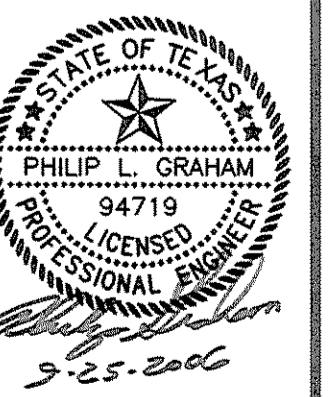

COPYRIGHT ©
WIER & ASSOCIATES, INC.
LAST SHEET EDIT
DATE 08-31-2006
WA# 04141
SHEET NO.
D101