

CURVE TABLE

NO.	RADIUS	DELTA	ARC TANGENT	CHORD	BEARING
128	40.00	63°54'14"	44.61 24.95	42.34	N 33°01'25"W
131	50.00	67°10'49"	58.63 33.21	55.32	S 32°31'06"W
153	15.00	93°54'02"	24.58 16.06	21.92	S 46°07'58"W
154	15.00	86°05'58"	22.54 14.01	20.48	N 43°52'02"W


REMAINDER
 LOFLAND FARMS, LTD.
 VOL. 1392, PG. 271
 D.R.R.C.T.

**RECORD PLANS
 MARCH 28, 2008**

BENCHMARK

1. BOX CUT WITH "X" CUT IN CENTER OF EXISTING SIDEWALK 2' SOUTH OF NORTH EDGE AT SOUTHEAST CORNER OF S.H. No. 205 BYPASS AND S.H. No. 276
 ELEV. 580.40

2. BOX CUT ON SOUTHEAST TOP OF HEADWALL ON SOUTH SIDE OF I.H. No. 30 ACCESS ROAD APPROX. 325' EAST OF FUTURE S.H. No. 205 BYPASS AND ON WEST SIDE OF NESBIT METAL CO. ORANGE METAL BLDG.
 ELEV. 573.70

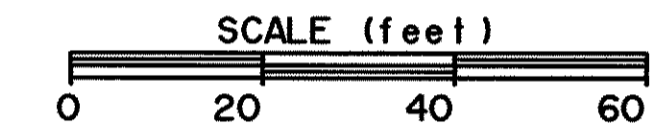

TIME 17:49 FILE: 04141-PAVE18.dwg