

**TYPICAL SECTION**  
 STA 20+16 TO 21+11  
 N.T.S.


(A) SAWED LONGITUDINAL CONTRACTION JOINT

**NOTES:**


1. CONSTRUCT PAVEMENT IN ACCORDANCE WITH CITY STANDARD CONSTRUCTION DETAILS EXCEPT AS NOTED HEREON.
2. PLACE BERMUDA GRASS SOD IN PARKWAY AND TO LIMITS SHOWN IN FUTURE MEDIANS AS PER SPECIFICATIONS.
3. IMPORT AND PLACE MINIMUM 4' TOPSOIL ON CUT AND FILL SLOPES. HYDROMULCH SEED WITH BERMUDA GRASS AS PER SPECIFICATIONS.
4. COMPACT ALL FILLS TO MINIMUM 95% OF STANDARD PROCTOR DENSITY. FILL COMPACTION SHALL BE PERFORMED WITH A SHEEPSFOOT ROLLER.
5. BACKFILL ALL CURBS WITH ON-SITE BROWN CLAY SOILS COMPACTED TO A MINIMUM 95% OF STANDARD PROCTOR DENSITY. TYPICAL ALL ROADWAY AND STREET CURBS THIS PROJECT.
6. 6'-0" CONCRETE SIDEWALK SHALL BE CONSTRUCTED WITH DEVELOPMENT OF ADJACENT PROPERTY.

**RECORD PLANS**  
**MARCH 28, 2008**

PREPARED BY:  
**WIER & ASSOCIATES, INC.**  
 ENGINEERS SURVEYORS LAND PLANNERS  
 4300 BELWAY PLACE SUITE 130 ARLINGTON, TEXAS 76018 METRO (817)467-7700  
 1380 U.S. HIGHWAY 287 N. SUITE 101 MANSFIELD, TEXAS 76063 METRO (817)477-8700  
 6848 ELM STREET PERCO, TEXAS 75084 METRO (214)387-8800  
 www.wierassociates.com

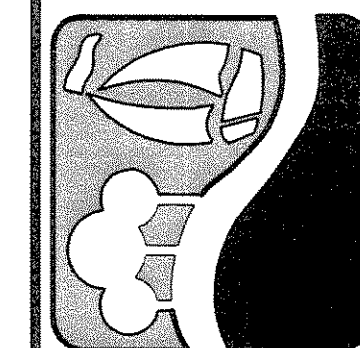

**PHASE I SH. 205 BYPASS**  
**FROM SH. 276 TO INTERSTATE 30**  
**TYPICAL**  
**SECTIONS**

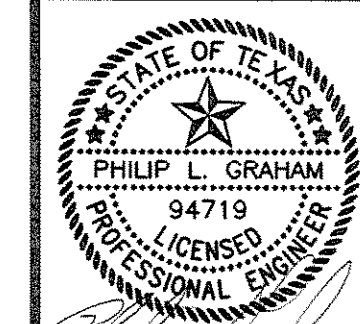

3/28/2008  
 COPYRIGHT ©  
 WIER & ASSOCIATES, INC.  
 LAST SHEET EDIT  
 DATE 11-05-2007  
 WA# 04141  
**SHEET NO.**  
**PO03**