


TIME 11:14 FILE: 04141-SDPP5.dwg

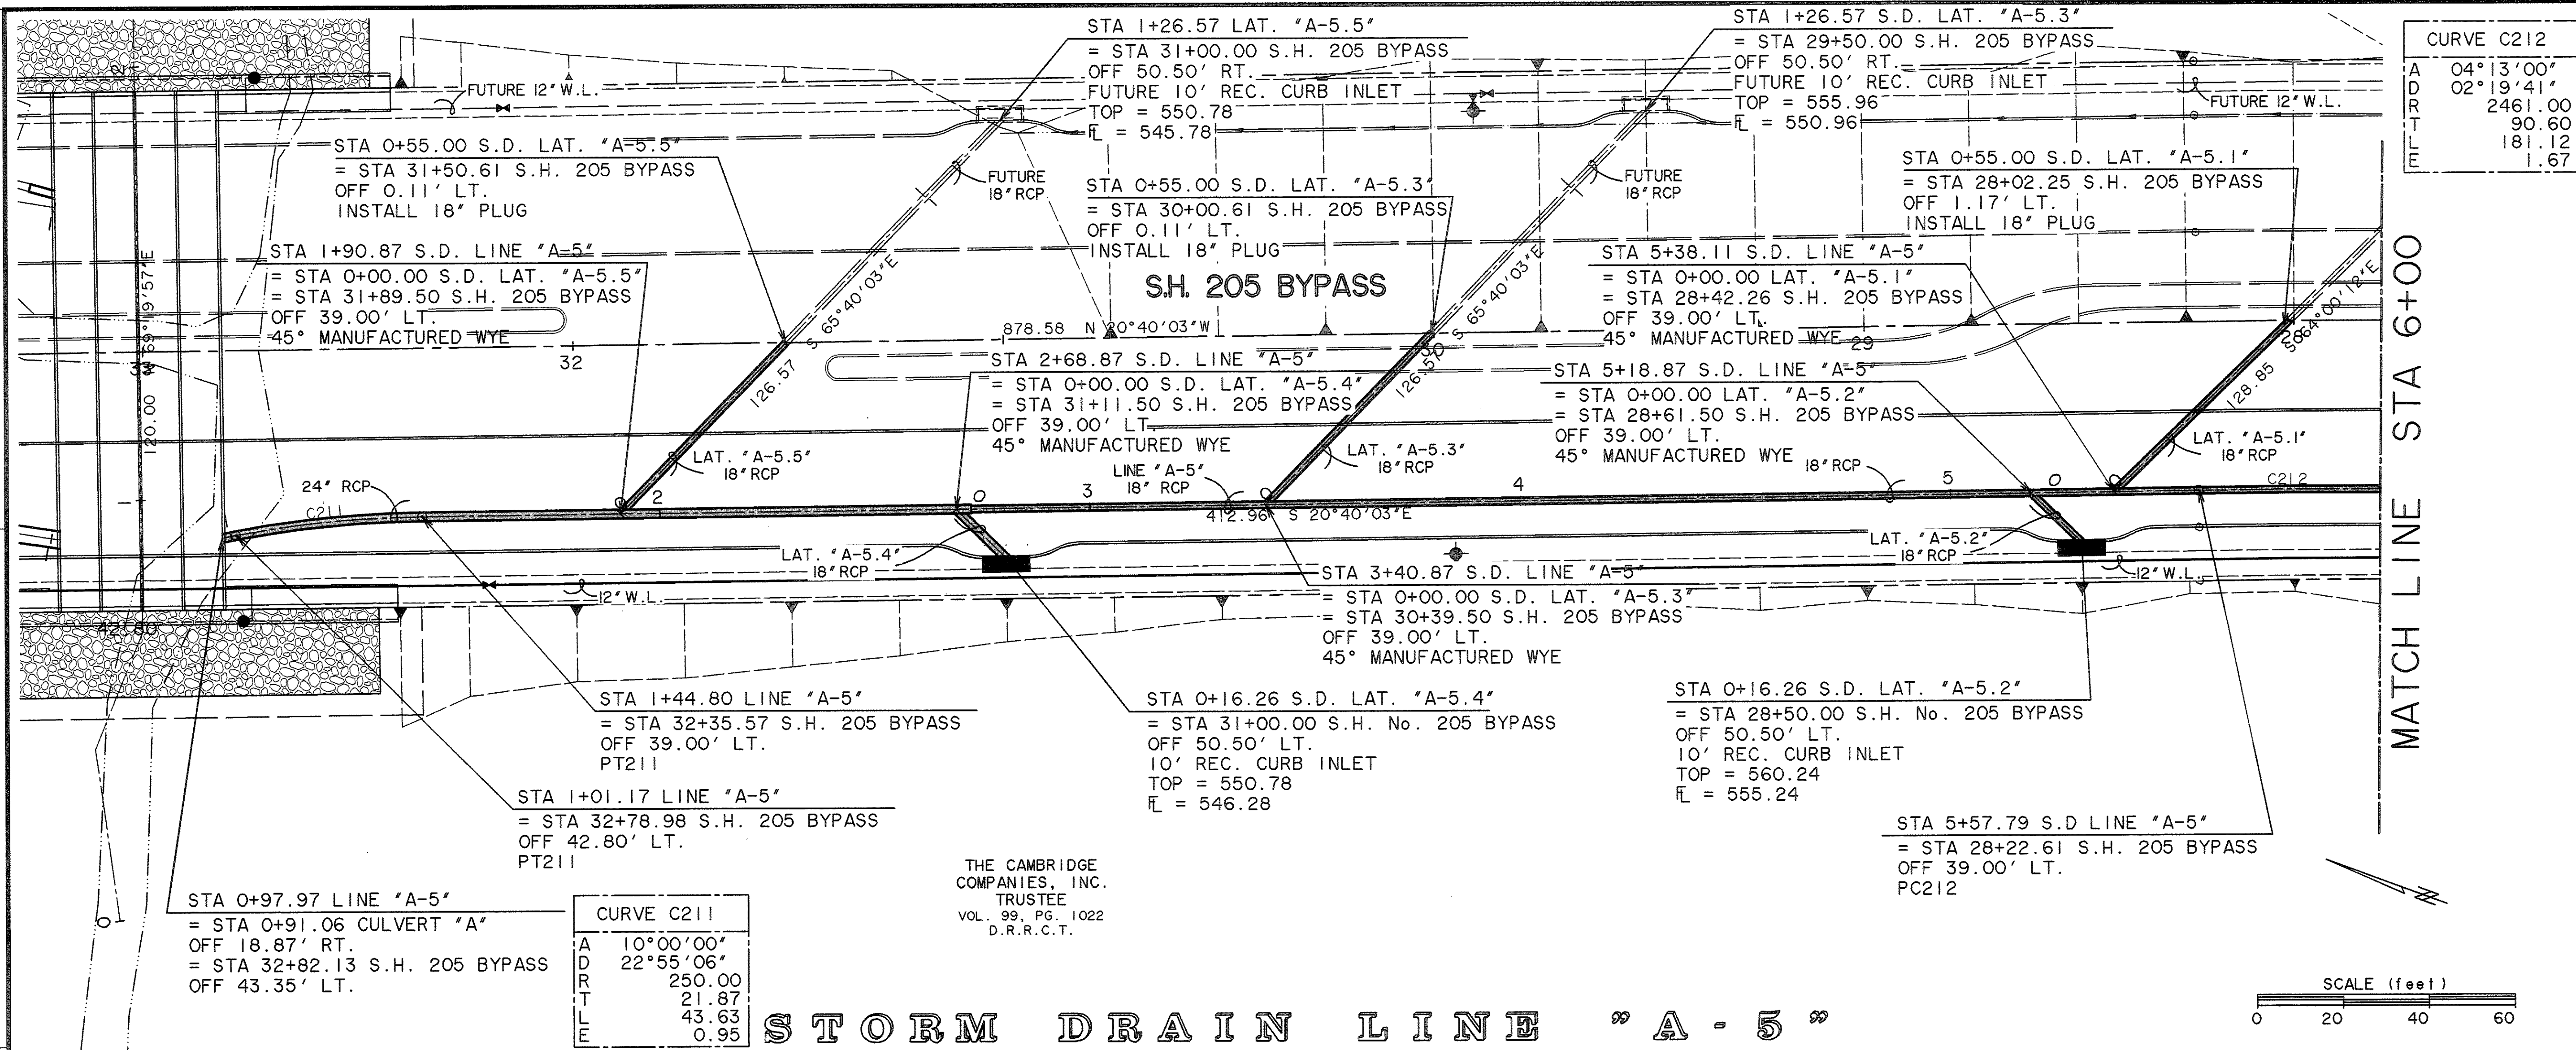



CURVE C212

A	04° 13' 00"
D	02° 19' 41"
R	2461.00
T	90.60
L	181.12
E	1.67

CURVE C211

A	10° 00' 00"
D	22° 55' 06"
R	250.00
T	21.87
L	43.63
E	0.95

THE CAMBRIDGE COMPANIES, INC. TRUSTEE
VOL. 99, PG. 1022
D.R.R.C.T.

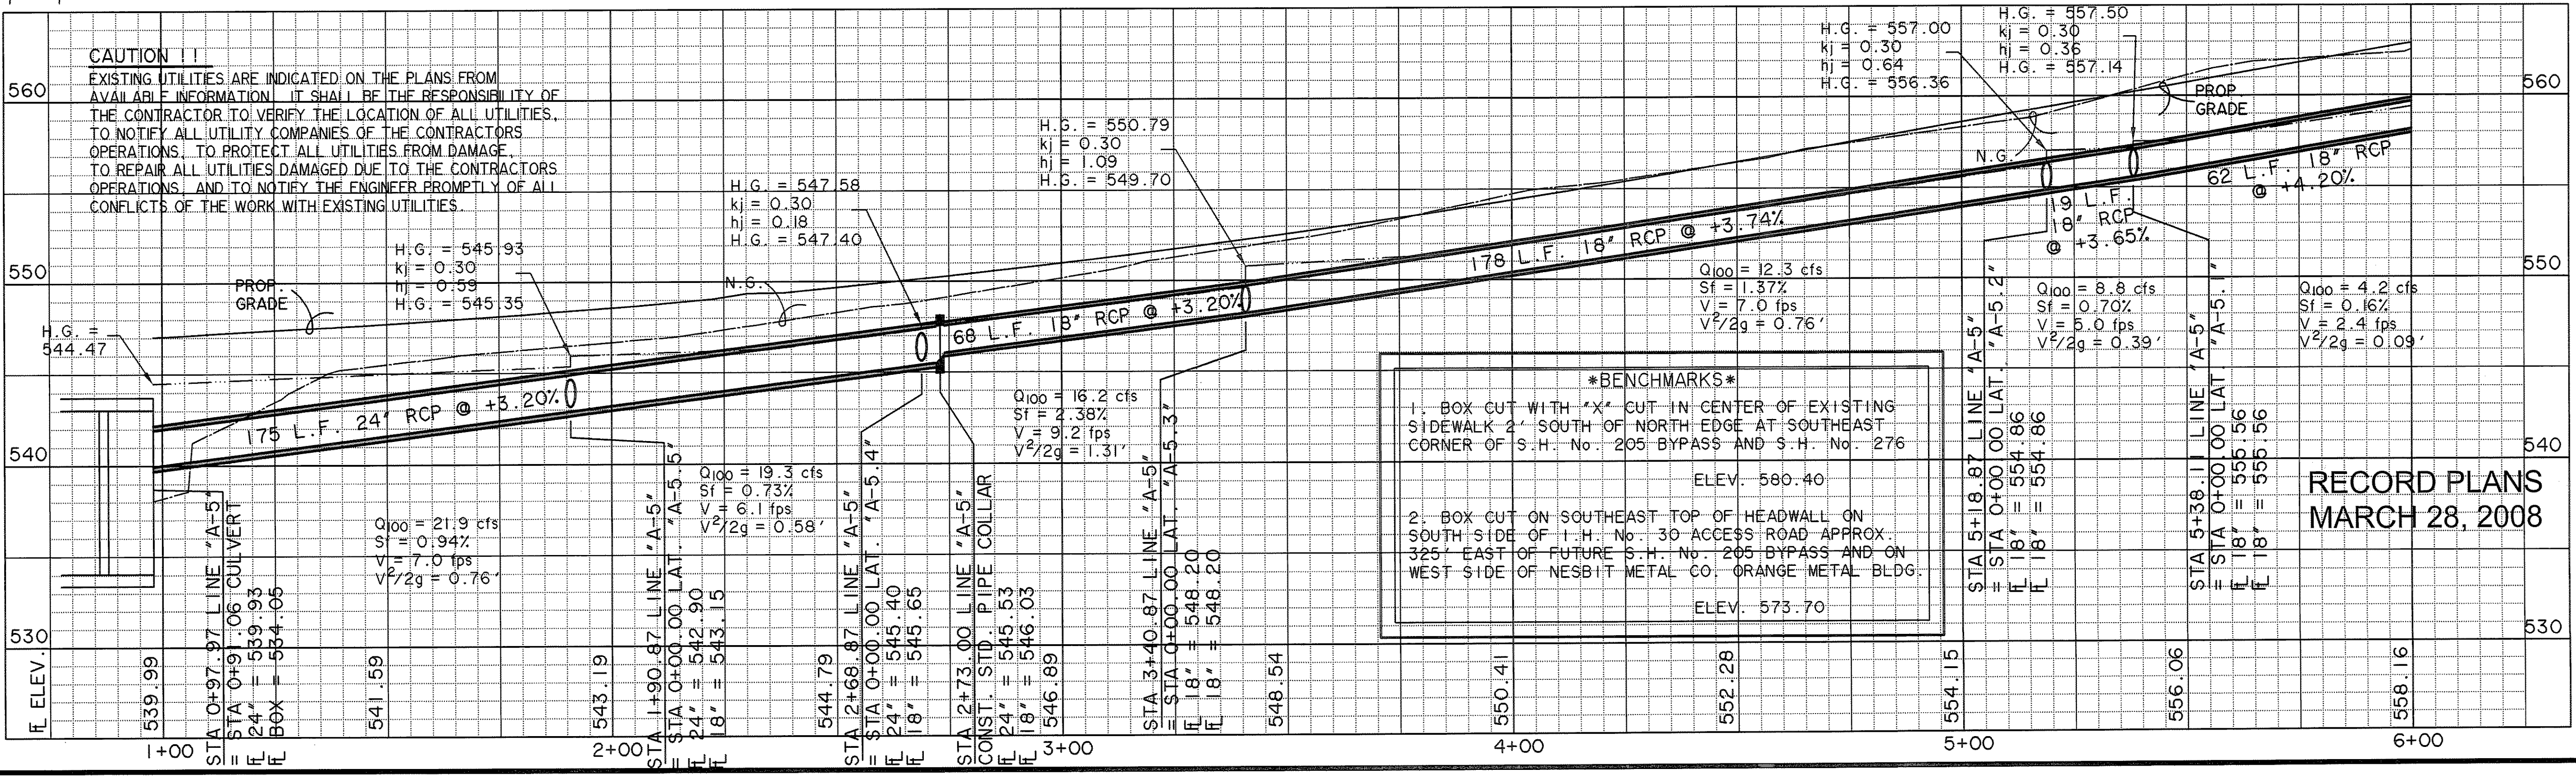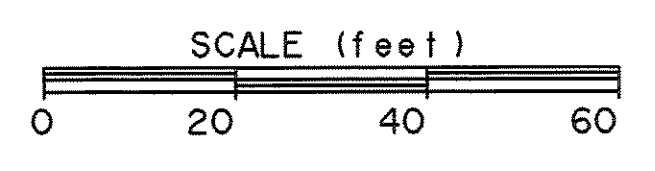


CAUTION !!
EXISTING UTILITIES ARE INDICATED ON THE PLANS FROM AVAILABLE INFORMATION. IT SHALL BE THE RESPONSIBILITY OF THE CONTRACTOR TO VERIFY THE LOCATION OF ALL UTILITIES, TO NOTIFY ALL UTILITY COMPANIES OF THE CONTRACTOR'S OPERATIONS, TO PROTECT ALL UTILITIES FROM DAMAGE, TO REPAIR ALL UTILITIES DAMAGED DUE TO THE CONTRACTOR'S OPERATIONS, AND TO NOTIFY THE ENGINEER PROMPTLY OF ALL CONFLICTS OF THE WORK WITH EXISTING UTILITIES.


BENCHMARKS
1. BOX CUT WITH "X" CUT IN CENTER OF EXISTING SIDEWALK 2' SOUTH OF NORTH EDGE AT SOUTHEAST CORNER OF S.H. No. 205 BYPASS AND S.H. No. 276
ELEV. = 580.40
2. BOX CUT ON SOUTHEAST TOP OF HEADWALL ON SOUTH SIDE OF I.H. No. 30 ACCESS ROAD APPROX. 325' EAST OF FUTURE S.H. No. 205 BYPASS AND ON WEST SIDE OF NESBIT METAL CO. ORANGE METAL BLDG.
ELEV. = 573.70

RECORD PLANS
MARCH 28, 2008

PREPARED BY:
VIA WIER & ASSOCIATES, INC.
ENGINEERS SURVEYORS LAND PLANNERS
4300 BELTWAY PLACE SUITE 130 ARLINGTON, TEXAS 76018 METRO (817) 467-7700
1390 U.S. HIGHWAY 287 N. SUITE 101 MANFELD, TEXAS 76063 METRO (817) 477-6700
6849 ELM STREET FRISCO, TEXAS 75034 METRO (214) 387-8000
www.viawier.com

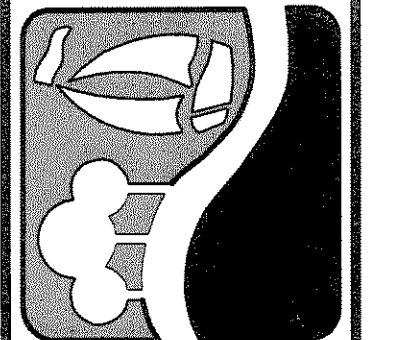

PHASE I S.H. 205 BYPASS
FROM S.H. 276 TO INTERSTATE 30
STORM DRAIN LINE "A-5"
PLAN & PROFILE
STA 1+00 TO 6+00

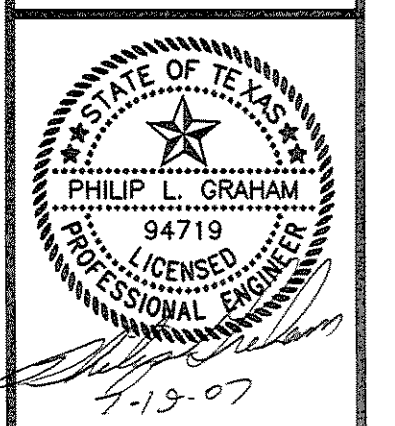

COPYRIGHT ©
WIER & ASSOCIATES, INC.
LAST SHEET EDIT
DATE 07-19-2007
WA# 04141
SHEET NO.
D108