

CITY OF ROCKWALL, TEXAS

CONSTRUCTION PLANS

FOR

PAVING, DRAINAGE & WATER IMPROVEMENTS

TO SERVE

PHASE I

S.H. 205 BYPASS

ROCKWALL COUNTY, TEXAS

NOTES:

- STANDARD DRAWINGS OF THE STANDARD SPECIFICATIONS FOR PUBLIC WORKS CONSTRUCTION, NORTH CENTRAL TEXAS, THIRD EDITION, DATED 1998 AND AS MODIFIED BY CITY OF ROCKWALL SPECIAL PROVISIONS SECTION II ARE HEREIN INCORPORATED BY REFERENCE.
- THE STANDARD SHEETS P301 THROUGH P303, M203 THROUGH M206, D301 THROUGH D309, AND T201 THROUGH T221, SPECIFICALLY IDENTIFIED IN THIS INDEX OF SHEETS, HAVE BEEN SELECTED BY ME OR UNDER MY RESPONSIBLE SUPERVISION AS BEING APPLICABLE TO THIS PROJECT.
- SPECIFICATIONS ADOPTED BY THE TEXAS DEPARTMENT OF TRANSPORTATION, JUNE 1, 2004 AND SPECIFICATION ITEMS LISTED AND DATED AS FOLLOWS SHALL GOVERN FOR CONSTRUCTION SHOWN ON SHEETS P101, P108, P109, P110, M102, D111 AND D112 OF THESE PLANS.

SHEET INDEX

GENERAL

- COVER SHEET
- RIGHT-OF-WAY DEDICATION PLAT
- S001 GENERAL NOTES & TOPOGRAPHIC LEGEND
- S002-S003 SHEET QUANTITIES

PAVING PLANS

- P001-P006 TYPICAL SECTIONS
- P101-P108 S.H. 205 BYPASS PAVING PLAN & PROFILES
- P109-P110 S.H. 276 WIDENING PAVING PLAN
- P201-P202 S.H. 205 & S.H. 276 ASPHALT TRANSITION PAVING PLAN
- P203 S.H. 205 & I-30 EB FRONTAGE ROAD ASPHALT TRANSITION PAVING PLAN
- P301-P303 MBGF DETAILS
- P304-P306 PAVING DETAILS

PAVEMENT MARKING PLANS

- M101-M102 STRIPING PLANS
- M201-M206 STRIPING DETAILS

DRAINAGE PLANS

- D101 OVERALL DRAINAGE AREA MAP
- D102 DRAINAGE AREA & INLET DESIGN CALCULATIONS
- D103 STORM DRAIN DESIGN CALCULATIONS
- D104-D112 STORM DRAIN PLAN & PROFILES
- D201-D202 STORM DRAIN LATERAL PROFILES
- D203 BOX CULVERT GRADING PLAN
- D301-D309 DRAINAGE DETAILS

WATER PLANS


- U101-U107 12' WATER LINE 'A' PLAN & PROFILES
- U108-U114 12' WATER LINE 'B' PLAN & PROFILES

STORMWATER POLLUTION PREVENTION PLANS

- E001-E004 SWP3 NOTES
- E101-E103 SWP3 PLANS
- E201-E202 SWP3 DETAILS

TRAFFIC CONTROL PLANS

- T101-T102 TRAFFIC CONTROL PLANS
- T201-T221 TRAFFIC CONTROL DETAILS

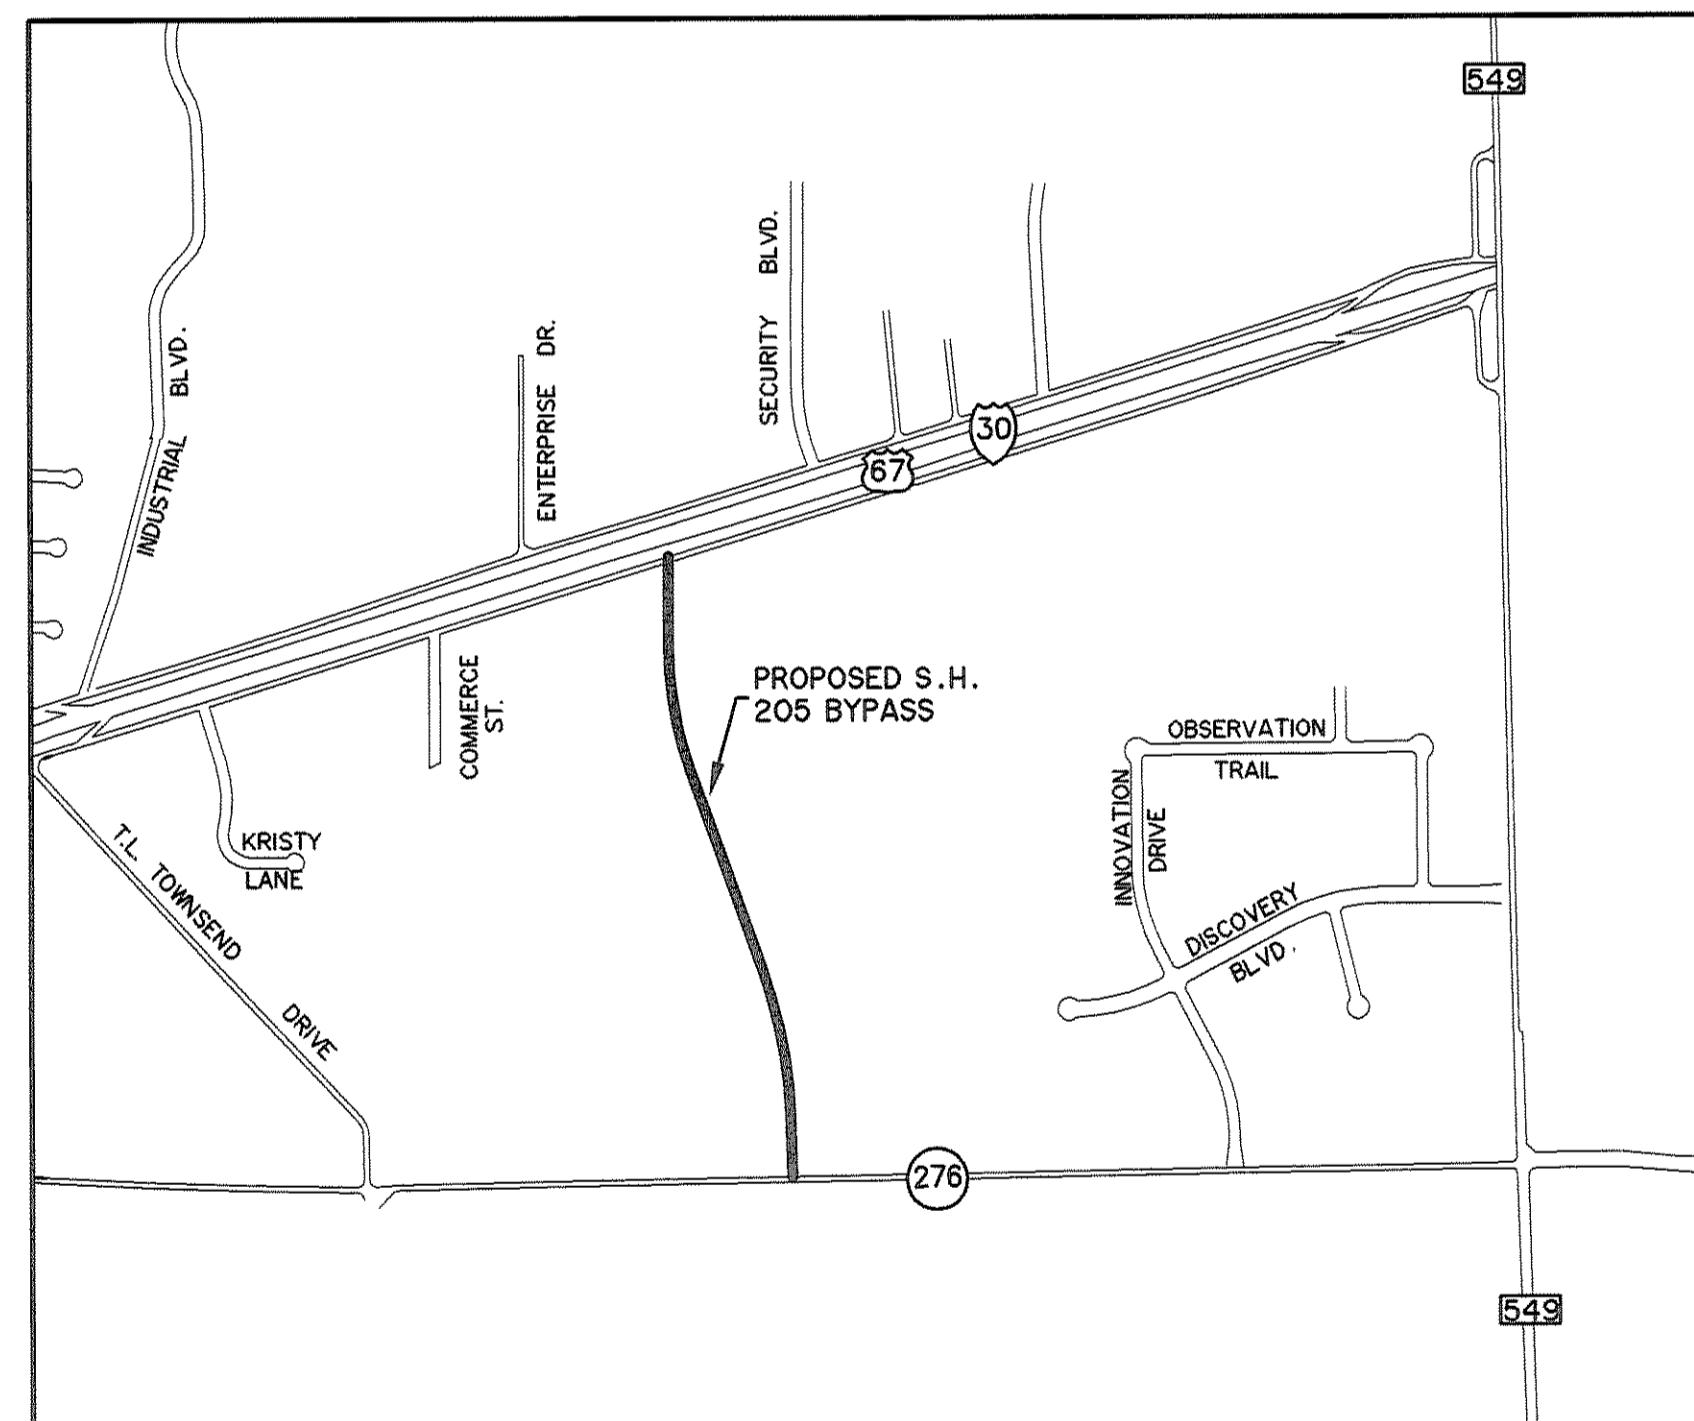

VICINITY MAP

N.T.S.

BILL CECIL - MAYOR

COUNCILMEMBERS

STEPHEN STRAUGHAN - MAYOR PRO-TEM

DAVID SWEET

MATT SCOTT

GLEN FARRIS


MARGO NIELSEN

CLIFF SEVIER


JULIE COUCH - City Manager

CHUCK TODD, P.E. - City Engineer

PREPARED BY:
WIA WIER & ASSOCIATES, INC.
 ENGINEERS SURVEYORS LAND PLANNERS
 4300 BELTWAY PLACE SUITE 130 ARLINGTON, TEXAS 76018 METRO (817)467-7700
 1380 U.S. HIGHWAY 287 N, SUITE 101 MANSFIELD, TEXAS 76063 METRO (817)477-8700
 6849 ELM STREET FRISCO, TEXAS 75034 METRO (214)387-8000
 www.WierAssociates.com

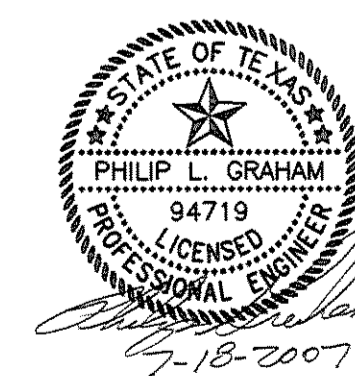


RECORD PLANS
 MARCH 28, 2008

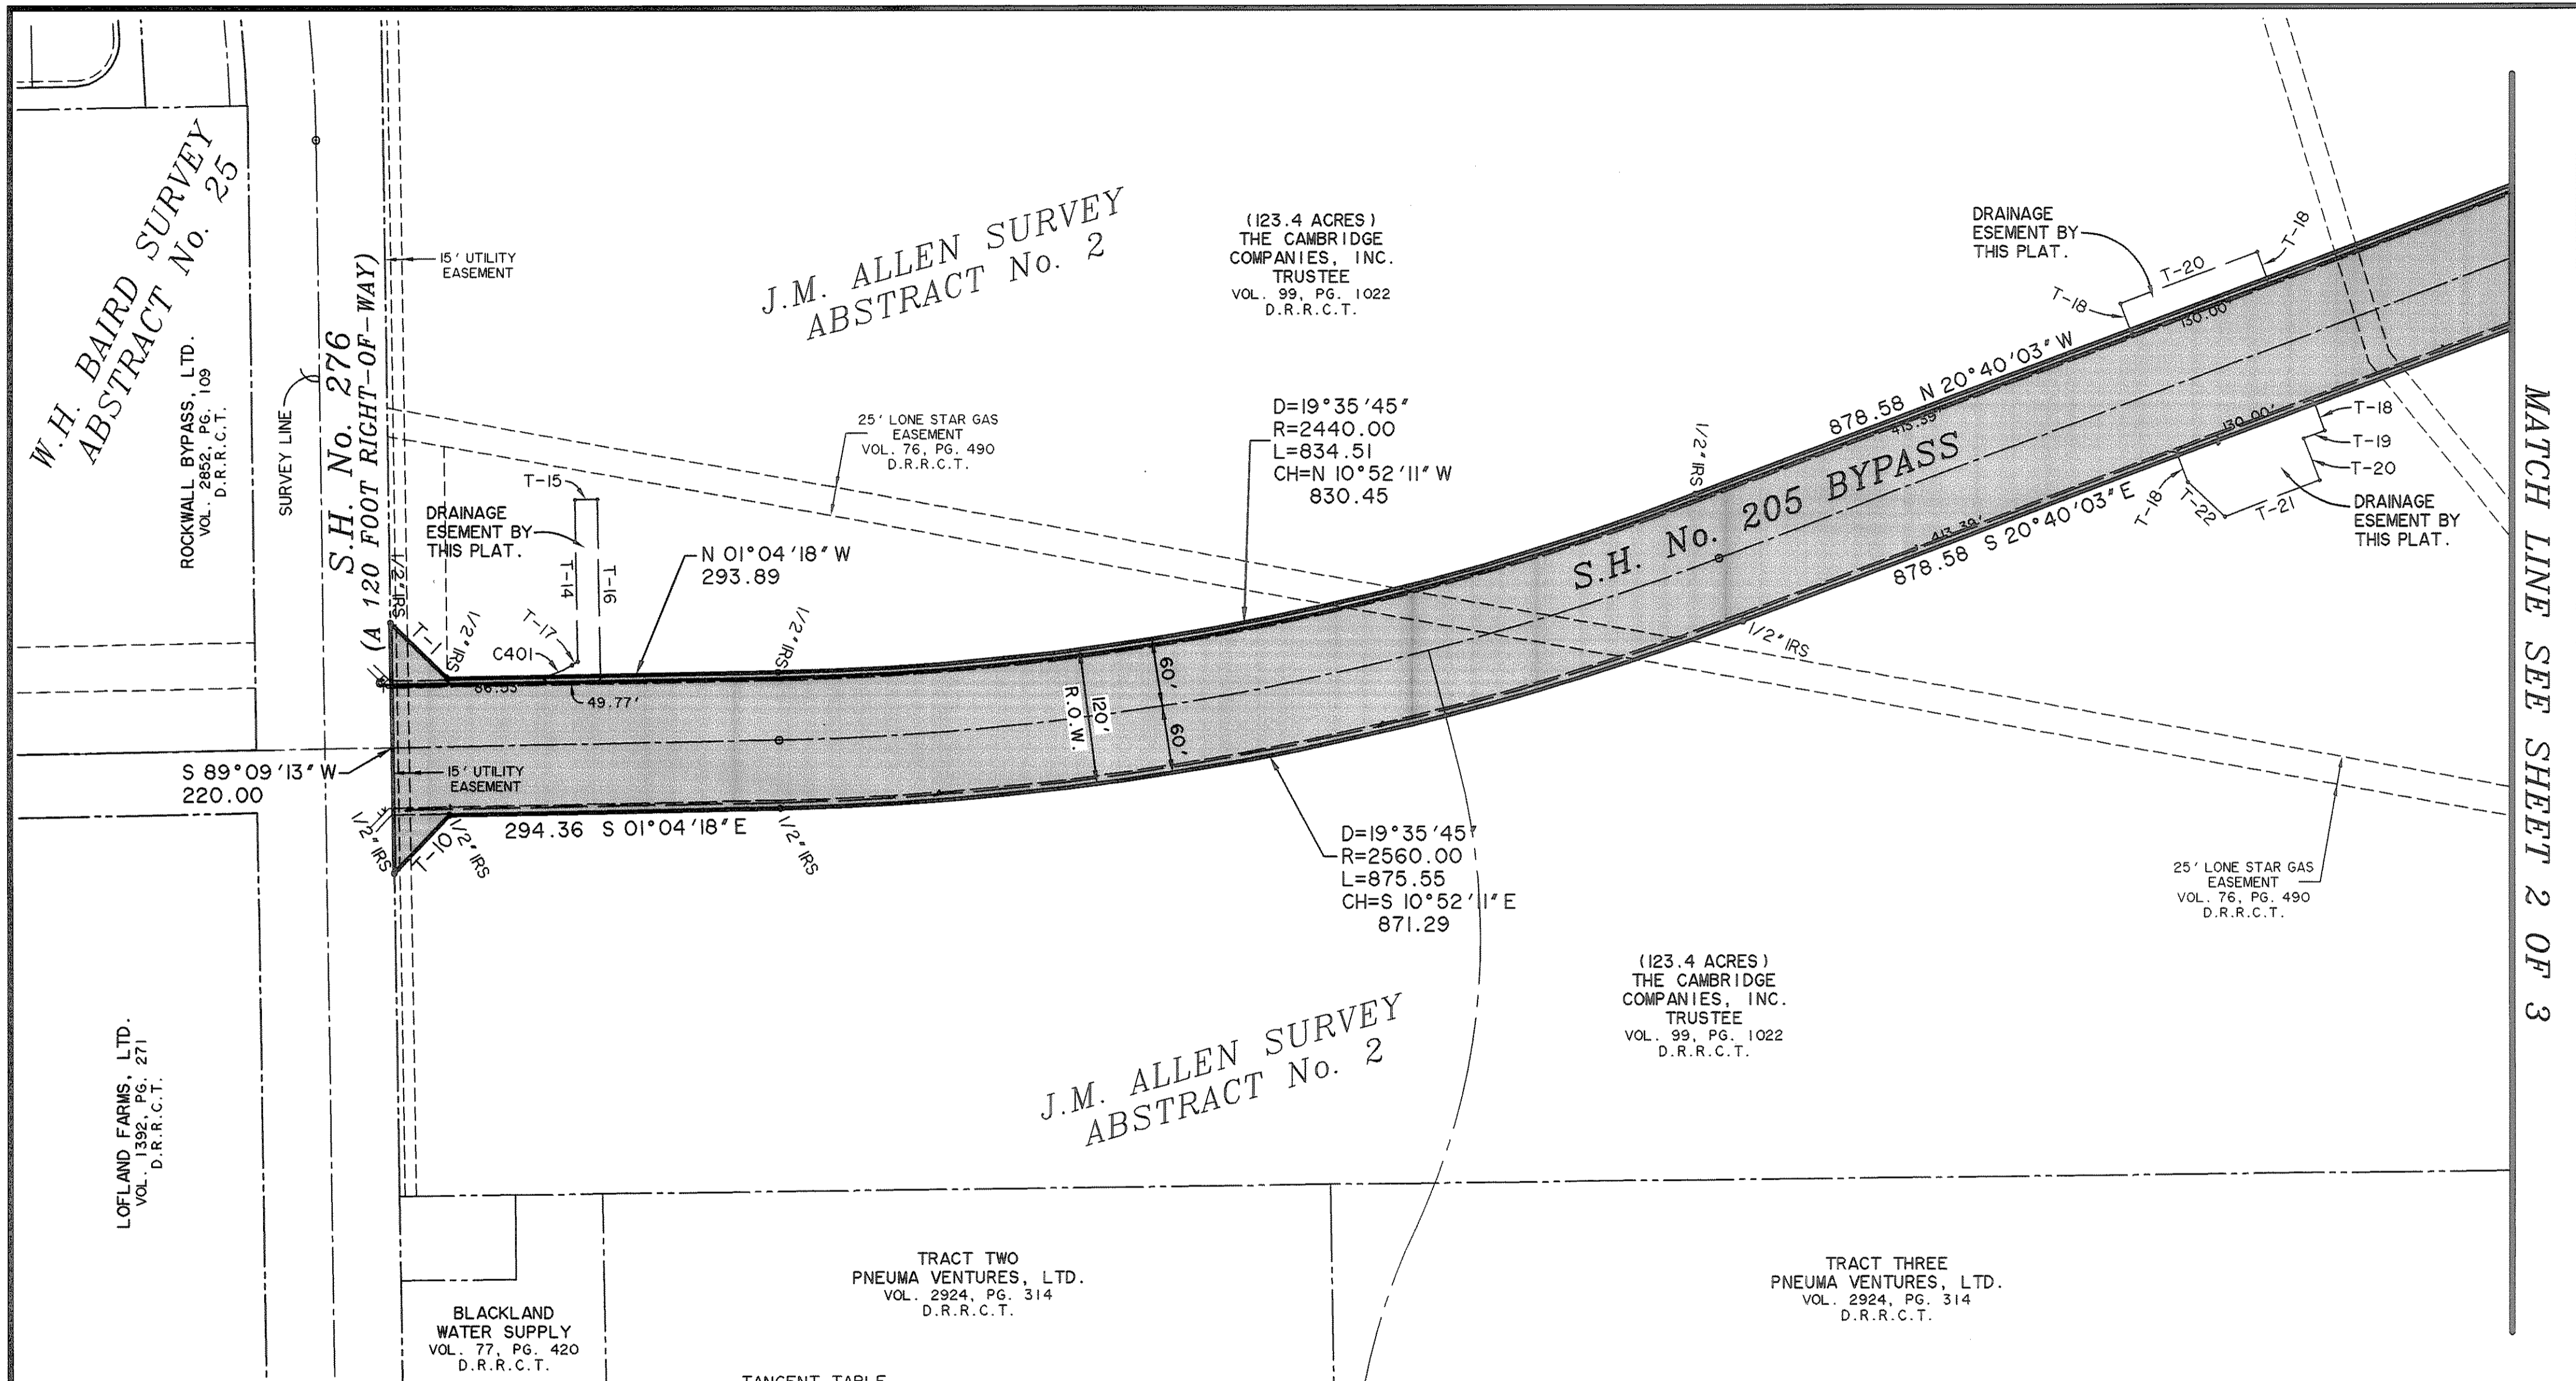

MATCH LINE SEE SHEET 2 OF 3

W.A. No. 04141

DATE: 03-07-2005 FILE: 04141-Plat1.dwg

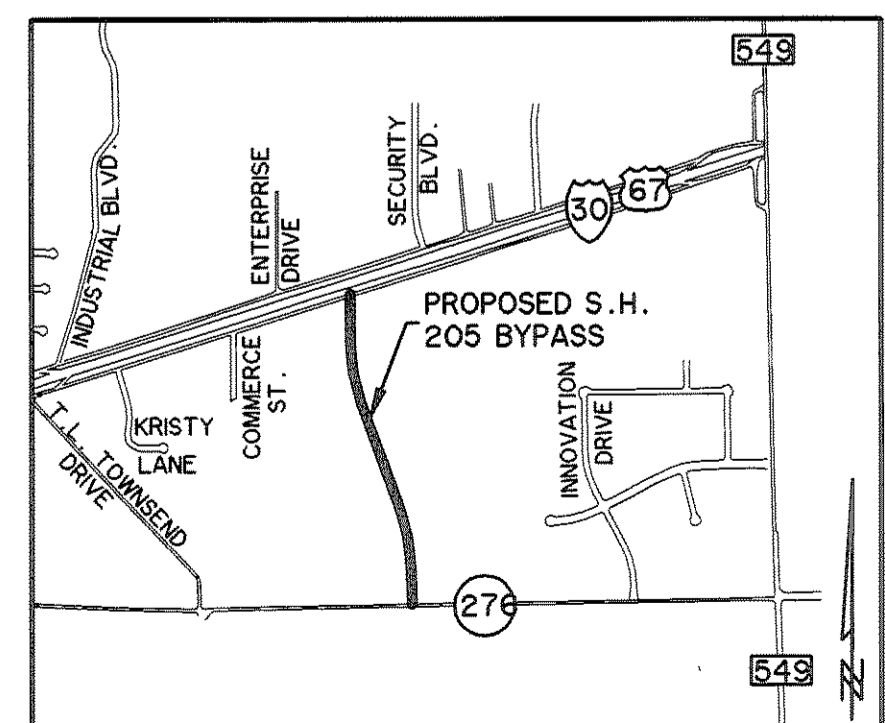


VICINITY MAP

N.T.S.

TANGENT TABLE

NO.	DISTANCE	BEARING
T-1	70.57	N 44°02'28"E
T-2	100.15	N 03°29'11"W
T-3	90.00	N 00°20'18"W
T-4	74.34	N 52°52'25"W
T-5	99.11	S 72°49'16"W
T-6	179.10	S 69°25'07"W
T-7	68.65	S 39°58'55"W
T-8	150.00	S 00°20'18"E
T-9	126.22	S 07°37'52"W
T-10	70.85	S 45°57'32"E
T-11	15.00	N 35°31'10"E
T-12	16.68	S 54°28'50"E
T-13	30.80	N 54°28'50"W
T-14	142.93	S 88°55'42"W
T-15	20.00	N 01°04'18"W
T-16	155.82	N 88°55'42"E
T-17	6.24	N 31°04'18"W
T-18	25.00	S 69°19'57"W
T-19	20.00	S 20°40'03"E
T-20	40.00	N 69°19'57"E
T-21	90.00	S 20°40'03"E
T-22	44.72	S 42°46'03"W

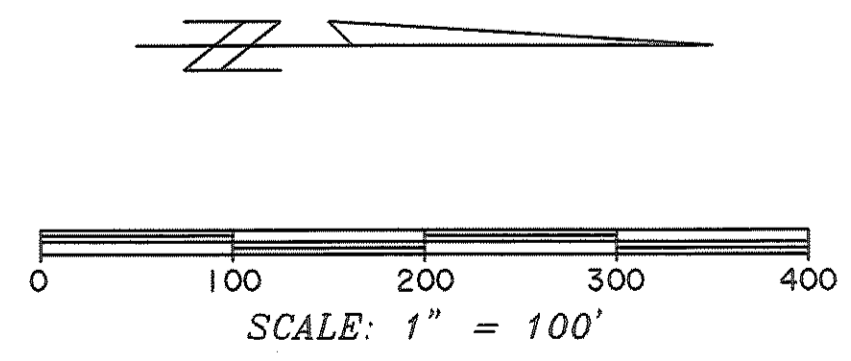

CURVE TABLE

NO.	RADIUS	DELTA	ARC	TANGENT	CHORD	BEARING
401	82.50	16°19'03"	26.34	13.26	26.25	S 22°54'46"E

RIGHT-OF-WAY DEDICATION PLAT FOR:
S.H. No. 205 BYPASS
 AN ADDITION TO THE CITY OF ROCKWALL, ROCKWALL COUNTY, TEXAS, BEING 9.408 ACRES OF LAND LOCATED IN THE J.M. ALLEN SURVEY, ABSTRACT No. 2 AND THE J. LOCKHART SURVEY, ABSTRACT No. 134, CITY OF ROCKWALL, ROCKWALL COUNTY, TEXAS

OWNER:
THE CAMBRIDGE COMPANIES, INC.
 8235 DOUGLAS AVE., SUITE 650
 DALLAS, TEXAS 75225
 (214) 691-2556

PREPARED BY:
VIA WIER & ASSOCIATES, INC.
ENGINEERS SURVEYORS LAND PLANNERS
 4300 BELTWAY PLACE SUITE 130 ARLINGTON, TEXAS 76018 METRO (817)467-7700
 1380 U.S. HIGHWAY 287 N, SUITE 101 MANSFIELD, TEXAS 76063 METRO (817)477-8700
 6849 ELM STREET FRISCO, TEXAS 75034 METRO (214)387-8000
 www.WierAssociates.com

SHEET 1 OF 3

RECORD PLANS
 MARCH 28, 2008

MATCH LINE SEE SHEET 1 OF 3

J.M. ALLEN SURVEY
ABSTRACT No. 2

(123.4 ACRES)
THE CAMBRIDGE
COMPANIES, INC.
TRUSTEE
VOL. 99, PG. 1022
D.R.R.C.T.

J. LOCKHART SURVEY
ABSTRACT No. 134

(12.4 ACRES)
THE CAMBRIDGE
COMPANIES, INC.
TRUSTEE
VOL. 101, PG. 795
D.R.R.C.T.

INTERSTATE HIGHWAY No. 30
(A VARIABLE WIDTH RIGHT-OF-WAY)

PLACE OF BEGINNING

S.H. No. 205 BYPASS

D=20°19'45"
R=2010.00
L=713.17
CH=N 10°30'11"W
709.43

DRAINAGE
EASEMENT BY
THIS PLAT.

N 00°20'18"W
229.35

N 65°41'46"E
201.30

N 20°40'03"W
878.58

D=20°19'45"
R=1890.00
L=670.59
CH=S 10°30'11"E
667.08

S 00°20'18"E
226.80

T-13
T-12
T-11
T-10
T-9
T-8
T-7
T-6
T-5
T-4
T-3
T-2
T-1

(123.4 ACRES)
THE CAMBRIDGE
COMPANIES, INC.
TRUSTEE
VOL. 99, PG. 1022
D.R.R.C.T.

J.M. ALLEN SURVEY
ABSTRACT No. 2

S 71°32'05"W
562.37


NESBO
TEXAS LIMITED PARTNERSHIP
VOL. 1201, PG. 251
D.R.R.C.T.

J. LOCKHART SURVEY
ABSTRACT No. 134

LAFON
SUBDIVISION
CAB. "B", SLIDE 42
P.R.R.C.T.

**RIGHT-OF-WAY DEDICATION PLAT FOR:
S.H. No. 205 BYPASS**



AN ADDITION TO THE CITY OF ROCKWALL, ROCKWALL
COUNTY, TEXAS, BEING 9.408 ACRES OF LAND
LOCATED IN THE J.M. ALLEN SURVEY,
ABSTRACT No. 2 AND THE J. LOCKHART SURVEY,
ABSTRACT No. 134, CITY OF ROCKWALL,
ROCKWALL COUNTY, TEXAS

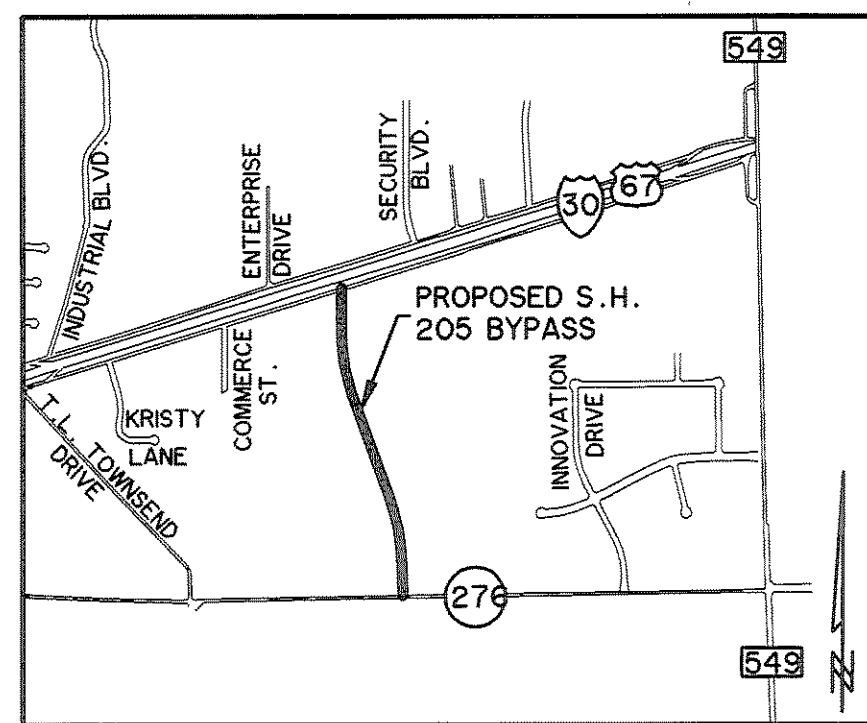

VICINITY MAP

N.T.S.

TANGENT TABLE		
NO.	DISTANCE	BEARING
T-1	70.57	N 44°02'28"E
T-2	100.15	N 03°29'11"W
T-3	90.00	N 00°20'18"W
T-4	74.34	N 52°52'25"W
T-5	99.11	S 72°49'16"W
T-6	179.10	S 69°25'07"W
T-7	68.65	S 39°58'55"W
T-8	150.00	S 00°20'18"E
T-9	126.22	S 07°37'52"W
T-10	70.85	S 45°57'32"E
T-11	15.00	N 35°31'10"E
T-12	16.68	S 54°28'50"E
T-13	30.80	S 54°28'50"W
T-14	142.93	S 88°55'42"W
T-15	20.00	N 01°04'18"W
T-16	155.82	N 88°55'42"E
T-17	6.24	N 31°04'18"W
T-18	25.00	S 69°19'57"W
T-19	20.00	S 20°40'03"E
T-20	40.00	N 69°19'57"E
T-21	90.00	S 20°40'03"E
T-22	44.72	S 42°46'03"W

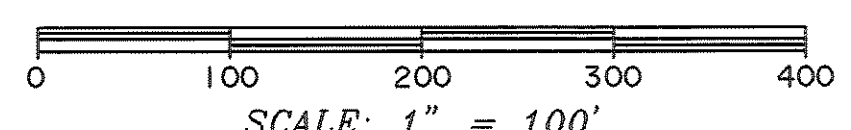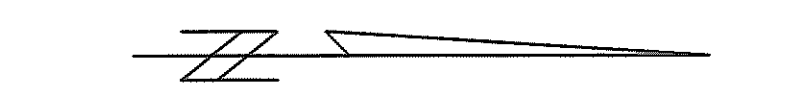

CURVE TABLE					
NO.	RADIUS	DELTA	ARC TANGENT	CHORD	BEARING
401	82.50	16°19'03"	26.34	13.26	26.25 S 22°54'46"E

OWNER:
THE CAMBRIDGE COMPANIES, INC.
8235 DOUGLAS AVE., SUITE 650
DALLAS, TEXAS 75225
(214) 691-2556

PREPARED BY:
VIA WIER & ASSOCIATES, INC.
ENGINEERS SURVEYORS LAND PLANNERS
4300 BELTWAY PLACE SUITE 130 ARLINGTON, TEXAS 76018 METRO (817)467-7700
1380 U.S. HIGHWAY 287 N, SUITE 101 MANSFIELD, TEXAS 76063 METRO (817)477-8700
6849 ELM STREET FRISCO, TEXAS 75034 METRO (214)387-8000
www.WierAssociates.com

SHEET 2 OF 3

W.A. No. 04141

FILE:04141-Plat12.dwg

DATE: 03-07-2005

RECORD PLANS
MARCH 28, 2008

OWNER'S CERTIFICATE

STATE OF TEXAS
COUNTY OF ROCKWALL

WHEREAS THE CAMBRIDGE COMPANIES, INC., BEING THE OWNER OF A TRACT OF land in the County of Rockwall, State of Texas, said tract being described as follows:

LEGAL DESCRIPTION

BEING 9.408 ACRES OF LAND LOCATED IN THE J.M. ALLEN SURVEY, ABSTRACT No. 2 AND THE J. LOCKHART SURVEY, ABSTRACT No. 134, ROCKWALL COUNTY, TEXAS AND BEING A PORTION OF THOSE CERTAIN 123.4 AND 12.4 ACRE TRACTS OF LAND DESCRIBED IN DEED TO THE CAMBRIDGE COMPANIES, INC. AS RECORDED IN VOLUME 99, PAGE 1022 AND VOLUME 101, PAGE 795, OF THE DEED RECORDS OF ROCKWALL COUNTY, TEXAS AND BEING MORE PARTICULARLY DESCRIBED BY METES AND BOUNDS AS FOLLOWS:

BEGINNING AT A 1/2" IRON ROD SET IN THE SOUTH RIGHT-OF-WAY LINE OF INTERSTATE HIGHWAY No. 30 AND THE NORTH BOUNDARY LINE OF SAID 12.4 ACRE CAMBRIDGE COMPANIES, INC. TRACT, LYING N 01°18'42"W, 632.33 FEET FROM A 3/8" IRON ROD FOUND FOR THE SOUTHEAST CORNER OF SAID 12.4 ACRE CAMBRIDGE COMPANIES TRACT, THE SOUTHWEST CORNER OF LAFON SUBDIVISION AS RECORDED IN CABINET "B", SLIDE 42 OF THE PLAT RECORDS OF ROCKWALL COUNTY, TEXAS AND IN THE NORTH BOUNDARY LINE OF SAID 123.4 ACRE CAMBRIDGE COMPANIES, INC. TRACT;

THENCE S 69°25'07"W, 179.10 FEET TO A 1/2" IRON ROD SET;

THENCE S 39°58'55"W, 68.65 FEET TO A 1/2" IRON ROD SET;

THENCE S 00°20'18"E, 150.00 FEET TO A 1/2" IRON ROD SET;

THENCE S 07°37'52"W, 126.22 FEET TO A 1/2" IRON ROD SET;

THENCE S 00°20'18"E, 226.80 FEET TO A 1/2" IRON ROD SET AT THE BEGINNING OF A CURVE TO THE LEFT;

THENCE SOUTHEASTERLY, 670.59 FEET ALONG SAID CURVE TO THE LEFT, HAVING A RADIUS OF 1,890.00 FEET, A CENTRAL ANGLE OF 20°19'45" AND A CHORD BEARING S 10°30'11"E, 667.08 FEET TO A 1/2" IRON ROD SET;

THENCE S 20°40'03"E, 878.58 FEET TO A 1/2" IRON ROD SET AT THE BEGINNING OF A CURVE TO THE RIGHT;

THENCE SOUTHEASTERLY, 875.55 FEET ALONG SAID CURVE TO THE RIGHT, HAVING A RADIUS OF 2,560.00 FEET, A CENTRAL ANGLE OF 19°35'45" AND A CHORD BEARING S 10°52'11"E, 871.29 FEET TO A 1/2" IRON ROD SET;

THENCE S 01°04'18"E, 294.36 FEET TO A 1/2" IRON ROD SET;

THENCE S 45°57'32"E, 70.85 FEET TO A 1/2" IRON ROD SET IN THE NORTH RIGHT-OF-WAY LINE OF STATE HIGHWAY No 276 (A 120 FOOT RIGHT-OF-WAY)

THENCE S 89°09'13"W ALONG THE NORTH RIGHT-OF-WAY LINE OF SAID STATE HIGHWAY No 276, 220.00 FEET TO A 1/2" IRON ROD SET;

THENCE N 44°02'28"E, 70.57 FEET TO A 1/2" IRON ROD SET;

THENCE N 01°04'18"W, 293.89 FEET TO A 1/2" IRON ROD SET AT THE BEGINNING OF A CURVE TO THE LEFT;

THENCE NORTHWESTERLY, 834.51 FEET ALONG SAID CURVE TO THE LEFT, HAVING A RADIUS OF 2,440.00 FEET, A CENTRAL ANGLE OF 19°35'45" AND A CHORD BEARING N 10°52'11"W, 830.45 FEET TO A 1/2" IRON ROD SET;

THENCE N 20°40'03"W, 878.58 FEET TO A 1/2" IRON ROD SET AT THE BEGINNING OF A CURVE TO THE RIGHT;

THENCE NORTHWESTERLY, 713.17 FEET ALONG SAID CURVE TO THE RIGHT, HAVING A RADIUS OF 2,010.00 FEET, A CENTRAL ANGLE OF 20°19'45" AND A CHORD BEARING N 10°30'11"W, 709.43 FEET TO A 1/2" IRON ROD SET;

THENCE N 00°20'18"W, 229.35 FEET TO A 1/2" IRON ROD SET;

THENCE N 03°29'11"W, 100.15 FEET TO A 1/2" IRON ROD SET;

THENCE N 00°20'18"W, 90.00 FEET TO A 1/2" IRON ROD SET;

THENCE N 52°52'25"W, 74.34 FEET TO A 1/2" IRON ROD SET;

THENCE S 72°49'16"W, 99.11 FEET TO A 1/2" IRON ROD SET IN THE SOUTH RIGHT-OF-WAY LINE OF INTERSTATE HIGHWAY No. 30 (A VARIABLE WIDTH RIGHT-OF-WAY);

THENCE ALONG THE SOUTH RIGHT-OF-WAY LINE OF SAID INTERSTATE HIGHWAY No. 30 AS FOLLOWS:

N 65°41'46"E, 201.30 FEET TO A DAMAGED CONCRETE TXDOT MONUMENT;

N 72°49'16"E, 339.95 FEET TO THE PLACE OF BEGINNING, CONTAINING 9.408 ACRES (409,808 SQUARE FEET) OF LAND.

NOW, THEREFORE, KNOW ALL MEN BY THESE PRESENTS:

STATE OF TEXAS
COUNTY OF ROCKWALL
I THE UNDERSIGNED OWNER OF THE LAND SHOWN ON THIS PLAT, AND DESIGNATED HEREIN AS THE STATE HIGHWAY NO. 205 BYPASS RIGHT-OF-WAY TO THE CITY OF ROCKWALL, TEXAS, AND WHOSE NAME IS SUBSCRIBED HERETO, HEREBY DEDICATE TO THE USE OF THE PUBLIC FOREVER ALL STREETS, ALLEYS, PARKS, WATER COURSES, DRAINS, EASEMENTS AND PUBLIC PLACES THEREON SHOWN ON THE PURPOSE AND CONSIDERATION THEREIN EXPRESSED. I FURTHER CERTIFY THAT ALL OTHER PARTIES WHO HAVE A MORTGAGE OR LIEN INTEREST IN THE STATE HIGHWAY NO. 205 BYPASS RIGHT-OF-WAY HAVE BEEN NOTIFIED AND SIGNED THIS PLAT.

I UNDERSTAND AND DO HEREBY RESERVE THE EASEMENT STRIPS SHOWN ON THIS PLAT FOR THE PURPOSES STATED AND FOR THE MUTUAL USE AND ACCOMMODATION OF ALL UTILITIES DESIRING TO USE OR USING SAME. I ALSO UNDERSTAND THE FOLLOWING;

1. NO BUILDINGS SHALL BE CONSTRUCTED OR PLACED UPON, OVER, OR ACROSS THE UTILITY EASEMENTS AS DESCRIBED HEREIN.

2. ANY PUBLIC UTILITY SHALL HAVE THE RIGHT TO REMOVE AND KEEP REMOVED ALL OR PART OF ANY BUILDINGS, FENCES, TREES, SHRUBS, OR OTHER GROWTHS OR IMPROVEMENTS WHICH IN ANY WAY ENDANGER OR INTERFERE WITH CONSTRUCTION, MAINTENANCE OR EFFICIENCY OF THEIR RESPECTIVE SYSTEM ON ANY OF THESE EASEMENT STRIPS, AND ANY PUBLIC UTILITY SHALL AT ALL TIMES HAVE THE RIGHT OF INGRESS OR EGRESS TO, FROM AND UPON THE SAID EASEMENT STRIPS FOR PURPOSE OF CONSTRUCTION, RECONSTRUCTION, INSPECTING, PATROLLING, MAINTAINING, AND EITHER ADDING TO OR REMOVING ALL OR PART OF THEIR RESPECTIVE SYSTEM WITHOUT THE NECESSITY OF, AT ANY TIME, PROCURING THE PERMISSION OF ANYONE.

3. THE CITY OF ROCKWALL WILL NOT BE RESPONSIBLE FOR ANY CLAIMS OF ANY NATURE RESULTING FROM OR OCCASIONED BY THE ESTABLISHMENT OF GRADE OF STREETS IN THE SUBDIVISION.

4. THE DEVELOPER AND ENGINEER SHALL BEAR TOTAL RESPONSIBILITY FOR STORM DRAIN IMPROVEMENTS.

5. THE DEVELOPER SHALL BE RESPONSIBLE FOR THE NECESSARY FACILITIES TO PROVIDE DRAINAGE PATTERNS AND DRAINAGE CONTROLS SUCH THAT PROPERTIES WITHIN THE DRAINAGE AREA ARE NOT ADVERSELY AFFECTED BY STORM DRAINAGE FROM THE DEVELOPMENT.

6. NO HOUSE DWELLING UNIT, OR OTHER STRUCTURE SHALL BE CONSTRUCTED ON ANY LOT IN THIS ADDITION BY THE OWNER OR ANY OTHER PERSON UNTIL THE DEVELOPER AND/OR OWNER HAS COMPLIED WITH ALL REQUIREMENTS OF THE SUBDIVISION REGULATIONS OF THE CITY OF ROCKWALL REGARDING IMPROVEMENTS WITH RESPECT TO THE ENTIRE BLOCK ON THE STREET OR STREETS ON WHICH PROPERTY ABUTS, INCLUDING THE ACTUAL INSTALLATION OF STREETS WITH THE REQUIRED BASE AND PAVING, CURB AND GUTTER, WATER AND SEWER, DRAINAGE STRUCTURES, STORM STRUCTURES, STORM SEWERS, AND ALLEYS, ALL ACCORDING TO THE SPECIFICATIONS OF THE CITY OF ROCKWALL, OR

UNTIL AN ESCROW DEPOSIT, SUFFICIENT TO PAY FOR THE COST OF SUCH IMPROVEMENTS, AS DETERMINED BY THE CITY'S ENGINEER AND/OR CITY ADMINISTRATOR, COMPUTED ON A PRIVATE COMMERCIAL RATE BASIS, HAS BEEN MADE WITH THE CITY SECRETARY, ACCOMPANIED BY AN AGREEMENT SIGNED BY THE DEVELOPER AND/OR OWNER, AUTHORIZING THE CITY TO MAKE SUCH IMPROVEMENTS AT PREVAILING PRIVATE COMMERCIAL RATES, OR HAVE THE SAME MADE BY A CONTRACTOR AND PAY FOR THE SAME OUT OF THE ESCROW DEPOSIT, SHOULD THE DEVELOPER AND/OR OWNER FAIL OR REFUSE TO INSTALL THE REQUIRED IMPROVEMENTS WITHIN THE TIME STATED IN SUCH WRITTEN AGREEMENT, BUT IN NO CASE SHALL THE CITY BE OBLIGATED TO MAKE SUCH IMPROVEMENTS ITSELF. SUCH DEPOSIT MAY BE USED BY THE OWNER AND/OR DEVELOPER AS PROGRESS PAYMENTS AS THE WORK PROGRESSES IN MAKING SUCH IMPROVEMENTS BY MAKING CERTIFIED REQUISITIONS TO THE CITY SECRETARY, SUPPORTED BY EVIDENCE OF WORK DONE, OR

UNTIL THE DEVELOPER AND/OR OWNER FILES A CORPORATE SURETY BOND WITH THE CITY SECRETARY IN A SUM EQUAL TO THE COST OF SUCH IMPROVEMENTS FOR THE DESIGNATED AREA, GUARANTEEING THE INSTALLATION THEREOF WITHIN THE TIME STATED IN THE BOND, WHICH TIME SHALL BE FIXED BY THE CITY COUNCIL OF THE CITY OF ROCKWALL.

I FURTHER ACKNOWLEDGE THAT THE DEDICATIONS AND/OR EXACTION'S MADE HEREIN ARE PROPORTIONAL TO THE IMPACT OF THE SUBDIVISION UPON THE PUBLIC SERVICES REQUIRED IN ORDER THAT THE DEVELOPMENT WILL COMPORT WITH THE PRESENT AND FUTURE GROWTH NEEDS OF THE CITY, I, MY SUCCESSORS AND ASSIGNS HEREBY WAIVE ANY CLAIM, DAMAGE, OR CAUSE OF ACTION THAT I (WE) MAY HAVE AS A RESULT OF THE DEDICATION OF EXACTIONS MADE HEREIN.

OWNER

STATE OF TEXAS
COUNTY OF ROCKWALL

BEFORE ME, THE UNDERSIGNED AUTHORITY, ON THIS DAY PERSONALLY APPEARED _____, KNOWN TO ME TO BE THE PERSON WHOSE NAME IS SUBSCRIBED TO THE FOREGOING INSTRUMENT, AND ACKNOWLEDGED TO ME THAT HE EXECUTED THE SAME FOR THE PURPOSE AND CONSIDERATION THEREIN STATED.

GIVEN UPON MY HAND AND SEAL OF OFFICE THIS ____DAY OF _____, 2005.

NOTARY PUBLIC IN AND FOR THE STATE OF TEXAS MY COMMISSION EXPIRES: _____

OWNER:
THE CAMBRIDGE COMPANIES, INC.
8235 DOUGLAS AVE., SUITE 650
DALLAS, TEXAS 75225
(214) 691-2556

SIGNATURE OF PARTY WITH MORTGAGE OR LIEN INTEREST

STATE OF TEXAS
COUNTY OF ROCKWALL

BEFORE ME, THE UNDERSIGNED AUTHORITY, ON THIS DAY PERSONALLY APPEARED _____, KNOWN TO ME TO BE THE PERSON WHOSE NAME IS SUBSCRIBED TO THE FOREGOING INSTRUMENT, AND ACKNOWLEDGED TO ME THAT HE EXECUTED THE SAME FOR THE PURPOSE AND CONSIDERATION THEREIN STATED.

GIVEN UPON MY HAND AND SEAL OF OFFICE THIS ____DAY OF _____, 2005.

NOTARY PUBLIC IN AND FOR THE STATE OF TEXAS MY COMMISSION EXPIRES: _____

NOTARY PUBLIC IN AND FOR THE STATE OF TEXAS MY COMMISSION EXPIRES: _____


NOTE: IT SHALL BE THE POLICY OF THE CITY OF ROCKWALL TO WITHHOLD ISSUING BUILDING PERMITS UNTIL ALL STREETS, WATER, SEWER AND STORM DRAINAGE SYSTEMS HAVE BEEN ACCEPTED BY THE CITY. THE APPROVAL OF A PLAT BY THE CITY DOES NOT CONSTITUTE ANY REPRESENTATION, ASSURANCE OR GUARANTEE THAT ANY BUILDING WITHIN SUCH PLAT SHALL BE APPROVED, AUTHORIZED OR PERMIT THEREFORE ISSUED. NOR SHALL SUCH APPROVAL CONSTITUTE ANY REPRESENTATION, ASSURANCE OR GUARANTEE BY THE CITY OF THE ADEQUACY AND AVAILABILITY FOR WATER FOR PERSONAL USE AND FIRE PROTECTION WITHIN SUCH PLAT, AS REQUIRED UNDER ORDINANCE 83-54.

SURVEYOR'S CERTIFICATE

NOW, THEREFORE KNOW ALL MEN BY THESE PRESENTS:

THAT I, GREGG A. E. MADSEN, DO HEREBY CERTIFY THAT I PREPARED THIS PLAT FROM AN ACTUAL AND ACCURATE SURVEY OF THE LAND, AND THAT THE CORNER MONUMENTS SHOWN THEREON WERE PROPERLY PLACED UNDER MY PERSONAL SUPERVISION.

REGISTERED PUBLIC SURVEYOR NO. 5978

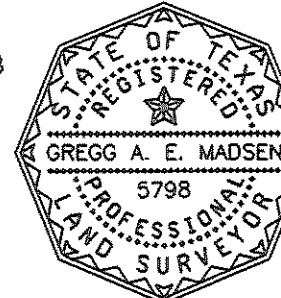

RECOMMENDED FOR FINAL APPROVAL

PLANNING AND ZONING COMMISSION DATE

APPROVED

I HEREBY CERTIFY THAT THE ABOVE AND FOREGOING PLAT OF AN ADDITION TO THE CITY OF ROCKWALL, TEXAS, WAS APPROVED BY THE CITY COUNCIL OF THE CITY OF ROCKWALL ON THE ____ DAY OF _____

WITNESS OUR HANDS, THIS ____DAY OF _____, 2005.

MAYOR, CITY OF ROCKWALL CITY SECRETARY CITY ENGINEER

APPROVED

I HEREBY CERTIFY THAT THE ABOVE AND FOREGOING PLAT OF AN ADDITION TO THE CITY OF ROCKWALL, TEXAS, WAS APPROVED BY THE CITY PLANNING DIRECTOR OF THE CITY OF ROCKWALL ON THE ____DAY OF _____, 2005.

THIS APPROVAL SHALL BE INVALID UNLESS THE APPROVED PLAT FOR SUCH ADDITION IS RECORDED IN THE OFFICE OF THE COUNTY CLERK OF ROCKWALL, COUNTY, TEXAS, WITHIN ONE HUNDRED EIGHTY (180) DAYS FROM SAID DATE OF FINAL APPROVAL.

SAID ADDITION SHALL BE SUBJECT TO ALL THE REQUIREMENTS OF THE SUBDIVISION REGULATIONS OF THE CITY OF ROCKWALL.

DIRECTOR OF PLANNING CITY ENGINEER

RIGHT-OF-WAY DEDICATION PLAT FOR:
S.H. No. 205 BYPASS

AN ADDITION TO THE CITY OF ROCKWALL, ROCKWALL COUNTY, TEXAS, BEING 9.408 ACRES OF LAND LOCATED IN THE J.M. ALLEN SURVEY, ABSTRACT No. 2 AND THE J. LOCKHART SURVEY, ABSTRACT No. 134, CITY OF ROCKWALL, ROCKWALL COUNTY, TEXAS

PREPARED BY:
WIA WIER & ASSOCIATES, INC.
ENGINEERS SURVEYORS LAND PLANNERS
4300 BELTWAY PLACE SUITE 130 ARLINGTON, TEXAS 76018 METRO (817)467-7700
1380 U.S. HIGHWAY 287 N, SUITE 101 MANSFIELD, TEXAS 76063 METRO (817)477-8700
6849 ELM STREET FRISCO, TEXAS 75034 METRO (214)367-8000
www.WierAssociates.com

SHEET 3 OF 3

W. A. No. 04141

FILE: 04141-Plat13.dwg

DATE: 03-07-2005

RECORD PLANS
MARCH 28, 2008

EXISTING FEATURES TOPOGRAPHIC LEGEND

OPP	POWER POLE
GUY (POWER POLE DOWN GUY WIRE
— OE —	OVERHEAD ELECTRIC LINE
○ GL	GROUND LIGHT
○ SCV	GROUND LIGHT
---- UE ----	UNDERGROUND ELECTRIC LINE
---- UT ----	UNDERGROUND TELEPHONE LINE
---- G ----	UNDERGROUND GAS LINE
== 24" RCP ==	EXISTING STORM DRAIN LINE
□ MH SD	STORM DRAIN MANHOLE
⊙ SSMH	SANITARY SEWER MANHOLE
--- 8" SS ---	SANITARY SEWER LINE
⊙ FH	FIRE HYDRANT
--- 8" W ---	WATER LINE
SIGN □	STREET SIGN
====	CONCRETE PAVEMENT
..... 640	EXISTING CONTOUR LINE
TRANSFORMER	TRANSFORMER
⊙	EXISTING TREE
~~~~	EXISTING TREE LINE
T	WATER VALVE
GUARD RAIL	GUARD RAIL
BARBED WIRE FENCE	BARBED WIRE FENCE
FO	UNDERGROUND FIBER OPTIC
⊙ ELEC. MH	ELECTRIC MANHOLE
□ DI	DROP INLET
□ EB	ELECTRIC BOX
□ EM	ELECTRIC METER

**GENERAL NOTES**

1. ALL MATERIALS AND CONSTRUCTION SHALL CONFORM TO THE CITY OF ROCKWALL 'S STANDARDS OF DESIGN AND CONSTRUCTION, ' DATED AUGUST, 2003 AND THE APPLICABLE SECTIONS OF THE STANDARD SPECIFICATIONS FOR PUBLIC WORKS CONSTRUCTION, NORTH CENTRAL TEXAS, THIRD EDITION, 1998, SECTION I AND II, EXCEPT AS AMENDED BY THE CITY OF ROCKWALL 'S SUPPLEMENTAL SPECIAL PROVISIONS, THESE PROJECT PLANS AND THE PROJECT CONTRACT DOCUMENTS.
2. EXISTING UTILITIES AND UNDERGROUND FACILITIES INDICATED ON THESE PLANS HAVE BEEN LOCATED FROM REFERENCE INFORMATION SUPPLIED BY VARIOUS OWNERS OF THE FACILITIES. THE ENGINEER DOES NOT ACCEPT RESPONSIBILITY FOR THE UTILITY LOCATIONS SHOWN. IT SHALL BE THE RESPONSIBILITY OF THE CONTRACTOR TO VERIFY BOTH HORIZONTALLY AND VERTICALLY THE LOCATION OF ALL EXISTING UTILITIES AND UNDERGROUND FACILITIES PRIOR TO CONSTRUCTION, TO TAKE NECESSARY PRECAUTIONS IN ORDER TO PROTECT ALL FACILITIES ENCOUNTERED, AND TO NOTIFY THE ENGINEER PROMPTLY OF ALL CONFLICTS OF THE WORK WITH EXISTING FACILITIES. THE CONTRACTOR SHALL PRESERVE AND PROTECT ALL EXISTING UTILITIES FROM DAMAGE DURING CONSTRUCTION. ANY DAMAGES BY THE CONTRACTOR TO EXISTING UTILITIES SHALL BE REPAIRED BY THE CONTRACTOR AT HIS EXPENSE.
3. ALL DIMENSIONS ARE TO THE BACK OF CURB UNLESS INDICATED OTHERWISE.
4. CONTRACTOR SHALL SAW-CUT TO PROVIDE SMOOTH TRANSITION AT TIE-IN TO EXISTING EDGE OF PAVEMENT. PROVIDE DOWELED 'BUTT' JOINT CONNECTIONS.
5. CONTRACTOR SHALL SAW-CUT TIE-INS AT EXISTING CURBS AS NECESSARY TO INSURE SMOOTH TRANSITIONS. CONTRACTOR SHALL SAW-CUT AND TRANSITION TO MEET EXISTING PAVEMENT AS NECESSARY TO INSURE POSITIVE DAMAGE. (TYPICAL ALL INTERSECTIONS)
6. ALL PARKWAYS ADJACENT TO PERMANENT CONCRETE PAVEMENT SHALL BE SODDED WITH BERMUDA GRASS SOD. BERMUDA GRASS SOD SHALL BE INSTALLED TO 5'-6" BACK OF TEMPORARY ASPHALT CURBS AND BACK OF CURB IN FUTURE MEDIANS.
7. ALL CUT AND FILL SLOPES SHALL BE HYDROMULCH SEED.
8. ALL SIGNS, BARRICADES, PAVEMENT MARKINGS, AND OTHER TRAFFIC CONTROL DEVICES SHALL CONFORM TO THE LATEST EDITION OF THE MANUAL ON UNIFORM TRAFFIC CONTROL DEVICES.
9. CONTRACTOR SHALL FURNISH AND INSTALL ALL PAVEMENT MARKINGS AS SHOWN ON THE PLANS. STOP BARS AND CROSSWALKS SHALL BE INSTALLED AT ALL STREET INTERSECTIONS.
10. 2" PVC SCHEDULE 40 DOVE GREY ELECTRICAL STREET LIGHT CONDUIT SHALL BE PLACED IN ALL MEDIANS 2' OFF CENTERLINE EXCEPT AS SHOWN OTHERWISE ON PLANS. CONDUIT SHALL HAVE A MINIMUM (AND TYPICAL) 3'-0" BURIAL DEPTH BELOW FINISHED GRADE.
11. RED MARKER TAPE IS TO BE INSTALLED ON THE ENDS OF THE CONDUIT WITH 3" CAP.
12. A No. 9 GALVANIZED PULLWIRE SHALL BE PLACED IN ALL CONDUIT. THIS WIRE SHALL EXTEND A MINIMUM 1'-0" FROM THE END OF THE CONDUIT.
13. 3" PVC SCHEDULE 40 DOVE GREY ELECTRICAL TRAFFIC SIGNAL CONDUIT SHALL BE INSTALLED CONTINUOUS ACROSS ALL INTERSECTIONS AS SHOWN ON THE PLANS, EXTENDING TO 2'-0" BEHIND CURBS. SWEEP BENDS TO BE USED AT ALL PULL BOXES.
14. TRAFFIC SIGNAL PULL BOXES SHALL BE #36 FROM TRAFFIC SIGNAL EQUIPMENT COMPANY, FORTH WORTH, TEXAS OR APPROVED EQUAL. BOXES ARE APPROXIMATELY 10 1/2" x 17" x 12" AND SHALL BE PROVIDED WITH A CONCRETE COVER. BOXES TO BE INSTALLED 1/4" PER FOOT ABOVE TOP OF CURB.
15. ALL EROSION CONTROL FACILITIES SHALL BE INSTALLED PRIOR TO THE BEGINNING OF ANY CLEARING OR GRADING.
16. EXISTING ASPHALT PAVEMENT REMOVAL SHALL BE A SUBSIDIARY ITEM TO UNCLASSIFIED EXCAVATION. REFER TO THE PROJECT SPECIFICATIONS.


**PROPOSED FEATURES LEGEND**

	PROPOSED STORM DRAIN INLET
	PROPOSED CURB LINE
	PROPOSED STORM DRAIN
	PROPOSED FIRE HYDRANT
	PROPOSED WATER MAIN 12" OR SMALLER
	PROPOSED GATE VALVE
	REDUCER
	PROPOSED CONTOUR LINE


**PAVEMENT LEGEND**

	11' 4,200 PSI CONCRETE PAVEMENT
	6' TYPE 'D' HMAc
	2' TYPE 'D' ASPHALT OVERLAY & 4' TYPE 'D' HMAc
	2' TYPE 'D' ASPHALT OVERLAY

PREPARED BY:  
**WIA WIER & ASSOCIATES, INC.**  
 ENGINEERS SURVEYORS LAND PLANNERS  
 4300 BELTWAY PLACE, SUITE 130 ARLINGTON, TEXAS 76018 METRO (817)461-7700  
 1380 U.S. HIGHWAY 287 N. SUITE 101 MANSFIELD, TEXAS 76063 METRO (817)477-8700  
 6848 ELM STREET FRESNO, TEXAS 75034 METRO (214)387-8800  
 www.wierassociates.com

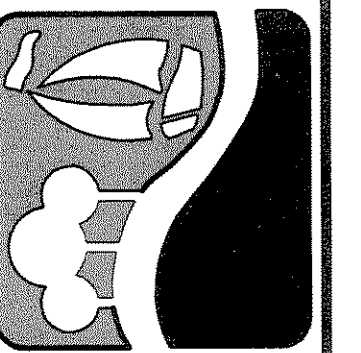

PHASE I S.H. 205 BYPASS  
 FROM S.H. 276 TO INTERSTATE 30  
**GENERAL NOTES &  
 TOPOGRAPHIC LEGEND**

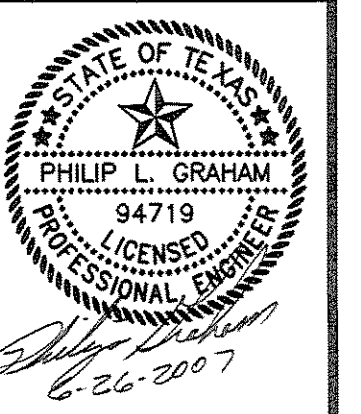

RECORD PLANS  
 MARCH 28, 2008

COPYRIGHT ©  
 WIER & ASSOCIATES, INC.  
 LAST SHEET EDIT  
 DATE 06-26-2007  
 WA# 04141

SHEET NO.  
 S001

## PAVING, STRIPING, TRAFFIC & EROSION CONTROL SHEET QUANTITIES


ITEM No.	DESCRIPTION	SHEET UNITS	TOTAL QUANTITY	P101	P102	P103	P104	P105	P106	P107	P108	P109	P110	M101	M102	E102	E103
101	Unclassified Excavation	CY	15,685	935	1,423	2,736	1,077	667	5,746	2,684	110	49	258				
102	Controlled Density Roadway Embankment	CY	11,421	90	1,375	215	2,715	5,438	107	206	472	640	163				
103	Right-of-way Preparation	STA	44.6	1.7	5.0	5.0	5.0	5.0	5.0	5.0	1.4	5.5	6.0				
104	Remove Existing 12" RCP	LF	42										42				
105	8" Lime Stabilized Subgrade (42 lbs/SY)	SY	14,708	2,379	2,337	1,567	1,594	1,603	1,637	1,628	617	373	973				
106	Hydrated Lime	TON	309.0	50.0	49.1	32.9	33.5	33.7	34.4	34.2	13.0	7.8	20.4				
107	10" 5,000 p.s.i. reinforced Concrete Street Pavement	SY	10,966	2,147	1,913	1,348	1,371	1,380	1,410	1,397							
108	2" Type "D" Asphalt Concrete Pavement Overlay	SY	7,045									3,066	3,979				
109	4" Type "D" Asphalt Concrete Pavement	SY	1,458									393	1,065				
110	6" Type "D" Asphalt Concrete Pavement	SY	846	69	194						583						
111	6" Rolled Asphalt Curb	LF	352	102	74						176						
112	Concrete Street Header	LF	76		49					27							
113	TXDOT Type III Barricade	LF	141	94	47												
114	Bermuda Grass Sod	SY	6,746	551	1,054	973	978	982	1,000	1,025	183						
115	Hydromulch Seed Parkways & Slopes	SY	36,555	773	4,680	4,834	4,739	5,529	5,558	5,220	1,652	1,468	2,102				
116	Place 4" Topsoil on Parkways & Slopes	SY	43,301	1,324	5,734	5,807	5,717	6,511	6,558	6,245	1,835	1,468	2,102				
117	Metal Beam Guard Fence, MBGF Transition & Terminal	LF	75					75									
118	Adjust Existing Water Valve to Finished Grade	EA	1	1													
119	Adjust Existing Sanitary Sewer Manhole to Finished Grade	EA	1					1									
120	4" Type I-A Yellow Reflectorized Ceramic Pavement Markers	EA	221											149	72		
121	4" Type I-A White Reflectorized Ceramic Pavement Markers	EA	90											72	18		
122	4" Non-reflectorized Yellow Ceramic Pavement Markers	EA	434											292	142		
123	4" Non-reflectorized White Ceramic Pavement Markers	EA	42											42			
124	24" Type I Thermoplastic Stop Bar	EA	2											1	1		
125	Type I Thermoplastic Left Turn Arrow	EA	5											1	4		
126	Type I Thermoplastic Right Turn Arrow	EA	5												5		
127	Type I Thermoplastic Through/Right Turn Arrow	EA	2											2			
128	Type I Thermoplastic Through Arrow	EA	12												12		
129	Type I Thermoplastic "ONLY" Word	EA	6											1	5		
130	4" White Thermoplastic Edge Line	LF	2,465												2,465		
131	8" White Thermoplastic Solid Lane Line	LF	1,030												1,030		
132	Double 4" Yellow Thermoplastic Solid Line	LF	2,065												2,065		
133	24" Thermoplastic Cross Hatch Line	LS	1												1		
134	Stop Sign R1-1	EA	2											1	1		
135	Speed Limit Sign R2-1	EA	2											1	1		
136	Left Lane Must Turn Left Sign R3-5L	EA	1											1			
137	2" Grey Schedule 40 PVC Street Light Conduit	LF	3,200	136	504	502	503	503	502	500	50						
138	TxDOT Type C Pullbox	EA	2	1							1						
139	Prepare & Maintain SWP3 Plan	LS	1														
140	Curb Inlet Protection (All Phases)	EA	8													5	3
141	Drop Inlet Protection (All Phases)	EA	5													2	3
142	Reinforced Silt Fence	LF	3,425													2,265	1,160
143	Rock Check Dam	LF	550													400	150
144	12" High Rock Berm	LF	60													20	40
145	18" High Rock Berm	LF	25													25	
146	28" High Rock Berm	LF	45													45	
147	Stabilized Construction Entrance	EA	2														2
148	S.H. 276 Temporary Traffic Control	LS	1														
149	I.H. 30 Connection Temporary Traffic Control	LS	1														

## DRAINAGE SHEET QUANTITIES


ITEM No.	DESCRIPTION	SHEET UNITS	TOTAL QUANTITY	D104	D105	D106	D107	D108	D109	D110	D111	D112	D201	D202	D203
201	Unclassified Channel Excavation	CY	1,404								59				1,345
202	4" Topsoil & Hydromulch Seed Slopes	SY	605							210					395
203	18" R.C.P. Storm Drain Pipe Class IV	LF	370								250	120			
204	18" R.C.P. Storm Drain Pipe Class III	LF	1,116				192	327	223		93		155	126	
205	21" R.C.P. Storm Drain Pipe Class III	LF	95	6						89					
206	24" R.C.P. Storm Drain Pipe Class III	LF	378				30	175		114			59		
207	27" R.C.P. Storm Drain Pipe Class III	LF	268				80								
208	30" R.C.P. Storm Drain Pipe Class III	LF	113				84			29					
209	33" R.C.P. Storm Drain Pipe Class III	LF	342		114	228									
210	36" R.C.P. Storm Drain Pipe Class III	LF	78		78										
211	42" R.C.P. Storm Drain Pipe Class III	LF	257		257										
212	48" R.C.P. Storm Drain Pipe Class III	LF	53		53										
213	4-9x9' Multiple Box Culvert	LF	120	120											
214	10' Recessed Curb Inlet	EA	8		1	2	1	2	1	1					
215	15' Recessed Curb Inlet	EA	2		1					1					
216	4'x4' Drop Inlet	EA	3			1				2					
217	TxDOT Type H Horizontal Inlet	EA	2								1	1			
218	30" 4:1 CH-FW-0 Headwall	EA	1							1					
219	18" 6:1 SETP-PD Headwall	EA	1								1				
220	Box Culvert Headwall & Wingwalls	EA	2	2											
221	Combination Rail (including parapet wall & railing)	LF	246	246											
222	Min. 12" Dia. Grouted Rock Rubble Riprap	SY	880	880											
223	Min. 8" Dia. Grouted Rock Rubble Riprap	SY	82							52	30				
224	Trench Safety	LF	2,327	126	502	500	154	302	223	235			195	90	
225	Remove 4'x4' Drop Inlet	EA	2							2					
226	Remove 18" 6:1 SETP-PD Headwall	EA	1								1				

RECORD PLANS  
MARCH 28, 2008

PREPARED BY:  
**VIA WIER & ASSOCIATES, INC.**  
 ENGINEERS SURVEYORS LAND PLANNERS  
 4300 BELTWAY PLACE, SUITE 130 ARLINGTON, TEXAS 76018 METRO (817)467-7700  
 1380 U.S. HIGHWAY 287 N., SUITE 101 WANSFELD, TEXAS 76063 METRO (817)477-6700  
 6949 ELM STREET FRSICO, TEXAS 75034 METRO (214)387-8000  
 www.viawier.com

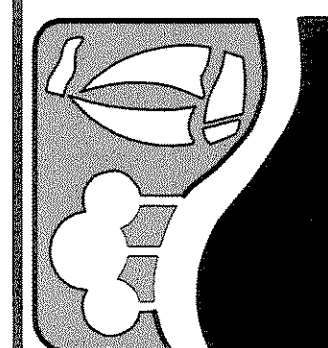


PHASE I S.H. 205 BYPASS  
 FROM S.H. 276 TO INTERSTATE 30  
 SHEET QUANTITIES

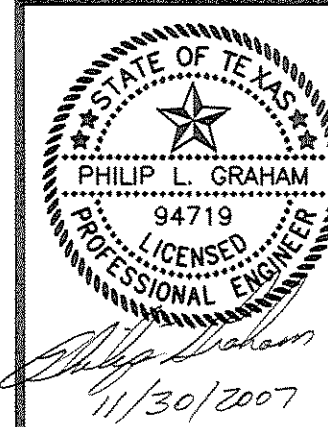

COPYRIGHT ©  
 WIER & ASSOCIATES, INC.  
 LAST SHEET EDIT  
 DATE: 11-30-2007  
 WA# 04141  
 SHEET NO.  
 S002


## WATER SHEET QUANTITIES

ITEM No.	DESCRIPTION	SHEET UNITS	TOTAL QUANTITY	U101	U102	U103	U104	U105	U106	U107
301	6" Water Main	LF	34	8	4	4	4	4	4	6
302	10" Water Main	LF	10	10						
303	12" Water Main	LF	3,294	490	500	500	500	500	500	304
304	6" Gate Valve	EA	8	2	1	1	1	1	1	1
305	12" Gate Valve	EA	8	1	1	1	3	1	1	
306	10"x10" Tapping Sleeve & Valve	EA	1	1						
307	16"x12" Tapping Sleeve & Valve	EA	1							1
308	6" Blow-off Valve	EA	2	1			1			
309	Cast Iron Fittings	TON	3.3	1.3	0.3	0.3	0.4	0.3	0.3	0.4
310	Trench Safety	LF	3,338	508	504	504	504	504	504	310
311	Relocate Existing 2" Air & Vacuum Release Valve & Manhole	LS	1							1
312	Blue EMS Locator Pads	EA	22	4	2	3	2	3	2	6
313										
314										

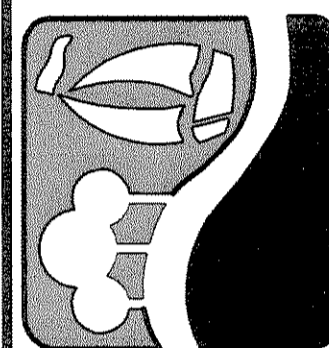

PREPARED BY:  
**WIER & ASSOCIATES, INC.**  
 ENGINEERS SURVEYORS LAND PLANNERS  
 4300 BELTWAY PLACE SUITE 130 ARLINGTON, TEXAS 76018 METRO (817)467-7700  
 1380 U.S. HIGHWAY 287 N. SUITE 101 WANSFELD, TEXAS 76063 METRO (817)477-8700  
 6848 ELM STREET PRISCO, TEXAS 75034 METRO (214)387-8800  
 www.wierassociates.com





PHASE I S.H. 205 BYPASS  
 FROM S.H. 276 TO INTERSTATE 30  
 SHEET QUANTITIES

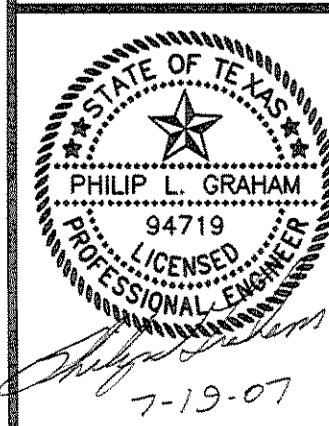

RECORD PLANS  
 MARCH 28, 2008

COPYRIGHT ©  
 WIER & ASSOCIATES, INC.  
 LAST SHEET EDIT  
 DATE 07-19-2007  
 WA# 04141

SHEET NO.  
 S003

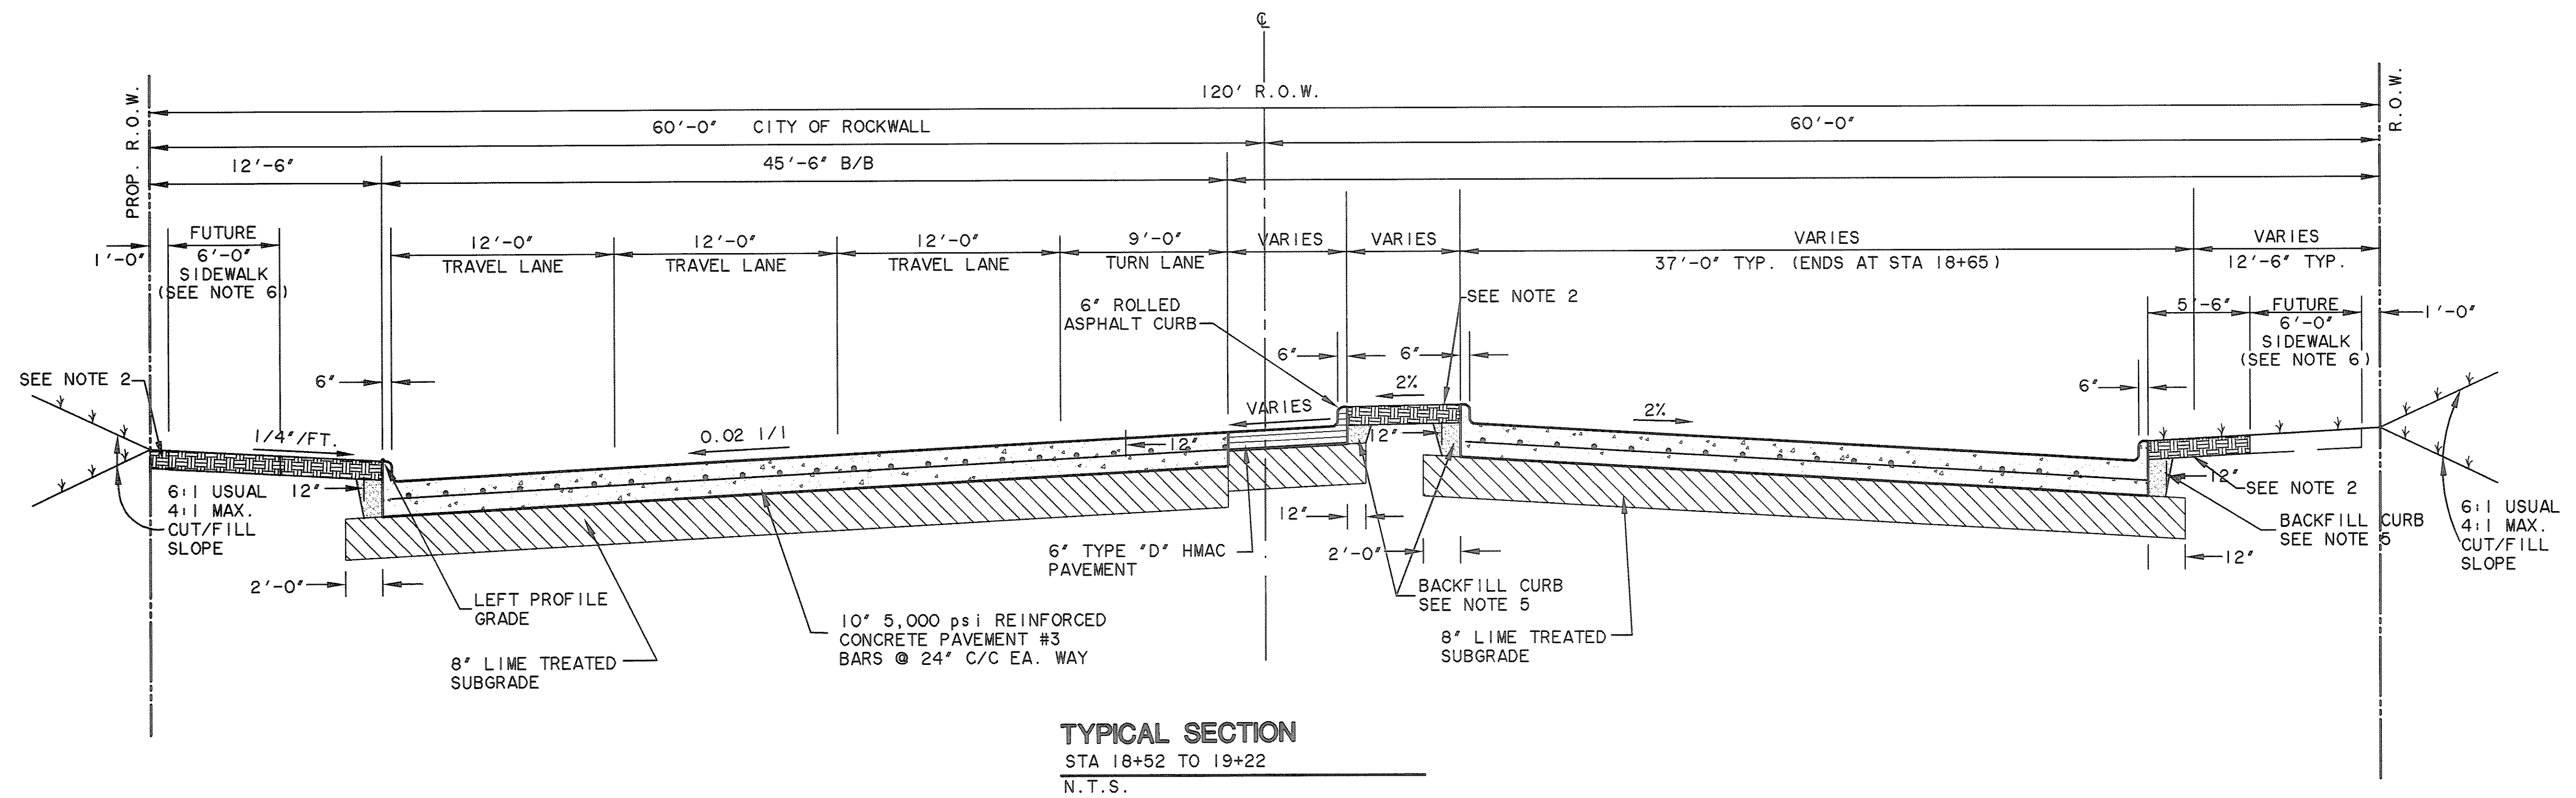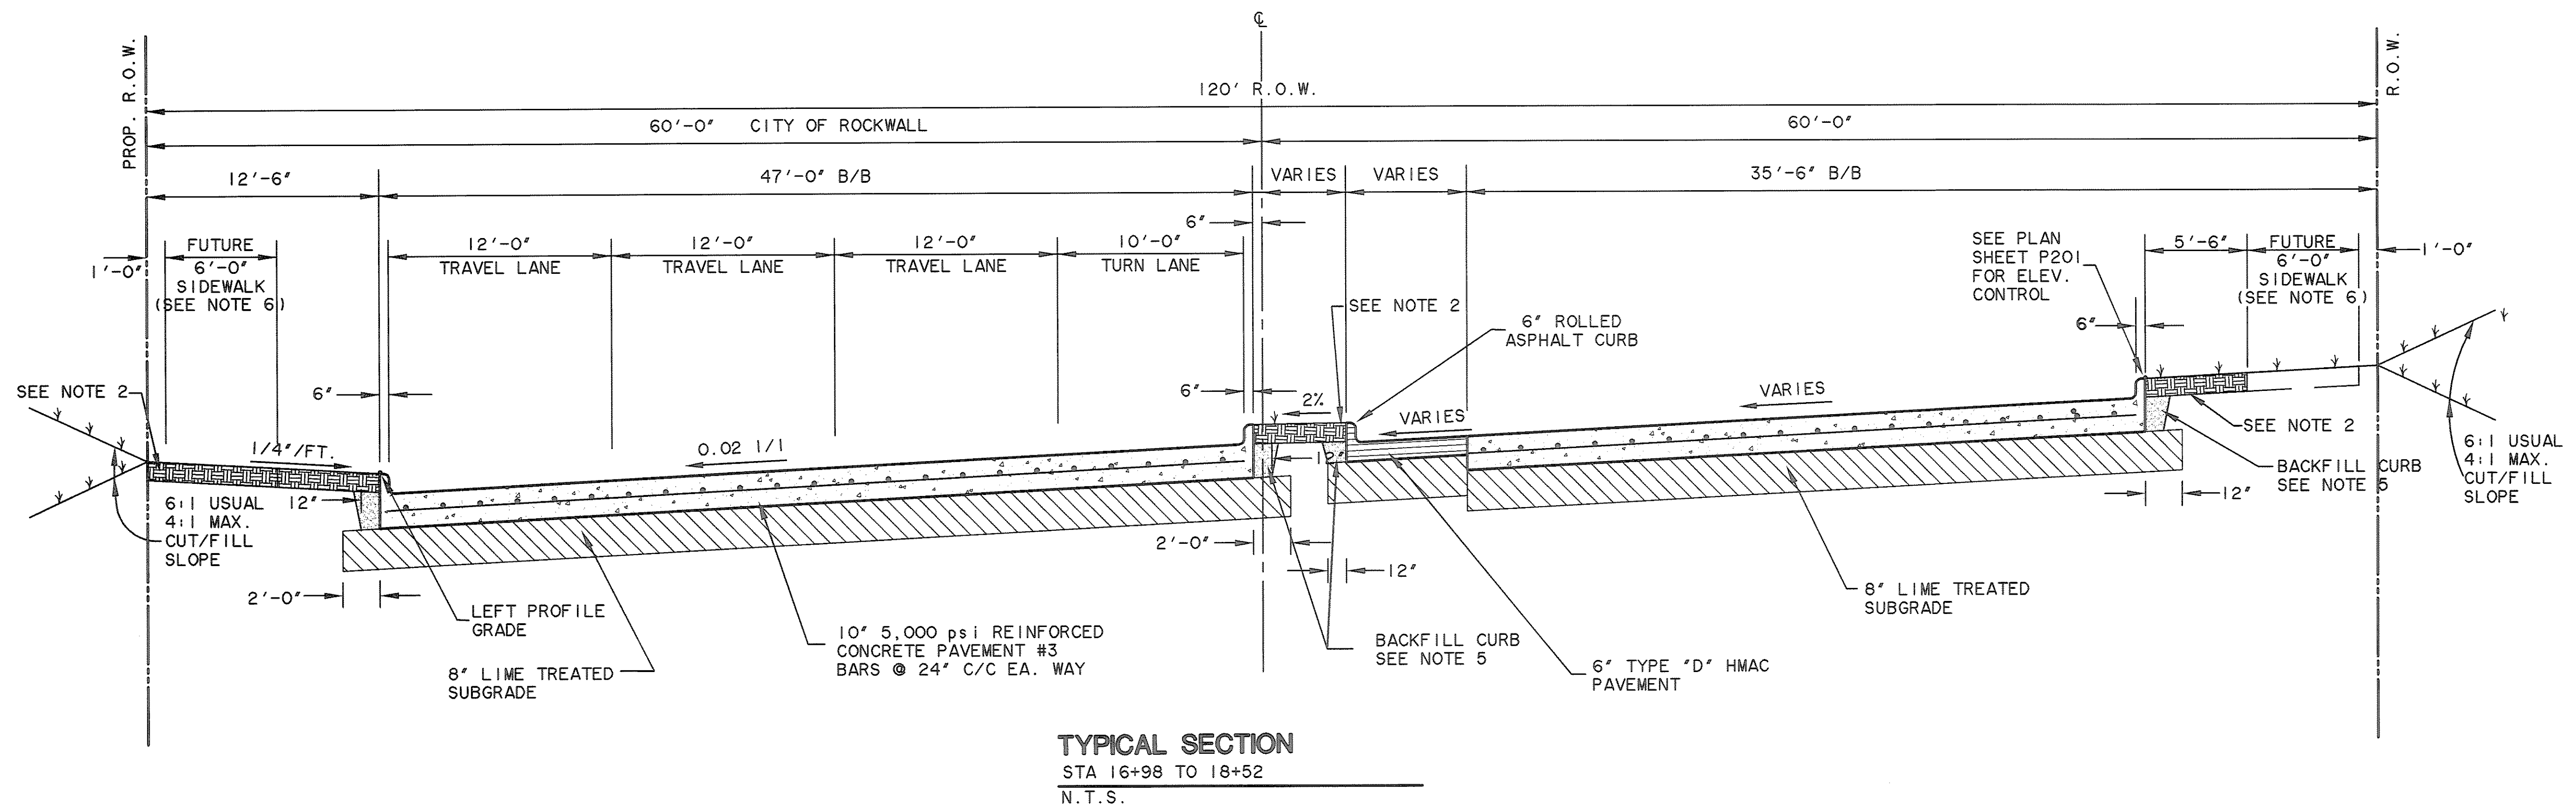
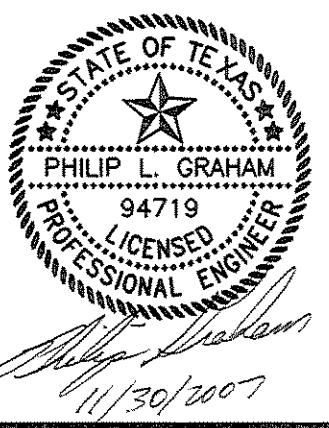
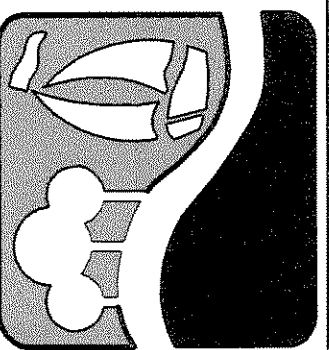


(A) SAWED LONGITUDINAL CONTRACTION JOINT

- NOTES:
- CONSTRUCT PAVEMENT IN ACCORDANCE WITH CITY STANDARD CONSTRUCTION DETAILS EXCEPT AS NOTED HEREON.
  - PLACE BERMUDA GRASS SOD IN PARKWAY AND TO LIMITS SHOWN IN FUTURE MEDIANS AS PER SPECIFICATIONS.
  - IMPORT AND PLACE MINIMUM 4" TOPSOIL ON CUT AND FILL SLOPES. HYDROMULCH SEED WITH BERMUDA GRASS AS PER SPECIFICATIONS.
  - COMPACT ALL FILLS TO MINIMUM 95% OF STANDARD PROCTOR DENSITY. FILL COMPACTION SHALL BE PERFORMED WITH A SHEEPSFOOT ROLLER.
  - BACKFILL ALL CURBS WITH ON-SITE BROWN CLAY SOILS COMPACTED TO A MINIMUM 95% OF STANDARD PROCTOR DENSITY. TYPICAL ALL ROADWAY AND STREET CURBS THIS PROJECT.
  - 6'-0" CONCRETE SIDEWALK SHALL BE CONSTRUCTED WITH DEVELOPMENT OF ADJACENT PROPERTY.

RECORD PLANS  
 MARCH 28, 2008



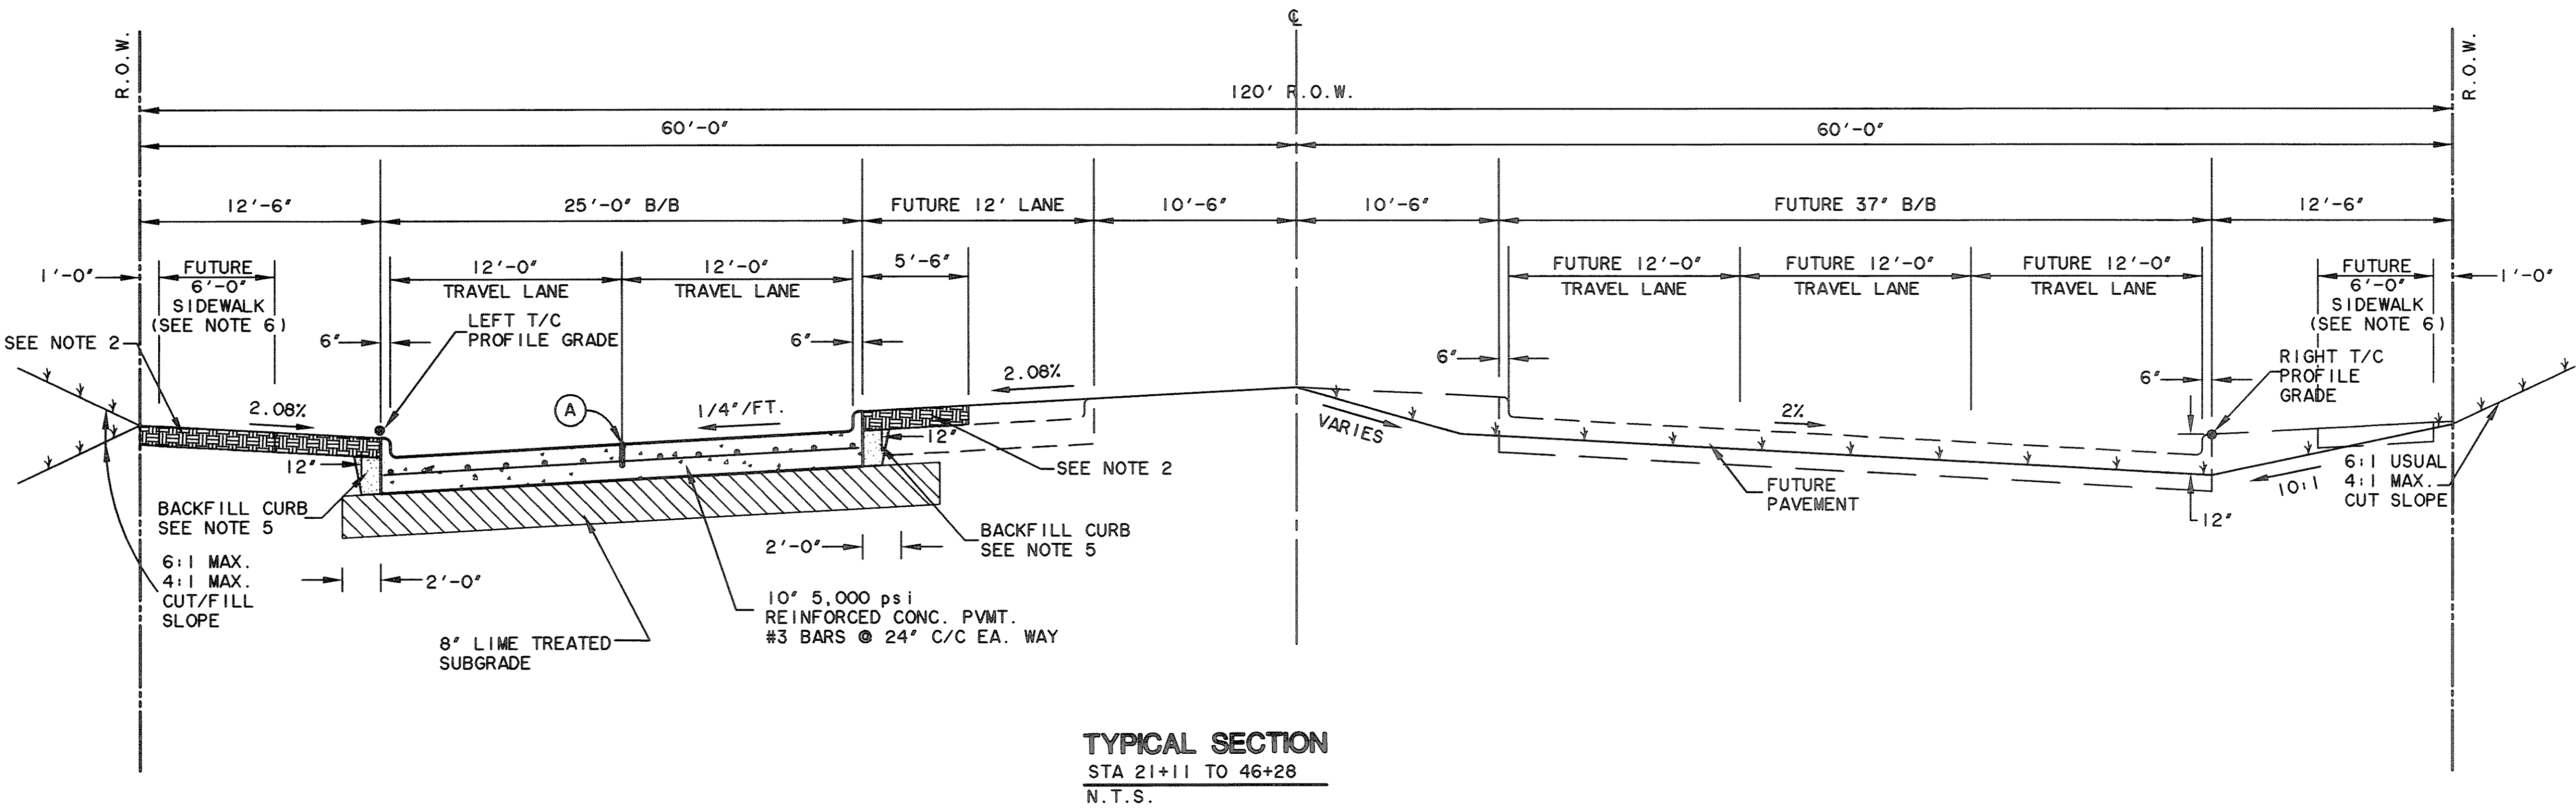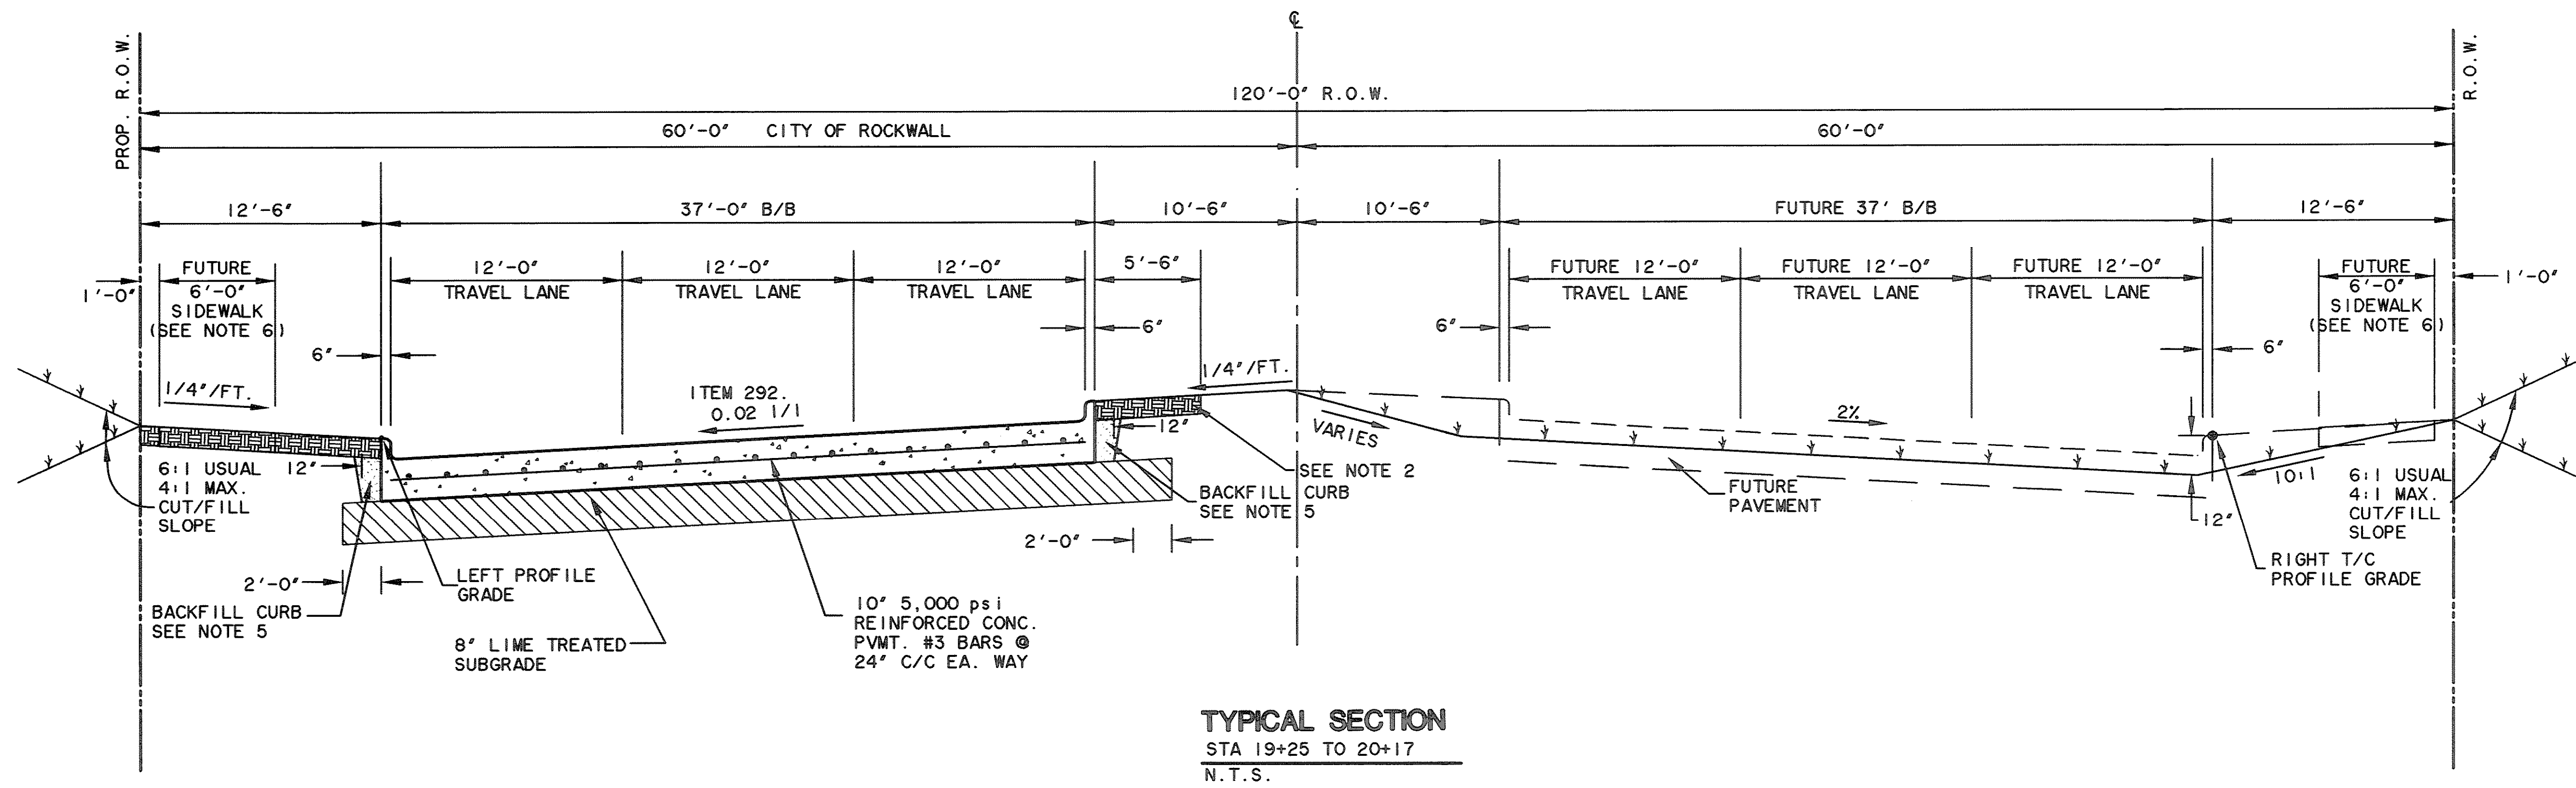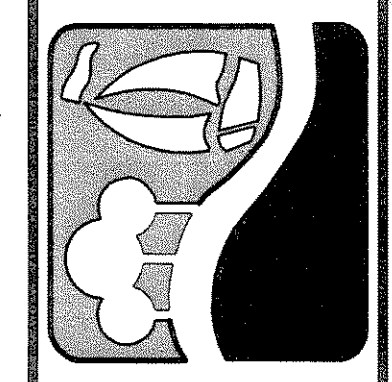


(A) SAWED LONGITUDINAL CONTRACTION JOINT

NOTES:

- CONSTRUCT PAVEMENT IN ACCORDANCE WITH CITY STANDARD CONSTRUCTION DETAILS EXCEPT AS NOTED HEREON.
- PLACE BERMUDA GRASS SOD IN PARKWAY AND TO LIMITS SHOWN IN FUTURE MEDIANS AS PER SPECIFICATIONS.
- IMPORT AND PLACE MINIMUM 4" TOPSOIL ON CUT AND FILL SLOPES. HYDROMULCH SEED WITH BERMUDA GRASS AS PER SPECIFICATIONS.
- COMPACT ALL FILLS TO MINIMUM 95% OF STANDARD PROCTOR DENSITY. FILL COMPACTION SHALL BE PERFORMED WITH A SHEEPSFOOT ROLLER.
- BACKFILL ALL CURBS WITH ON-SITE BROWN CLAY SOILS COMPACTED TO A MINIMUM 95% OF STANDARD PROCTOR DENSITY. TYPICAL ALL ROADWAY AND STREET CURBS THIS PROJECT.
- 6'-0" CONCRETE SIDEWALK SHALL BE CONSTRUCTED WITH DEVELOPMENT OF ADJACENT PROPERTY.

**RECORD PLANS**  
**MARCH 28, 2008**

FILE: 04141-TypSec2Phase1.dwg  
 TIME: 13:51

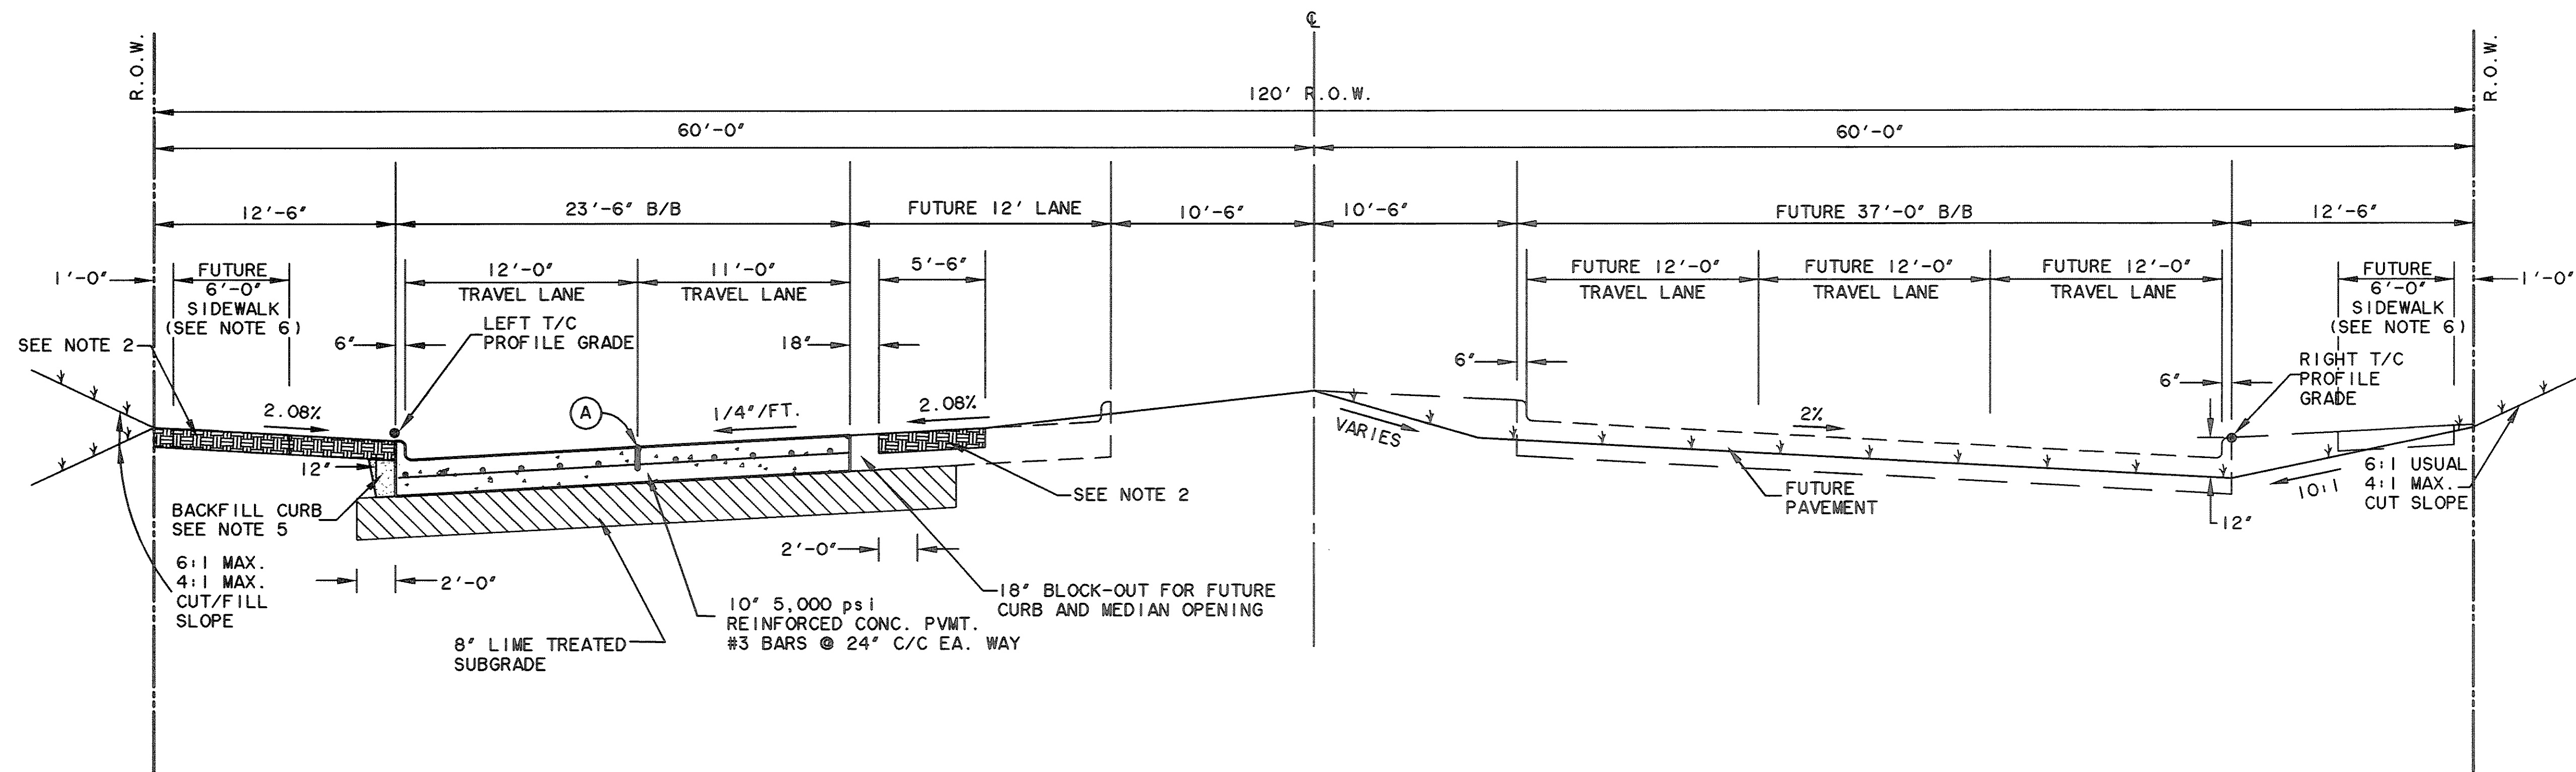

**TYPICAL SECTION**  
 STA 20+16 TO 21+11  
 N.T.S.


(A) SAWED LONGITUDINAL CONTRACTION JOINT

**NOTES:**


1. CONSTRUCT PAVEMENT IN ACCORDANCE WITH CITY STANDARD CONSTRUCTION DETAILS EXCEPT AS NOTED HEREON.
2. PLACE BERMUDA GRASS SOD IN PARKWAY AND TO LIMITS SHOWN IN FUTURE MEDIANS AS PER SPECIFICATIONS.
3. IMPORT AND PLACE MINIMUM 4' TOPSOIL ON CUT AND FILL SLOPES. HYDROMULCH SEED WITH BERMUDA GRASS AS PER SPECIFICATIONS.
4. COMPACT ALL FILLS TO MINIMUM 95% OF STANDARD PROCTOR DENSITY. FILL COMPACTION SHALL BE PERFORMED WITH A SHEEPSFOOT ROLLER.
5. BACKFILL ALL CURBS WITH ON-SITE BROWN CLAY SOILS COMPACTED TO A MINIMUM 95% OF STANDARD PROCTOR DENSITY. TYPICAL ALL ROADWAY AND STREET CURBS THIS PROJECT.
6. 6'-0" CONCRETE SIDEWALK SHALL BE CONSTRUCTED WITH DEVELOPMENT OF ADJACENT PROPERTY.

**RECORD PLANS**  
**MARCH 28, 2008**



PREPARED BY:  
**WIER & ASSOCIATES, INC.**  
**ENGINEERS SURVEYORS LAND PLANNERS**  
 4300 BELWAY PLACE SUITE 130 ARLINGTON, TEXAS 76018 METRO (817)467-7700  
 1380 U.S. HIGHWAY 287 N. SUITE 101 MANSFIELD, TEXAS 76063 METRO (817)477-8700  
 6848 ELM STREET PERCO, TEXAS 75084 METRO (214)387-8800  
 www.wierassociates.com

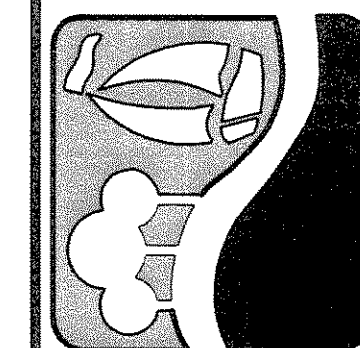

**PHASE I SH. 205 BYPASS**  
**FROM SH. 276 TO INTERSTATE 30**  
**TYPICAL**  
**SECTIONS**

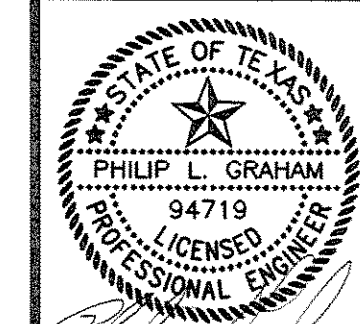


3/28/2008  
 COPYRIGHT ©  
 WIER & ASSOCIATES, INC.  
 LAST SHEET EDIT  
 DATE 11-05-2007  
 WA# 04141  
**SHEET NO.**  
**PO03**

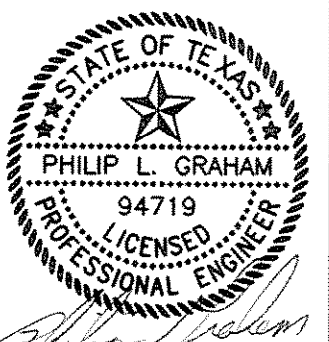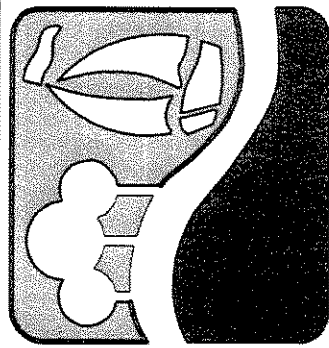


3/28/2008

COPYRIGHT ©  
 WIER & ASSOCIATES, INC.  
 LAST SHEET EDIT  
 DATE 11-13-2007  
 WA# 04141

SHEET NO.  
 P004

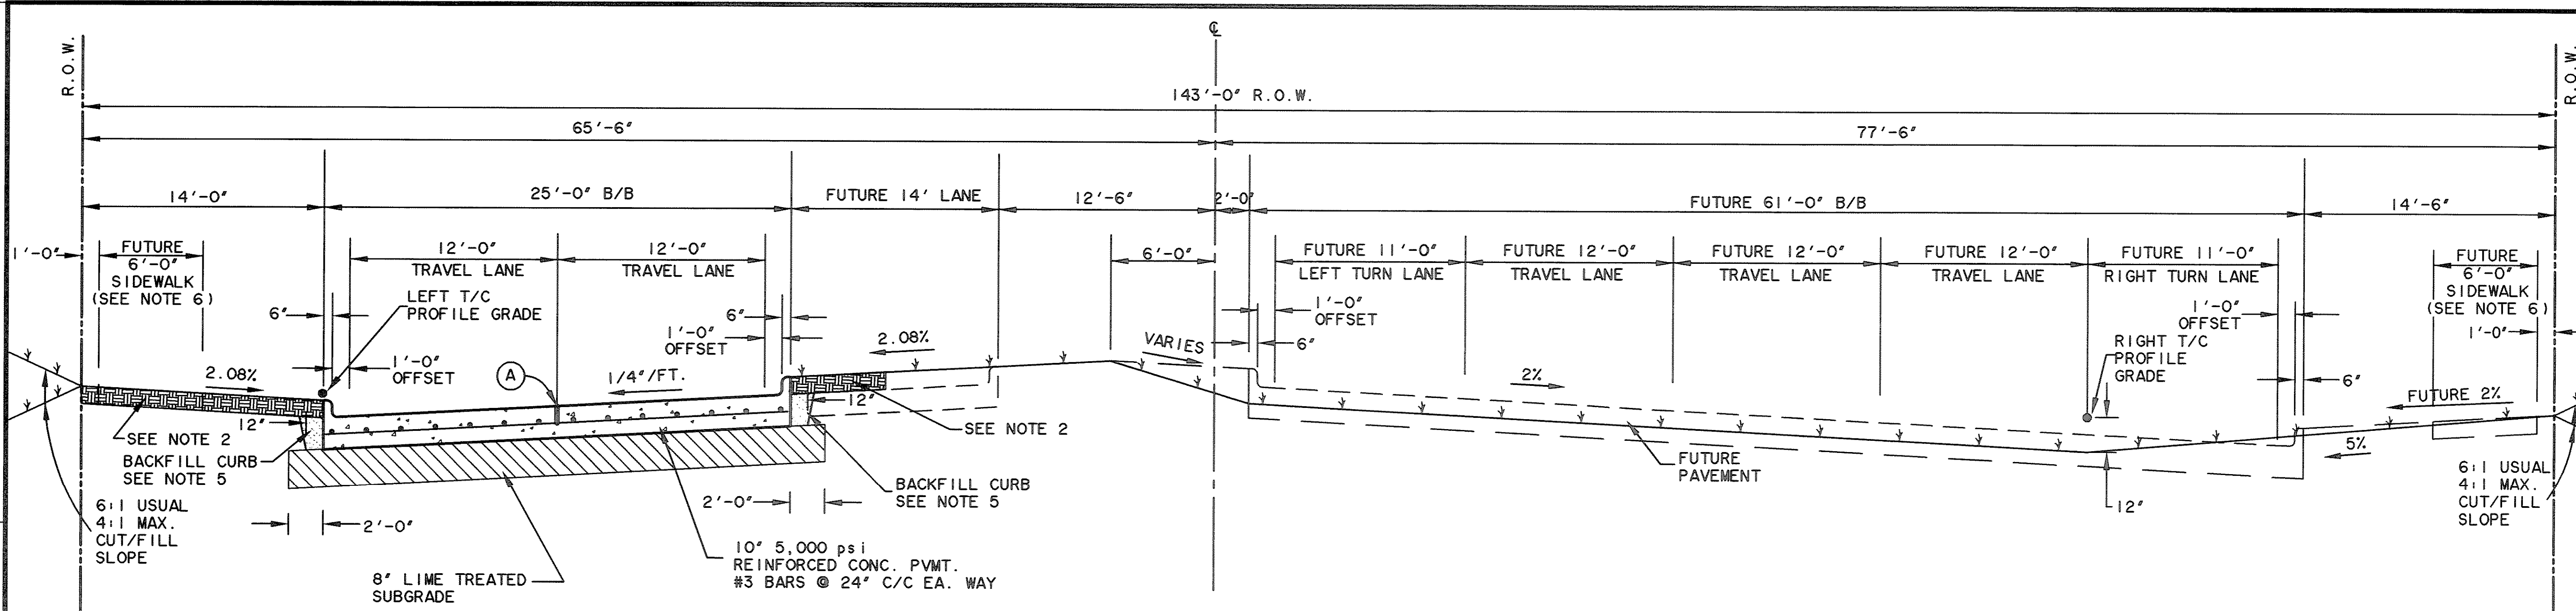

**PHASE I TYPICAL SECTION**  
 STA 47+55 TO 48+00  
 N.T.S.

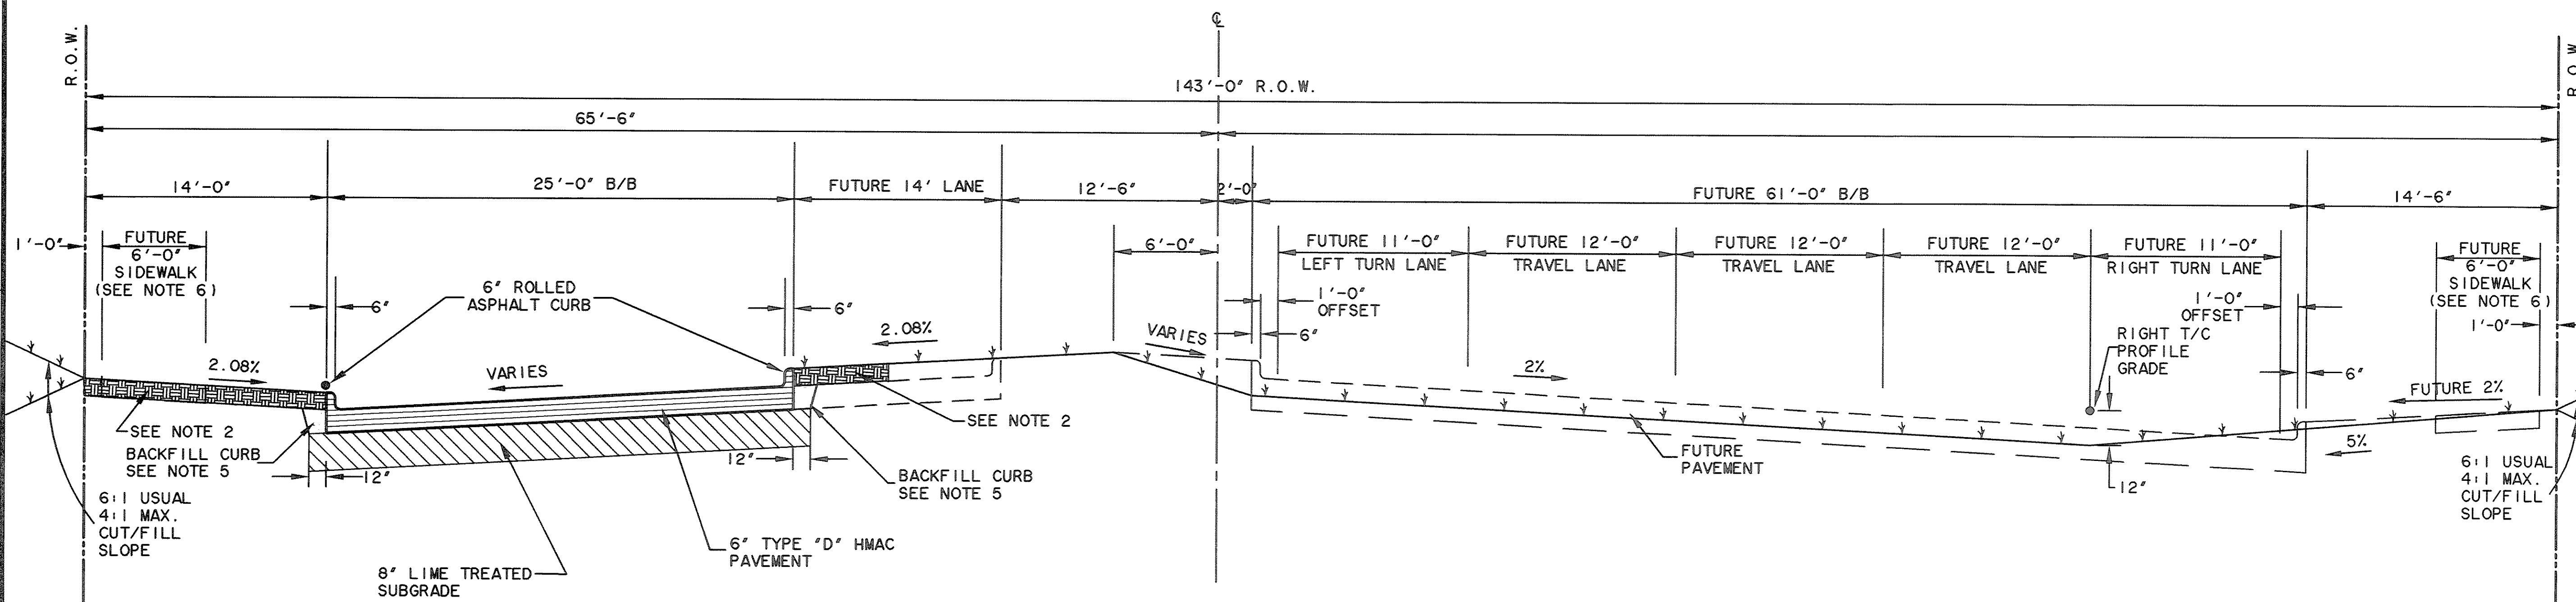

**PHASE I TYPICAL SECTION**  
 STA 48+00 TO I.H. 30  
 N.T.S.

(A) SAWED LONGITUDINAL CONTRACTION JOINT



NOTES:

1. CONSTRUCT PAVEMENT IN ACCORDANCE WITH CITY STANDARD CONSTRUCTION DETAILS EXCEPT AS NOTED HEREON.
2. PLACE BERMUDA GRASS SOD IN PARKWAY AND TO LIMITS SHOWN IN FUTURE MEDIANS AS PER SPECIFICATIONS.
3. IMPORT AND PLACE MINIMUM 4' TOPSOIL ON CUT AND FILL SLOPES. HYDROMULCH SEED WITH BERMUDA GRASS AS PER SPECIFICATIONS.
4. COMPACT ALL FILLS TO MINIMUM 95% OF STANDARD PROCTOR DENSITY. FILL COMPACTION SHALL BE PERFORMED WITH A SHEEPSFOOT ROLLER.
5. BACKFILL ALL CURBS WITH ON-SITE BROWN CLAY SOILS COMPACTED TO A MINIMUM 95% OF STANDARD PROCTOR DENSITY. TYPICAL ALL ROADWAY AND STREET CURBS THIS PROJECT.
6. 6'-0" CONCRETE SIDEWALK SHALL BE CONSTRUCTED WITH DEVELOPMENT OF ADJACENT PROPERTY.

**RECORD PLANS**  
**MARCH 28, 2008**

FILE: 04141-TypSec4Phase1.dwg  
 TIME: 10:31

TIME 115.16 FILE: 04141-TypSec5Phase1.dwg

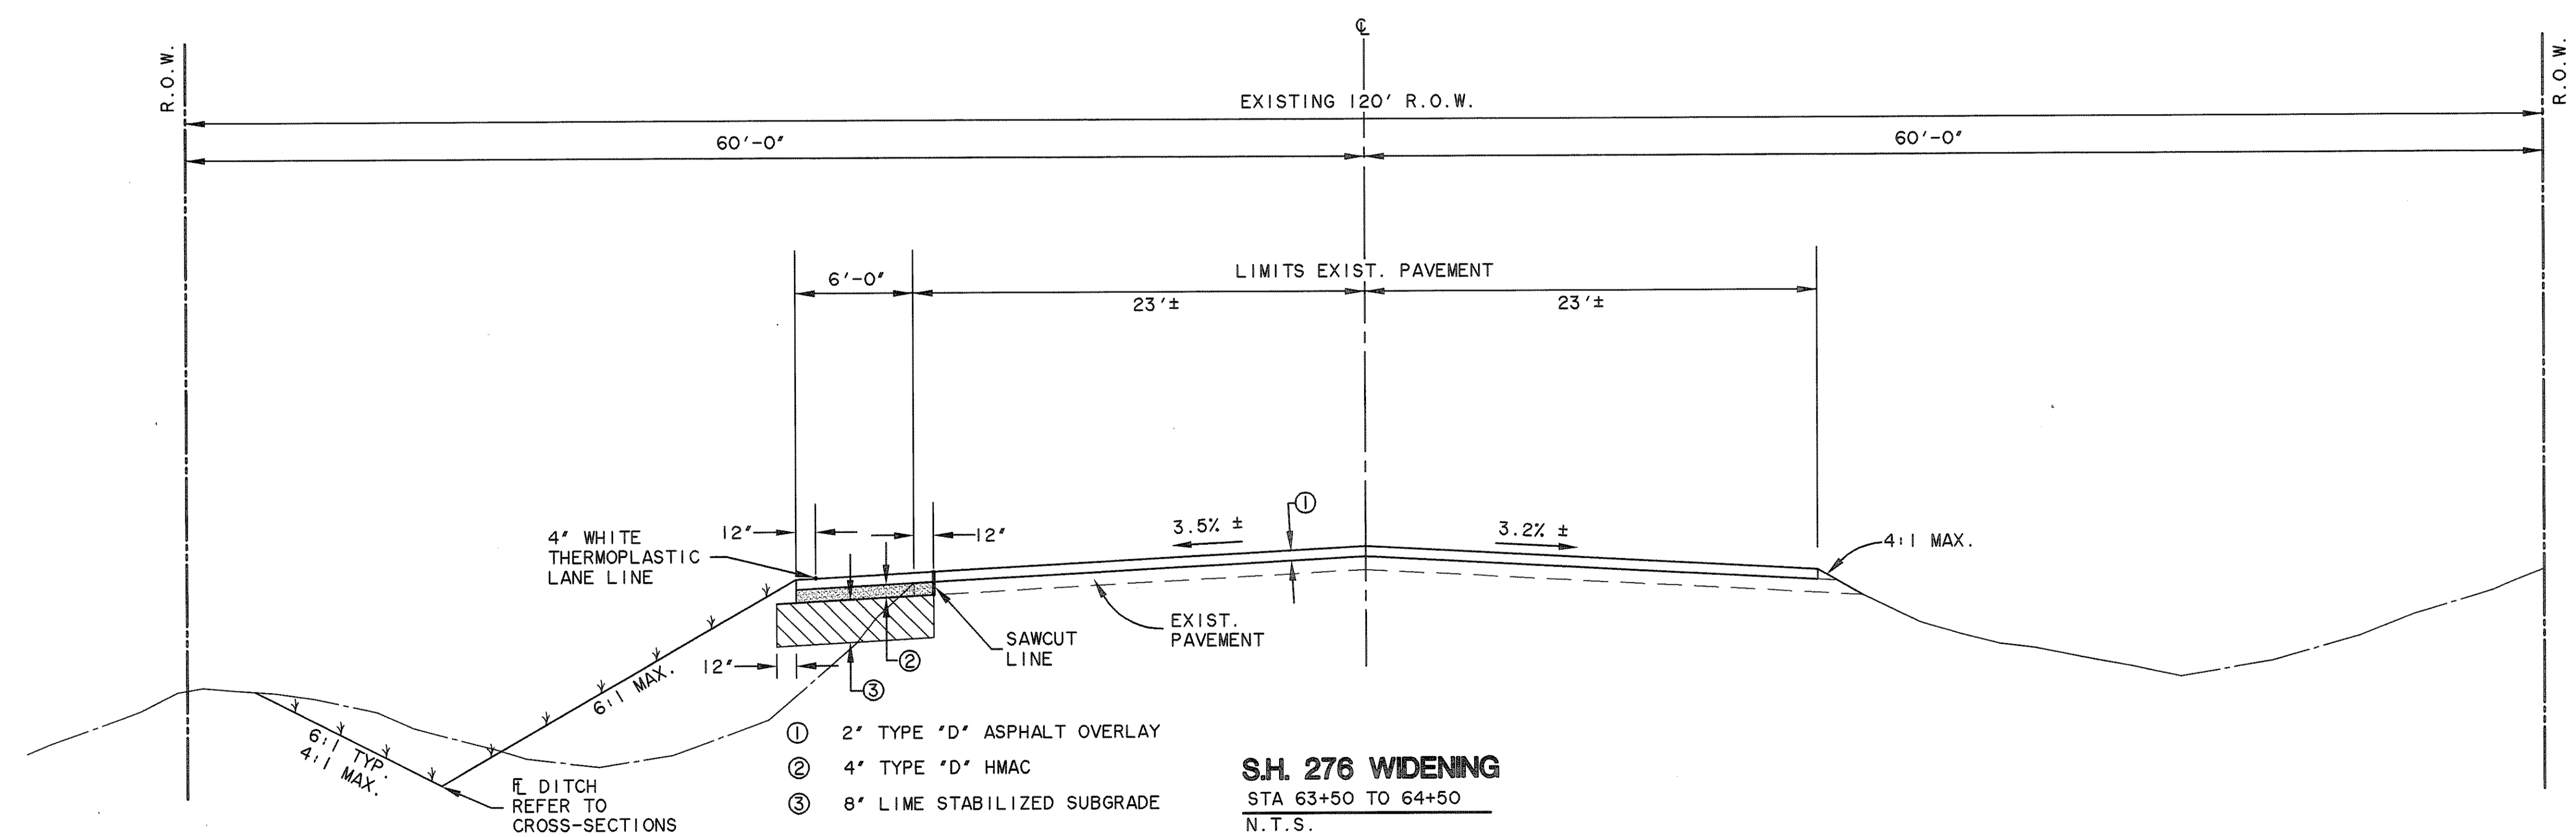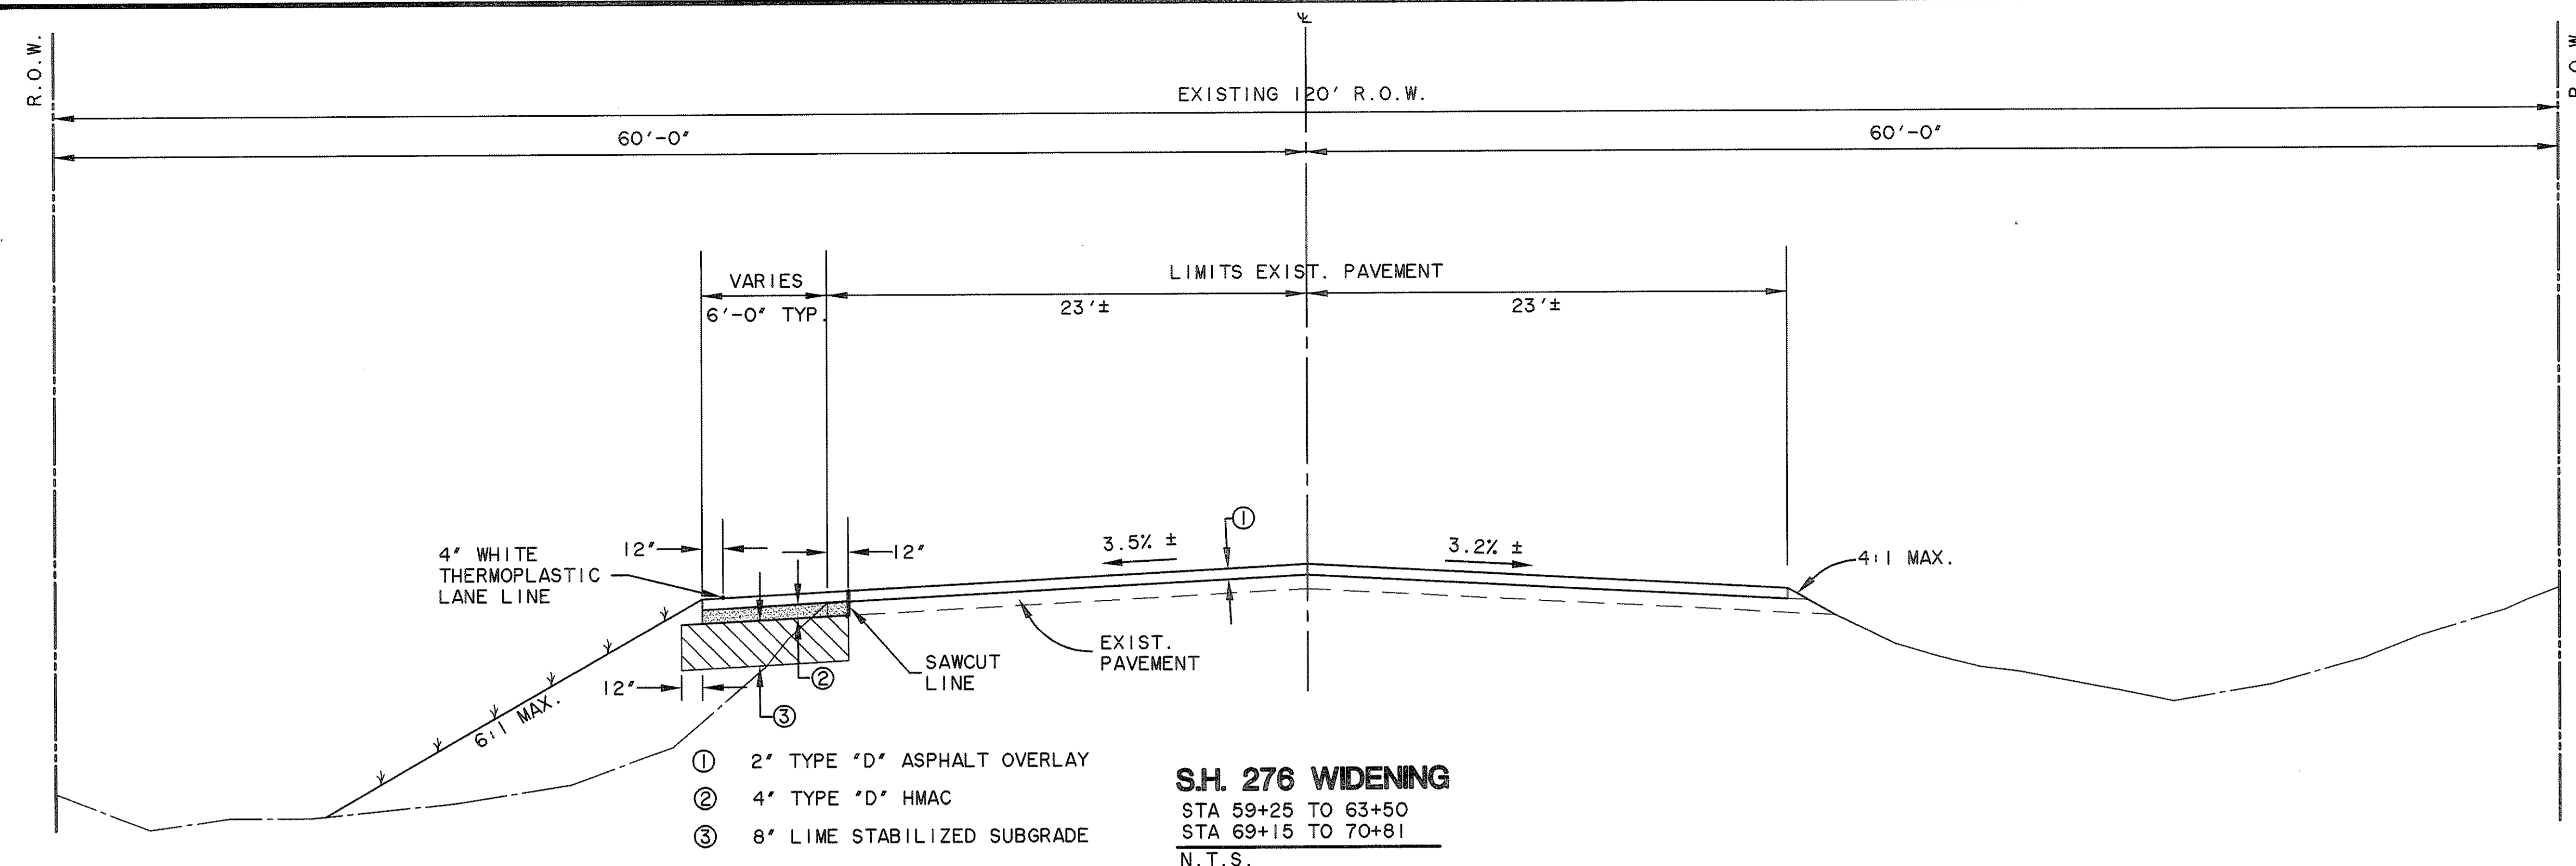


**NOTES:**


- CONSTRUCT PAVEMENT IN ACCORDANCE WITH CITY STANDARD CONSTRUCTION DETAILS EXCEPT AS NOTED HEREON.
- PLACE BERMUDA GRASS SOD IN PARKWAY AND TO LIMITS SHOWN IN FUTURE MEDIANS AS PER SPECIFICATIONS.
- IMPORT AND PLACE MINIMUM 4" TOPSOIL ON CUT AND FILL SLOPES. HYDROMULCH SEED WITH BERMUDA GRASS AS PER SPECIFICATIONS.
- COMPACT ALL FILLS TO MINIMUM 95% OF STANDARD PROCTOR DENSITY. FILL COMPACTION SHALL BE PERFORMED WITH A SHEEPSFOOT ROLLER.
- BACKFILL ALL CURBS WITH ON-SITE BROWN CLAY SOILS COMPACTED TO A MINIMUM 95% OF STANDARD PROCTOR DENSITY. TYPICAL ALL ROADWAY AND STREET CURBS THIS PROJECT.
- 6'-0" CONCRETE SIDEWALK SHALL BE CONSTRUCTED WITH DEVELOPMENT OF ADJACENT PROPERTY.

RECORD PLANS  
MARCH 28, 2008

PREPARED BY:  
**WIA WIER & ASSOCIATES, INC.**  
 ENGINEERS SURVEYORS LAND PLANNERS  
 4300 BELTWAY PLACE SUITE 130 ARLINGTON, TEXAS 76018 METRO (817)467-7700  
 1380 U.S. HIGHWAY 287 N. SUITE 101 MANSFIELD, TEXAS 76063 METRO (817)477-8700  
 6848 ELM STREET FRISCO, TEXAS 75034 METRO (214)387-8000  
 www.wierassociates.com

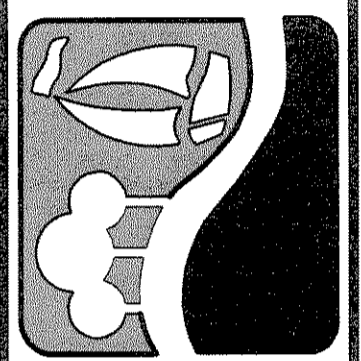


PHASE I S.H. 205 BYPASS  
 FROM S.H. 276 TO INTERSTATE 30  
 TYPICAL  
 SECTIONS

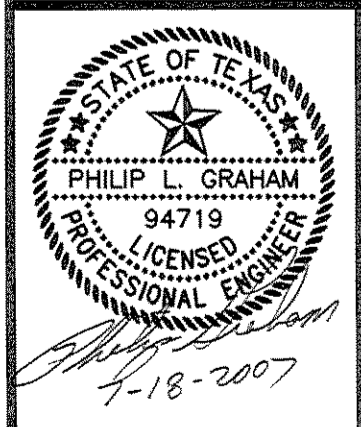

COPYRIGHT ©  
 WIER & ASSOCIATES, INC.  
 LAST SHEET EDIT  
 DATE 07-18-2007  
 WA# 04141  
 SHEET NO.  
 P005

FILE: 04141-TypSec6Phase1.dwg  
TIME: 15.17

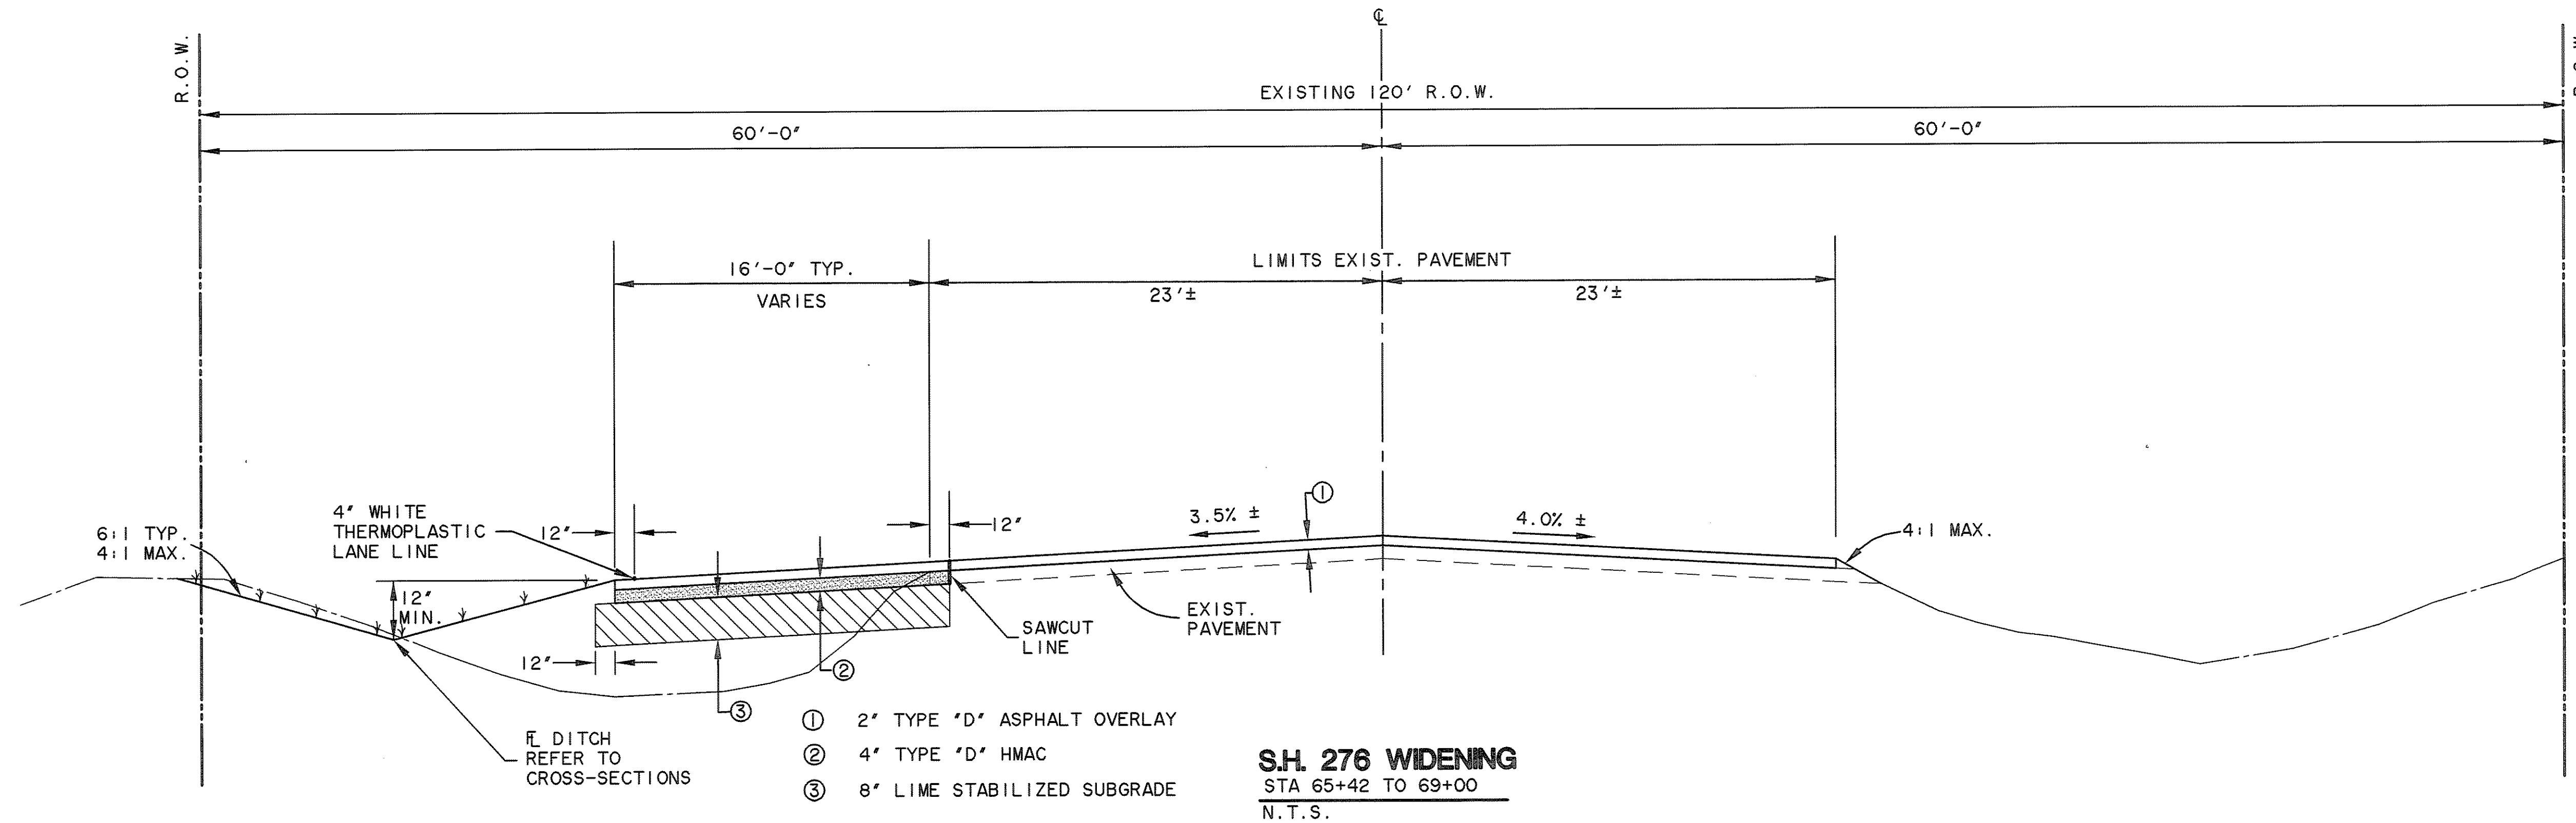


- ① 2" TYPE "D" ASPHALT OVERLAY
- ② 4" TYPE "D" HMAc
- ③ 8" LIME STABILIZED SUBGRADE

**NOTES:**


1. CONSTRUCT PAVEMENT IN ACCORDANCE WITH CITY STANDARD CONSTRUCTION DETAILS EXCEPT AS NOTED HEREON.
2. PLACE BERMUDA GRASS SOD IN PARKWAY AND TO LIMITS SHOWN IN FUTURE MEDIANS AS PER SPECIFICATIONS.
3. IMPORT AND PLACE MINIMUM 4" TOPSOIL ON CUT AND FILL SLOPES. HYDROMULCH SEED WITH BERMUDA GRASS AS PER SPECIFICATIONS.
4. COMPACT ALL FILLS TO MINIMUM 95% OF STANDARD PROCTOR DENSITY. FILL COMPACTION SHALL BE PERFORMED WITH A SHEEPSFOOT ROLLER.
5. BACKFILL ALL CURBS WITH ON-SITE BROWN CLAY SOILS COMPACTED TO A MINIMUM 95% OF STANDARD PROCTOR DENSITY. TYPICAL ALL ROADWAY AND STREET CURBS THIS PROJECT.
6. 6'-0" CONCRETE SIDEWALK SHALL BE CONSTRUCTED WITH DEVELOPMENT OF ADJACENT PROPERTY.

RECORD PLANS  
MARCH 28, 2008

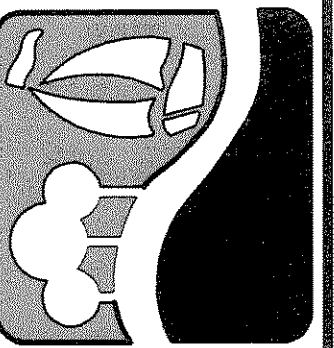

PREPARED BY:  
**WIER & ASSOCIATES, INC.**  
 ENGINEERS SURVEYORS LAND PLANNERS  
 4300 BELTWAY PLACE SUITE 130 ARLINGTON, TEXAS 76018 METRO (817)467-7700  
 1380 U.S. HIGHWAY 287 N. SUITE 101 MANSFIELD, TEXAS 76063 METRO (817)477-8700  
 6848 ELM STREET FRISCO, TEXAS 75034 METRO (214)387-8000  
 www.wierassociates.com

PHASE I S.H. 205 BYPASS  
 FROM S.H. 276 TO INTERSTATE 30  
 TYPICAL  
 SECTIONS

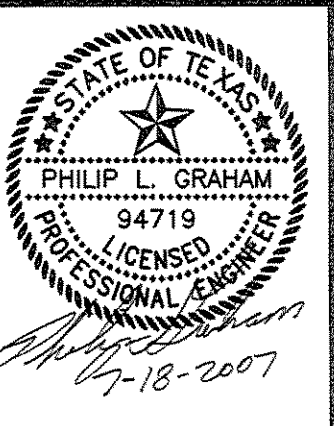


COPYRIGHT ©  
 WIER & ASSOCIATES, INC.  
 LAST SHEET EDIT  
 DATE 07-18-2007  
 WA# 04141  
 SHEET NO.  
 P006

9-07-07	CORRECTED LABELS & ELEVATIONS	JRA	
10-31-07	REDESIGNED S.H. 276 CONNECTION & CHANGED S.H. 205 BYPASS TO CITY SECTION	JRA	
NO.	DATE	DESCRIPTION	BY

**CAUTION !!**  
 EXISTING UTILITIES ARE INDICATED ON THE PLANS FROM AVAILABLE INFORMATION. IT SHALL BE THE RESPONSIBILITY OF THE CONTRACTOR TO VERIFY THE LOCATION OF ALL UTILITIES, TO NOTIFY ALL UTILITY COMPANIES OF THE CONTRACTORS OPERATIONS, TO PROTECT ALL UTILITIES FROM DAMAGE, TO REPAIR ALL UTILITIES DAMAGED DUE TO THE CONTRACTORS OPERATIONS, AND TO NOTIFY THE ENGINEER PROMPTLY OF ALL CONFLICTS OF THE WORK WITH EXISTING UTILITIES.

ROCKWALL BYPASS, LTD.  
 VOL. 2852, PG. 109  
 D.R.R.C.T.

***BENCHMARKS***  
 1. BOX CUT WITH 'X' CUT IN CENTER OF EXISTING SIDEWALK 2' SOUTH OF NORTH EDGE AT SOUTHEAST CORNER OF S.H. No. 205 BYPASS AND S.H. No. 276  
 ELEV. 580.40  
 2. BOX CUT ON SOUTHEAST TOP OF HEADWALL ON SOUTH SIDE OF I.H. No. 30 ACCESS ROAD APPROX. 325' EAST OF FUTURE S.H. No. 205 BYPASS AND ON WEST SIDE OF NESBIT METAL CO. ORANGE METAL BLDG.  
 ELEV. 573.70


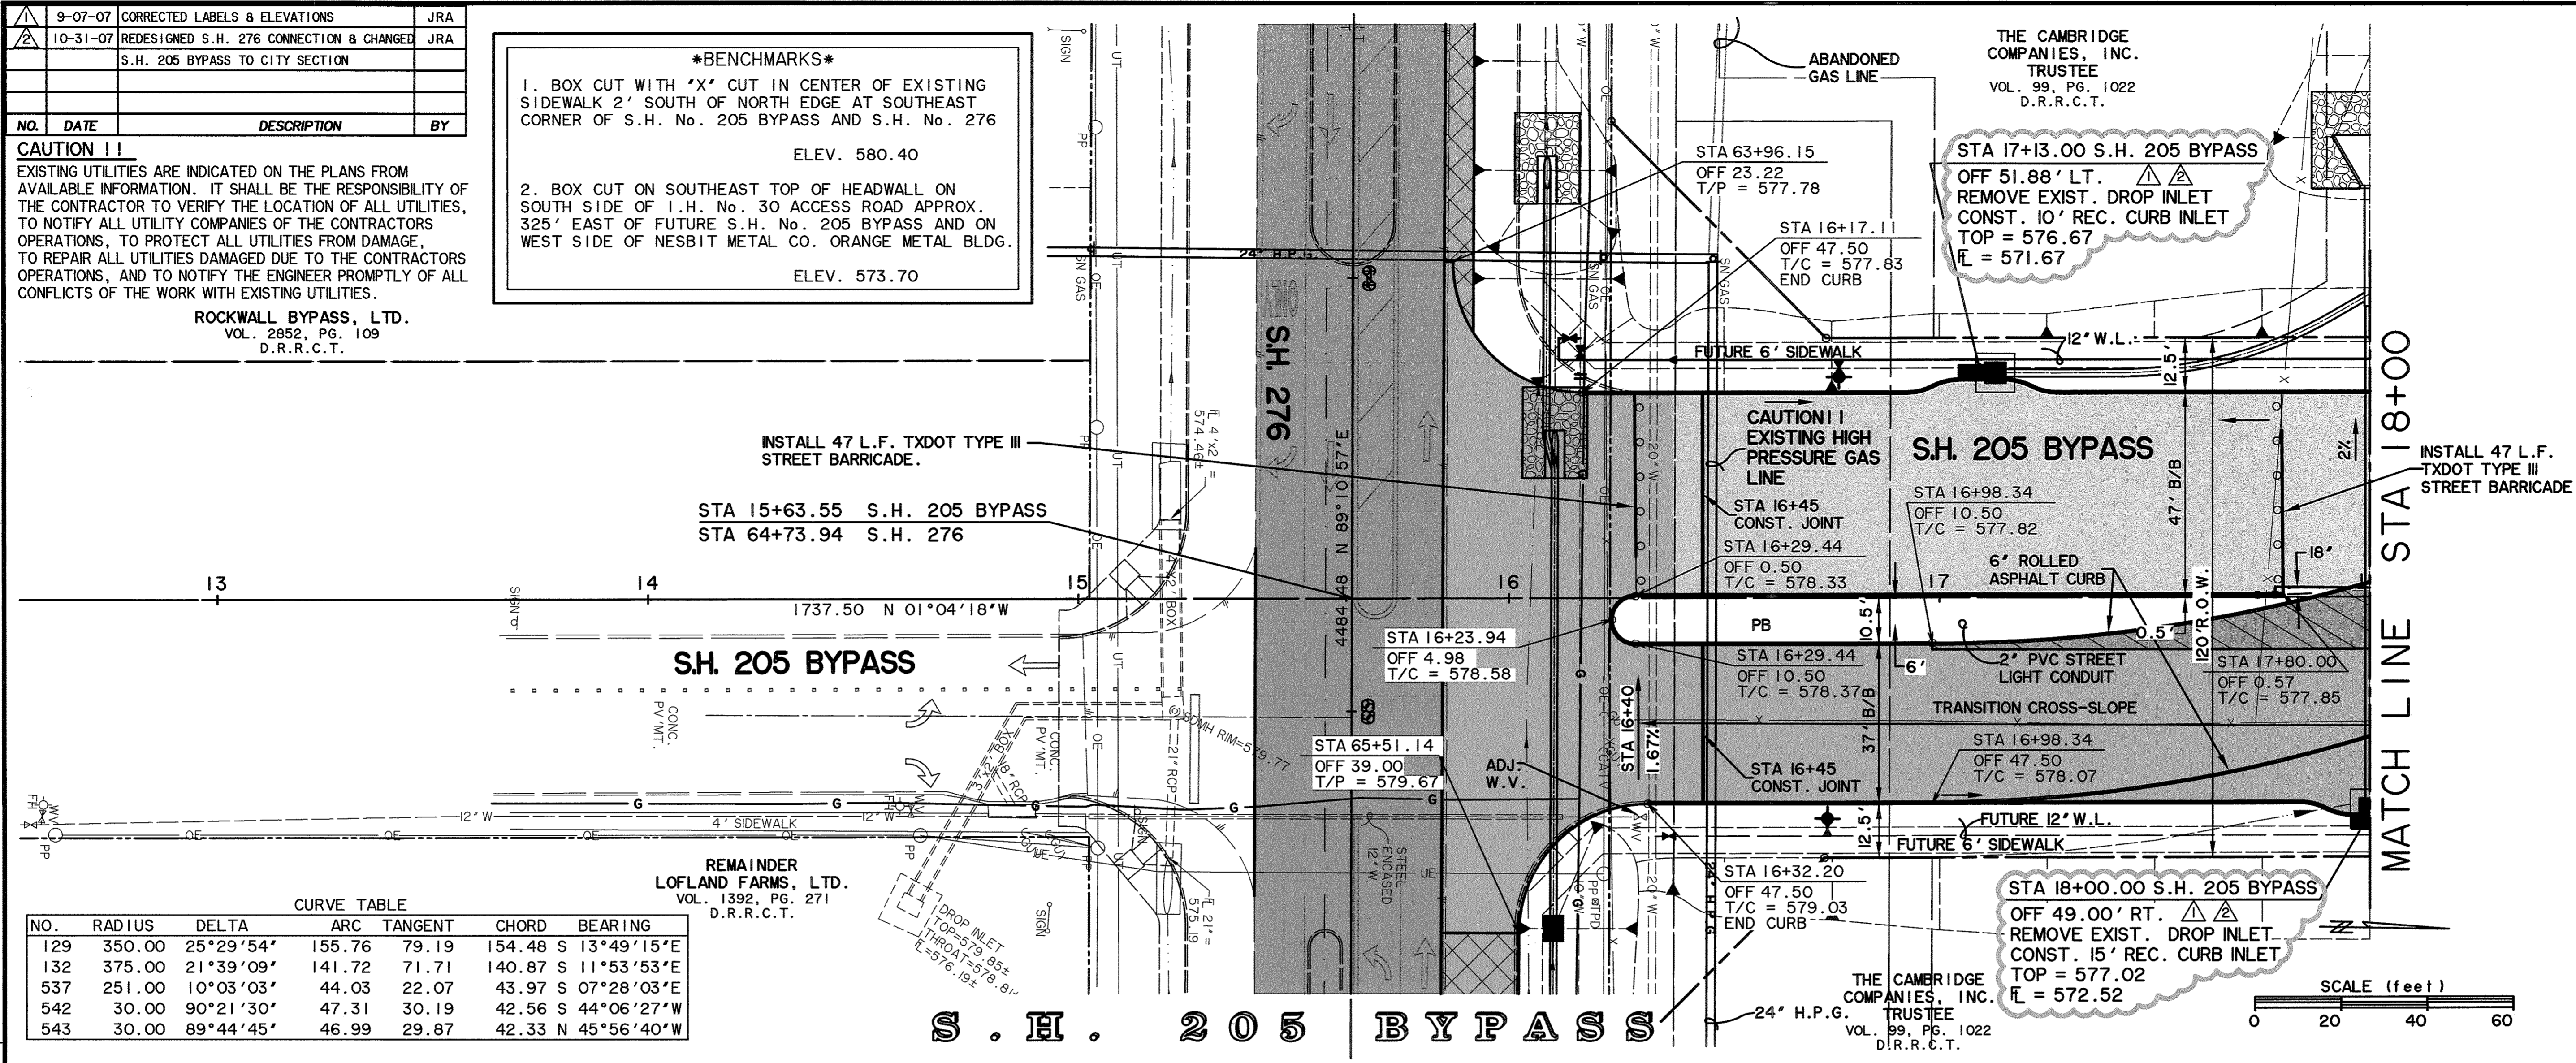


**CURVE TABLE**

NO.	RADIUS	DELTA	ARC TANGENT	CHORD	BEARING
129	350.00	25°29'54"	155.76	79.19	154.48 S 13°49'15"E
132	375.00	21°39'09"	141.72	71.71	140.87 S 11°53'53"E
537	251.00	10°03'03"	44.03	22.07	43.97 S 07°28'03"E
542	30.00	90°21'30"	47.31	30.19	42.56 S 44°06'27"W
543	30.00	89°44'45"	46.99	29.87	42.33 N 45°56'40"W


REMAINDER  
 LOFLAND FARMS, LTD.  
 VOL. 1392, PG. 271  
 D.R.R.C.T.

THE CAMBRIDGE  
 COMPANIES, INC.  
 TRUSTEE  
 VOL. 99, PG. 1022  
 D.R.R.C.T.

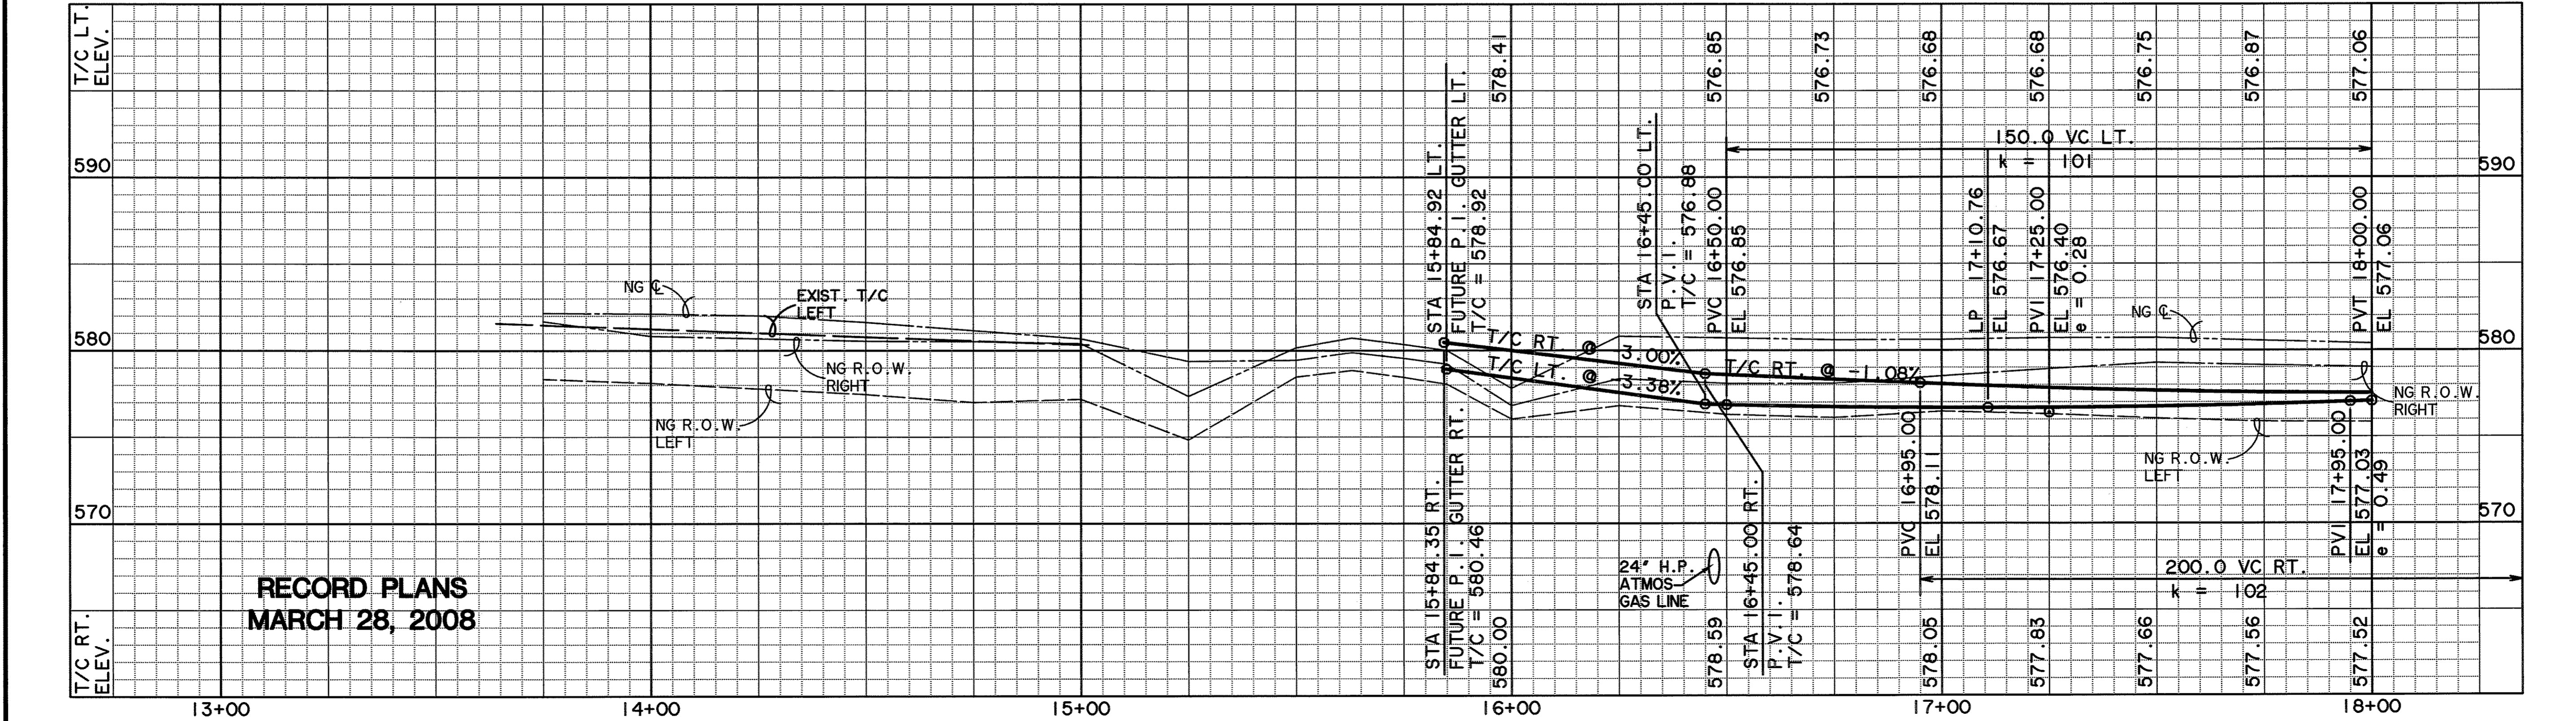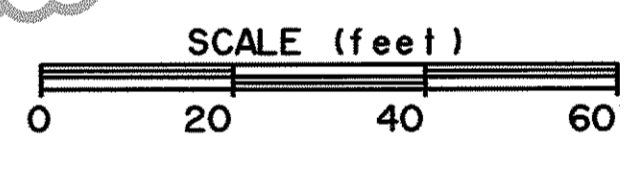

**RECORD PLANS**  
**MARCH 28, 2008**

PREPARED BY:  
**WIER & ASSOCIATES, INC.**  
 ENGINEERS SURVEYORS LAND PLANNERS  
 4300 BELWAY PLACE SUITE 130 ARLINGTON, TEXAS 76018 METRO (817)467-7700  
 1380 U.S. HIGHWAY 287 N. SUITE 101 MANSFIELD, TEXAS 76063 METRO (817)477-8700  
 6848 ELM STREET FRSICO, TEXAS 75064 METRO (214)387-8000  
 www.wierassociates.com

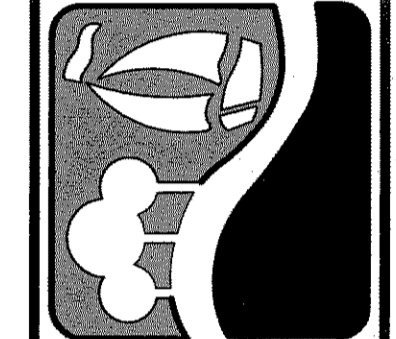

**PHASE I S.H. 205 BYPASS**  
**FROM S.H. 276 TO INTERSTATE 30**  
**PAVING**  
**PLAN & PROFILE**  
 STA 13+00s TO 18+00

STATE OF TEXAS  
 PHILIP L. GRAHAM  
 94719  
 LICENSED PROFESSIONAL ENGINEER  
 3/28/08  
 COPYRIGHT ©  
 WIER & ASSOCIATES, INC.  
 LAST SHEET EDIT  
 DATE 03-28-2008  
 WA# 04141  
**SHEET NO.**  
**P101**

TIME: 6:34 FILE: 04141-PAVE1.dwg


NO.	RADIUS	DELTA	ARC	TANGENT	CHORD	BEARING
118	2476.00	02°09'16"	93.10	46.55	93.09	S 03°16'22"E
130	350.00	24°50'55"	151.79	77.11	150.60	N 14°08'45"W
133	450.00	20°57'30"	164.61	83.23	163.69	N 12°14'42"W
136	2489.50	01°07'26"	48.83	24.42	48.83	S 01°38'01"E
537	215.00	12°01'47"	45.14	22.65	45.06	N 06°29'16"W
538	285.00	11°25'46"	56.85	28.52	56.76	S 06°47'17"E
541	2479.50	00°25'40"	18.51	9.25	18.51	S 01°56'08"E

THE CAMBRIDGE COMPANIES, INC. TRUSTEE  
VOL. 99, PG. 1022  
D.R.R.C.T.

**CAUTION !!**  
EXISTING UTILITIES ARE INDICATED ON THE PLANS FROM AVAILABLE INFORMATION. IT SHALL BE THE RESPONSIBILITY OF THE CONTRACTOR TO VERIFY THE LOCATION OF ALL UTILITIES, TO NOTIFY ALL UTILITY COMPANIES OF THE CONTRACTORS OPERATIONS, TO PROTECT ALL UTILITIES FROM DAMAGE, TO REPAIR ALL UTILITIES DAMAGED DUE TO THE CONTRACTORS OPERATIONS, AND TO NOTIFY THE ENGINEER PROMPTLY OF ALL CONFLICTS OF THE WORK WITH EXISTING UTILITIES.

***BENCHMARKS***  
1. BOX CUT WITH "X" CUT IN CENTER OF EXISTING SIDEWALK 2' SOUTH OF NORTH EDGE AT SOUTHEAST CORNER OF S.H. No. 205 BYPASS AND S.H. No. 276  
ELEV. 580.40  
2. BOX CUT ON SOUTHEAST TOP OF HEADWALL ON SOUTH SIDE OF I.H. No. 30 ACCESS ROAD APPROX. 325' EAST OF FUTURE S.H. No. 205 BYPASS AND ON WEST SIDE OF NESBIT METAL CO. ORANGE METAL BLDG.  
ELEV. 573.70

CURVE C1	
A	19°35'45"
D	02°17'31"
R	2500.00
L	431.73
E	855.03
	37.00

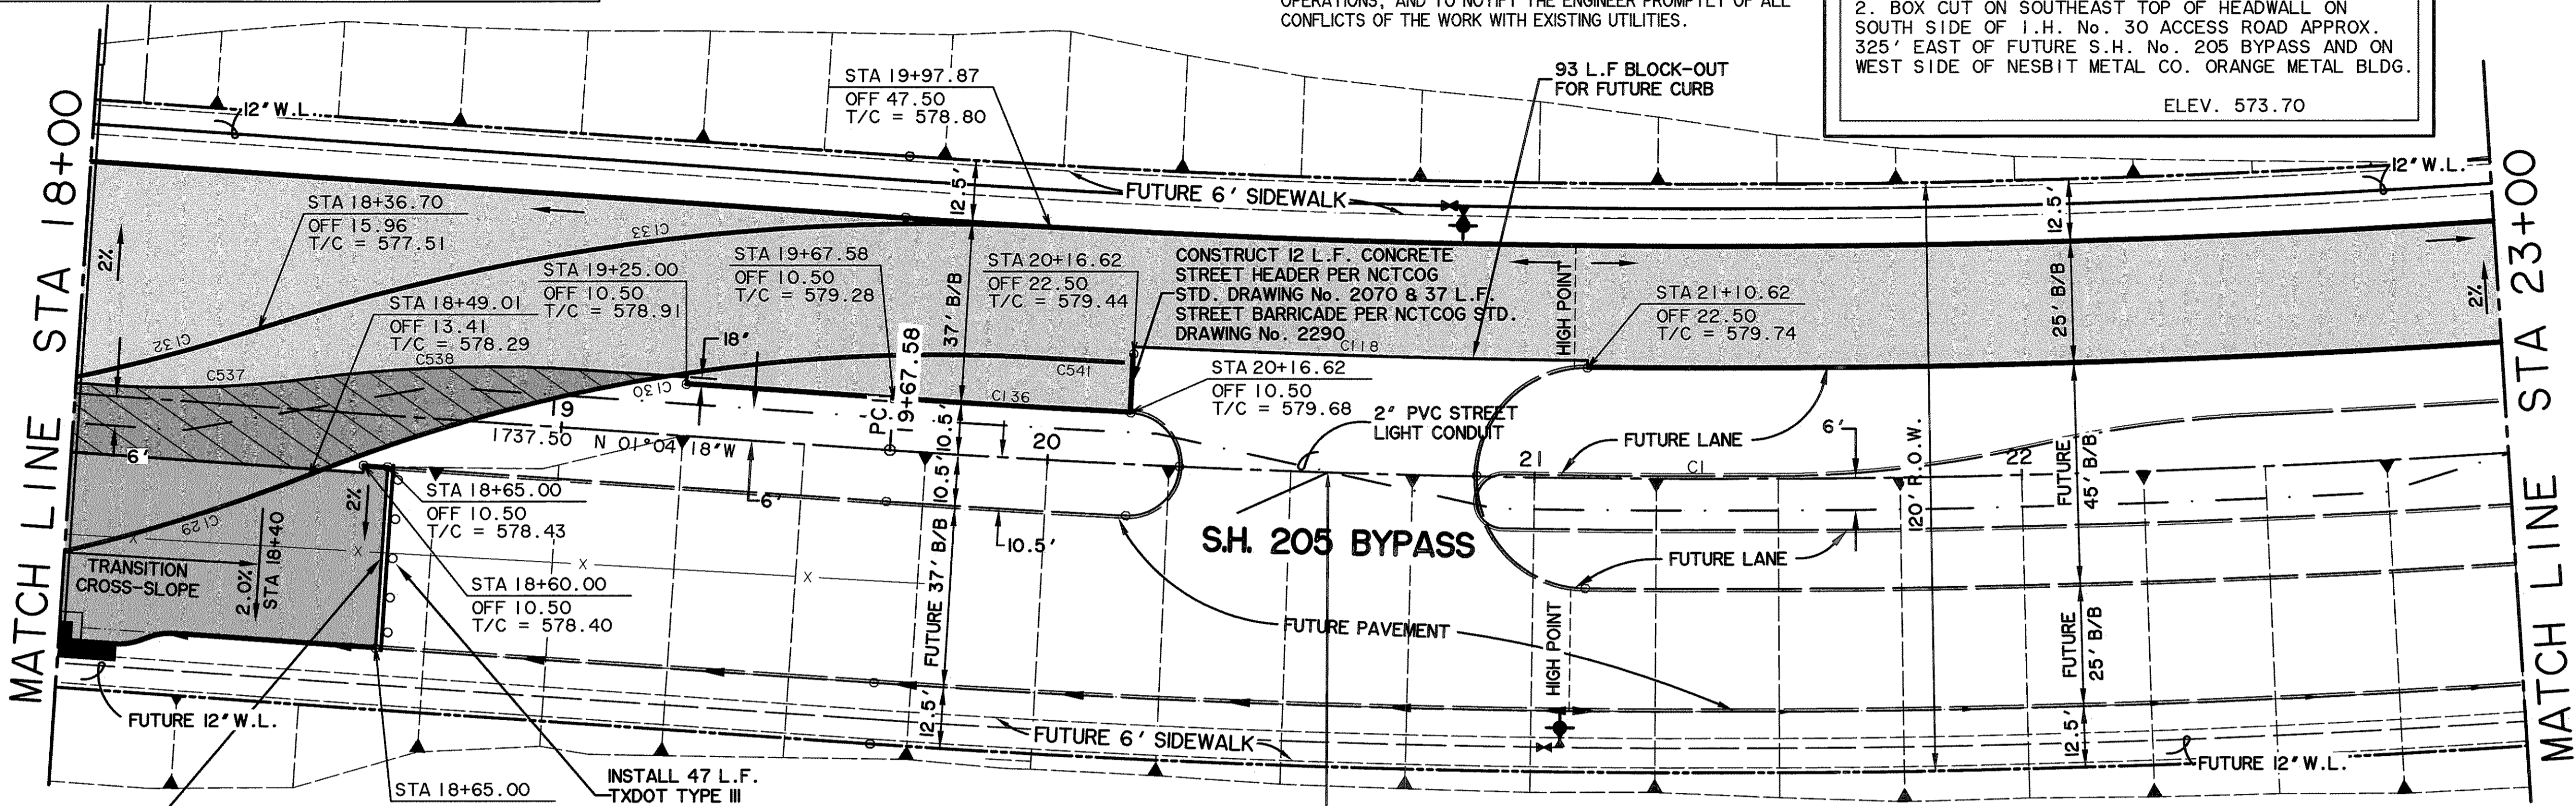


CONSTRUCT 37 L.F. CONCRETE STREET HEADER PER NCTCOG STD. DRAWING No. 2070.

INSTALL 47 L.F. TXDOT TYPE III STREET BARRICADE.


THE CAMBRIDGE COMPANIES, INC. TRUSTEE  
VOL. 99, PG. 1022  
D.R.R.C.T.

STA 20+57.62 S.H. No. 205 BYPASS  
CENTER OF FUTURE 60' WIDE MEDIAN OPENING

NO.	DATE	DESCRIPTION	BY
1	10-31-07	CHANGED S.H. 205 BYPASS TO CITY SECTION	JRA

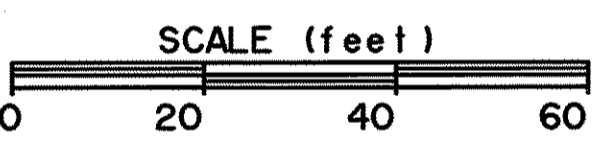


**S . H . 2 0 5 B Y P A S S**

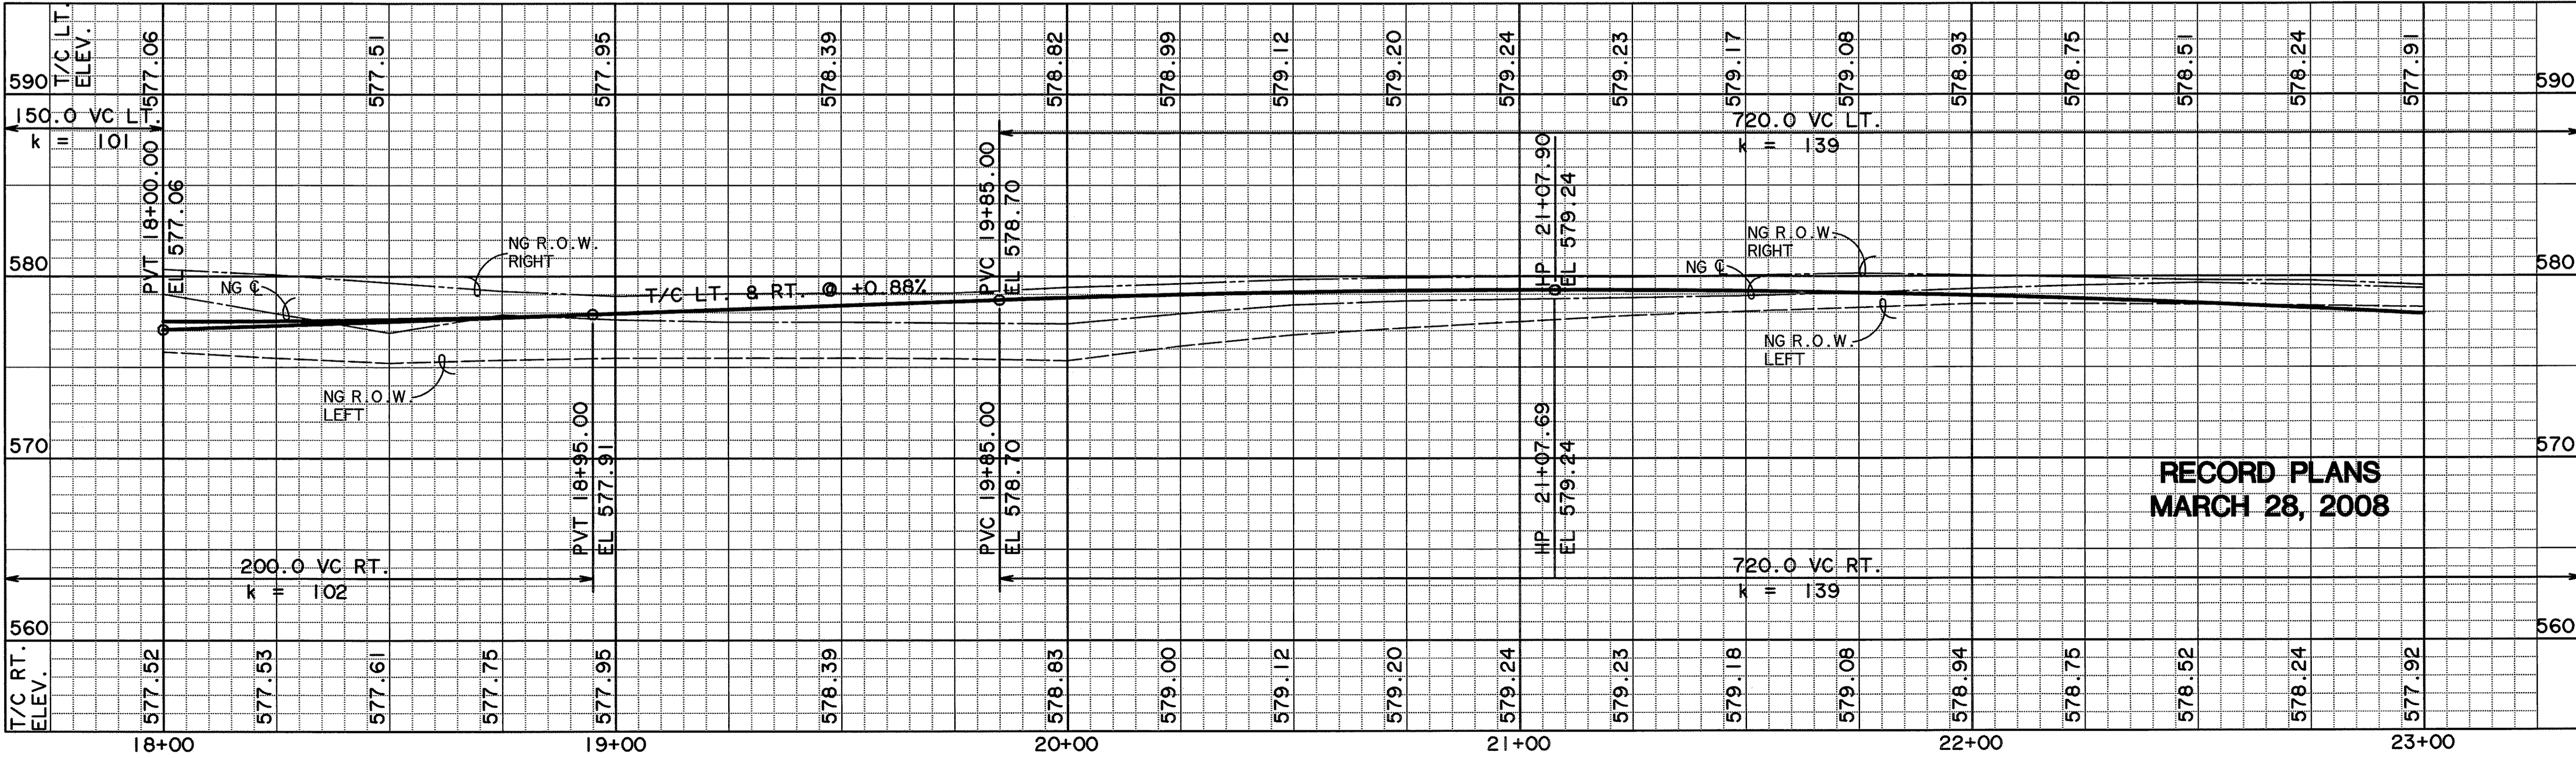


RECORD PLANS  
MARCH 28, 2008

PREPARED BY:  
**WIA WIER & ASSOCIATES, INC.**  
ENGINEERS SURVEYORS LAND PLANNERS  
4300 BELWAY PLACE SUITE 130 ARLINGTON, TEXAS 76018 METRO (817)467-7700  
1380 U.S. HIGHWAY 287 N. SUITE 101 WANSFELD, TEXAS 76783 METRO (817)477-8700  
6848 ELM STREET FRSO, TEXAS 75034 METRO (214)387-8800  
www.wierassociates.com

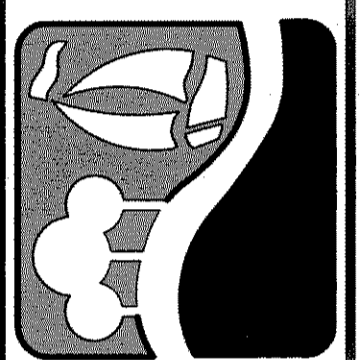

PHASE I S.H. 205 BYPASS  
FROM S.H. 276 TO INTERSTATE 30  
PAVING  
PLAN & PROFILE  
STA 18+00 TO 23+00

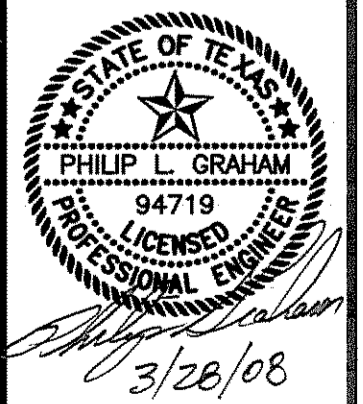

COPYRIGHT ©  
WIER & ASSOCIATES, INC.  
LAST SHEET EDIT  
DATE 03-28-2008  
WA# 04141  
SHEET NO.  
P102


10-31-07	CHANGED S.H. 205 BYPASS TO CITY SECTION	JRA	
NO.	DATE	DESCRIPTION	BY

**CAUTION !!**  
 EXISTING UTILITIES ARE INDICATED ON THE PLANS FROM AVAILABLE INFORMATION. IT SHALL BE THE RESPONSIBILITY OF THE CONTRACTOR TO VERIFY THE LOCATION OF ALL UTILITIES, TO NOTIFY ALL UTILITY COMPANIES OF THE CONTRACTORS OPERATIONS, TO PROTECT ALL UTILITIES FROM DAMAGE, TO REPAIR ALL UTILITIES DAMAGED DUE TO THE CONTRACTORS OPERATIONS, AND TO NOTIFY THE ENGINEER PROMPTLY OF ALL CONFLICTS OF THE WORK WITH EXISTING UTILITIES.



THE CAMBRIDGE COMPANIES, INC. TRUSTEE  
 VOL. 99, PG. 1022  
 D.R.R.C.T.

***BENCHMARK***  
 1. BOX CUT WITH 'X' CUT IN CENTER OF EXISTING SIDEWALK 2' SOUTH OF NORTH EDGE AT SOUTHEAST CORNER OF S.H. No. 205 BYPASS AND S.H. No. 276  
 ELEV. 580.40  
 2. BOX CUT ON SOUTHEAST TOP OF HEADWALL ON SOUTH SIDE OF I.H. No. 30 ACCESS ROAD APPROX. 325' EAST OF FUTURE S.H. No. 205 BYPASS AND ON WEST SIDE OF NESBIT METAL CO. ORANGE METAL BLDG.  
 ELEV. 573.70

CURVE C1	
A	19°35'45"
D	02°17'31"
R	2500.00
L	431.73
E	855.03
T	37.00

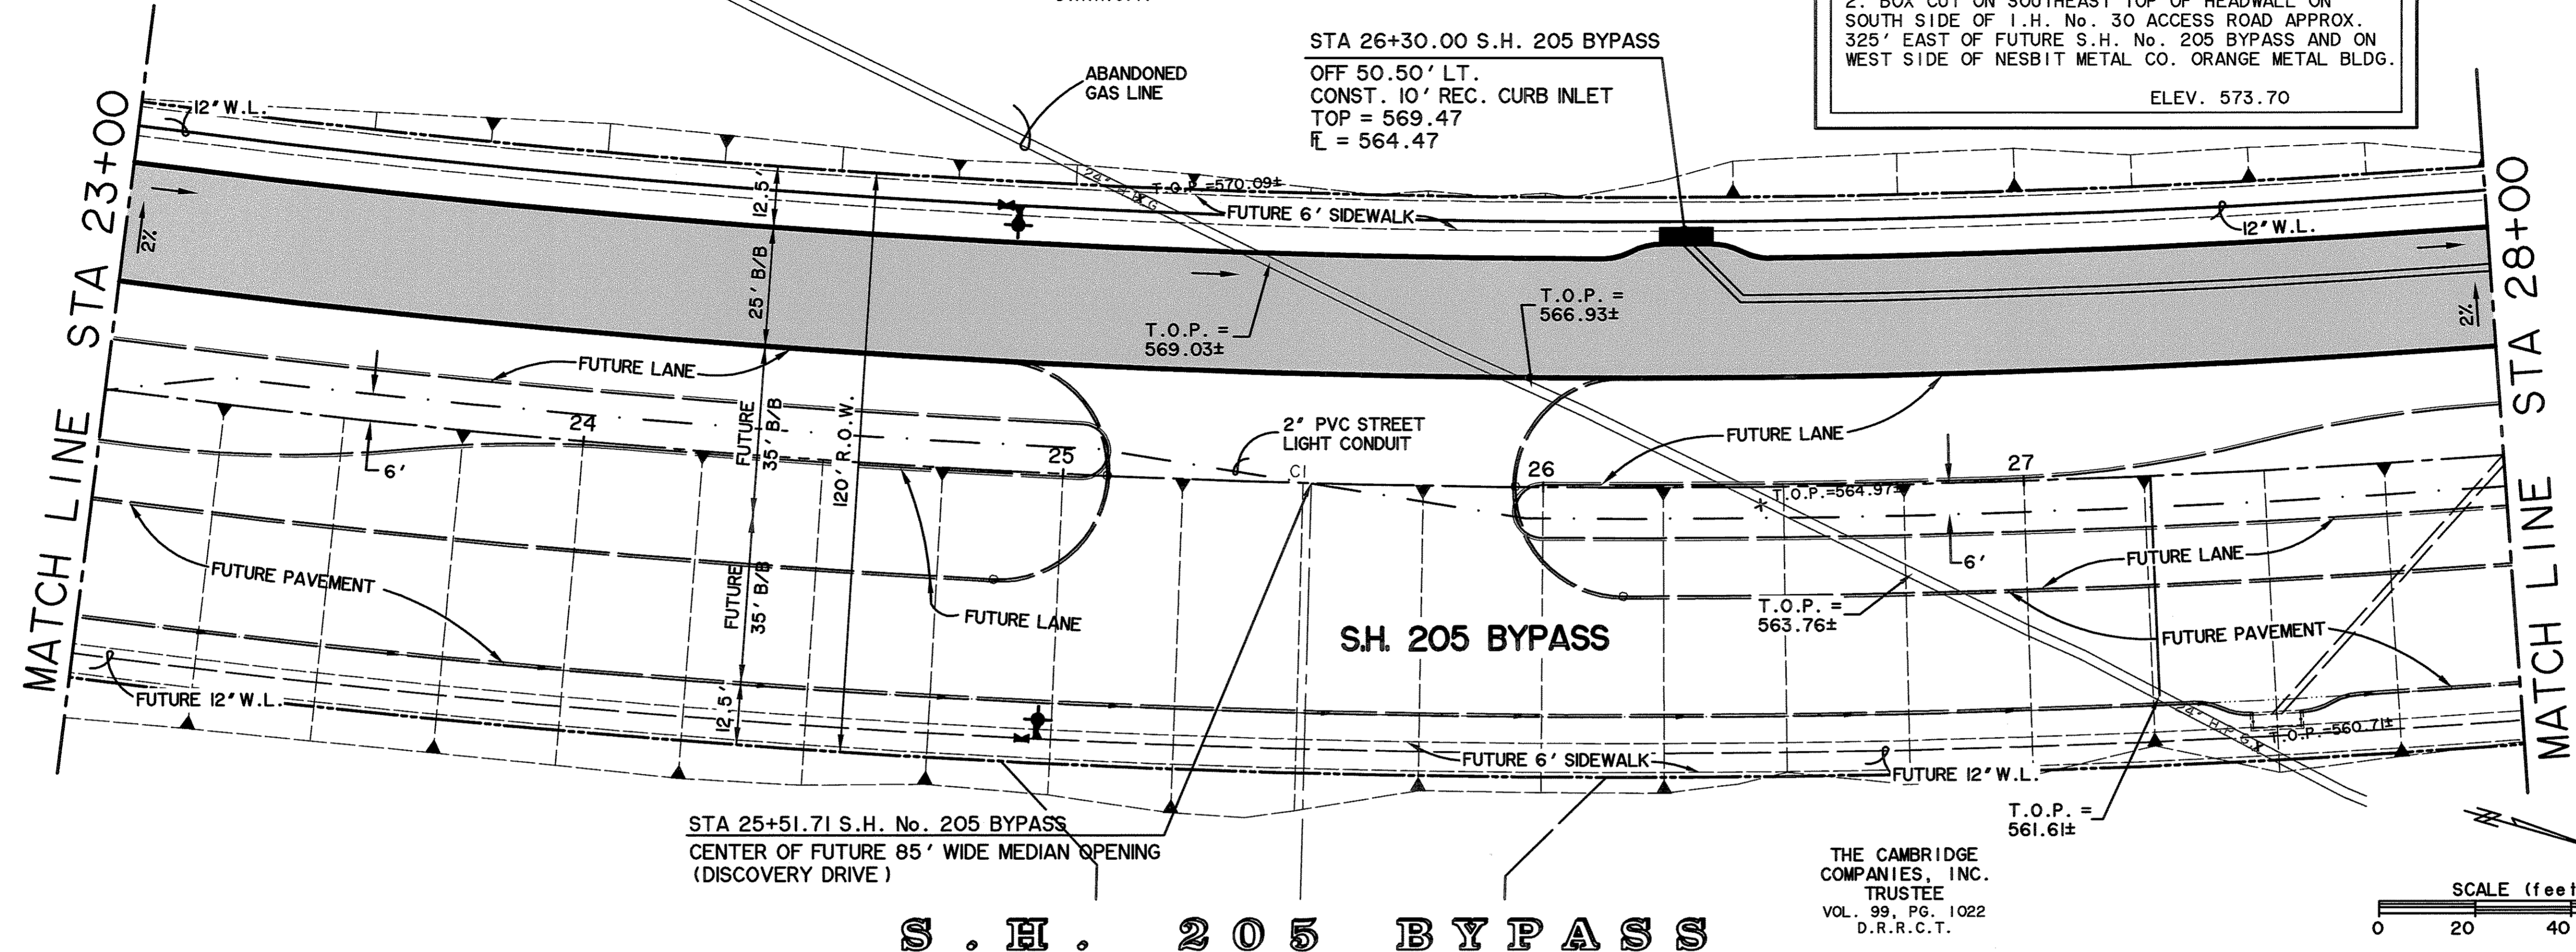


THE CAMBRIDGE COMPANIES, INC. TRUSTEE  
 VOL. 99, PG. 1022  
 D.R.R.C.T.

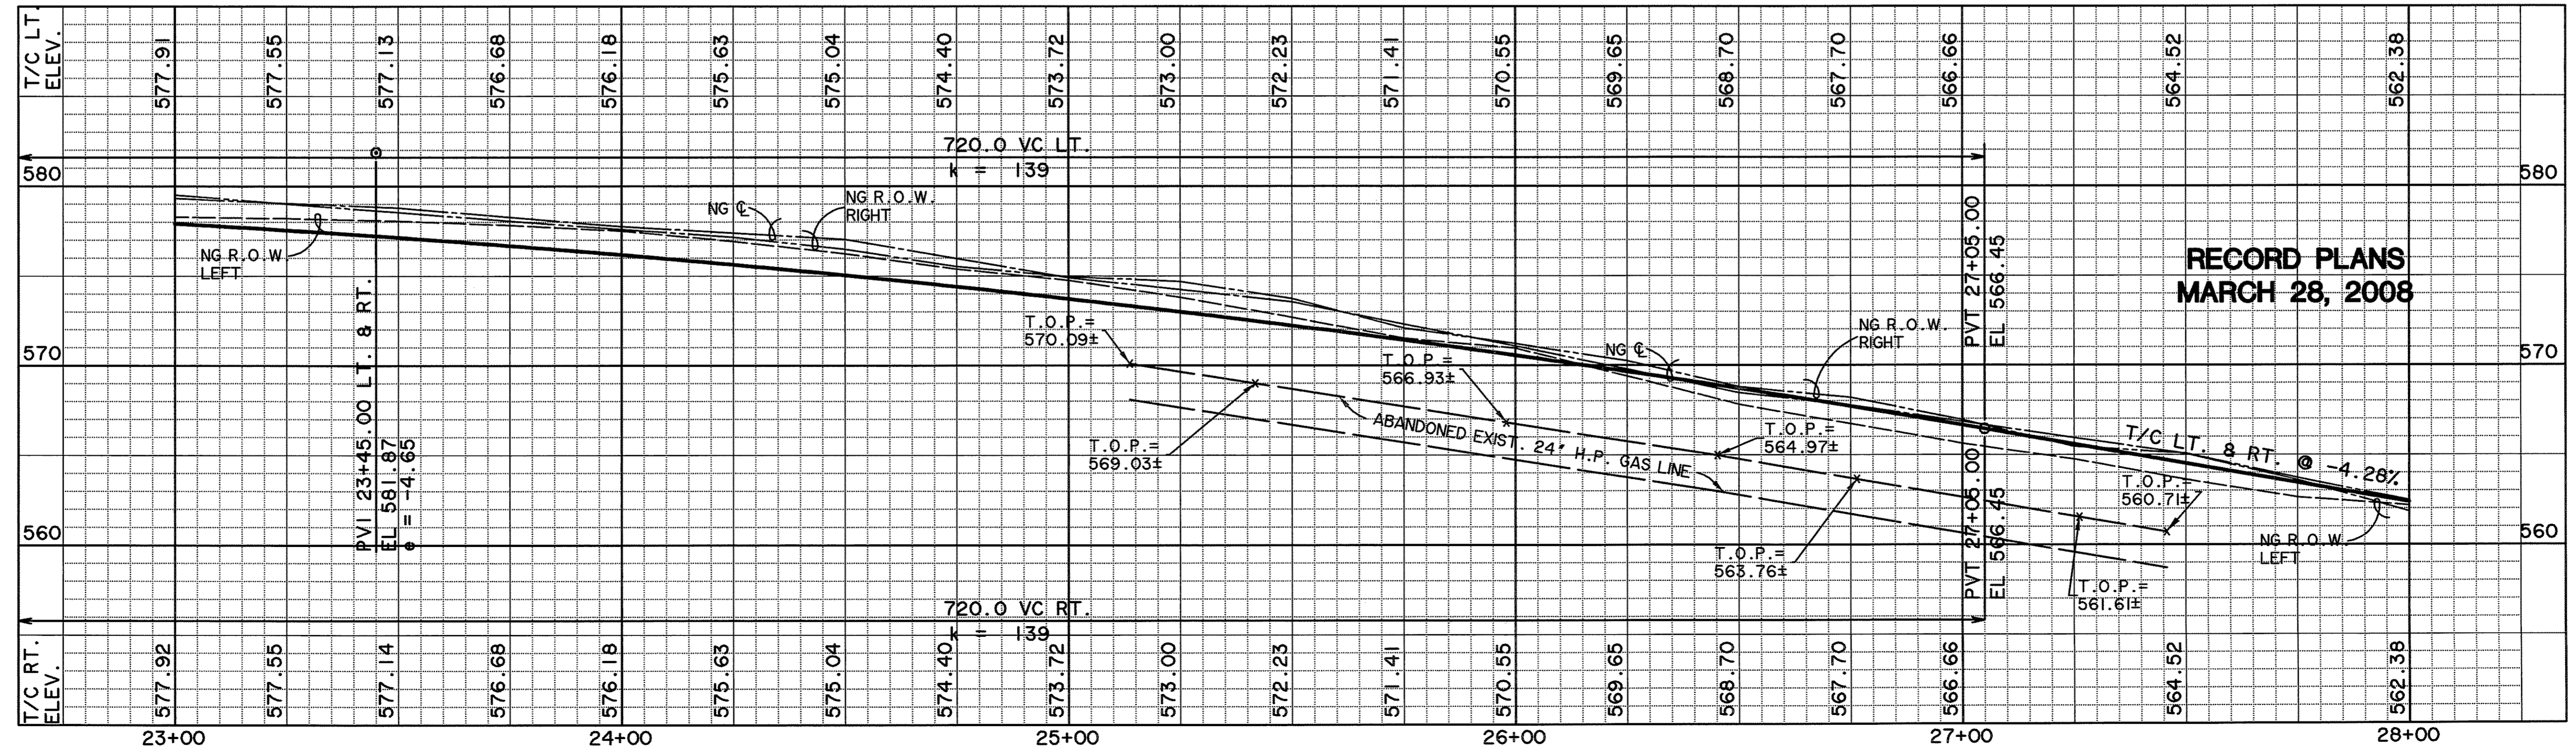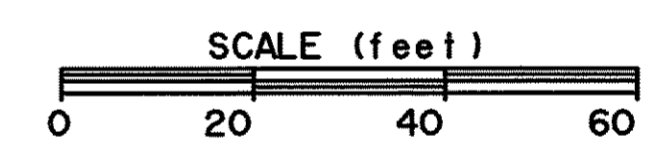


RECORD PLANS  
 MARCH 28, 2008

PREPARED BY:  
**VIA WIER & ASSOCIATES, INC.**  
 ENGINEERS SURVEYORS LAND PLANNERS  
 4300 BELWAY PLACE SUITE 130 ARLINGTON, TEXAS 76018 METRO (817)467-7700  
 1380 U.S. HIGHWAY 287 N. SUITE 101 WANSFRED, TEXAS 76663 METRO (817)477-9700  
 6848 ELM STREET PRISCO, TEXAS 75034 METRO (214)387-8800  
 www.wierassociates.com

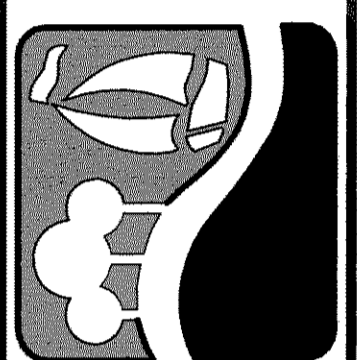

PHASE I S.H. 205 BYPASS  
 FROM SH. 276 TO INTERSTATE 30  
 PAVING  
 PLAN & PROFILE  
 STA 23+00 TO 28+00

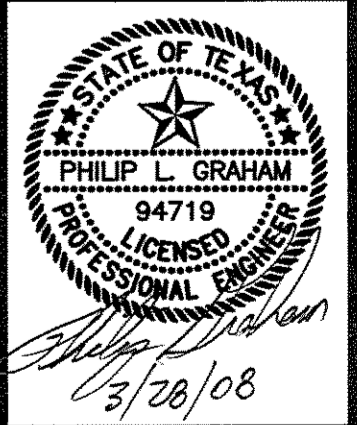

COPYRIGHT ©  
 WIER & ASSOCIATES, INC.  
 LAST SHEET EDIT  
 DATE 03-28-2008  
 WA# 04141  
 SHEET NO.  
 P103

TIME: 6:37 FILE: 04141-PAVE3.dwg



10-31-07	CHANGED S.H. 205 BYPASS TO CITY SECTION	JRA	
NO.	DATE	DESCRIPTION	BY

***BENCHMARKS***


1. BOX CUT WITH 'X' CUT IN CENTER OF EXISTING SIDEWALK 2' SOUTH OF NORTH EDGE AT SOUTHEAST CORNER OF S.H. No. 205 BYPASS AND S.H. No. 276  
ELEV. 580.40

2. BOX CUT ON SOUTHEAST TOP OF HEADWALL ON SOUTH SIDE OF I.H. No. 30 ACCESS ROAD APPROX. 325' EAST OF FUTURE S.H. No. 205 BYPASS AND ON WEST SIDE OF NESBIT METAL CO. ORANGE METAL BLDG.  
ELEV. 573.70

THE CAMBRIDGE COMPANIES, INC.  
TRUSTEE  
VOL. 99, PG. 1022  
D.R.R.C.T.

STA 31+00 S.H. 205 BYPASS  
OFF 50.50' LT.  
CONST. 10' REC. CURB INLET  
TOP = 550.78

STA 28+50.00 S.H. 205 BYPASS  
OFF 50.50' LT.  
CONST. 10' REC. CURB INLET  
TOP = 560.24  
E = 555.24

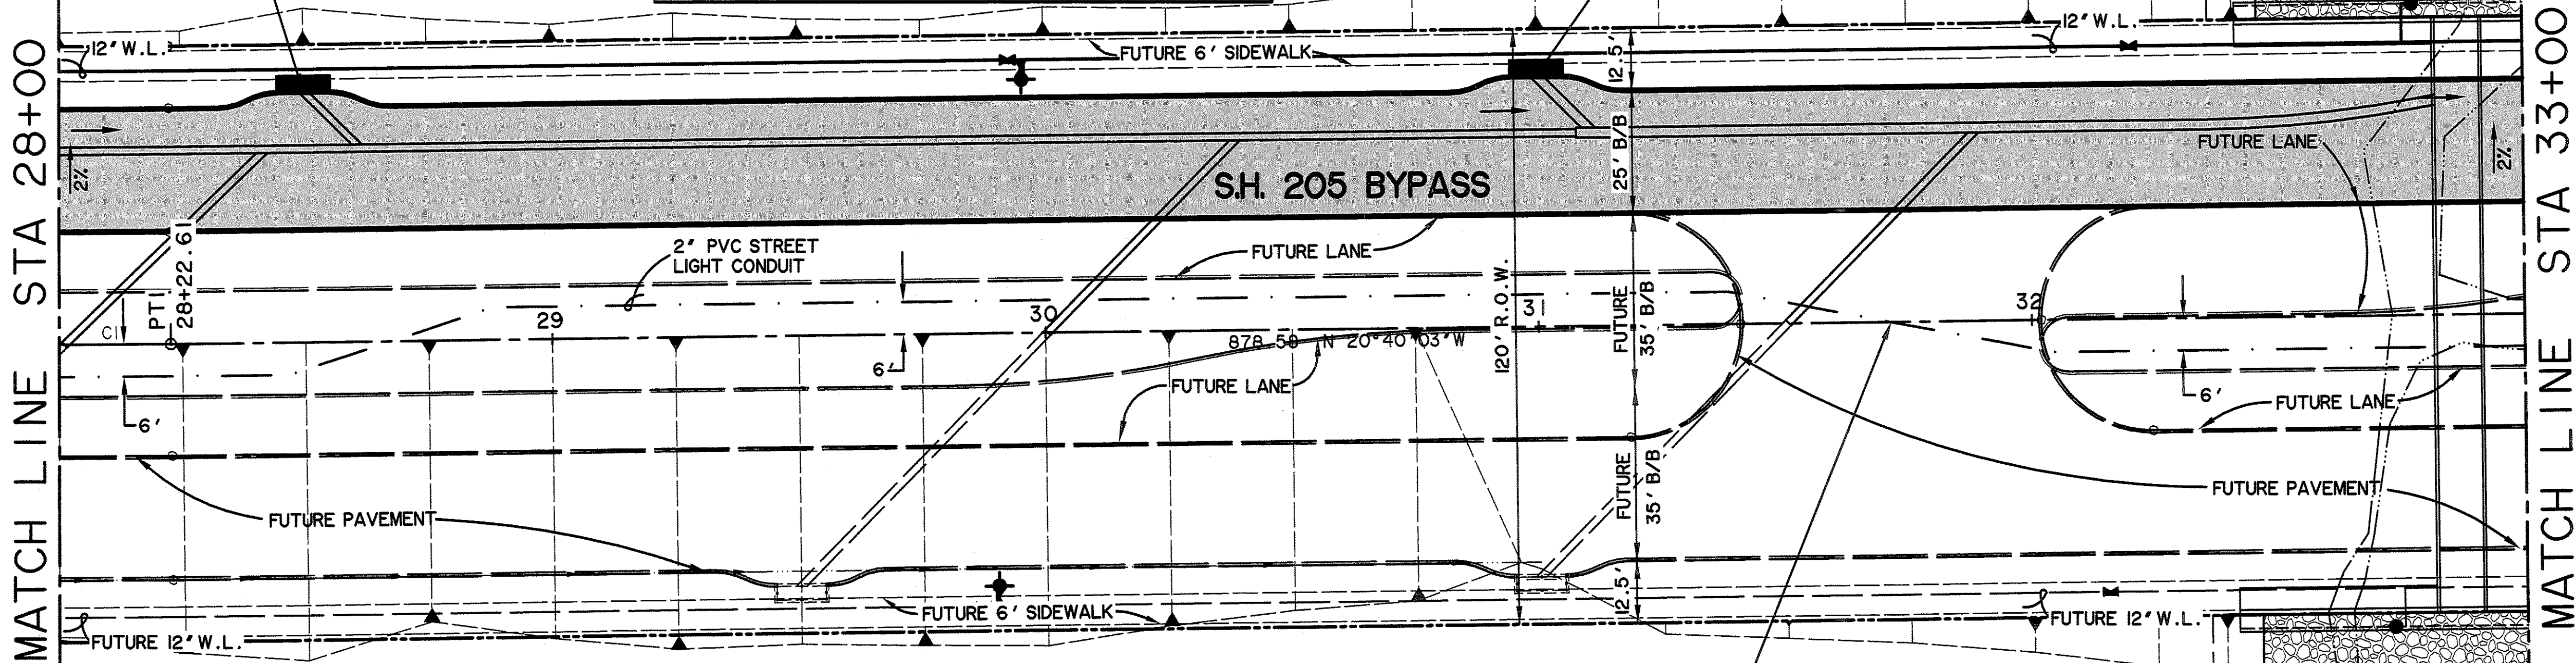

STA 32+71.42 S.H. No. 205 BYPASS  
CENTER OF FUTURE 60' WIDE MEDIAN OPENING



THE CAMBRIDGE COMPANIES, INC.  
TRUSTEE  
VOL. 99, PG. 1022  
D.R.R.C.T.

**CURVE CI**

A	19°35'45"
D	02°17'31"
R	2500.00'
T	431.73'
L	855.03'
E	37.00'


**CAUTION !!**  
EXISTING UTILITIES ARE INDICATED ON THE PLANS FROM AVAILABLE INFORMATION. IT SHALL BE THE RESPONSIBILITY OF THE CONTRACTOR TO VERIFY THE LOCATION OF ALL UTILITIES, TO NOTIFY ALL UTILITY COMPANIES OF THE CONTRACTORS OPERATIONS, TO PROTECT ALL UTILITIES FROM DAMAGE, TO REPAIR ALL UTILITIES DAMAGED DUE TO THE CONTRACTORS OPERATIONS, AND TO NOTIFY THE ENGINEER PROMPTLY OF ALL CONFLICTS OF THE WORK WITH EXISTING UTILITIES.

**S . H . 2 0 5 B Y P A S S**

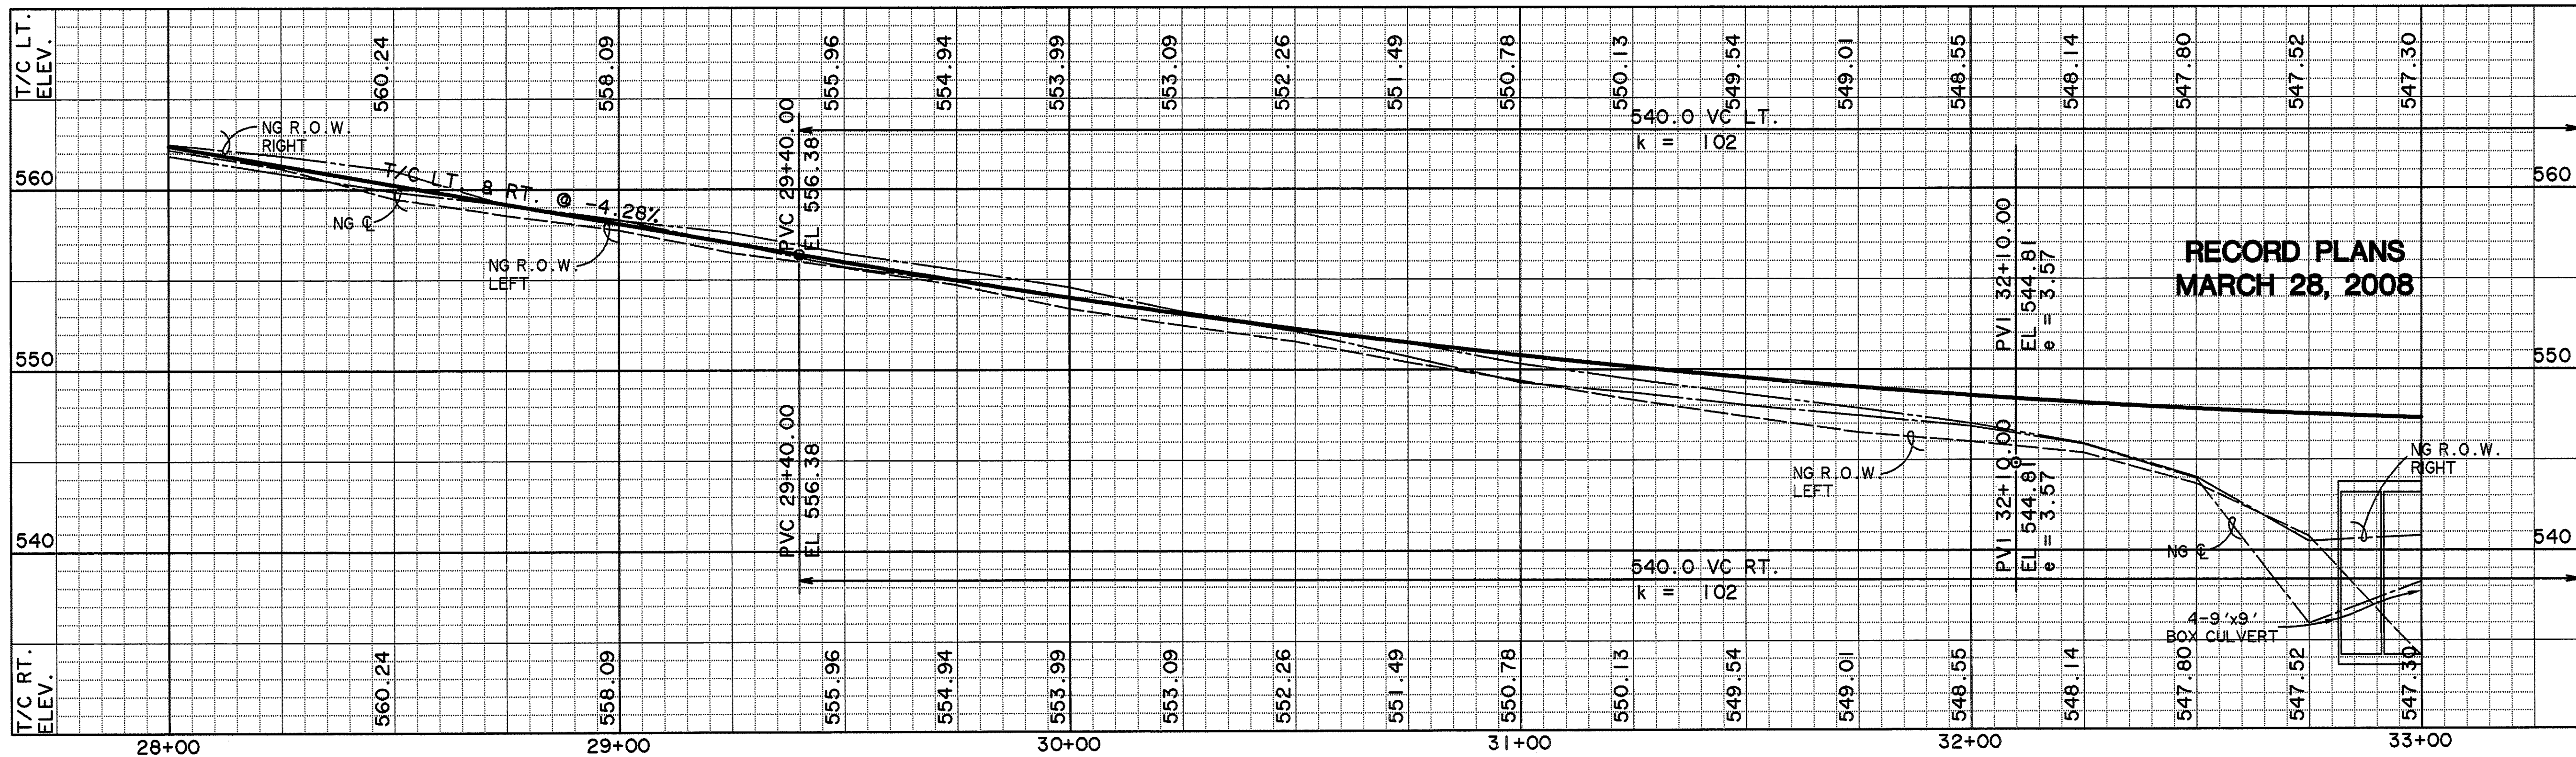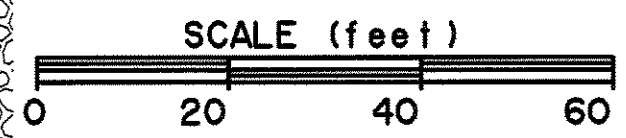


**RECORD PLANS  
MARCH 28, 2008**

PREPARED BY:  
**WIA WIER & ASSOCIATES, INC.**  
ENGINEERS SURVEYORS LAND PLANNERS  
4300 BELWAY PLACE SUITE 130 ARLINGTON, TEXAS 76018 METRO (817)467-7700  
1300 U.S. HIGHWAY 287 N. SUITE 101 WANSFELD, TEXAS 76063 METRO (817)477-8700  
6849 ELM STREET FRODO, TEXAS 75054 METRO (214)397-8000  
www.wiaassociates.com

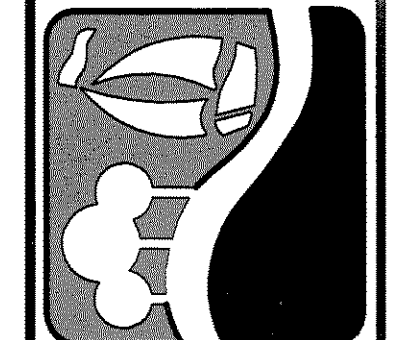

**PHASE I S.H. 205 BYPASS  
FROM S.H. 276 TO INTERSTATE 30  
PAVING  
PLAN & PROFILE  
STA 28+00 TO 33+00**

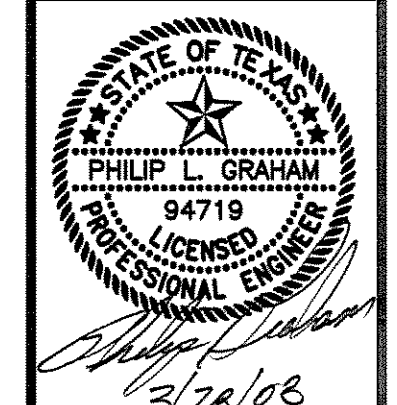

3/28/08  
COPYRIGHT ©  
WIER & ASSOCIATES, INC.  
LAST SHEET EDIT  
DATE 03-28-2008  
WA# 04141  
**SHEET NO.  
P104**

10-31-07	CHANGED S.H. 205 BYPASS TO CITY SECTION	JRA	
NO.	DATE	DESCRIPTION	BY

STA 33+80.00 S.H. 205 BYPASS  
 OFF 50.50' LT.  
 CONST. 15' REC. CURB INLET  
 TOP = 547.00  
 R = 542.00


THE CAMBRIDGE COMPANIES, INC.  
 TRUSTEE  
 VOL. 99 PG. 1022  
 D.R.R.C.T.

*BENCHMARK*

1. BOX CUT WITH 'X' CUT IN CENTER OF EXISTING SIDEWALK 2' SOUTH OF NORTH EDGE AT SOUTHEAST CORNER OF S.H. No. 205 BYPASS AND S.H. No. 276  
 ELEV. 580.40



2. BOX CUT ON SOUTHEAST TOP OF HEADWALL ON SOUTH SIDE OF I.H. No. 30 ACCESS ROAD APPROX. 325' EAST OF FUTURE S.H. No. 205 BYPASS AND ON WEST SIDE OF NESBIT METAL CO. ORANGE METAL BLDG.  
 ELEV. 573.70

CURVE C2	
A	20°19'45"
B	02°56'18"
PC	1950.00
PT	349.62
PI	691.88
ET	31.09

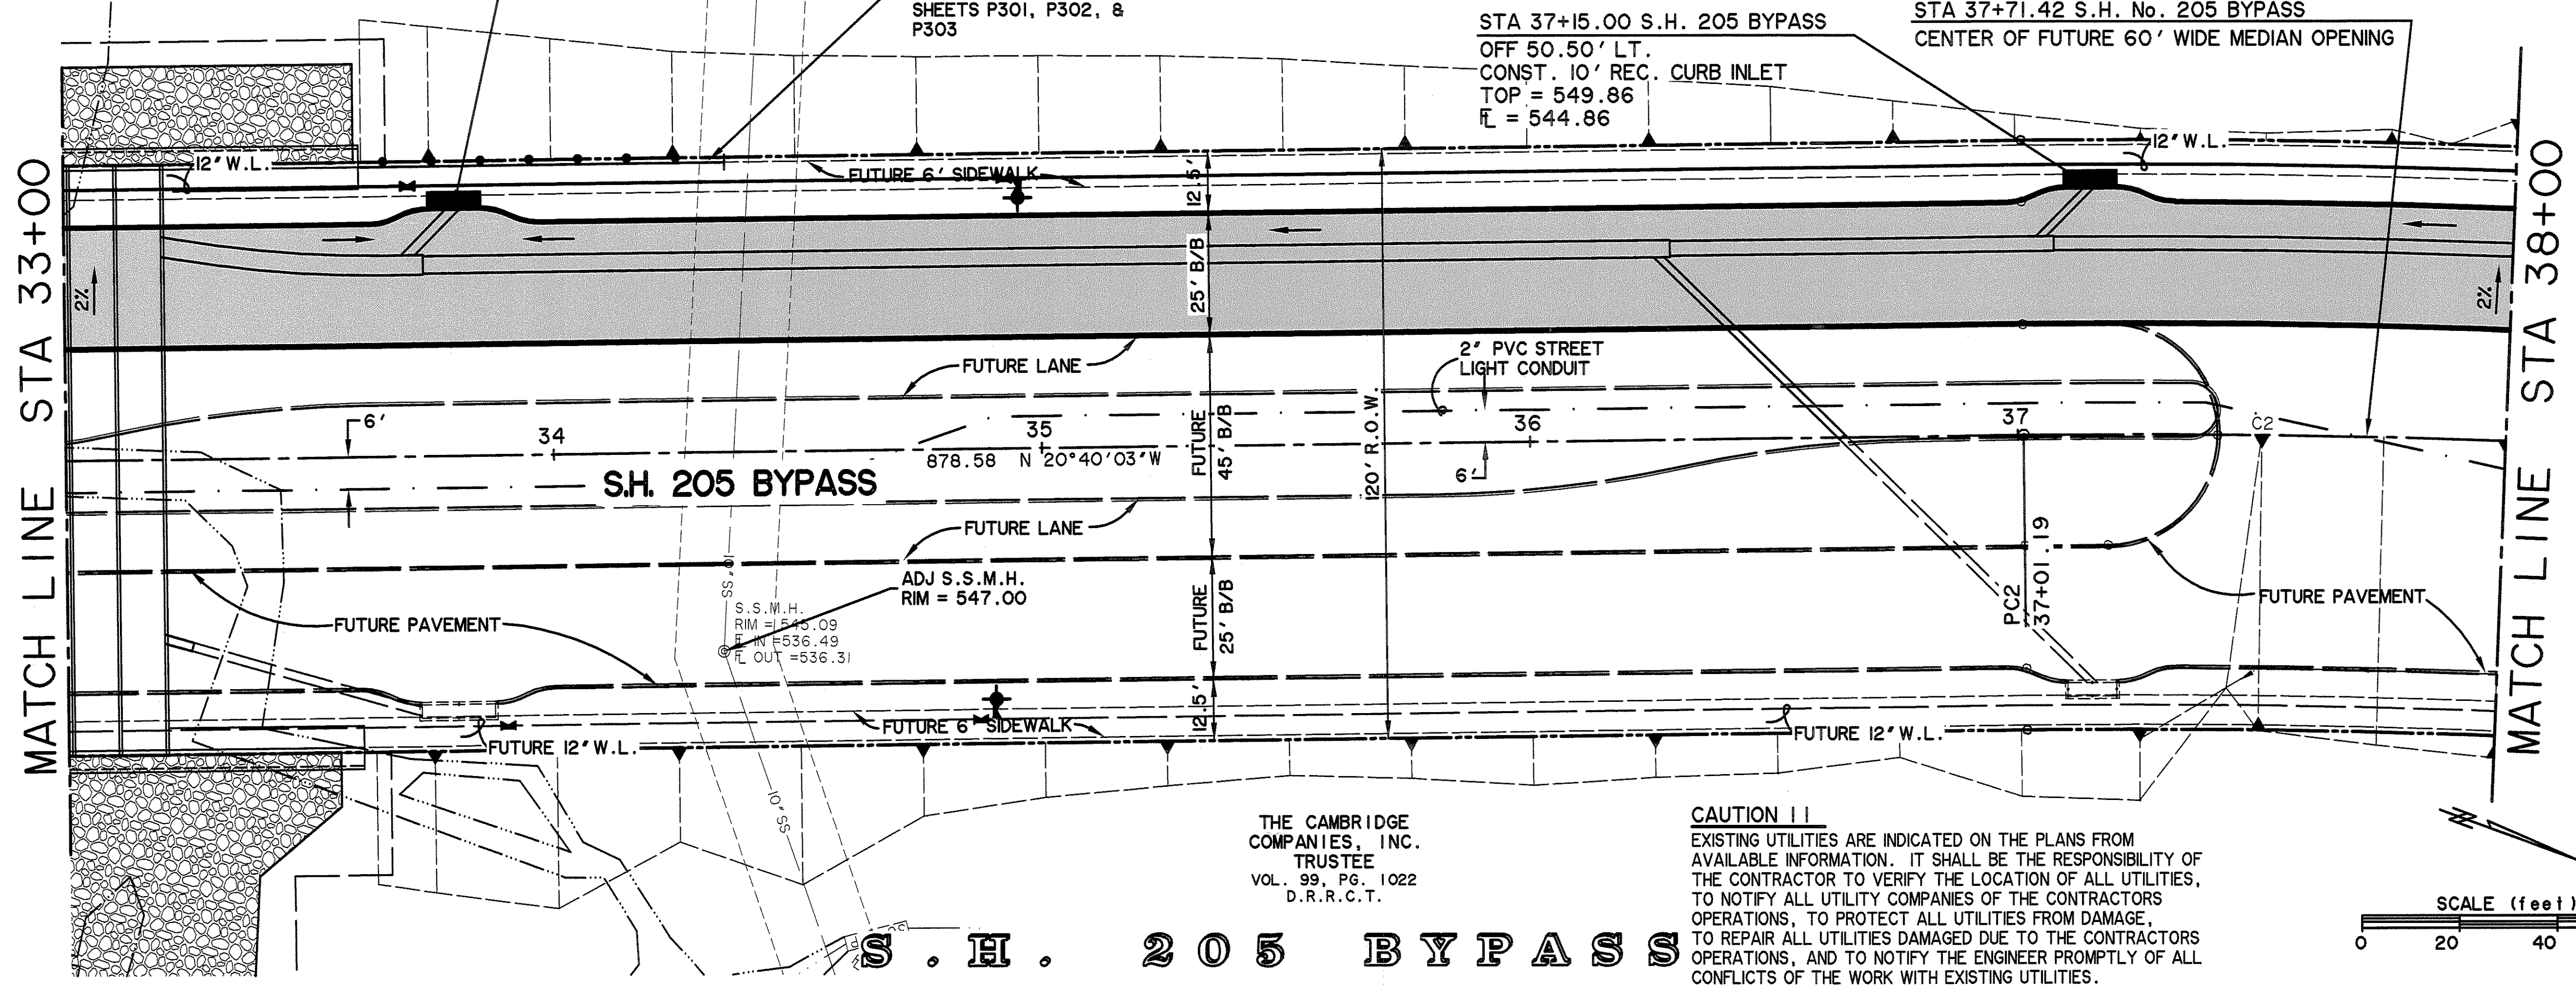


THE CAMBRIDGE COMPANIES, INC.  
 TRUSTEE  
 VOL. 99 PG. 1022  
 D.R.R.C.T.

**CAUTION !!**  
 EXISTING UTILITIES ARE INDICATED ON THE PLANS FROM AVAILABLE INFORMATION. IT SHALL BE THE RESPONSIBILITY OF THE CONTRACTOR TO VERIFY THE LOCATION OF ALL UTILITIES, TO NOTIFY ALL UTILITY COMPANIES OF THE CONTRACTORS OPERATIONS, TO PROTECT ALL UTILITIES FROM DAMAGE, TO REPAIR ALL UTILITIES DAMAGED DUE TO THE CONTRACTORS OPERATIONS, AND TO NOTIFY THE ENGINEER PROMPTLY OF ALL CONFLICTS OF THE WORK WITH EXISTING UTILITIES.

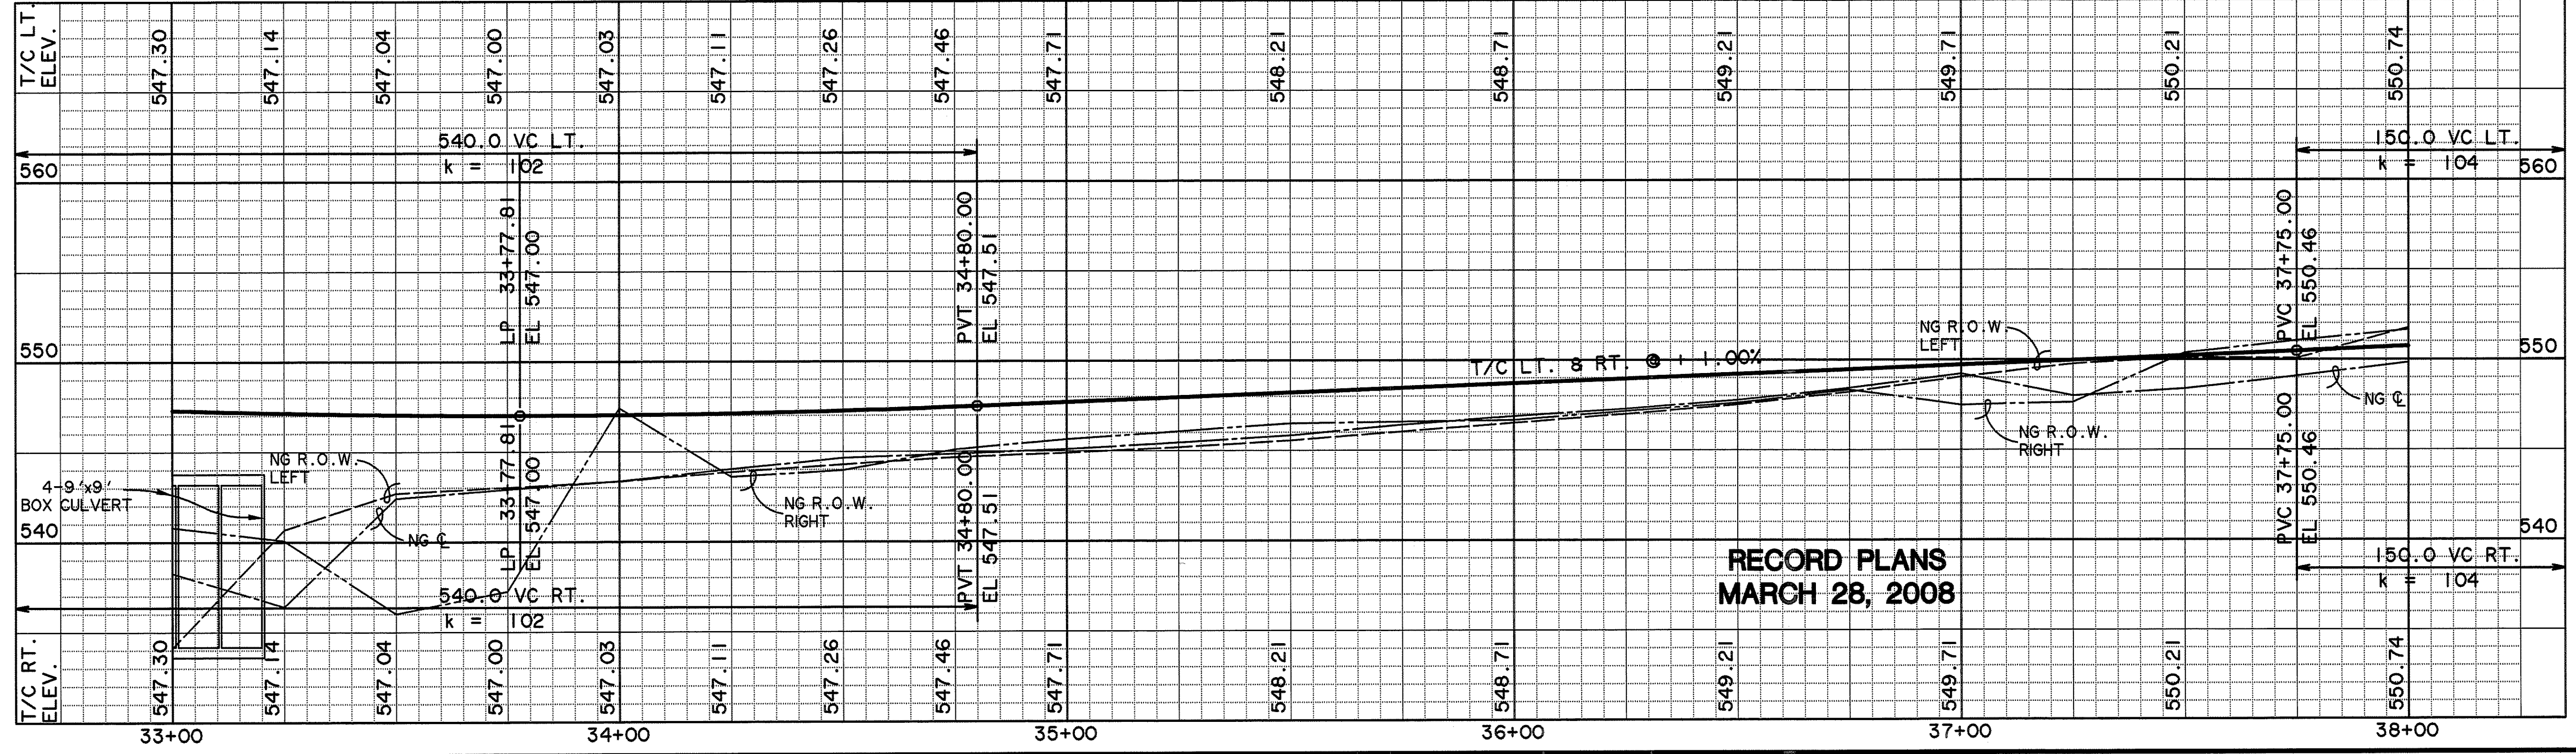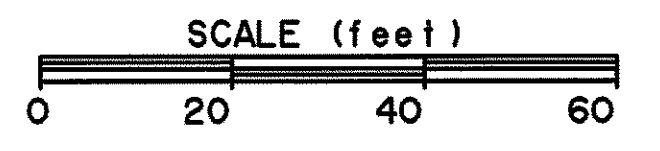


**RECORD PLANS**  
**MARCH 28, 2008**

PREPARED BY:  
**WIER & ASSOCIATES, INC.**  
 ENGINEERS SURVEYORS LAND PLANNERS  
 4300 BELTWAY PLACE SUITE 130 ARLINGTON, TEXAS 76018 METRO (817)467-7700  
 1300 U.S. HIGHWAY 287 N. SUITE 101 WAXSFELD, TEXAS 76063 METRO (817)477-9700  
 6848 ELM STREET FRSO3, TEXAS 75034 METRO (214)387-8000  
 www.wierassociates.com

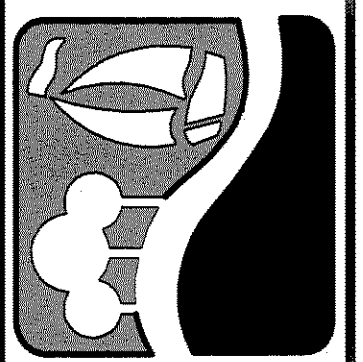

**PHASE I S.H. 205 BYPASS**  
**FROM S.H. 276 TO INTERSTATE 30**  
**PAVING**  
**PLAN & PROFILE**  
 STA 33+00 TO 38+00

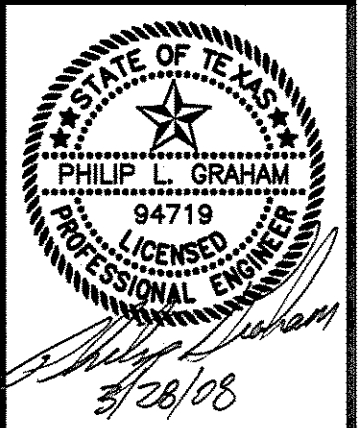

COPYRIGHT ©  
 WIER & ASSOCIATES, INC.  
 LAST SHEET EDIT  
 DATE: 03-28-2008  
 WA# 04181  
**SHEET NO.**  
**P105**

TIME: 6:38 FILE: 04141-PAVES.dwg


**CAUTION !!**  
 EXISTING UTILITIES ARE INDICATED ON THE PLANS FROM AVAILABLE INFORMATION. IT SHALL BE THE RESPONSIBILITY OF THE CONTRACTOR TO VERIFY THE LOCATION OF ALL UTILITIES, TO NOTIFY ALL UTILITY COMPANIES OF THE CONTRACTORS OPERATIONS, TO PROTECT ALL UTILITIES FROM DAMAGE, TO REPAIR ALL UTILITIES DAMAGED DUE TO THE CONTRACTORS OPERATIONS, AND TO NOTIFY THE ENGINEER PROMPTLY OF ALL CONFLICTS OF THE WORK WITH EXISTING UTILITIES.

THE CAMBRIDGE COMPANIES, INC. TRUSTEE  
 VOL. 99, PG. 1022  
 D.R.R.C.T.

STA 40+50.00 S.H. 205 BYPASS  
 OFF 50.50' LT.  
 CONST. 10' REC. CURB INLET  
 TOP = 556.09  
 FL = 551.09


STA 41+51.32 S.H. 205 BYPASS  
 OFF 71.46' LT.  
 Q 4'x4' DROP INLET  
 TOP = 560.43  
 THROAT = 559.43  
 FL = 554.93

***BENCHMARK***  
 1. BOX CUT WITH 'X' CUT IN CENTER OF EXISTING SIDEWALK 2' SOUTH OF NORTH EDGE AT SOUTHEAST CORNER OF S.H. No. 205 BYPASS AND S.H. No. 276  
 ELEV. 580.40  
 2. BOX CUT ON SOUTHEAST TOP OF HEADWALL ON SOUTH SIDE OF I.H. No. 30 ACCESS ROAD APPROX. 325' EAST OF FUTURE S.H. No. 205 BYPASS AND ON WEST SIDE OF NESBIT METAL CO. ORANGE METAL BLDG.  
 ELEV. 573.70

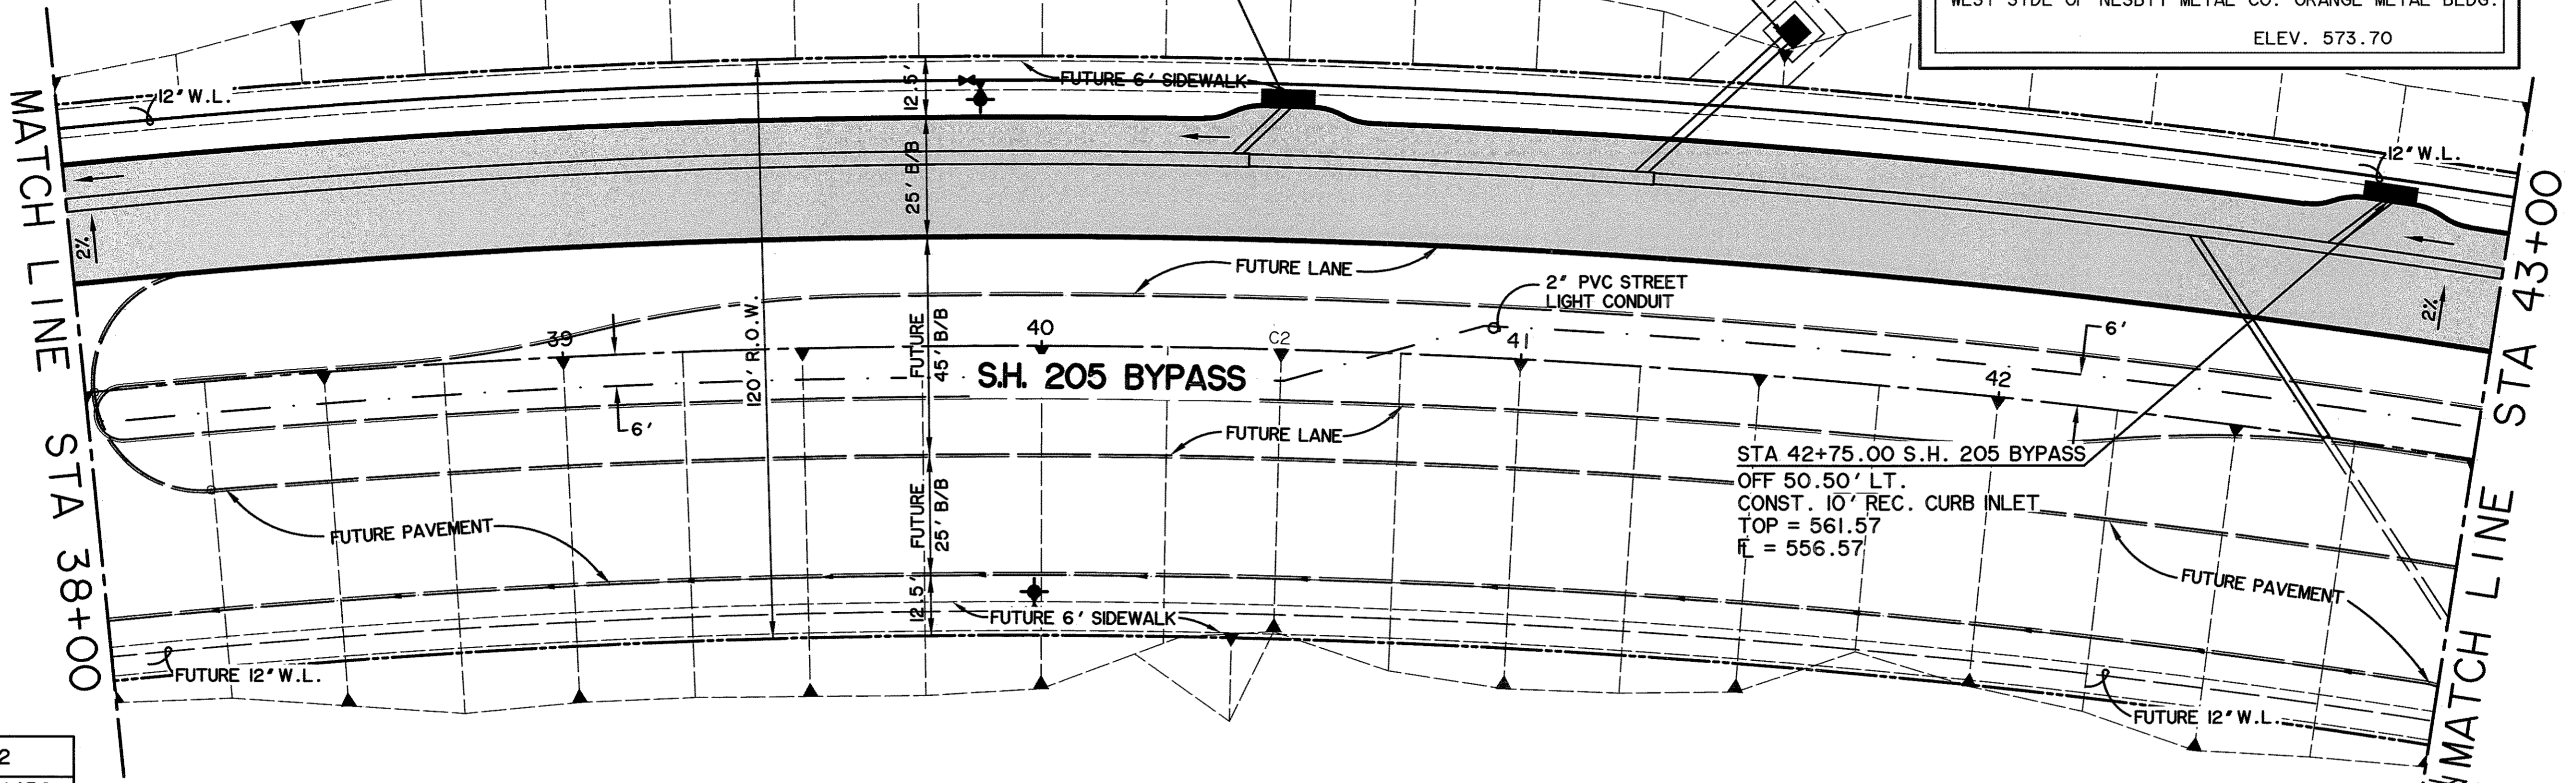


CURVE C2	
A	20° 19' 45"
D	02° 56' 18"
T	1950.00
L	349.62
E	691.88
	31.09

THE CAMBRIDGE COMPANIES, INC. TRUSTEE  
 VOL. 99, PG. 1022  
 D.R.R.C.T.

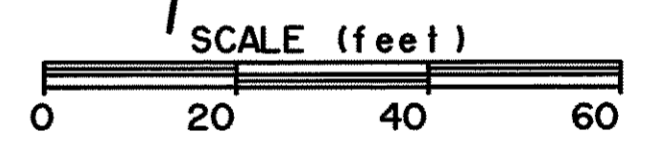


**S . H . 2 0 5 B Y P A S S**

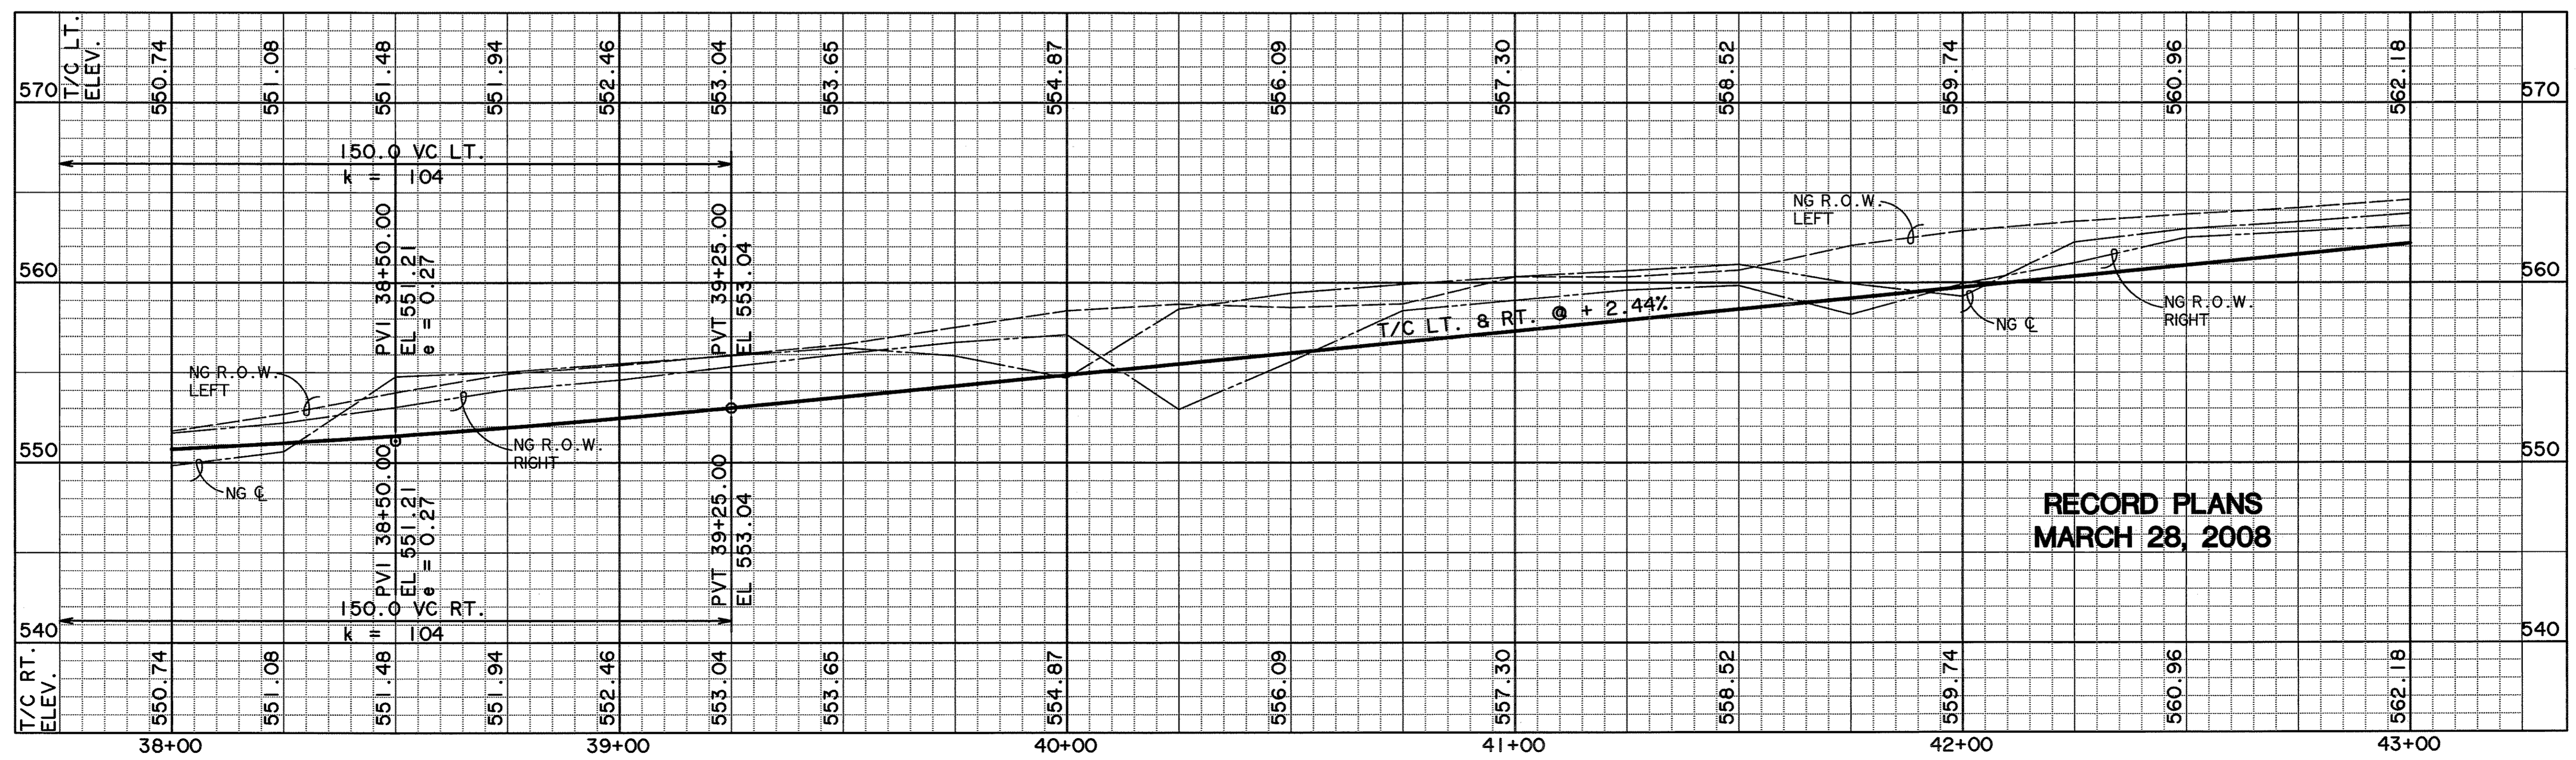


**RECORD PLANS  
 MARCH 28, 2008**

PREPARED BY:  
**VIA WIER & ASSOCIATES, INC.**  
 ENGINEERS SURVEYORS LAND PLANNERS  
 4300 BELTWAY PLACE SUITE 130 ARLINGTON, TEXAS 76018 METRO (817)467-7700  
 1380 U.S. HIGHWAY 287 N. SUITE 101 WANSFELD, TEXAS 76783 METRO (817)477-8700  
 6848 ELI STREET PERCO, TEXAS 75084 METRO (214)387-8000  
 www.viawier.com


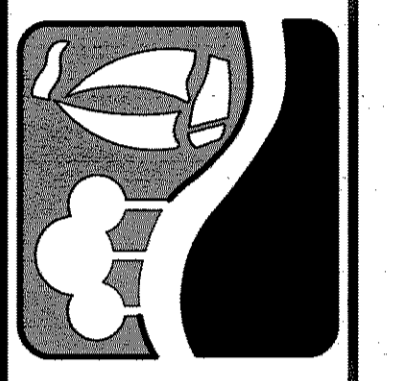


**PHASE I S.H. 205 BYPASS  
 FROM S.H. 276 TO INTERSTATE 30  
 PAVING  
 PLAN & PROFILE  
 STA 38+00 TO 43+00**

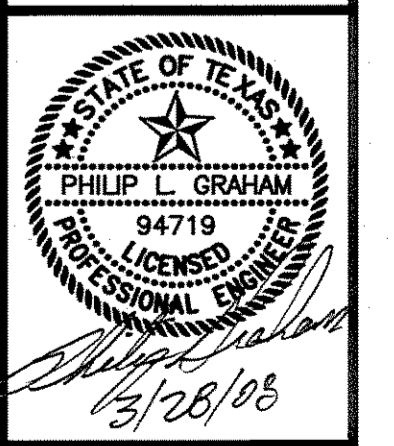

COPYRIGHT ©  
 WIER & ASSOCIATES, INC.  
 LAST SHEET EDIT  
 DATE 03-28-2008  
 WA# 04141  
**SHEET NO.  
 P106**

TIME 6:40 FILE: 04141-PAVE6.dwg

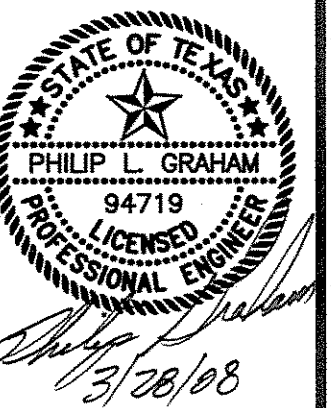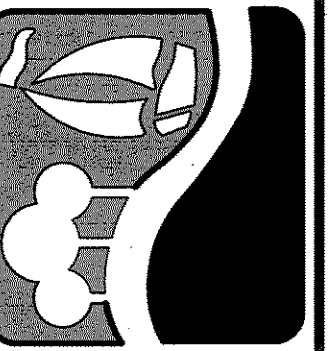

***BENCHMARKS***  
 1. BOX CUT WITH 'X' CUT IN CENTER OF EXISTING SIDEWALK 2' SOUTH OF NORTH EDGE AT SOUTHEAST CORNER OF S.H. No. 205 BYPASS AND S.H. No. 276  
 ELEV. 580.40  
 2. BOX CUT ON SOUTHEAST TOP OF HEADWALL ON SOUTH SIDE OF I.H. No. 30 ACCESS ROAD APPROX. 325' EAST OF FUTURE S.H. No. 205 BYPASS AND ON WEST SIDE OF NESBIT METAL CO. ORANGE METAL BLDG.  
 ELEV. 573.70

THE CAMBRIDGE COMPANIES, INC. TRUSTEE  
 VOL. 101, PG. 795  
 D.R.R.C.T.


THE CAMBRIDGE COMPANIES, INC. TRUSTEE  
 VOL. 99, PG. 1022  
 D.R.R.C.T.

STA 45+75.00 S.H. 205 BYPASS  
 OFF 50.50' LT.  
 CONST. 10' REC. CURB INLET  
 TOP = 568.75  
 FL = 563.75

STA 43+71.42 S.H. No. 205 BYPASS  
 CENTER OF FUTURE 60' WIDE MEDIAN OPENING

MATCH LINE STA 43+00

MATCH LINE STA 48+00

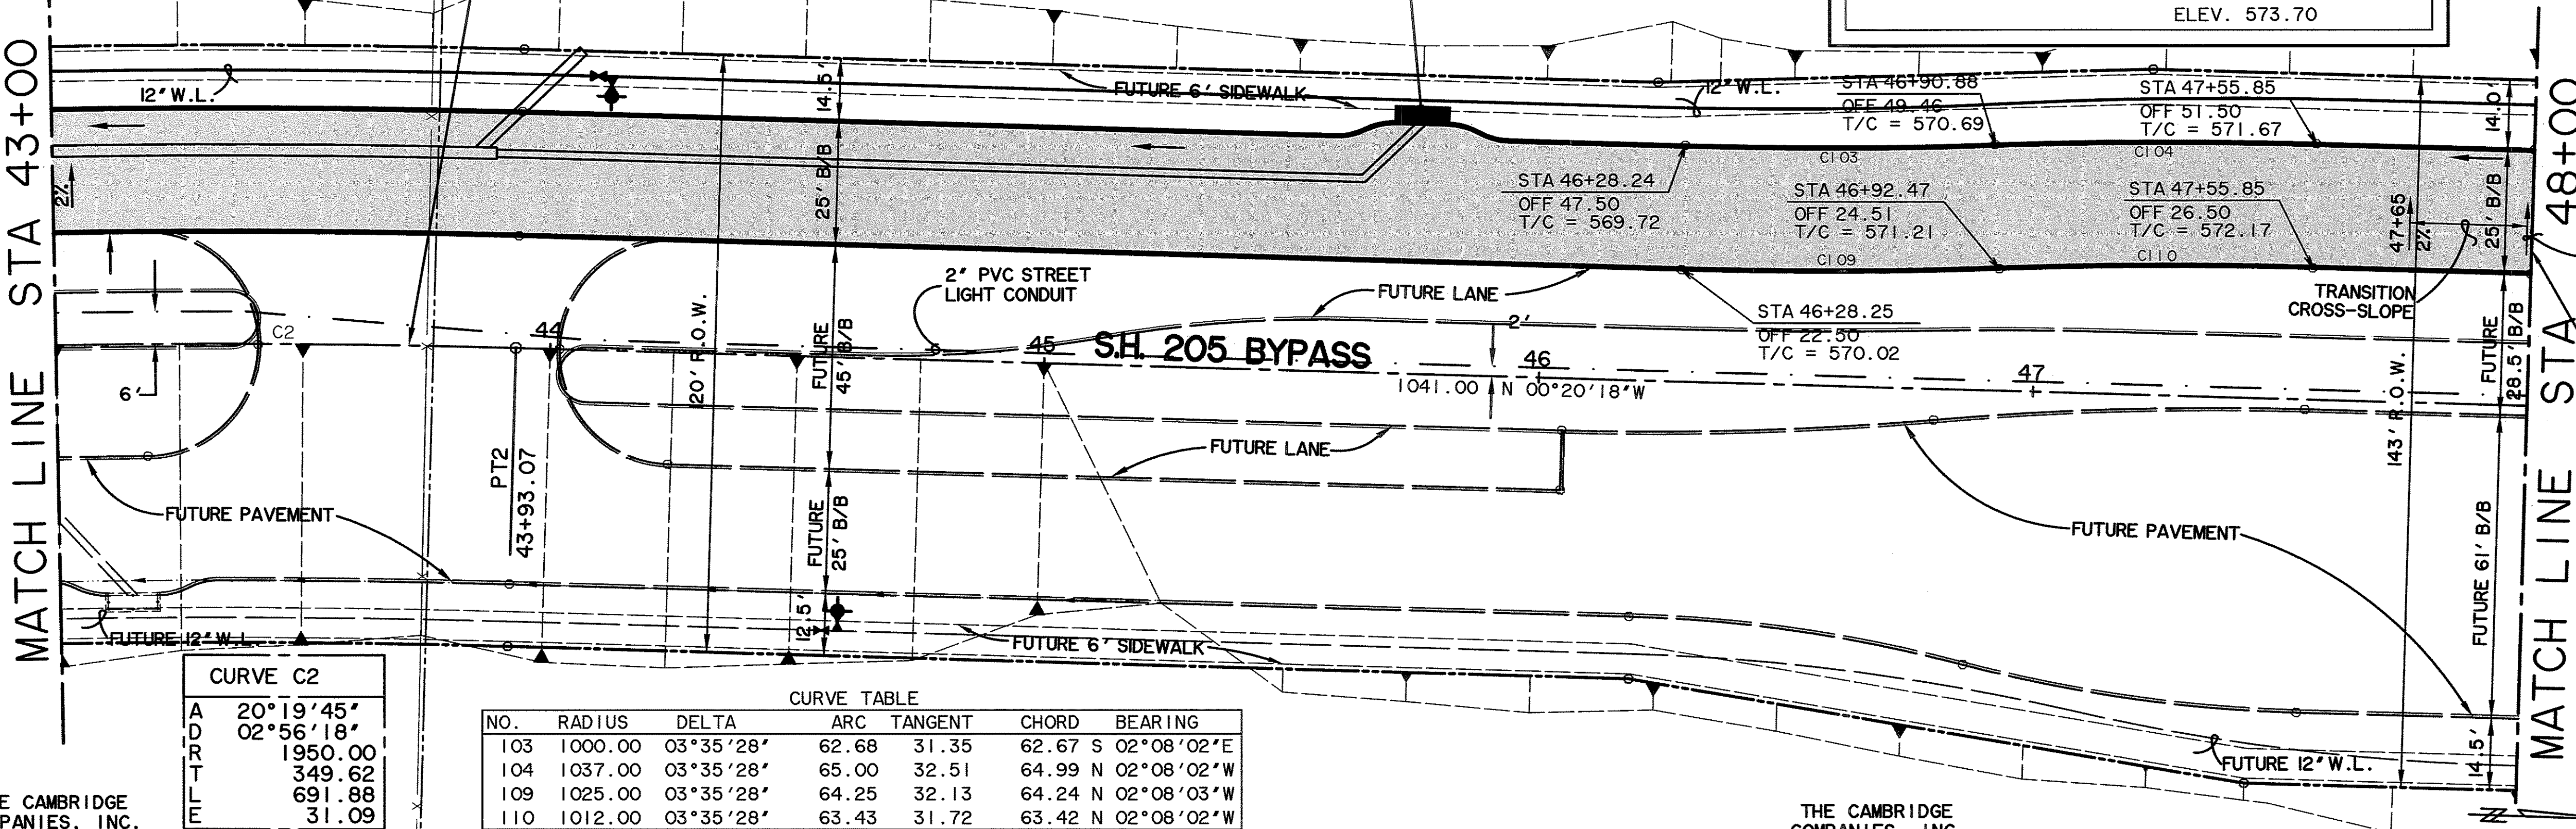

**CURVE C2**

A	20°19'45"
D	02°56'18"
R	1950.00
T	349.62
L	691.88
E	31.09



**CURVE TABLE**

NO.	RADIUS	DELTA	ARC	TANGENT	CHORD	BEARING
103	1000.00	03°35'28"	62.68	31.35	62.67	S 02°08'02"E
104	1037.00	03°35'28"	65.00	32.51	64.99	N 02°08'02"W
109	1025.00	03°35'28"	64.25	32.13	64.24	N 02°08'03"W
110	1012.00	03°35'28"	63.43	31.72	63.42	N 02°08'02"W

THE CAMBRIDGE COMPANIES, INC. TRUSTEE  
 VOL. 99, PG. 1022  
 D.R.R.C.T.

THE CAMBRIDGE COMPANIES, INC. TRUSTEE  
 VOL. 101, PG. 795  
 D.R.R.C.T.


**S . H . 2 0 5 B Y P A S S**

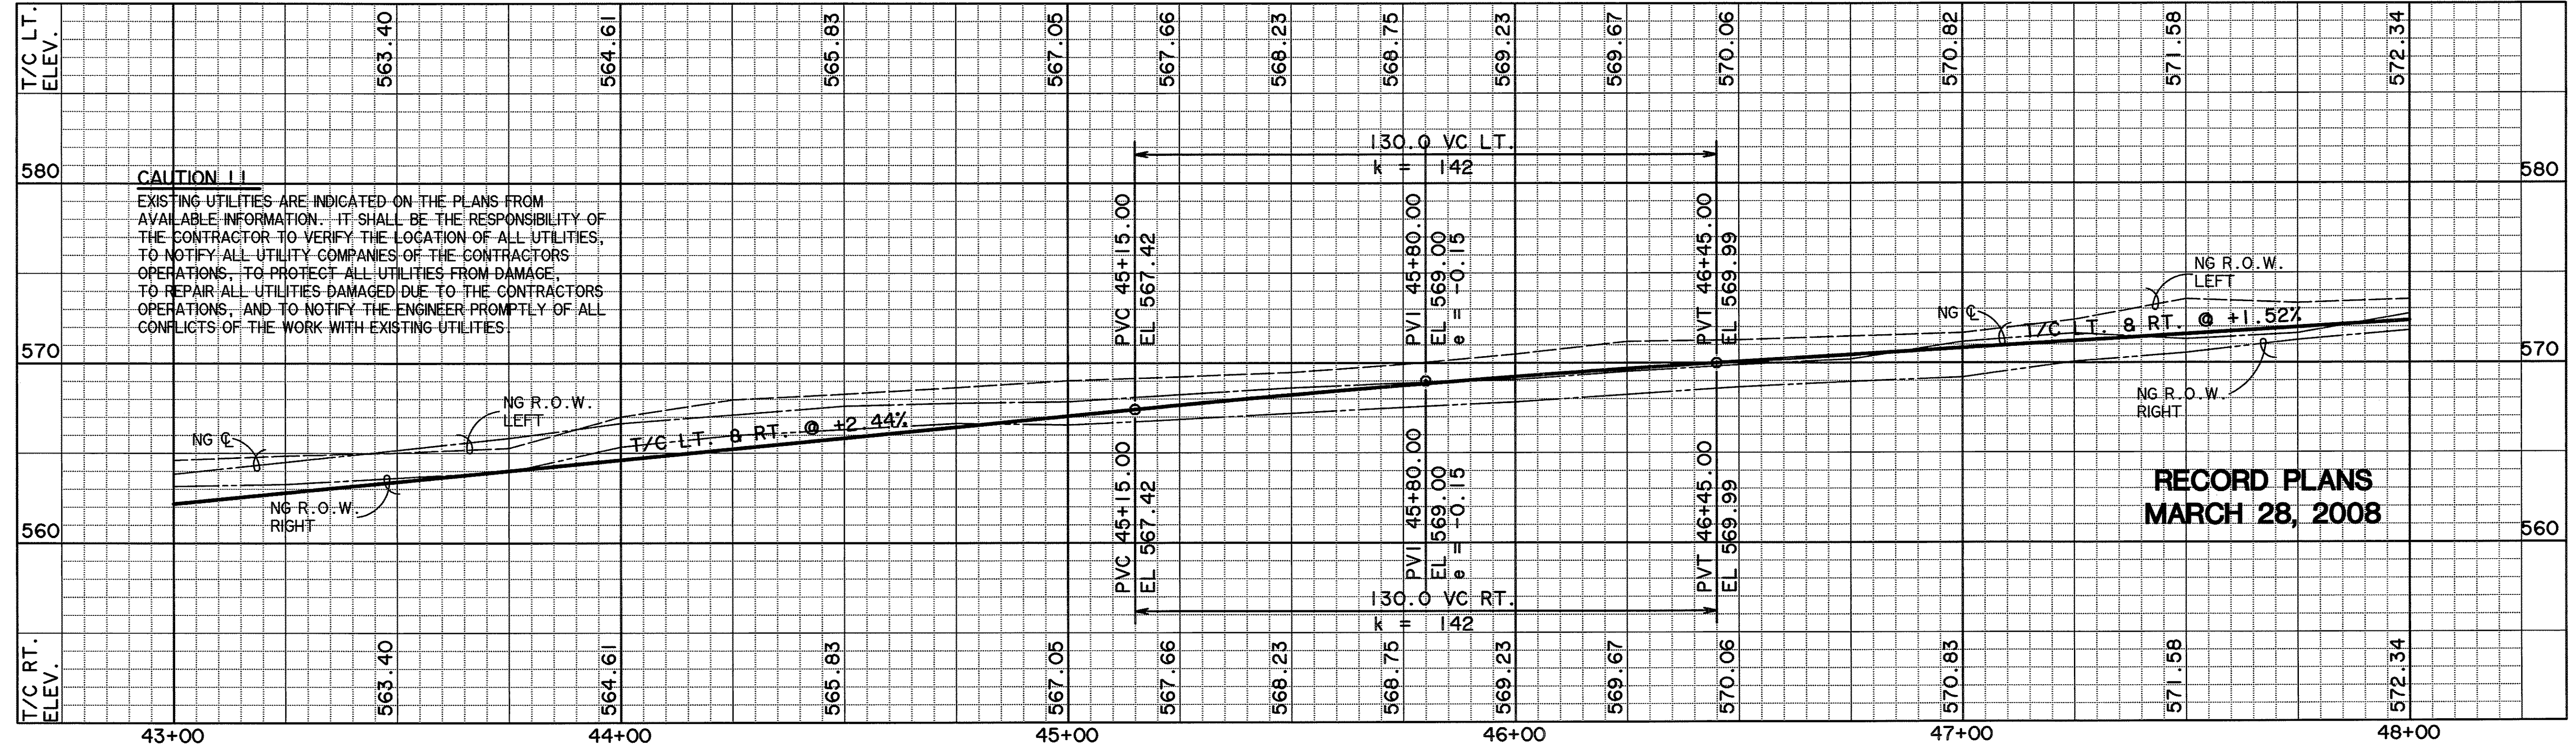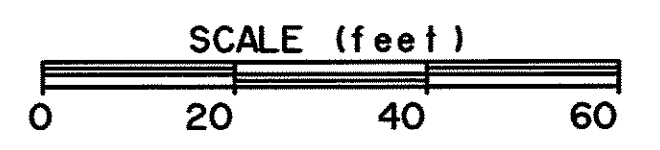

**CAUTION !!**  
 EXISTING UTILITIES ARE INDICATED ON THE PLANS FROM AVAILABLE INFORMATION. IT SHALL BE THE RESPONSIBILITY OF THE CONTRACTOR TO VERIFY THE LOCATION OF ALL UTILITIES, TO NOTIFY ALL UTILITY COMPANIES OF THE CONTRACTORS OPERATIONS, TO PROTECT ALL UTILITIES FROM DAMAGE, TO REPAIR ALL UTILITIES DAMAGED DUE TO THE CONTRACTORS OPERATIONS, AND TO NOTIFY THE ENGINEER PROMPTLY OF ALL CONFLICTS OF THE WORK WITH EXISTING UTILITIES.

**RECORD PLANS**  
**MARCH 28, 2008**

TIME 6.42 FILE: 04141-PAVES.dwg


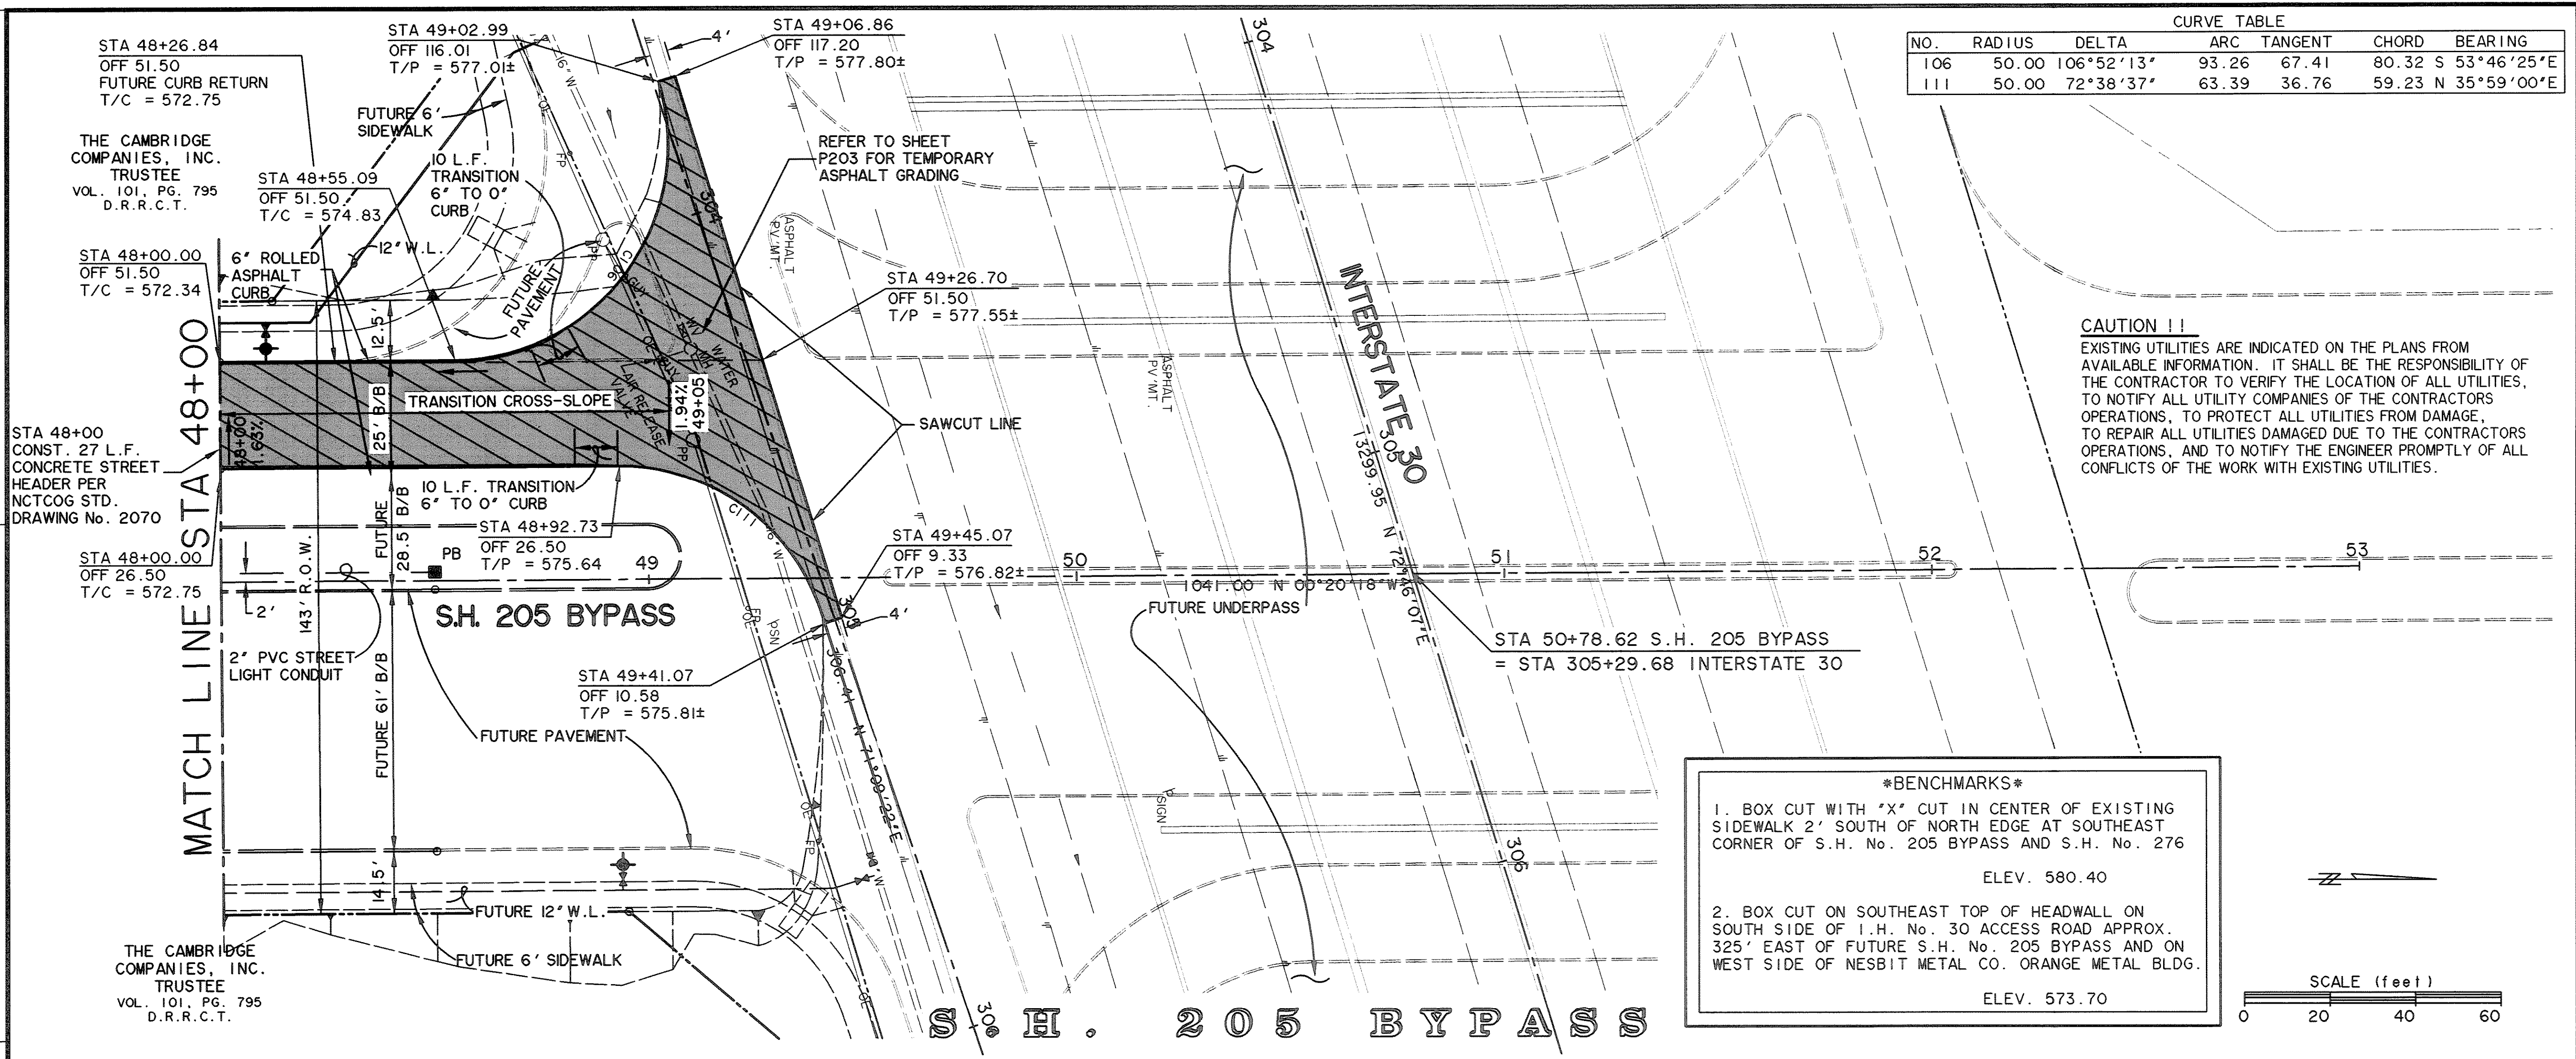


CURVE TABLE

NO.	RADIUS	DELTA	ARC TANGENT	CHORD	BEARING
106	50.00	106°52'13"	93.26	67.41	80.32 S 53°46'25"E
111	50.00	72°38'37"	63.39	36.76	59.23 N 35°59'00"E


**CAUTION !!**  
 EXISTING UTILITIES ARE INDICATED ON THE PLANS FROM AVAILABLE INFORMATION. IT SHALL BE THE RESPONSIBILITY OF THE CONTRACTOR TO VERIFY THE LOCATION OF ALL UTILITIES, TO NOTIFY ALL UTILITY COMPANIES OF THE CONTRACTORS OPERATIONS, TO PROTECT ALL UTILITIES FROM DAMAGE, TO REPAIR ALL UTILITIES DAMAGED DUE TO THE CONTRACTORS OPERATIONS, AND TO NOTIFY THE ENGINEER PROMPTLY OF ALL CONFLICTS OF THE WORK WITH EXISTING UTILITIES.

***BENCHMARK***  
 1. BOX CUT WITH "X" CUT IN CENTER OF EXISTING SIDEWALK 2' SOUTH OF NORTH EDGE AT SOUTHEAST CORNER OF S.H. No. 205 BYPASS AND S.H. No. 276  
 ELEV. 580.40  
 2. BOX CUT ON SOUTHEAST TOP OF HEADWALL ON SOUTH SIDE OF I.H. No. 30 ACCESS ROAD APPROX. 325' EAST OF FUTURE S.H. No. 205 BYPASS AND ON WEST SIDE OF NESBIT METAL CO. ORANGE METAL BLDG.  
 ELEV. 573.70

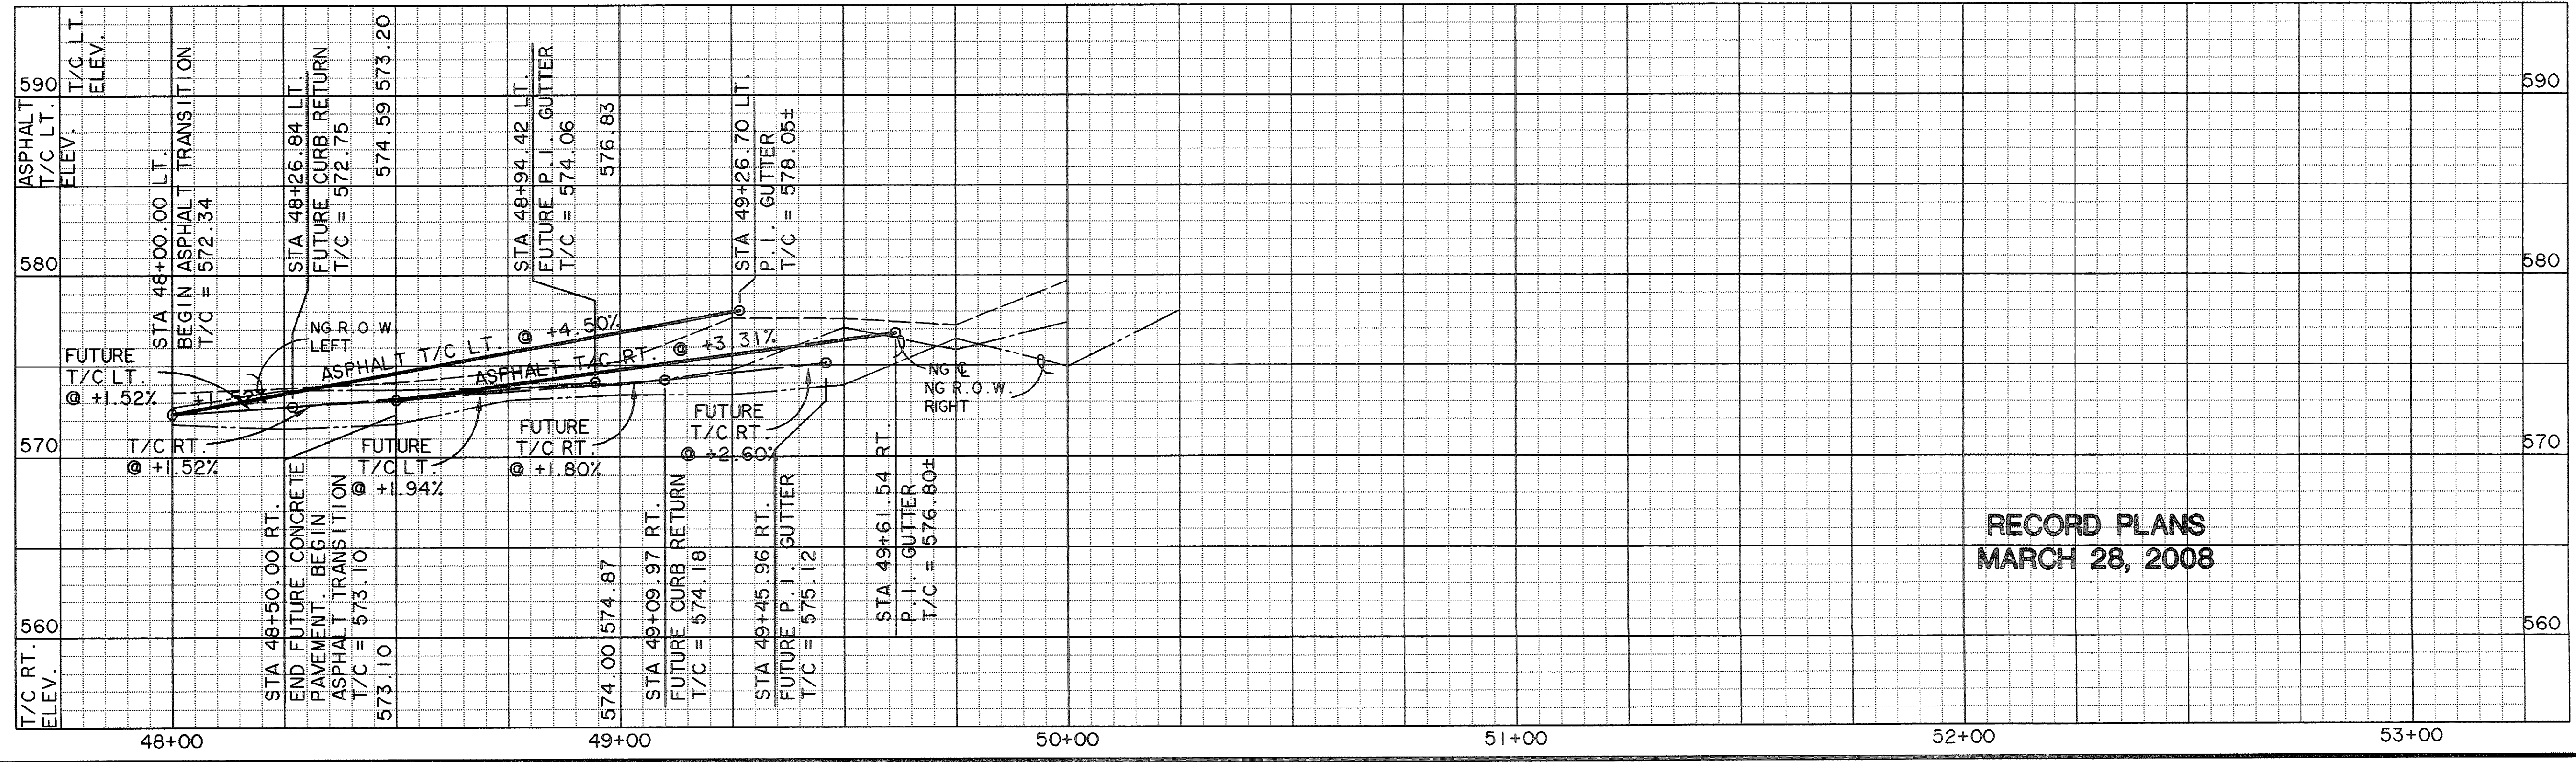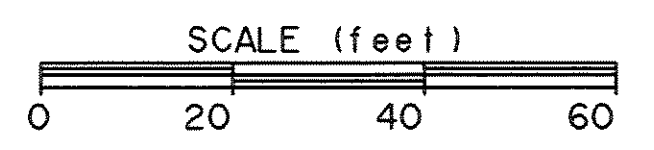


RECORD PLANS  
 MARCH 28, 2008

PREPARED BY:  
**WIA WIER & ASSOCIATES, INC.**  
 ENGINEERS SURVEYORS LAND PLANNERS  
 4300 BELWAY PLACE SUITE 130 ARLINGTON, TEXAS 76018 METRO (817)467-7700  
 1380 U.S. HIGHWAY 287 N. SUITE 101 MANSFIELD, TEXAS 76063 METRO (817)477-8700  
 6849 ELM STREET FRSO, TEXAS 75034 METRO (214)387-8000  
 www.wierassociates.com

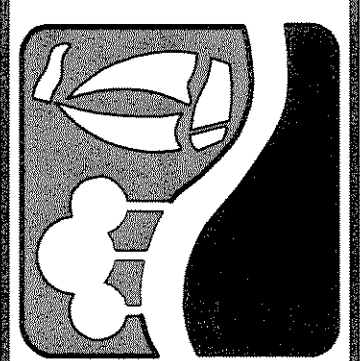

PHASE I S.H. 205 BYPASS  
 FROM S.H. 276 TO INTERSTATE 30  
 PAVING  
 PLAN & PROFILE  
 STA 48+00 TO END

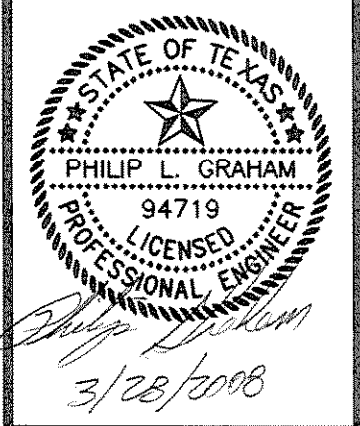

COPYRIGHT ©  
 WIER & ASSOCIATES, INC.  
 LAST SHEET EDIT  
 DATE 03-28-2008  
 WA# 04141  
 SHEET NO.  
 P108

**CAUTION !!**


EXISTING UTILITIES ARE INDICATED ON THE PLANS FROM AVAILABLE INFORMATION. IT SHALL BE THE RESPONSIBILITY OF THE CONTRACTOR TO VERIFY THE LOCATION OF ALL UTILITIES, TO NOTIFY ALL UTILITY COMPANIES OF THE CONTRACTORS OPERATIONS, TO PROTECT ALL UTILITIES FROM DAMAGE, TO REPAIR ALL UTILITIES DAMAGED DUE TO THE CONTRACTORS OPERATIONS, AND TO NOTIFY THE ENGINEER PROMPTLY OF ALL CONFLICTS OF THE WORK WITH EXISTING UTILITIES.

***BENCHMARK***

- BOX CUT WITH 'X' CUT IN CENTER OF EXISTING SIDEWALK 2' SOUTH OF NORTH EDGE AT SOUTHEAST CORNER OF S.H. No. 205 BYPASS AND S.H. No. 276  
ELEV. 580.40
- BOX CUT ON SOUTHEAST TOP OF HEADWALL ON SOUTH SIDE OF I.H. No. 30 ACCESS ROAD APPROX. 325' EAST OF FUTURE S.H. No. 205 BYPASS AND ON WEST SIDE OF NESBIT METAL CO. ORANGE METAL BLDG.  
ELEV. 573.70


THE CAMBRIDGE COMPANIES, INC.  
TRUSTEE  
VOL. 99, PG. 1022  
D.R.R.C.T.

CURVE C30	
A	44°42'06"
B	04°24'27"
C	1300.00
D	534.52
E	1014.25
F	105.60

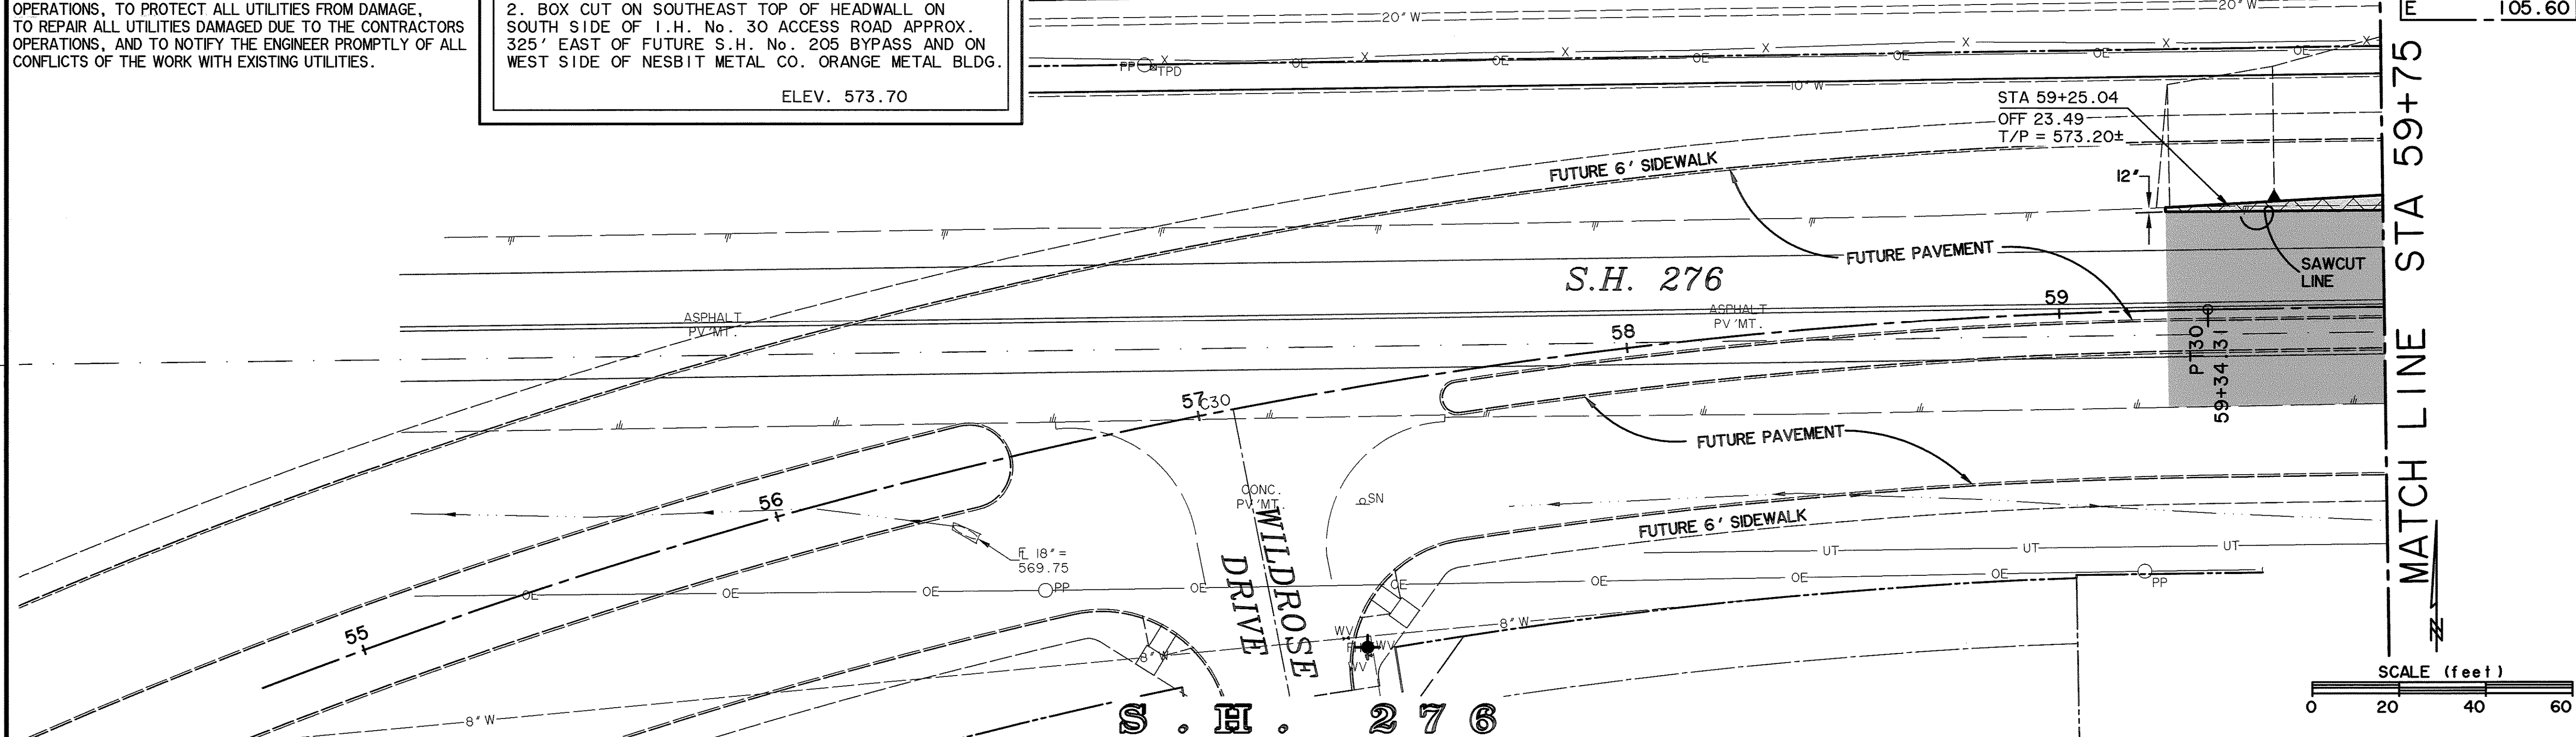

CURVE TABLE						
NO.	RADIUS	DELTA	ARC TANGENT	CHORD BEARING		
131	50.00	67°10'49"	58.63	33.21	55.32	S 32°31'06"W


THE CAMBRIDGE COMPANIES, INC.  
TRUSTEE  
VOL. 99, PG. 1022  
D.R.R.C.T.

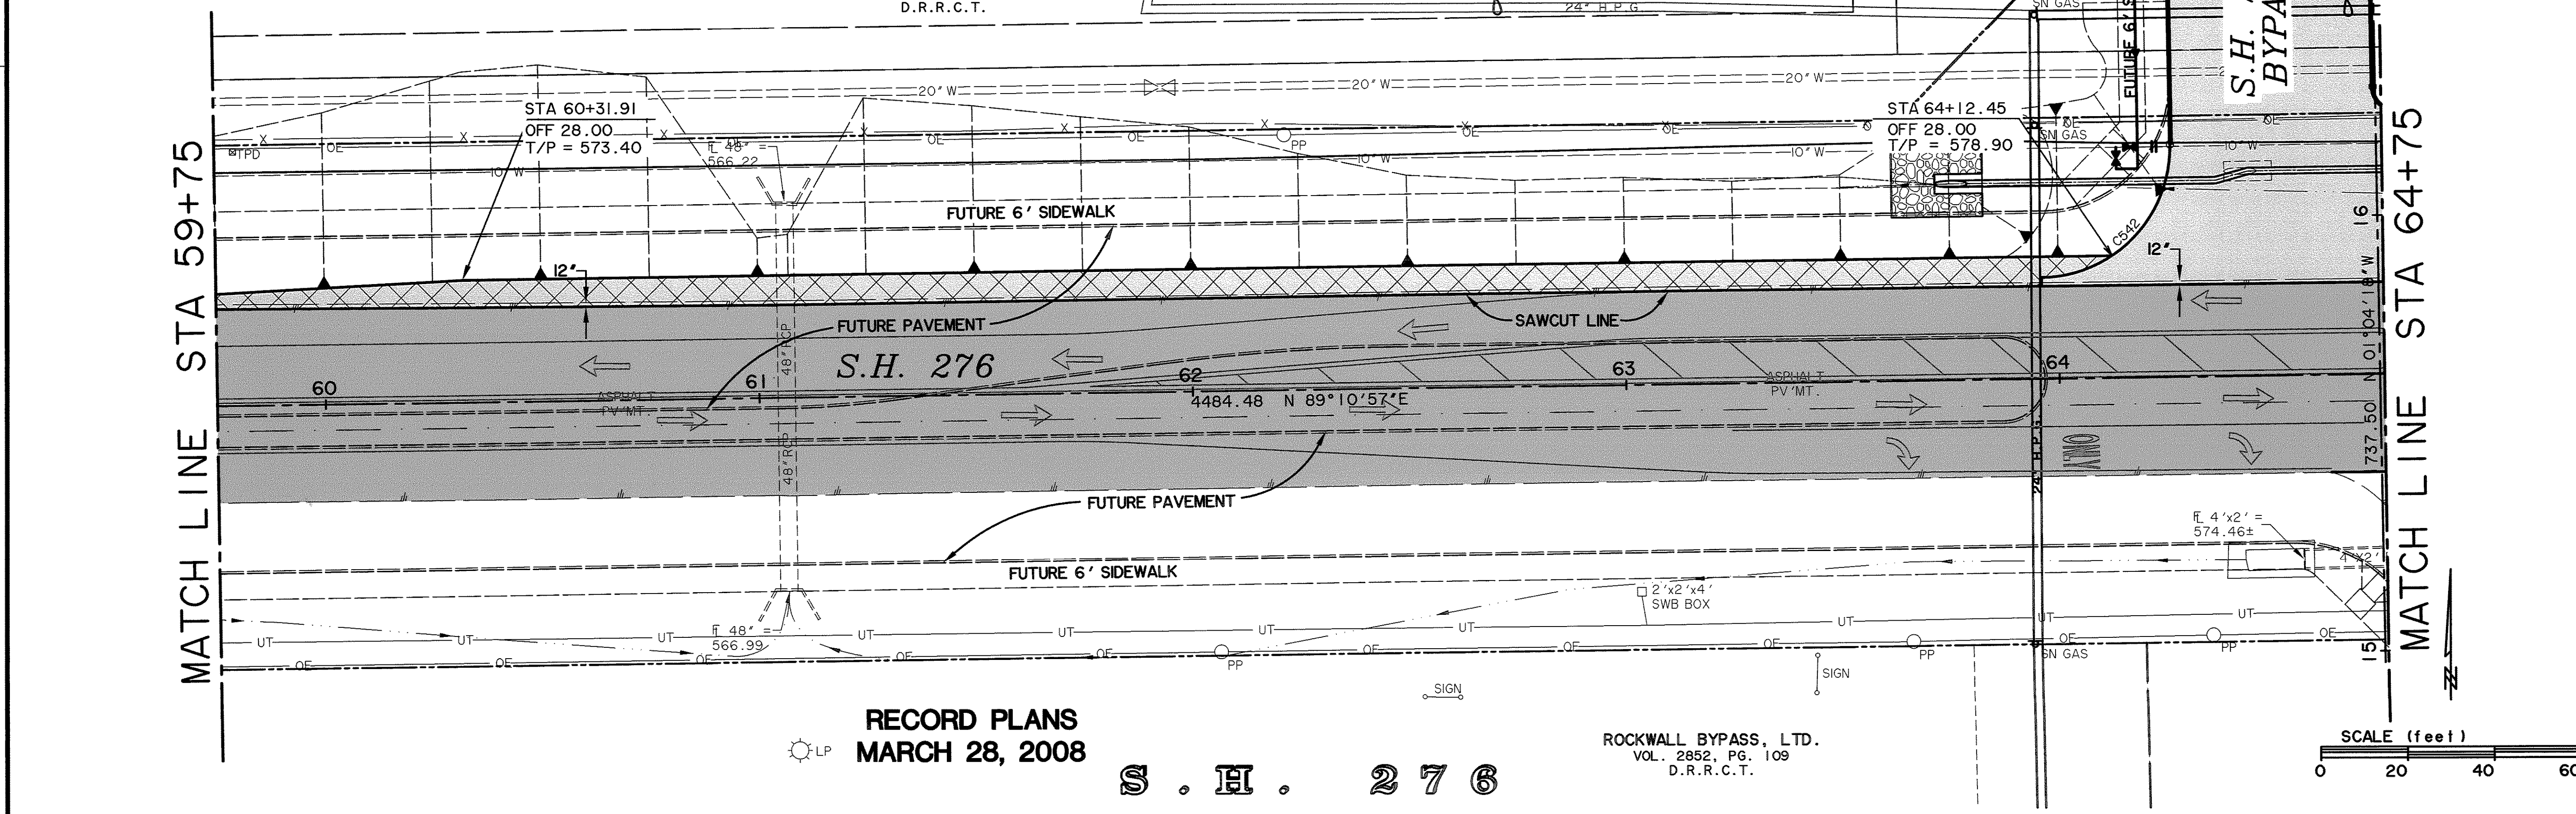


RECORD PLANS  
MARCH 28, 2008

ROCKWALL BYPASS, LTD.  
VOL. 2852, PG. 109  
D.R.R.C.T.

PREPARED BY:  
**WIER & ASSOCIATES, INC.**  
ENGINEERS SURVEYORS LAND PLANNERS  
4300 BELWAY PLACE SUITE 130 ARLINGTON, TEXAS 76018 METRO (817)467-7700  
1380 U.S. HIGHWAY 287 N. SUITE 101 WANSFELD, TEXAS 76783 METRO (817)477-8700  
6848 ELM STREET PERSCO, TEXAS 75084 METRO (214)387-8800  
www.wierassociates.com



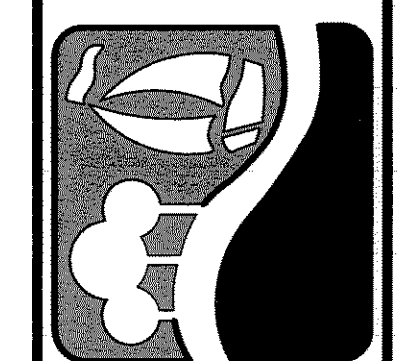


PHASE I S.H. 205 BYPASS  
FROM S.H. 276 TO INTERSTATE 30  
S.H. 276 WIDENING  
PAVING PLAN

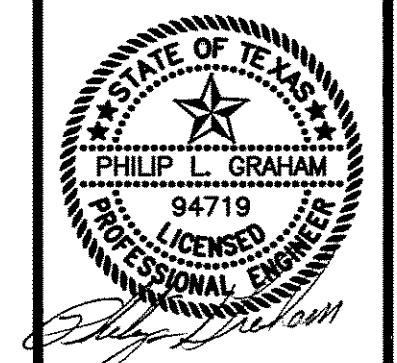

COPYRIGHT ©  
WIER & ASSOCIATES, INC.  
LAST SHEET EDIT  
DATE 11-02-2007  
WA# 04141  
SHEET NO.  
P109

TIME 117.39 FILE:04141-PAVE17.dwg

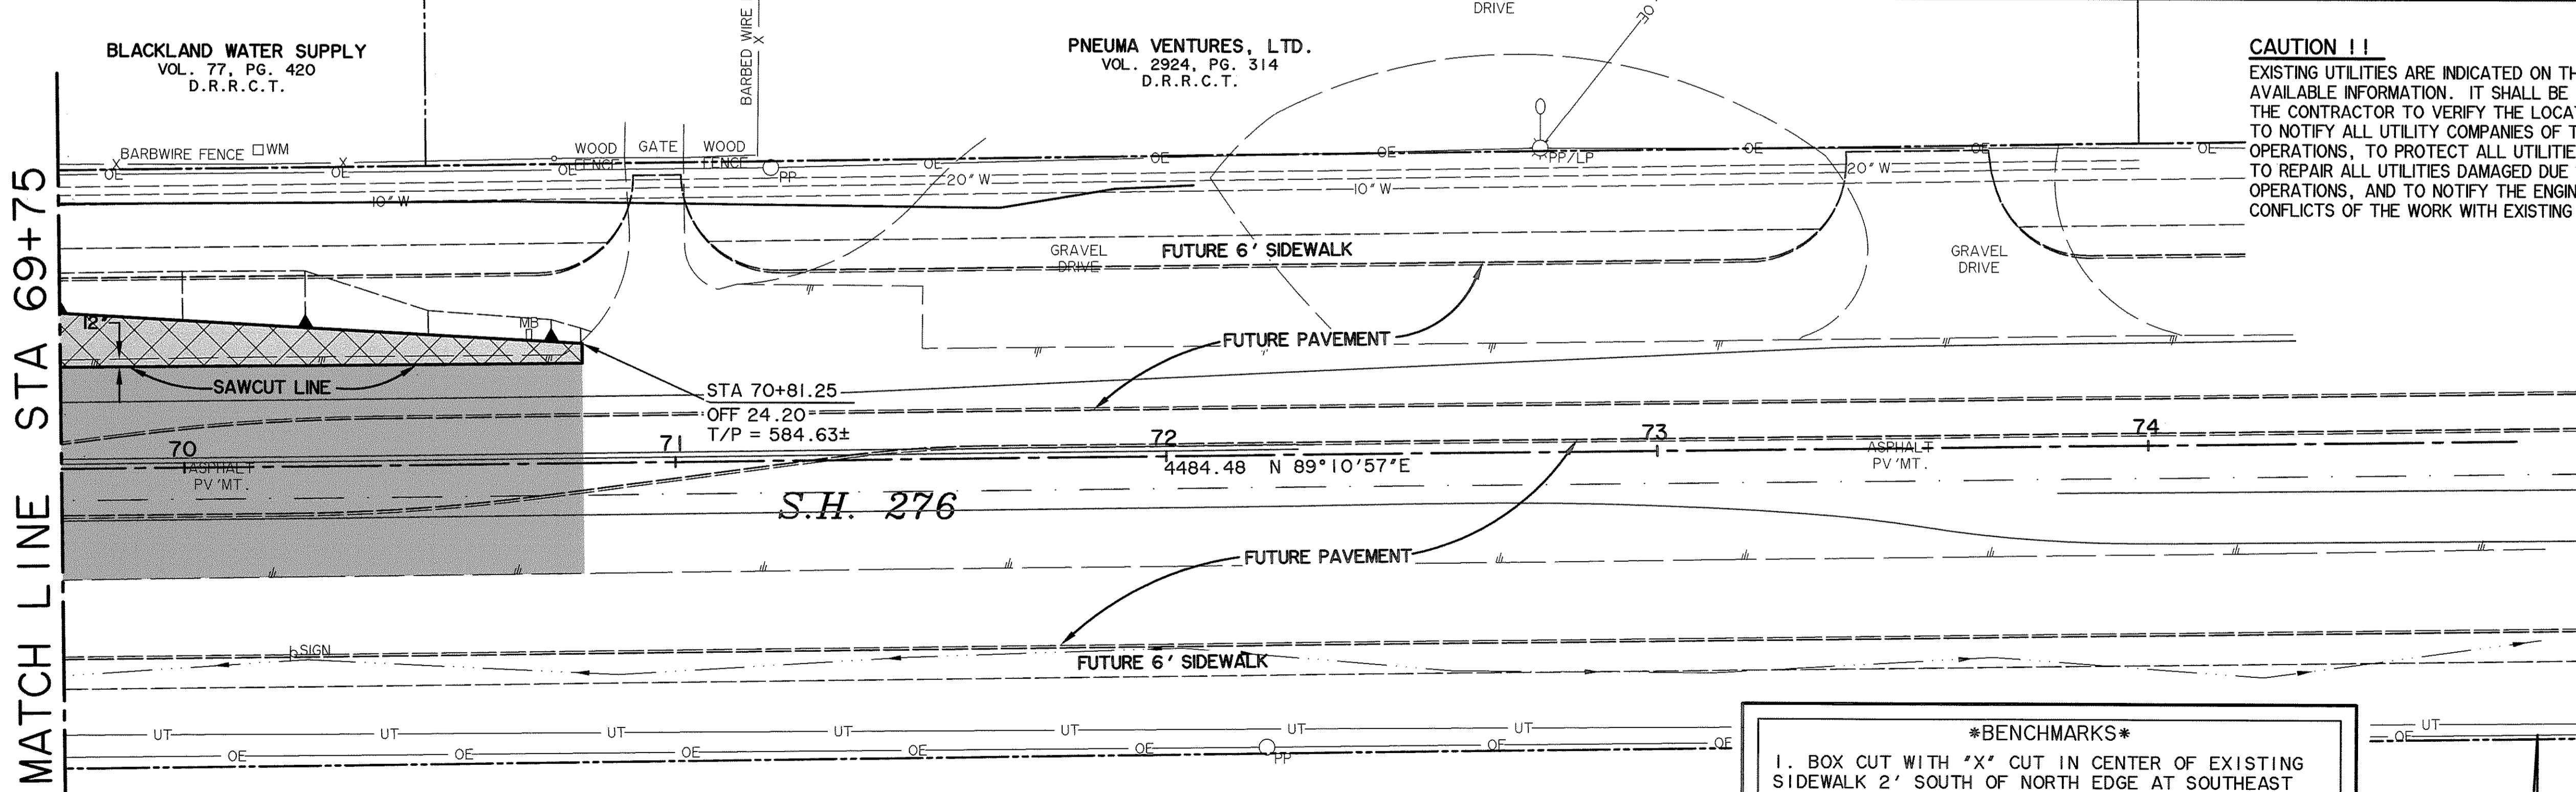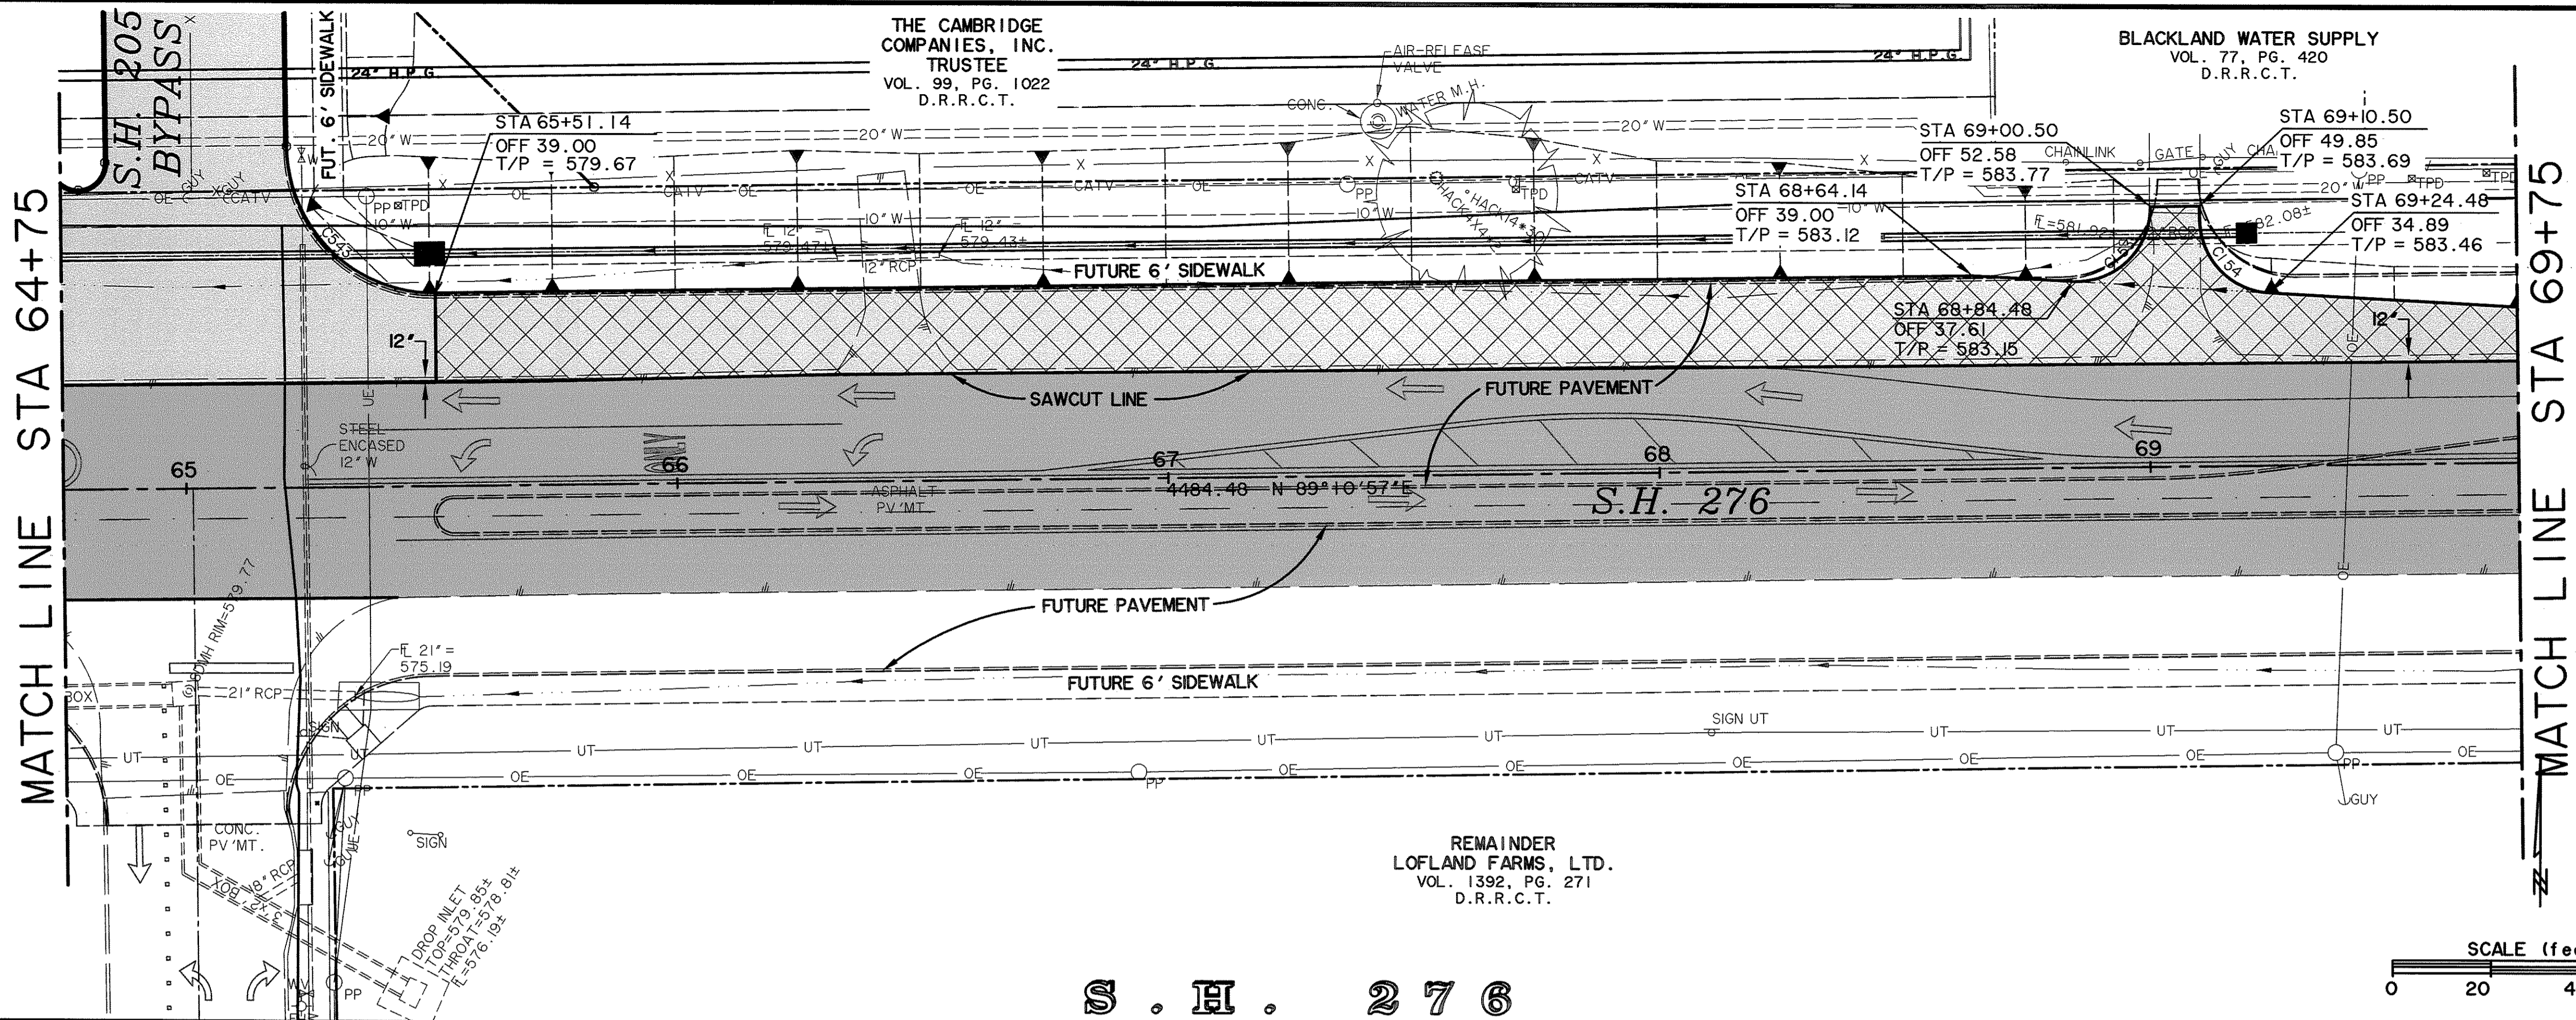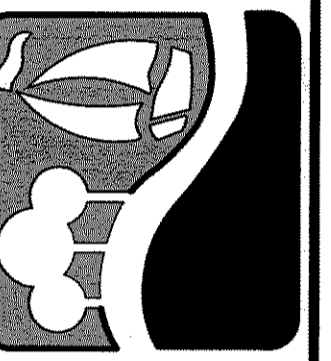

CURVE TABLE

NO.	RADIUS	DELTA	ARC TANGENT	CHORD	BEARING
128	40.00	63°54'14"	44.61 24.95	42.34	N 33°01'25"W
131	50.00	67°10'49"	58.63 33.21	55.32	S 32°31'06"W
153	15.00	93°54'02"	24.58 16.06	21.92	S 46°07'58"W
154	15.00	86°05'58"	22.54 14.01	20.48	N 43°52'02"W


REMAINDER  
 LOFLAND FARMS, LTD.  
 VOL. 1392, PG. 271  
 D.R.R.C.T.

**RECORD PLANS  
 MARCH 28, 2008**

***BENCHMARK***


1. BOX CUT WITH "X" CUT IN CENTER OF EXISTING SIDEWALK 2' SOUTH OF NORTH EDGE AT SOUTHEAST CORNER OF S.H. No. 205 BYPASS AND S.H. No. 276  
 ELEV. 580.40

2. BOX CUT ON SOUTHEAST TOP OF HEADWALL ON SOUTH SIDE OF I.H. No. 30 ACCESS ROAD APPROX. 325' EAST OF FUTURE S.H. No. 205 BYPASS AND ON WEST SIDE OF NESBIT METAL CO. ORANGE METAL BLDG.  
 ELEV. 573.70

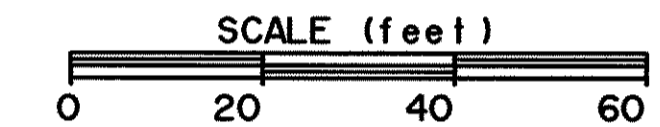

TIME 17:49 FILE: 04141-PAVE18.dwg

9-07-07	CORRECTED LABELS & ELEVATIONS	JRA
10-31-07	REDESIGNED S.H. 276 CONNECTION & CHANGED S.H. 205 BYPASS TO CITY SECTION	

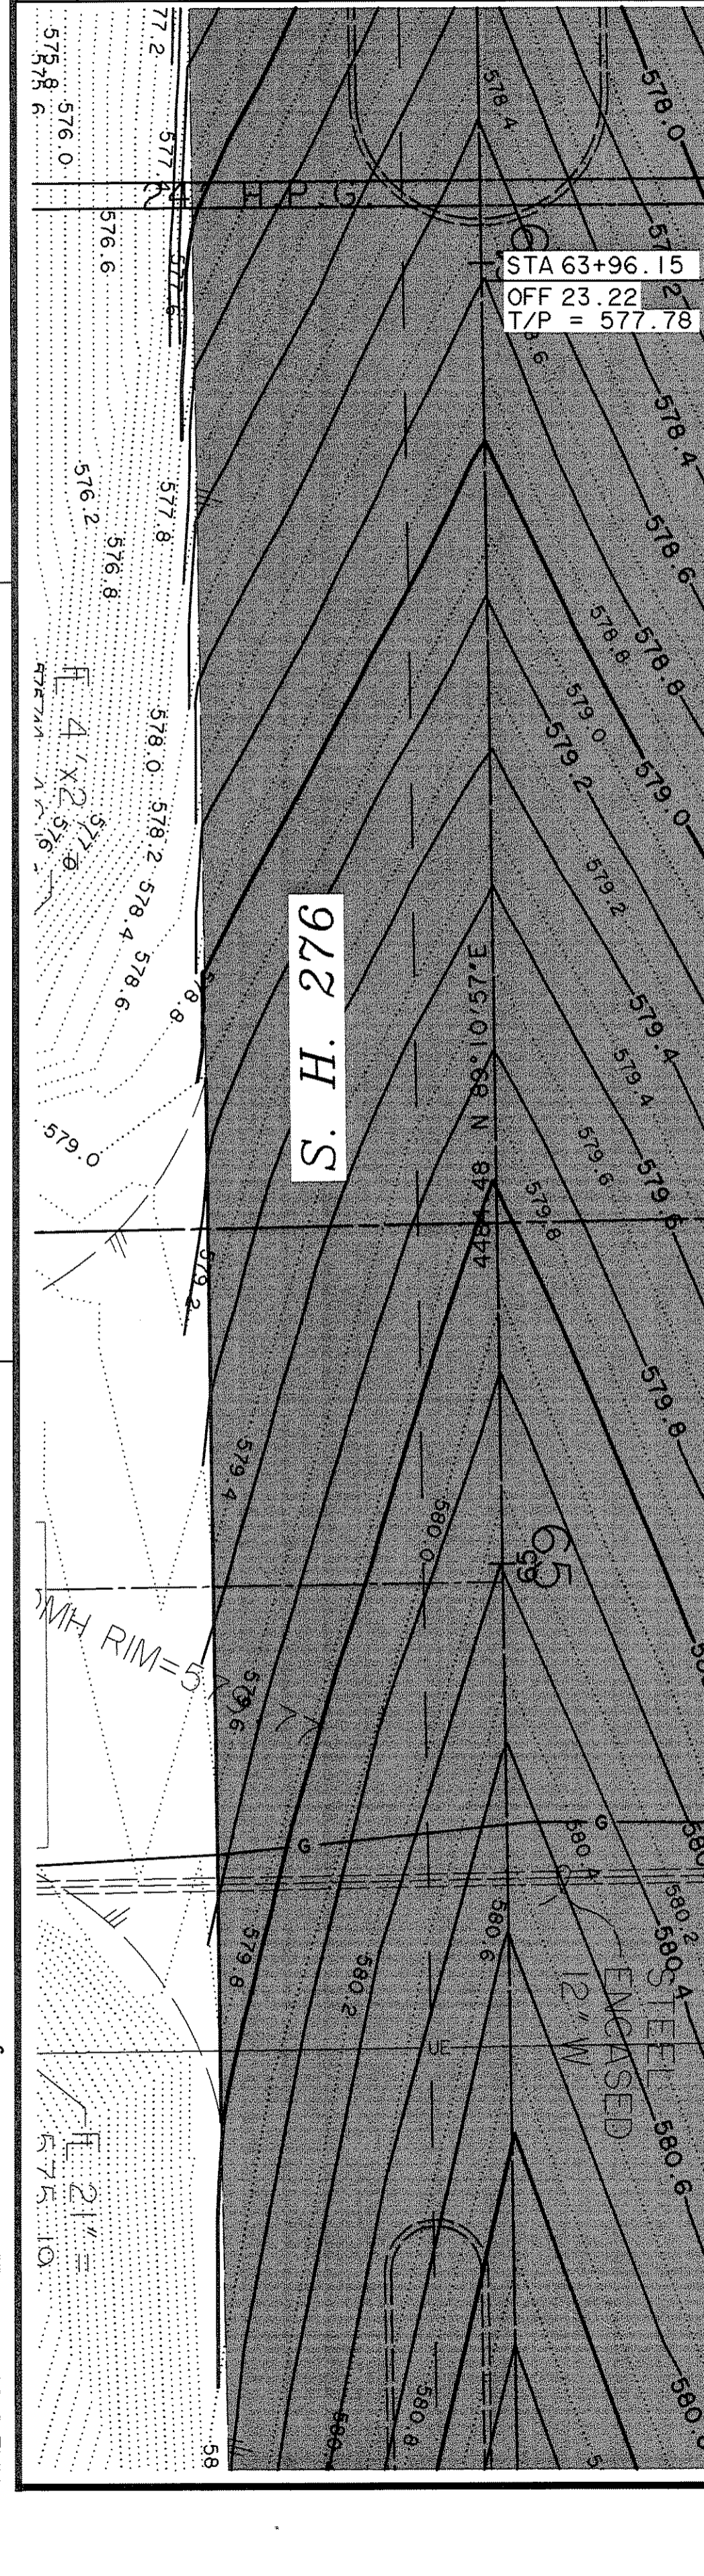

POINT	STATION	LEFT T/C ELEVATION	RIGHT T/P ELEVATION
1	17+00	577.81	577.31
2	17+25	577.78	577.26
3	17+50	577.82	577.27
4	17+75	577.82	577.34
5	18+00	577.94	577.48

NO.	RADIUS	DELTA	ARC TANGENT	CHORD BEARING
129	350.00	25°29'54"	155.76	79.19 154.48 S 13°49'15"E
132	375.00	21°39'09"	141.72	71.71 140.87 S 11°53'53"E
537	251.00	10°03'03"	44.03	22.07 43.97 S 07°28'03"E
542	30.00	90°21'30"	47.31	30.19 42.56 S 44°06'27"W
543	30.00	89°44'45"	46.99	29.87 42.33 N 45°56'40"W

THE CAMBRIDGE COMPANIES, INC.  
VOL. 99, PG. 1022  
D.R.R.C.T.

STA 17+13.00 S.H. 205 BYPASS  
OFF 51.88' LT.  
REMOVE EXIST. 4'x4' DROP INLET  
CONST. 10' REC. CURB INLET  
TOP = 576.67  
FL = 571.67

**S. H. 205 BYPASS**

MATCH LINE STA 18+00

TIME: 8:136 FILE: I04141-PAVE21.dwg

**CAUTION !!**  
EXISTING UTILITIES ARE INDICATED ON THE PLANS FROM AVAILABLE INFORMATION. IT SHALL BE THE RESPONSIBILITY OF THE CONTRACTOR TO VERIFY THE LOCATION OF ALL UTILITIES, TO NOTIFY ALL UTILITY COMPANIES OF THE CONTRACTORS OPERATIONS, TO PROTECT ALL UTILITIES FROM DAMAGE, TO REPAIR ALL UTILITIES DAMAGED DUE TO THE CONTRACTORS OPERATIONS, AND TO NOTIFY THE ENGINEER PROMPTLY OF ALL CONFLICTS OF THE WORK WITH EXISTING UTILITIES.


***BENCHMARK***

1. BOX CUT WITH 'X' CUT IN CENTER OF EXISTING SIDEWALK 2' SOUTH OF NORTH EDGE AT SOUTHEAST CORNER OF S.H. No. 205 BYPASS AND S.H. No. 276  
ELEV. 580.40


2. BOX CUT ON SOUTHEAST TOP OF HEADWALL ON SOUTH SIDE OF I.H. No. 30 ACCESS ROAD APPROX. 325' EAST OF FUTURE S.H. No. 205 BYPASS AND ON WEST SIDE OF NESBIT METAL CO. ORANGE METAL BLDG.  
ELEV. 573.70

STA 18+00.00 S.H. 205 BYPASS  
OFF 49.00' RT.  
REMOVE EXIST. DROP INLET  
CONST. 15' REC. CURB INLET  
TOP = 577.02  
FL = 572.52


**RECORD PLANS**  
MARCH 28, 2008

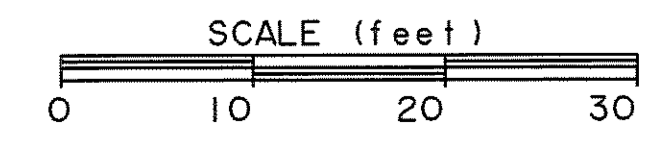

PREPARED BY:  
**VIA WIER & ASSOCIATES, INC.**  
ENGINEERS SURVEYORS LAND PLANNERS  
4300 BELWAY PLACE SUITE 130 ARLINGTON, TEXAS 76010 METRO (817)467-7700  
1380 U.S. HIGHWAY 287 N. SUITE 101 WANSFORD, TEXAS 76063 METRO (817)477-8700  
6949 ELM STREET FRISCO, TEXAS 75034 METRO (214)387-8000  
www.viawier.com

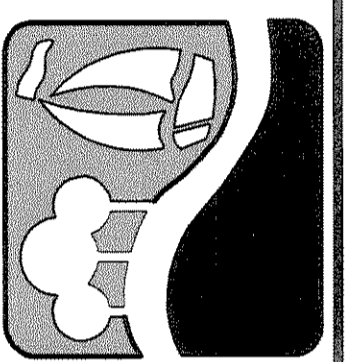

**PHASE I S.H. 205 BYPASS**  
FROM S.H. 276 TO INTERSTATE 30  
S.H. 205 & S.H. 276 INTERSECTION  
ASPHALT TRANSITION PAVING PLAN

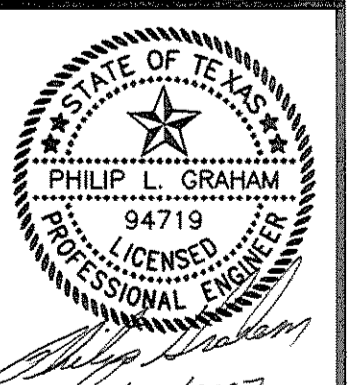

COPYRIGHT ©  
WIER & ASSOCIATES, INC.  
LAST SHEET EDIT  
DATE 11-14-2007  
WA# 04141  
**SHEET NO.**  
P201



ASPHALT TRANSITION T/C ELEVATIONS			
POINT	STATION	LEFT T/P ELEVATION	RIGHT ELEVATION
1	18+25	577.59	T/P = 577.67
2	18+50	577.74	T/P = 577.82
3	18+75	577.94	T/C = 578.50
4	19+00	578.16	T/C = 578.67

THE CAMBRIDGE COMPANIES, INC.  
VOL. 99, PG. 1022  
D.R.R.C.T.

PROVIDE 5'-0" NOTCH IN ASPHALT CURB FOR DRAINAGE

FUTURE 6' SIDEWALK

STA 19+67.58  
OFF 47.50  
T/C = 578.54

STA 19+97.87  
OFF 47.50  
T/C = 578.80

STA 19+95.94  
OFF 20.50  
PT

STA 20+16.62  
OFF 10.50  
T/C = 579.68

STA 18+65.00  
OFF 10.50  
T/C = 578.43

STA 18+60.00  
OFF 10.50  
T/C = 578.40

STA 18+65.00  
OFF 47.50  
T/C = 577.69

STA 19+22.21  
OFF 12.00  
T/C = 579.12  
T/P = 578.62

MATCH LINE STA 18+00

PROVIDE 5'-0" NOTCH IN ASPHALT CURB FOR DRAINAGE

CURVE TABLE						
NO.	RADIUS	DELTA	ARC TANGENT	CHORD	BEARING	
129	350.00	25°29'54"	155.76	79.19	154.48 S 13°49'15"E	
130	350.00	24°50'55"	151.79	77.11	150.60 N 14°08'45"W	
132	375.00	21°39'09"	141.72	71.71	140.87 S 11°53'53"E	
133	450.00	20°57'30"	164.61	83.23	163.69 N 12°14'42"W	
537	251.00	10°03'03"	44.03	22.07	43.97 S 07°28'03"E	
538	254.00	11°25'16"	50.63	25.40	50.55 N 06°46'56"W	
541	2479.50	00°25'40"	18.51	9.25	18.51 S 01°56'08"E	

THE CAMBRIDGE COMPANIES, INC.  
VOL. 99, PG. 1022  
D.R.R.C.T.


**CAUTION !!**  
EXISTING UTILITIES ARE INDICATED ON THE PLANS FROM AVAILABLE INFORMATION. IT SHALL BE THE RESPONSIBILITY OF THE CONTRACTOR TO VERIFY THE LOCATION OF ALL UTILITIES, TO NOTIFY ALL UTILITY COMPANIES OF THE CONTRACTORS OPERATIONS, TO PROTECT ALL UTILITIES FROM DAMAGE, TO REPAIR ALL UTILITIES DAMAGED DUE TO THE CONTRACTORS OPERATIONS, AND TO NOTIFY THE ENGINEER PROMPTLY OF ALL CONFLICTS OF THE WORK WITH EXISTING UTILITIES.

**RECORD PLANS**  
**MARCH 28, 2008**


***BENCHMARKS***

- BOX CUT WITH 'X' CUT IN CENTER OF EXISTING SIDEWALK 2' SOUTH OF NORTH EDGE AT SOUTHEAST CORNER OF S.H. No. 205 BYPASS AND S.H. No. 276  
ELEV. 580.40
- BOX CUT ON SOUTHEAST TOP OF HEADWALL ON SOUTH SIDE OF I.H. No. 30 ACCESS ROAD APPROX. 325' EAST OF FUTURE S.H. No. 205 BYPASS AND ON WEST SIDE OF NESBIT METAL CO. ORANGE METAL BLDG.  
ELEV. 573.70


CURVE C1	
A	19°35'45"
D	02°17'31"
R	2500.00
T	431.73
L	855.03
E	37.00

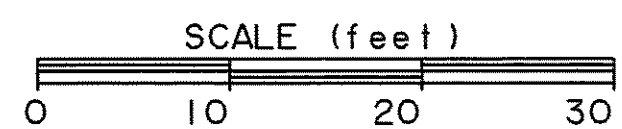

PREPARED BY:  
**VIA WIER & ASSOCIATES, INC.**  
ENGINEERS SURVEYORS LAND PLANNERS  
4300 BELWAY PLACE SUITE 130 ARLINGTON, TEXAS 76018 METRO (817)467-7700  
1380 U.S. HIGHWAY 287 N. SUITE 101 MANSFIELD, TEXAS 76063 METRO (817)477-9700  
6949 ELM STREET FRISCO, TEXAS 75034 METRO (214)397-8000  
www.wierassociates.com

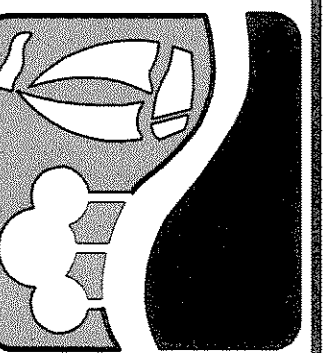


**PHASE I S.H. 205 BYPASS FROM S.H. 276 TO INTERSTATE 30 S.H. 205 & S.H. 276 INTERSECTION ASPHALT TRANSITION PAVING PLAN**

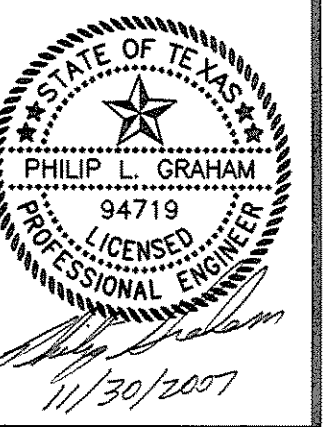

COPYRIGHT © WIER & ASSOCIATES, INC.  
LAST SHEET EDIT DATE 11-30-2007  
WA# 04141  
**SHEET NO. P202**

CURVE TABLE						
NO.	RADIUS	DELTA	ARC TANGENT	CHORD	BEARING	
106	50.00	106°52'13"	93.26	67.41	80.32 S 53°46'25"E	
111	50.00	72°38'37"	63.39	36.76	59.23 N 35°59'00"E	

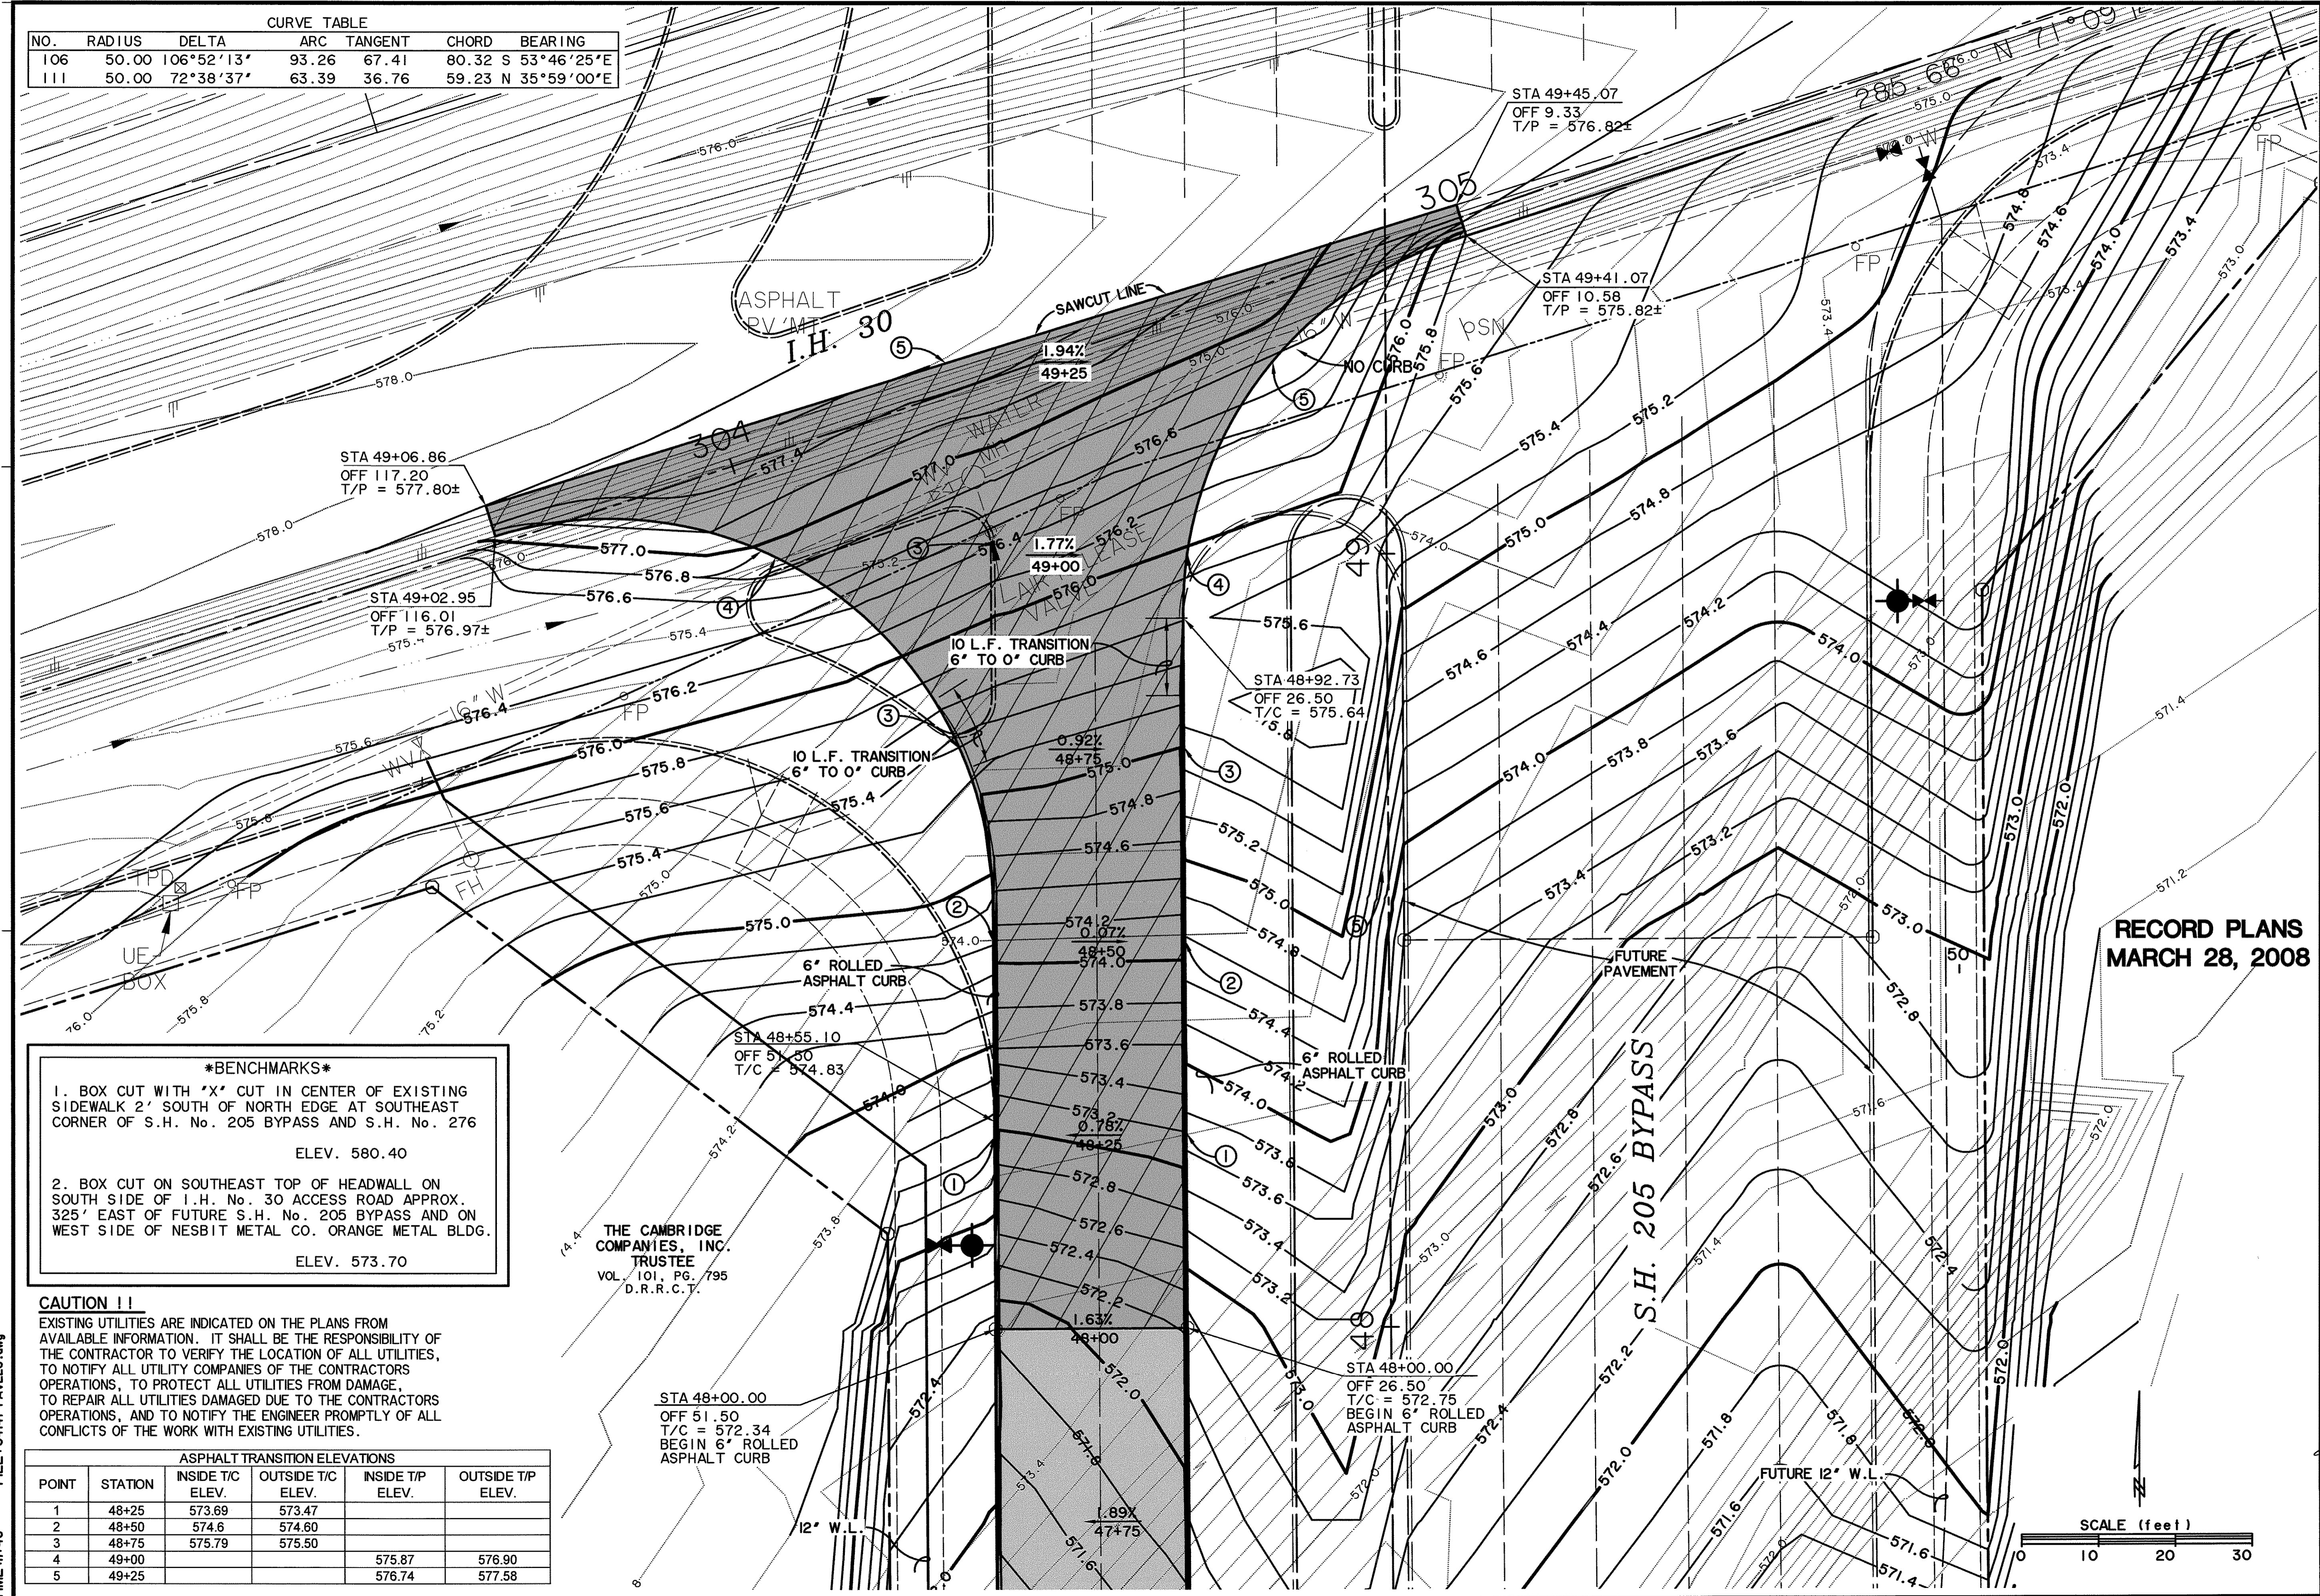


***BENCHMARKS***

- BOX CUT WITH 'X' CUT IN CENTER OF EXISTING SIDEWALK 2' SOUTH OF NORTH EDGE AT SOUTHEAST CORNER OF S.H. No. 205 BYPASS AND S.H. No. 276  
ELEV. 580.40
- BOX CUT ON SOUTHEAST TOP OF HEADWALL ON SOUTH SIDE OF I.H. No. 30 ACCESS ROAD APPROX. 325' EAST OF FUTURE S.H. No. 205 BYPASS AND ON WEST SIDE OF NESBIT METAL CO. ORANGE METAL BLDG.  
ELEV. 573.70


**CAUTION !!**  
EXISTING UTILITIES ARE INDICATED ON THE PLANS FROM AVAILABLE INFORMATION. IT SHALL BE THE RESPONSIBILITY OF THE CONTRACTOR TO VERIFY THE LOCATION OF ALL UTILITIES, TO NOTIFY ALL UTILITY COMPANIES OF THE CONTRACTORS OPERATIONS, TO PROTECT ALL UTILITIES FROM DAMAGE, TO REPAIR ALL UTILITIES DAMAGED DUE TO THE CONTRACTORS OPERATIONS, AND TO NOTIFY THE ENGINEER PROMPTLY OF ALL CONFLICTS OF THE WORK WITH EXISTING UTILITIES.

ASPHALT TRANSITION ELEVATIONS					
POINT	STATION	INSIDE T/C ELEV.	OUTSIDE T/C ELEV.	INSIDE T/P ELEV.	OUTSIDE T/P ELEV.
1	48+25	573.69	573.47		
2	48+50	574.6	574.60		
3	48+75	575.79	575.50		
4	49+00			575.87	576.90
5	49+25			576.74	577.58


**RECORD PLANS  
MARCH 28, 2008**

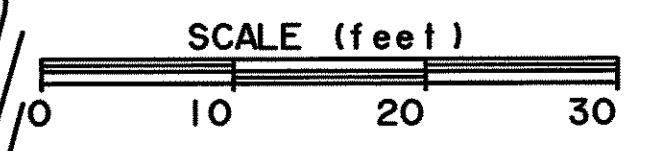

PREPARED BY:  
**WIER & ASSOCIATES, INC.**  
ENGINEERS SURVEYORS LAND PLANNERS  
4300 BELLEVUE PLACE SUITE 130 ARLINGTON, TEXAS 76018 METRO (817)467-7700  
1380 U.S. HIGHWAY 287 N. SUITE 101 MARSHFIELD, TEXAS 76663 METRO (817)477-8700  
6848 ELM STREET PERSCO, TEXAS 75084 METRO (214)387-8000  
www.wierassociates.com

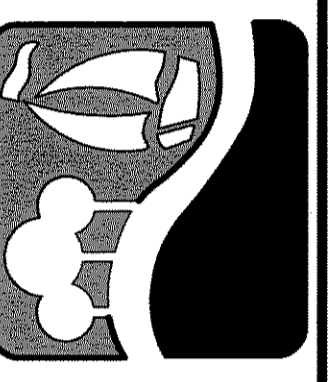


**PHASE I S.H. 205 BYPASS  
FROM S.H. 276 TO INTERSTATE 30  
S.H. 205 & I.H. 30 INTERSECTION  
ASPHALT TRANSITION PAVING PLAN**

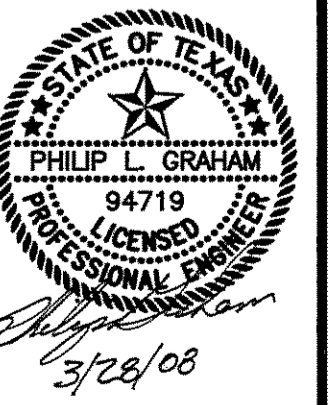


COPYRIGHT ©  
WIER & ASSOCIATES, INC.  
LAST SHEET EDIT  
DATE 03-28-2008  
WA# 04141  
**SHEET NO.  
P203**

TIME 11:46 FILE:104141-PAVE23.dwg


DISCLAIMER: The use of this standard is governed by the "Texas Engineering Practice Act". No warranty of any kind is made by TxDOT for any purpose whatsoever. TxDOT assumes no responsibility for the conversion of this standard to other formats or for incorrect results or damages resulting from its use.

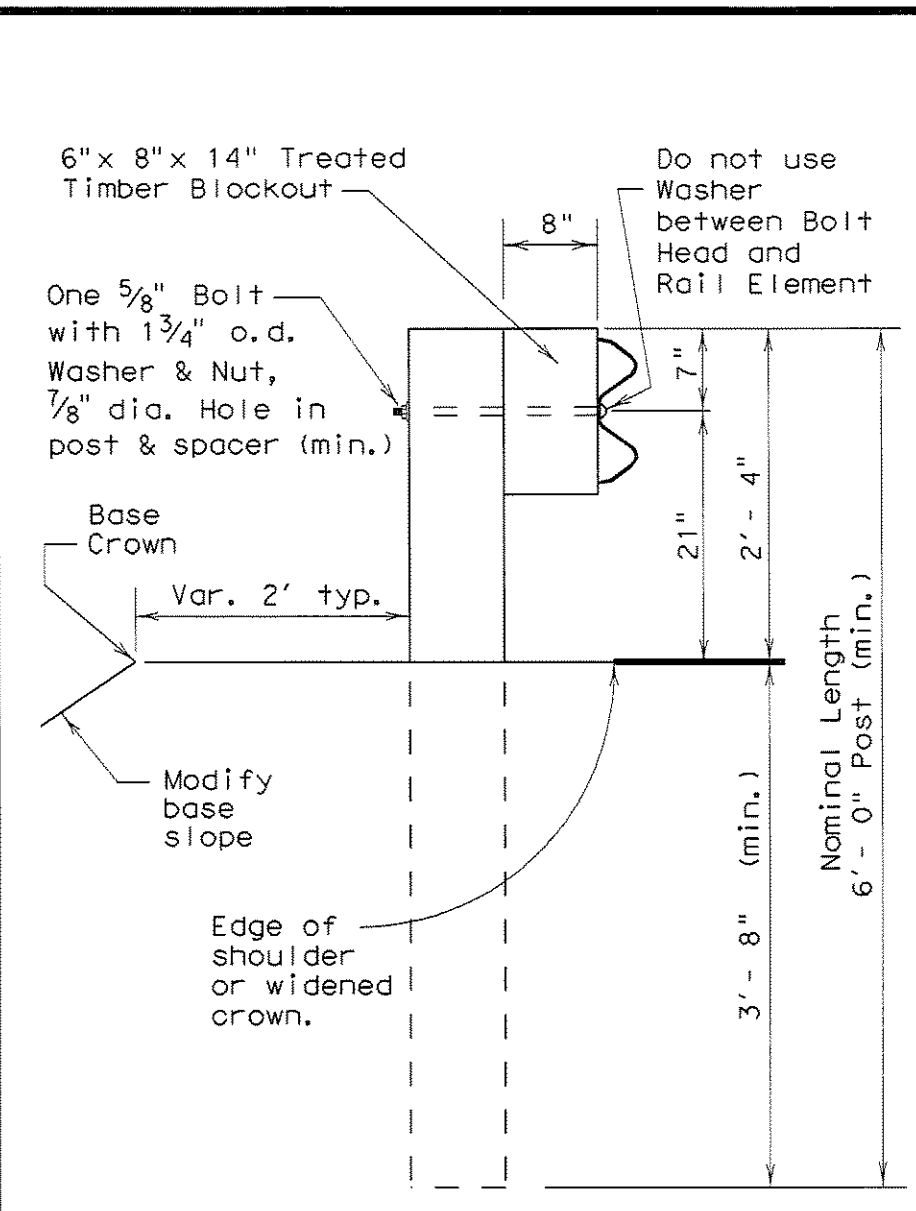


TYPICAL POST

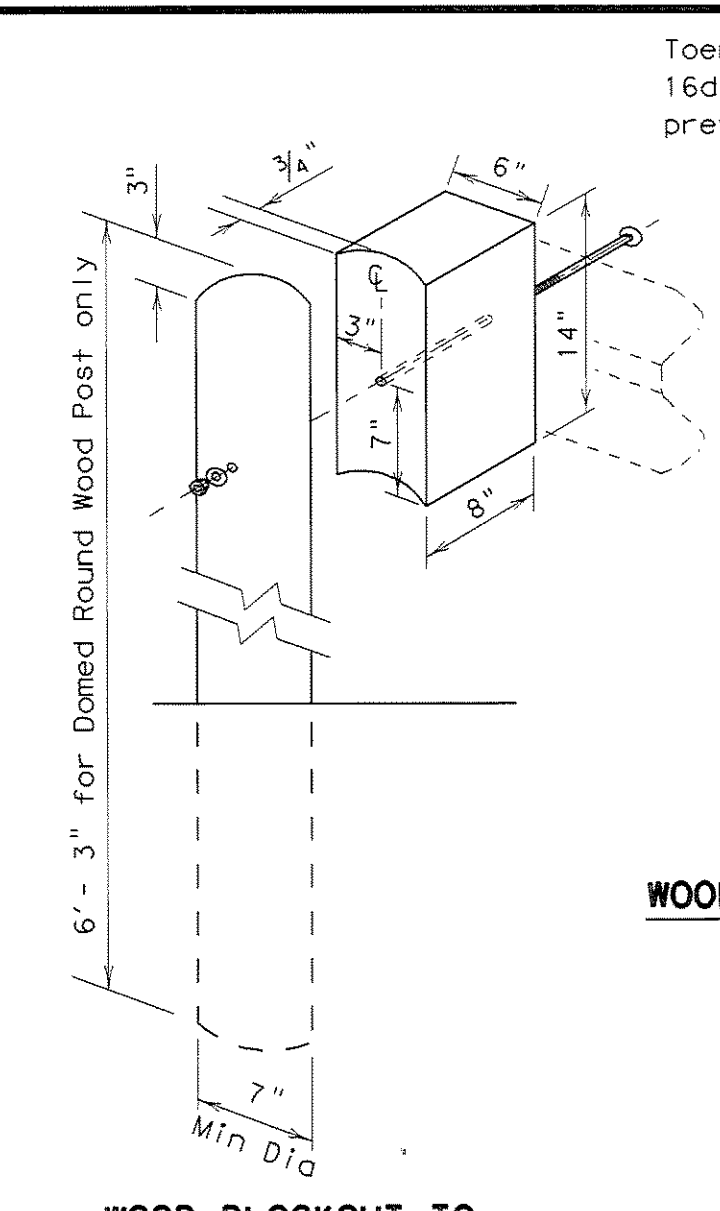


WOOD BLOCKOUT TO ROUND WOOD POST DETAIL

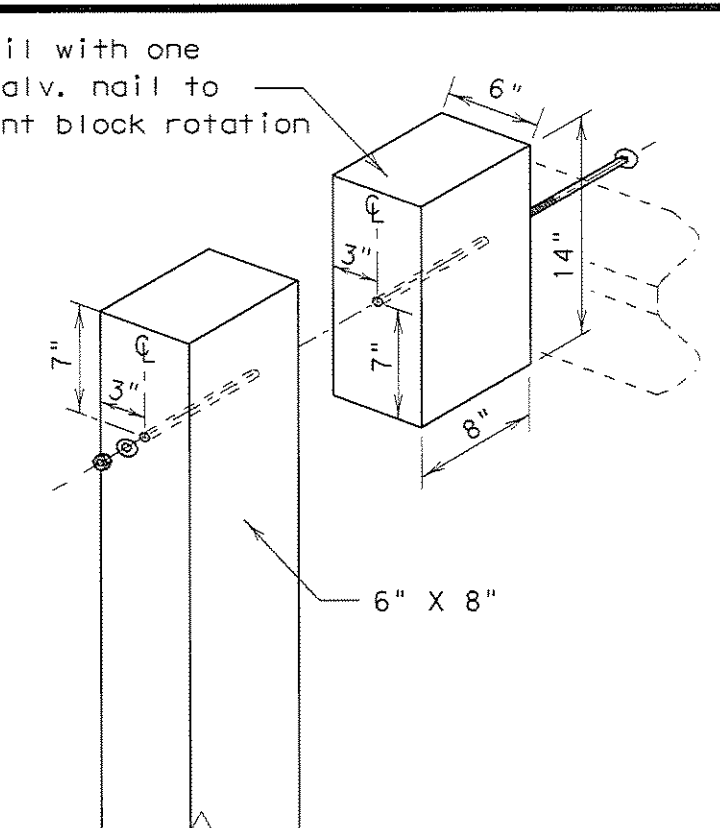


WOOD BLOCKOUT TO RECTANGULAR WOOD POST DETAIL

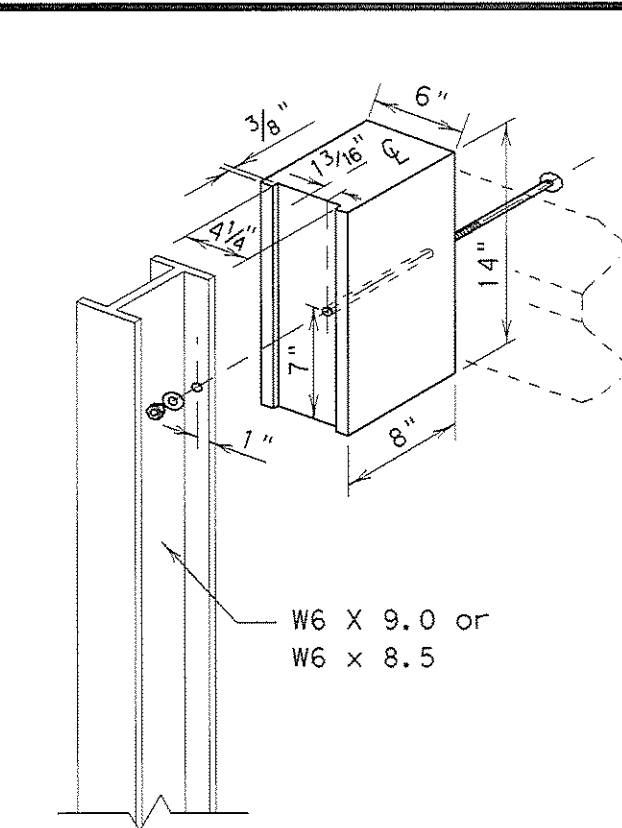


WOOD BLOCKOUT TO STEEL POST DETAIL

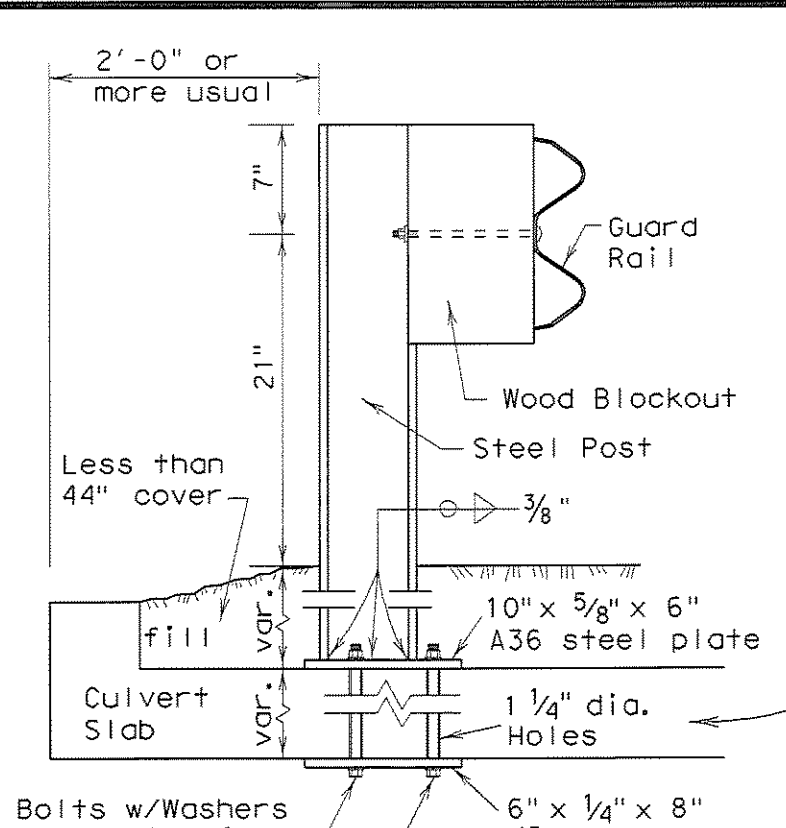


LOW FILL CULVERT POST MOUNTING OPTION

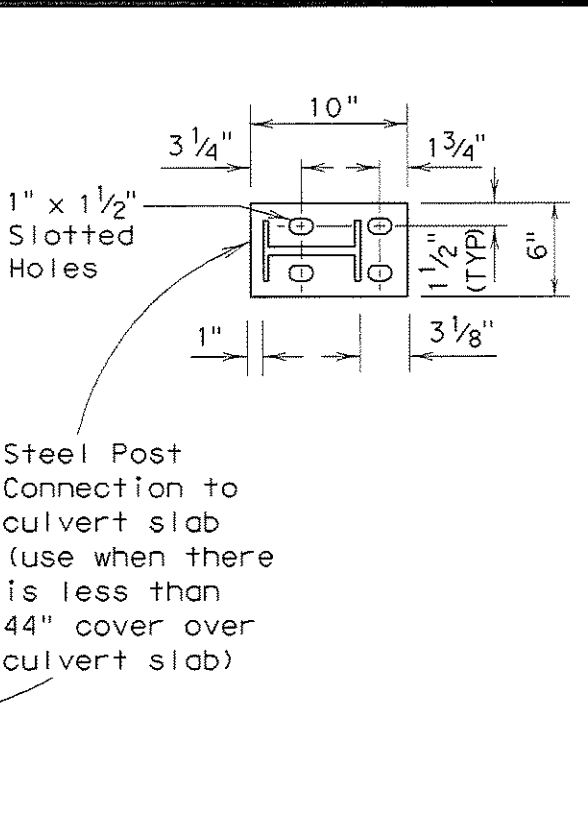

Steel Post Connection to culvert slab (use when there is less than 44" cover over culvert slab)

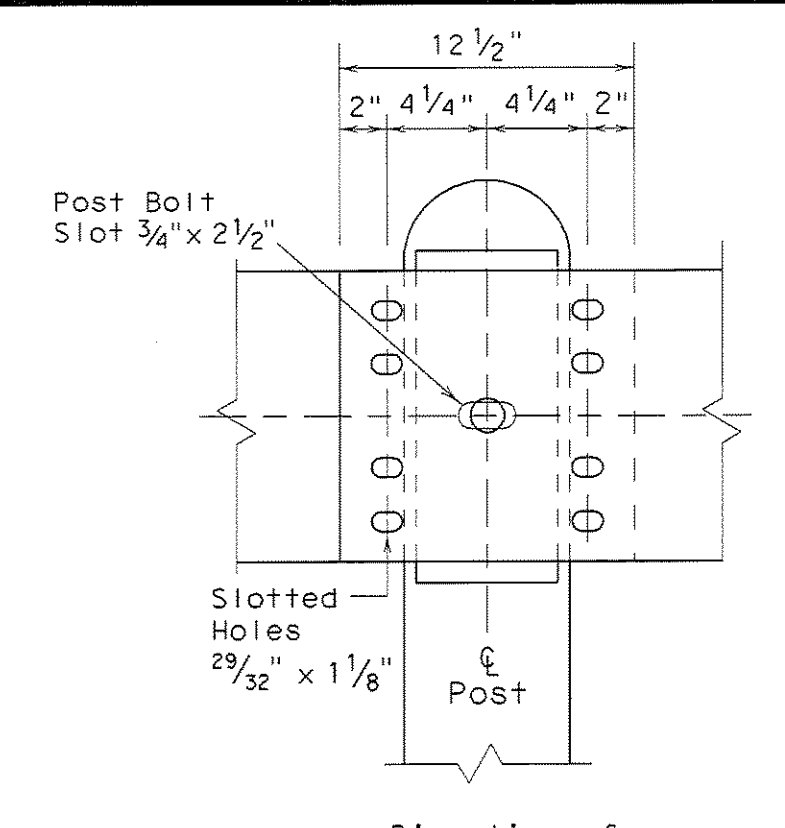


RAIL SPLICE

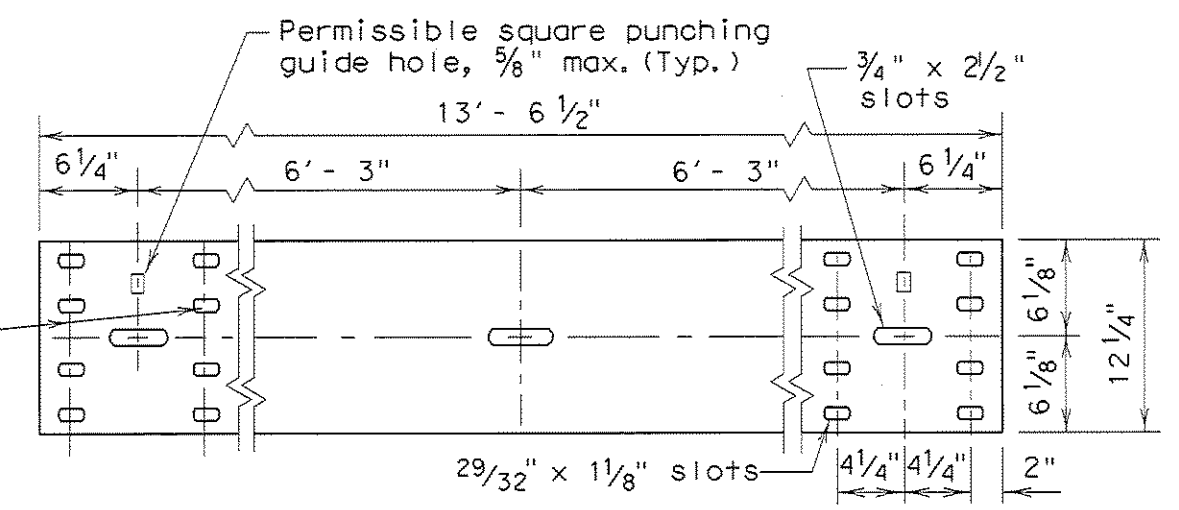

ELEVATION OF NOMINAL 12 1/2 FOOT GUARDRAIL (25 foot sections may also be supplied)


GENERAL NOTES

- The exact position of guard fence shall be as shown elsewhere on the plans or as directed by the Engineer. Guard fence shall be transitioned to a smooth connection with other guard fence or structure railing as shown elsewhere on plans.
- Rail element shall meet all requirements of AASHTO M-180 except as modified on the plans. The terminal connectors shall be of the same material, but shall not be less than 10 gauge. Contractor shall verify that the locations of bolt holes match those in the Terminal Connector prior to ordering of materials.
- Unless otherwise shown in the plans, guard fence placed in the vicinity of curbs shall be blocked out so that the face of curb is located directly below or behind the face of the blockout. Rail placed over curbs shall be installed so that the post bolt is located approximately 21-inches above the gutter pan or roadway surface.
- Unless otherwise shown in the plans, MBGF shall be placed with the face of rail directly above the shoulder edge (or curbface) except for upstream end treatments.
- At the option of the Contractor, the rail elements for the guard fence may be furnished in either 12 1/2 or 25 foot nominal lengths with post bolt slots for connection to posts.
- The terminal anchor post shall be set in Class "A" concrete in (unless otherwise shown on plans) in accordance with Item, "Portland Cement Concrete". Concrete shall be subsidiary to the bid item requiring construction of the terminal rail section and anchorage system.
- An anchor other than to a terminal anchor post shall consist of a connection similar to the rail splice or similar to the terminal connector.
- Galvanized washers used with the eight 5/8" splice bolts and nuts that are provided for terminal connectors and/or terminal anchor posts shall be 1 3/4"x 3"x 3/16", or 1" i.d. and 2" o.d. x 0.134" (ANSI B27.2) narrow Type A plain washers.
- Special fabrication will be required at installations having a curvature of less than 150' radius.
- Button head post bolts (A307) shall be of sufficient length to extend through the full thickness of the nut and no more than 3/4" beyond it. Button head splice bolts (A307) are 5/8"x 1 1/4" with a 5/8" double recessed nut. Fittings (bolts, nuts, and washers) shall be in accordance with Item, Metal for Structures". Fittings shall be subsidiary.
- Crown will be widened to accommodate guard fence.
- If guardrail is placed on a side slope away from the pavement edge, then the slope rate between the edge of the pavement and the face of the barrier will be 1V:10H or flatter.
- Posts shall not be set full depth in concrete.
- Where solid rock is encountered or where shown on the plans, the diameter of the holes shall be approximately 12 inches, the backfilling shall be with a cohesionless material, and embedment depth shall be 1'-6" or more as directed by the Engineer.
- Unless otherwise directed by the Engineer, a composite material post and/or blockout from the Department approved list of suppliers may be substituted for a post and/or blockout of similar dimensions. The list of approved suppliers of posts and blockouts will be maintained by the Construction Division, TxDOT.

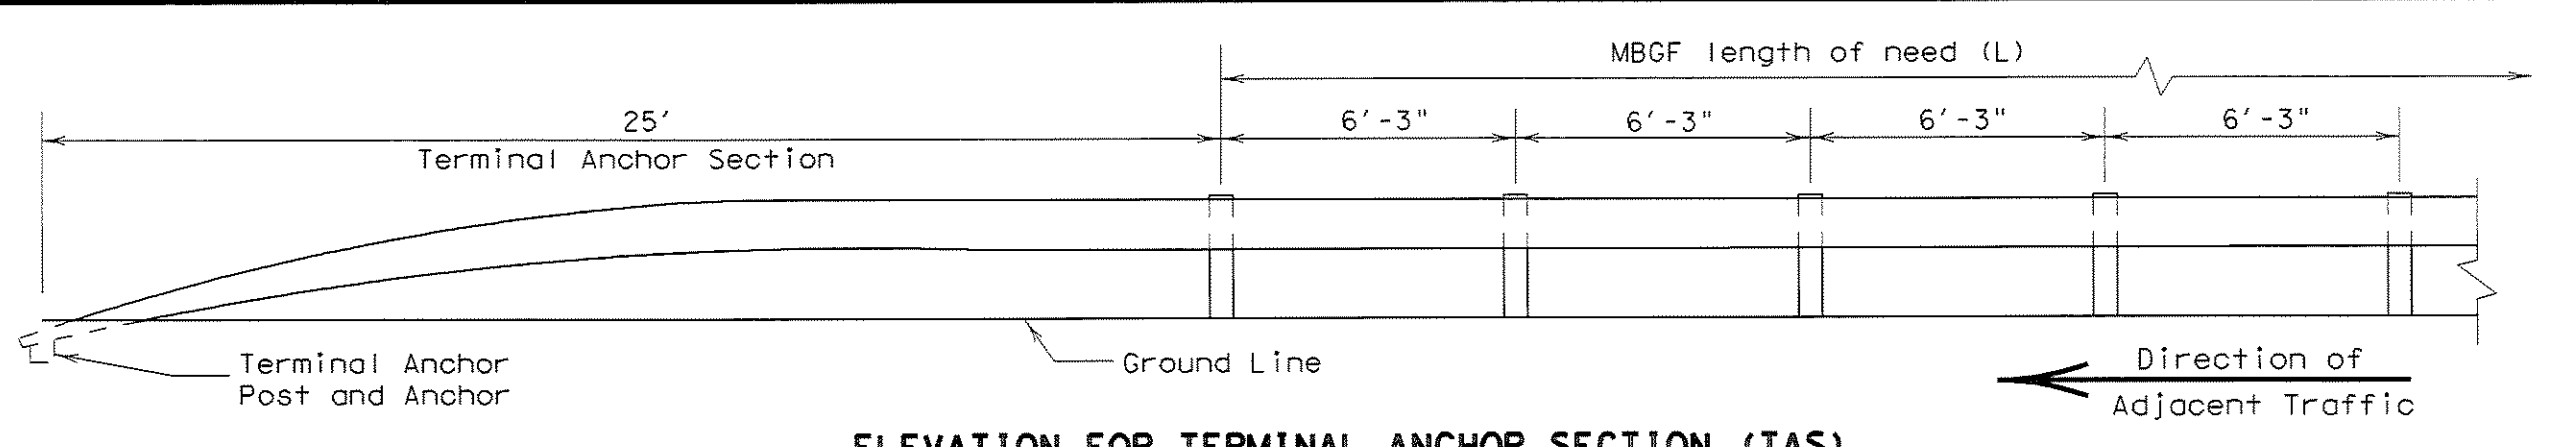


ELEVATION FOR TERMINAL ANCHOR SECTION (TAS)

(Terminal anchor sections are only for downstream guardrail end anchorage usage outside the horizontal clearance area of opposing traffic)

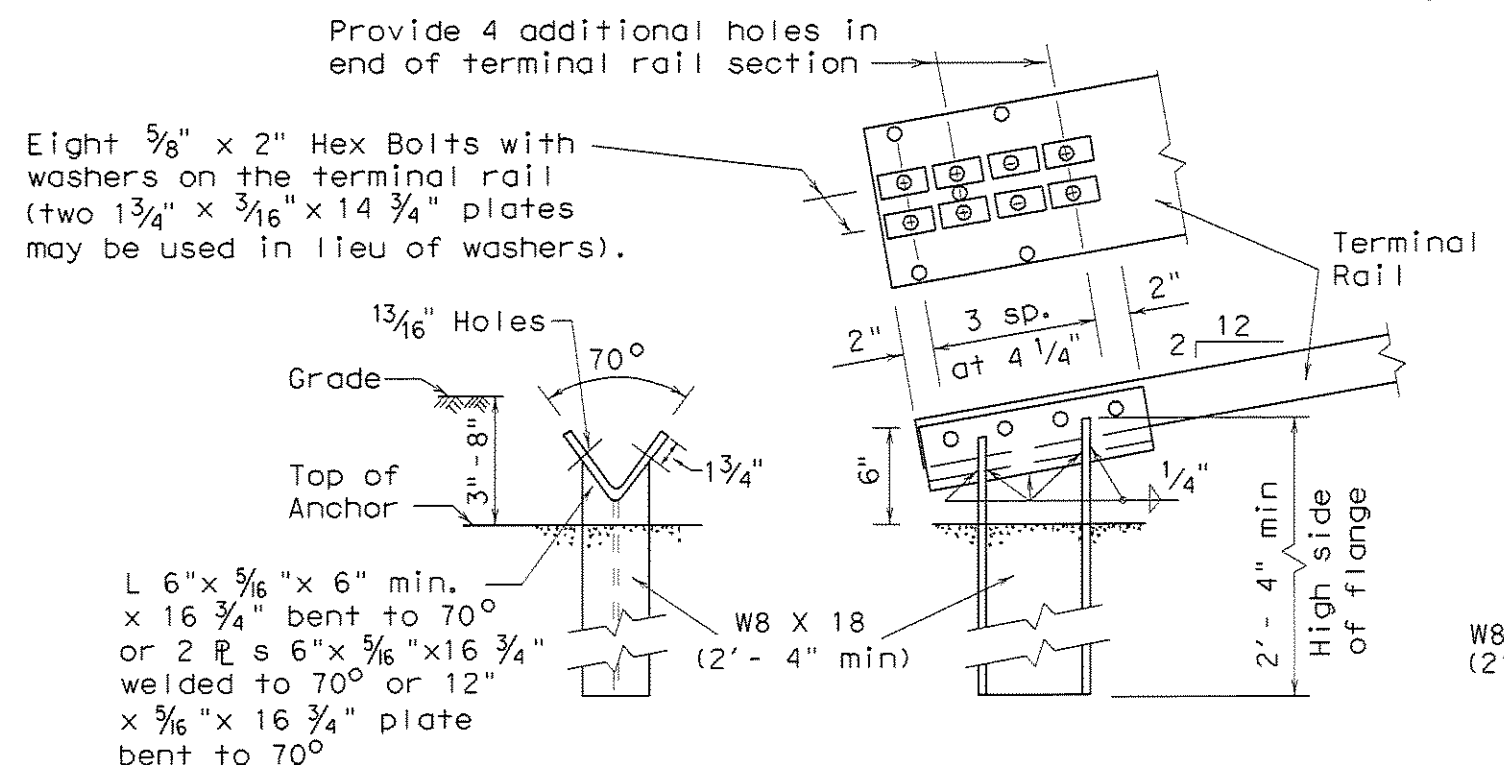


TERMINAL ANCHOR POST OPTIONS

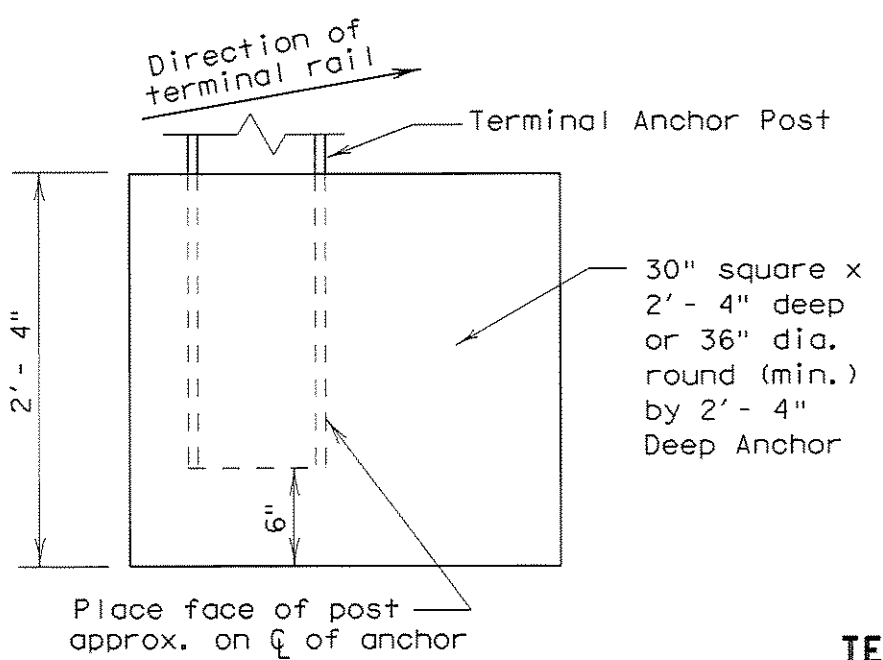


TERMINAL CONCRETE ANCHOR OPTIONS

Notes:  
Either post may be used with either anchor.  
No construction joint is allowed in the concrete anchor.  
Terminal rail may be bolted to post and in twist position prior to placing concrete anchor.  
If concrete anchor is precast, the area should be compacted as directed by the Engineer, when placed in the field.

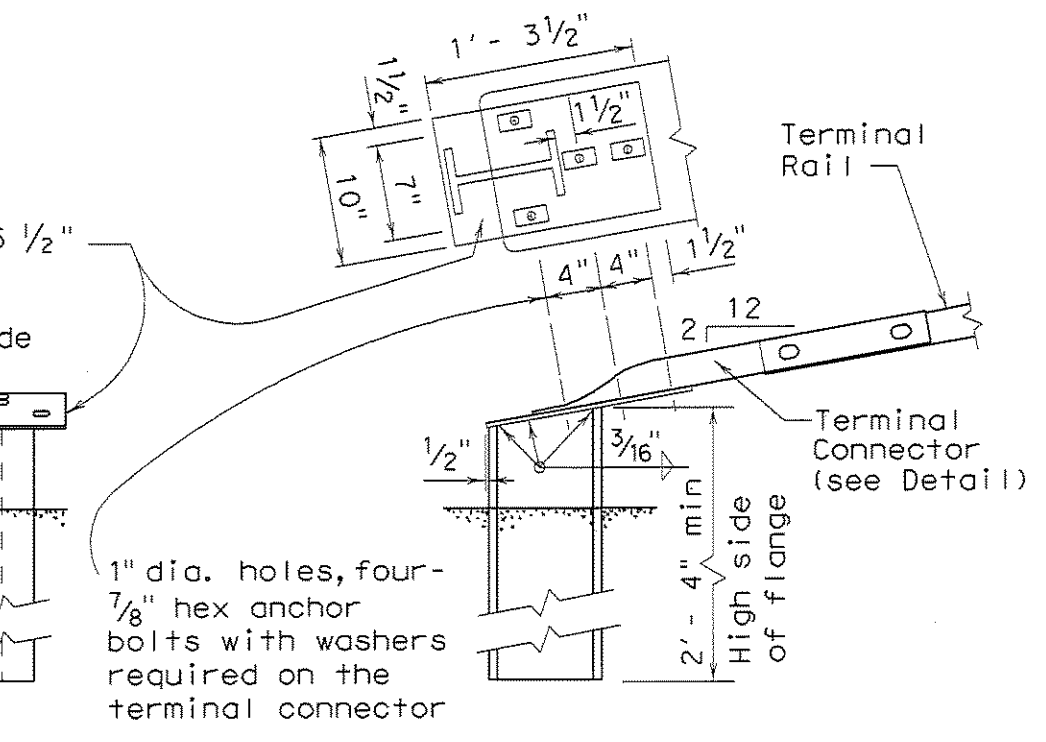


Note: This optional post requires the use of the 10 ga. terminal connector with four 5/8" hex bolts for attachment to the anchor post.

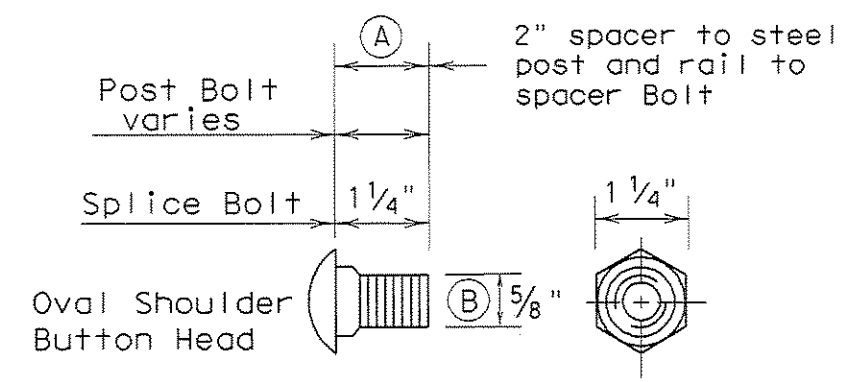

SPLICE BOLT

- (A) 1 1/4" spacer to steel post hex bolt, 2" rail to spacer button head bolt.
- (B) 5/8" hex bolts required for terminal connector

TERMINAL CONNECTOR: The terminal connector may also be used on the MBGF (TL2) transition (See MBGF (TL2) Standard Sheet), or on the downstream end of a concrete rail located outside the horizontal clearance area of opposing traffic. (See BED Standard Sheet)

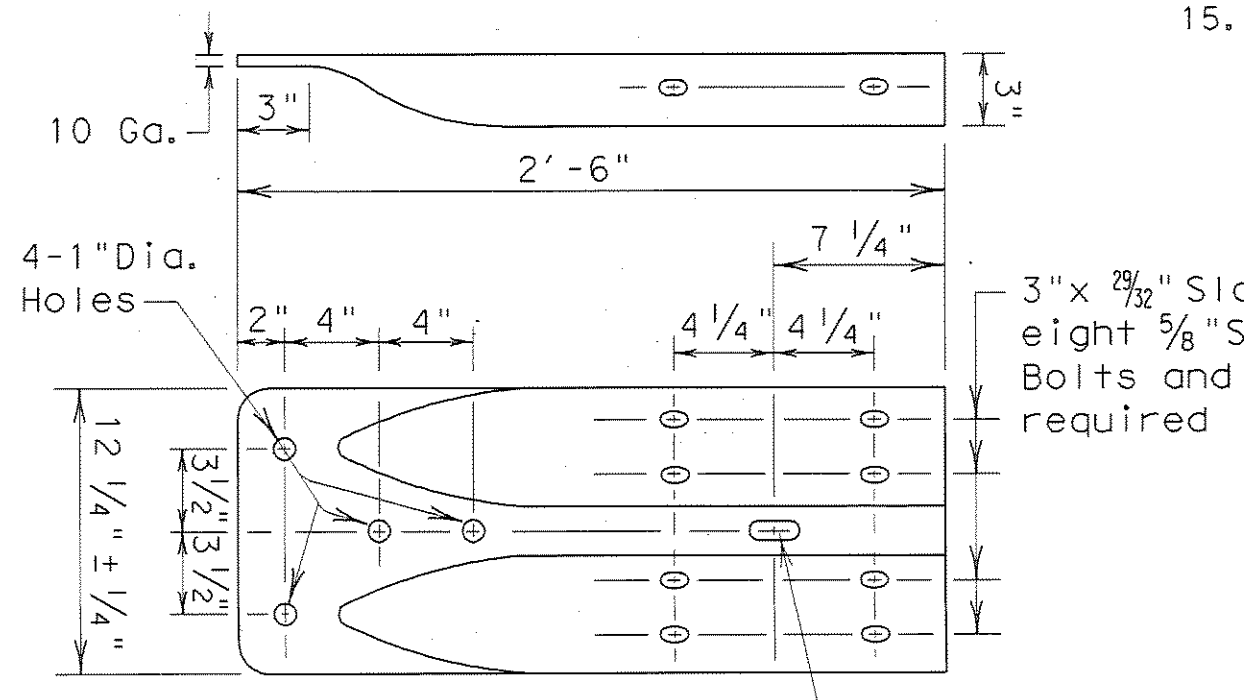

TERMINAL CONNECTOR

RECORD PLANS  
MARCH 28, 2008

R = Radius  
D = Diameter

Texas Department of Transportation  
Design Division (Roadway)





## METAL BEAM GUARD FENCE

### MBGF-03A

FILE: mbgf03a.dgn DN: MAM CK: MAM DW: RAR CR: MAM  
© TxDOT JULY 1994 DIST FEDERAL AID PROJECT SHEET  
REVISIONS COUNTY CONTROL SECT JOB HIGHWAY




DISCLAIMER: The use of this standard is governed by the "Texas Engineering Practice Act". No warranty of any kind is made by TxDOT for any purpose whatsoever. TxDOT assumes no responsibility for the conversion of this standard to other formats or for incorrect results or damages resulting from its use.

LEVELS DISPLAYED	
1	

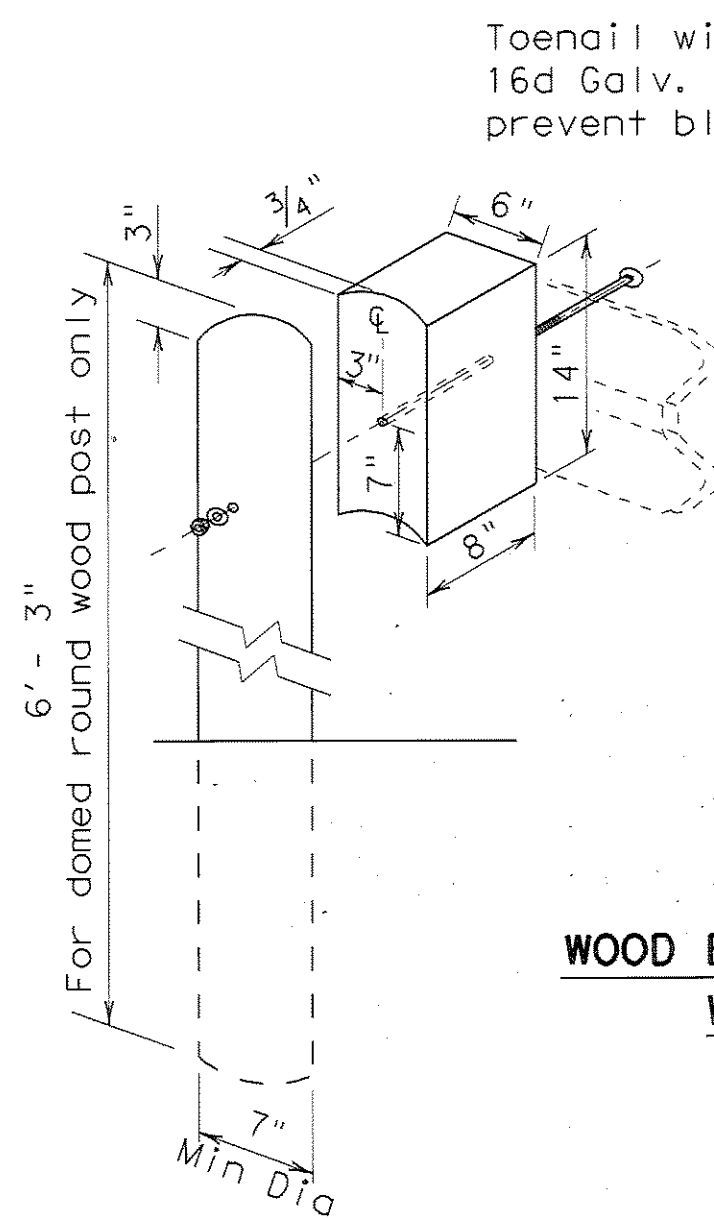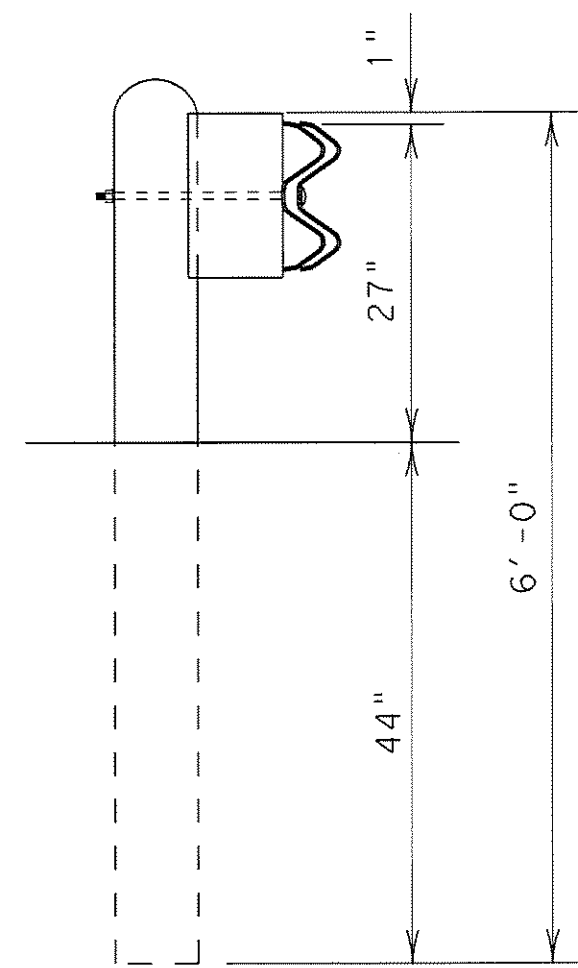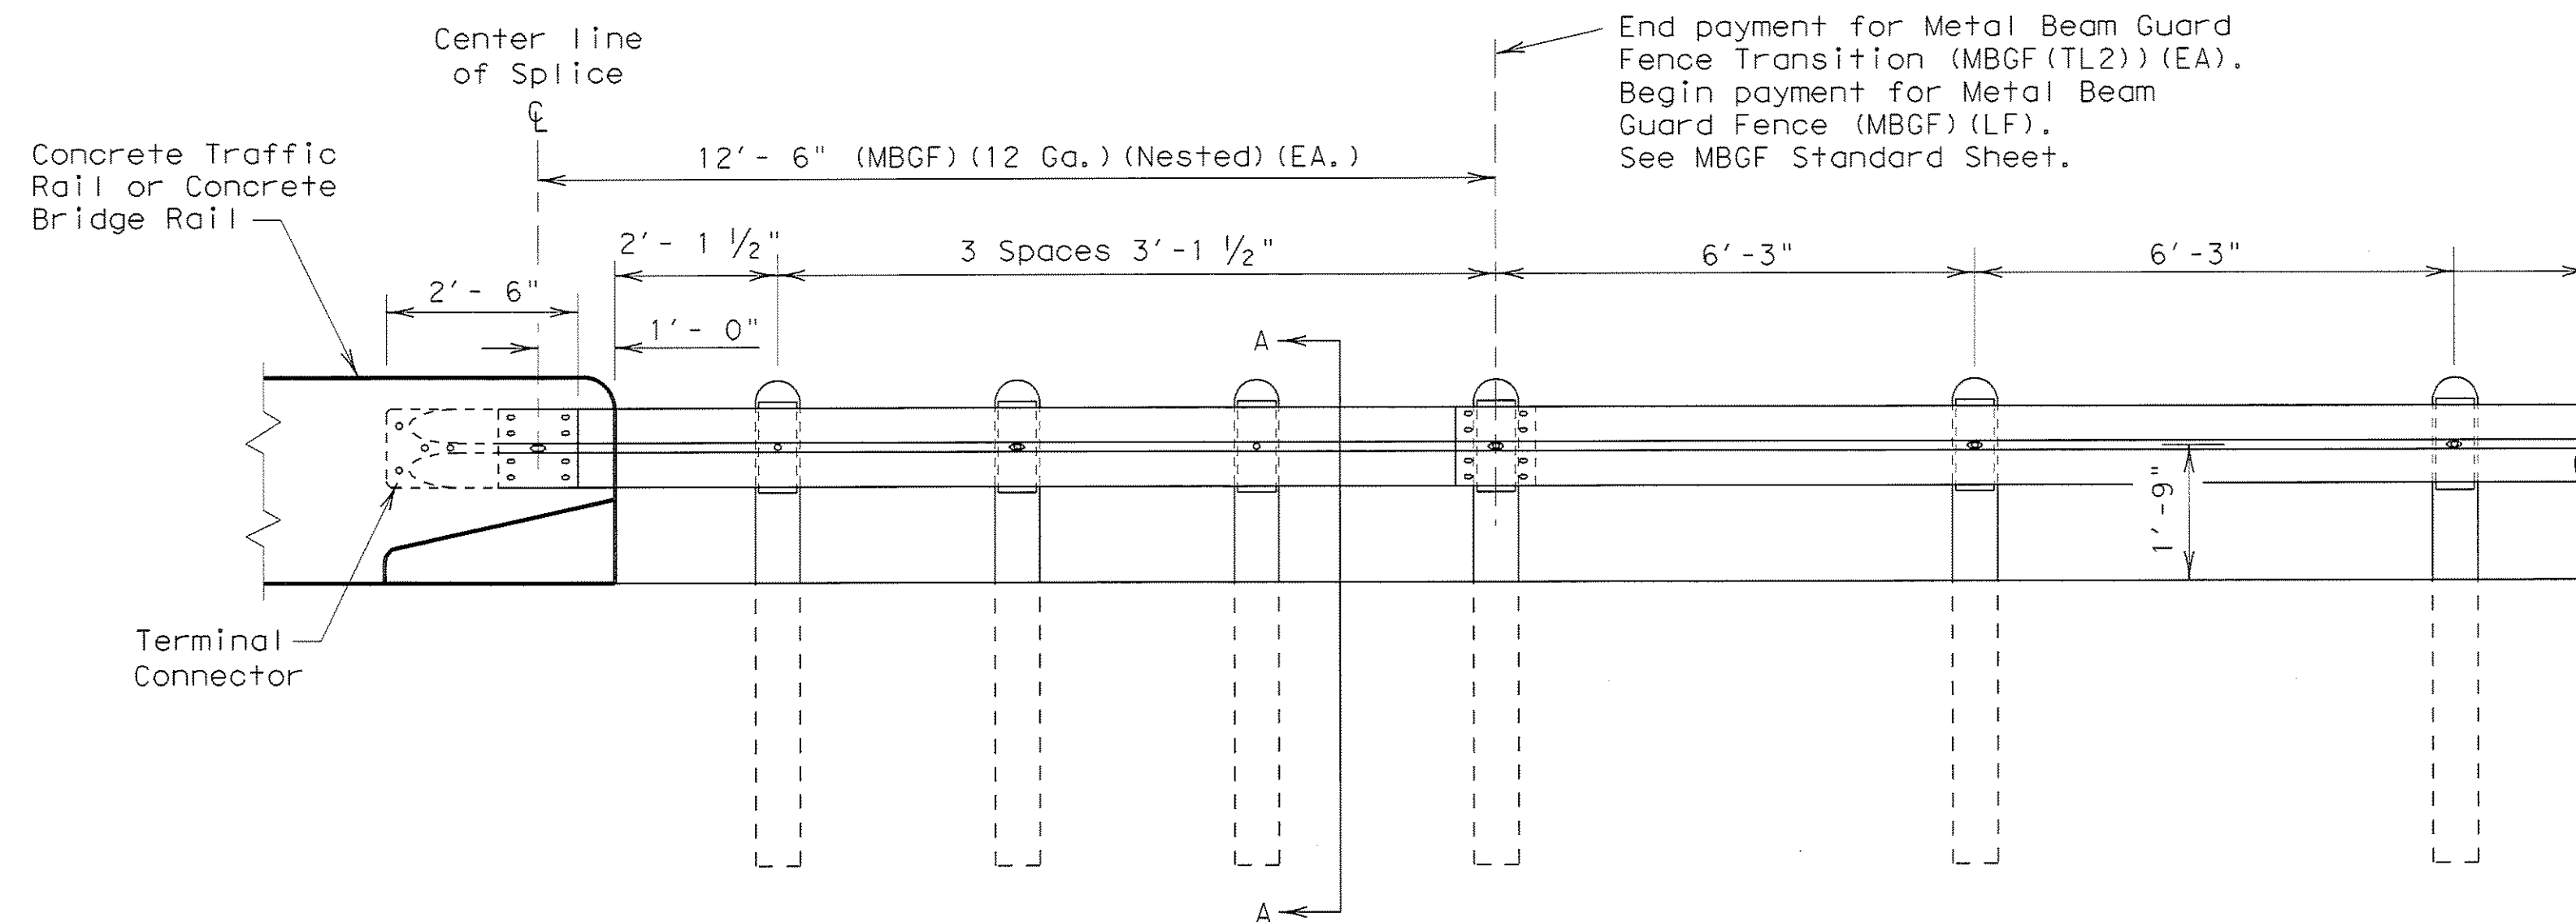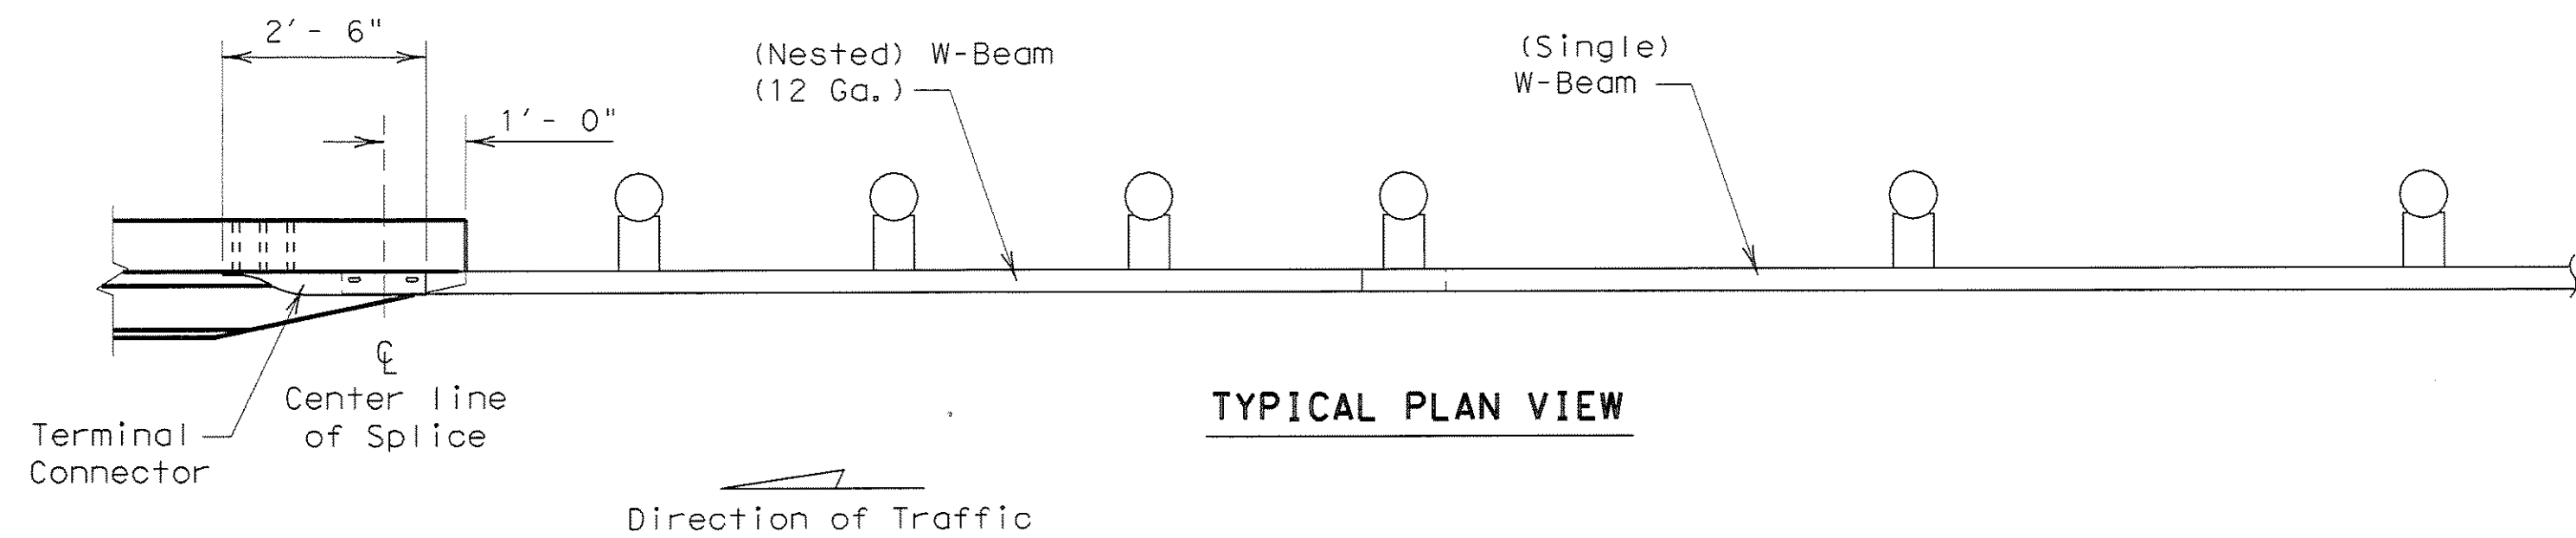

**WOOD BLOCKOUT TO RECTANGULAR WOOD POST DETAIL**

**WOOD BLOCKOUT TO STEEL POST DETAIL**

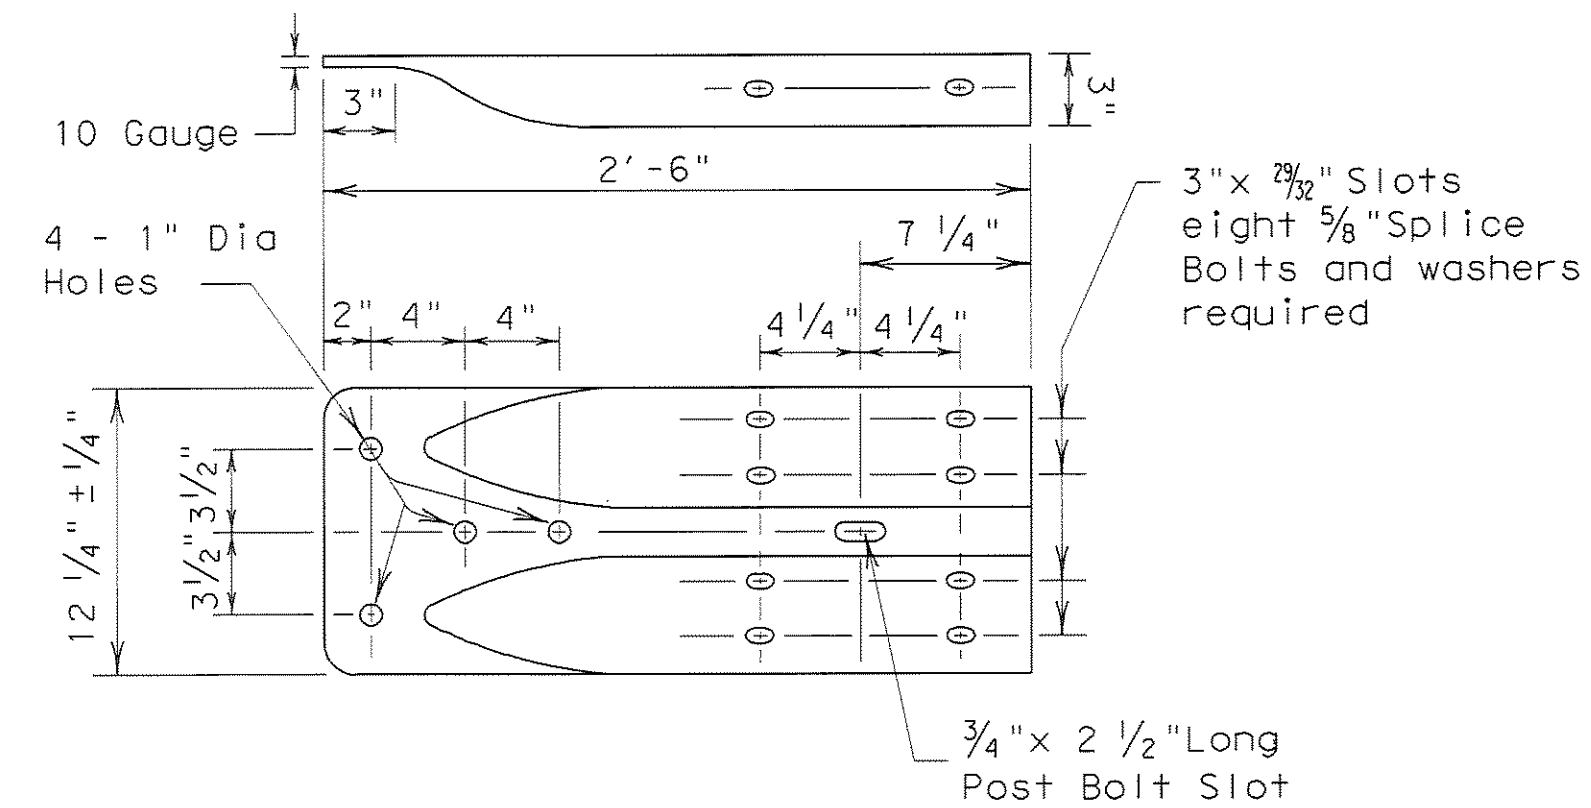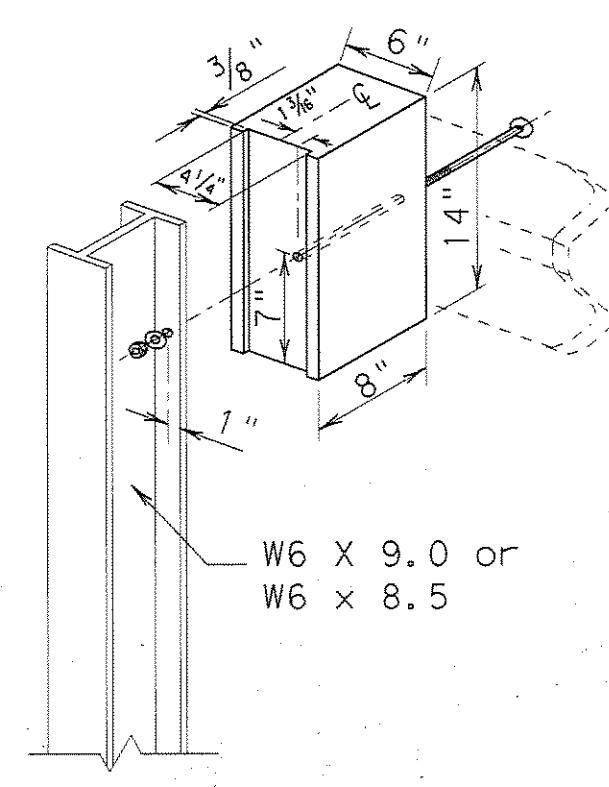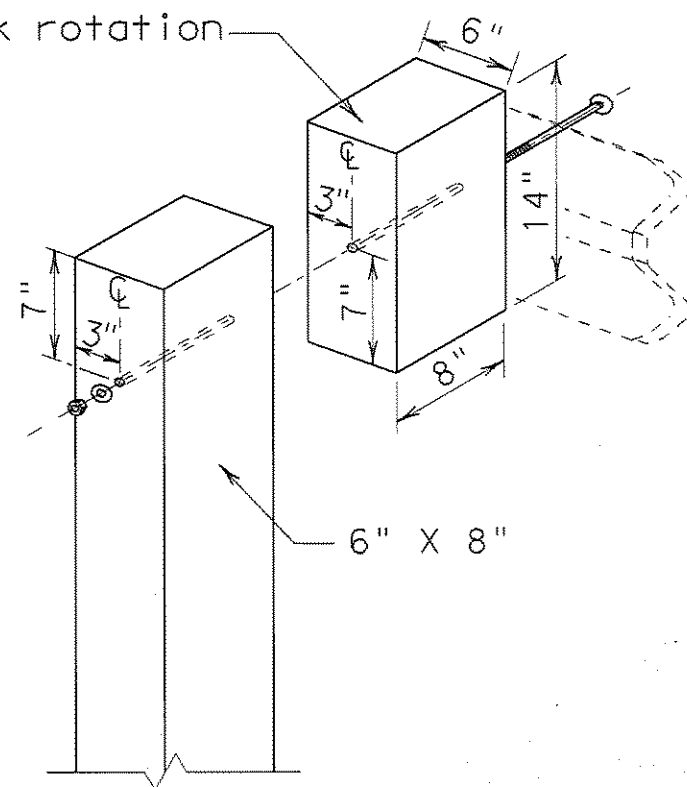

**GENERAL NOTES**

1. The type of post (round wood post, rectangular wood post, or steel post) will be shown elsewhere in the plans. The exact position of transitions shall be shown elsewhere in the plans or as directed by the Engineer.
2. Rail element shall meet all requirements of AASHTO M-180 except as modified on the plans.
3. Button head post bolts (A307) shall be of sufficient length to extend through the full thickness of the nut and no more than 3/4" beyond it. Button head splice bolts (A307) are 5/8" x 1 1/4" with a 5/8" double recessed nut. Galvanized fittings (bolts, nuts, and washers) shall be in accordance with Item, "Metal For Structures". Fittings shall be subsidiary to the bid item requiring construction of transition.
4. Crown will be widened to accommodate transitions.
5. Where solid rock is encountered or where shown on the plans, the diameter of the holes shall be approximately 12 inches, the backfilling shall be with a cohesionless material, and embedment depth shall be 1'-6" or more as directed by the Engineer.
6. Posts shall not be set full depth in concrete.
7. Unless otherwise directed by the Engineer, a composite material post and/or blockout from the Department approved list of suppliers may be substituted for a post and/or blockout of similar dimensions. The list of approved suppliers of posts and blockouts will be maintained by the Construction Division, TxDOT.
8. Refer to MBSGF Standard Sheet for additional details.

The use of this railing is restricted to design speeds of 45 mph or less.

Texas Department of Transportation  
Design Division (Roadway)

**METAL BEAM GUARD FENCE TRANSITION (TL2)**  
(Low Speed Transition)


**MBSGF (TL2) -05**

FILE: mbgtl205.dgn	DN: TxDOT	CK: AM	DR: BGD	CR:
© TxDOT April 2003	DIST	FEDERAL AID PROJECT	SHEET	
REVISIONS			P302	
	COUNTY	CONTROL SECT	JOB	HIGHWAY


RECORD PLANS  
MARCH 28, 2008

DISCLAIMER: The use of this standard is governed by the "Texas Engineering Practice Act". No warranty of any kind is made by TxDOT for any use of this standard other than that intended. TxDOT assumes no responsibility for any damages, including consequential damages, resulting from its use.


LEVELS DISPLAYED	
1	

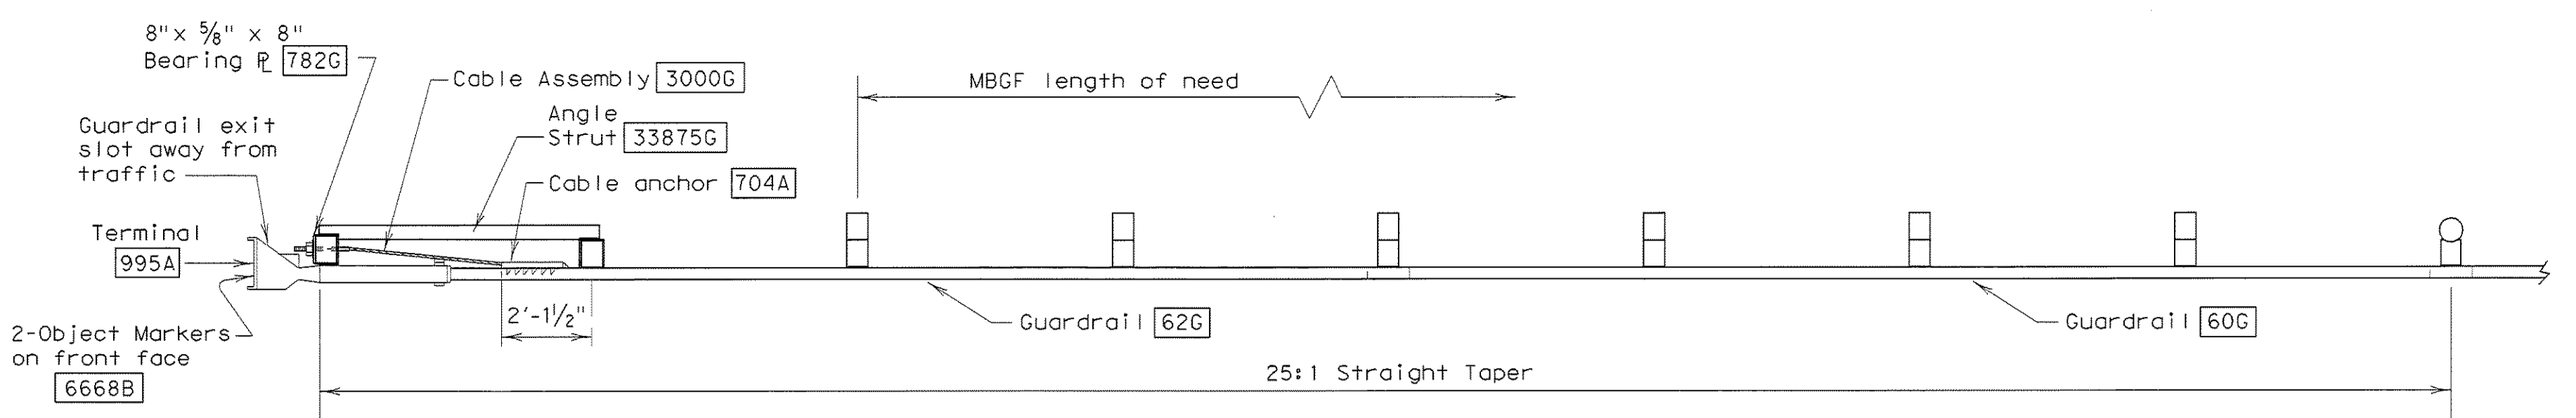

**PLAN**

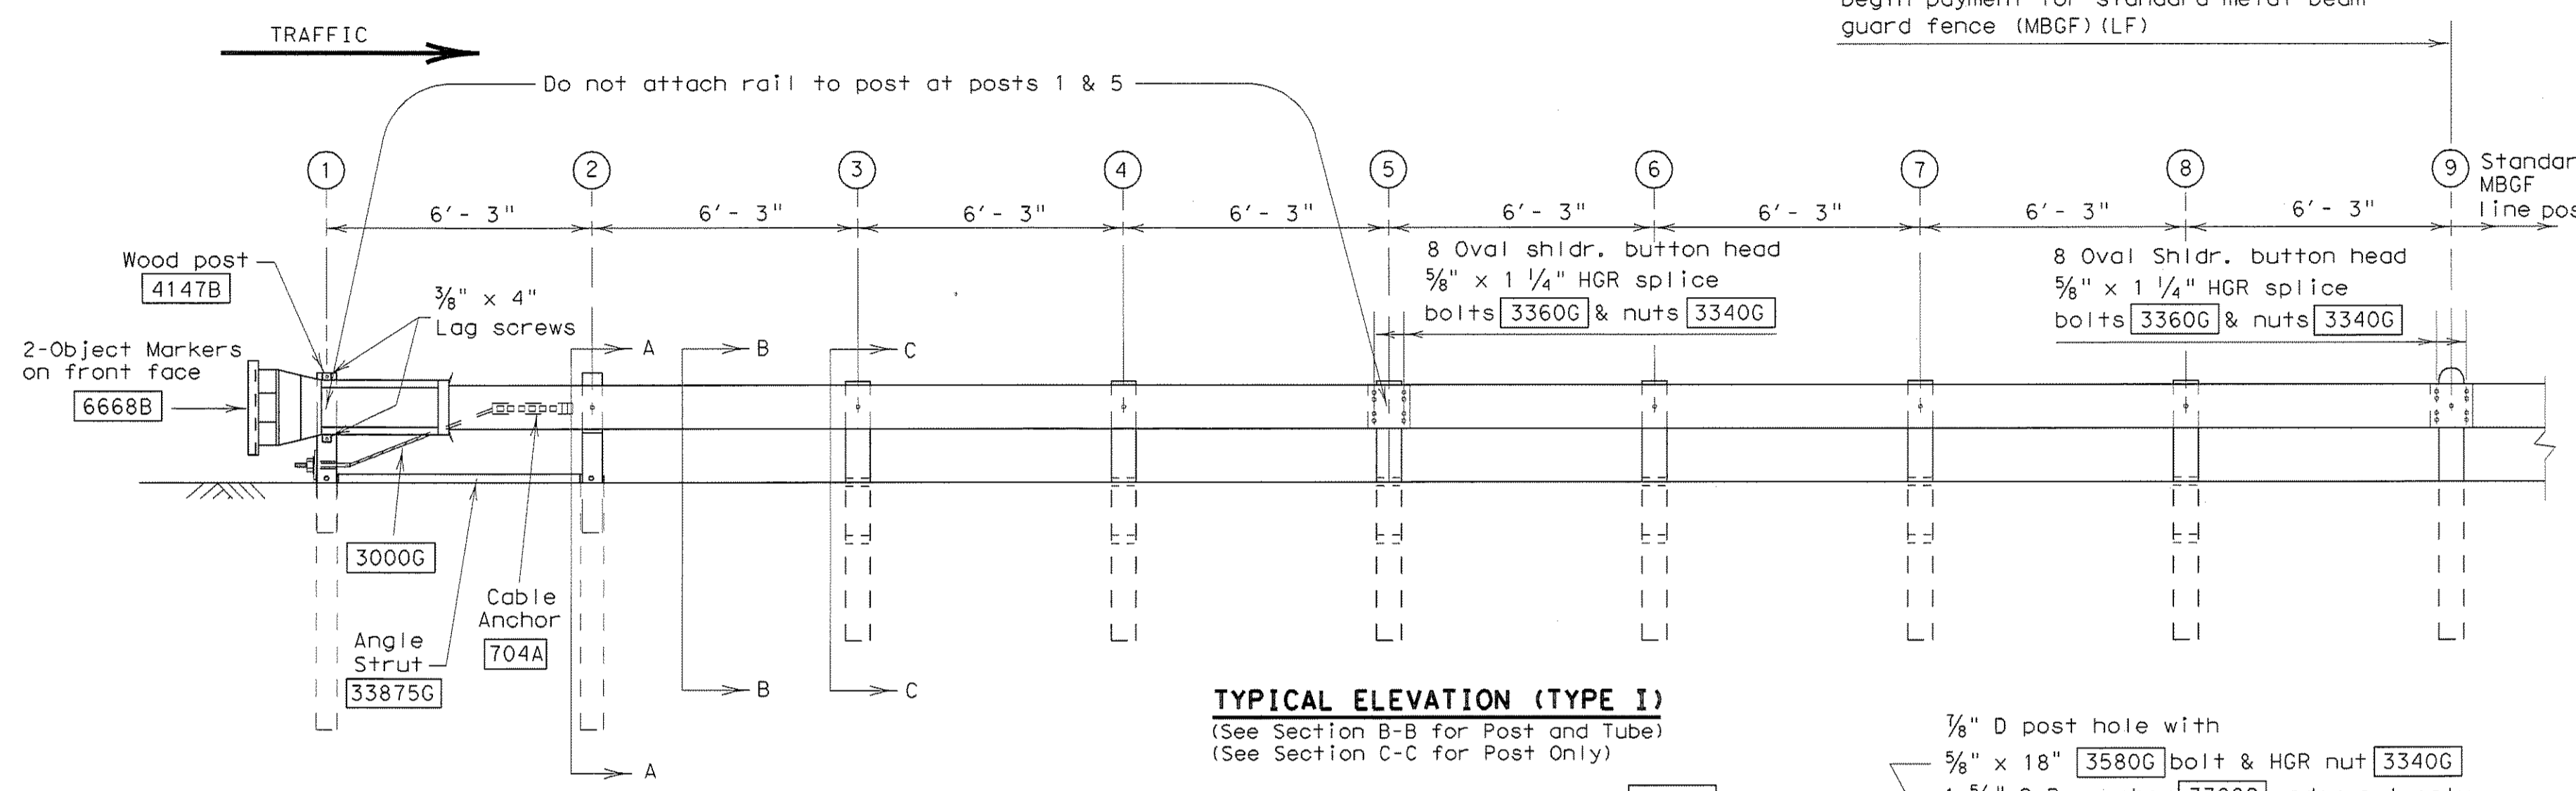


**TYPICAL ELEVATION (TYPE I)**

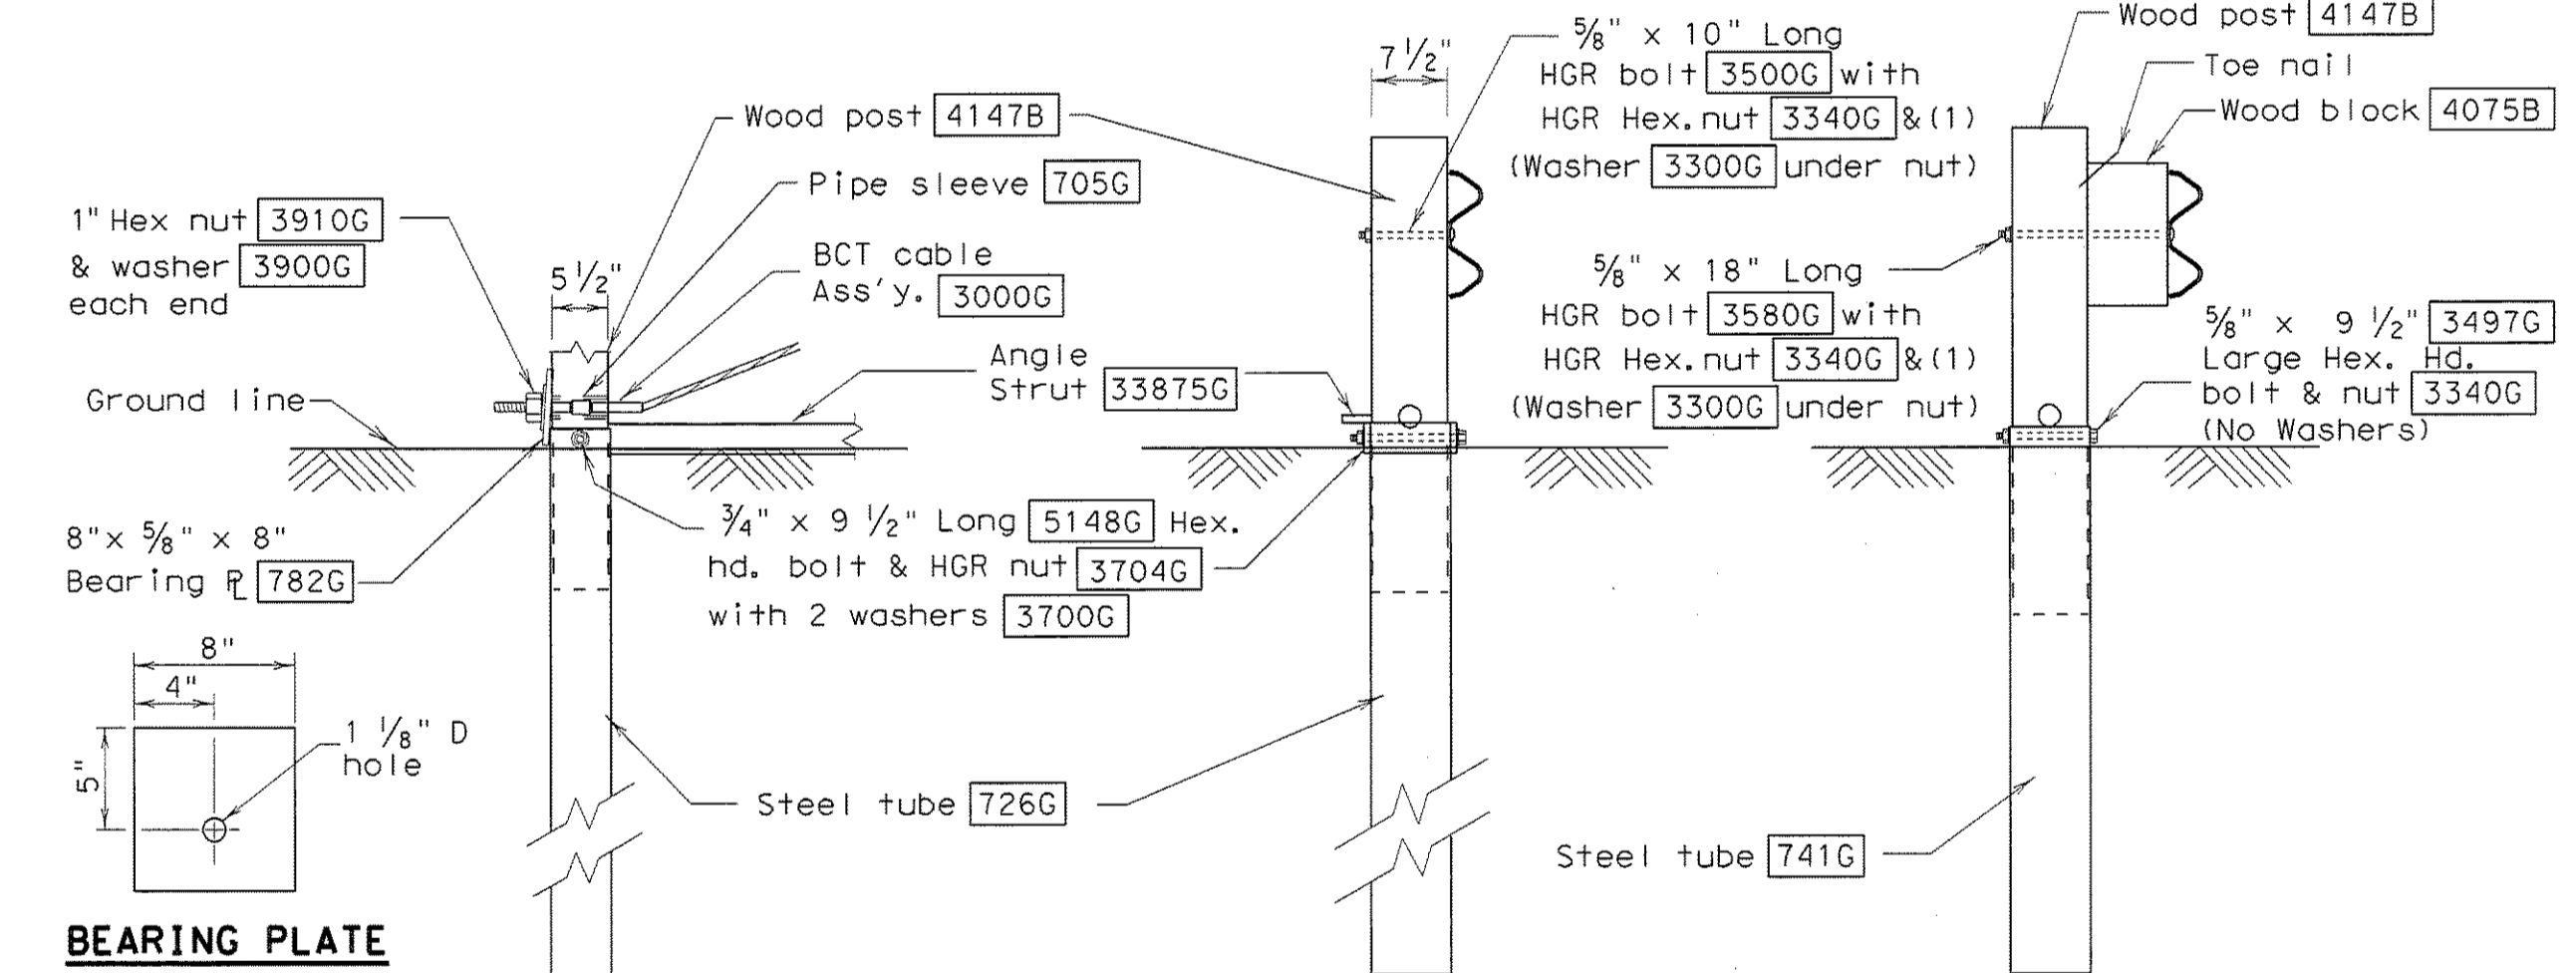


**PARTIAL VIEW AT POST #1**

**SECTION A-A**  
(at post 2)


**SECTION B-B**  
(Typ. at Posts 3 thru 8, Type II & III)

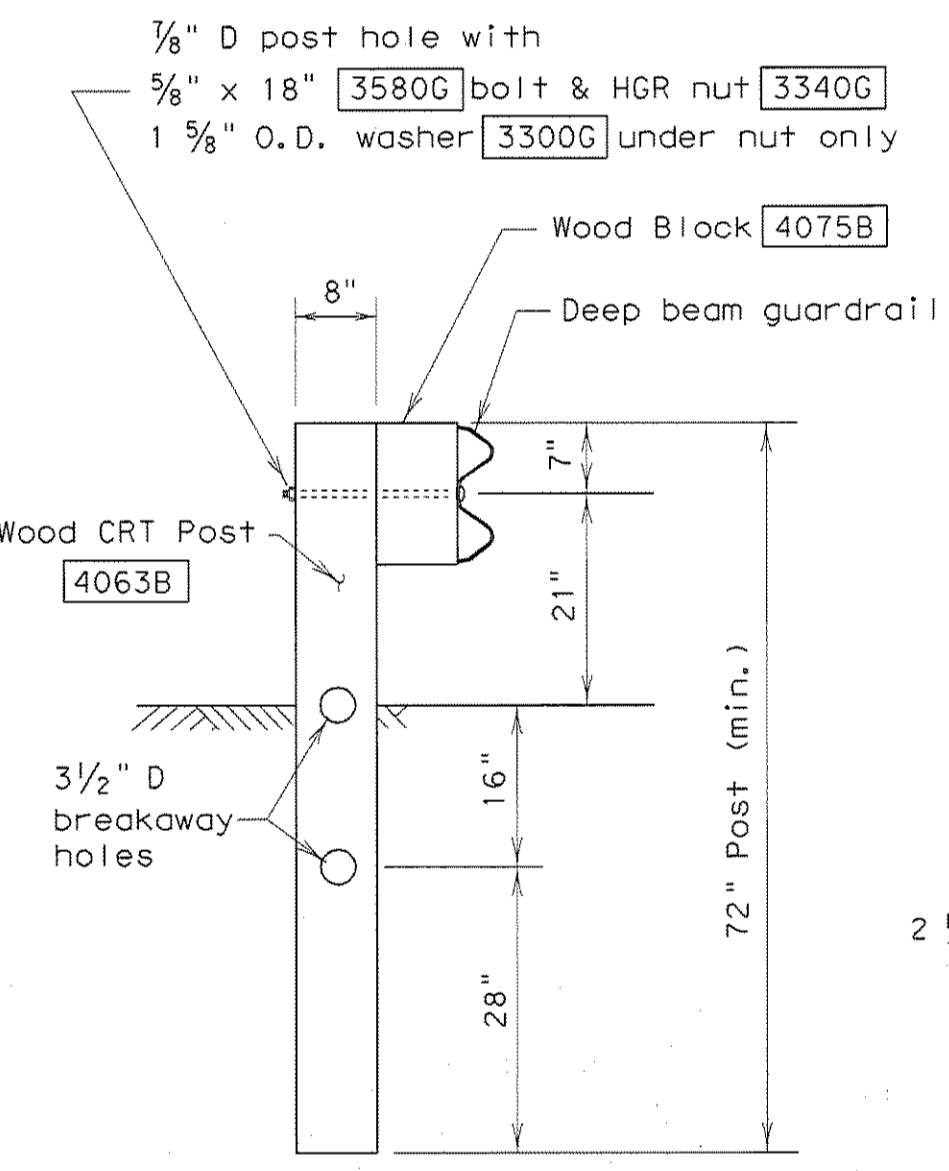


**SECTION C-C**  
(Typ. at post only positions)

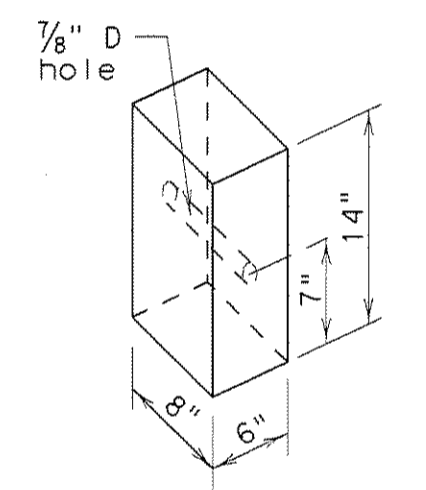


**WOOD BLOCKOUT**  
4075B

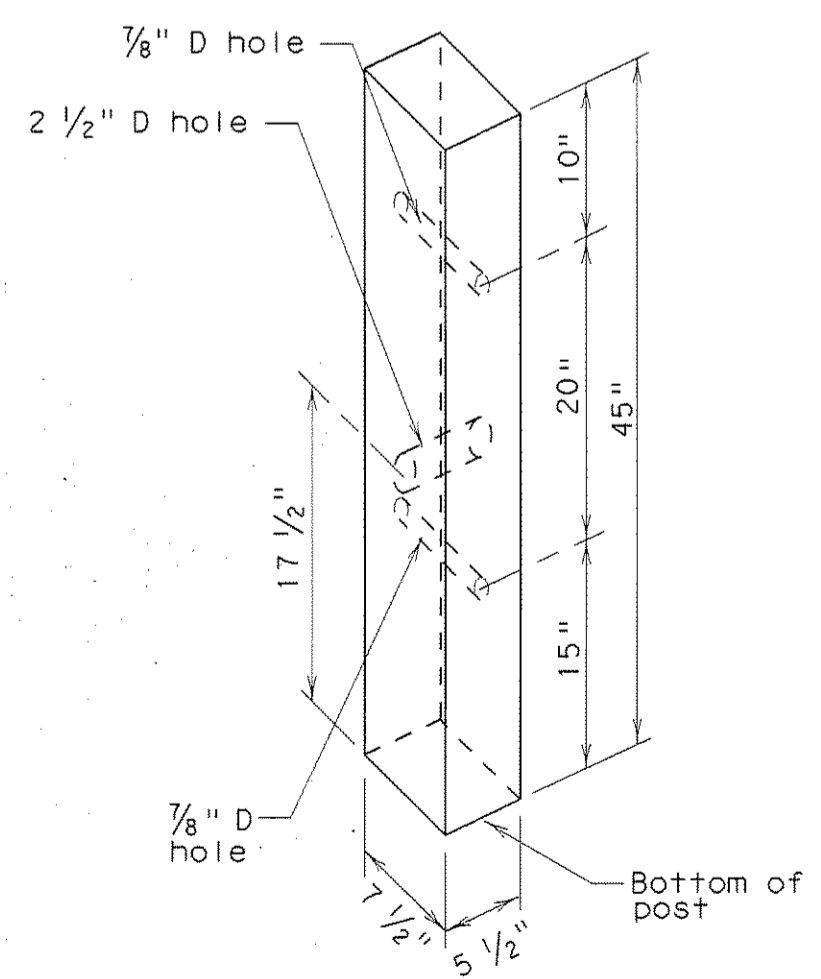

**WOOD POST**  
4147B

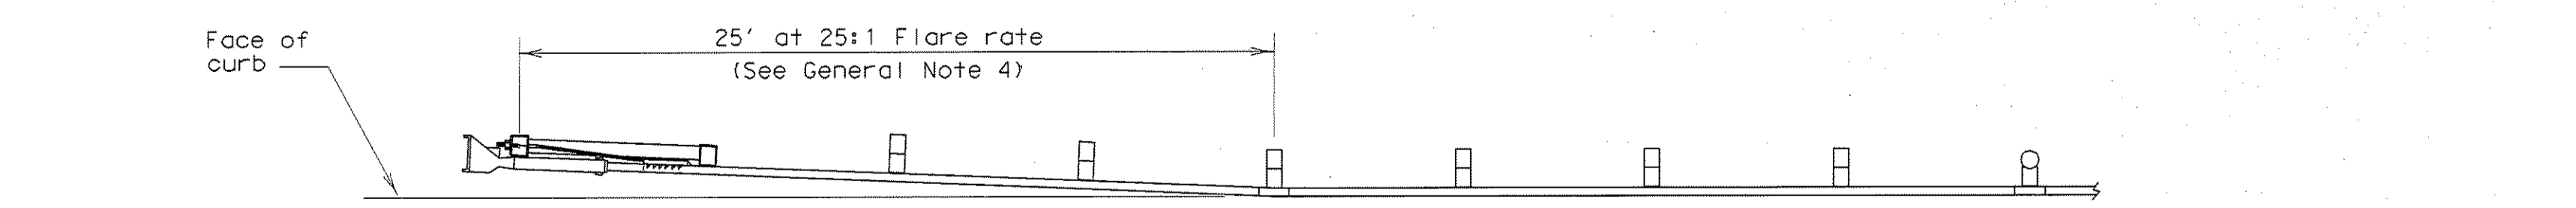

**DETAIL A**

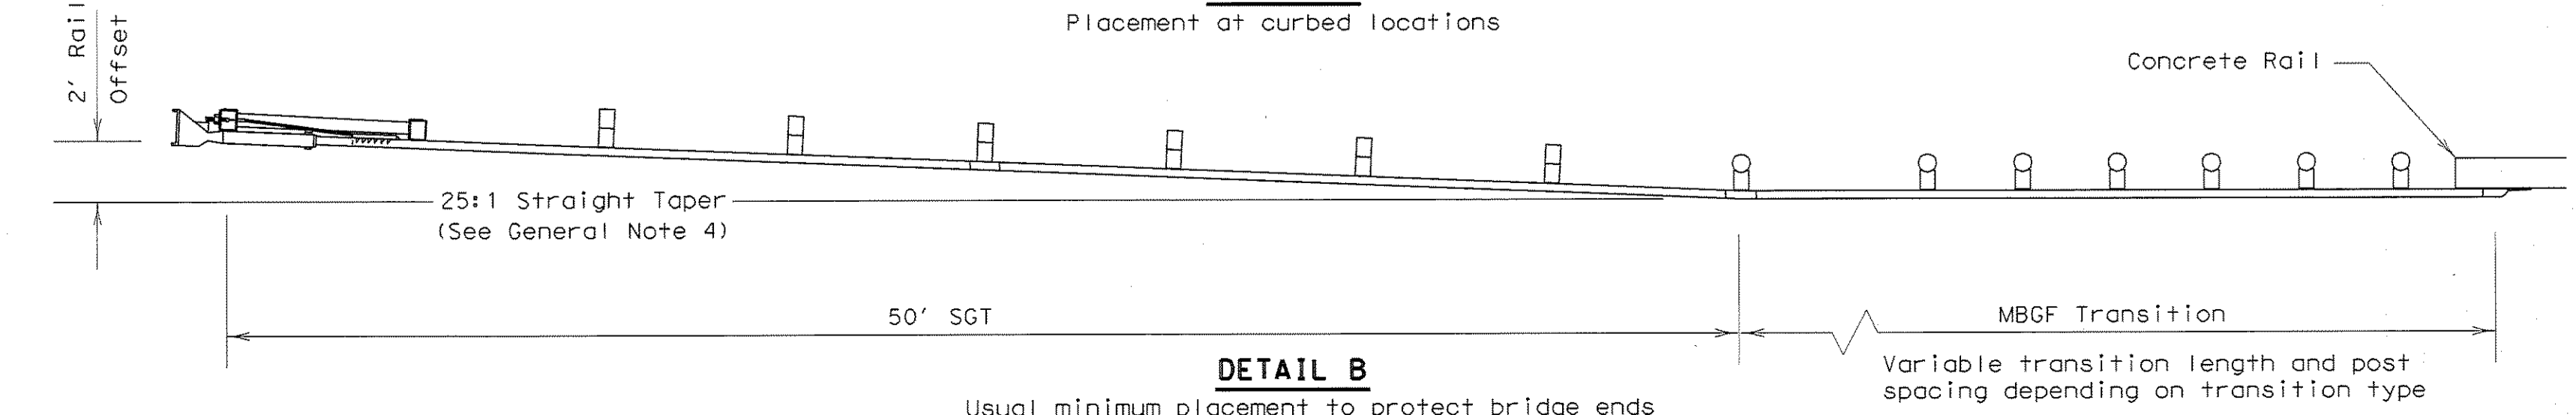

**DETAIL B**

**GENERAL NOTES**

- The Type of SGT unit will be specified elsewhere in the plans. Numbers in circles indicate post position. The Type of SGT unit chosen is a maintenance consideration and does not affect the systems performance.
 

Post & Tube Options		Post Only	
Type I	Posts ① thru ②	Posts ③ thru ⑥	
Type II	Posts ① thru ④	Posts ⑤ thru ⑥	
Type III	Posts ① thru ⑥	None	
- If the SGT system must be placed on a radius, the minimum radius is 150 feet.
- All bolts, nuts, cable assemblies, cable anchors, steel tubes & bearing plates shall be galvanized.
- For non-curb installations, the MGBF will be flared at a rate of 25:1 over the first 50 foot of the system to prevent the terminal head from encroaching on the shoulder. The flare may be decreased or eliminated for specific installations if directed by the Engineer. A 25:1 flare rate will be used at curb sections, beginning at post number 5 and ending at post number one.
- The steel tubes shall not protrude more than 4 inches above ground. Site grading may be necessary to meet this requirement.
- The steel tubes may be driven with an approved driving head. They shall not be driven with the wood post in the tube. If the steel tubes are placed in drilled holes, the backfill material must be satisfactorily compacted to prevent tube settlement.
- When rock excavation is encountered, a 12 inch diameter post hole, 20 inches deep may be used if approved by the Engineer. Granular material will be placed in the bottom of the hole approximately 2 1/2 inches deep to provide drainage. The steel tube sleeves will be field cut to 20 inches in length, placed in the hole and backfilled with adequately compacted material excavated from the hole.
- The breakaway cable assembly must be taut. A locking device, (vice grips or channel lock pliers) should be used to prevent the cable from twisting when tightening the nuts.
- The wood blockouts shall be "toe nailed" to the rectangular wood posts to prevent them from turning when the wood shrinks.
- For curb installations, the soil tubes and posts shall be installed at the proper ground elevation behind the curb. The posts will then require field drilling new holes to accommodate the rail to post connection bolt to maintain the proper height of the rail above the gutter pan. The excess post length above the rail will be removed if directed by the Engineer.
- An object marker shall be installed on the front of the impact head as detailed on D&M(VIA).
- A special site evaluation should be considered, prior to using this end treatment where there is less than 25 feet between the extrusion side of the end treatment and any adjacent driving lane.

**BILL OF MATERIAL**

Code #	POST & TUBE OPTIONS			DESCRIPTION
	Type I Qty.	Type II Qty.	Type III Qty.	
62G	1	1	1	#1 Deep Beam Guardrail (12 Ga) at 25'
60G	1	1	1	#2 Deep Beam Guardrail (12 Ga) at 25'
726G	2	2	2	Steel Tube - 6"x 8"x 72"x 1/8" min
741G	0	2	6	Steel Tube - 6" x 8" x 54" x 1/8" min
4147B	2	4	8	Wood Posts - 5 1/2" x 7 1/2" x 45"
4063B	6	4	0	Wood CRT Posts - 6" x 8" x 72"
4075B	6	6	6	Wood Block - 6" x 8" x 14"
705G	1	1	1	Pipe Sleeve - 2" std. pipe x 5 1/2"
782G	1	1	1	Bearing Plate - 8" x 8" x 5/8"
704A	1	1	1	Cable Anchor
3000G	1	1	1	Cable Assembly (3/4" x 78")
33875G	1	1	1	Angle Strut
995A	1	1	1	ET-2000 Plus Guardrail Terminal
<b>HARDWARE</b>				
5148G	2	2	2	3/4" x 9 1/2" Hex Hd (Top of tubes 1&2) A325
3300G	7	7	7	5/8" Washers
3478G	2	2	2	5/8" x 7 1/2" Hex Bolt
3500G	1	1	1	5/8" x 10" Post Bolt (Post 2 of LET)
3580G	6	6	6	5/8" x 18" HGR Post Bolt (posts ③ thru ⑥)
3360G	16	16	16	5/8" x 1 1/4" HGR Splice Bolt
3340G	25	27	31	5/8" HGR Nut (16-spl, 7-posts)
4228G	2	2	2	3/4" x 4" Lag Screw
3910G	2	2	2	1" Hex Nut (Anchor Cable)
3900G	2	2	2	1" Washer (Anchor Cable)
6668B	2	2	2	Object Marker (12" x 12")
3700G	4	4	4	3/4" Washer
3704G	2	2	2	3/4" Heavy Hex Nut
3497G	0	2	6	5/8" x 9 1/2" Hex Hd (Top of Tubes 3-8) A307

All measurements should be taken from bottom of posts.

POST & TUBE OPTIONS	
Type I	Posts ① thru ②
Type II	Posts ① thru ④
Type III	Posts ① thru ⑥

**RECORD PLANS**  
MARCH 28, 2008

R = Radius  
D = Diameter

Texas Department of Transportation  
 Design Division (Roadway)  
**SINGLE GUARDRAIL TERMINAL**  
 (ET-2000 PLUS)  
 (WOOD POST)  
**SGT (7) -03A**


FILE: sgtT03a.dgn	DN: MAM	CK: MAM	DW: BGD	CK:
© TxDOT APRIL 1997	DIST	FEDERAL AID PROJECT	SHEET	
REVISIONS		COUNTY		CONTROL SECT
		JOB		HIGHWAY

P303


DISCLAIMER: The use of this standard is governed by the "Texas Engineering Practice Act". No warranty of any kind is made by TxDOT for any purpose whatsoever. TxDOT assumes no responsibility for the conversion of this standard to other formats or for incorrect results or damages resulting from its use.

FILE: CRCP103.DGN


LEVELS DISPLAYED

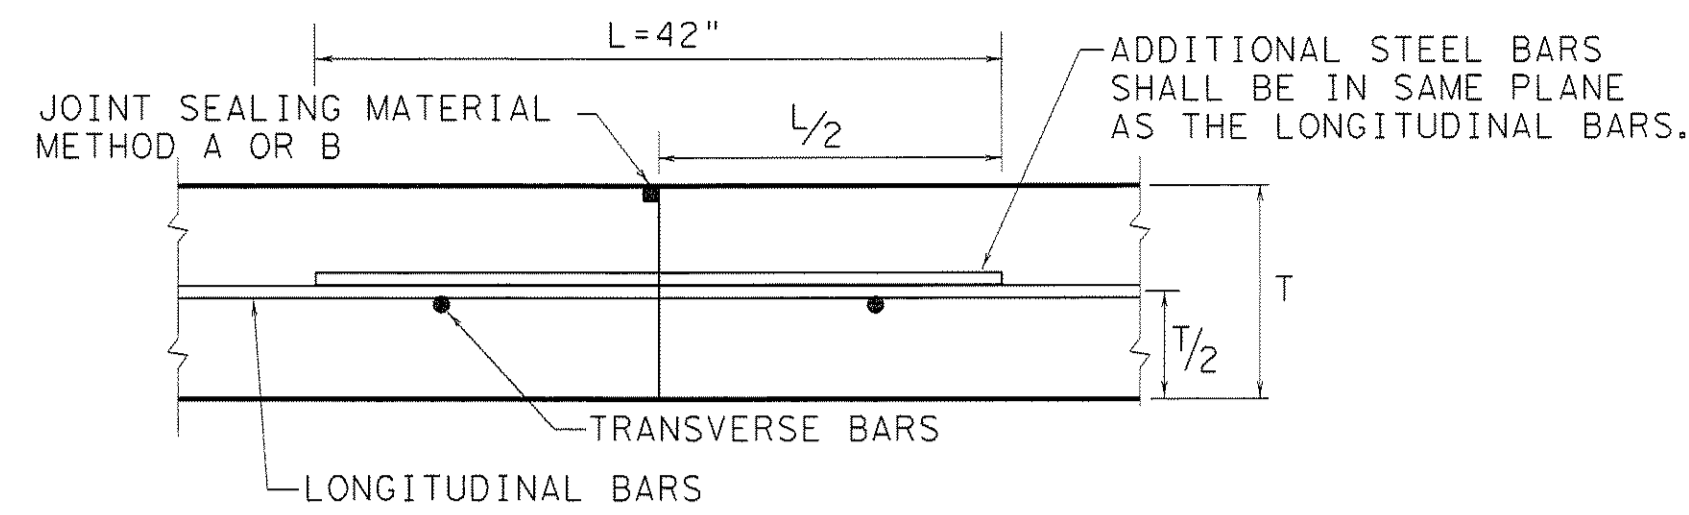


**TRANSVERSE CONSTRUCTION JOINT SECTION X - X**

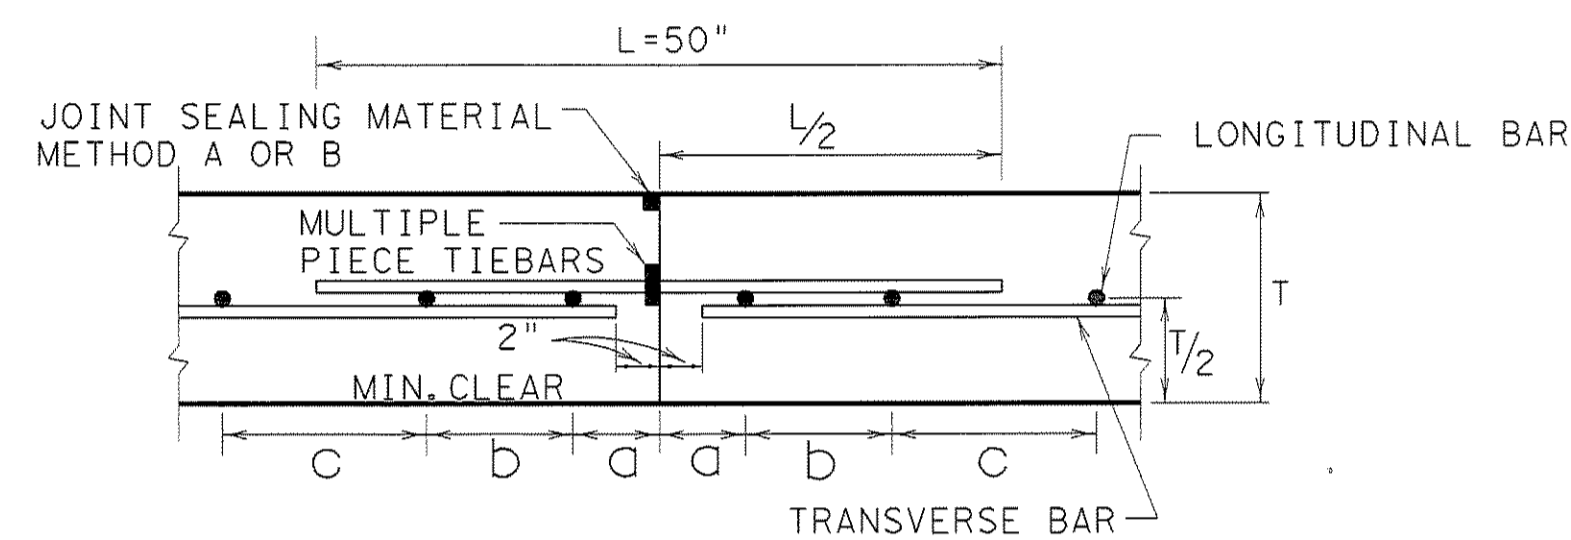


**LONGITUDINAL CONSTRUCTION JOINT SECTION Y - Y**

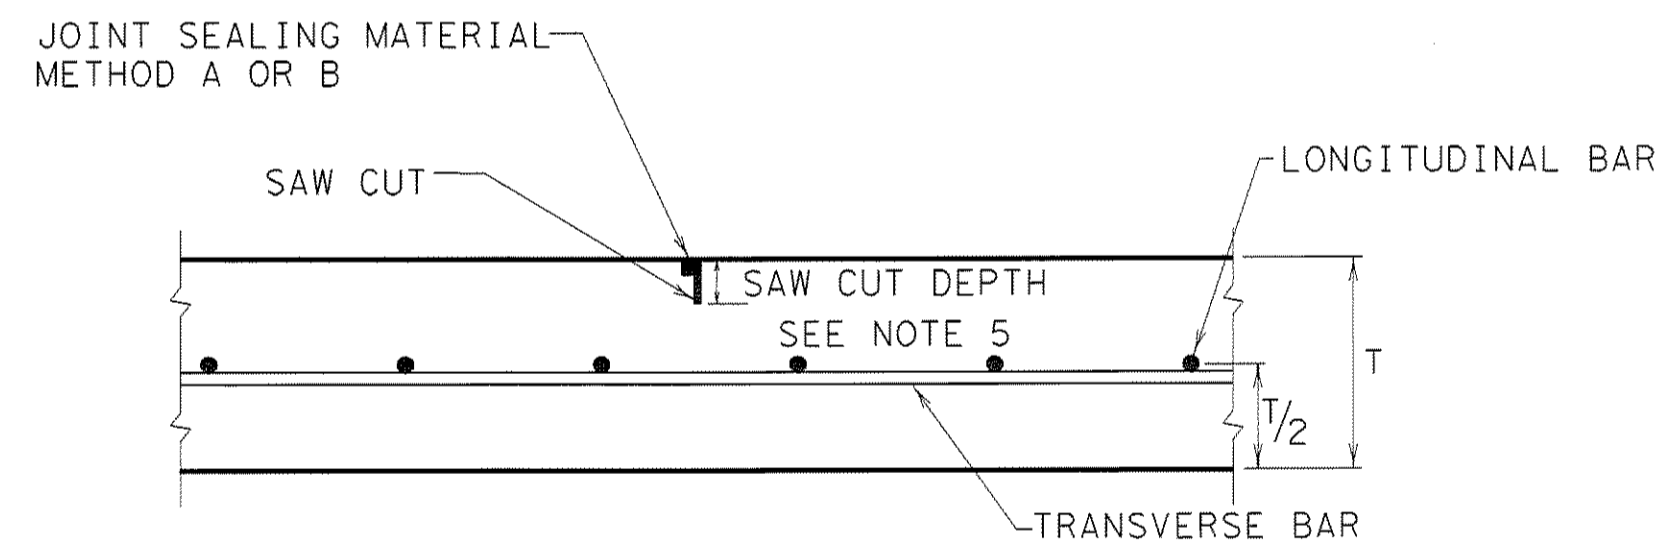

**LONGITUDINAL CONTRACTION JOINT SECTION Z - Z**

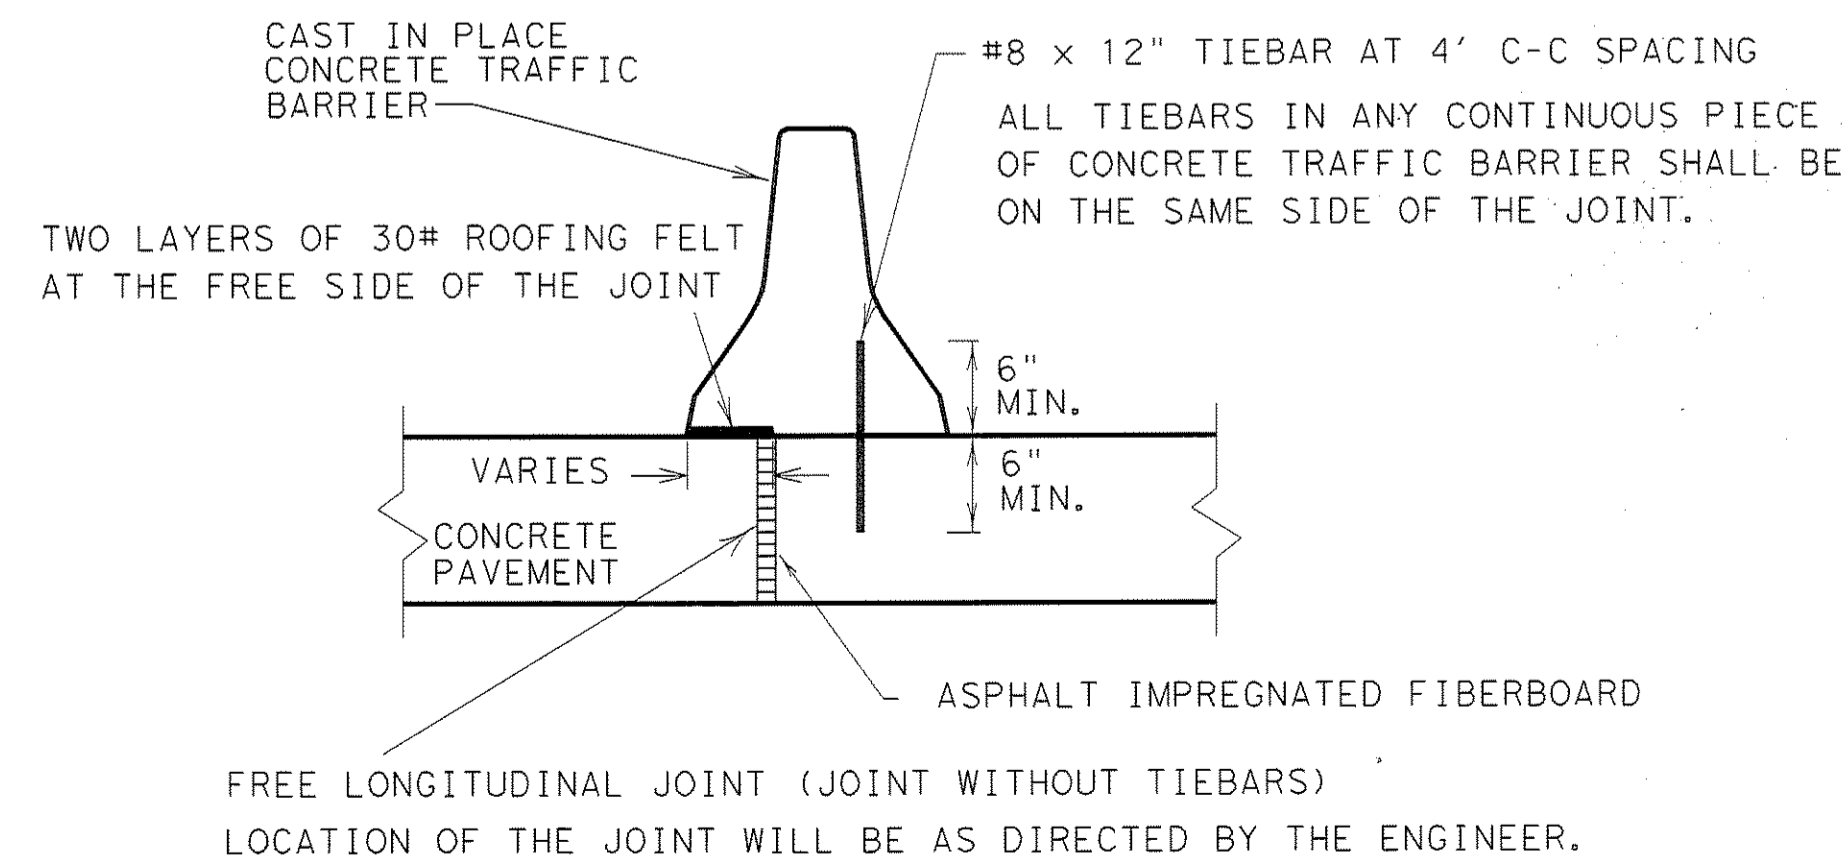

**FREE LONGITUDINAL JOINT DETAIL**

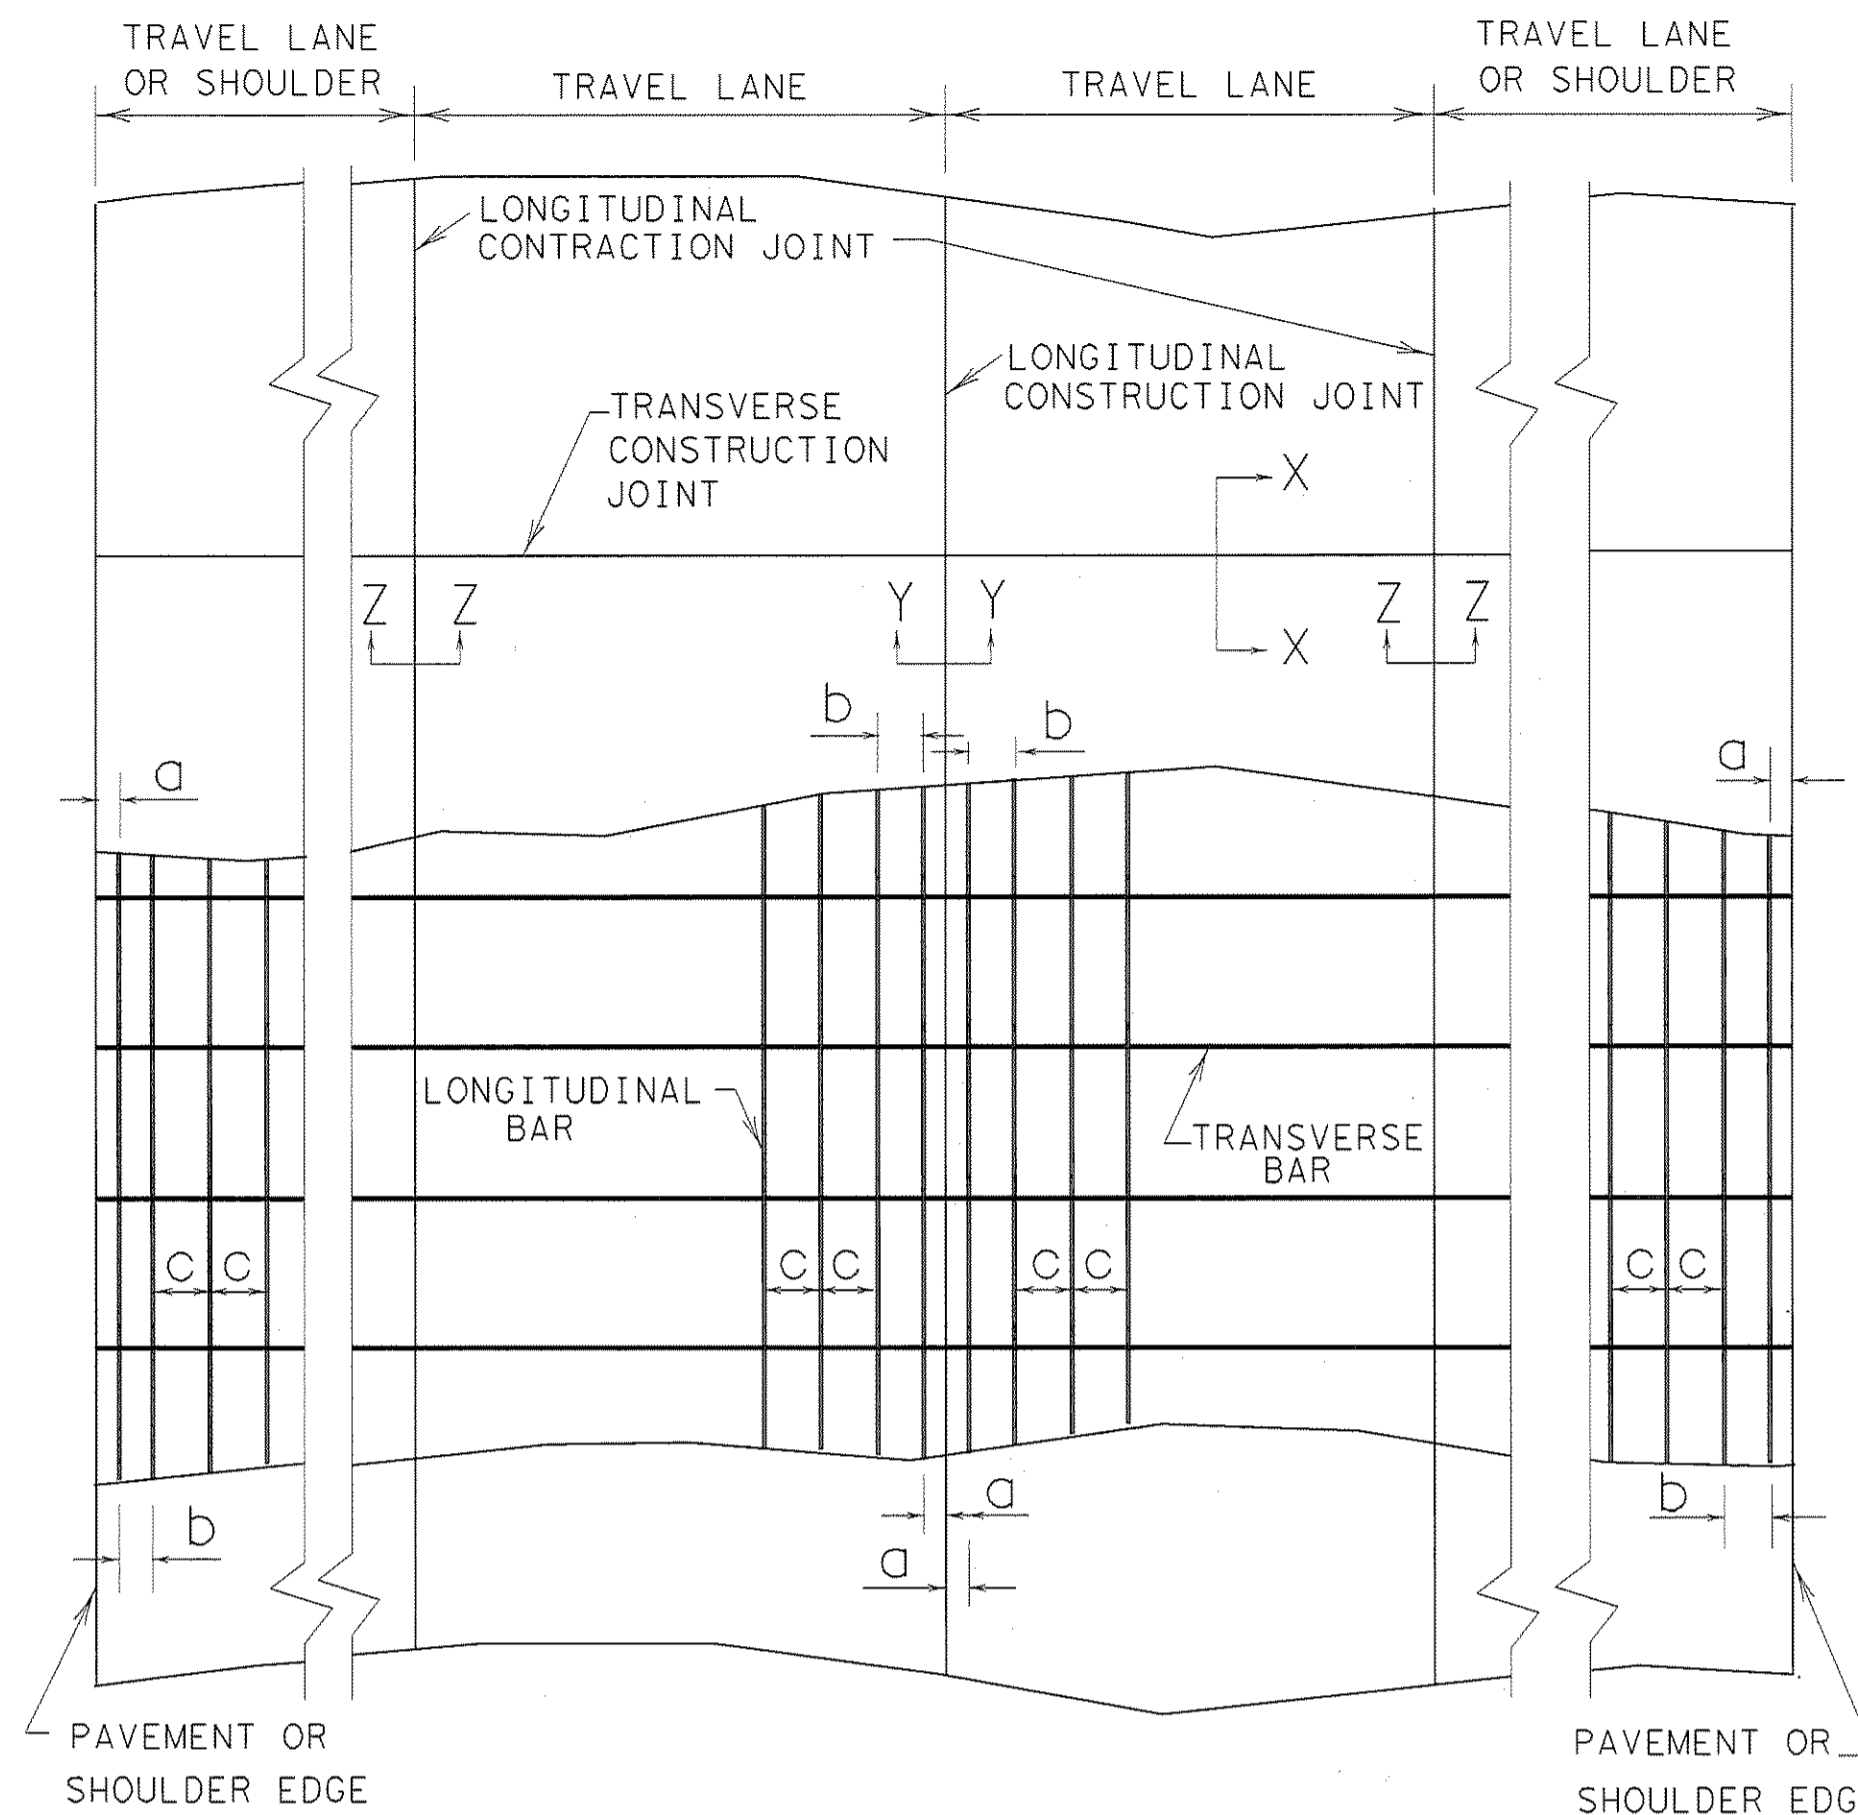

**TYPICAL PAVEMENT LAYOUT**

**TABLE NO. 1 LONGITUDINAL STEEL**

SLAB THICKNESS AND BAR SIZE		REGULAR STEEL BARS	FIRST SPACING AT EDGE OR JOINT	SECOND SPACING FROM EDGE OR JOINT	ADDITIONAL STEEL BARS AT TRANSVERSE CONST. JOINT	
T (IN.)	BAR SIZE	SPACING C (IN.)	SPACING a (IN.)	SPACING b (IN.)	SPACING 2 x c (IN.)	LENGTH L (IN.)
8	#6	9	3 TO 4	3 TO 9	18	42
9	#6	8	3 TO 4	3 TO 8	16	42
10	#6	7	3 TO 4	3 TO 7	14	42
11	#6	6.5	3 TO 4	3 TO 6.5	13	42
12	#6	6	3 TO 4	3 TO 6	12	42
13	#6	5.5	3 TO 4	3 TO 5.5	11	42

**TABLE NO. 2 TRANSVERSE STEEL**

SLAB THICKNESS AND BAR SIZE		PAVEMENT WIDTH (PW) FROM LONGITUDINAL FREE EDGE TO NEAREST LONGITUDINAL FREE EDGE, FT.						
T (IN.)	BAR SIZE	PW <=48	PW <=60	PW <=72	PW <=84	PW <=96	PW <=108	PW <=120
8	#6	3	3	3	3	2.5	2.5	2
9	#6	3	3	3	2.5	2	2	1.5
10	#6	3	3	2.5	2.5	2	1.5	1.5
11	#6	3	2.5	2.5	2	2	1.5	1.5
12	#6	3	2.5	2	2	1.5	1.5	1
13	#6	2.5	2.5	2	1.5	1.5	1.5	1

**GENERAL NOTES**

1. DETAILS FOR PAVEMENT WIDTH, PAVEMENT THICKNESS AND THE CROWN CROSS-SLOPE SHALL BE SHOWN ELSEWHERE IN THE PLANS.
2. LONGITUDINAL AND TRANSVERSE REINFORCING STEEL SHALL BE #6 DEFORMED STEEL BARS CONFORMING TO ASTM A 615 (GRADE 60) OR ASTM A 996 (GRADE 60).
3. THE DETAIL FOR THE JOINT SEALANT AND RESERVOIR IS SHOWN ON STANDARD SHEET "CONCRETE PAVING DETAILS, JOINT SEALS."
4. PAVEMENT WIDTHS OF MORE THAN 15 FT. SHALL HAVE A LONGITUDINAL JOINT (SECTION Z-Z OR Y-Y). THESE JOINTS SHALL BE LOCATED WITHIN 6 IN. OF THE LANE LINE UNLESS THE JOINT LOCATION IS SHOWN ELSEWHERE ON THE PLANS.
5. THE SAW CUT DEPTH FOR THE LONGITUDINAL JOINT SHALL BE MINIMUM OF ONE THIRD THE SLAB THICKNESS. IT MAY BE MINIMUM OF ONE FOURTH THE SLAB THICKNESS WHEN CRUSHED LIMESTONE IS USED AS THE COARSE AGGREGATE.
6. REINFORCING STEEL SPLICES SHALL BE A MINIMUM OF 25 IN.
7. MULTIPLE PIECE TIEBARS SHALL BE USED AT LONGITUDINAL CONSTRUCTION JOINTS UNLESS OTHERWISE SPECIFIED IN THE PLANS. THE TIEBARS SHALL BE #6 BARS. THE TIEBAR SPACING SHALL BE EQUAL TO THE TRANSVERSE BAR SPACING.
8. STEEL BAR PLACEMENT TOLERANCE SHALL BE +/- 1 IN. HORIZONTALLY AND +/- 0.5 IN. VERTICALLY. THE AVERAGE BAR SPACINGS SHALL CONFORM TO TABLE NO. 1 AND TABLE NO. 2.
9. MISSING OR DAMAGED TIEBARS SHALL BE REPLACED BY DRILLING AND EPOXY GROUTING AT THE CONTRACTOR'S EXPENSE.
10. AT TRANSVERSE CONSTRUCTION JOINTS, THE ADDITIONAL STEEL BARS SHALL BE PLACED APPROXIMATELY MIDWAY BETWEEN THE LONGITUDINAL STEEL BARS.
11. CONSOLIDATION WITH HAND-MANIPULATED MECHANICAL VIBRATORS IS REQUIRED ADJACENT TO ALL TRANSVERSE CONSTRUCTION JOINTS.

**RECORD PLANS  
MARCH 28, 2008**

Texas Department of Transportation
   
 Construction Division (Pavements)


**CONTINUOUSLY REINFORCED  
CONCRETE PAVEMENT**
  
 ONE LAYER STEEL BAR PLACEMENT
   
 T-8, 9, 10, 11, 12, & 13 INCHES

**CRCP (1) - 03**


© TxDOT SEPTEMBER 2003	DRI - HC	CKI - MCW	DRI - HC	CKI - GEL	SHEET
MODIFICATIONS	DISTRICT	FEDERAL AID PROJECT		JOB	HIGHWAY
COUNTY		CONTROL SECTION	P 304		

DISCLAIMER: The use of this standard is governed by the "Texas Engineering Practice Act." No warranty of any kind is made by TxDOT for any purpose whatsoever. TxDOT assumes no responsibility for the conversion of units or for other errors or for incorrect results or damages resulting from its use.


LEVELS DISPLAYED	
1	

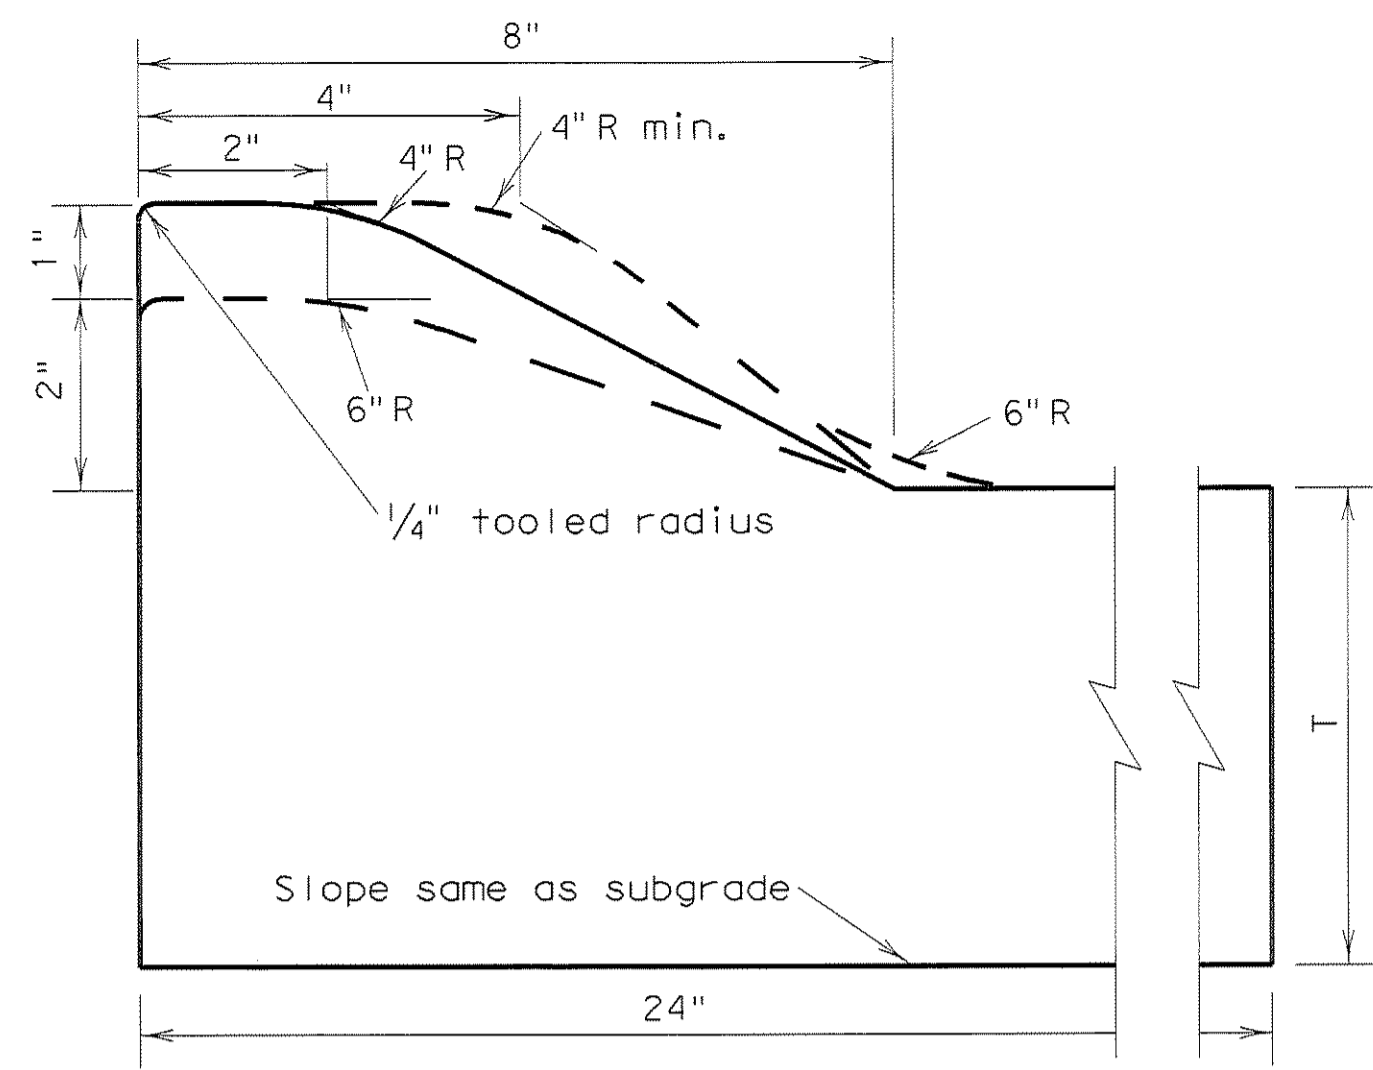

TYPE I CURB AND GUTTER

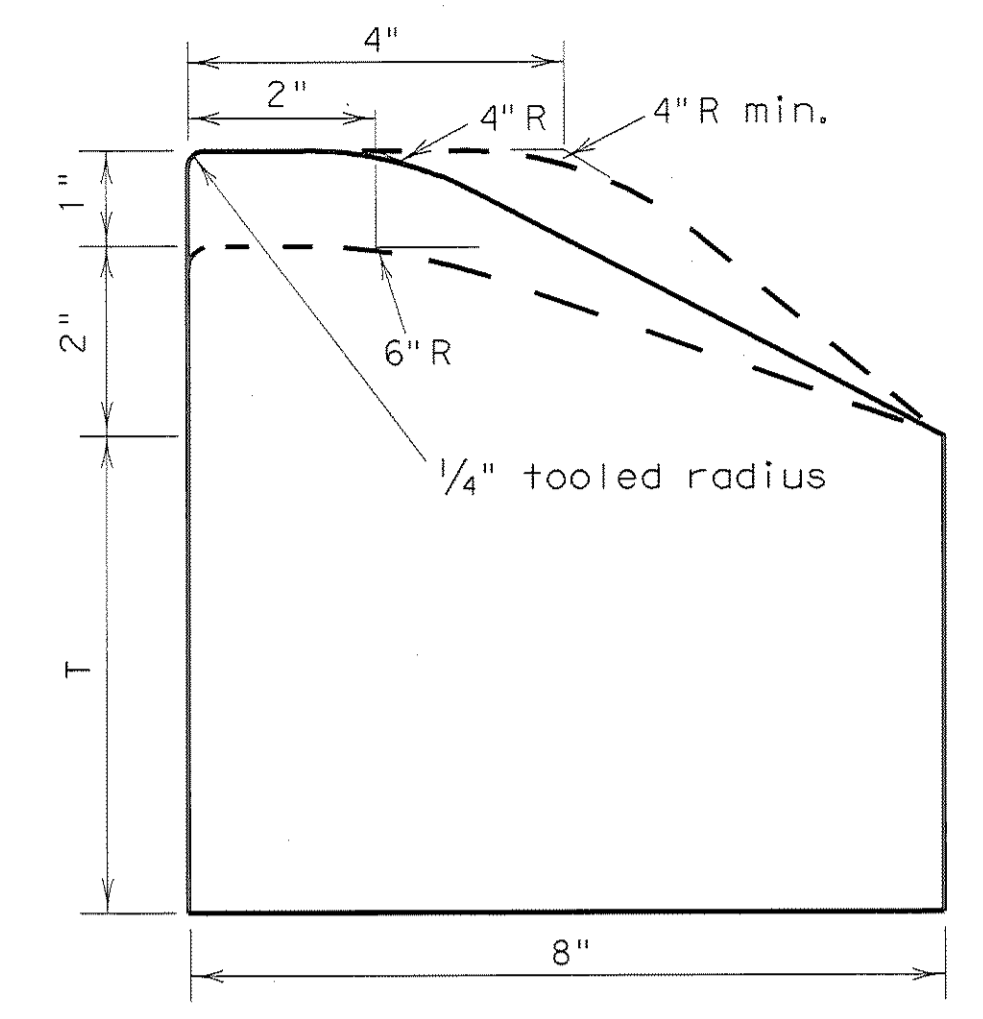


TYPE I CURB

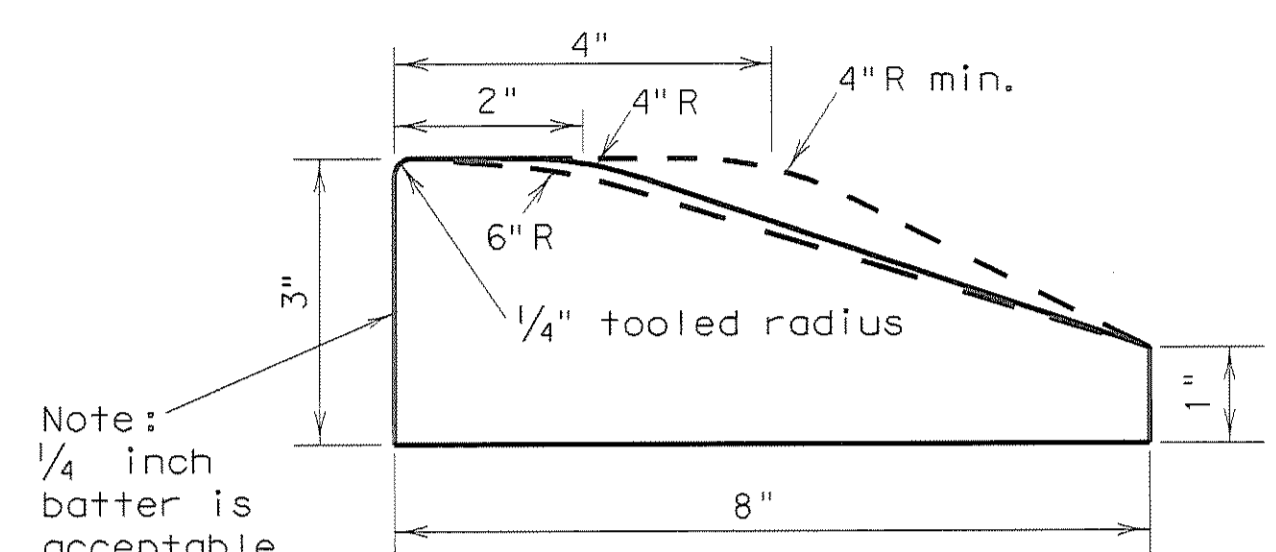


TYPE I MONO CURB OR CURB PLACED ON PAVEMENT


Note: 1/4 inch batter is acceptable

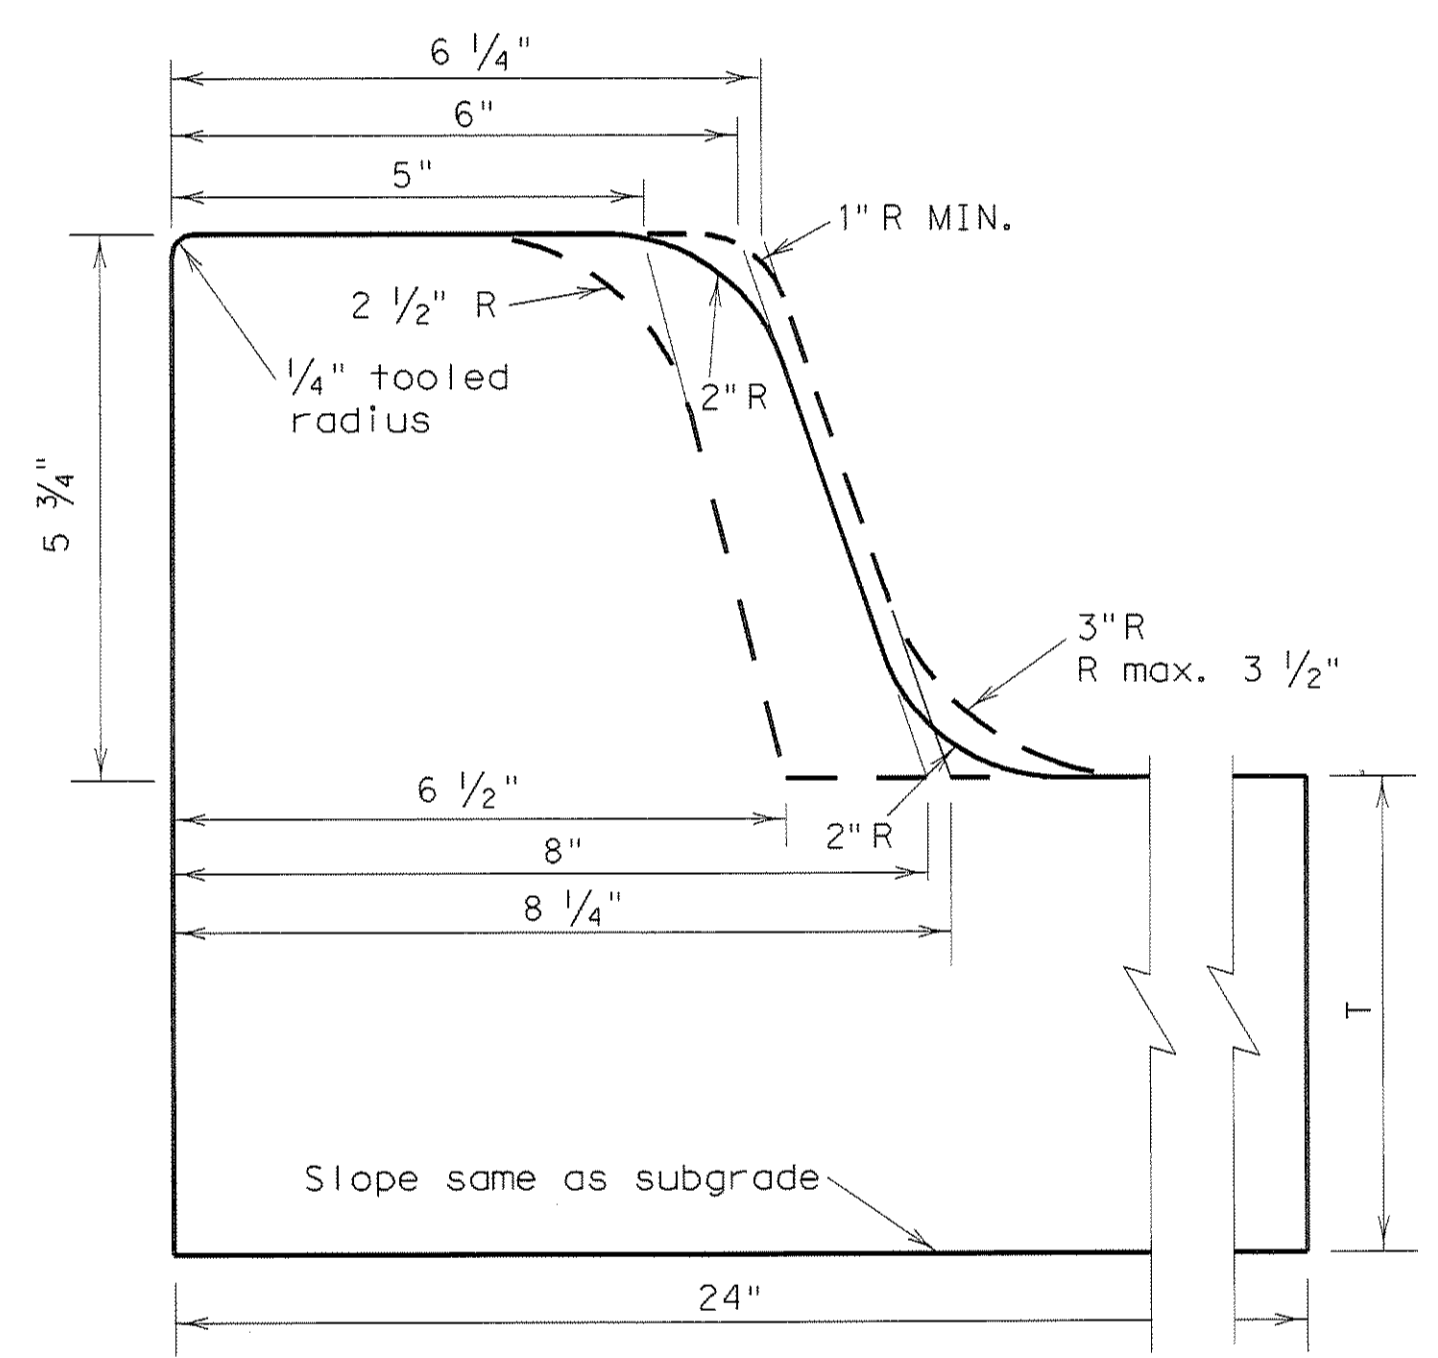

TYPE II CURB AND GUTTER

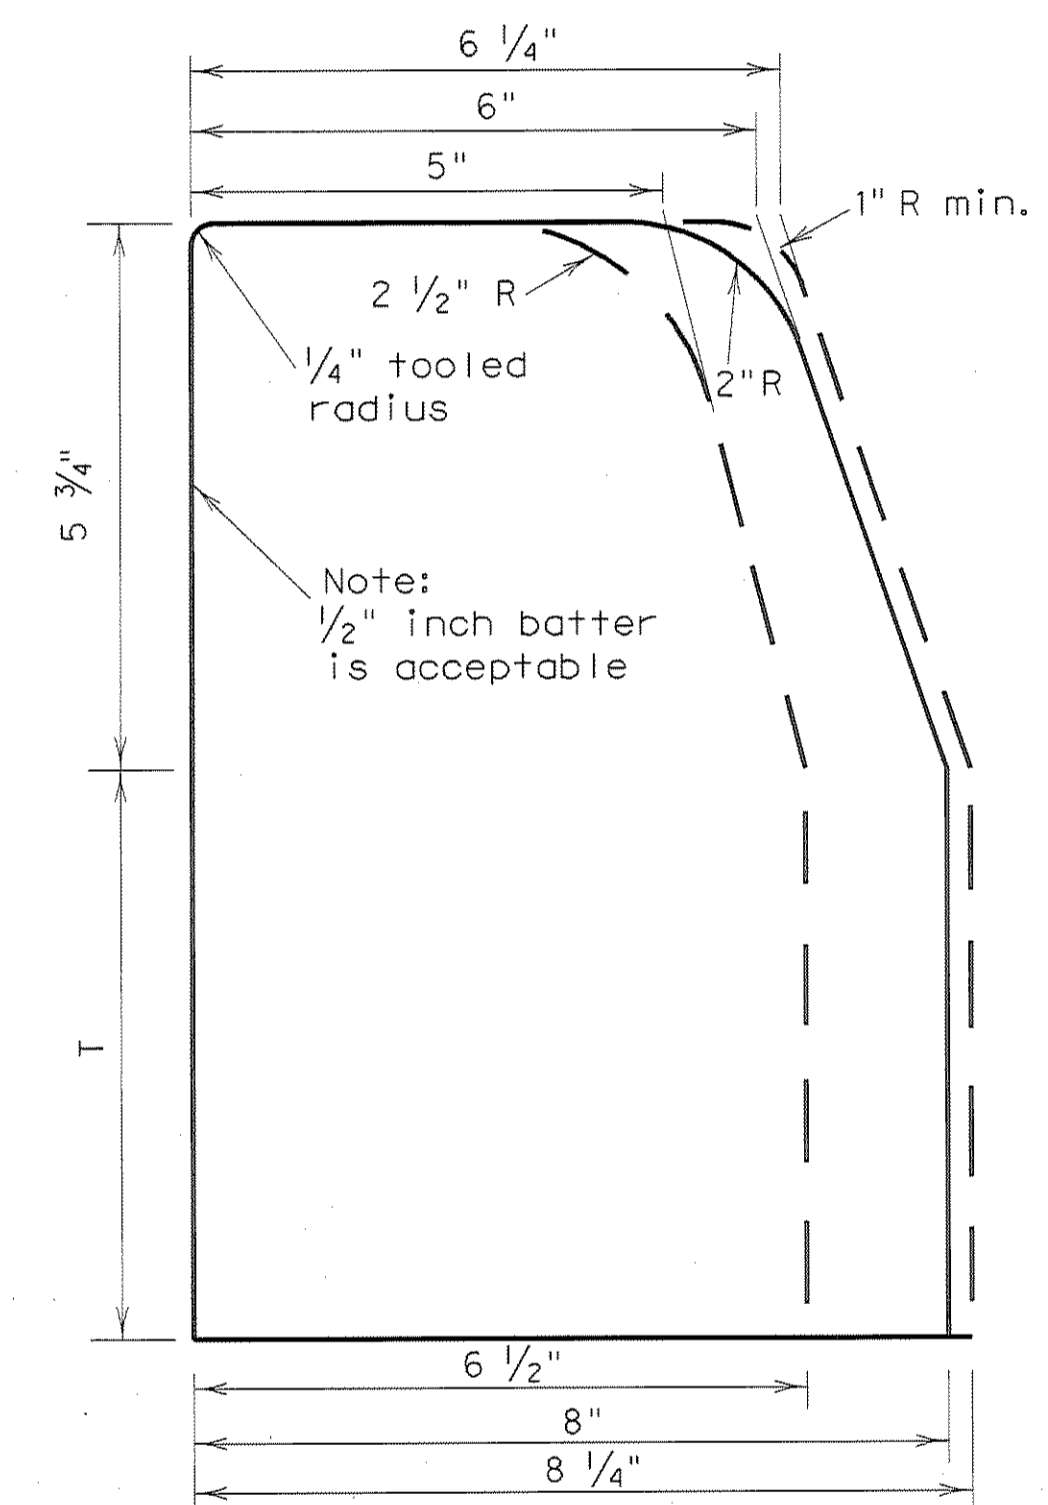


TYPE II CURB

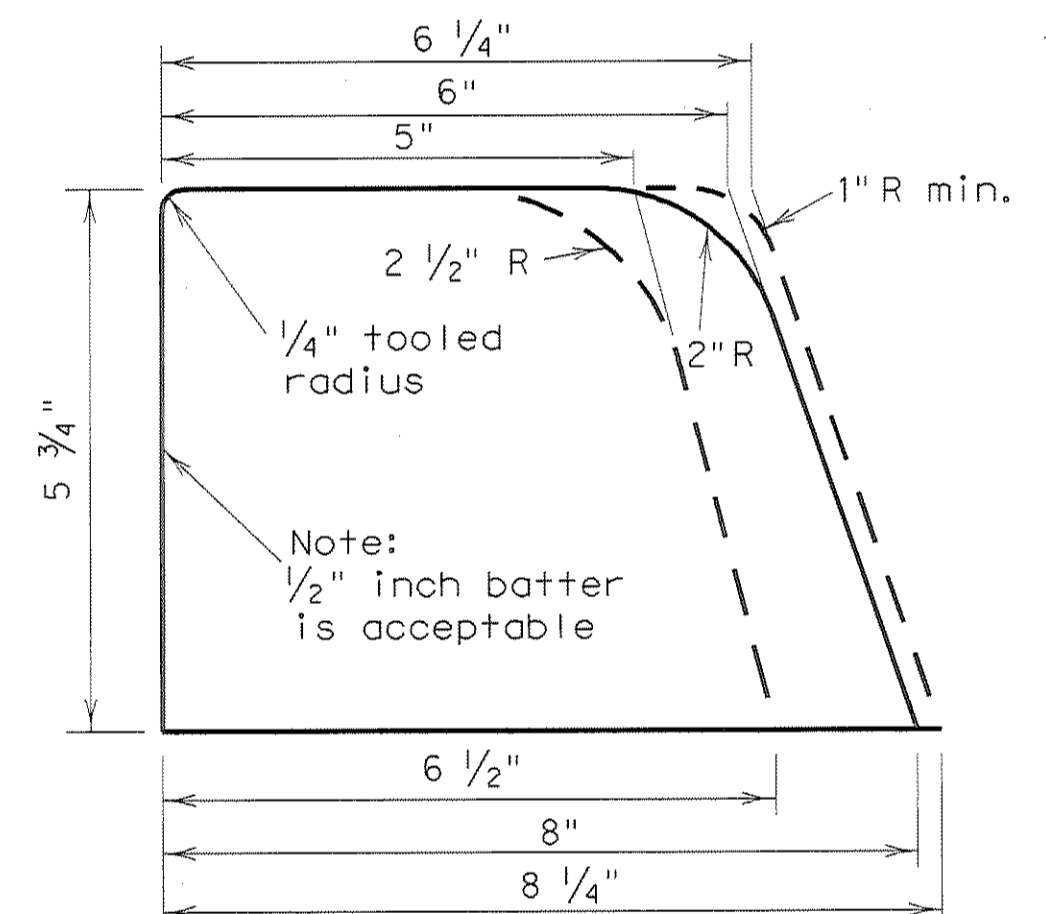

TYPE II MONO CURB OR CURB PLACED ON PAVEMENT

Note: 1/2 inch batter is acceptable

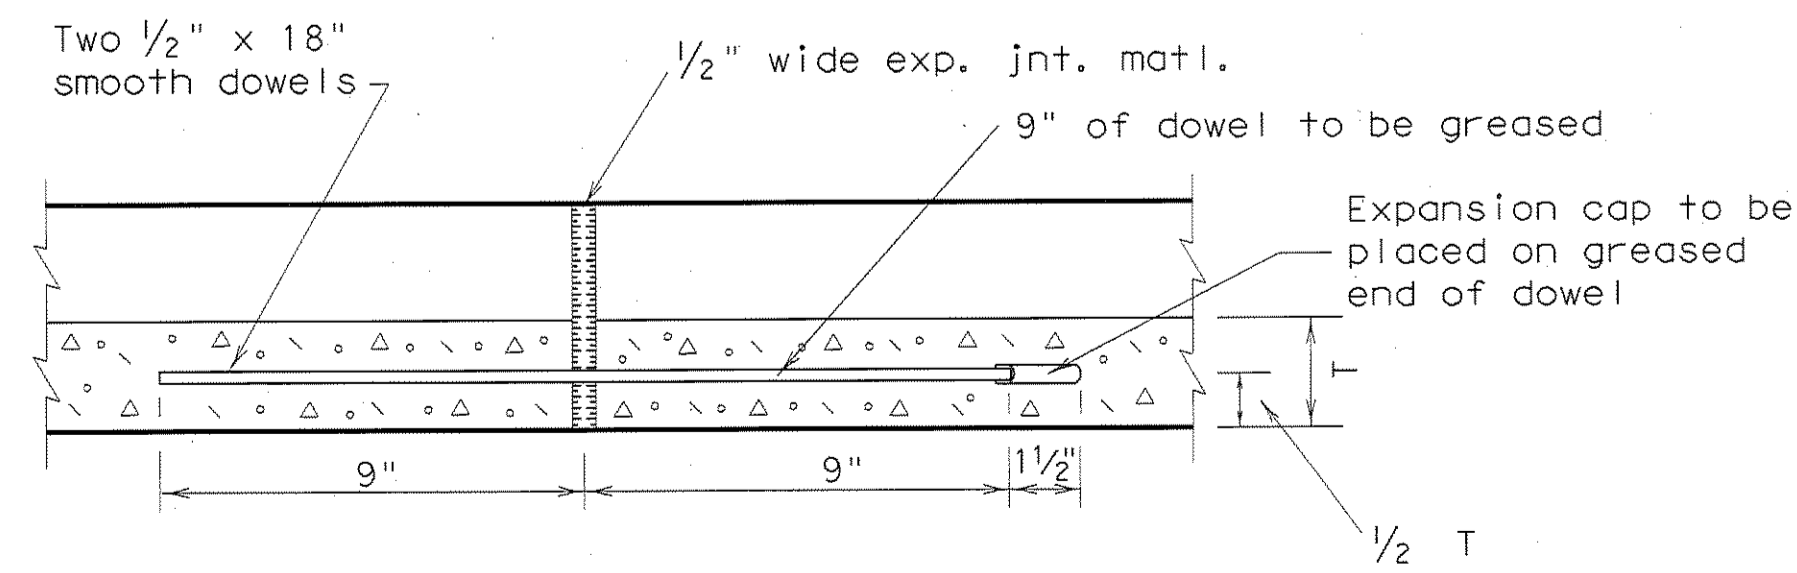

Longitudinal section thru curb and gutter showing typical expansion joint details.

Reinforcing steel (when used) shall not cross expansion joints. Steel shall be terminated 3" ± 1" from face of the joint.

GENERAL NOTES

- Contractor may use existing forms if the cross section lies within the band shown by dotted lines. If new forms are to be purchased, leased, or constructed they shall conform to the solid line.
- When reinforcing steel is required or placed at contractor's option, one of the following schemes of reinforcement shall be required. The manner of placement and location shall be to the satisfaction of the Engineer.
  - Type I, or Type II, curb and gutter reinforcement shall have longitudinal reinforcing bars as follows: Three #3, two #4, two #5, or one #6.
  - All types of curb (reinf.) shall have one #3 or #4 bar for longitudinal reinforcement.
- Reinforcing bars shall be lapped a minimum of 15".
- When curb or curb and gutter is placed by a separate pour adjacent to or atop concrete pavement, curb or curb and gutter shall be tied to pavement in a manner satisfactory to the engineer with 8-inch long #3 or #4 bars spaced at 5 feet and expansion and/or contraction joints of curb or curb and gutter shall match those of pavement.
 

When curb and curb and gutter is not constructed adjacent to concrete pavement, the following shall govern:

  - Reinforced curb or curb and gutter shall have no contraction joints.
  - Non-reinforced curb or curb and gutter shall have formed, tooled or sawed contraction joints at 10' ±. The depth of these joints shall be sufficient to ensure cracking at the joints.
  - Reinforcing curb or curb and gutter shall have expansion joints at points of curvature and at intervals no greater than 120' in all curves and at structures such as bridges, box culverts, curb inlets, etc.
  - Non-reinforced curb or curb and gutter shall have expansion joints at points of curvature on curves of radius less than 25' and at structures such as bridges, box culverts, curb inlets, etc.
- One-half inch expansion joint material shall be provided where curb or curb gutter is adjacent to sidewalk or riprap.
- Unless otherwise shown, transitions between curbs or curbs and gutters of differing cross section shall be accomplished over a 20 foot length or as approved by the Engineer.
- At contractor's option, dimension "T" may be thickness of pavement structure. In no case shall it be less than 6".
- See the RAMP standard sheet for information on curb ramps and sidewalks crossing driveways.

RECORD PLANS  
MARCH 28, 2008

Texas Department of Transportation  
Design Division (Roadway)


## CONCRETE CURB AND CURB AND GUTTER

CCCG-01


FILE: cccg01.DGN	DN: MAM	CK: RAR	DW: RAR	CK: MAM
© TxDOT 1995	DIST	FEDERAL AID PROJECT	SHEET	
REVISIONS	COUNTY	CONTROL SECT	JOB	HIGHWAY

DISCLAIMER: The use of this standard is governed by the "Texas Engineering Practice Act". No warranty of any kind is made by TxDOT for any purpose whatsoever. TxDOT assumes no responsibility for the conversion of this standard to other formats or for incorrect results or damages resulting from its use.

LEVELS DISPLAYED	
1	

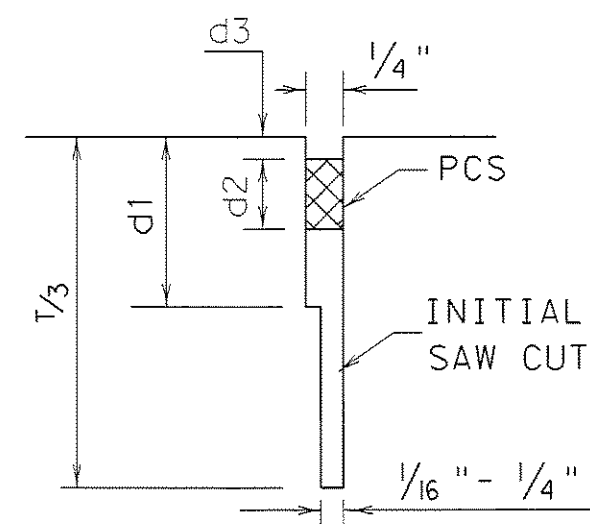


SAWED LONGITUDINAL JOINT

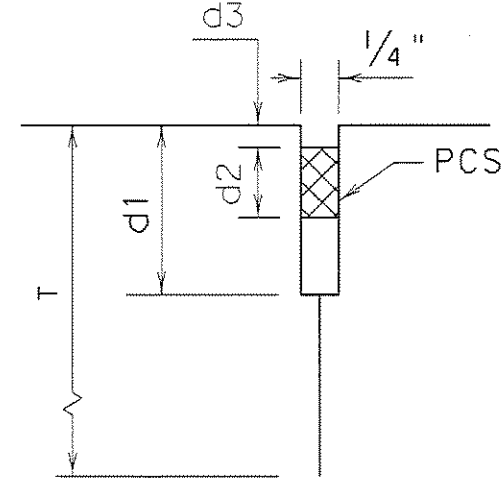


LONGITUDINAL CONSTRUCTION JOINT

LONGITUDINAL JOINT SEALS

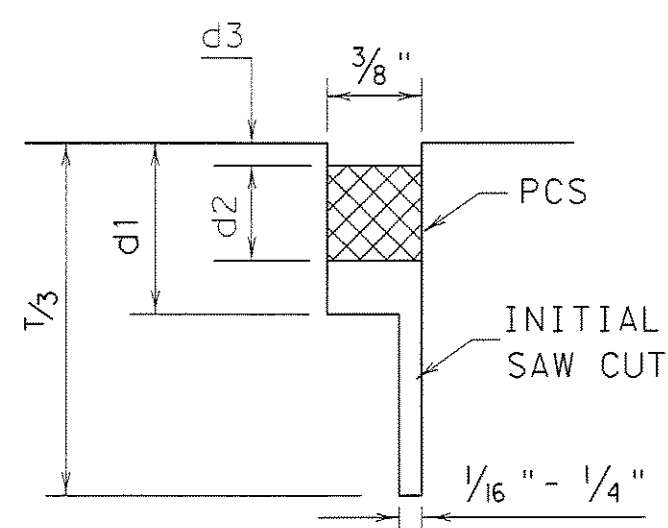

SAWED CONTRACTION JOINT

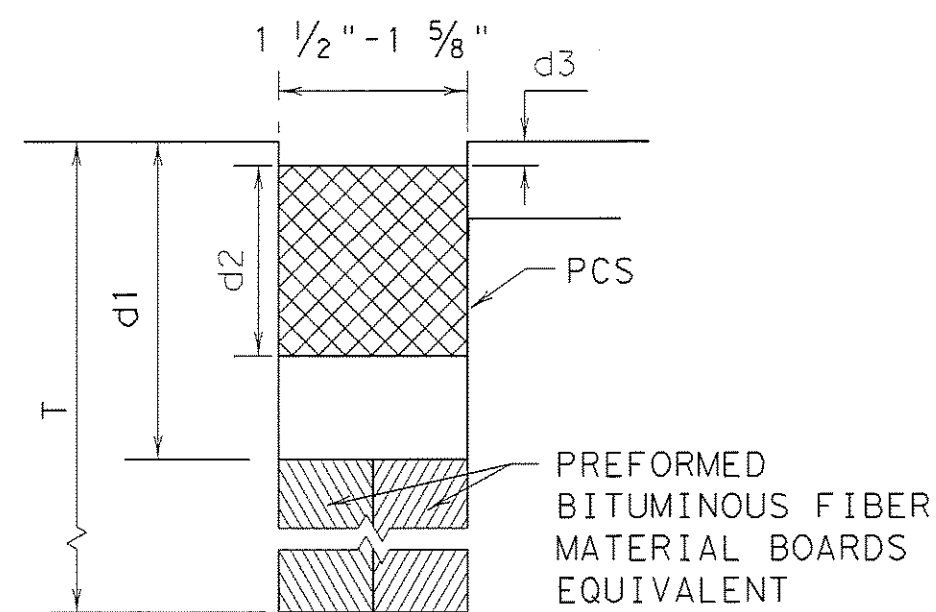


FORMED FORMED EXPANSION JOINT

TRANSVERSE JOINT SEALS


METHOD A: PREFORMED COMPRESSION SEALS (PCS)  
(CLASS 6 PREFORMED JOINT SEALANT)

GENERAL NOTES FOR METHOD "A"


- UNLESS OTHERWISE SHOWN IN THE PLANS, EITHER METHOD "A" OR METHOD "B" MAY BE USED.
- THE LOCATION OF JOINTS SHALL BE AS SHOWN ELSEWHERE IN THE PLANS.
- DIMENSIONS d1, d2, AND d3 SHALL BE IN ACCORDANCE WITH THE PREFORMED COMPRESSION SEAL MANUFACTURER'S RECOMMENDATION.
- THE JOINT RESERVOIR FOR SEALANT SHALL BE SAWED UNLESS OTHERWISE SHOWN ON THE PLANS FOR THE LONGITUDINAL AND TRANSVERSE CONSTRUCTION AND THE TWO SAWED JOINTS.
- THE JOINTS SHALL BE CLEANED IN ACCORDANCE WITH THE ITEM 438 AND PRIOR TO BEGINNING OPERATIONS, THE CONTRACTOR SHALL SUBMIT A STATEMENT FROM THE SEALANT MANUFACTURER SHOWING THE RECOMMENDED EQUIPMENT AND INSTALLATION PROCEDURES TO BE USED.
- THE SAW CUT FOR THE LONGITUDINAL JOINT SHALL BE ONE FOURTH THE SLAB THICKNESS WHEN CRUSHED LIMESTONE IS USED AS THE COARSE AGGREGATE.

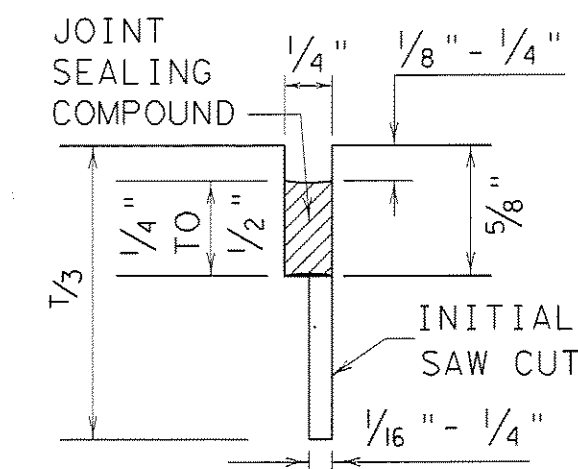


SAWED LONGITUDINAL JOINT

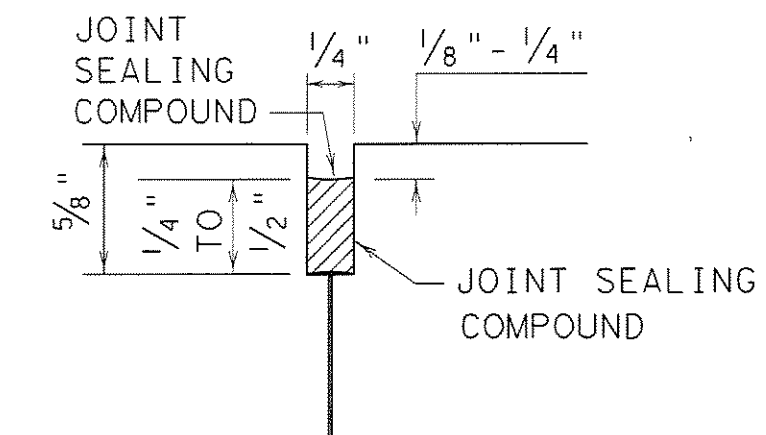

LONGITUDINAL OR TRANSVERSE CONSTRUCTION JOINT

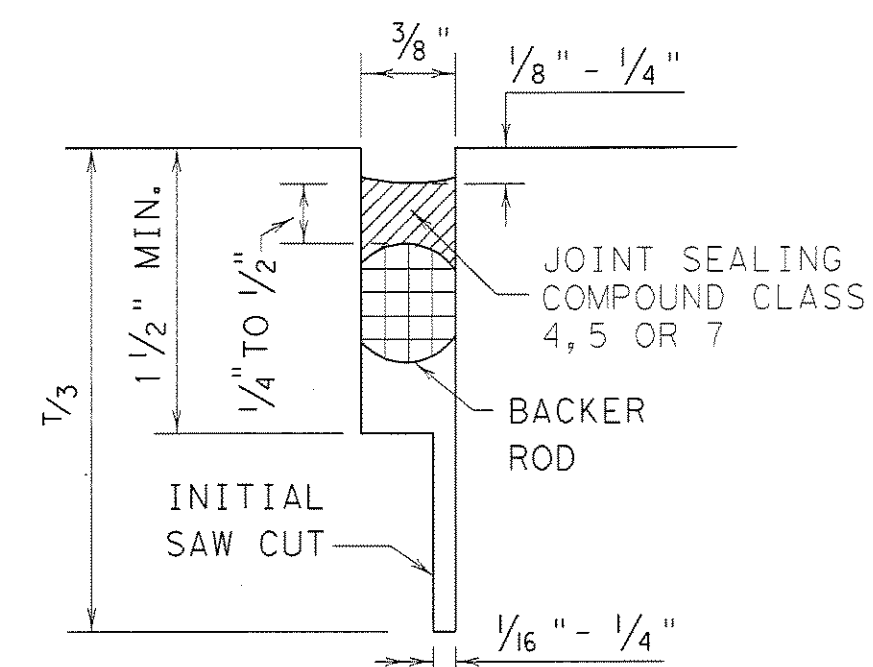

TRANSVERSE SAWED CONTRACTION JOINT

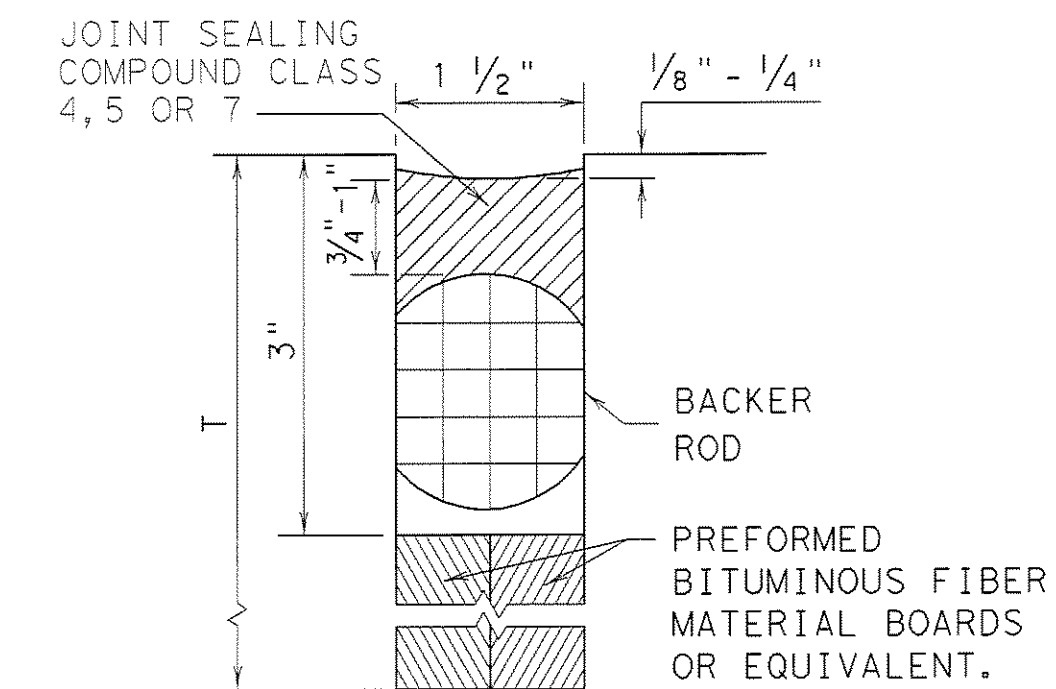

TRANSVERSE FORMED EXPANSION JOINT

METHOD B: JOINT SEALING COMPOUND

GENERAL NOTES FOR METHOD "B"

- UNLESS OTHERWISE SHOWN IN THE PLANS, EITHER METHOD "A" OR METHOD "B" MAY BE USED.
- THE LOCATION OF JOINTS SHALL BE AS SHOWN ELSEWHERE IN THE PLANS.
- THE ENGINEER SHALL SELECT A TARGET PLACEMENT THICKNESS FOR THE SEALANT DETAILS WHICH SHOW RANGES IN THICKNESS. THE TARGET THICKNESS WILL NORMALLY BE THE MIDPOINT OF THE RANGE.
- THE JOINT RESERVOIR FOR SEALANT SHALL BE SAWED UNLESS OTHERWISE SHOWN ON THE PLANS FOR THE LONGITUDINAL AND TRANSVERSE CONSTRUCTION AND THE TWO SAWED JOINTS.
- THE JOINTS SHALL BE CLEANED IN ACCORDANCE WITH THE ITEM 438 AND PRIOR TO BEGINNING OPERATIONS, THE CONTRACTOR SHALL SUBMIT A STATEMENT FROM THE SEALANT MANUFACTURER SHOWING THE RECOMMENDED EQUIPMENT AND INSTALLATION PROCEDURES TO BE USED.
- THE SAW CUT FOR THE LONGITUDINAL JOINT SHALL BE ONE FOURTH THE SLAB THICKNESS WHEN CRUSHED LIMESTONE IS USED AS THE COARSE AGGREGATE.

RECORD PLANS  
MARCH 28, 2008

Texas Department of Transportation  
Construction Division (Pavement)

CONCRETE PAVING DETAILS  
JOINT SEALS

JS-94

TXDOT SEPTEMBER 1994	DRG - LJB	CHK - LJB	DRG - BGD	CHK - GLG	SHEET
MODIFICATIONS	DISTRICT	FEDERAL AID PROJECT	P-300		
COUNTY	CONTROL SECTION	JOB	HIGHWAY		



ROCKWALL BYPASS, LTD.  
VOL. 2852, PG. 109  
D.R.R.C.T.

THE CAMBRIDGE  
COMPANIES, INC.  
TRUSTEE  
VOL. 99, PG. 1022  
D.R.R.C.T.

REMAINDER  
LOFLAND FARMS, LTD.  
VOL. 1392, PG. 271  
D.R.R.C.T.

REMOVE EXISTING RIGHT  
TURN ONLY ARROW AND  
INSTALL THROUGH AND RIGHT  
TURN ARROW PER DETAIL  
SHEET M207

STOP SIGN  
R1-1

INSTALL THROUGH AND RIGHT  
TURN ARROW PER DETAIL  
SHEET M207

LEFT LANE  
MUST TURN  
LEFT SIGN  
R3-5L

INSTALL DOUBLE WHITE  
REFLECTORIZED BUTTONS  
ALONG ASPHALT CURB @ 25' C/C

INSTALL DOUBLE SOLID YELLOW  
LINE PER DETAIL SHEET M201


INSTALL DOUBLE WHITE  
REFLECTORIZED BUTTONS  
ALONG ASPHALT CURB @ 25' C/C

SPEED LIMIT  
SIGN R2-1

INSTALL LEFT TURN  
ONLY ARROW PER  
DETAIL SHEET M207

INSTALL DOUBLE WHITE  
LINE PER DETAIL SHEET M201

THE CAMBRIDGE  
COMPANIES, INC.  
TRUSTEE  
VOL. 99, PG. 1022  
D.R.R.C.T.

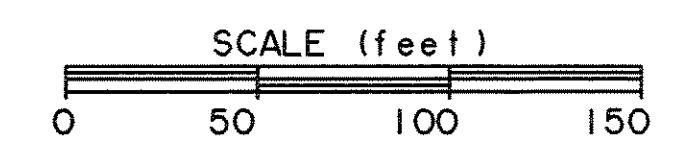


S . H . 2 0 5 B Y P A S S

THE CAMBRIDGE  
COMPANIES, INC.  
TRUSTEE  
VOL. 99, PG. 1022  
D.R.R.C.T.

INSTALL SOLID YELLOW LINE  
PER DETAIL SHEET M201


THE CAMBRIDGE  
COMPANIES, INC.  
TRUSTEE  
VOL. 99, PG. 1022  
D.R.R.C.T.

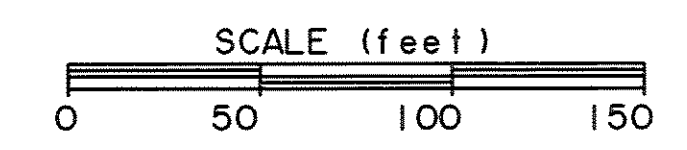


S . H . 2 0 5 B Y P A S S

RECORD PLANS  
MARCH 28, 2008

PREPARED BY:  
**WIER & ASSOCIATES, INC.**  
ENGINEERS SURVEYORS LAND PLANNERS  
4300 BELWAY PLACE SUITE 130 ARLINGTON, TEXAS 76018 METRO (817)467-7700  
1300 U.S. HIGHWAY 287 N. SUITE 101 WANSFELD, TEXAS 76063 METRO (817)477-8700  
6849 ELM STREET FRESNO, TEXAS 75034 METRO (214)387-8000  
www.wierassociates.com

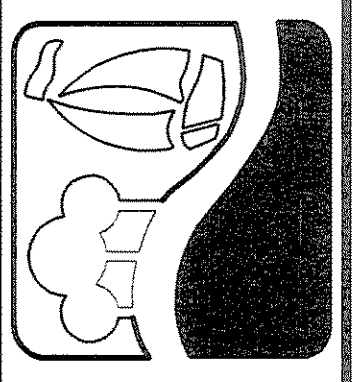

PHASE I SH. 205 BYPASS  
FROM SH. 276 TO INTERSTATE 30  
STRIPING  
PLAN  
STA 13+50+ TO 38+50

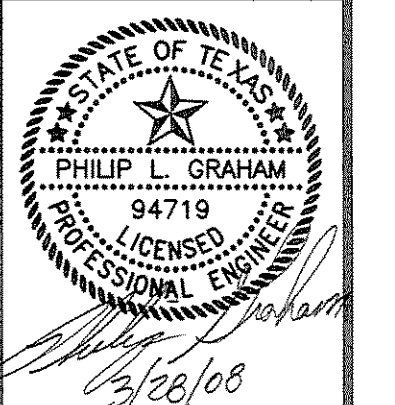

COPYRIGHT ©  
WIER & ASSOCIATES, INC.  
LAST SHEET EDIT  
DATE 03-28-2008  
WA# 04141  
SHEET NO.  
M101

TIME: 6:13 FILE: 04141-STRIPES.dwg

MATCH LINE  
STA 38+50


THE CAMBRIDGE COMPANIES, INC. TRUSTEE  
VOL. 99, PG. 1022  
D.R.R.C.T.

THE CAMBRIDGE COMPANIES, INC. TRUSTEE  
VOL. 101, PG. 795  
D.R.R.C.T.

INSTALL DOUBLE WHITE REFLECTORIZED BUTTONS ALONG ASPHALT CURB @ 25' C/C

SPEED LIMIT SIGN R2-1

INSTALL THERMOPLASTIC STOP BAR PER DETAIL SHEET M201

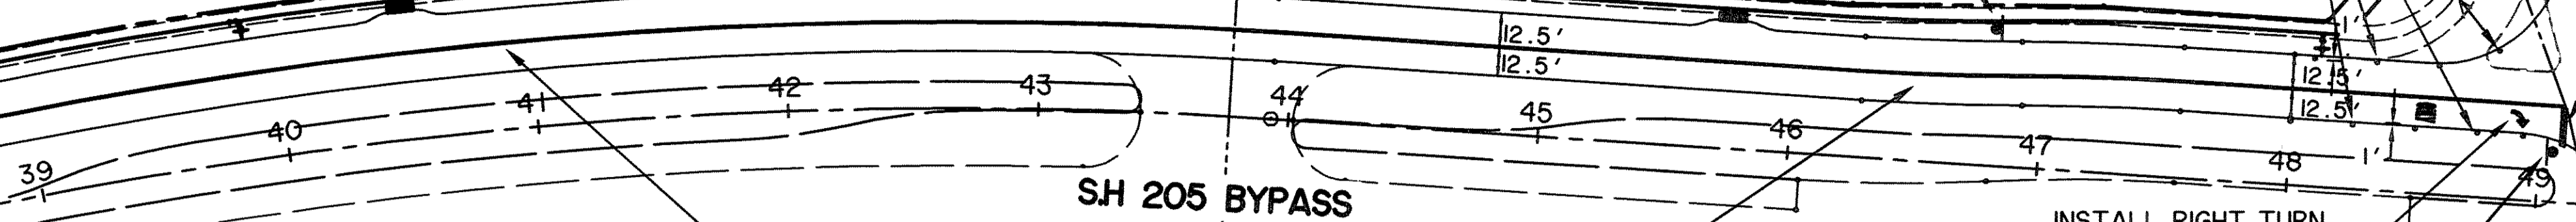

SH 205 BYPASS


INSTALL RIGHT TURN ONLY ARROW PER DETAIL SHEET M207

INSTALL SOLID YELLOW LINE PER DETAIL SHEET M201


STOP SIGN RI-1

THE CAMBRIDGE COMPANIES, INC. TRUSTEE  
VOL. 99, PG. 1022  
D.R.R.C.T.

THE CAMBRIDGE COMPANIES, INC. TRUSTEE  
VOL. 101, PG. 795  
D.R.R.C.T.

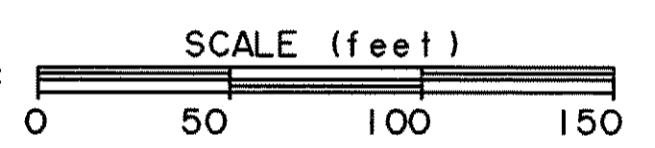

S . H . 2 0 5 B Y P A S S

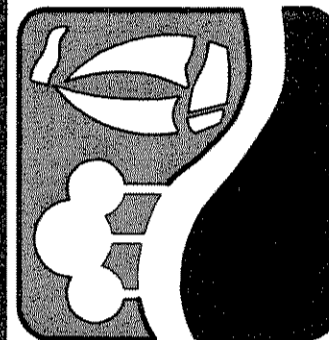

PREPARED BY:  
**WIER & ASSOCIATES, INC.**  
ENGINEERS SURVEYORS LAND PLANNERS  
4300 BELTWAY PLACE SUITE 130 ARLINGTON, TEXAS 76018 METRO (817)467-7700  
1380 U.S. HIGHWAY 287 N. SUITE 101 WANSFORD, TEXAS 76063 METRO (817)477-8700  
6849 ELM STREET FRISCO, TEXAS 75034 METRO (214)387-8000  
www.wierassociates.com

DBL. 4" THERMOPLASTIC YELLOW SOLID LINE PER DETAIL SHEET M205

THE CAMBRIDGE COMPANIES, INC. TRUSTEE  
VOL. 99, PG. 1022  
D.R.R.C.T.

INSTALL LEFT TURN ONLY ARROW PER DETAIL SHEET M207


INSTALL RIGHT TURN ONLY ARROW PER DETAIL SHEET M207

THE CAMBRIDGE COMPANIES, INC. TRUSTEE  
VOL. 99, PG. 1022  
D.R.R.C.T.

PNEUMA VENTURES, LTD.  
VOL. 2924, PG. 314  
D.R.R.C.T.

BLACKLAND WATER SUPPLY  
VOL. 77, PG. 420  
D.R.R.C.T.

24" CROSS HATCH PER DETAIL SHEET M205

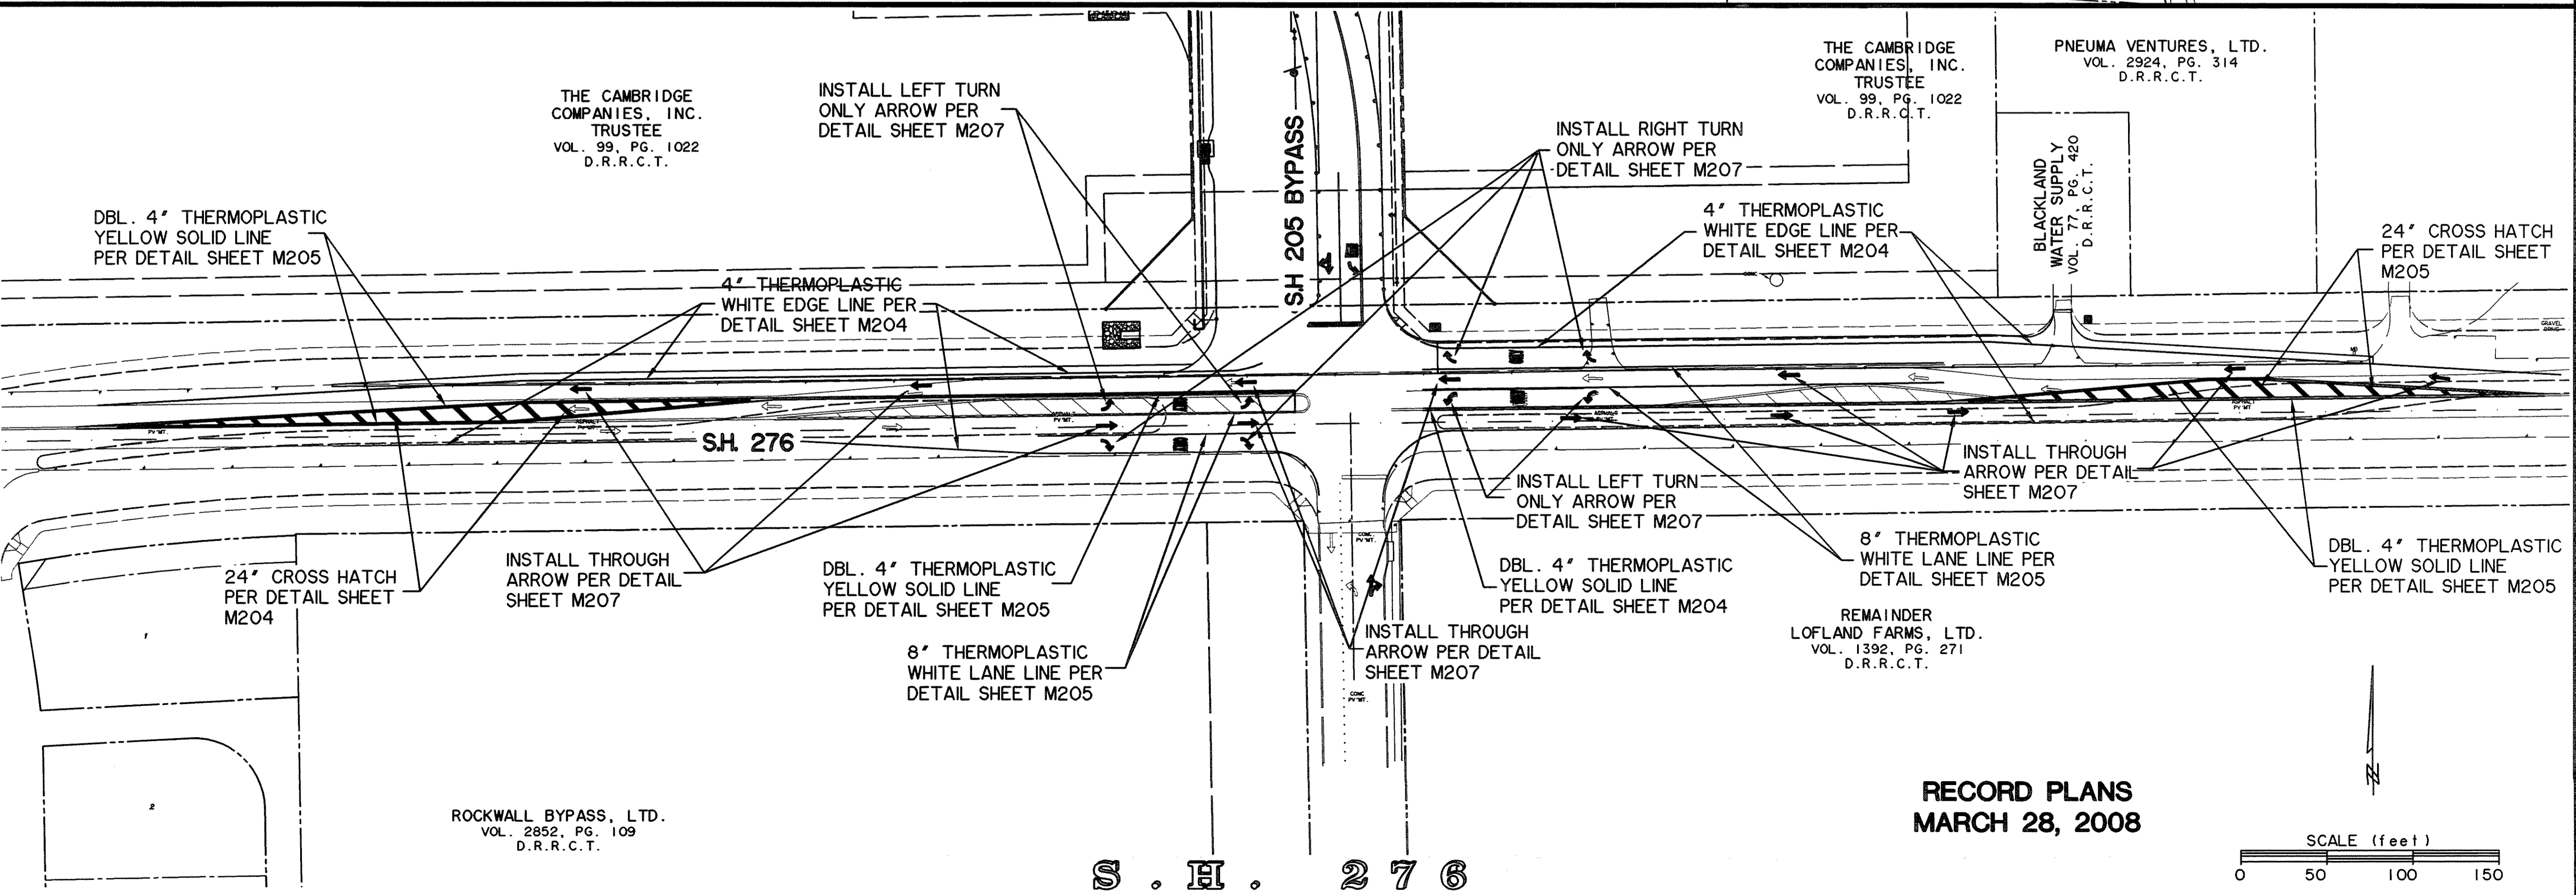

SH 276

SH 205 BYPASS

4" THERMOPLASTIC WHITE EDGE LINE PER DETAIL SHEET M204

4" THERMOPLASTIC WHITE EDGE LINE PER DETAIL SHEET M204

24" CROSS HATCH PER DETAIL SHEET M204

INSTALL THROUGH ARROW PER DETAIL SHEET M207

DBL. 4" THERMOPLASTIC YELLOW SOLID LINE PER DETAIL SHEET M205

INSTALL LEFT TURN ONLY ARROW PER DETAIL SHEET M207

INSTALL THROUGH ARROW PER DETAIL SHEET M207

8" THERMOPLASTIC WHITE LANE LINE PER DETAIL SHEET M205

DBL. 4" THERMOPLASTIC YELLOW SOLID LINE PER DETAIL SHEET M205


ROCKWALL BYPASS, LTD.  
VOL. 2852, PG. 109  
D.R.R.C.T.

INSTALL THROUGH ARROW PER DETAIL SHEET M207

DBL. 4" THERMOPLASTIC YELLOW SOLID LINE PER DETAIL SHEET M204


REMAINDER LOFLAND FARMS, LTD.  
VOL. 1392, PG. 271  
D.R.R.C.T.

RECORD PLANS  
MARCH 28, 2008

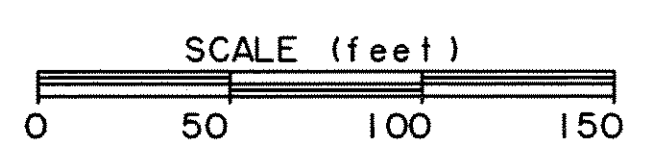

S . H . 2 7 6


PHASE I SH. 205 BYPASS  
FROM SH. 276 TO INTERSTATE 30  
STRIPING PLAN  
STA 38+50 TO I-30

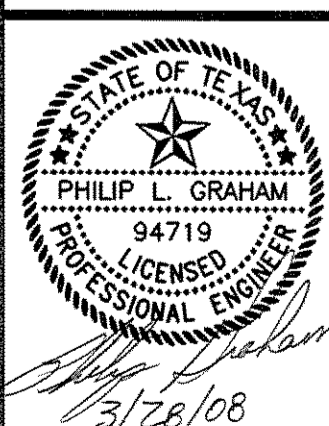


COPYRIGHT ©  
WIER & ASSOCIATES, INC.  
LAST SHEET EDIT  
DATE 03-28-2008  
WA# 04141  
SHEET NO.  
M102

FILE: 04141-STRIPES.dwg  
TIME: 6:14


TIME: 19:26 FILE: 04141-StripingDetPhase1.dwg

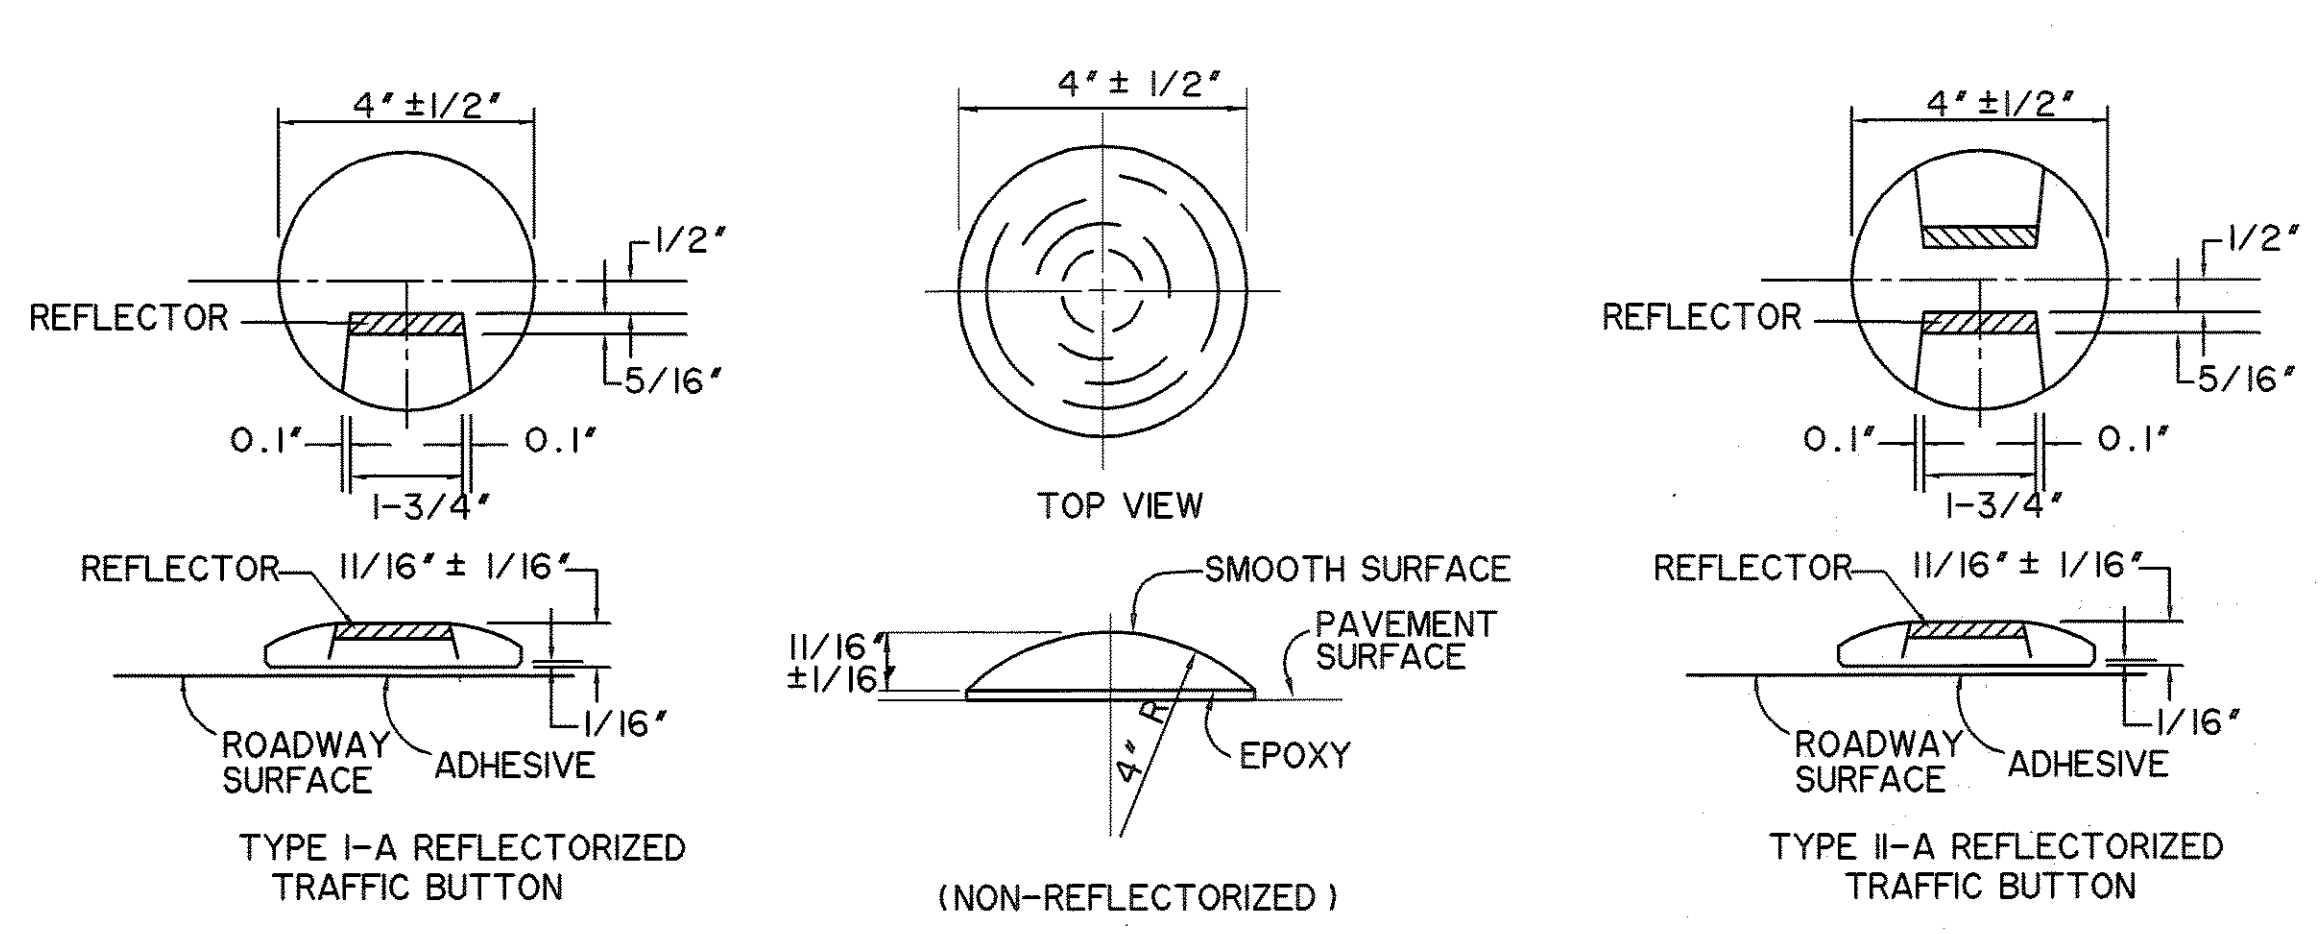


**4" TRAFFIC BUTTONS**

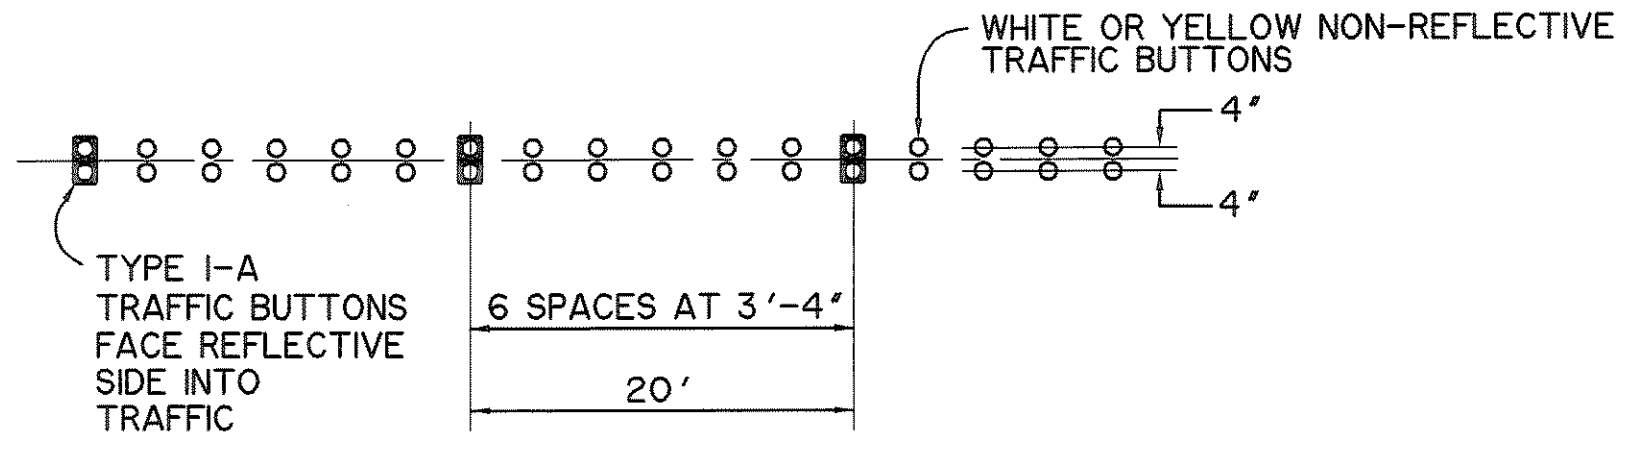

**DOUBLE SOLID LINE**

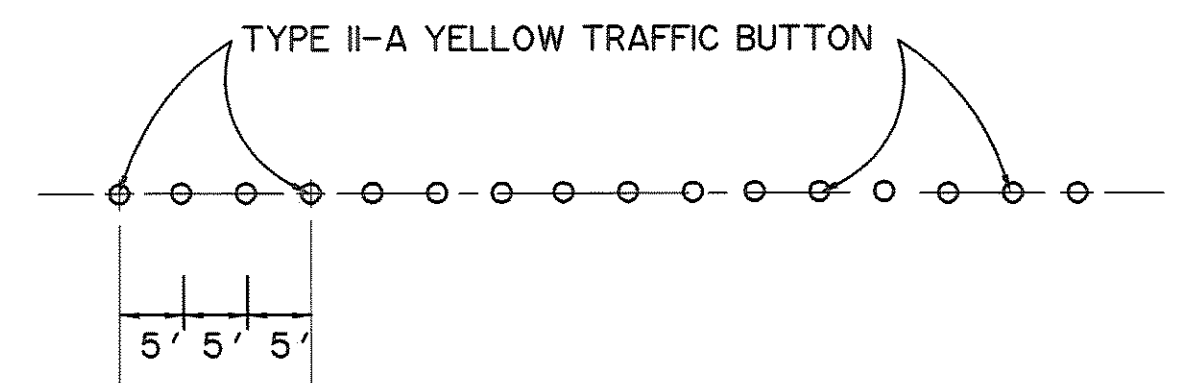

**SOLID LINE**

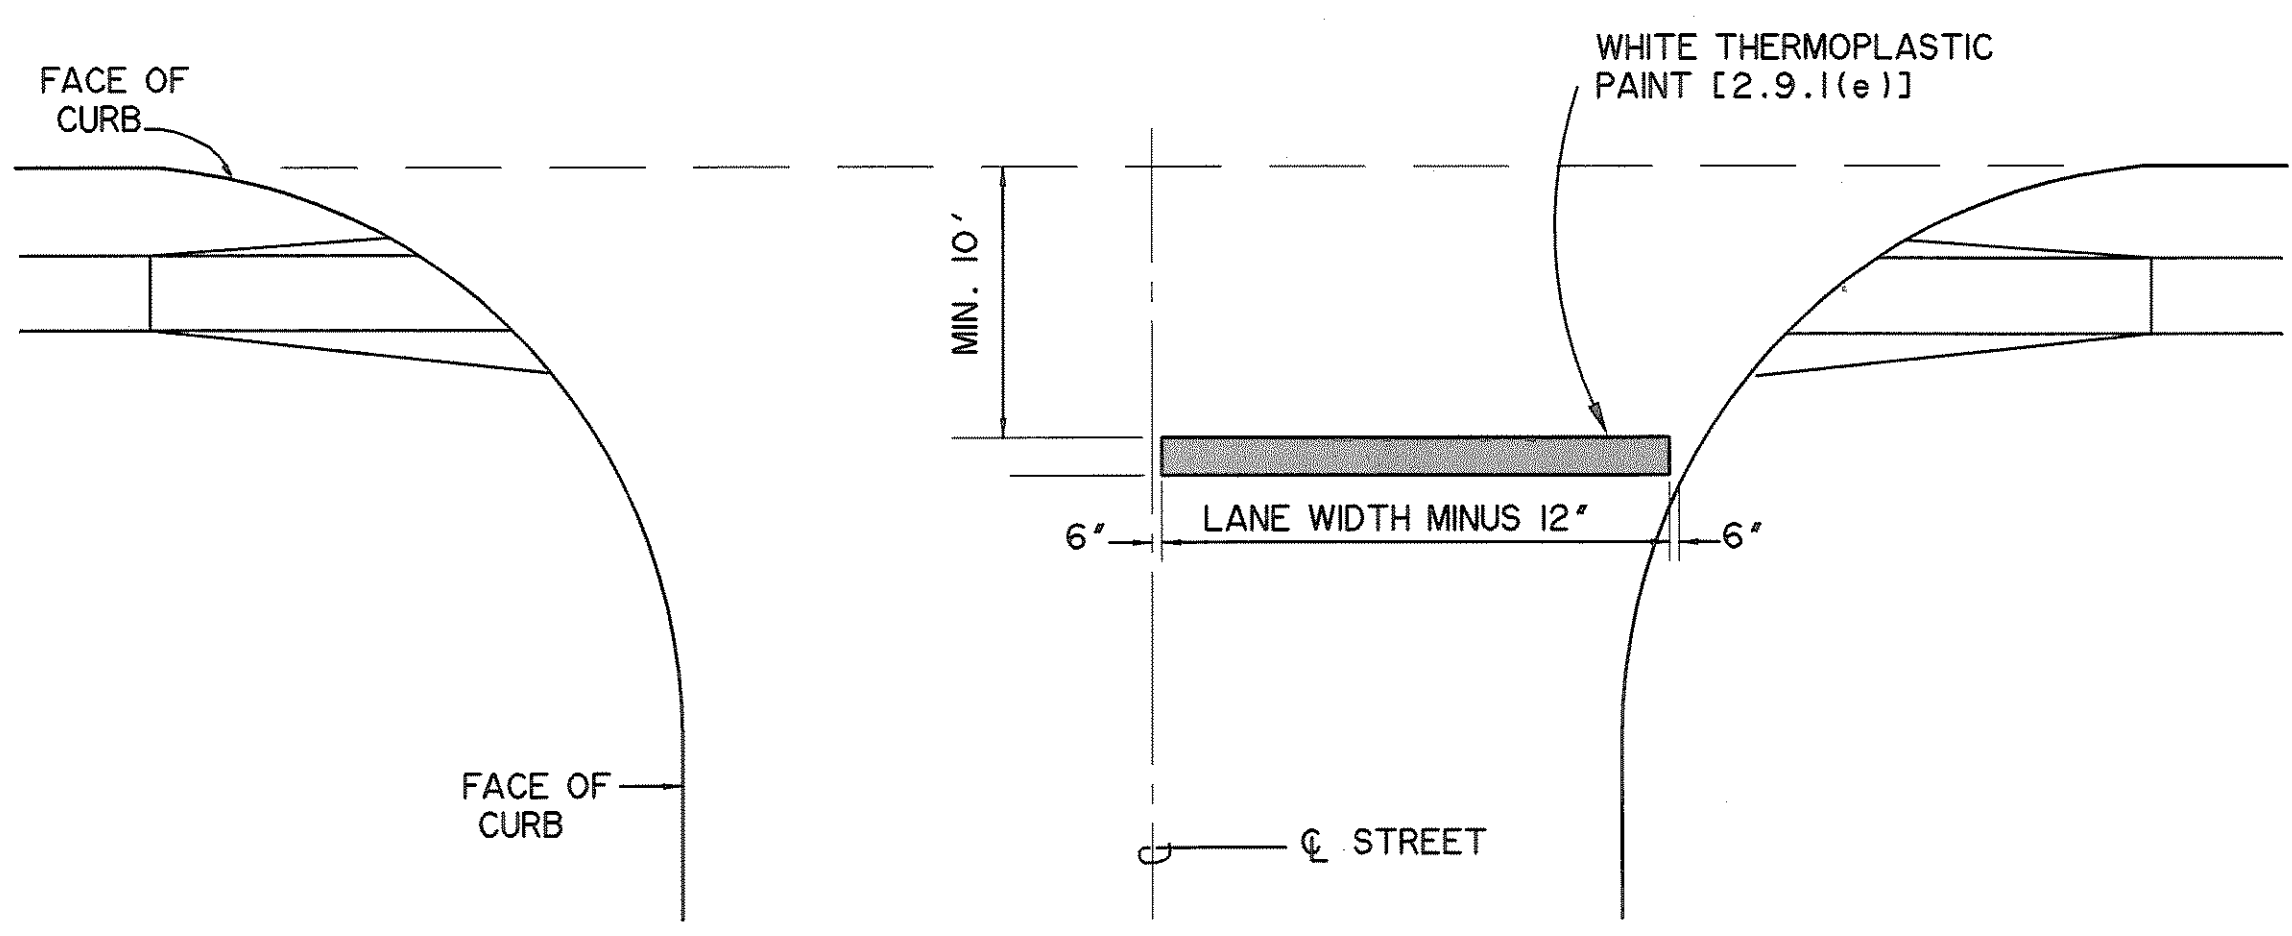


**INTERSECTION STOPBAR**

PREPARED BY:  
**WIA WIER & ASSOCIATES, INC.**  
 ENGINEERS SURVEYORS LAND PLANNERS  
 4300 BELTWAY PLACE SUITE 130 ARLINGTON, TEXAS 76018 METRO (817)467-7700  
 1390 U.S. HIGHWAY 287 N., SUITE 101 WANSFIELD, TEXAS 76063 METRO (817)477-8700  
 6849 ELM STREET FRISCO, TEXAS 75034 METRO (214)387-8000  
 www.WierAssociates.com




**PHASE I S.H. 205 BYPASS  
 FROM S.H. 276 TO INTERSTATE 30  
 STRIPING DETAILS**

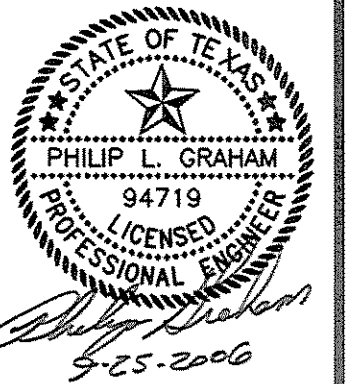


COPYRIGHT ©  
 WIER & ASSOCIATES, INC.  
 LAST SHEET EDIT  
 DATE 02-06-2006  
 WA# 0414  
**SHEET NO.  
 M201**

RECORD PLANS  
 MARCH 28, 2008

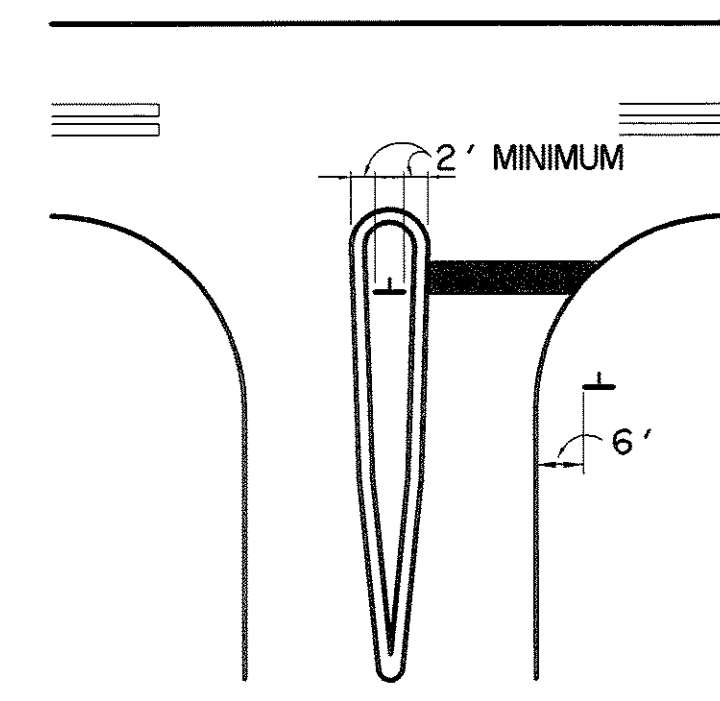


DIVISION ISLAND

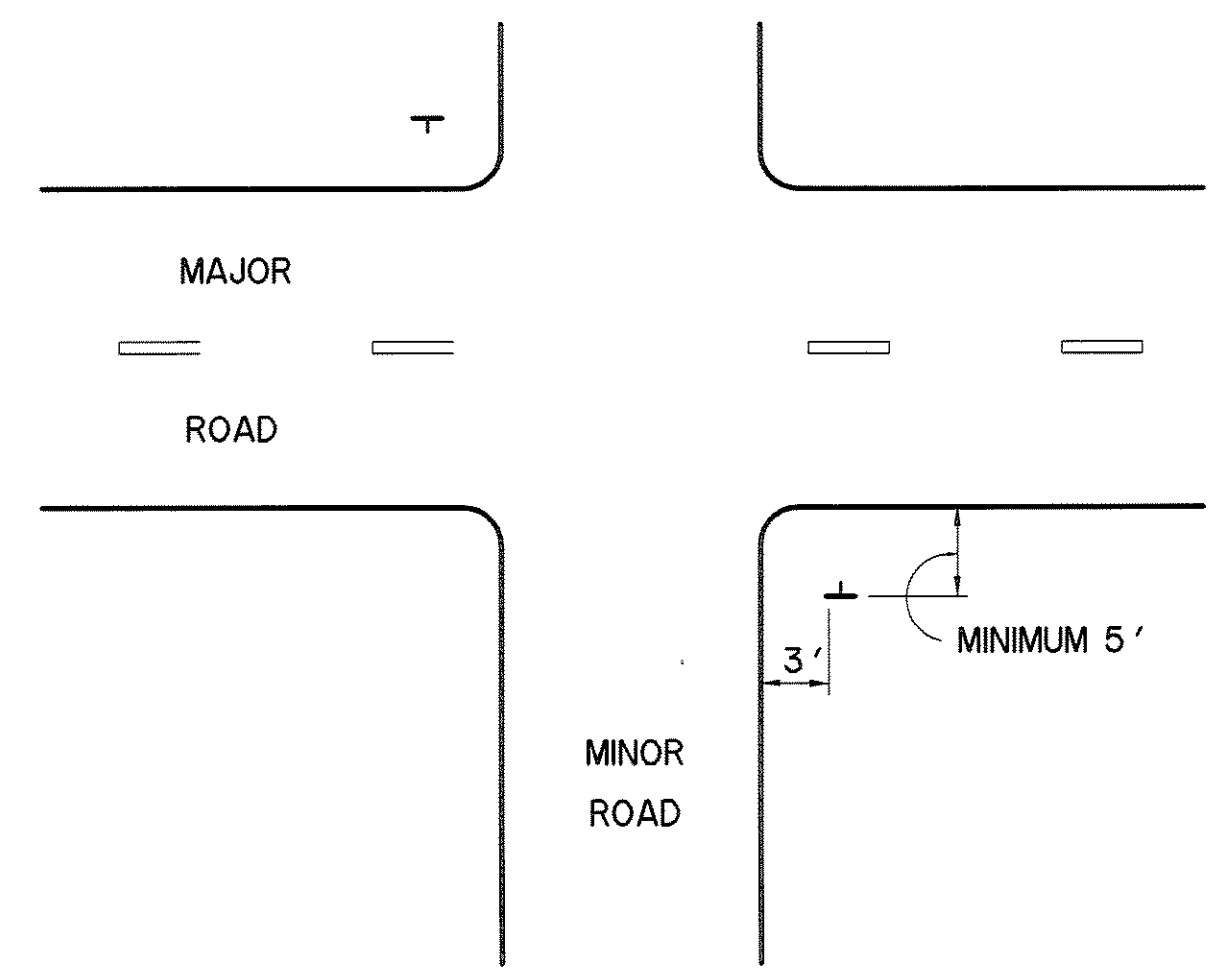


URBAN CROSS ROAD

N.T.S.

STREET SIGN PLACEMENT

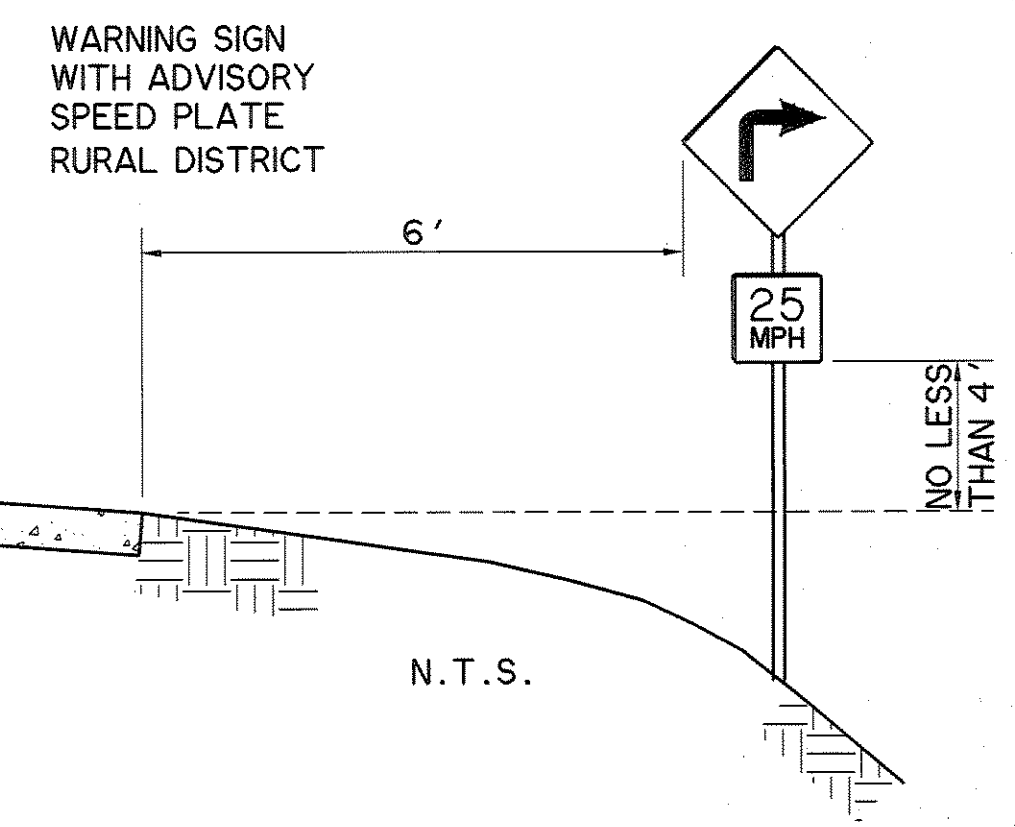


ROADSIDE SIGN  
BUSINESS OR  
RESIDENTIAL DISTRICT

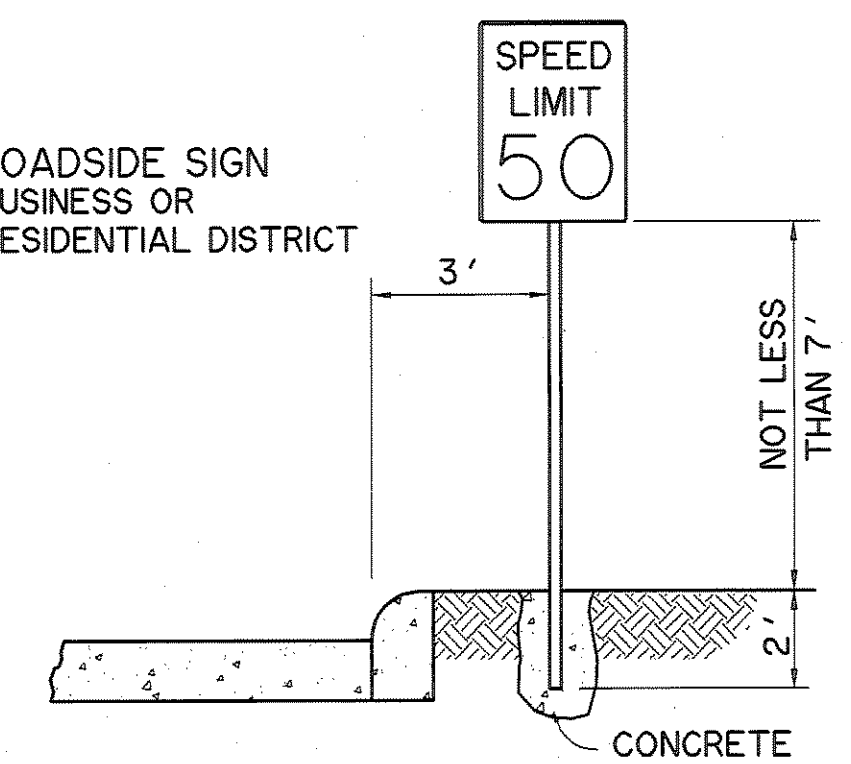

MINIMUM DIAMETER OF CONCRETE BASE 6', MAXIMUM 12'

N.T.S.

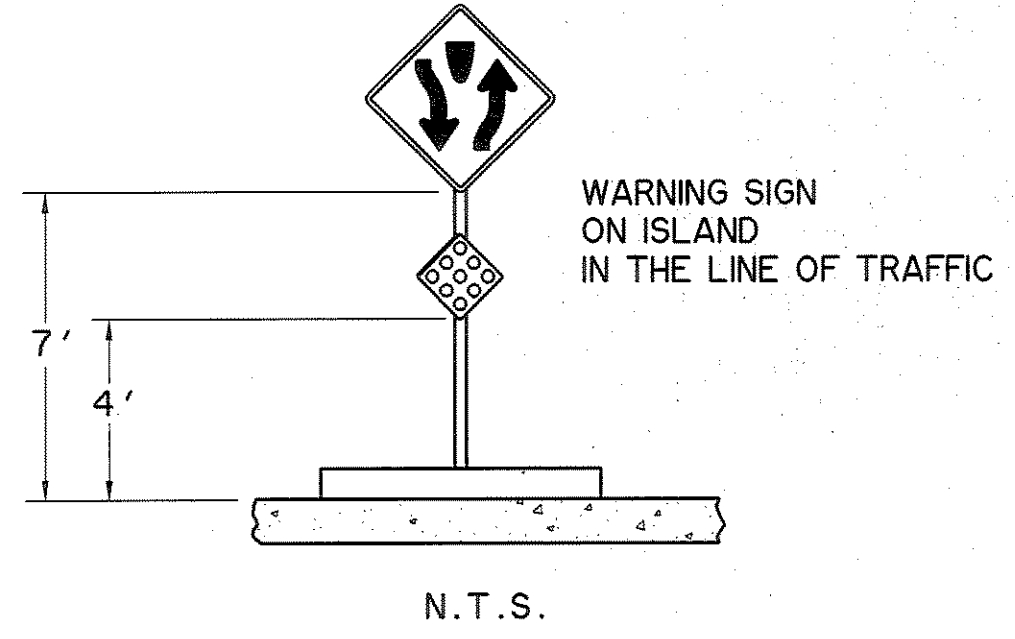


WARNING SIGN  
ON ISLAND  
IN THE LINE OF TRAFFIC

N.T.S.

GENERAL STREET SIGN REQUIREMENTS: (INSTALLATION BY CITY)

1. THE STOCK NUMBERS LISTED FOR SIGNS ARE AVAILABLE FROM SARGENT-SOWEL INC. (SASO) IN GRAND PRAIRIE, TEXAS AND UNLESS OTHERWISE SPECIFIED, ANY SUBSTITUTIONS SHALL BE APPROVED BY THE ENGINEERING DEPARTMENT PRIOR TO INSTALLATION.
2. ALL SIGNS SHALL BE OF ALUMINUM SHEET WITH REFLECTORIZED SHEETING AND REFLECTORIZED LETTERS.
  - A. STOP SIGNS: SASO #09-398 30"x30" STANDARD SIZE
  - B. OTHER SIGNS: 'YIELD', SASO #09-512, 30"x30"x30"  
 SPEED LIMIT 30, SASO #01-312, 24"x30"  
 4 WAY STOP, SASO #09E418, 12"x6"  
 3 WAY STOP, SASO #09E419, 12"x6"  
 NO PARKING, SASO #01E539, 18"x24"  
 DEAD END/NO OUTLET, SASO #01E070/09E121, 30' x 30'
  - C. STREET SIGNS: 24' TO 42' IN LENGTH, EXTRUDED ALUMINUM PLATES, .091 THICK, 6-3/4" HIGH, LENGTH SUITABLE TO THE STREET NAME.
3. THE STREET SIGN SHALL BE A GREEN BACKGROUND WITH WHITE REFLECTORIZED LETTERS. THE LETTERS SHALL BE 4' HIGH FOR THE STREET NAME, AND 2' HIGH FOR ALL OTHER LETTERS. THE LENGTH OF THE SIGN SHALL BE APPROPRIATE FOR THE STREET NAME. EACH STREET SIGN SHALL HAVE THE APPROPRIATE HUNDRED BLOCK FOR ITS LOCATION. ALL LETTERS SHALL BE CAPITAL LETTERS.
  - A. POSTS: ALL POSTS SHALL BE OF GALVANIZED STEEL TUBING 12' LONG x 2-3/8" DIA. WITH A WALL THICKNESS OF .080 INCHES SASO #03-099, ALSO AVAILABLE AT ANY LOCAL FENCE SUPPLY COMPANY.
  - B. TEE'S: 90 DEGREE BRACKETS, SASO #45E683  
 45 DEGREE BRACKETS, SASO #45E684
  - C. POST CAP: SASO #45E682
  - D. ALUMINUM SIGN CLAMPS: SASO #03E154
4. LOCATIONS FOR SIGNS SHALL BE ASSIGNED BY THE CITY OF ROCKWALL ENGINEERING DEPARTMENT AND SHALL BE PLACED IN THE FIELD AS DIAGRAMMED AND/OR SHALL MEET OR EXCEED THE REQUIREMENTS GIVEN IN THE TEXAS MANUAL ON UNIFORM TRAFFIC CONTROL DEVICES, 1980 ED. WITH ADDENDUMS.

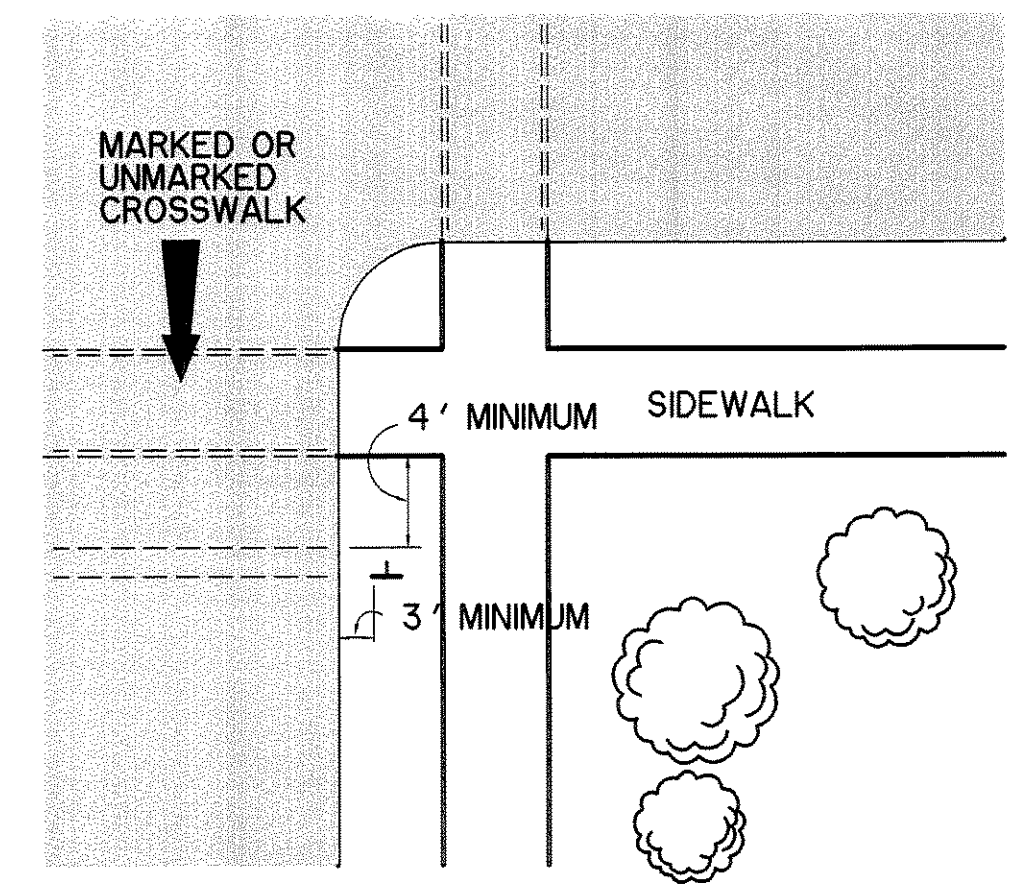


URBAN INTERSECTION


N.T.S.

STREET SIGN PLACEMENT

PREPARED BY:  
**WIA WIER & ASSOCIATES, INC.**  
 ENGINEERS SURVEYORS LAND PLANNERS  
 4300 BELWAY PLACE SUITE 130 ARLINGTON, TEXAS 76018 METRO (817)467-7700  
 1380 U.S. HIGHWAY 287 N. SUITE 101 MANSFIELD, TEXAS 76063 METRO (817)477-0700  
 6649 ELM STREET FRISCO, TEXAS 75034 METRO (214)387-8000  
 www.WierAssociates.com

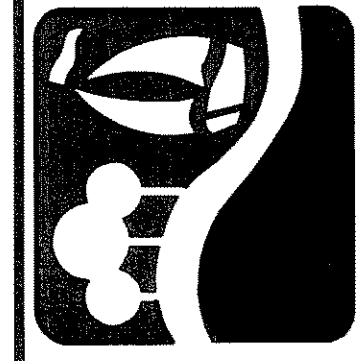

PHASE I  
 S.H. 205 BYPASS  
 STREET SIGN DETAILS

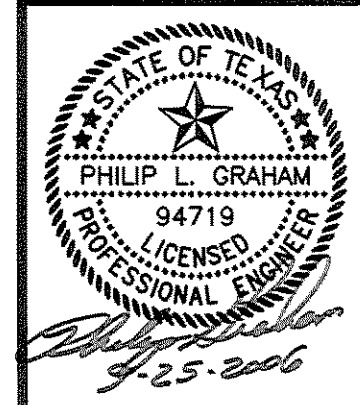







RECORD PLANS  
 MARCH 28, 2008

COPYRIGHT ©  
 WIER & ASSOCIATES, INC.  
 LAST SHEET EDIT  
 DATE 02-06-2006  
 WA# 04141  
 SHEET NO.  
 M202

TIME 12.15 FILE: 04141-SignDetPhase1.dwg

DISCLAIMER  
 The use of this standard is governed by the "Texas Engineering Practice Act". No warranty of any kind is made by TxDOT for any purpose whatsoever. TxDOT assumes no responsibility for damages resulting from its use of this standard to other formats or for incorrect results or damages resulting from its use.


ACC:  
 LEVELS DISPLAYED:  
 1 2 3 4 5 6 7 8 9 10 11 12 13 14 15 16  
 17 18 19 20 21 22 23 24 25 26 27 28 29 30 31 32  
 33 34 35 36 37 38 39 40 41 42 43 44 45 46 47 48  
 49 50 51 52 53 54 55 56 57 58 59 60 61 62 63

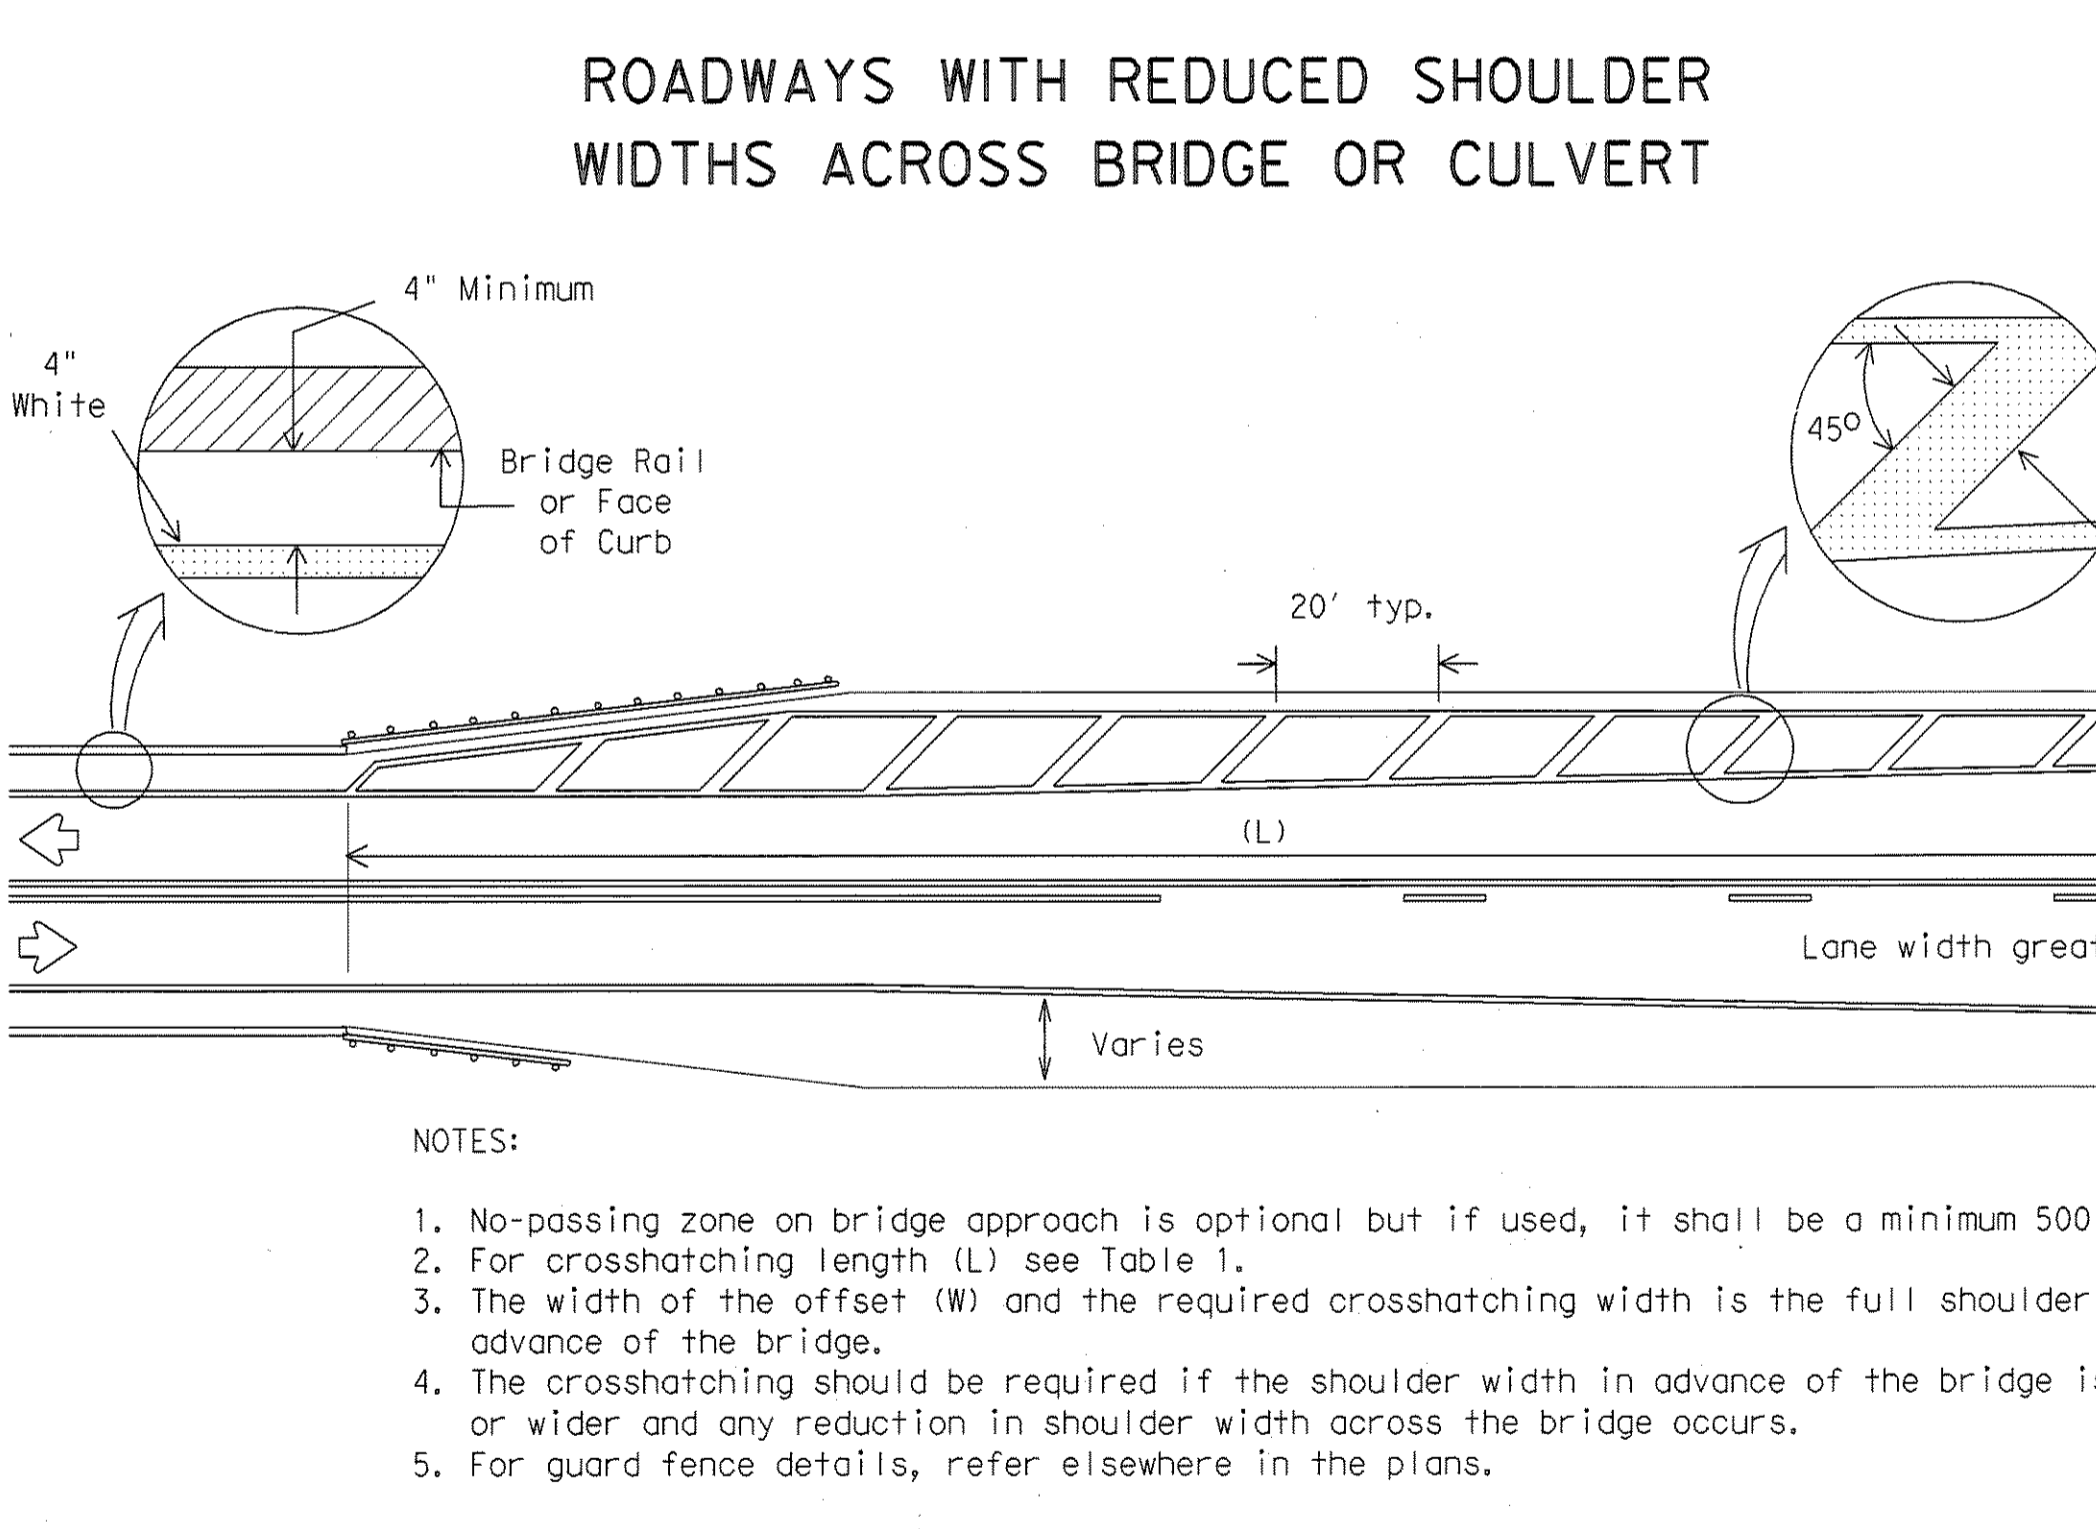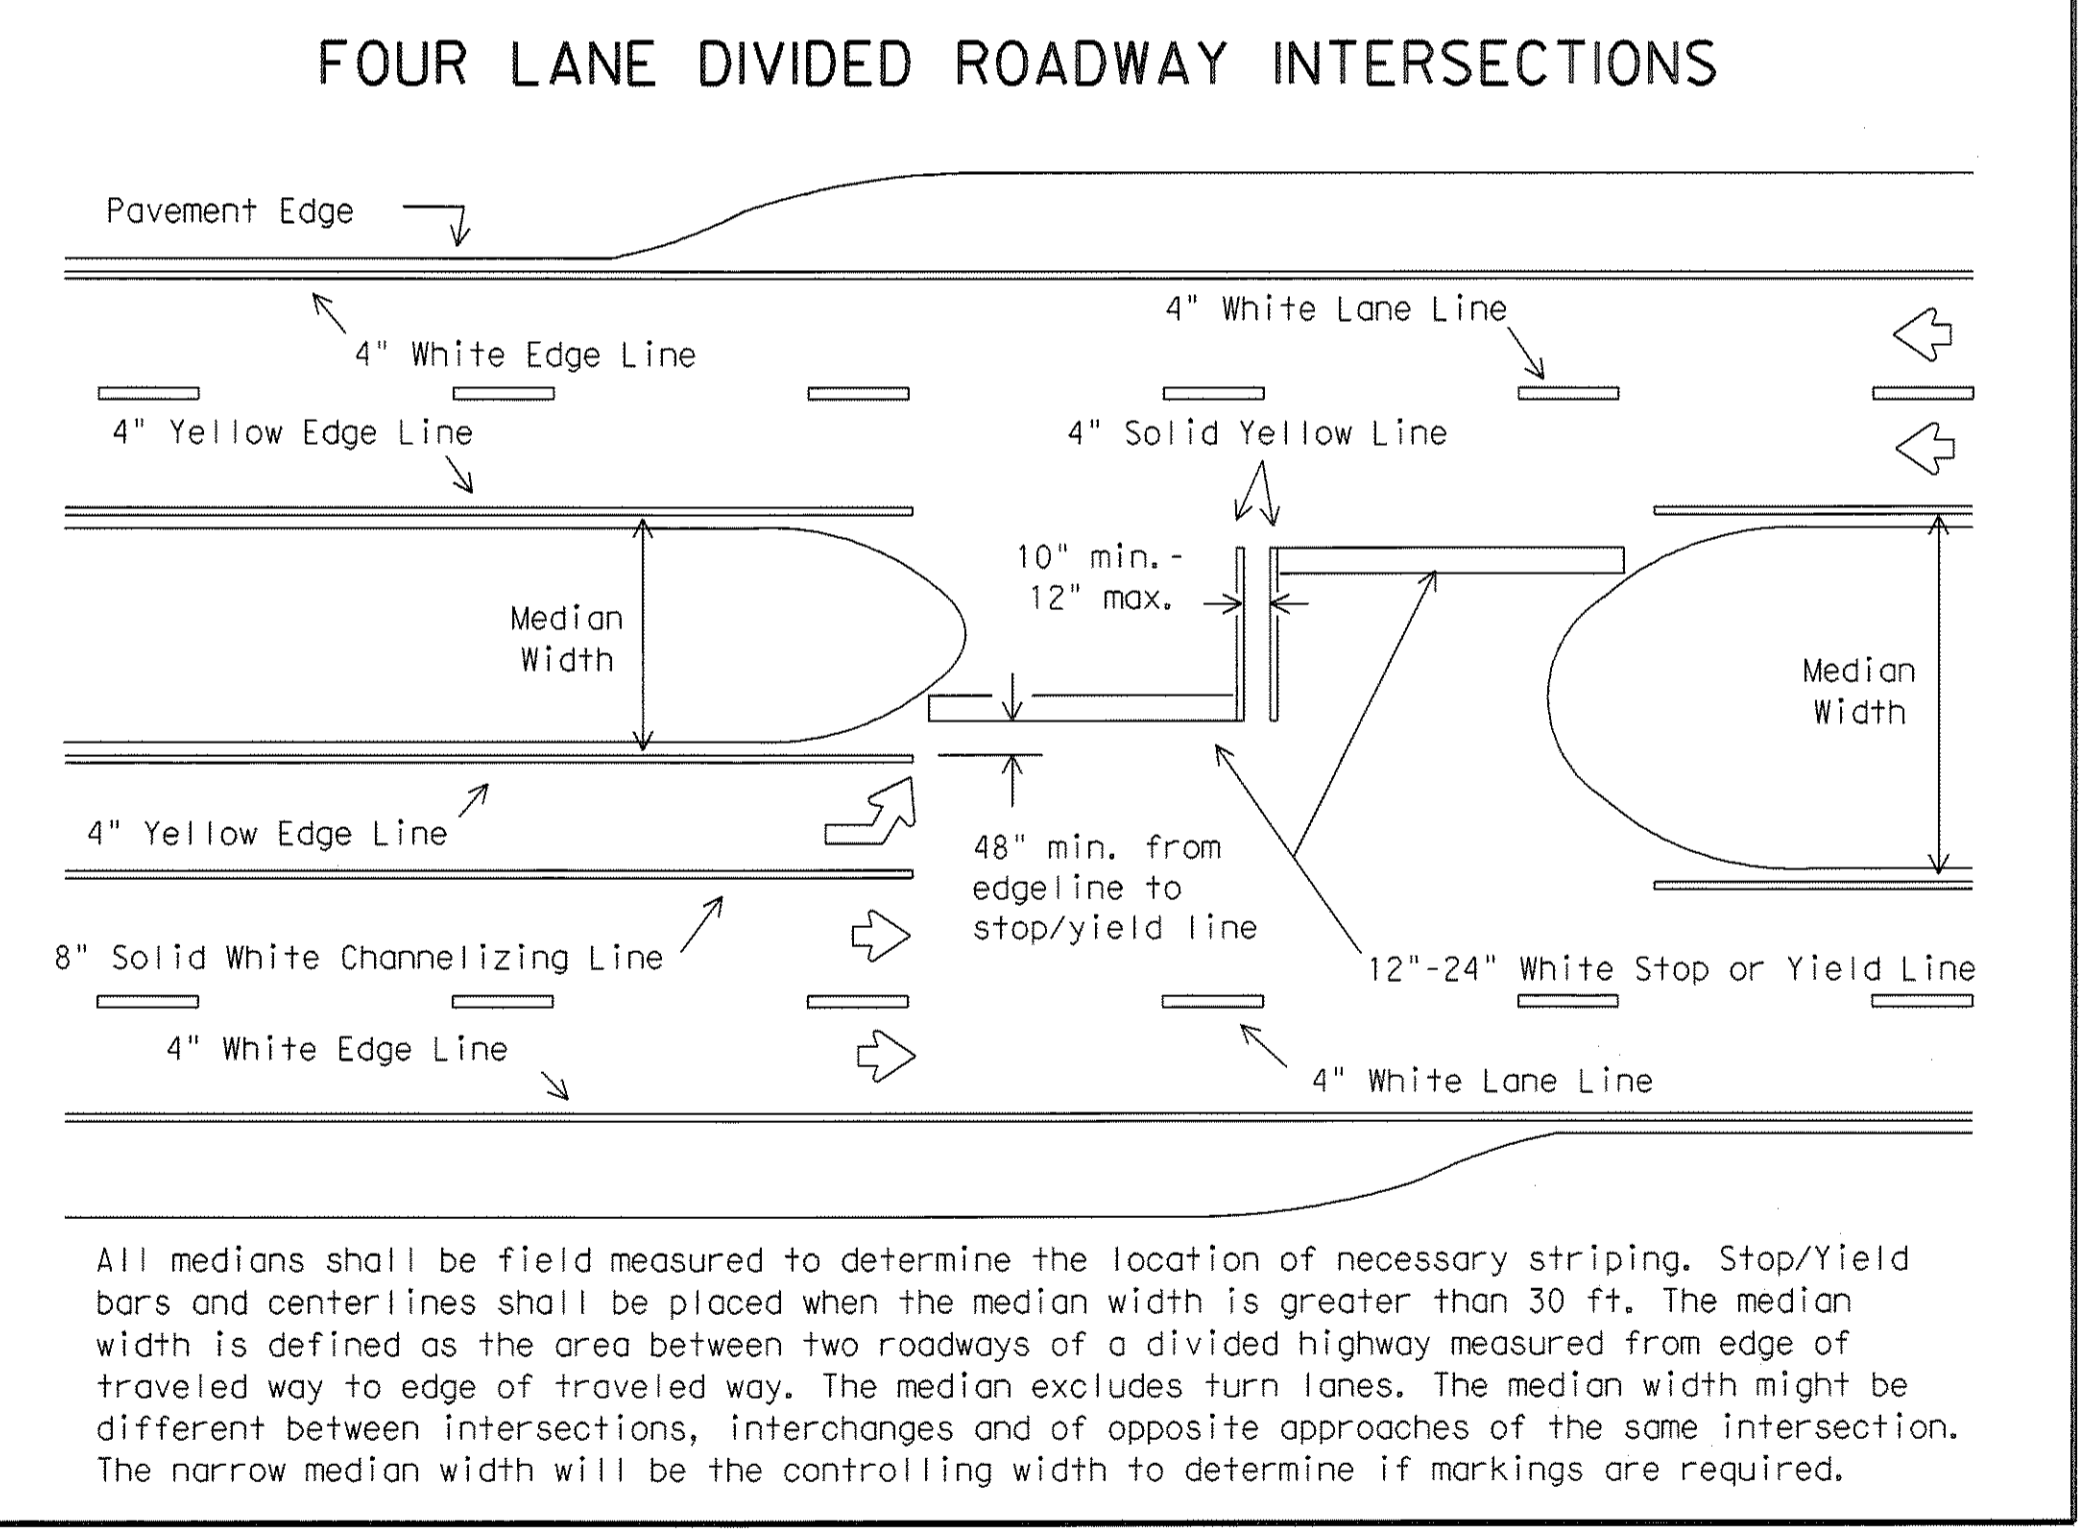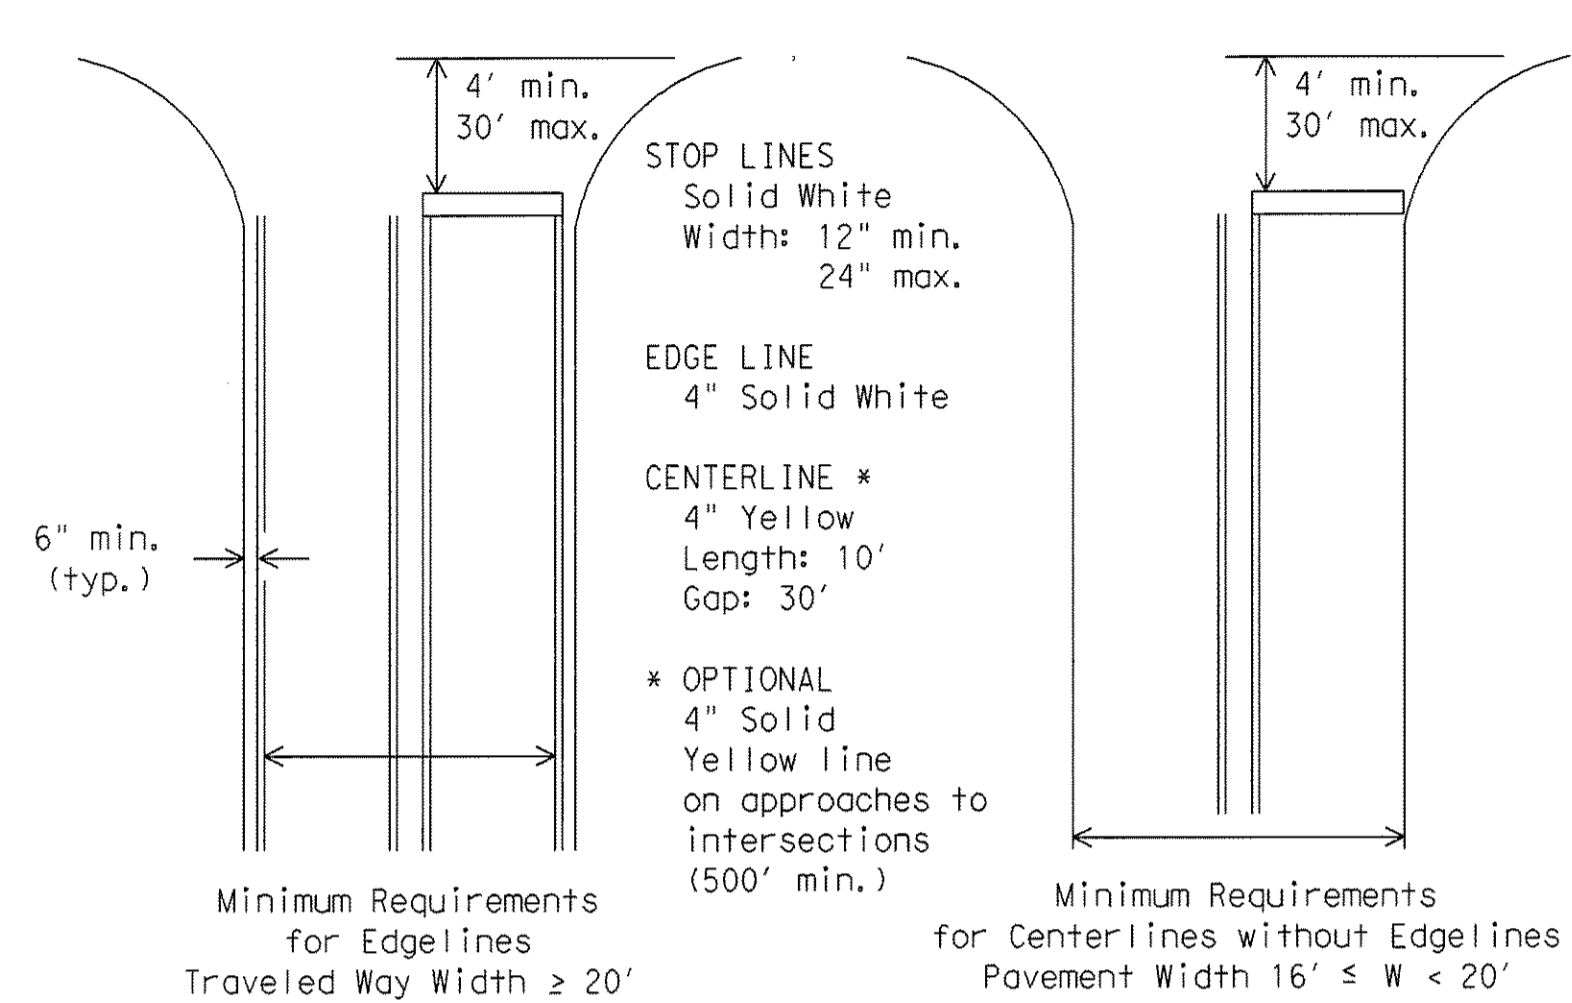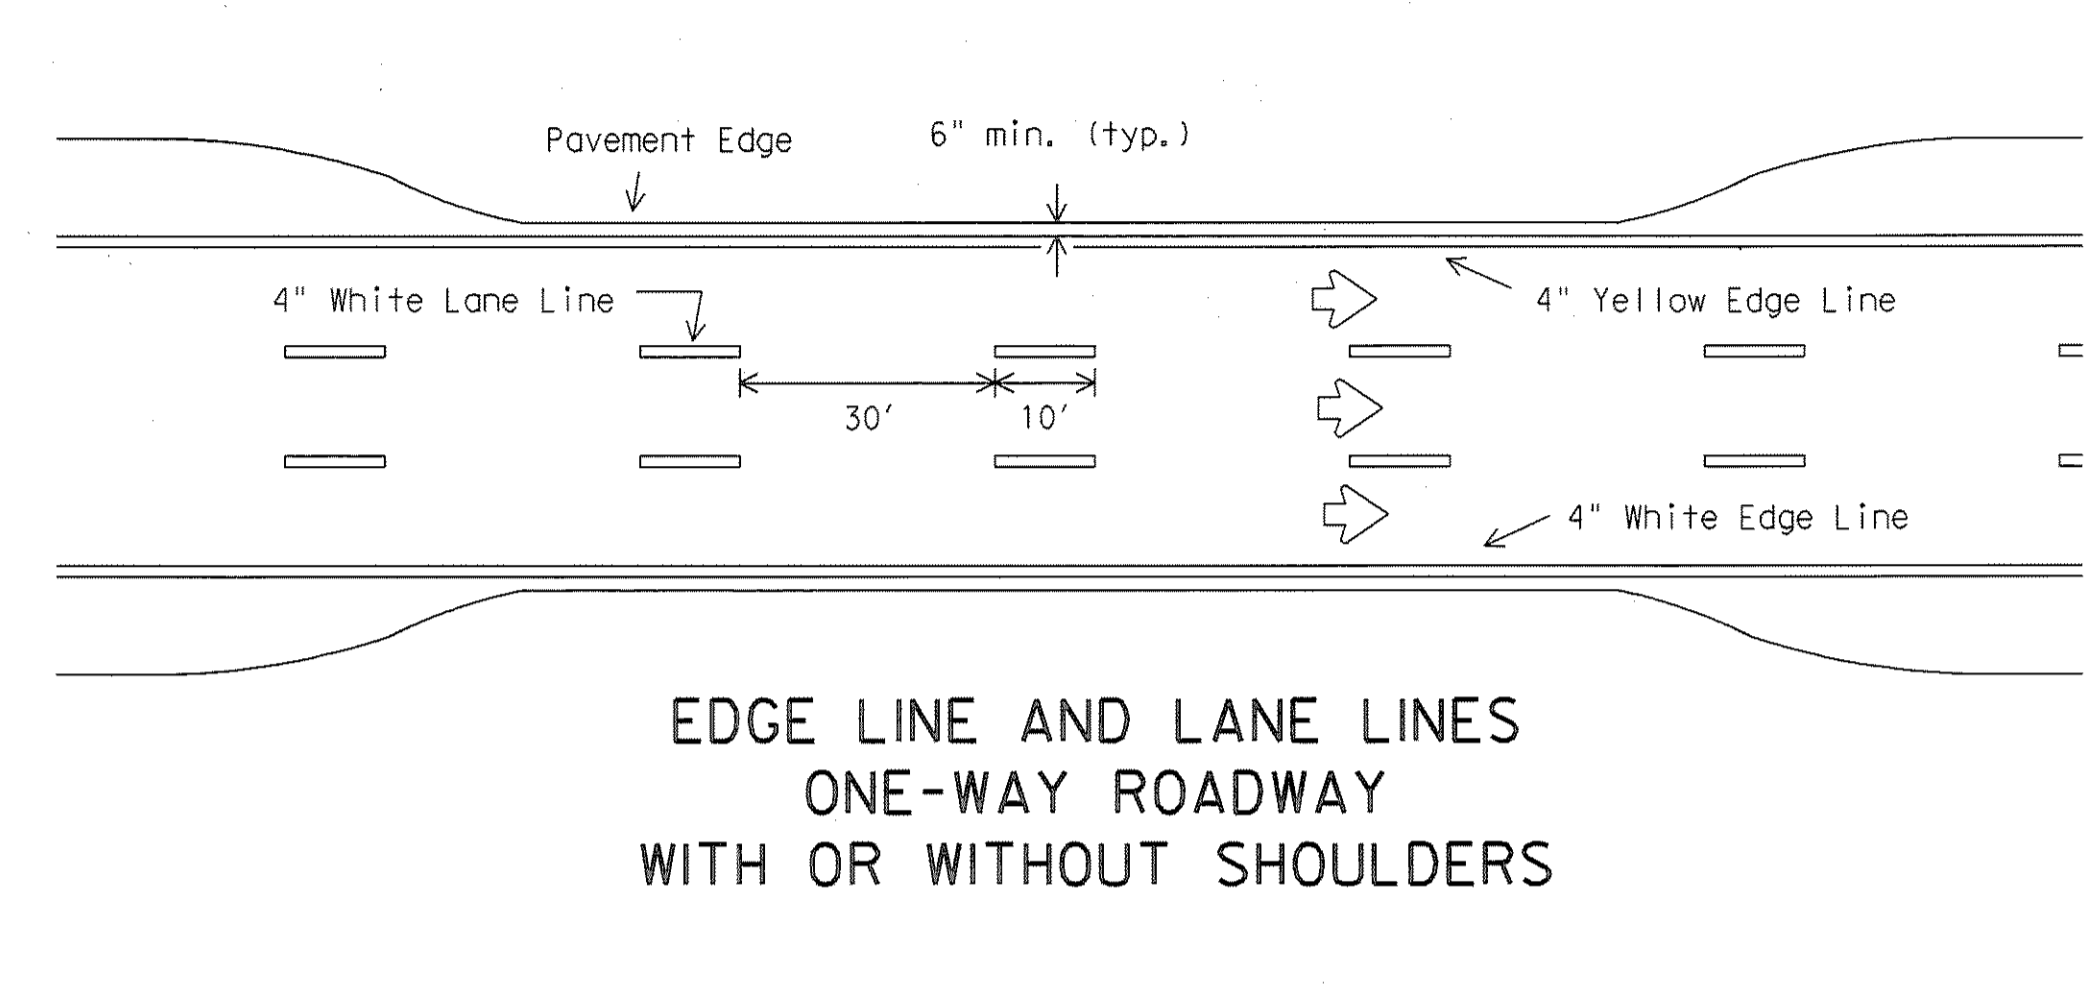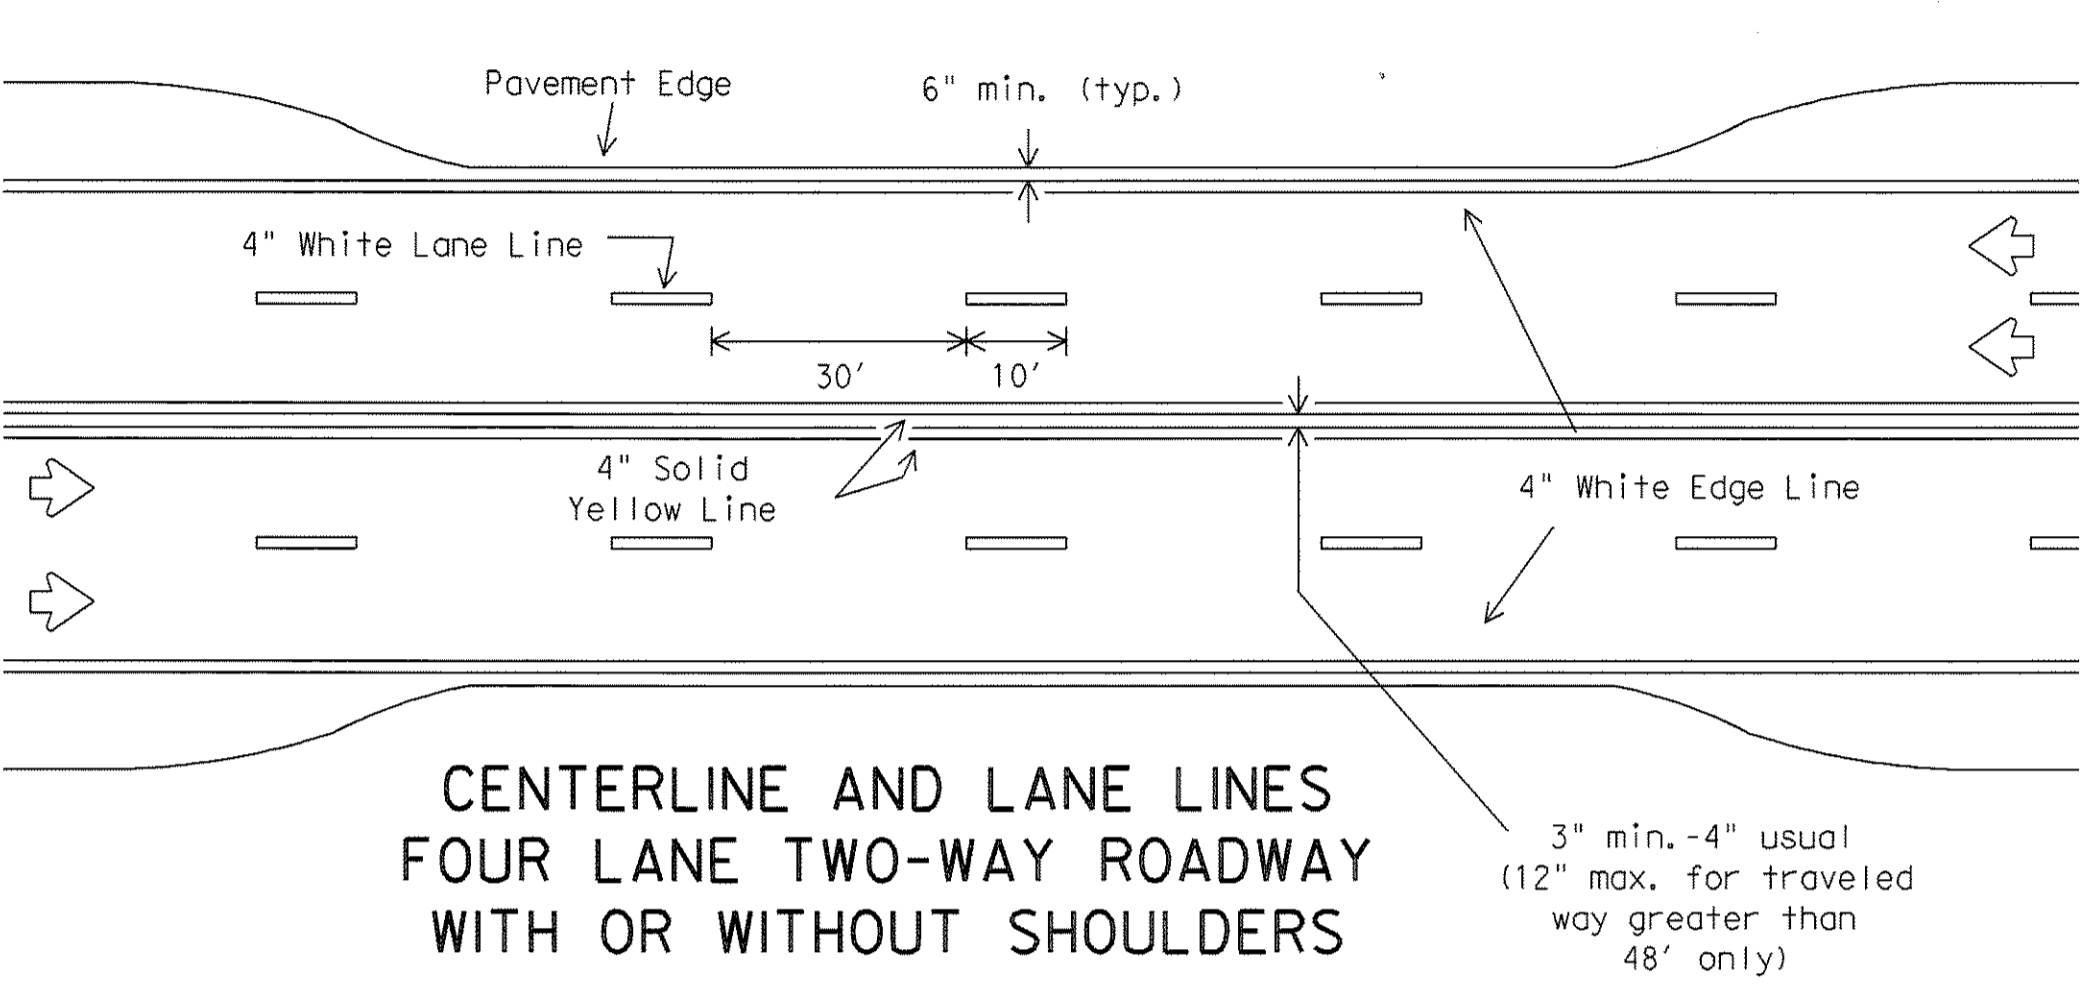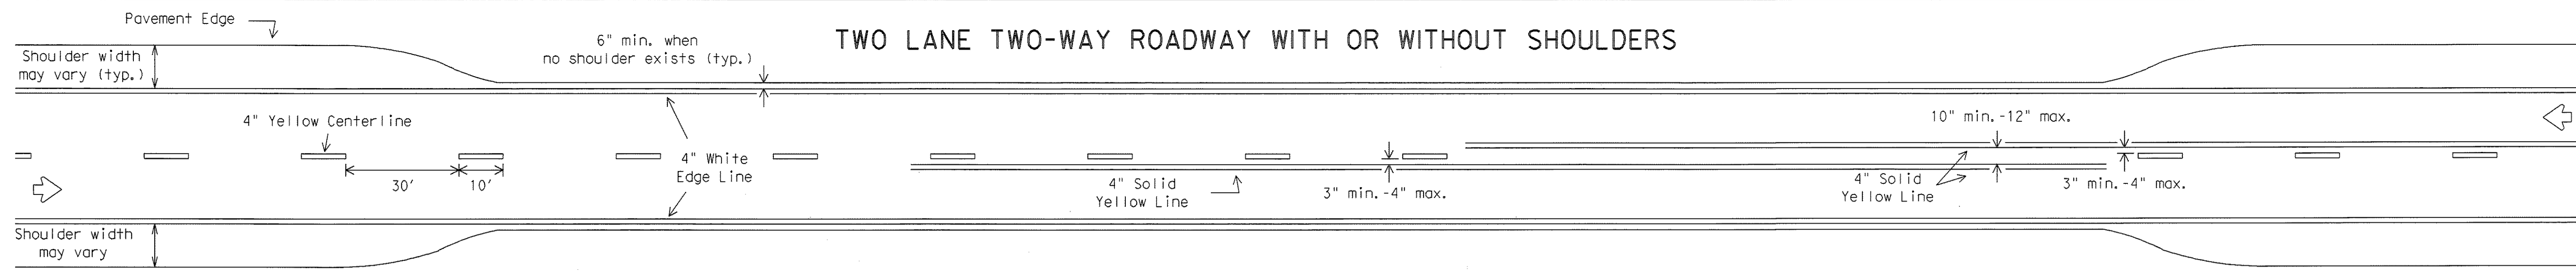

**GUIDE FOR PLACEMENT OF STOP LINES, EDGE LINE & CENTERLINE**  
 Based on Traveled Way and Pavement Widths for Undivided Highways

**GENERAL NOTES:**  
 Edgeline striping shall be as shown in the plans or as directed by the Engineer. The edgeline should typically be placed a minimum of 6 inches from the edge of pavement. This distance may vary due to pavement raveling or other conditions. Edgelines are not required in curb and gutter sections of roadways.  
 The traveled way includes only that portion of the roadway used for vehicular travel and not the parking lanes, sidewalks, berms and shoulders. The traveled ways shall be measured from the inside of edgeline to inside of edgeline of a two lane roadway.  
 All pavement marking materials shall meet the required Departmental Material Specifications as specified by the plans.

**SPECIFICATION REFERENCE TABLE**  
 MATERIAL SPECIFICATIONS  
 PAVEMENT MARKERS (REFLECT.) DMS-4200  
 EPOXY DMS-6100  
 BITUMINOUS ADHESIVE FOR PAVEMENT MARKERS DMS-6130

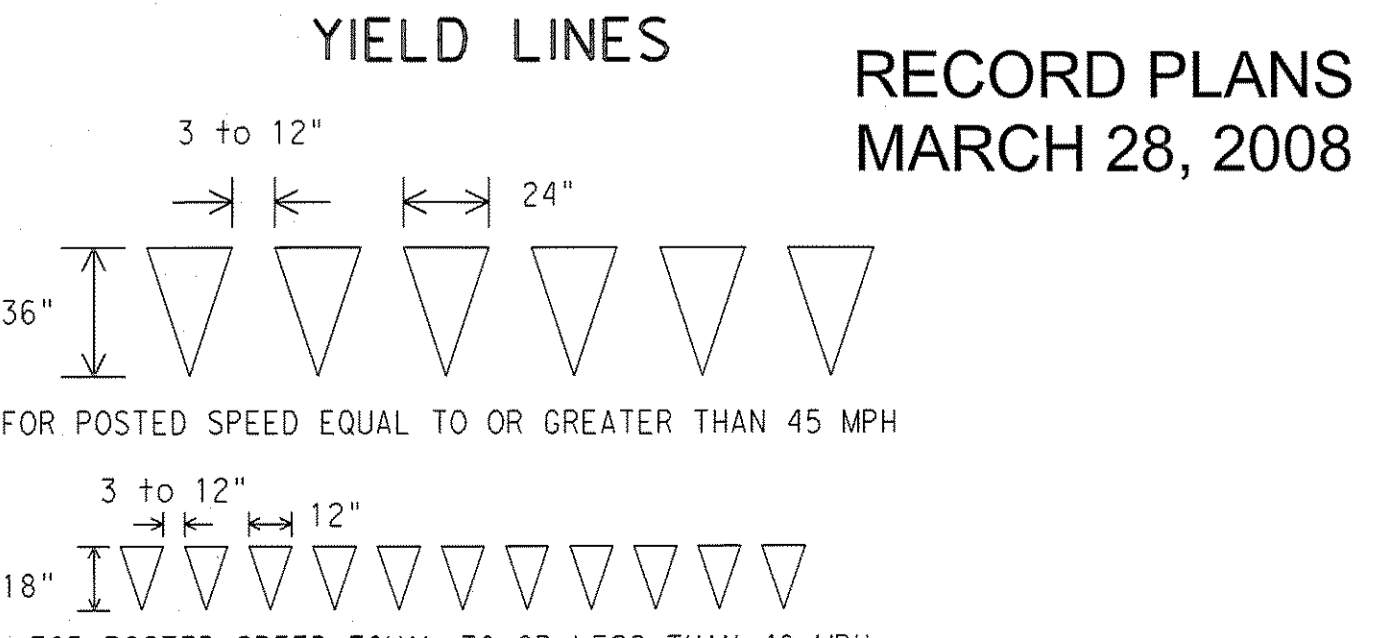

**TABLE 1 - TYPICAL LENGTH (L)**

Posted Speed *	Formula
30, 35, 40	$L = \frac{WS^2}{60}$
45, 50, 55, 60, 65, 70	$L = WS$

* 85th Percentile Speed may be used on roads where traffic speeds normally exceed the posted speed limit. Crosshatching length should be rounded up to nearest 5 foot increment.  
 L=Length of Crosshatching (FT.) W=Width of Offset (FT.) S=Posted Speed (MPH)



**EXAMPLES:**  
 An 8 foot shoulder in advance of a bridge reduces to 4 feet on a 70 MPH roadway. The length of the crosshatching should be:  
 $L = 8 \times 70 = 560$  ft.  
 A 4 foot shoulder in advance of a bridge reduces to 2 feet on a 40 MPH roadway. The length of the crosshatching should be:  
 $L = 4(40)^2 / 60 = 106.67$  ft. rounded to 110 ft.

**STANDARD PLANS**  
 Texas Department of Transportation  
 Traffic Operations Division


**TYPICAL STANDARD PAVEMENT MARKINGS**  
**PM(1)-03**

© TxDOT November 1978  
 REVISIONS: 8-95, 5-00, 8-00, 3-03  
 STATE: 6  
 FEDERAL AID PROJECT: COUNTY CONTROL SECTION JOB HIGHWAY  
 SHEET: M203


## REFLECTIVE RAISED PAVEMENT MARKERS FOR VEHICLE POSITIONING GUIDANCE

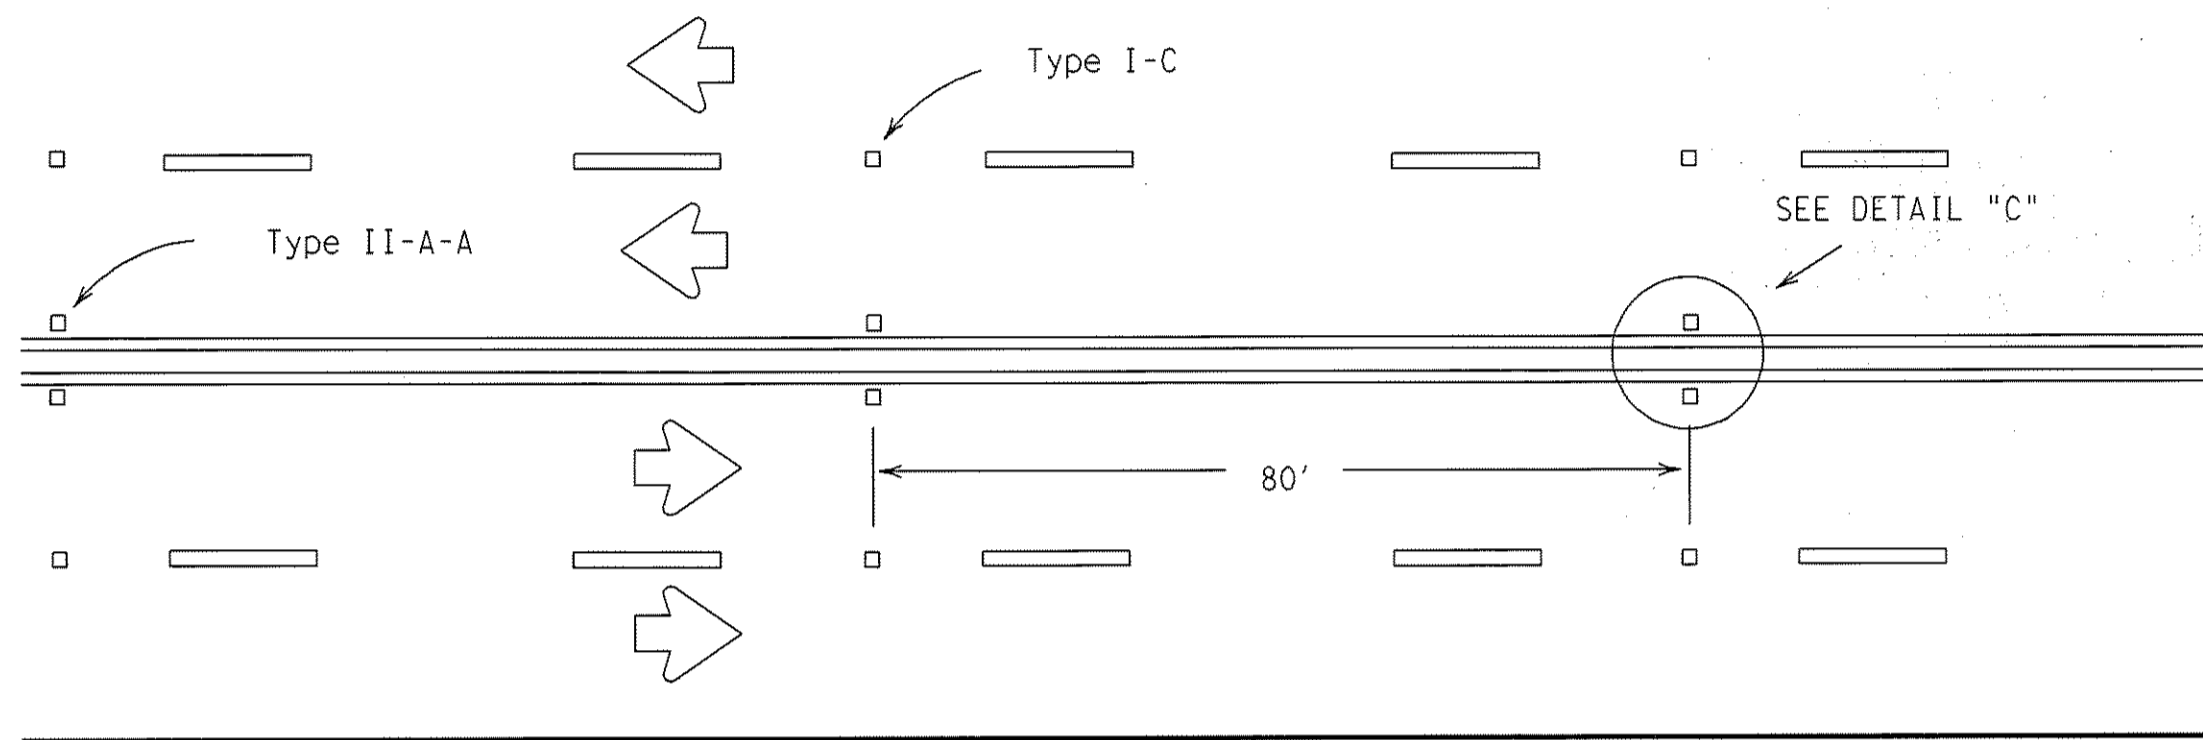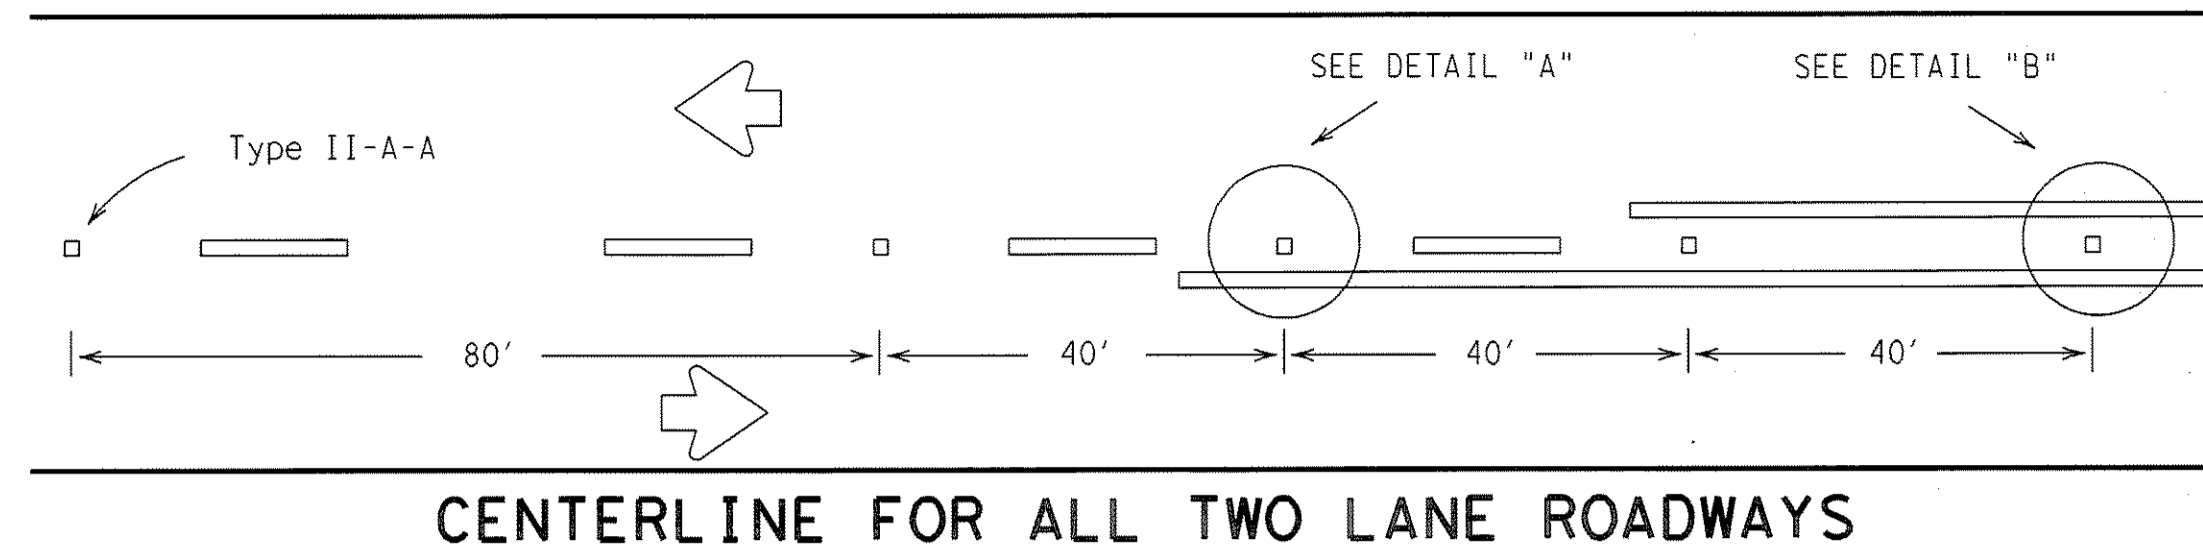

Raised pavement marker Type I-C, clear face toward normal traffic, shall be placed on 80-foot centers.

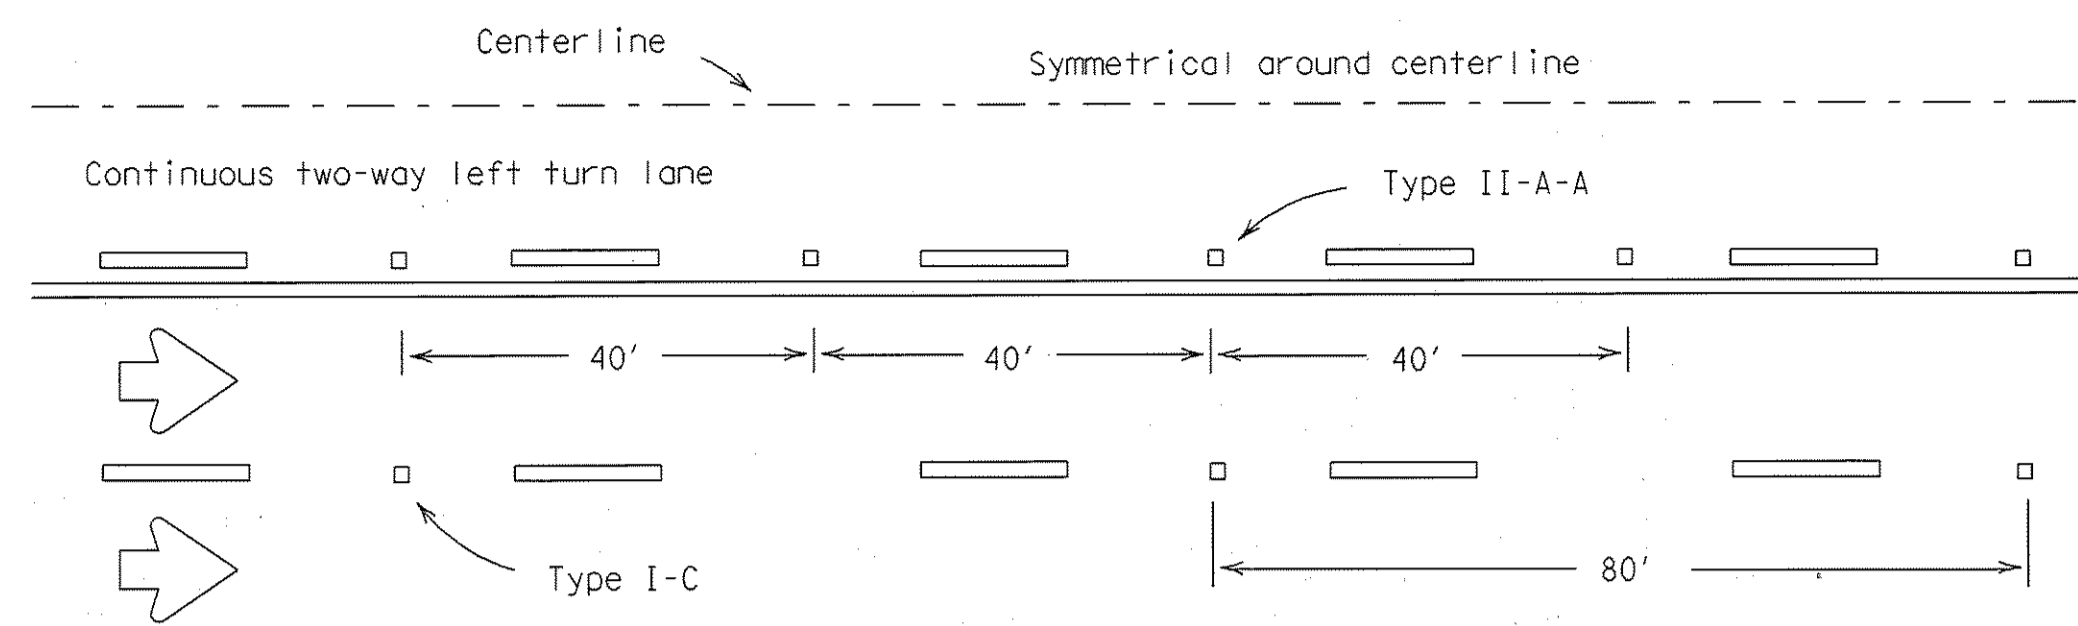

### CENTERLINE AND LANE LINES FOR TWO-WAY LEFT TURN LANE

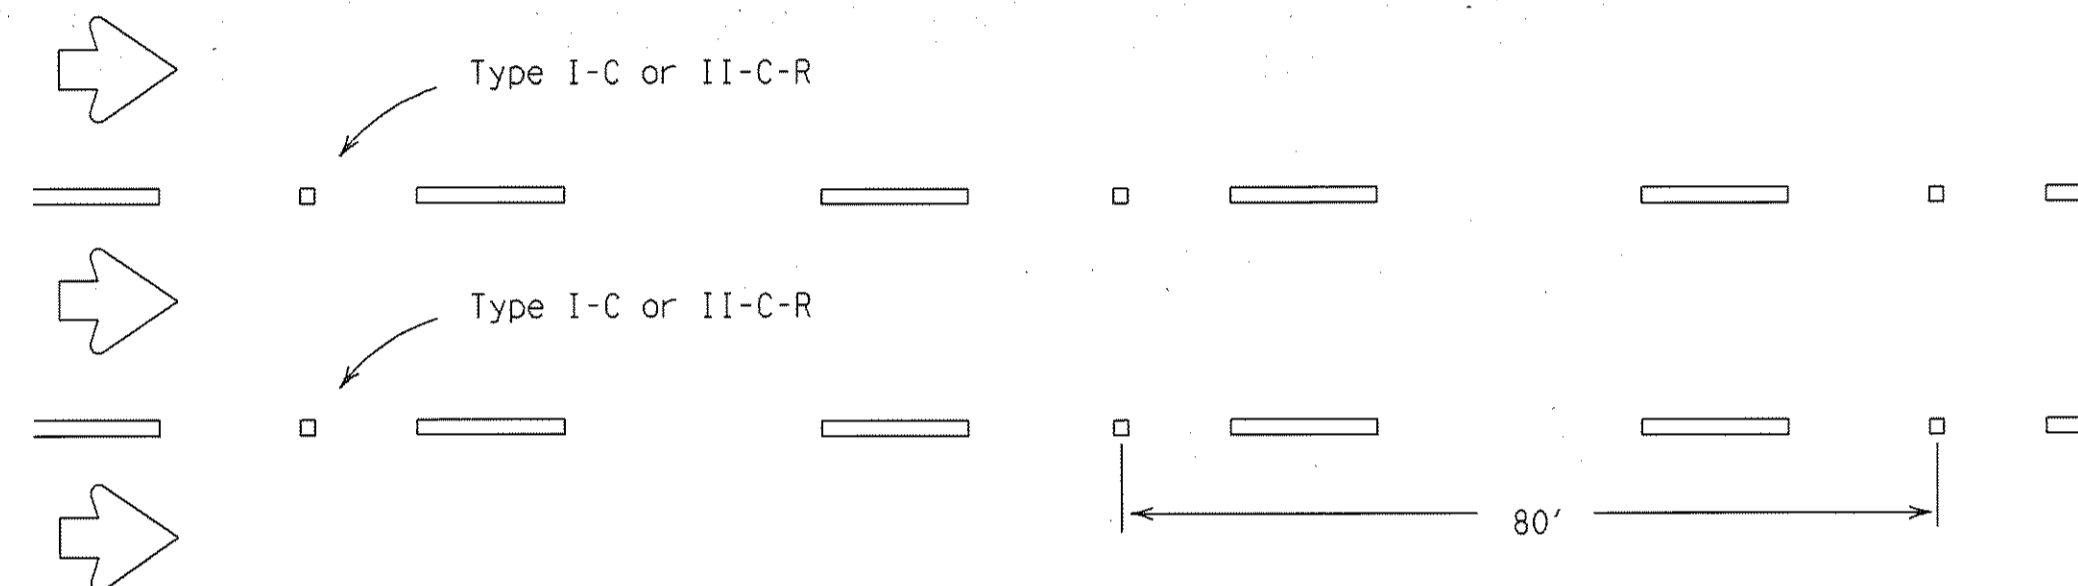


### LANE LINES FOR ONE-WAY ROADWAY (NON-FREEWAY FACILITIES)

Raised pavement markers Type II-C-R shall have clear face toward normal traffic and red face toward wrong-way traffic. As required by the Engineer or shown elsewhere in the plans, Type II-C-R or Type I-C markers may be placed on 40-foot centers for the below listed conditions:


1. horizontal curves,
2. continuously illuminated sections,
3. high volume roadways
4. or roadways where safety concerns exist.

## RAISED PAVEMENT MARKERS (REFLECTORIZED)

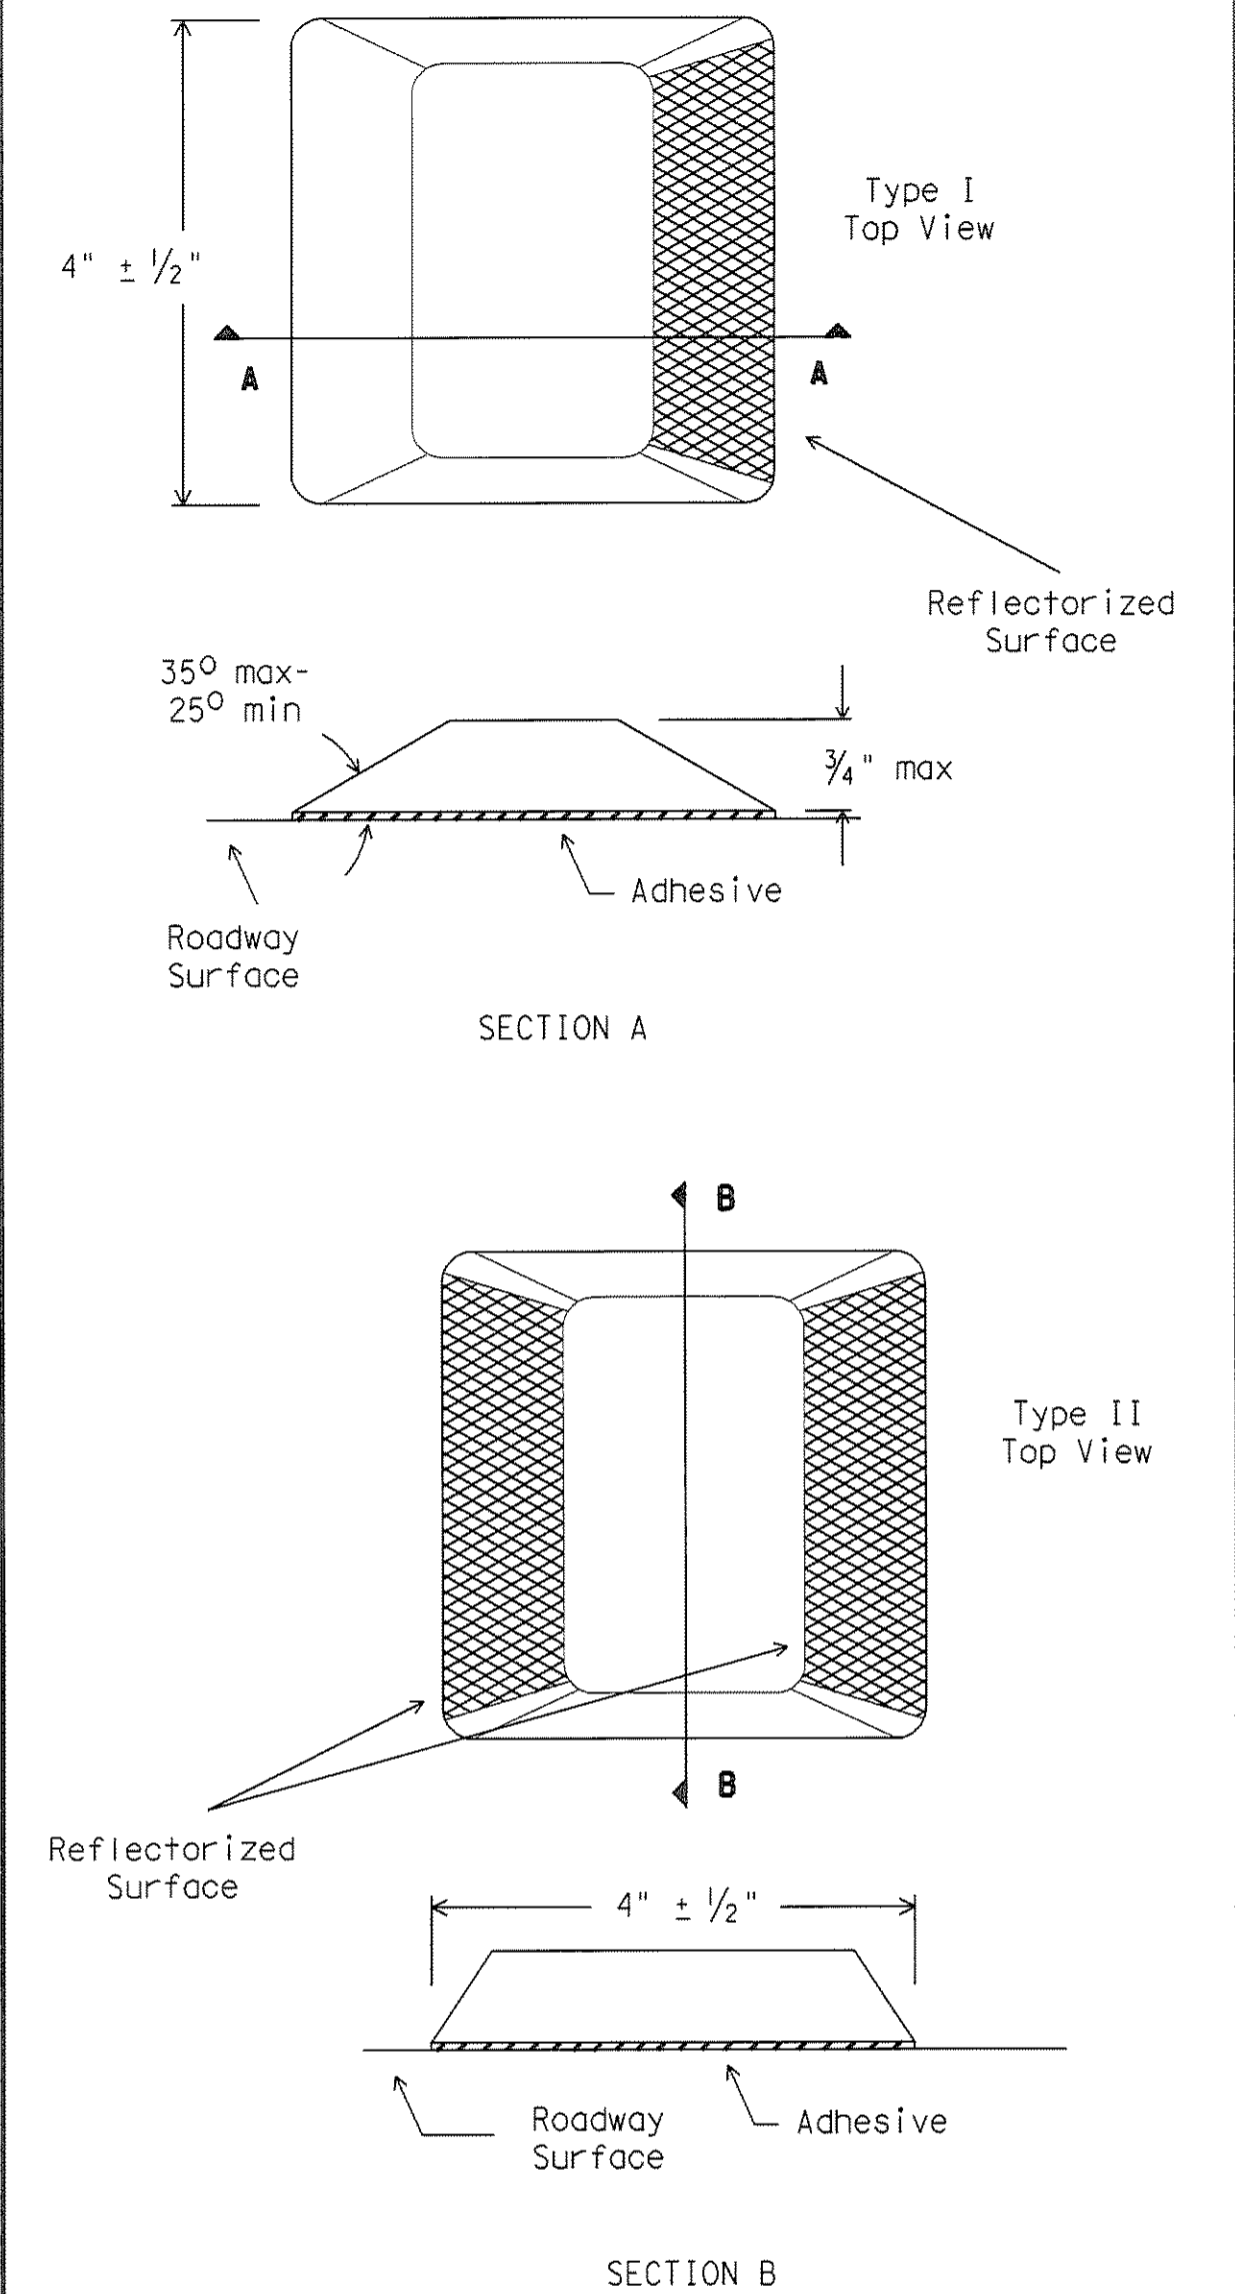

DISCLAIMER  
The use of this standard is governed by the "Texas Engineering Practice Act". No warranty of any kind is made by TxDOT for any purpose whatsoever. TxDOT assumes no responsibility for the conversion of this standard to other formats or for incorrect results or damages resulting from its use.

LEVELS DISPLAYED  
1 2 3 4 5 6 7 8 9 10 11 12 13 14 15 16  
17 18 19 20 21 22 23 24 25 26 27 28 29 30 31 32  
33 34 35 36 37 38 39 40 41 42 43 44 45 46 47 48  
49 50 51 52 53 54 55 56 57 58 59 60 61 62 63

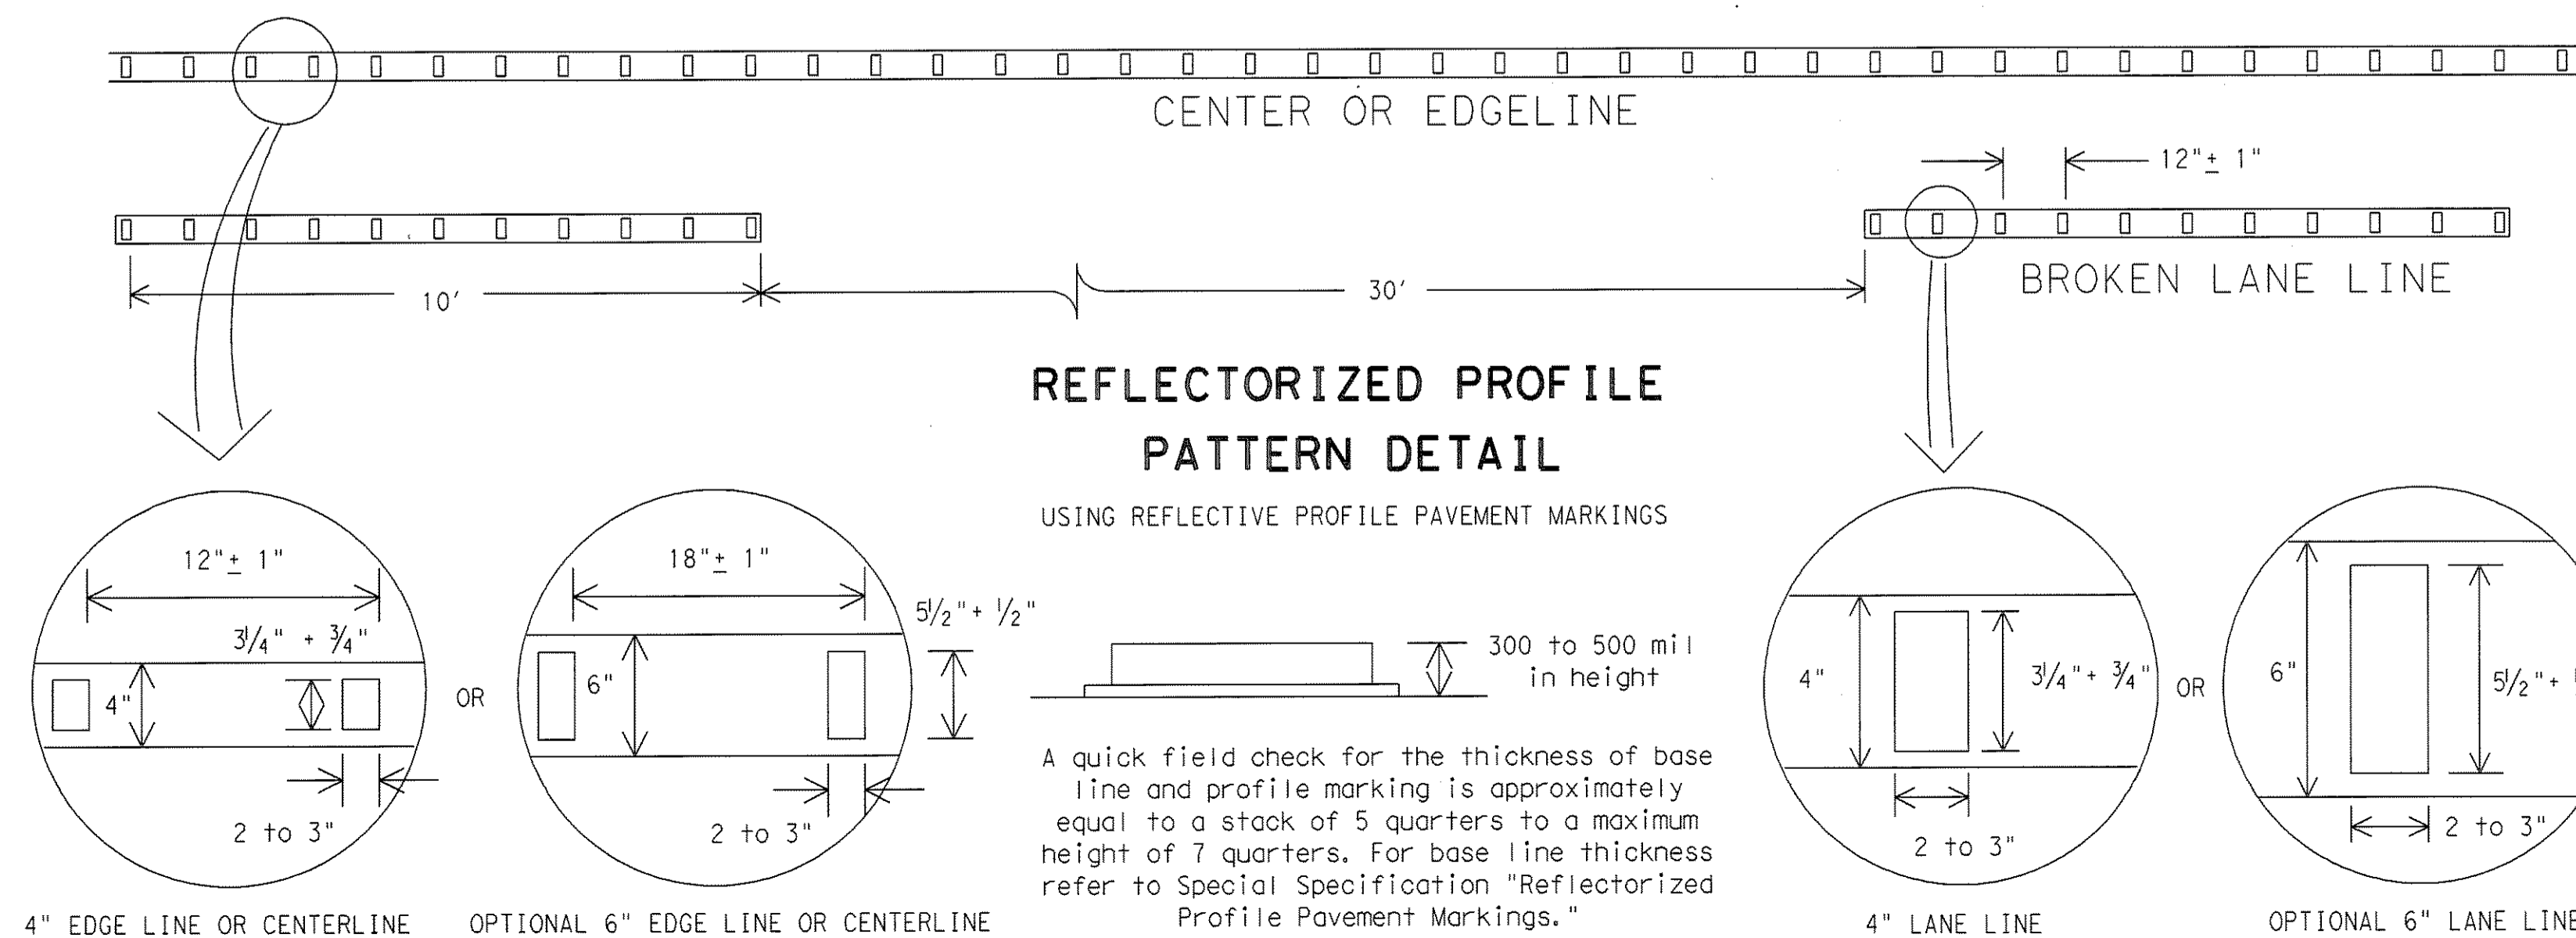

#### GENERAL NOTES:

All raised pavement markers placed in broken lines shall be placed in line with and midway between the stripes.

On concrete pavements the raised pavement markers should be placed to one side of the longitudinal joints.

All pavement marking materials shall meet the required Departmental Material Specifications as specified by the plans.

#### SPECIFICATION REFERENCE TABLE

MATERIAL SPECIFICATIONS	DMS-4200
PAVEMENT MARKERS (REFLECT.)	DMS-6100
EPOXY	DMS-6130
BITUMINOUS ADHESIVE FOR PAVEMENT MARKERS	

**RECORD PLANS  
MARCH 28, 2008**

**STANDARD PLANS**  
Texas Department of Transportation  
Traffic Operations Division







## POSITION GUIDANCE USING RAISED MARKERS REFLECTORIZED PROFILE MARKINGS

**PM(2)-00A**



REVISED	DATE	BY	CHK	APP	PROJECT	SHEET
10-86	4-92	5-00	8-00		FEDERAL A10 PROJECT	24
COUNTY		CONTROL	SECTION	JOB	HIGHWAY	

DISCLAIMER  
 The use of this standard is governed by the "Texas Engineering Practice Act". No warranty of any kind is made by TxDOT for any purpose whatsoever. TxDOT assumes no responsibility for the conversion of this standard to other formats or for incorrect results or damages resulting from its use.

LEVELS DISPLAYED  
 1 2 3 4 5 6 7 8 9 10 11 12 13 14 15 16  
 ACC: 17 18 19 20 21 22 23 24 25 26 27 28 29 30 31 32  
 33 34 35 36 37 38 39 40 41 42 43 44 45 46 47 48  
 49 50 51 52 53 54 55 56 57 58 59 60 61 62 63

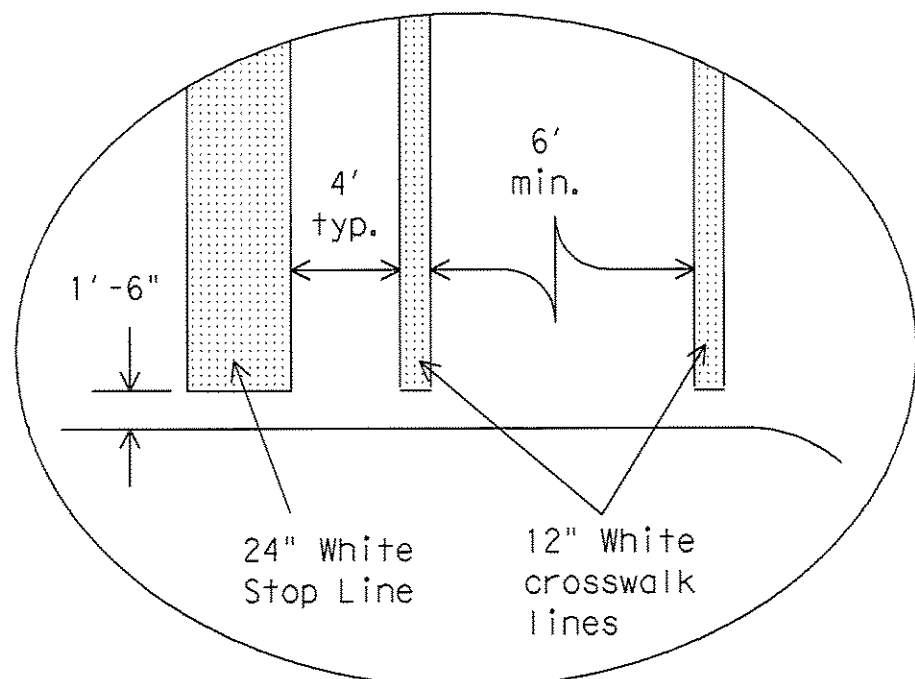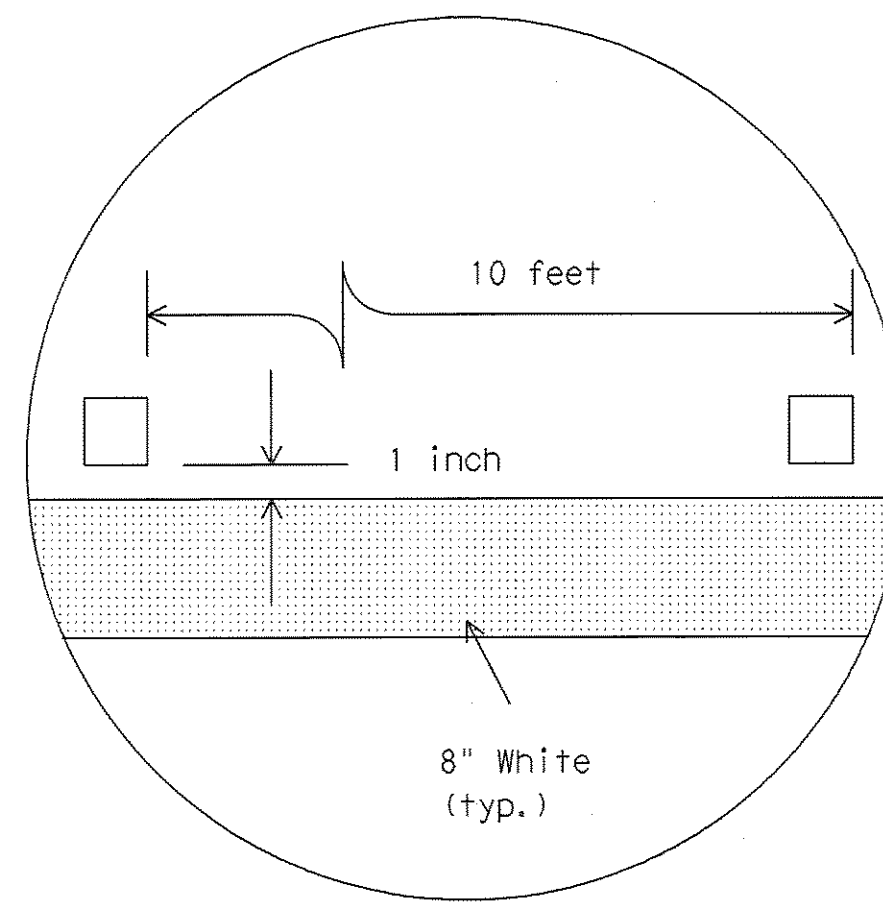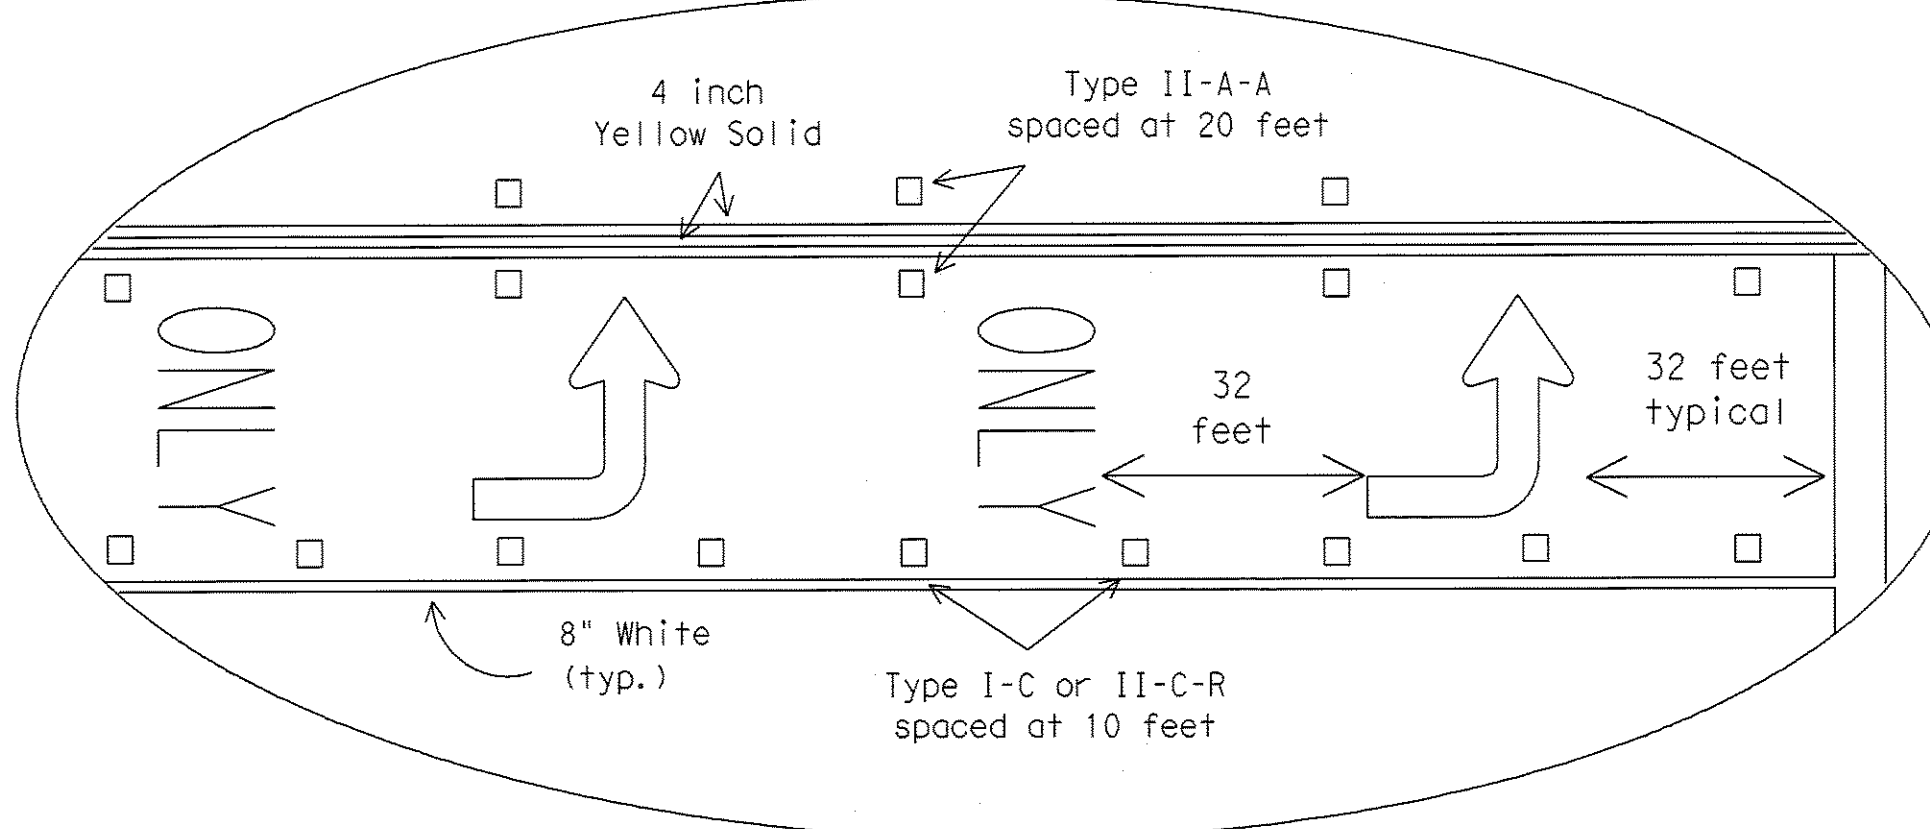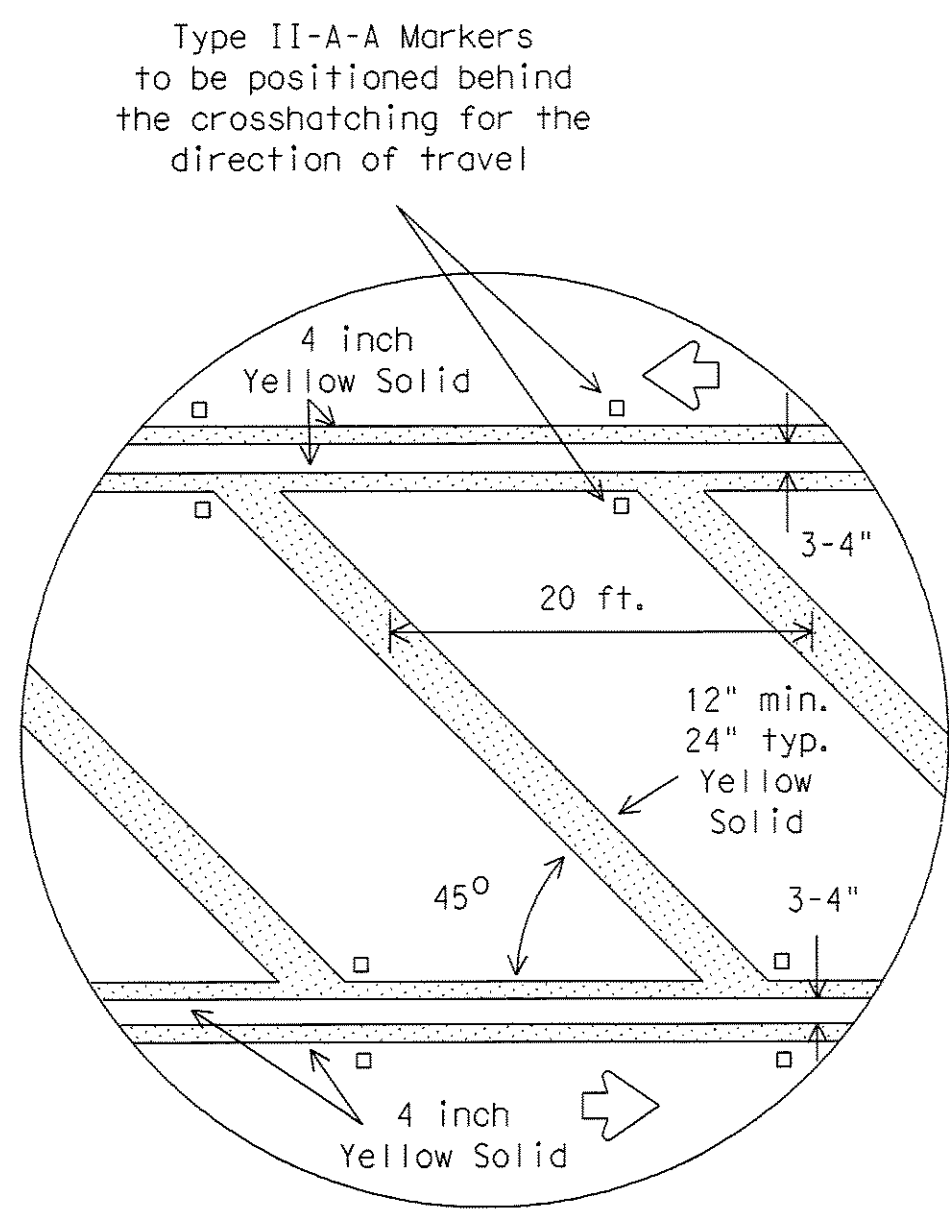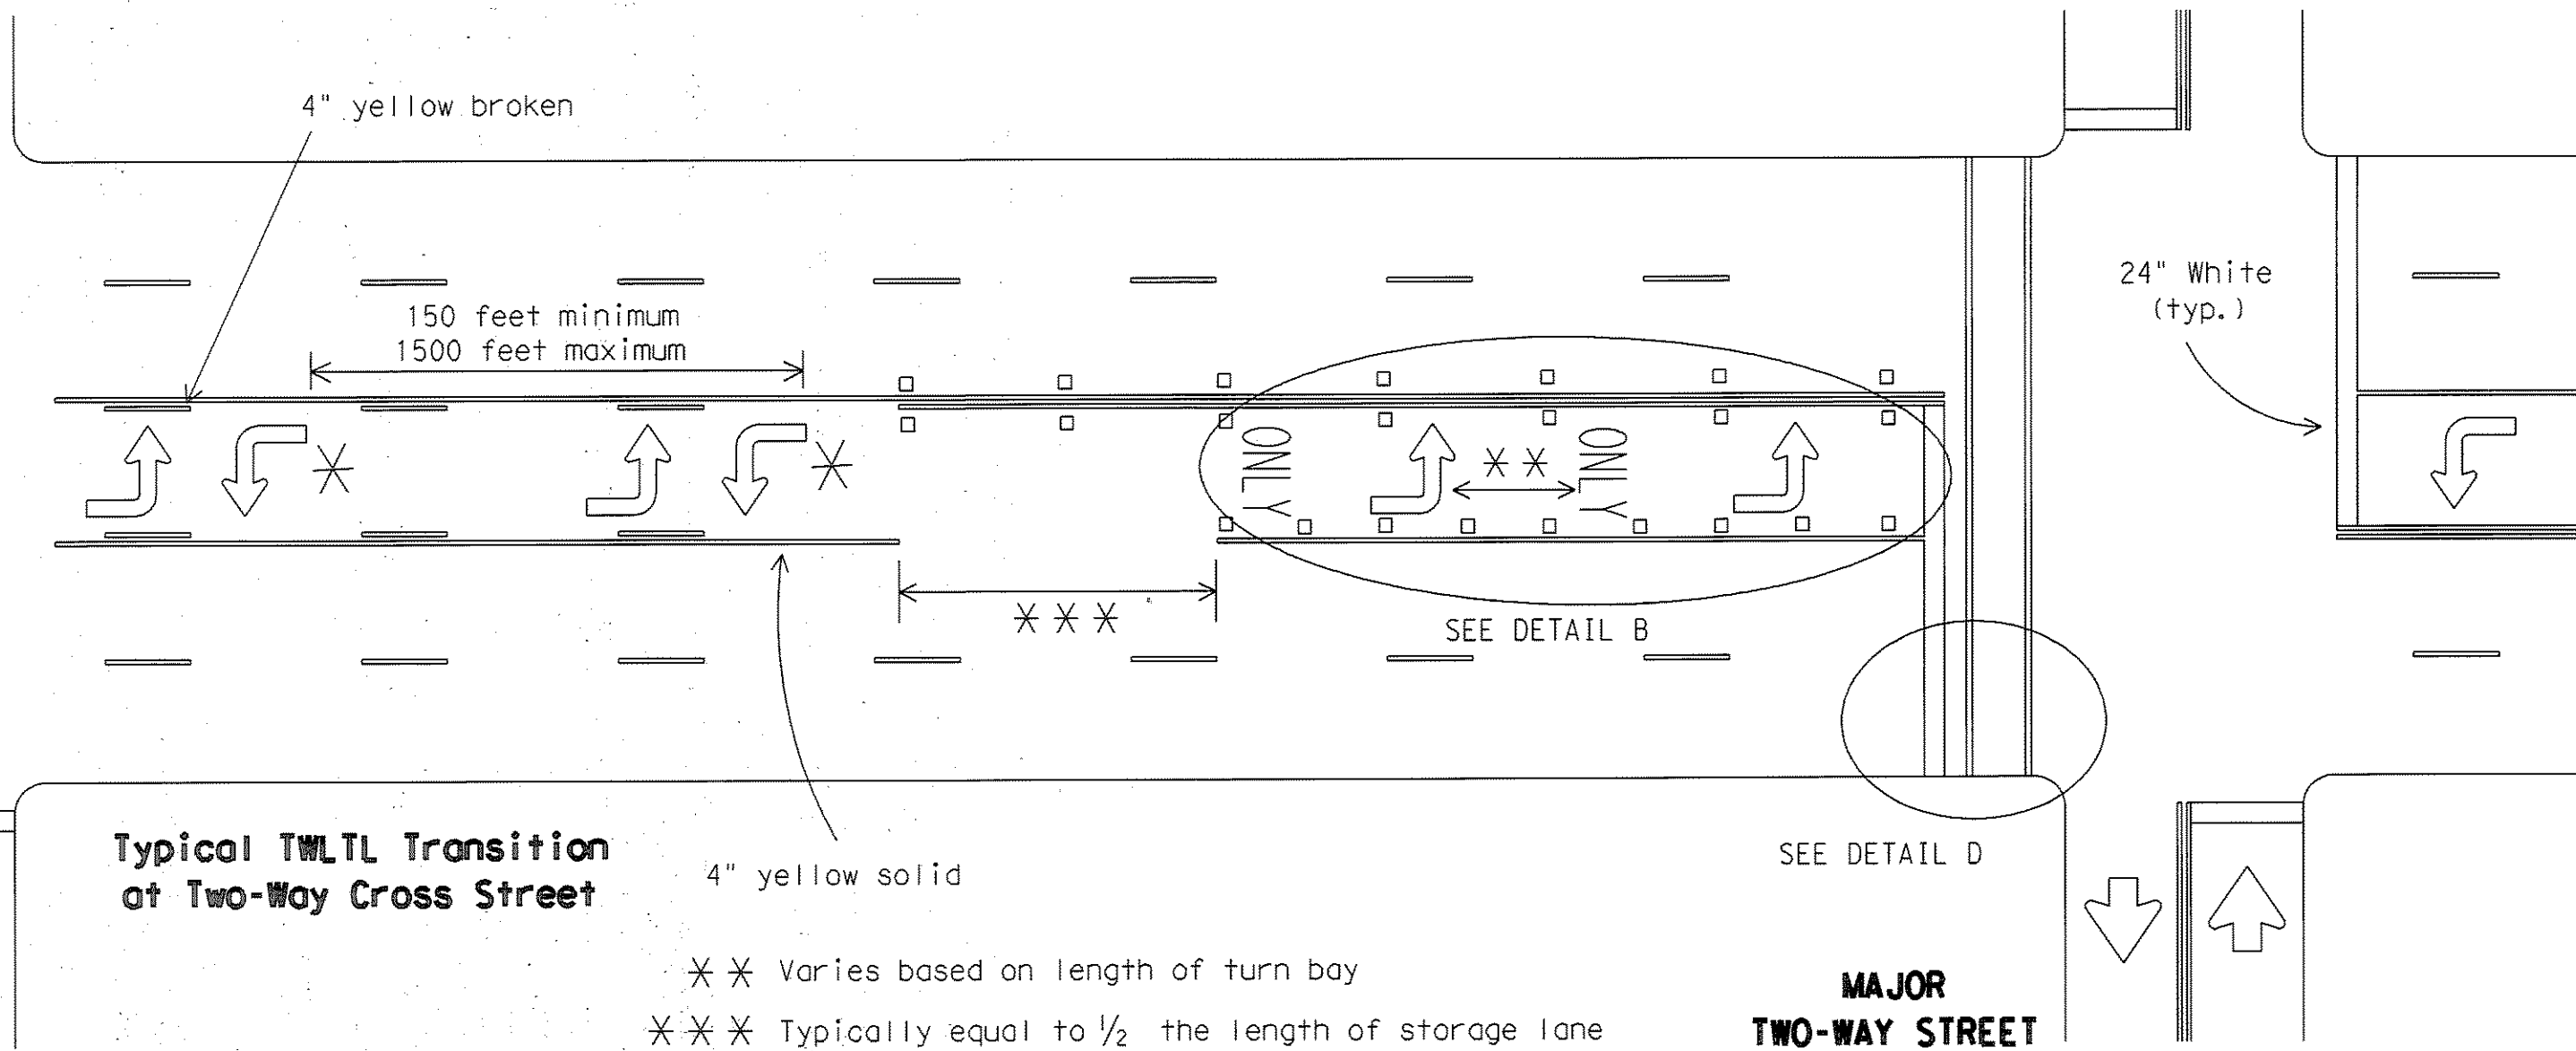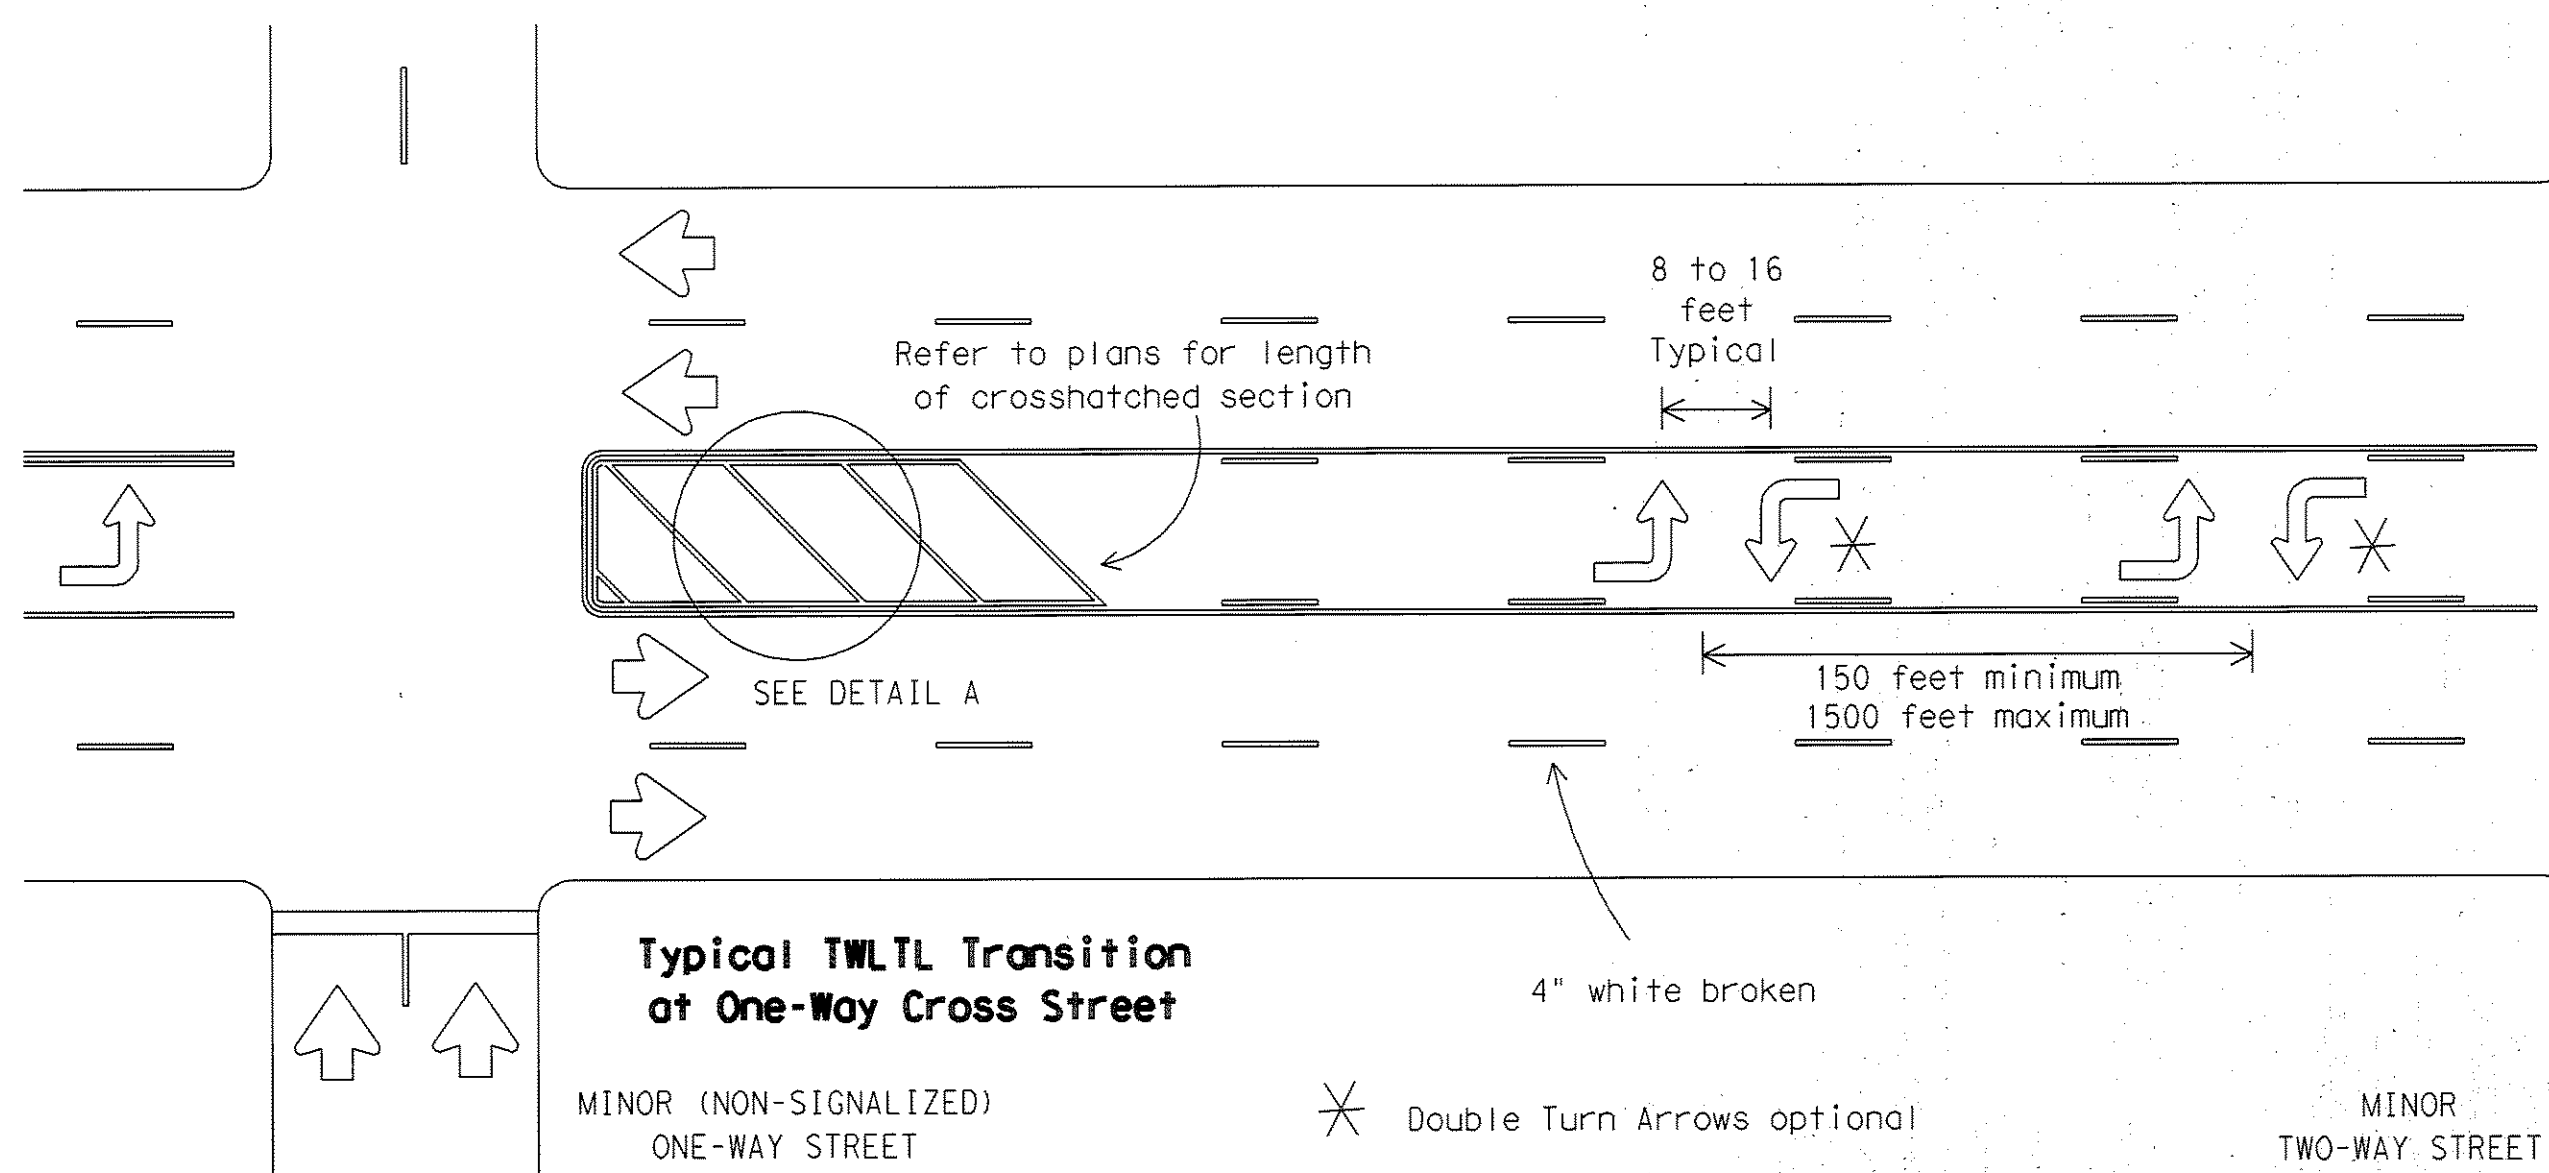

DETAIL D  
 Final placement of Stop Bar and Crosswalk shall be approved by the Engineer in the field.

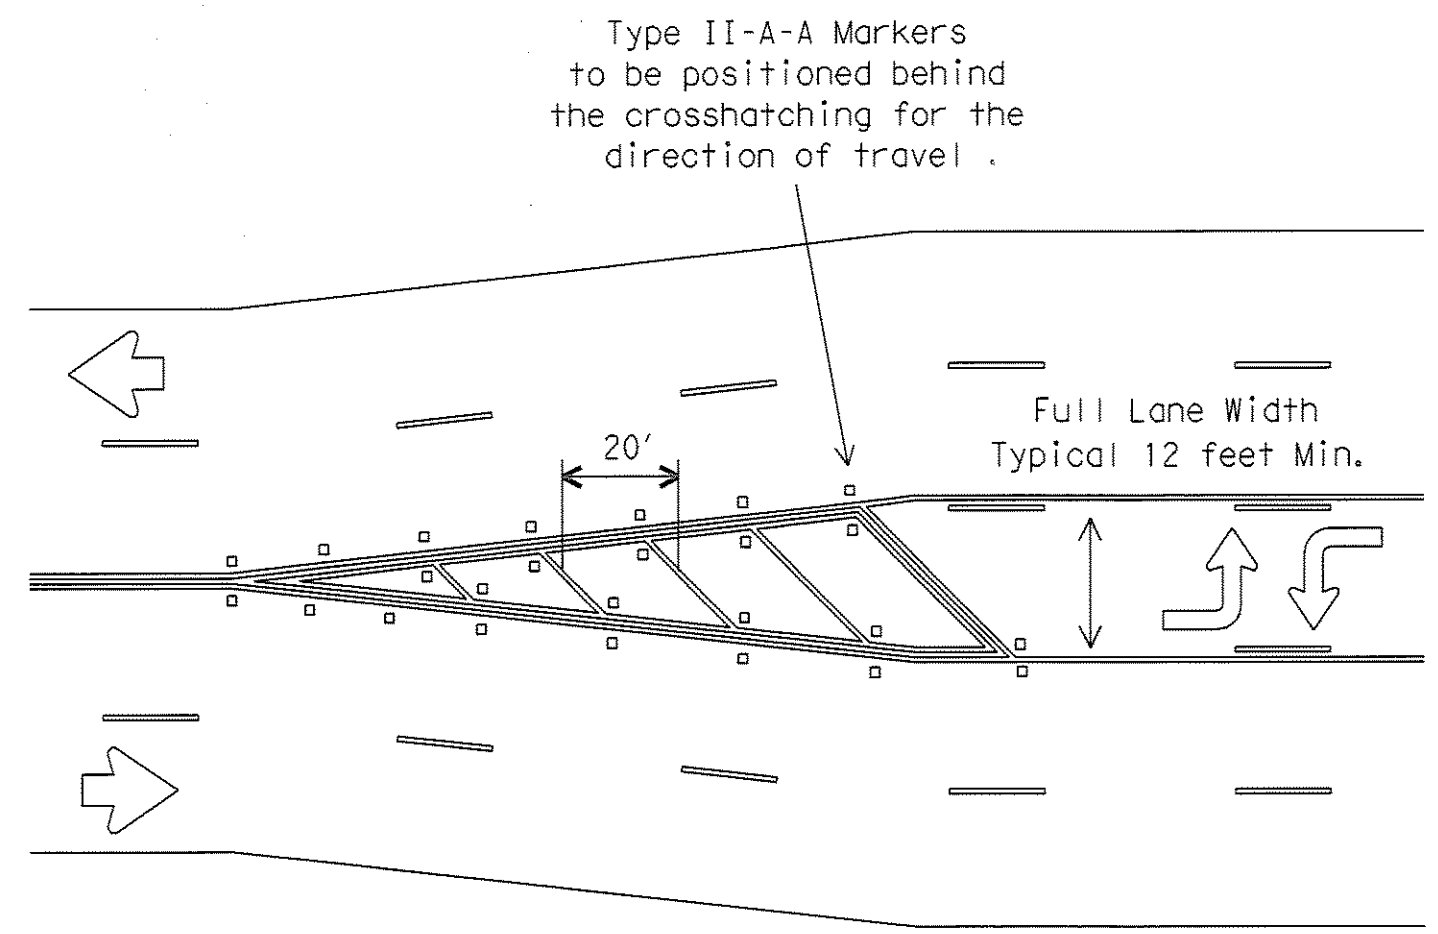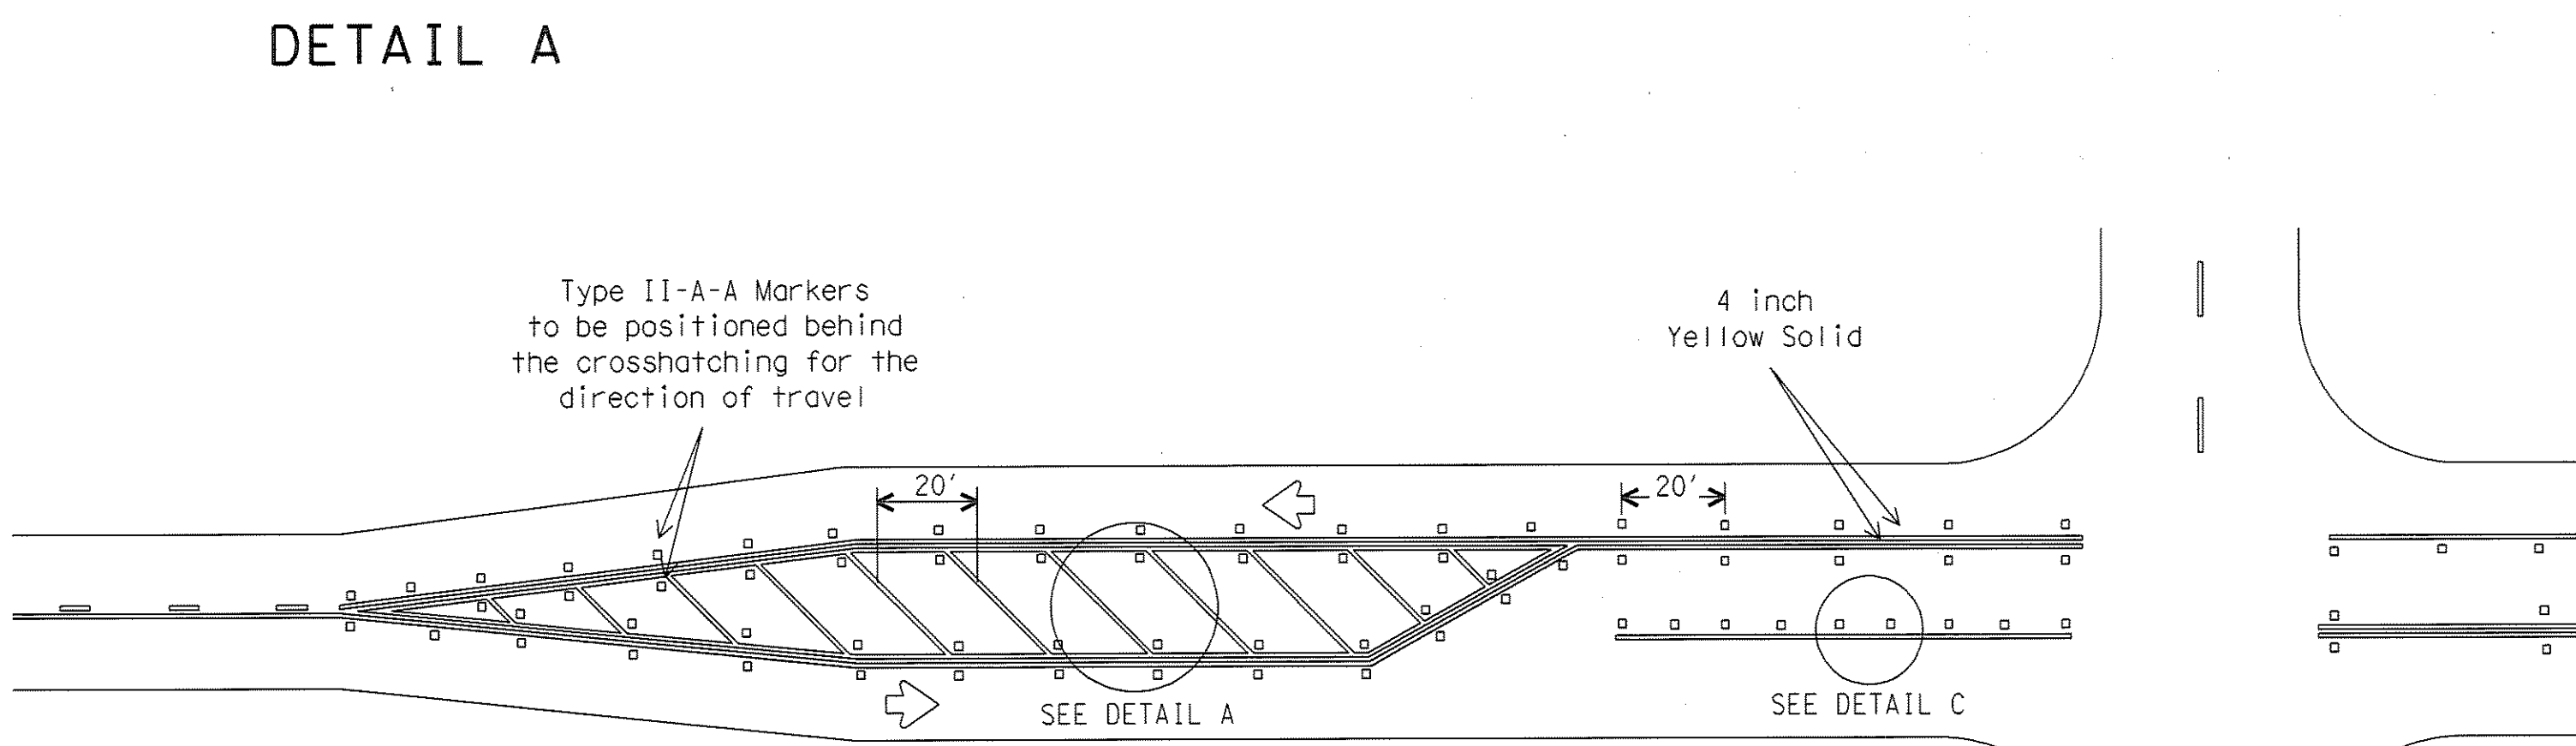

TYPICAL TWO-LANE HIGHWAY INTERSECTION WITH LEFT TURN BAYS

TYPICAL TRANSITION FOR TWLTL AND DIVIDED HIGHWAY

DETAIL C  
 Raised pavement marker Type I-C with undivided highways, flush medians and two way left turn lanes.  
 Raised pavement marker Type II-C-R with divided highways and raised medians.

GENERAL NOTES  
 Refer elsewhere in plans for additional RPM placement and details.  
 Details for words and arrows as shown on other sheets.  
 All pavement marking materials shall meet the required Departmental Material Specifications as specified by the plans.  
 For a left turn bay, two sets of words and arrows shall be used if the length of the bay is equal to or greater than 180 feet. The bottom of the first ONLY shall be placed at the beginning of the turn bay lane line as shown above.  
 Other crosswalk patterns as shown in the "Texas Manual on Uniform Traffic Control Devices" may be used.

SPECIFICATION REFERENCE TABLE  
 MATERIAL SPECIFICATIONS  
 PAVEMENT MARKERS (REFLECT.) DMS-4200  
 EPOXY DMS-6100  
 BITUMINOUS ADHESIVE FOR PAVE. MKS. DMS-6130

STANDARD PLANS  
 Texas Department of Transportation  
 Traffic Operations Division

PAVEMENT MARKINGS FOR TWO-WAY LEFT TURN LANES DIVIDED HIGHWAYS AND RURAL LEFT TURN BAYS  
 PM(4)-03

REVISIONS	STATE DISTRICT	FEDERAL REGION	FEDERAL AID PROJECT	SHEET
5-00		6		M205
8-00				
3-03	COUNTY	CONTROL	SECTION	JOB
				HIGHWAY

© TxDOT April 1998  
 ON-BAS  
 CR-GRB  
 DM-FDN  
 CR-CAL  
 NEG NO.:

DISCLAIMER

The use of this standard is governed by the "Texas Engineering Practice Act". No warranty of any kind is made by TxDOT for any purpose whatsoever. TxDOT assumes no responsibility for the conversion of this standard to other formats or for incorrect results or damages resulting from its use.

LEVELS DISPLAYED

1 2 3 63 ACC: 1718192021222324252627282930313233343536373839404142434445464748495051525354555657585960616263

TRUCKS

9.5' (±.5) 4" ←

NEXT

7.5' (±.5) 4" ←

YIELD

7.0' (±.5) 4" ←

MERGE

8.0' (±.5) 4" ←

EXIT

6.5' (±.5) 4" ←

STOP

6.5' (±.5) 4" ←

ONLY

8.0' (±.5) 4" ←

SCHOOL

9.5' (±.5) 4" ←

SIGNAL

8.5' (±.5) 4" ←

TURN

6.5' (±.5) 4" ←

LANE

6.5' (±.5) 4" ←

ENDS

7.5' (±.5) 4" ←

PED

5.5' (±.5) 4" ←

STOP

10.0' (±.5)

ZONE

6.5' (±.5) 4" ←

AHEAD

8.0' (±.5) 4" ←

RIGHT

8.5' (±.5) 4" ←

LEFT

6.5' (±.5) 4" ←

ROUTE

8.0' (±.5) 4" ←

X-ING

8.0' (±.5) 4" ←

1234567890

4" ←

MPH

6.0' (±.5) 4" ←

TEXAS

8.0' (±.5) 4" ←

STATE

8.0' (±.5) 4" ←

IH US

4" ← 8.0' (±.5) 4" ←

RECORD PLANS  
MARCH 28, 2008

STANDARD PLANS  
Texas Department of Transportation  
Traffic Operations Division

STANDARD  
PAVEMENT MARKINGS  
(WORDS)








PM(5) - 01

© TxDOT March 2001		DR--	CR-- GRB	SR-- FDN	CR-- CAL
REVISIONS	STATE DISTRICT	FEDERAL REGION	FEDERAL AID PROJECT		SHEET
	6				M206
	COUNTY	CONTROL	SECTION	JOB	HIGHWAY



DISCLAIMER  
The use of this standard is governed by the "Texas Engineering Practice Act". No warranty of any kind is made by TxDOT for any purpose whatsoever. TxDOT assumes no responsibility for the conversion of this standard to other formats or for incorrect results or damages resulting from its use.

LEVELS DISPLAYED  
1 2 3 4 5 6 7 8 9 10 11 12 13 14 15 16 17 18 19 20 21 22 23 24 25 26 27 28 29 30 31 32 33 34 35 36 37 38 39 40 41 42 43 44 45 46 47 48 49 50 51 52 53 54 55 56 57 58 59 60 61 62 63  
ACC:

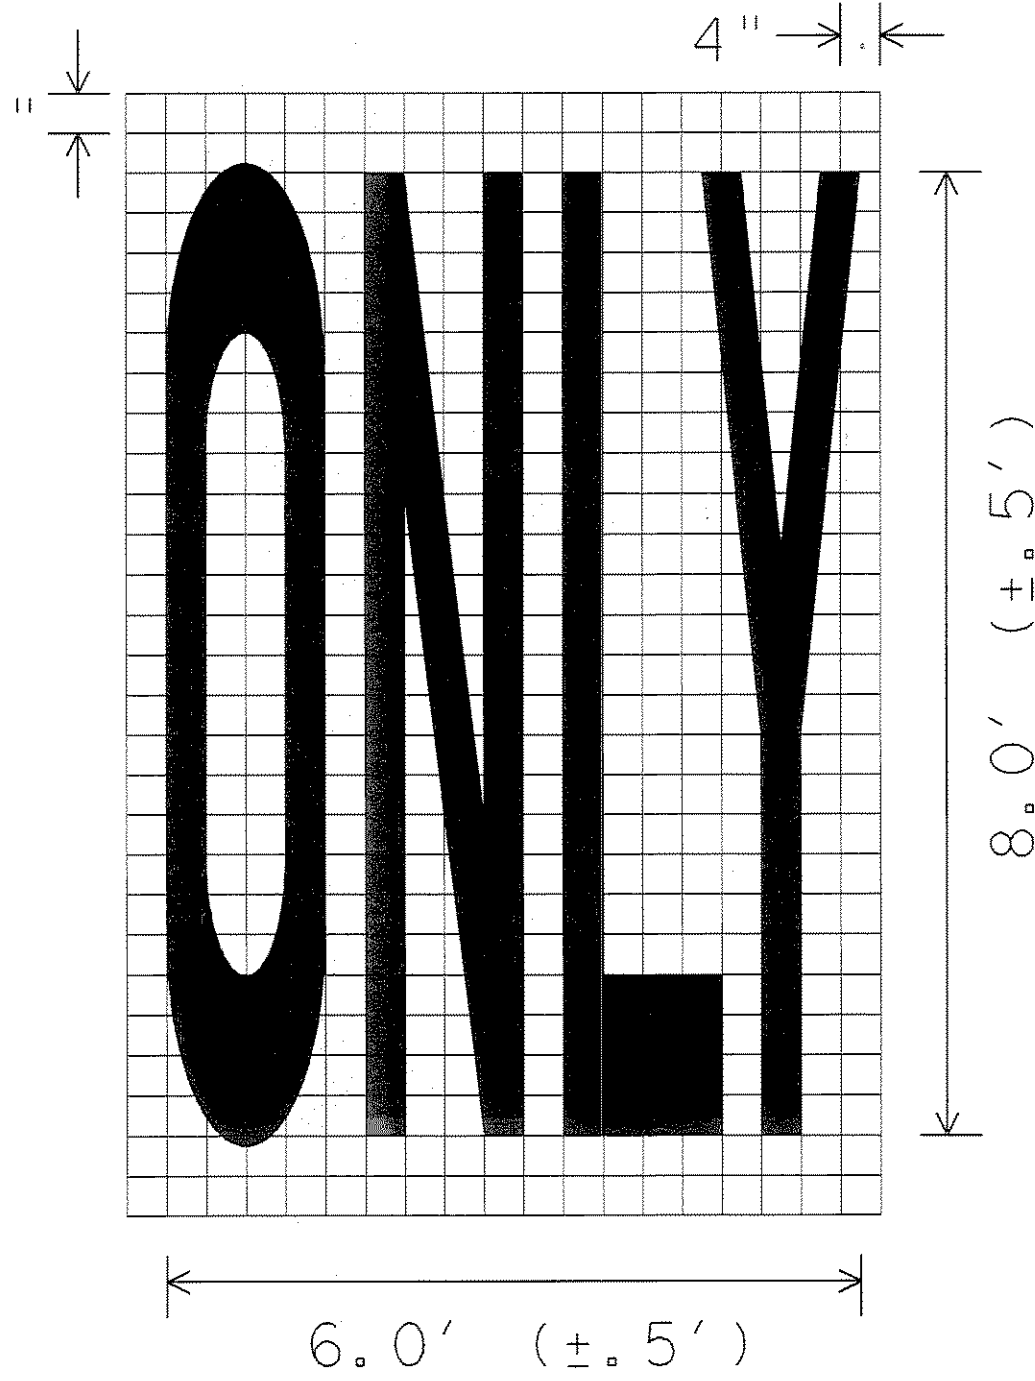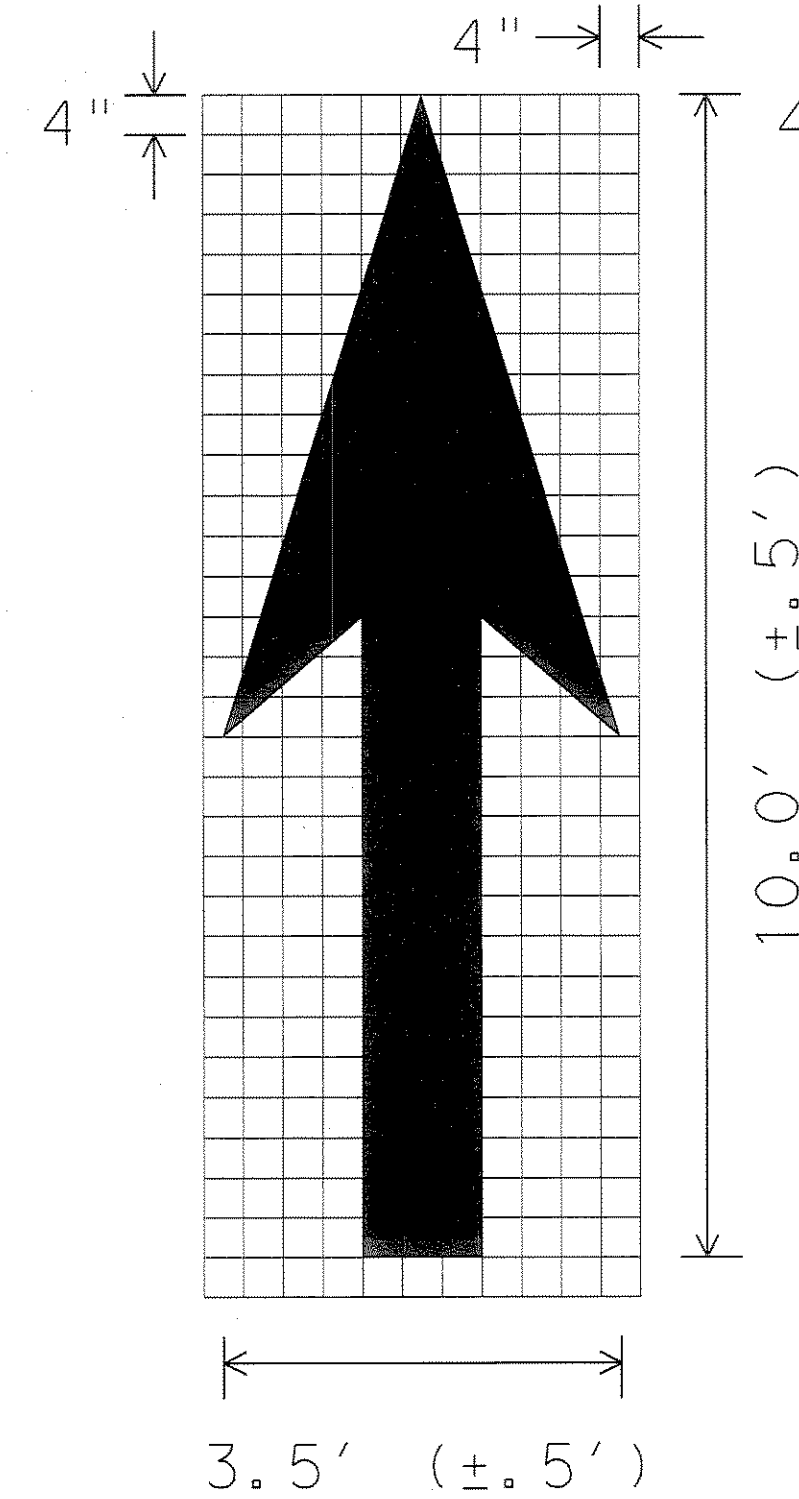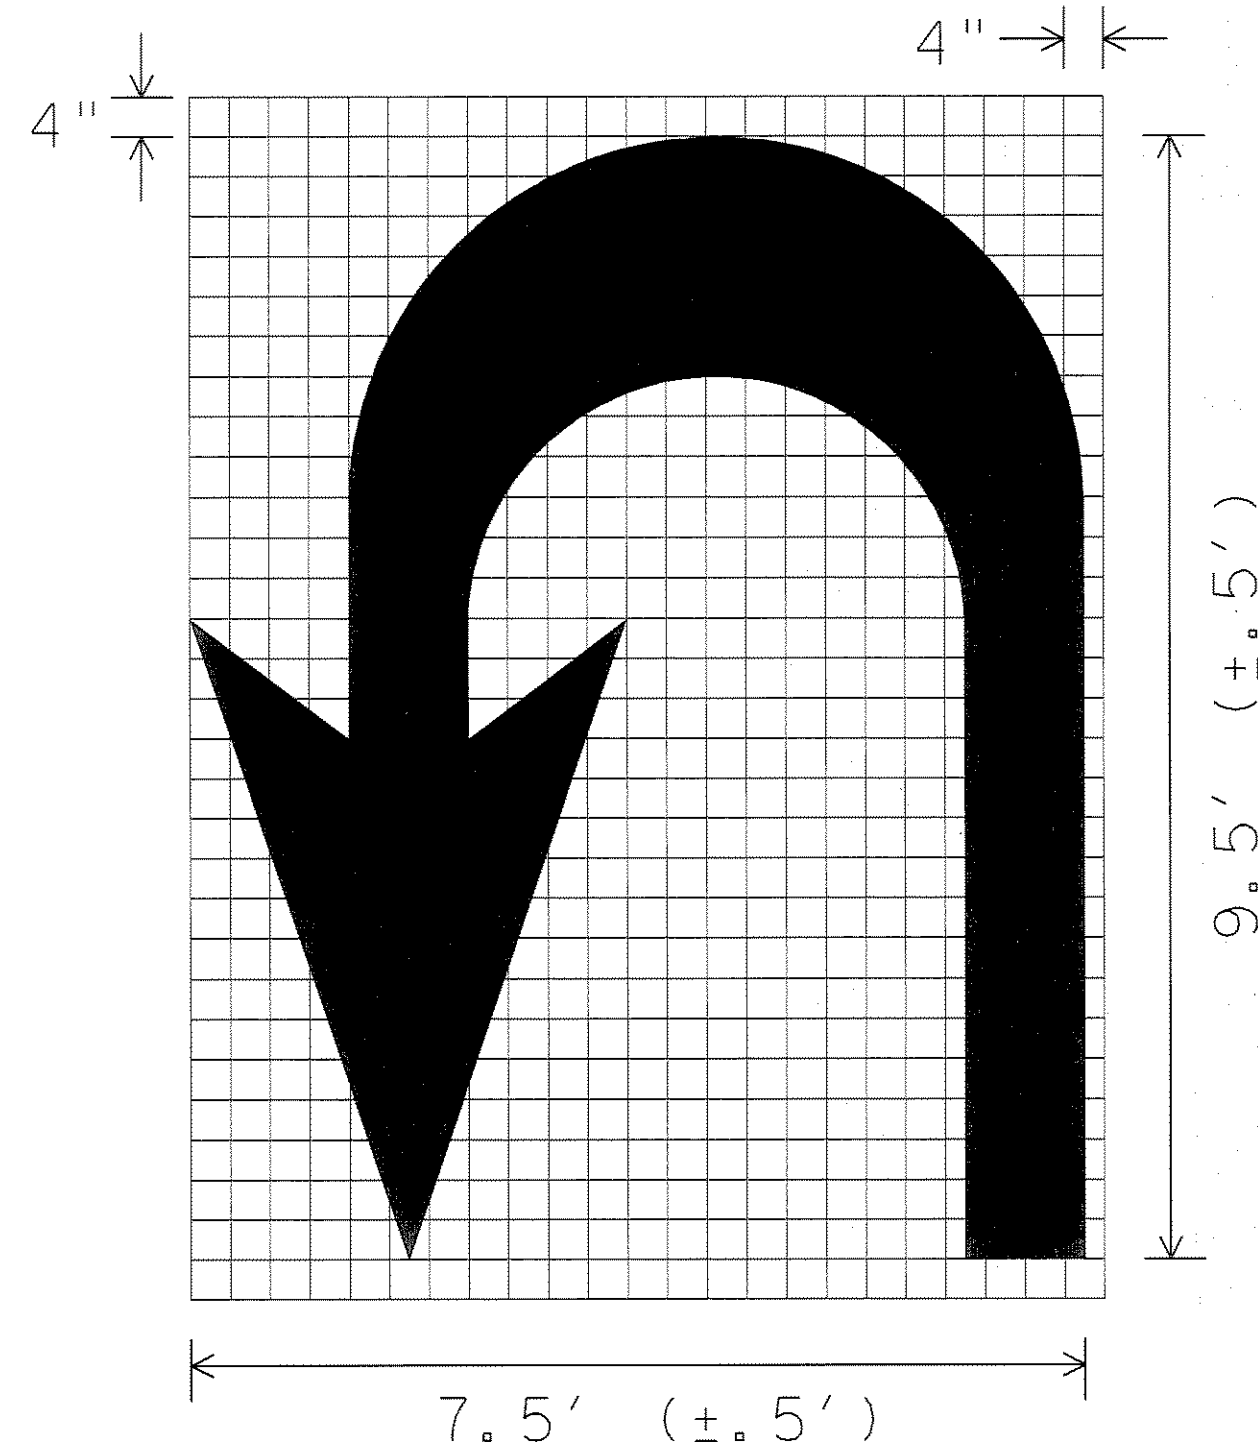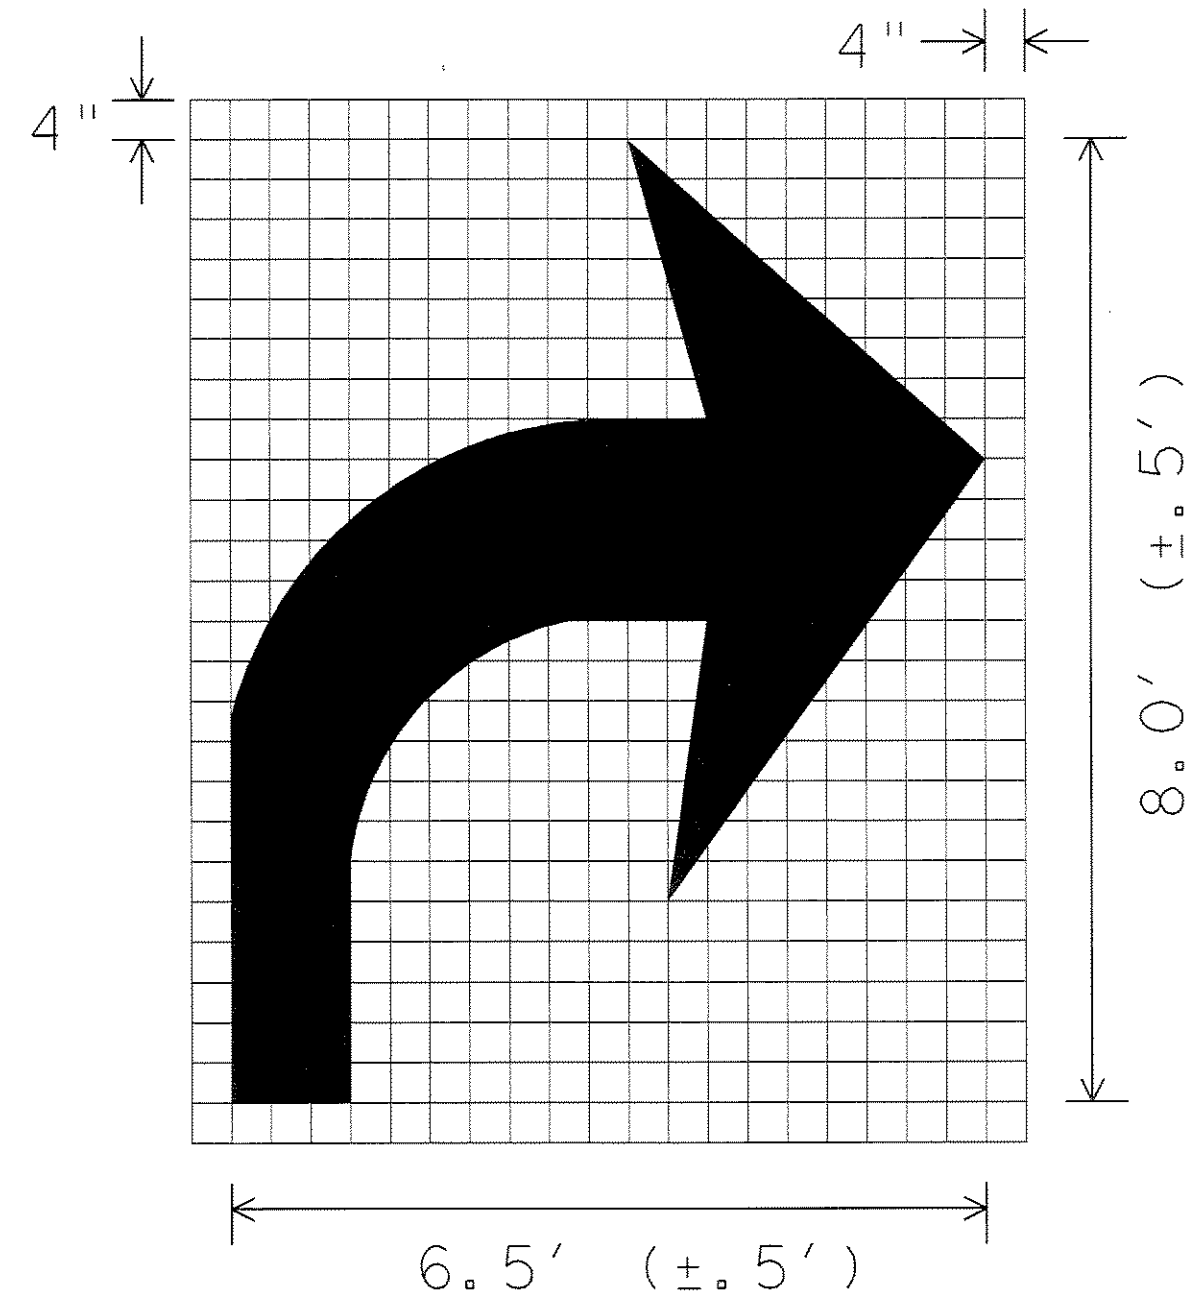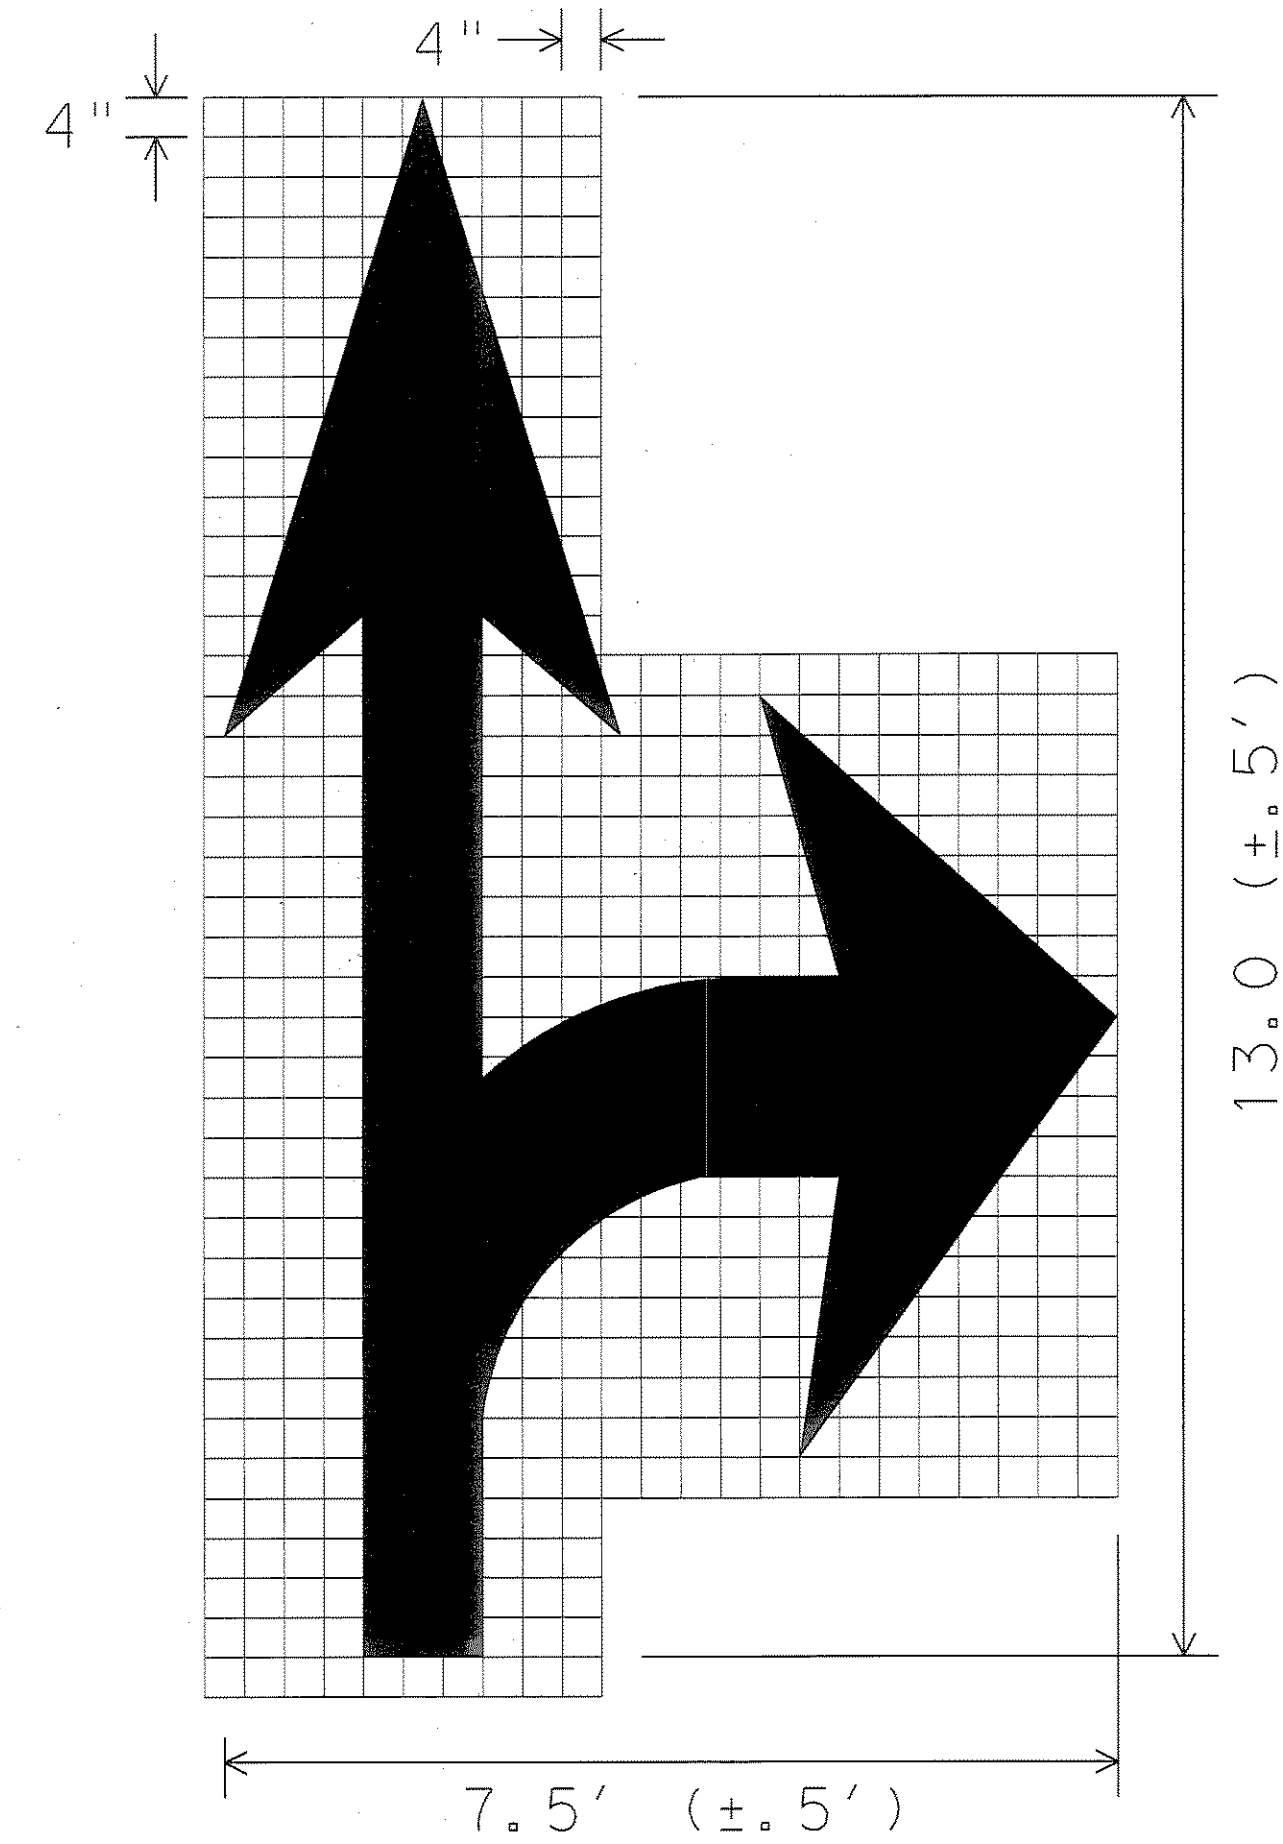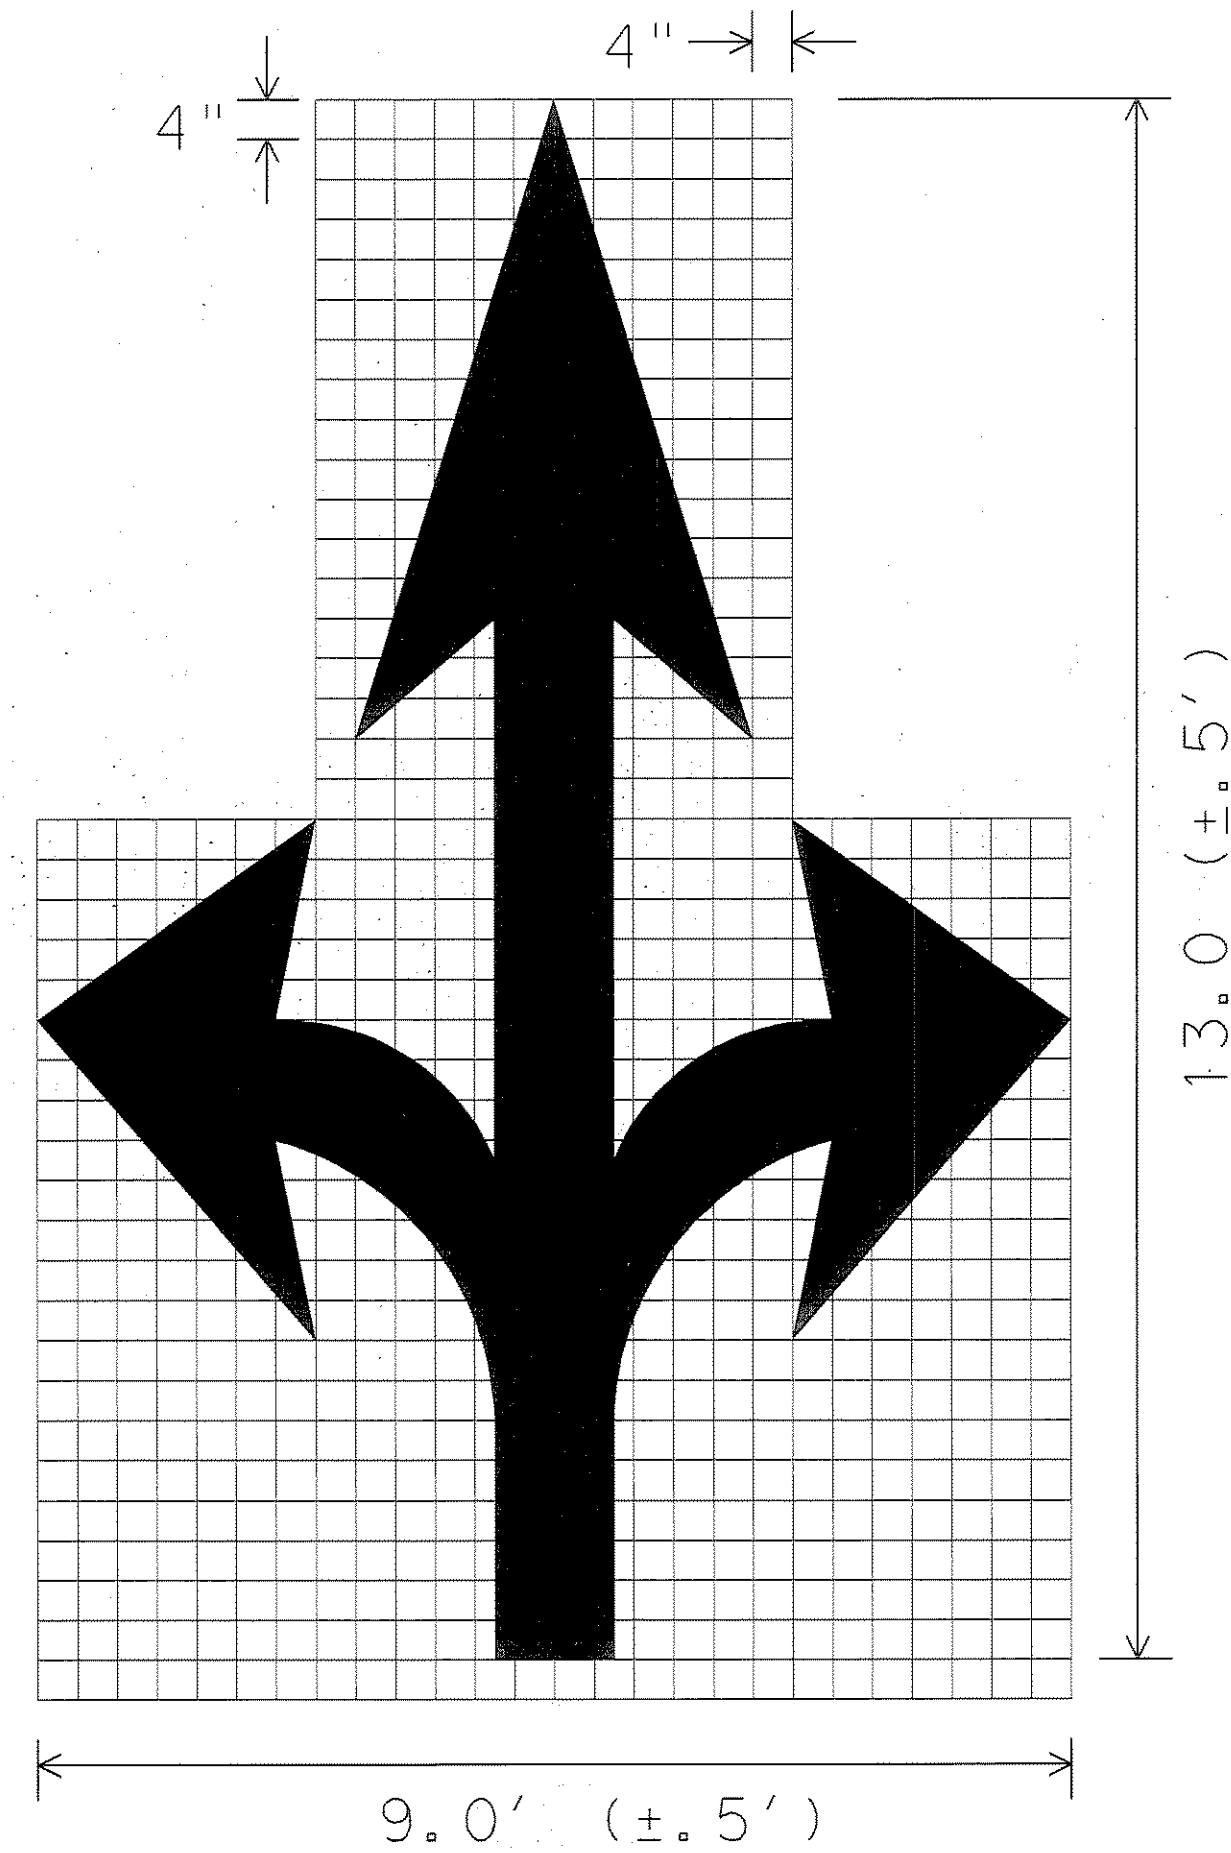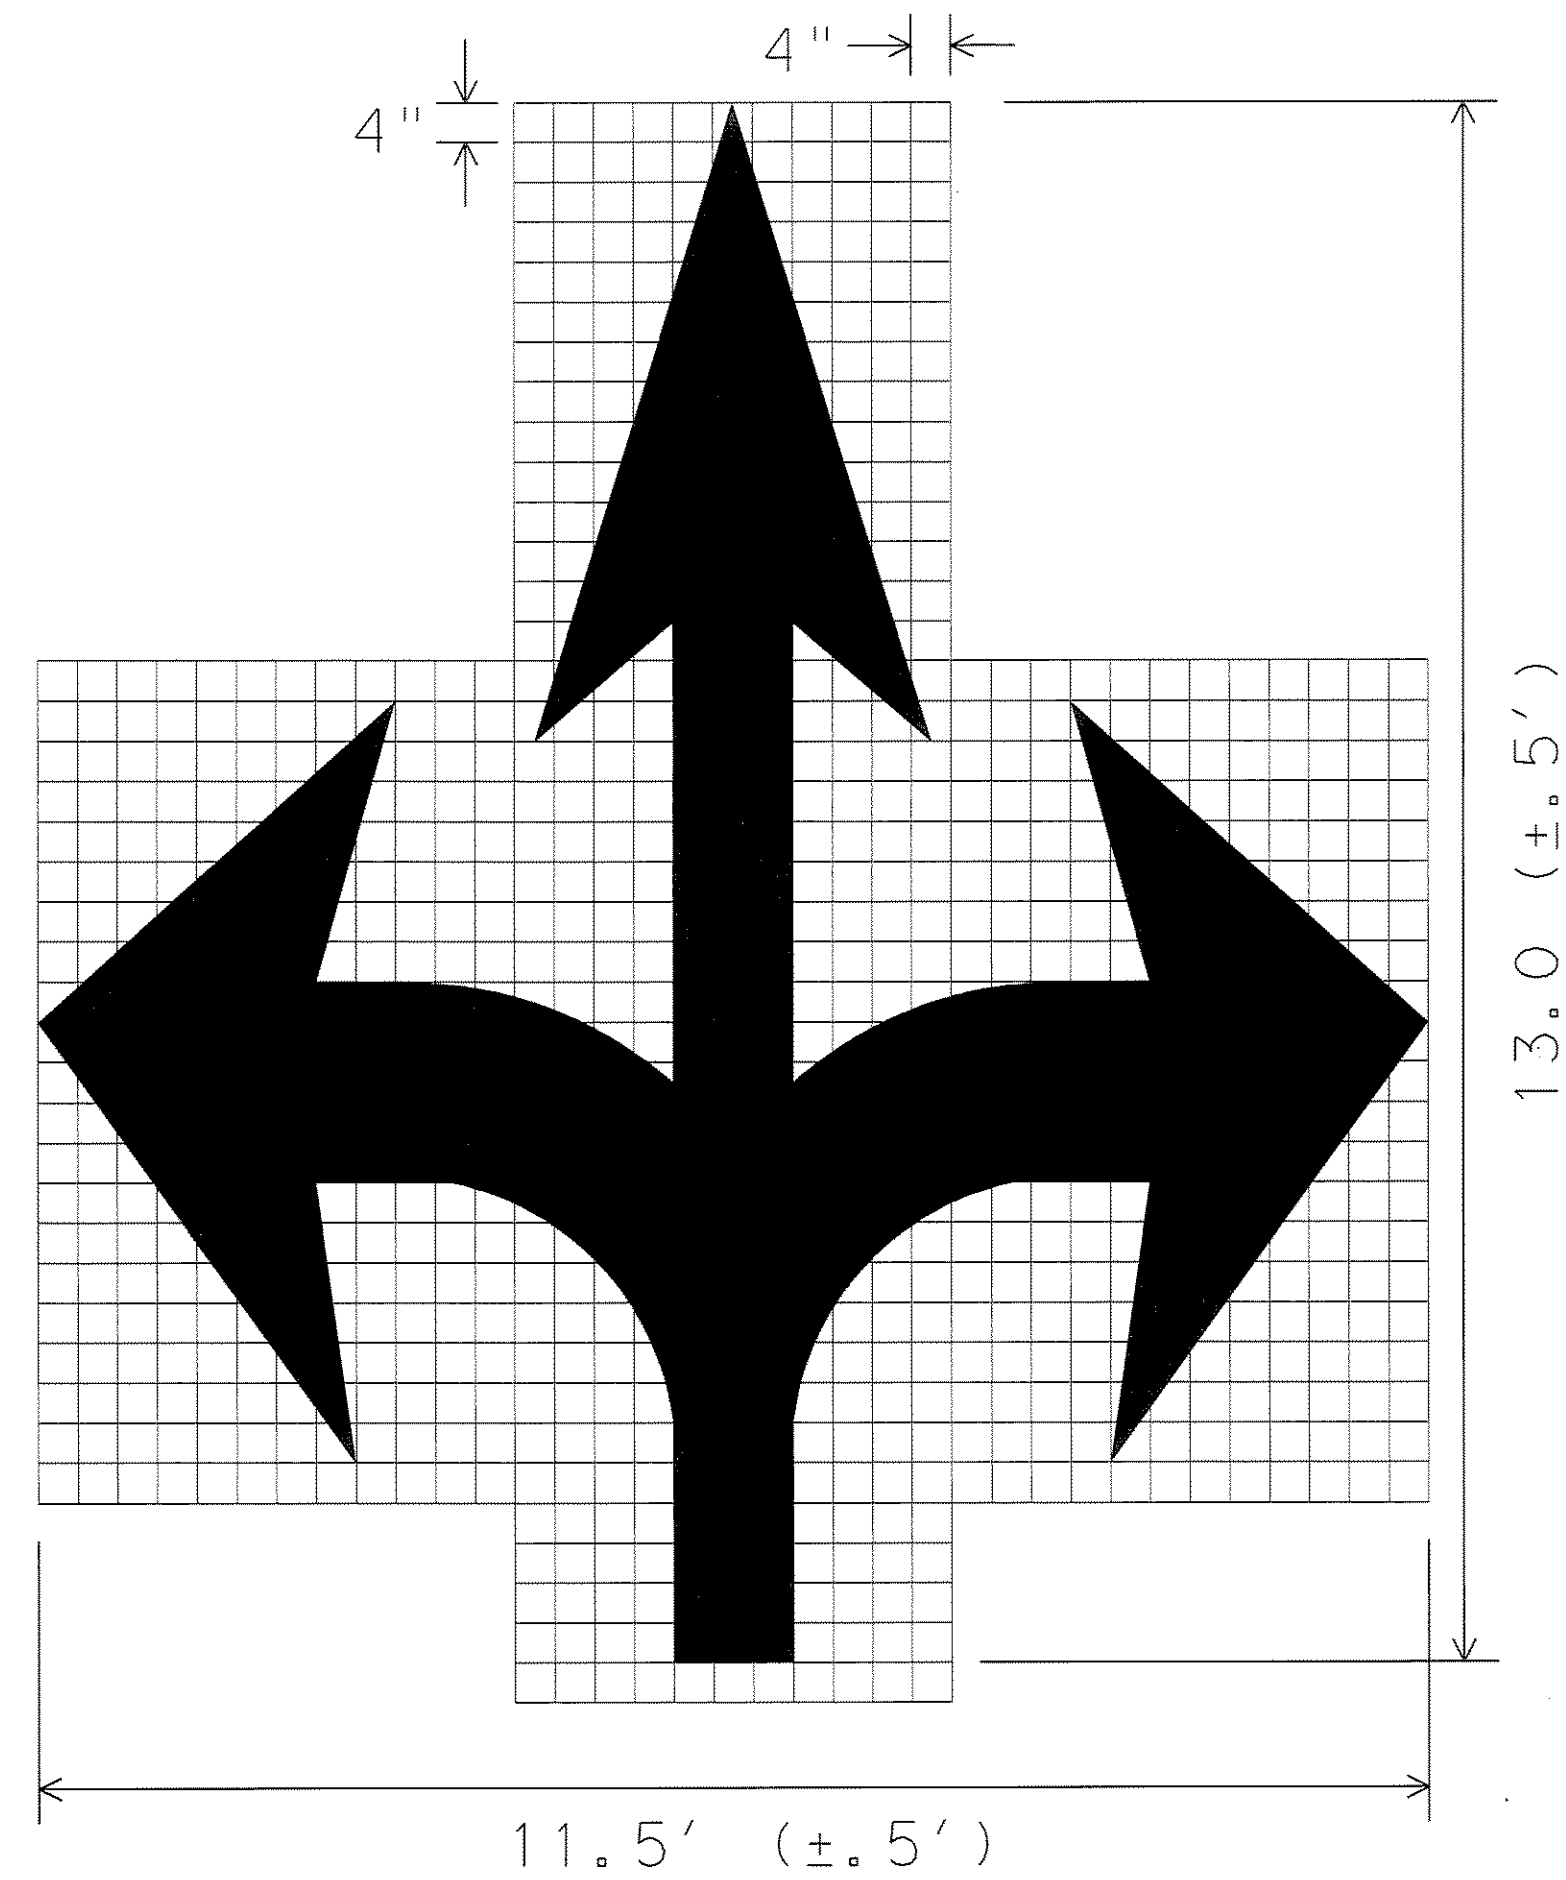

GENERAL NOTES:

- Minimum 8 foot white markings should be used, unless otherwise noted. If message consists of more than one word, it should be placed with first word nearest the driver.
- These details are standard size for normal installation; sizes may be reduced approximately one-third for low speed urban conditions; larger sizes may be needed for freeways, above average speed conditions or other critical locations.
- The longitudinal space between markings should be at least four times the height of the markings, on low speed roads, but should not exceed ten times the height under any condition.
- Markings considered appropriate for use when warranted include the following:
  - A. Regulatory
    - STOP
    - RIGHT (LEFT) TURN ONLY
    - 25 MPH
    - SYMBOL ARROWS
  - B. Warning
    - STOP AHEAD
    - SIGNAL AHEAD
    - SCHOOL
    - SCHOOL X-ING
    - PED X-ING
    - R X R (see RCPM standard)
  - C. Guide
    - US XXX
    - ROUTE XXX
    - STATE XXX
 Other words or symbols may be necessary under certain conditions
- Uncontrolled use of pavement markings can result in driver confusion. Word and symbol markings should be no more than three lines.
- The word "STOP" shall not be used on the pavement unless accompanied by a Stop line and Stop sign. The word "STOP" shall not be placed on the pavement in advance to a stop line, unless every vehicle is required to stop at all times.
- Pavement markings should generally be no more than one lane in width, with School messages being the exception. For details of School and School crossing pavement markings, refer to Part VII of the "Texas Manual on Uniform Traffic Control Devices".
- Spacing between letters should be approximately 4 inches. The width of letters may vary depending on the width of the travel lanes.
- Lane-Use arrow markings may be used to convey either guidance or mandatory messages. Arrows used to convey a mandatory movement must be accompanied by standard signs and the pavement marking word "ONLY".
- Pavement markings are to be located as specified elsewhere in the plans.

SPACING BETWEEN LINES OF PAVEMENT MARKINGS	
MPH	SPACING
≤ 45	MINIMUM 4 TIMES THE LETTER HEIGHT
> 45	MINIMUM - 4 TIMES THE LETTER HEIGHT MAXIMUM - 10 TIMES THE LETTER HEIGHT

STANDARD PLANS  
Texas Department of Transportation  
Traffic Operations Division


STANDARD  
PAVEMENT MARKINGS  
(ARROWS)

PM (6) - 01

RECORD PLANS  
MARCH 28, 2008

© TxDOT March 2001	REV-	CK- GRB	DN- FDN	CK- CAL
STATE DISTRICT	FEDERAL REGION	FEDERAL AID PROJECT		SHEET
6				M207
COUNTY	CONTROL	SECTION	JOB	HIGHWAY

TIME: 8:59 FILE: I:\04141-DAMAP-Phase1.dwg

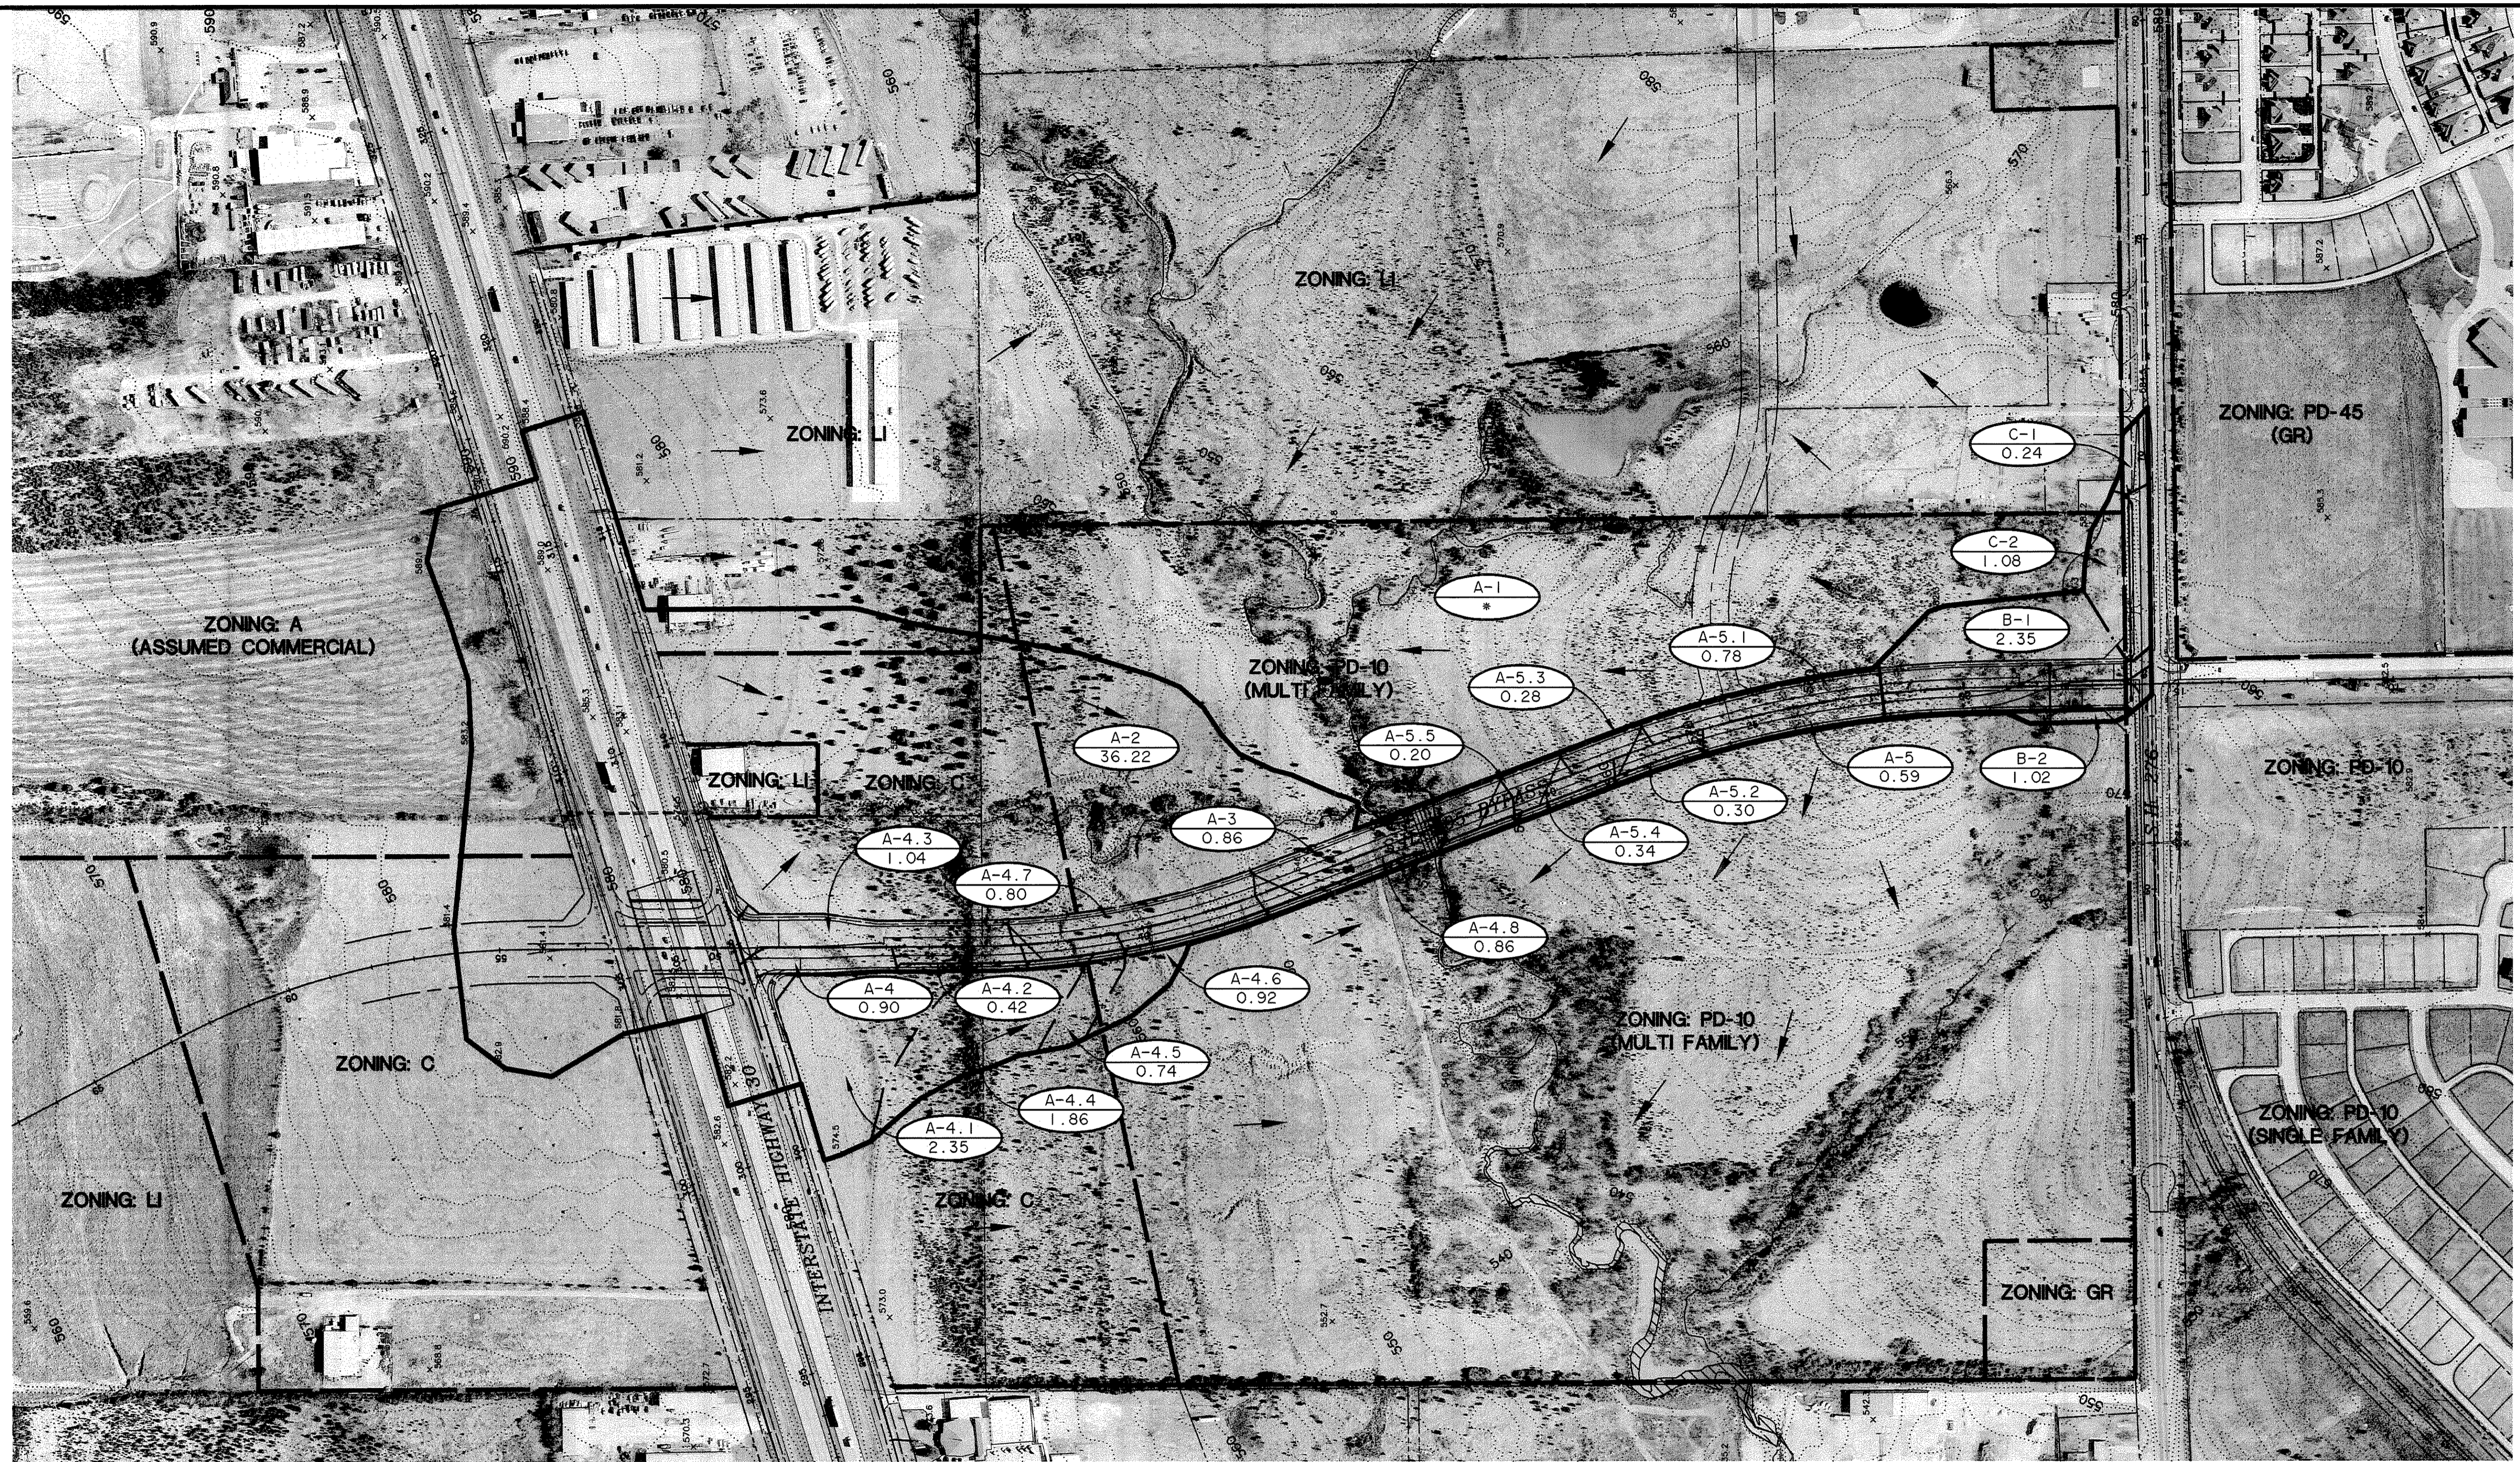


LEGEND

	DENOTES WATERSHED BOUNDARY		ZONING BOUNDARY LINE
	DENOTES MAJOR DRAINAGE AREA DIVIDE		EXISTING CONTOUR
	DENOTES MAJOR DRAINAGE AREA SUBDIVIDE		PROPOSED CONTOUR
	DRAINAGE AREA DESIGNATION DRAINAGE AREA ACRES		DESIGN POINT
	PROPOSED STORM DRAIN & INLET		

*A-1 REFER TO FLOOD STUDY PREPARED BY NATIONWIDE WATER RESOURCE SERVICES, INC. FOR DRAINAGE AREA A-1 Q₁₀₀ = 2841 cfs.


RECORD PLANS  
MARCH 28, 2008

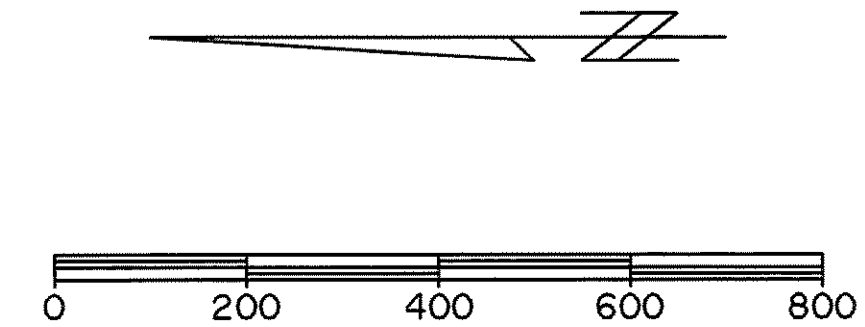

PREPARED BY:  
**VIA WIER & ASSOCIATES, INC.**  
ENGINEERS SURVEYORS LAND PLANNERS  
4300 BELTWAY PLACE SUITE 130 ARLINGTON, TEXAS 76018 METRO (817)467-7700  
1380 U.S. HIGHWAY 287 N. SUITE 101 MANFRIED, TEXAS 76063 METRO (817)477-8700  
6849 ELM STREET FRISCO, TEXAS 75034 METRO (214)387-8000  
www.wierassociates.com



S.H. No. 205 BYPASS  
I.H. Mo. 30 TO S.H. No. 276  
PHASE I  
DRAINAGE AREA MAP

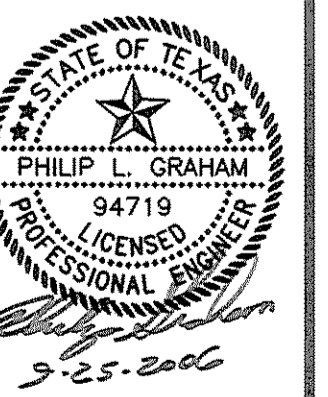

COPYRIGHT ©  
WIER & ASSOCIATES, INC.  
LAST SHEET EDIT  
DATE 08-31-2006  
WA# 04141  
SHEET NO.  
D101

DRAINAGE AREA CALCULATIONS

Drainage Area Designation	Total Area (Acres)	C 0.35 Parks, Open Space & Flood Plain	C 0.50 Single Family & Duplex Residential	C 0.70 School	C 0.75 Multi Family Residential	C 0.80 Townhouse / Churches	C 0.90 Industrial / Commercial / Mercantile Retail	C 0.90 Street Right-of-Way	C x A	tc (min.)	I (in./hr.) 10 Year Storm	I (in./hr.) 25 Year Storm	I (in./hr.) 100 Year Storm	Q (cfs) 10 Year Storm	Q (cfs) 25 Year Storm	Q (cfs) 100 Year Storm
A-1	653															2,841
A-2	36.22				6.21		18.49	11.52	31.67	13.9	6.65	7.51	9.11	210.6	237.8	288.5
A-3	0.86							0.86	0.77	10	7.24	8.15	9.80	5.6	6.3	7.5
A-4	0.90							0.90	0.81	10	7.24	8.15	9.80	5.9	6.6	7.9
A-4.1	2.35						2.35		2.12	10	7.24	8.15	9.80	15.3	17.3	20.8
A-4.2	0.42							0.42	0.38	10	7.24	8.15	9.80	2.8	3.1	3.7
A-4.3	1.04							1.04	0.94	10	7.24	8.15	9.80	6.8	7.7	9.2
A-4.4	1.86						1.86		1.67	10	7.24	8.15	9.80	12.1	13.6	16.4
A-4.5	0.74				0.13		0.30	0.31	0.65	10	7.24	8.15	9.80	4.7	5.3	6.4
A-4.6	0.92				0.43		0.02	0.47	0.76	10	7.24	8.15	9.80	5.5	6.2	7.4
A-4.7	0.80							0.80	0.72	10	7.24	8.15	9.80	5.2	5.9	7.1
A-4.8	0.86							0.86	0.77	10	7.24	8.15	9.80	5.6	6.3	7.5
A-5	0.59							0.59	0.53	10	7.24	8.15	9.80	3.8	4.3	5.2
A-5.1	0.78				0.01			0.77	0.70	10	7.24	8.15	9.80	5.1	5.7	6.9
A-5.2	0.30							0.30	0.27	10	7.24	8.15	9.80	2.0	2.2	2.6
A-5.3	0.28							0.28	0.25	10	7.24	8.15	9.80	1.8	2.0	2.5
A-5.4	0.34							0.34	0.31	10	7.24	8.15	9.80	2.2	2.5	3.0
A-5.5	0.20							0.20	0.18	10	7.24	8.15	9.80	1.3	1.5	1.8
B-1	2.35				1.49			0.86	1.89	10	7.24	8.15	9.80	13.7	15.4	18.5
B-2	1.02				0.12			0.90	0.90	10	7.24	8.15	9.80	6.5	7.3	8.8
C-1	0.24						0.02	0.22	0.22	10	7.24	8.15	9.80	1.6	1.8	2.2
C-2	1.08				0.50		0.04	0.54	0.90	10	7.24	8.15	9.80	6.5	7.3	8.8


NOTE: FOR DRAINAGE BASIN "A-1", REFER TO FLOOD STUDY PREPARED BY NATIONWIDE RESOURCE SERVICES, INC. Q100 FOR DRAINAGE BASIN "A-1" PER THIS STUDY = 2,841 cfs AT PROPOSED BOX CULVERT CROSSING LOCATION.

TIME OF CONCENTRATION CALCULATION DRAINAGE AREA "A-2"						
Drainage Area	Travel Distance (ft)	Average Slope (%)	Type Of Conveyance	Average Velocity (ft/sec)	Travel Time (min.)	Time Of Concn. (min.)
A-2	150	0.7	Paved Swale	2.5	1.0	13.9
	600	1.1	Earthen Swale	1.5	6.7	
	310	2.5	Enclosed Storm Drain System	11.4	0.5	
	270	1.5	Earthen Swale	1.8	2.5	
	1550	1.8	Earthen Ditch	8.2	3.2	


INLET DESIGN CALCULATIONS

Inlet No.	Discharges To	Design Storm Frequency (years)	Time Of Concn. (min.)	Rainfall Intensity (in./hr.)	Drainage Area (acres)	Drainage Area CA	Flow From Drainage Area (cfs)	Carry-Over (cfs)	Total Gutter Flow (cfs)	Gutter Slope (%)	Street Section	Cross-Slope Or Crown (ft/ft) OR (in.)	Depth Of Flow (ft)	Ponded Width (ft)	Inlet Length	Flow Collected	Carry-Over (cfs)	Remarks
INLET A-3	LINE A-3	100	10	9.8	0.86	0.77	7.5	4.4	11.9	-	TRIANGULAR	2.00%	0.41	-	15	11.9	0.0	FUTURE RECESSED CURB INLET
INLET A-4	LINE A-4	100	10	9.8	0.90	0.81	7.9	0.0	7.9	1.30	TRIANGULAR	2.00%	0.29	14.6	10	5.5	2.4	RECESSED CURB INLET
AREA A-4.1	LAT. A-4.1	100	10	9.8	2.35	2.12	20.8	0.0	20.8	-	TRIANGULAR	2.00%	0.40	-	N/A	20.8	0.0	FUTURE STORM DRAIN EXTENSION
INLET A-4.2	LAT. A-4.2	100	10	9.8	0.42	0.38	3.7	2.4	6.1	2.44	TRIANGULAR	2.00%	0.23	11.7	10	4.6	1.5	RECESSED CURB INLET
INLET A-4.3	LAT. A-4.3	100	10	9.8	1.04	0.94	9.2	0.0	9.2	2.44	TRIANGULAR	2.00%	0.27	13.7	10	5.4	3.8	FUTURE RECESSED CURB INLET
INLET A-4.4	LAT. A-4.4	100	10	9.8	1.86	1.67	16.4	0.0	16.4	-	TRIANGULAR	2.00%	0.37	-	16	16.4	0.0	TEMP. DROP INLET FUTURE STORM DRAIN EXTENSION
INLET A-4.5	LAT. A-4.5	100	10	9.8	0.74	0.65	6.4	1.5	7.9	2.44	TRIANGULAR	2.00%	0.26	13.0	10	5.2	2.7	RECESSED CURB INLET
INLET A-4.6	LAT. A-4.6	100	10	9.8	0.92	0.76	7.4	2.7	10.1	1.00	TRIANGULAR	2.00%	0.33	16.7	10	6.4	3.7	RECESSED CURB INLET
INLET A-4.7	LAT. A-4.7	100	10	9.8	0.80	0.72	7.1	3.8	10.9	1.00	TRIANGULAR	2.00%	0.34	17.2	10	6.5	4.4	FUTURE RECESSED CURB INLET
INLET A-4.8	LAT. A-4.8	100	10	9.8	0.86	0.77	7.5	3.7	11.2	-	TRIANGULAR	2.00%	0.40	-	15	11.2	0.0	RECESSED CURB INLET
INLET A-5	LINE A-5	100	10	9.8	0.59	0.53	5.2	0.0	5.2	3.74	TRIANGULAR	2.00%	0.20	10.2	10	4.2	1.0	RECESSED CURB INLET
INLET A-5.1	LAT. A-5.1	100	10	9.8	0.78	0.70	6.9	0.0	6.9	4.28	TRIANGULAR	2.00%	0.22	11.1	10	4.6	2.3	FUTURE RECESSED CURB INLET
INLET A-5.2	LAT. A-5.2	100	10	9.8	0.30	0.27	2.6	1.0	3.6	4.28	TRIANGULAR	2.00%	0.17	8.7	10	3.5	0.1	RECESSED CURB INLET
INLET A-5.3	LAT. A-5.3	100	10	9.8	0.28	0.25	2.5	2.3	4.8	4.28	TRIANGULAR	2.00%	0.19	8.6	10	4.0	0.8	FUTURE RECESSED CURB INLET
INLET A-5.4	LAT. A-5.4	100	10	9.8	0.34	0.31	3.0	0.1	3.1	2.72	TRIANGULAR	2.00%	0.18	8.9	10	3.1	0.0	RECESSED CURB INLET
INLET A-5.5	LAT. A-5.5	100	10	9.8	0.20	0.18	1.8	0.8	2.6	2.72	TRIANGULAR	2.00%	0.17	8.3	10	2.6	0.0	FUTURE RECESSED CURB INLET
INLET B-1	LINE B	100	10	9.8	2.35	1.89	18.5	0.0	18.5	-	TRIANGULAR	2.00%	0.48	-	15	18.5	0.0	RECESSED CURB INLET
INLET B-2	LAT. B-2	100	10	9.8	1.02	0.90	8.8	0.0	8.8	-	TRIANGULAR	2.00%	0.36	-	10	8.8	0.0	RECESSED CURB INLET
INLET C-1	LINE C	100	10	9.80	0.24	0.22	2.2	0.0	2.2	1.00	SWALE	12" INVERT	0.50	6.0	3.5x5'	2.2	0.0	TxDOT TYPE H HORIZONTAL GRATE INLET
INLET C-2	LINE C	100	10	9.80	1.08	0.90	8.8	0.0	8.8	1.00	SWALE	12" INVERT	0.90	11.0	3'x3'	8.8	0.0	TxDOT TYPE H HORIZONTAL GRATE INLET

PREPARED BY:  
**WIER & ASSOCIATES, INC.**  
 ENGINEERS SURVEYORS LAND PLANNERS  
 4300 BELTWAY PLACE SUITE 130 ARLINGTON, TEXAS 76018 METRO (817)467-7700  
 1380 U.S. HIGHWAY 287 N. SUITE 101 WANSFELD, TEXAS 76063 METRO (817)477-8700  
 6846 ELM STREET FRSICO, TEXAS 75034 METRO (214)387-8000  
 www.wierassociates.com

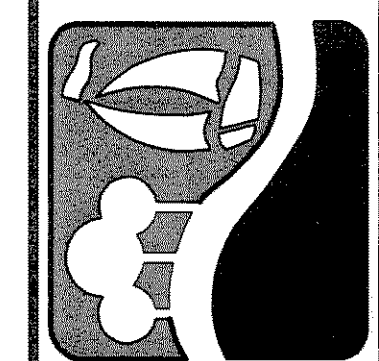

PHASE I SH. 205 BYPASS  
 FROM SH. 276 TO INTERSTATE 30  
**DRAINAGE AREA &  
 INLET DESIGN CALCULATIONS**

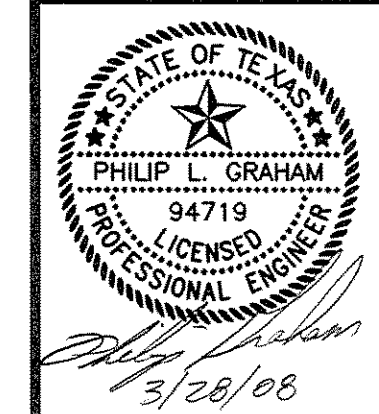


RECORD PLANS  
 MARCH 28, 2008

COPYRIGHT ©  
 WIER & ASSOCIATES, INC.  
 LAST SHEET EDIT  
 DATE 11-30-2006  
 WA# 04141  
**SHEET NO.  
 D102**


STORM DRAIN DESIGN CALCULATIONS

FROM	REACH TO	INFLOW (INLETS & HEADWALLS)				TOTAL 'CA'	TIME AT UPSTREAM OF REACH (min)	DESIGN STORM FREQUENCY (yr)	RAINFALL INTENSITY 'I' (in/hr)	TOTAL FLOW 'Q' (cfs)	STORM DRAIN SIZE	VELOCITY (ft/sec)	SLOPE OF FRICTION GRADIENT (ft/ft)	STRUCTURE LOSS COEFF. 'K'	STRUCTURE LOSS AT UPSTREAM OF REACH (ft)	FLOW TIME IN DRAIN (min)	TIME AT DOWNSTREAM OF REACH (min)	H.G. AT UPSTREAM OF REACH (ft)	REMARKS
		LENGTH (ft)	SOURCE	'CA'	INLET TIME (min)														
SYSTEM "A"																			
1+94.41	1+70.83	23.58		289.90	10.0	289.90	10.0	100	9.80	2841.0	9x9	8.8	0.0020	0.00	0.00	0.0	10.0	544.67	
INLET A-3	1+70.83	54.85		1.21	10.0	1.21	10.0	100	9.80	11.9	21	4.9	0.0056	1.25	0.48	0.2	10.2	545.41	
1+70.83	0+91.06	76.77	-	-	-	291.11	10.2	100	9.77	2844.1	9x9	8.8	0.0020	0.00	0.00	0.1	10.3	544.63	
INLET A-4	13+55.71	16.26		0.56	10.0	0.56	10.0	100	9.80	5.5	18	3.1	0.0027	1.25	0.19	0.0	10.0	565.94	
13+55.71	11+76.18	179.53	-	-	-	0.56	10.0	100	9.80	5.5	18	3.1	0.0027	0.50	0.08	0.3	10.3	565.55	
AREA A-4.1	11+76.18	29.73		2.12	10.0	2.12	10.0	100	9.80	20.8	24	6.6	0.0085	0.00	0.00	0.0	10.0	561.82	FUTURE STORM DRAIN EXTENSION
11+76.18	10+53.31	122.87	-	-	-	2.68	10.3	100	9.76	26.2	27	6.6	0.0072	0.30	0.63	0.2	10.5	561.33	
INLET A-4.2	10+53.31	16.31		0.47	10.0	0.47	10.0	100	9.80	4.6	18	2.6	0.0019	1.25	0.13	0.1	10.1	559.49	
10+53.31	10+24.54	28.77	-	-	-	3.15	10.5	100	9.73	30.6	27	7.7	0.0098	0.30	0.72	0.1	10.6	559.33	
INLET A-4.3	10+24.54	119.54		0.55	10.0	0.55	10.0	100	9.80	5.4	18	3.1	0.0026	1.25	0.18	0.2	10.2	560.69	
10+24.54	9+08.24	116.3	-	-	-	3.70	10.6	100	9.71	35.9	27	9.0	0.0134	0.30	0.98	0.2	10.8	558.33	
INLET A-4.4	9+08.24	42.68		1.67	10.0	1.67	10.0	100	9.80	16.4	24	5.2	0.0053	1.25	0.53	0.0	10.0	557.46	
9+08.24	8+23.81	84.43	-	-	-	5.37	10.8	100	9.68	52.0	30	10.6	0.0161	0.30	1.37	0.1	10.9	555.79	
INLET A-4.5	8+23.81	16.31		0.53	10.0	0.53	10.0	100	9.80	5.2	18	2.9	0.0025	1.25	0.17	0.1	10.1	553.27	
8+23.81	4+82.11	341.7	-	-	-	5.90	10.9	100	9.67	57.1	33	9.6	0.0117	0.30	0.91	0.6	11.5	553.06	
INLET A-4.6	4+82.11	16.31		0.65	10.0	0.65	10.0	100	9.80	6.4	18	3.6	0.0037	1.25	0.25	0.1	10.1	548.47	
4+82.11	4+03.46	78.65	-	-	-	6.55	11.5	100	9.57	62.7	36	8.9	0.0088	0.30	0.80	0.1	11.6	548.15	
INLET A-4.7	4+03.46	126.64		0.66	10.0	0.66	10.0	100	9.80	6.5	18	3.7	0.0038	1.25	0.26	0.6	10.6	547.41	
4+03.46	1+75	228.46	-	-	-	7.21	11.6	100	9.56	68.9	42	7.2	0.0047	0.30	0.44	0.5	12.1	546.66	
1+75	1+46.87	28.13	-	-	-	7.21	12.1	100	9.49	68.4	42	7.1	0.0046	0.00	0.00	0.1	12.2	545.15	
INLET A-4.8	1+46.87	16.26		1.14	10.0	1.14	10.0	100	9.80	11.2	24	3.6	0.0025	1.25	0.25	0.1	10.1	545.31	
1+46.87	0+91.06	55.81	-	-	-	8.35	12.2	100	9.47	79.1	48	6.3	0.0030	0.30	0.38	0.1	12.3	545.02	
INLET A-5	7+35.89	16.23		0.43	10.0	0.43	10.0	100	9.80	4.2	18	2.4	0.0016	1.25	0.11	0.0	10.0	566.08	
7+35.89	5+38.11	197.78	-	-	-	0.43	10.0	100	9.80	4.2	18	2.4	0.0016	0.50	0.04	0.3	10.3	565.41	
INLET A-5.1	5+38.11	128.85		0.47	10.0	0.47	10.0	100	9.80	4.6	18	2.6	0.0019	1.25	0.13	0.2	10.2	561.15	
5+38.11	5+18.87	19.24	-	-	-	0.90	10.3	100	9.76	8.8	18	5.0	0.0070	0.30	0.36	0.1	10.4	557.50	
INLET A-5.2	5+18.87	16.26		0.36	10.0	0.36	10.0	100	9.80	3.5	18	2.0	0.0011	1.25	0.08	0.1	10.1	557.10	
5+18.87	3+40.87	178	-	-	-	1.26	10.4	100	9.74	12.3	18	7.0	0.0137	0.30	0.64	0.2	10.6	557.00	
INLET A-5.3	3+40.87	126.57		0.41	10.0	0.41	10.0	100	9.80	4.0	18	2.3	0.0015	1.25	0.10	0.3	10.3	552.56	
3+40.87	2+68.87	72	-	-	-	1.67	10.6	100	9.71	16.2	18	9.2	0.0238	0.30	1.09	0.1	10.7	550.79	
INLET A-5.4	2+68.87	16.26		0.32	10.0	0.32	10.0	100	9.80	3.1	18	1.8	0.0009	1.25	0.06	0.0	10.0	547.84	
2+68.87	1+90.87	78	-	-	-	1.99	10.7	100	9.70	19.3	24	6.1	0.0073	0.30	0.18	0.1	10.8	547.58	
INLET A-5.5	1+90.87	126.57		0.27	10.0	0.27	10.0	100	9.80	2.6	18	1.5	0.0006	1.25	0.04	0.3	10.3	547.32	
1+90.87	0+91.06	92.9	-	-	-	2.26	10.8	100	9.68	21.9	24	7.0	0.0094	0.30	0.59	0.2	11.0	545.93	
0+91.06	0+74.41	16.65	-	-	-	301.72	12.3	100	9.46	2854.3	9x9	8.8	0.0020	0.00	0.00	0.0	12.3	544.47	
SYSTEM "B"																			
INLET B-1	2+30.00	117.50		1.89	10.0	1.89	10.0	100	9.80	18.5	24	5.9	0.0067	1.25	0.67	0.3	10.3	575.19	
INLET B-2	2+30.00	88.63		0.90	10.0	0.90	10.0	100	9.80	8.8	21	3.7	0.0031	1.25	0.26	0.4	10.4	574.25	
2+30.00	2+05.00	25.00	-	-	-	2.79	10.4	100	9.74	27.2	30	5.5	0.0044	0.50	0.20	0.1	10.5	573.72	
SYSTEM "C"																			
INLET C-1	INLET C-2	370.00		0.22	10.0	0.22	10.0	100	9.80	2.2	18	1.2	0.0004	1.25	0.03	1.3	11.3	580.88	
INLET C-2	1+46.00	104.00		0.90	10.0	1.12	11.3	100	9.60	10.8	18	6.1	0.0106	0.50	0.57	0.3	11.6	578.16	

PREPARED BY:  
**WIA WIER & ASSOCIATES, INC.**  
**ENGINEERS SURVEYORS LAND PLANNERS**  
 4300 BELTWAY PLACE SUITE 130 ARLINGTON, TEXAS 76018 METRO (817)467-7700  
 1380 U.S. HIGHWAY 287 N. SUITE 101 MARSHFIELD, TEXAS 76663 METRO (817)477-8700  
 6849 ELM STREET FRISCO, TEXAS 75004 METRO (214)957-9000  
 www.WierAssociates.com

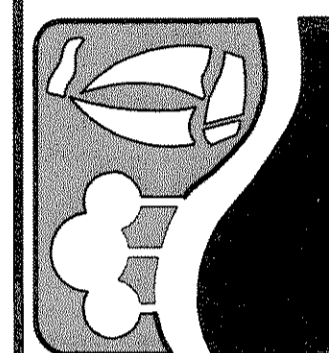

PHASE I S.H. 205 BYPASS  
 FROM S.H. 276 TO INTERSTATE 30  
**STORM DRAIN  
 DESIGN CALCULATIONS**

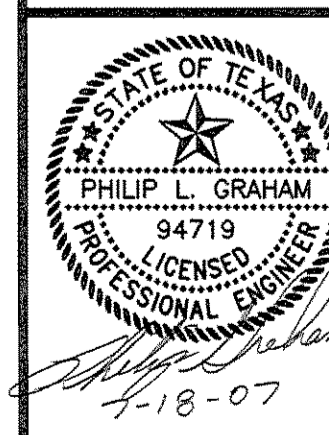


COPYRIGHT ©  
 WIER & ASSOCIATES, INC.  
 LAST SHEET EDIT  
 DATE 07-18-2007  
 WA# 04141  
**SHEET NO.  
 D103**

RECORD PLANS  
 MARCH 28, 2008

NO.	DATE	DESCRIPTION	BY
	10/31/07	REVISED HEADWALL TOP ELEV	PLG


THE CAMBRIDGE COMPANIES, INC. TRUSTEE  
VOL. 99, PG. 1022  
D.R.R.C.T.

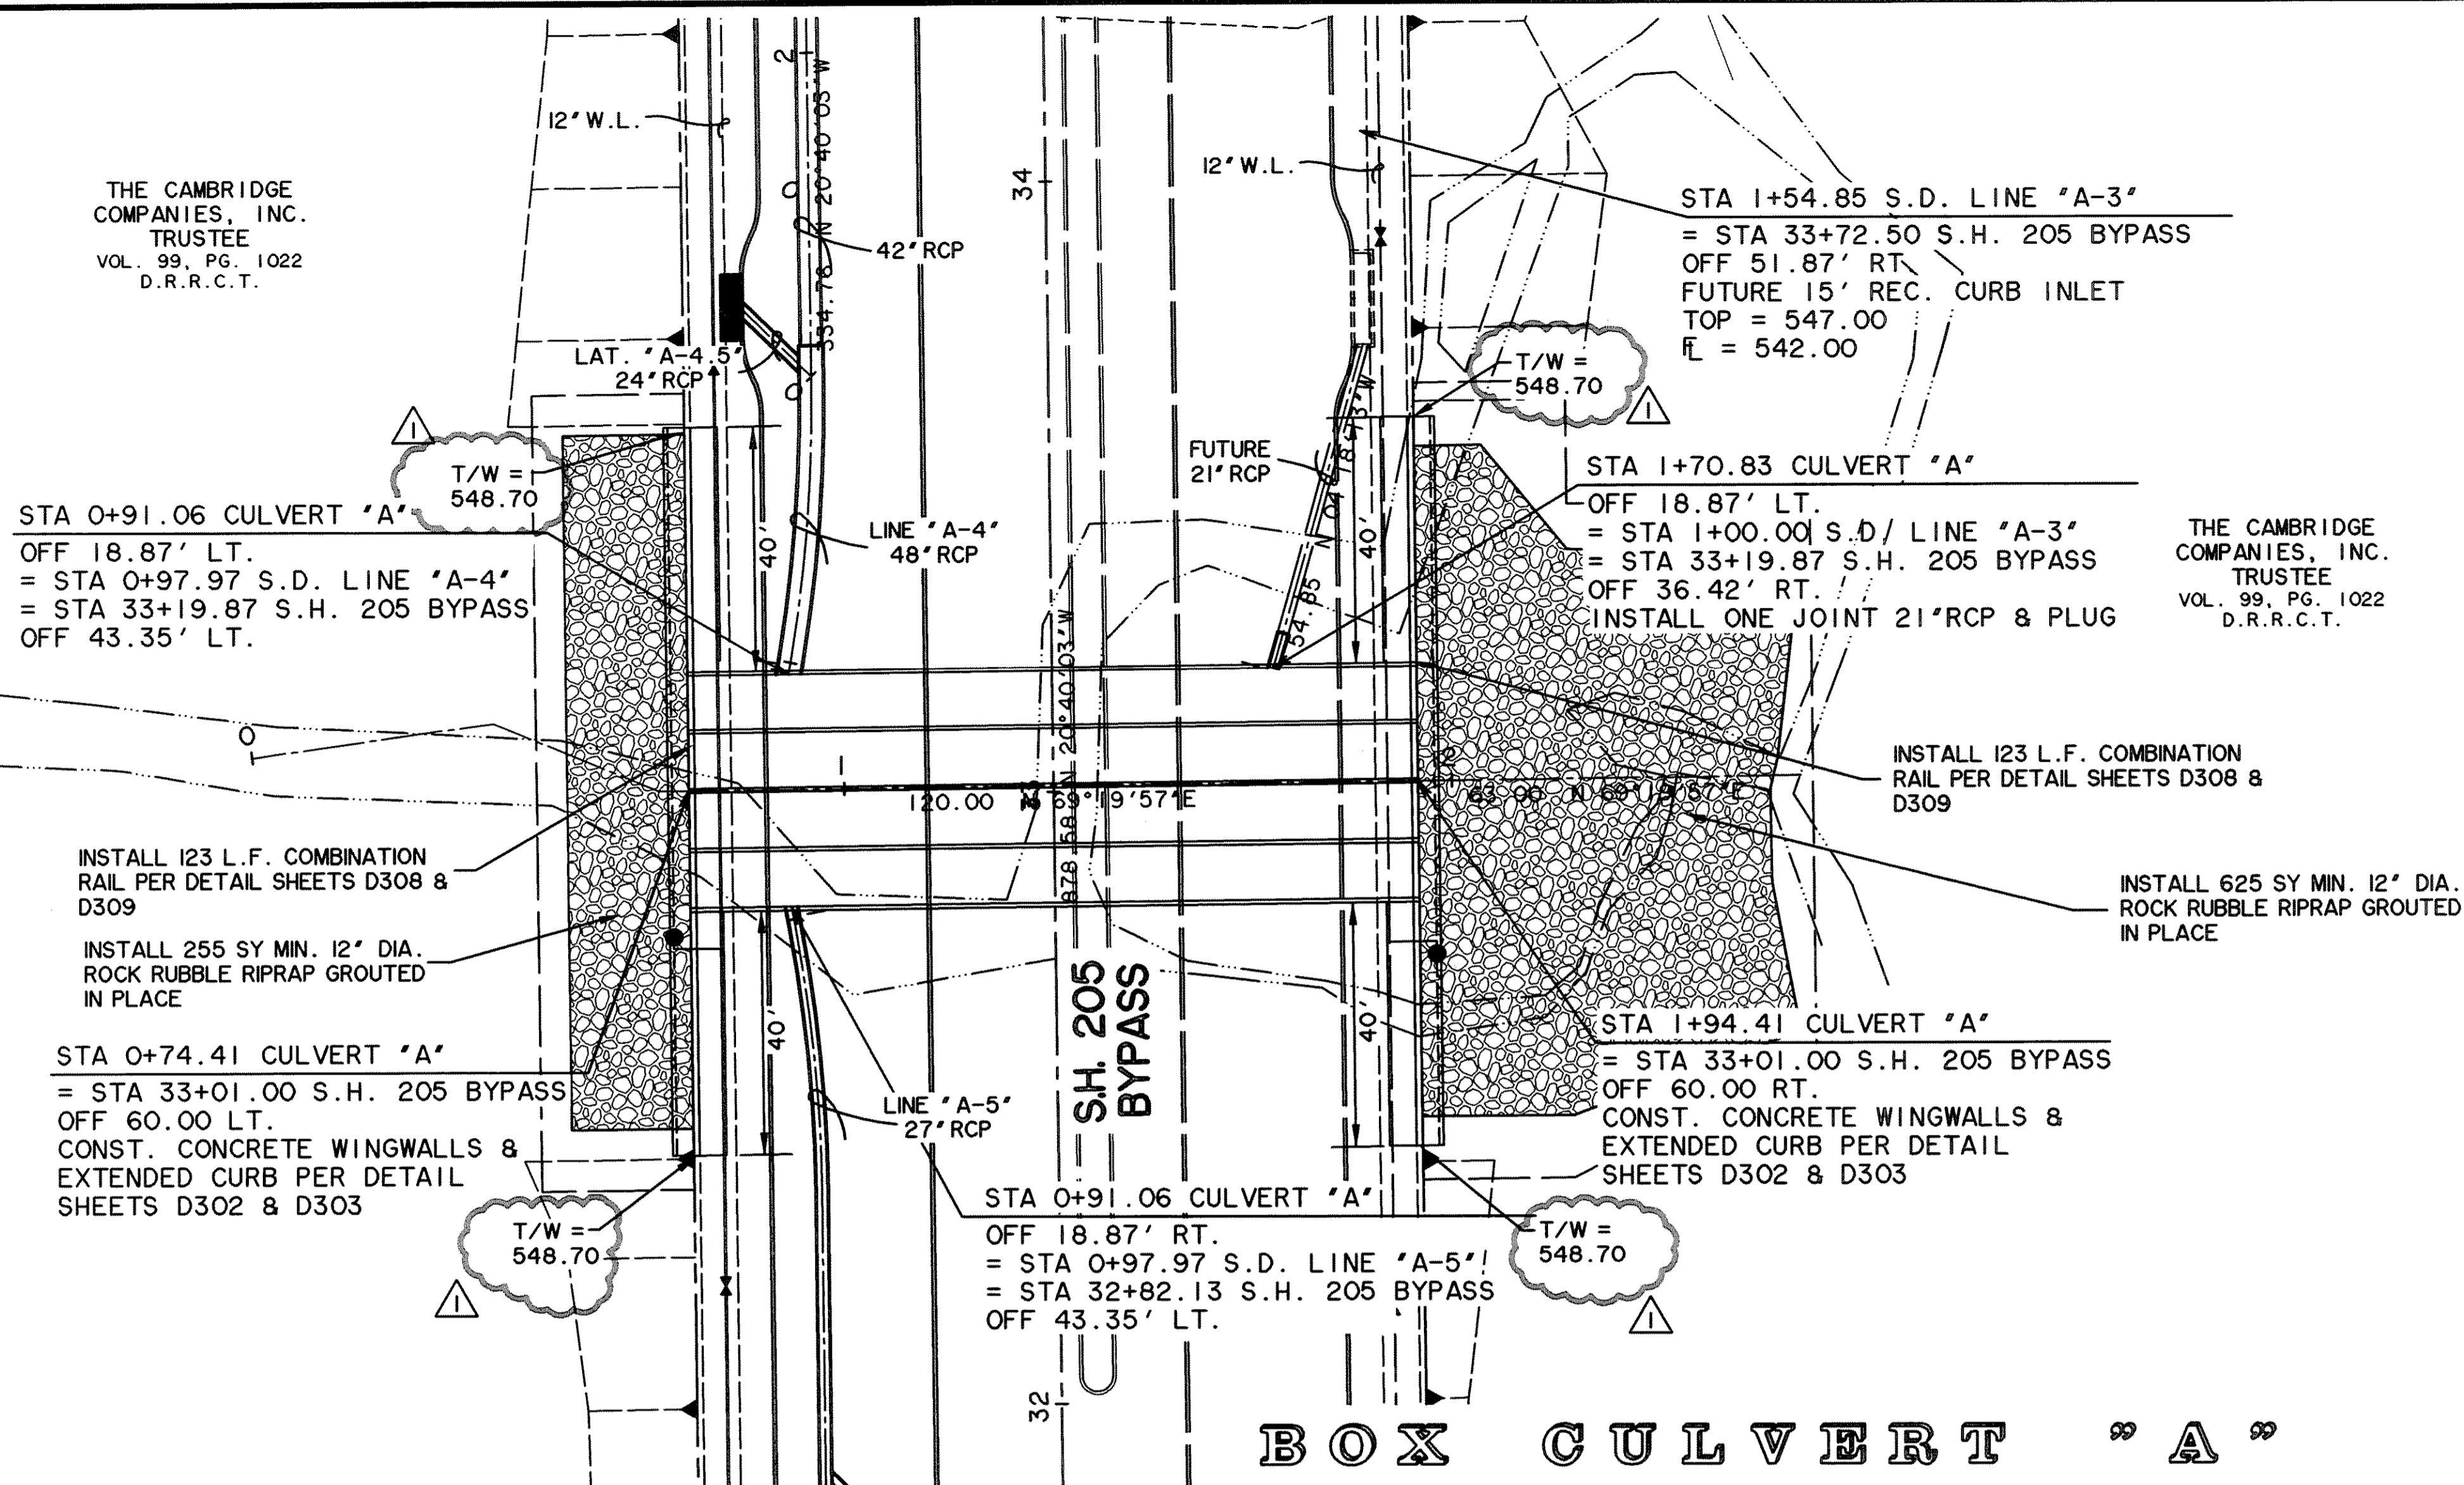


THE CAMBRIDGE COMPANIES, INC. TRUSTEE  
VOL. 99, PG. 1022  
D.R.R.C.T.

**CAUTION !!**  
EXISTING UTILITIES ARE INDICATED ON THE PLANS FROM AVAILABLE INFORMATION. IT SHALL BE THE RESPONSIBILITY OF THE CONTRACTOR TO VERIFY THE LOCATION OF ALL UTILITIES, TO NOTIFY ALL UTILITY COMPANIES OF THE CONTRACTORS OPERATIONS, TO PROTECT ALL UTILITIES FROM DAMAGE, TO REPAIR ALL UTILITIES DAMAGED DUE TO THE CONTRACTORS OPERATIONS, AND TO NOTIFY THE ENGINEER PROMPTLY OF ALL CONFLICTS OF THE WORK WITH EXISTING UTILITIES.

- *BENCHMARKS***
- BOX CUT WITH "X" CUT IN CENTER OF EXISTING SIDEWALK 2' SOUTH OF NORTH EDGE AT SOUTHEAST CORNER OF S.H. No. 205 BYPASS AND S.H. No. 276  
ELEV. 580.40
  - BOX CUT ON SOUTHEAST TOP OF HEADWALL ON SOUTH SIDE OF I.H. No. 30 ACCESS ROAD APPROX. 325' EAST OF FUTURE S.H. No. 205 BYPASS AND ON WEST SIDE OF NESBIT METAL CO. ORANGE METAL BLDG.  
ELEV. 573.70

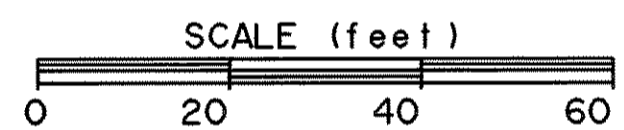


**BOX CULVERT "A"**

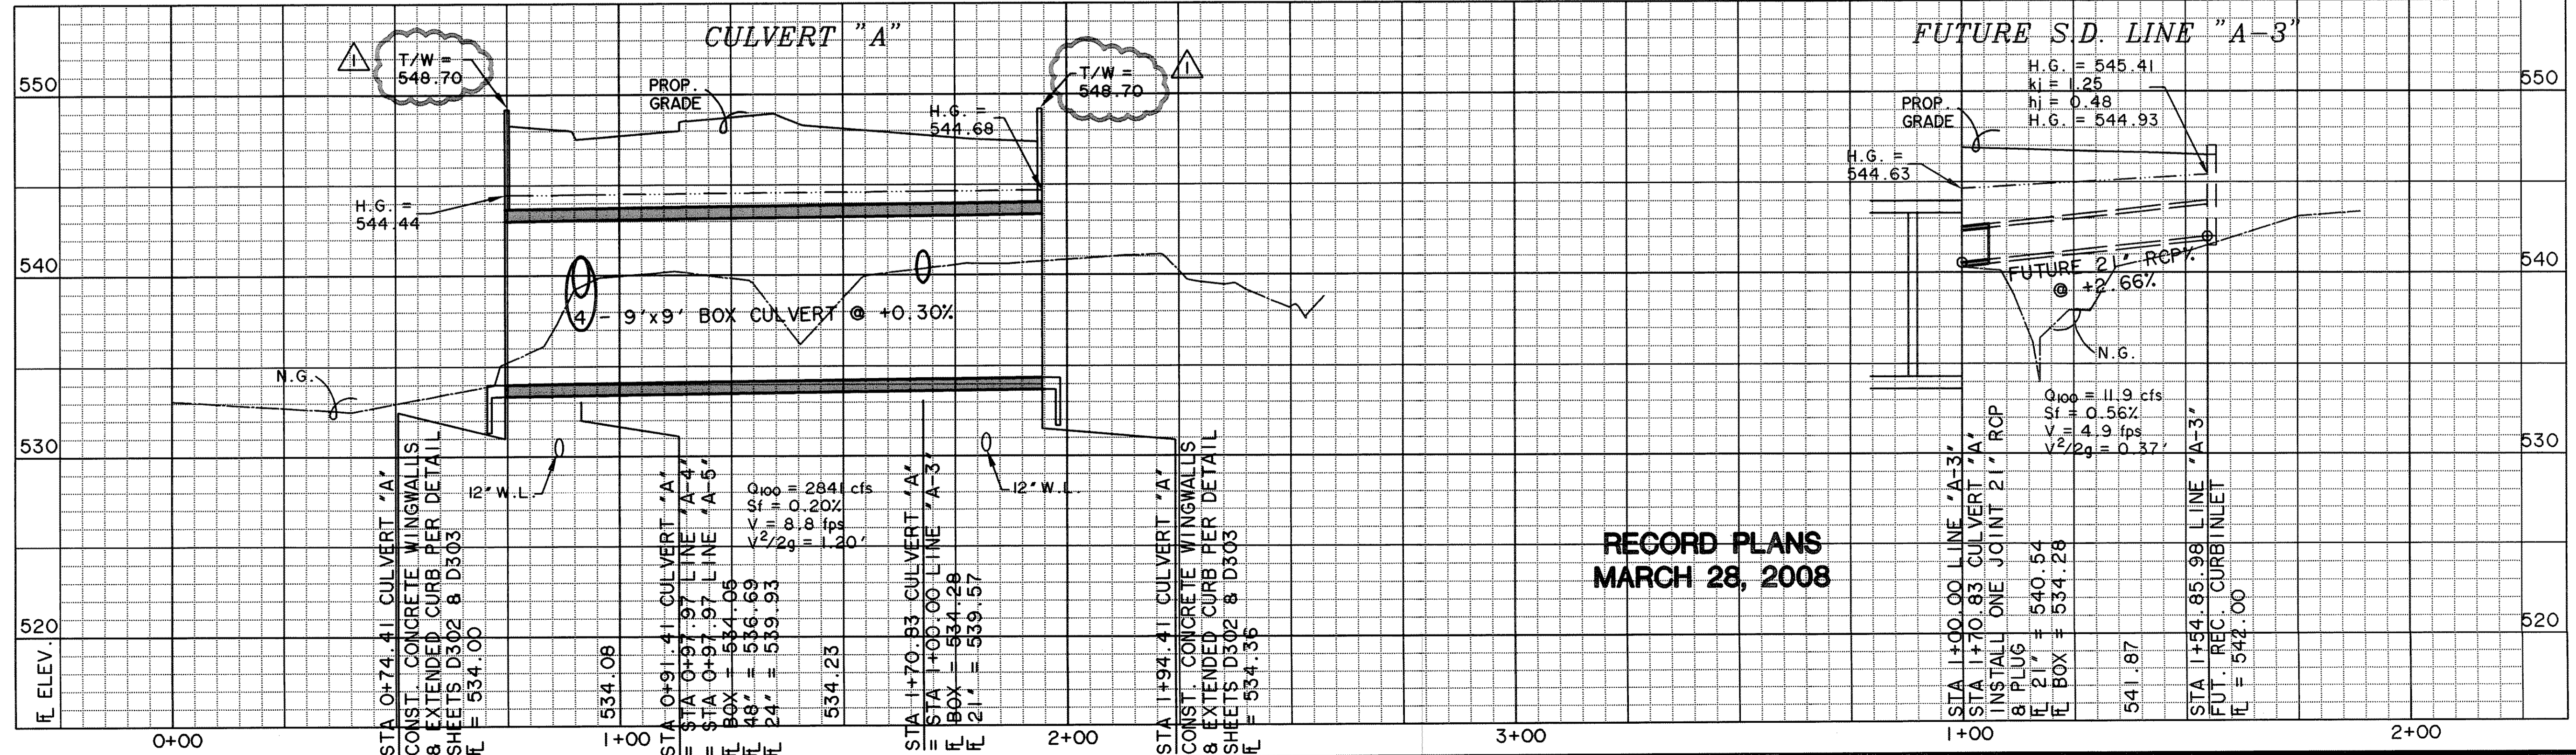


**RECORD PLANS  
MARCH 28, 2008**

PREPARED BY:  
**WIER & ASSOCIATES, INC.**  
ENGINEERS SURVEYORS LAND PLANNERS  
4300 BELTWAY PLACE SUITE 130 ARLINGTON, TEXAS 76018 METRO (817)467-7700  
1380 U.S. HIGHWAY 287 N. SUITE 101 WANSFELD, TEXAS 76063 METRO (817)477-8700  
6849 ELM STREET FRISCO, TEXAS 75034 METRO (214)387-8000  
www.wierassociates.com

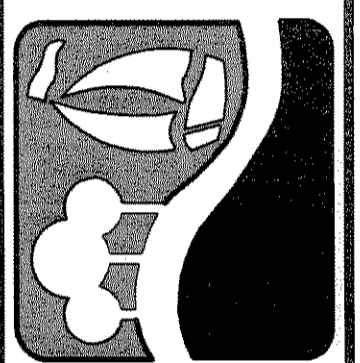

**PHASE I S.H. 205 BYPASS  
FROM S.H. 276 TO INTERSTATE 30  
BOX CULVERT "A"  
PLAN & PROFILE**

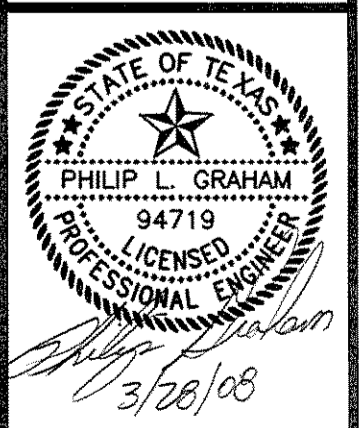

COPYRIGHT ©  
WIER & ASSOCIATES, INC.  
LAST SHEET EDIT  
DATE 10-31-2007  
WA# 04141  
**SHEET NO.  
D104**

**CAUTION !!**

EXISTING UTILITIES ARE INDICATED ON THE PLANS FROM AVAILABLE INFORMATION. IT SHALL BE THE RESPONSIBILITY OF THE CONTRACTOR TO VERIFY THE LOCATION OF ALL UTILITIES, TO NOTIFY ALL UTILITY COMPANIES OF THE CONTRACTORS OPERATIONS, TO PROTECT ALL UTILITIES FROM DAMAGE, TO REPAIR ALL UTILITIES DAMAGED DUE TO THE CONTRACTORS OPERATIONS, AND TO NOTIFY THE ENGINEER PROMPTLY OF ALL CONFLICTS OF THE WORK WITH EXISTING UTILITIES.

THE CAMBRIDGE COMPANIES, INC. TRUSTEE  
VOL. 99, PG. 1022  
D.R.R.C.T.

***BENCHMARKS***



- BOX CUT WITH 'X' CUT IN CENTER OF EXISTING SIDEWALK 2' SOUTH OF NORTH EDGE AT SOUTHEAST CORNER OF S.H. No. 205 BYPASS AND S.H. No. 276  
ELEV. 580.40
- BOX CUT ON SOUTHEAST TOP OF HEADWALL ON SOUTH SIDE OF I.H. No. 30 ACCESS ROAD APPROX. 325' EAST OF FUTURE S.H. No. 205 BYPASS AND ON WEST SIDE OF NESBIT METAL CO. ORANGE METAL BLDG.  
ELEV. 573.70

**CURVE C208**


A	10°00'00"
D	22°55'06"
R	250.00
L	21.87
E	43.63
F	0.95

**CURVE C209**

A	17°57'29"
D	02°52'50"
R	1989.00
L	314.28
E	623.40
F	24.68

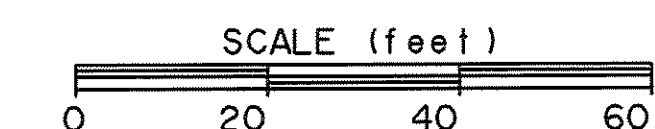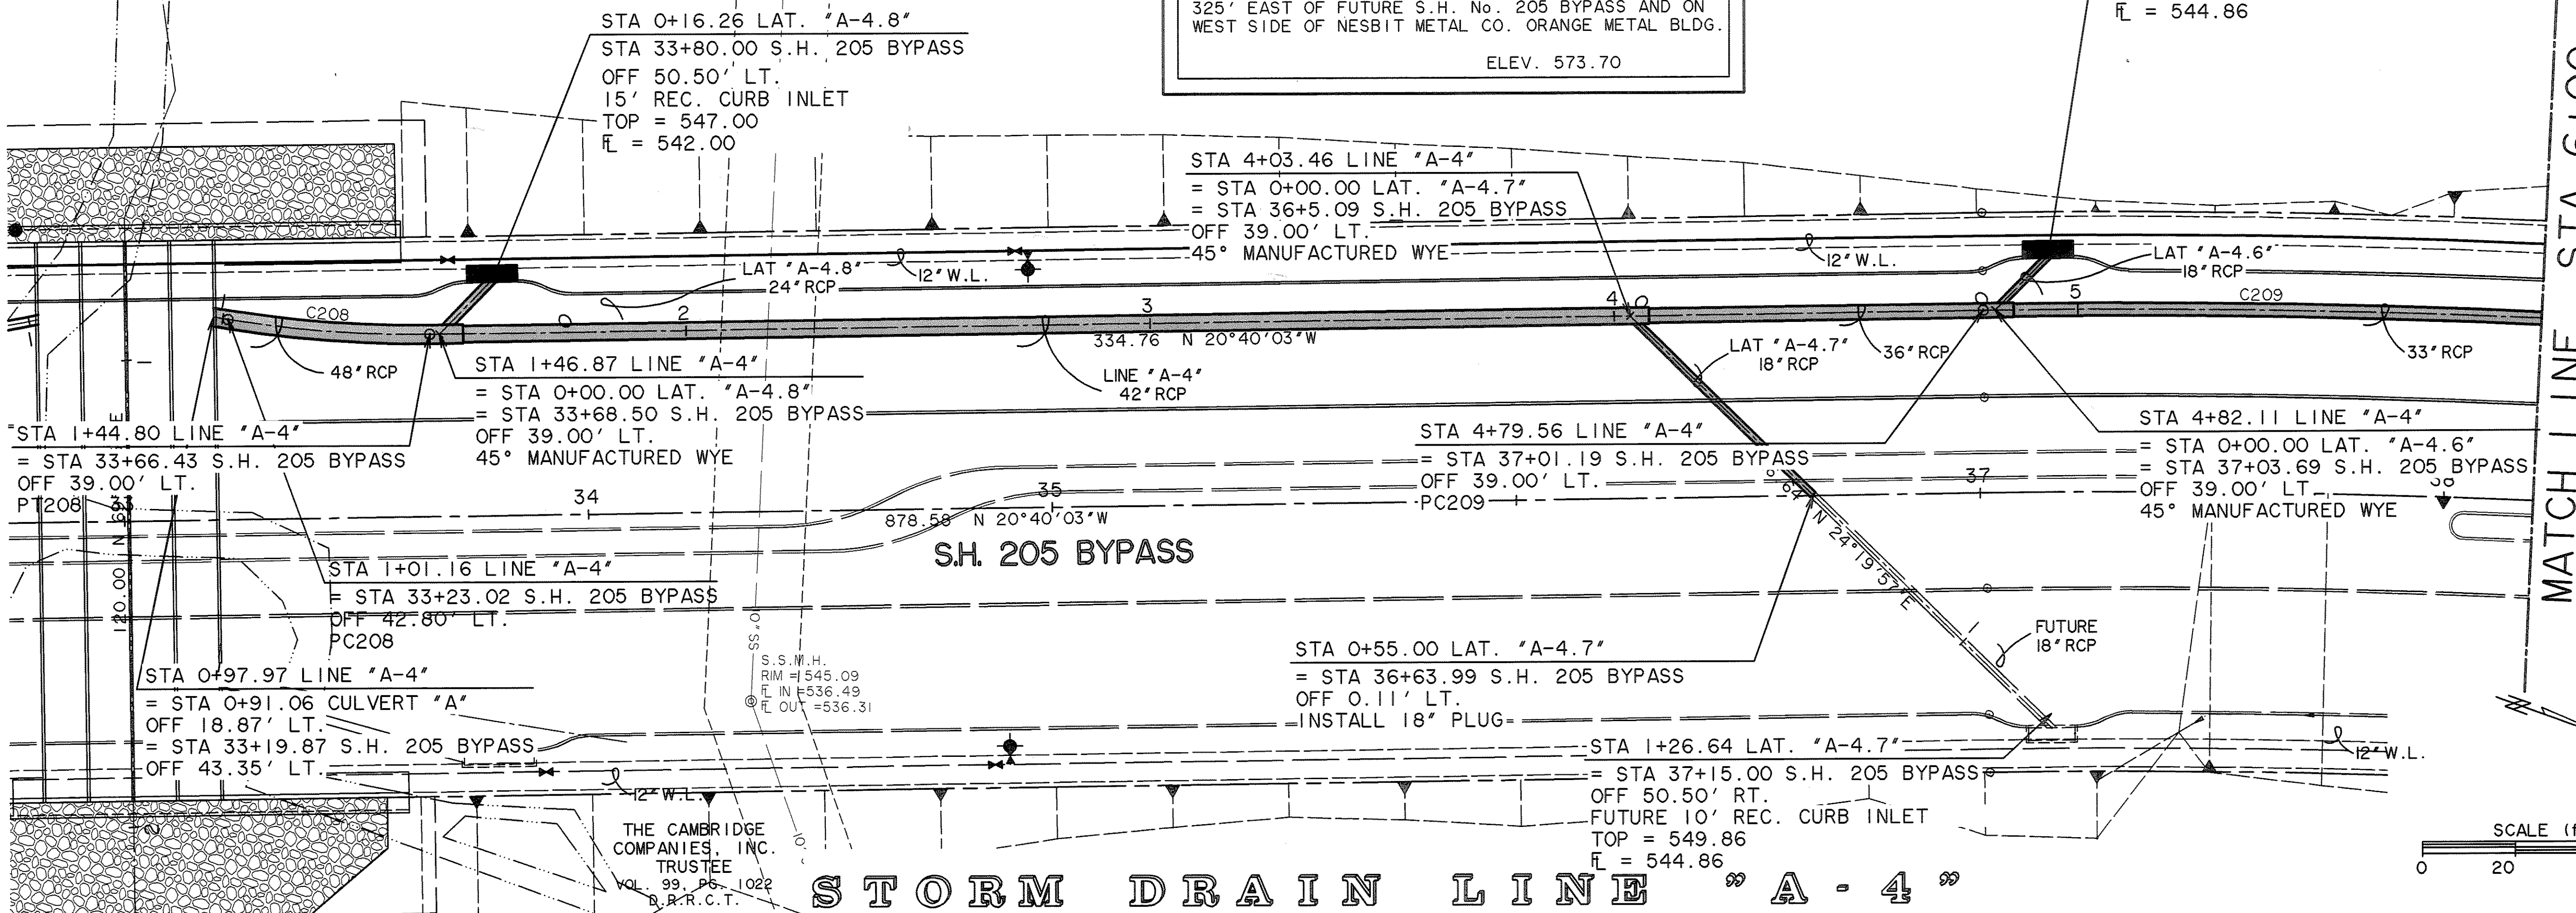


**STORM DRAIN LINE "A-4"**

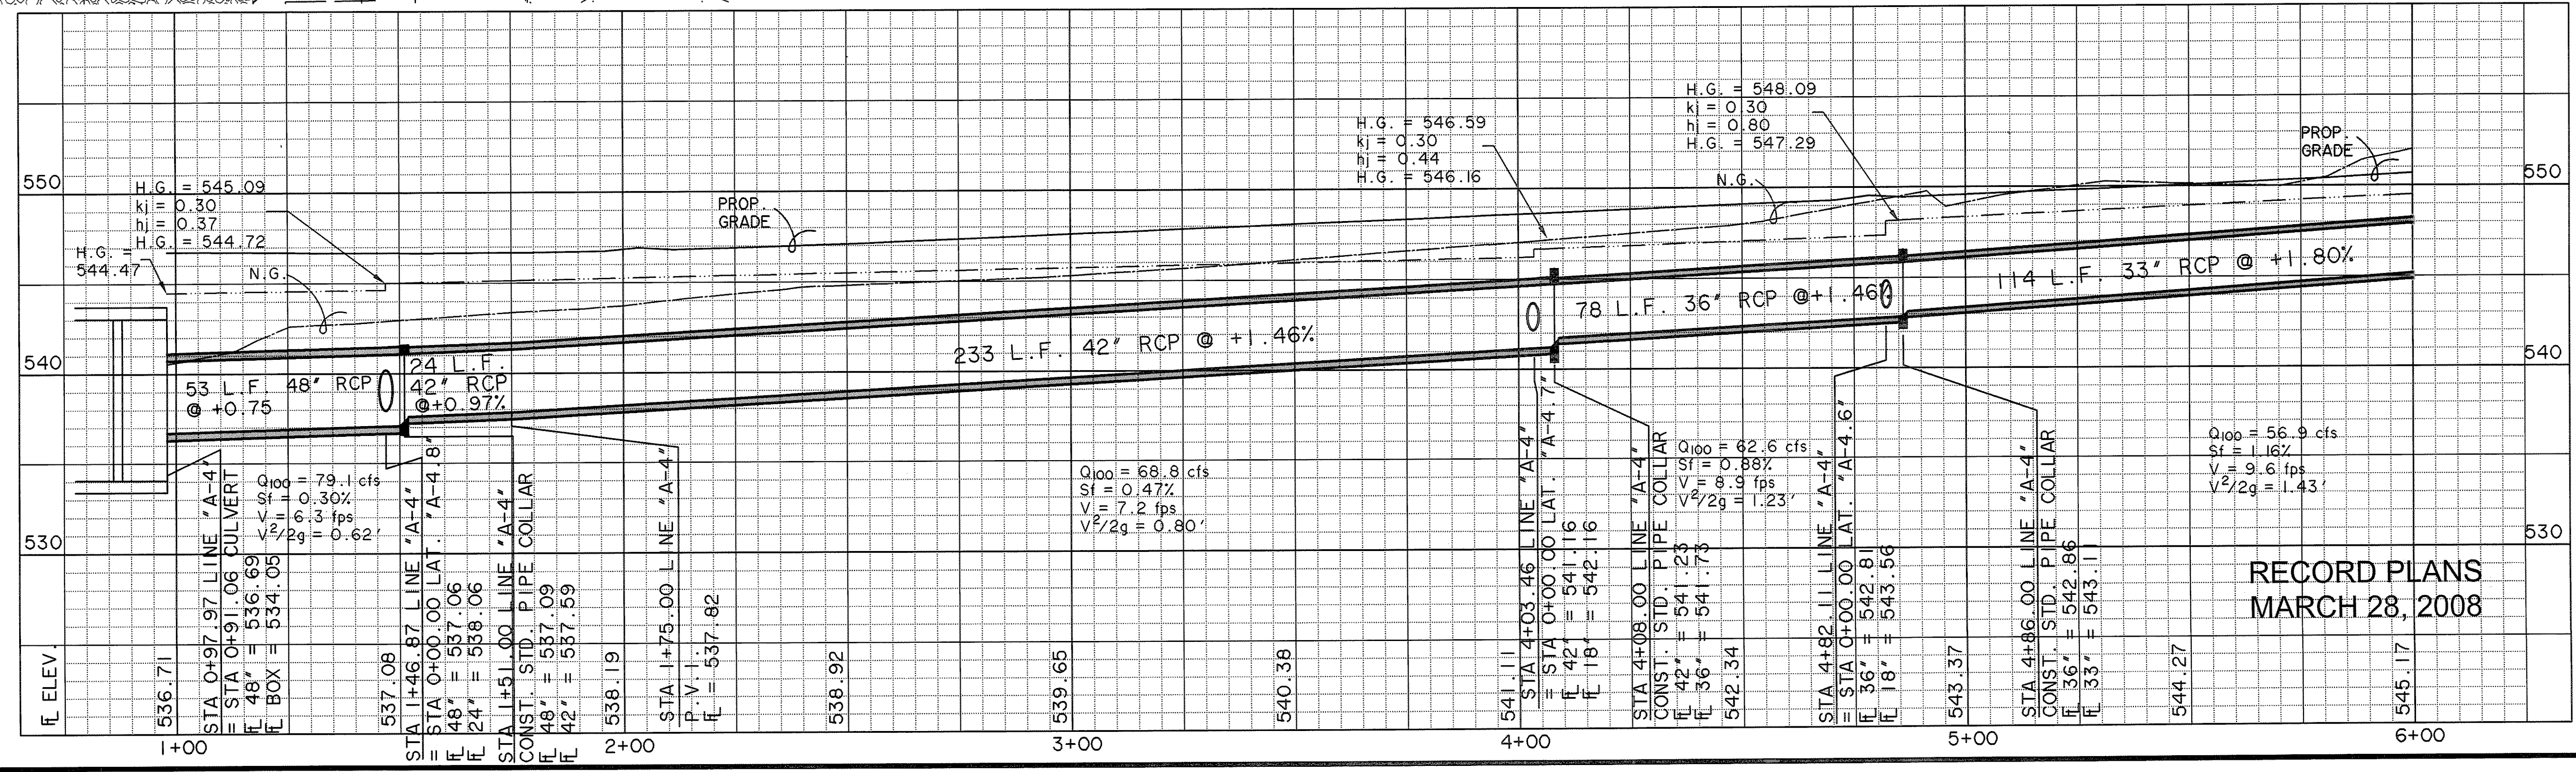

RECORD PLANS  
MARCH 28, 2008

PREPARED BY:  
**VIA WIER & ASSOCIATES, INC.**  
ENGINEERS SURVEYORS LAND PLANNERS  
4300 BELWAY PLACE SUITE 130 ARLINGTON, TEXAS 76018 METRO (817)467-7700  
1380 U.S. HIGHWAY 287 N. SUITE 101 WANSFELD, TEXAS 76063 METRO (817)477-8700  
6848 ELM STREET FRSICO, TEXAS 75034 METRO (214)387-8800  
www.viawier.com

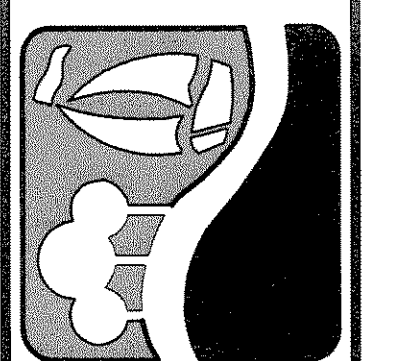

PHASE I S.H. 205 BYPASS  
FROM S.H. 276 TO INTERSTATE 30  
**STORM DRAIN LINE "A-4"**  
PLAN & PROFILE  
STA 1+00 TO 6+00

COPYRIGHT ©  
WIER & ASSOCIATES, INC.  
LAST SHEET EDIT  
DATE 07-19-2007  
WA# 04141  
**SHEET NO.**  
D105

***BENCHMARKS***

1. BOX CUT WITH "X" CUT IN CENTER OF EXISTING SIDEWALK 2' SOUTH OF NORTH EDGE AT SOUTHEAST CORNER OF S.H. No. 205 BYPASS AND S.H. No. 276  
ELEV. 580.40

2. BOX CUT ON SOUTHEAST TOP OF HEADWALL ON SOUTH SIDE OF I.H. No. 30 ACCESS ROAD APPROX. 325' EAST OF FUTURE S.H. No. 205 BYPASS AND ON WEST SIDE OF NESBIT METAL CO. ORANGE METAL BLDG.  
ELEV. 573.70

THE CAMBRIDGE COMPANIES, INC. TRUSTEE  
VOL. 99, PG. 1022  
D.R.R.C.T.

**CAUTION !!**  
EXISTING UTILITIES ARE INDICATED ON THE PLANS FROM AVAILABLE INFORMATION. IT SHALL BE THE RESPONSIBILITY OF THE CONTRACTOR TO VERIFY THE LOCATION OF ALL UTILITIES, TO NOTIFY ALL UTILITY COMPANIES OF THE CONTRACTORS OPERATIONS, TO PROTECT ALL UTILITIES FROM DAMAGE, TO REPAIR ALL UTILITIES DAMAGED DUE TO THE CONTRACTORS OPERATIONS, AND TO NOTIFY THE ENGINEER PROMPTLY OF ALL CONFLICTS OF THE WORK WITH EXISTING UTILITIES.

STA 0+16.31 LAT. "A-4.2"  
= STA 42+75.00 S.H. 205 BYPASS  
OFF 50.50' LT.  
10' REC. CURB INLET  
TOP = 561.57  
FL = 556.57

STA 0+42.68 LAT. "A-4.4"  
= STA 41+50.00 S.H. 205 BYPASS  
OFF 70.00' LT.

STA 41+51.32 S.H. 205 BYPASS  
OFF 71.46' LT.  
4'x4' DROP INLET  
TOP = 560.43  
THROAT = 559.43  
FL = 554.93

STA 0+16.31 LAT. "A-4.5"  
= STA 40+50.00 S.H. 205 BYPASS  
OFF 50.50' LT.  
10' REC. CURB INLET  
TOP = 556.09  
FL = 551.09



MATCH LINE STA 6+00

MATCH LINE STA 11+00


CURVE C209	
A	17°57'29"
D	02°52'50"
R	1989.00
T	314.28
L	623.40
E	24.68

THE CAMBRIDGE COMPANIES, INC. TRUSTEE  
VOL. 99, PG. 1022  
D.R.R.C.T.


**STORM DRAIN LINE "A-4"**

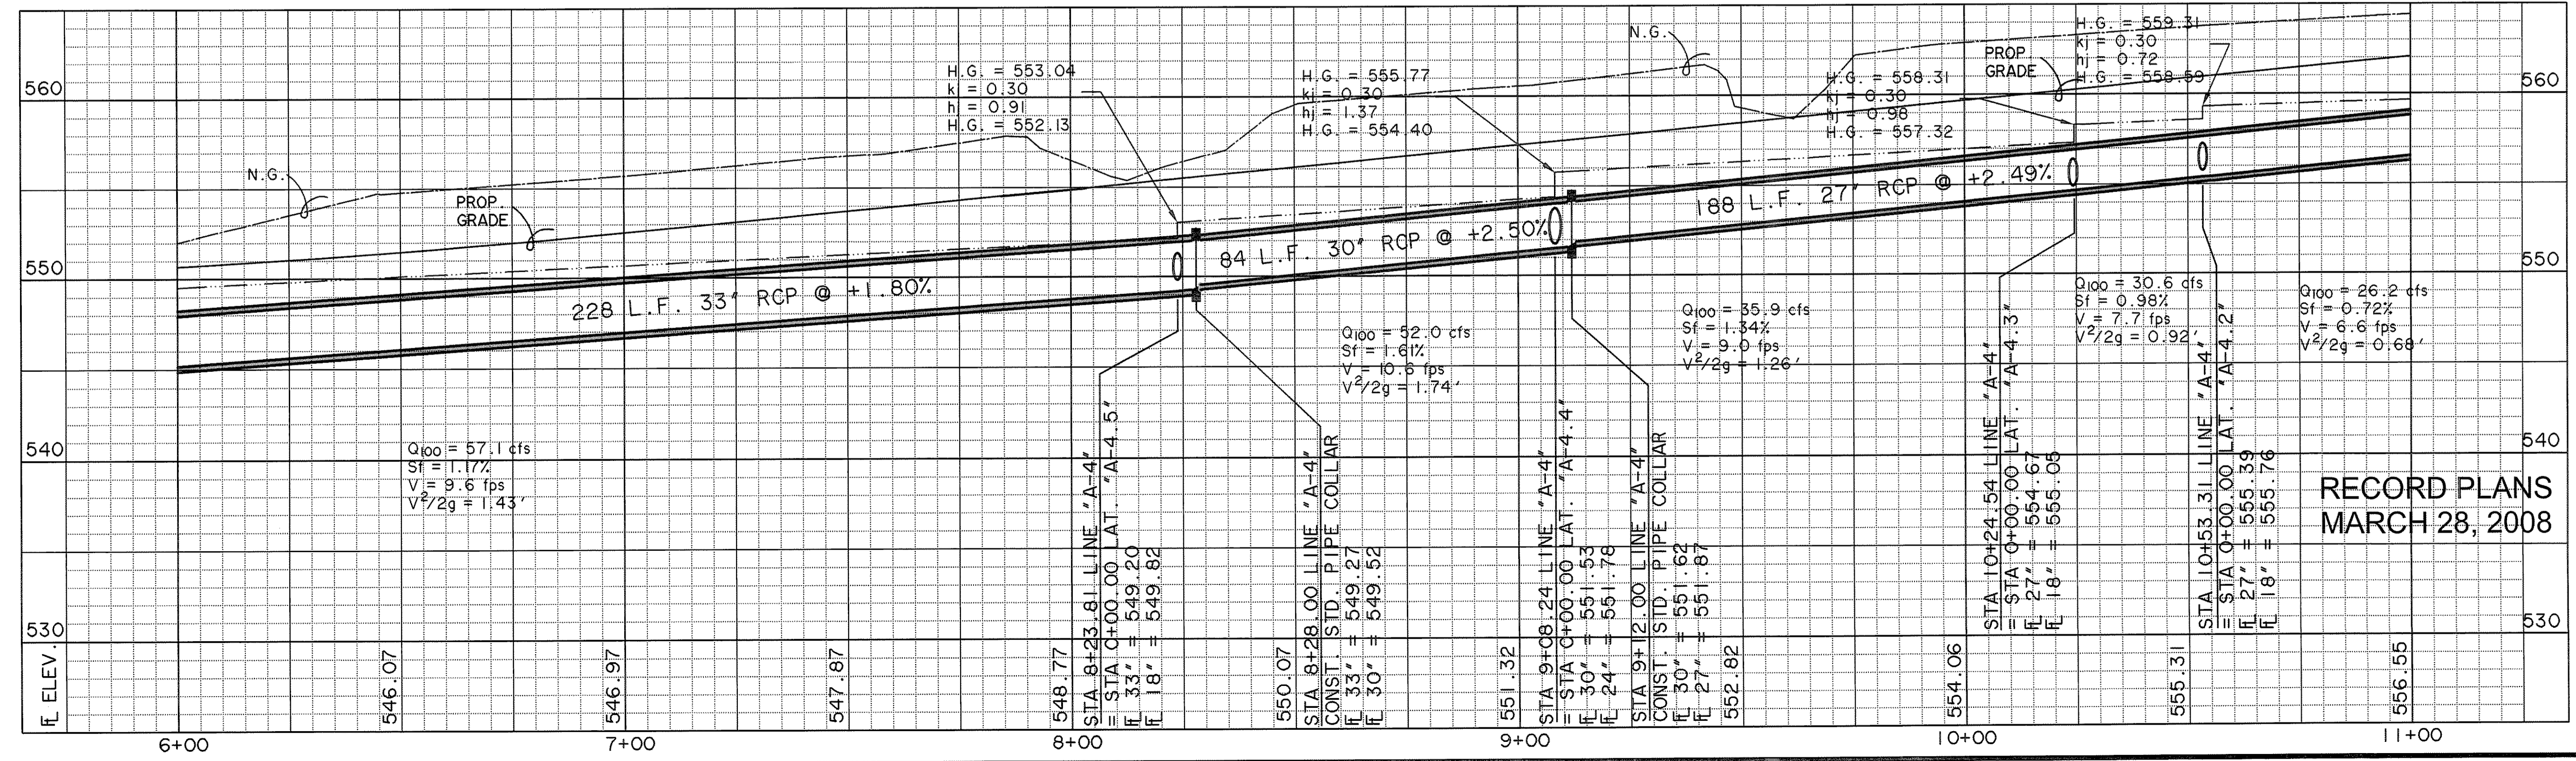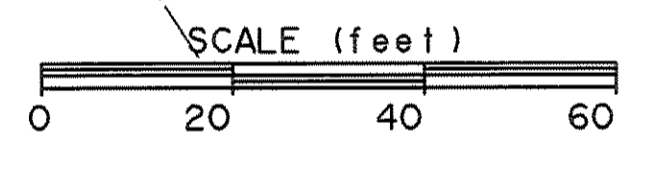

PREPARED BY:  
**VIA WIER & ASSOCIATES, INC.**  
ENGINEERS SURVEYORS LAND PLANNERS  
4300 BELTWAY PLACE SUITE 130 ARLINGTON, TEXAS 76018 METRO (817)467-7700  
1380 U.S. HIGHWAY 287 N. SUITE 101 MANSFIELD, TEXAS 76063 METRO (817)477-8700  
6848 ELM STREET FRISCO, TEXAS 75034 METRO (214)387-8000  
www.viawier.com

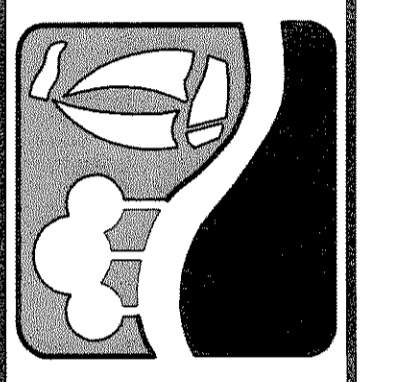

**PHASE I S.H. 205 BYPASS  
FROM S.H. 276 TO INTERSTATE 30  
STORM DRAIN LINE "A-4"  
PLAN & PROFILE  
STA 6+00 TO 11+00**

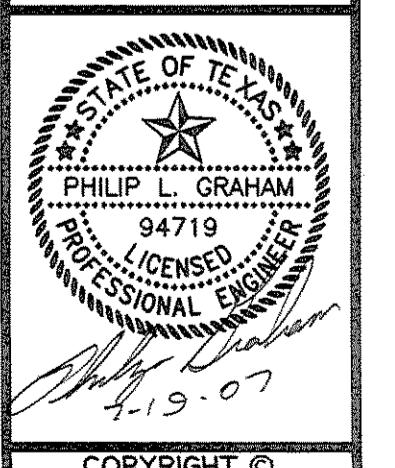

COPYRIGHT ©  
WIER & ASSOCIATES, INC.  
LAST SHEET EDIT  
DATE 07-19-2007  
WA# 04141  
**SHEET NO. D106**

CURVE C209	
A	17°57'29"
D	02°52'50"
R	1989.00
T	314.28
L	623.40
E	24.68

CURVE C210	
A	22°21'11"
D	22°55'06"
R	250.00
T	49.39
L	97.53
E	4.83


THE CAMBRIDGE COMPANIES, INC. TRUSTEE  
VOL. 99, PG. 1022  
D.R.R.C.T.

THE CAMBRIDGE COMPANIES, INC. TRUSTEE  
VOL. 101, PG. 795  
D.R.R.C.T.


***BENCHMARK***  
1. BOX CUT WITH "X" CUT IN CENTER OF EXISTING SIDEWALK 2' SOUTH OF NORTH EDGE AT SOUTHEAST CORNER OF S.H. No. 205 BYPASS AND S.H. No. 276  
ELEV. 580.40  
2. BOX CUT ON SOUTHEAST TOP OF HEADWALL ON SOUTH SIDE OF I.H. No. 30 ACCESS ROAD APPROX. 325' EAST OF FUTURE S.H. No. 205 BYPASS AND ON WEST SIDE OF NESBIT METAL CO. ORANGE METAL BLDG.  
ELEV. 573.70

**CAUTION !!**  
EXISTING UTILITIES ARE INDICATED ON THE PLANS FROM AVAILABLE INFORMATION. IT SHALL BE THE RESPONSIBILITY OF THE CONTRACTOR TO VERIFY THE LOCATION OF ALL UTILITIES, TO NOTIFY ALL UTILITY COMPANIES OF THE CONTRACTORS OPERATIONS, TO PROTECT ALL UTILITIES FROM DAMAGE, TO REPAIR ALL UTILITIES DAMAGED DUE TO THE CONTRACTORS OPERATIONS, AND TO NOTIFY THE ENGINEER PROMPTLY OF ALL CONFLICTS OF THE WORK WITH EXISTING UTILITIES.

PREPARED BY:  
**WIER & ASSOCIATES, INC.**  
ENGINEERS SURVEYORS LAND PLANNERS  
4300 BELLEVUE PLACE SUITE 130 ARLINGTON, TEXAS 76018 METRO (817)467-7700  
1380 U.S. HIGHWAY 287 N. SUITE 101 WAREFIELD, TEXAS 76683 METRO (817)477-8700  
6849 ELM STREET FRISCO, TEXAS 75084 METRO (214)387-8800  
www.wierassociates.com



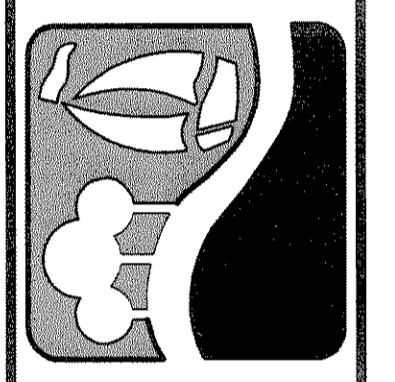


PHASE I S.H. 205 BYPASS  
FROM S.H. 276 TO INTERSTATE 30  
**STORM DRAIN LINE "A-4"**  
PLAN & PROFILE  
STA 11+00 TO END

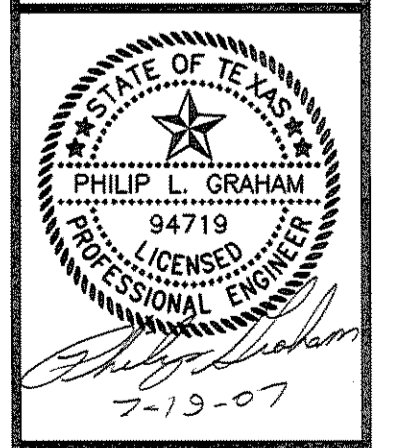

COPYRIGHT ©  
WIER & ASSOCIATES, INC.  
LAST SHEET EDIT  
DATE 07-19-2007  
WA# 04141  
**SHEET NO. D107**


MATCH LINE STA 11+00

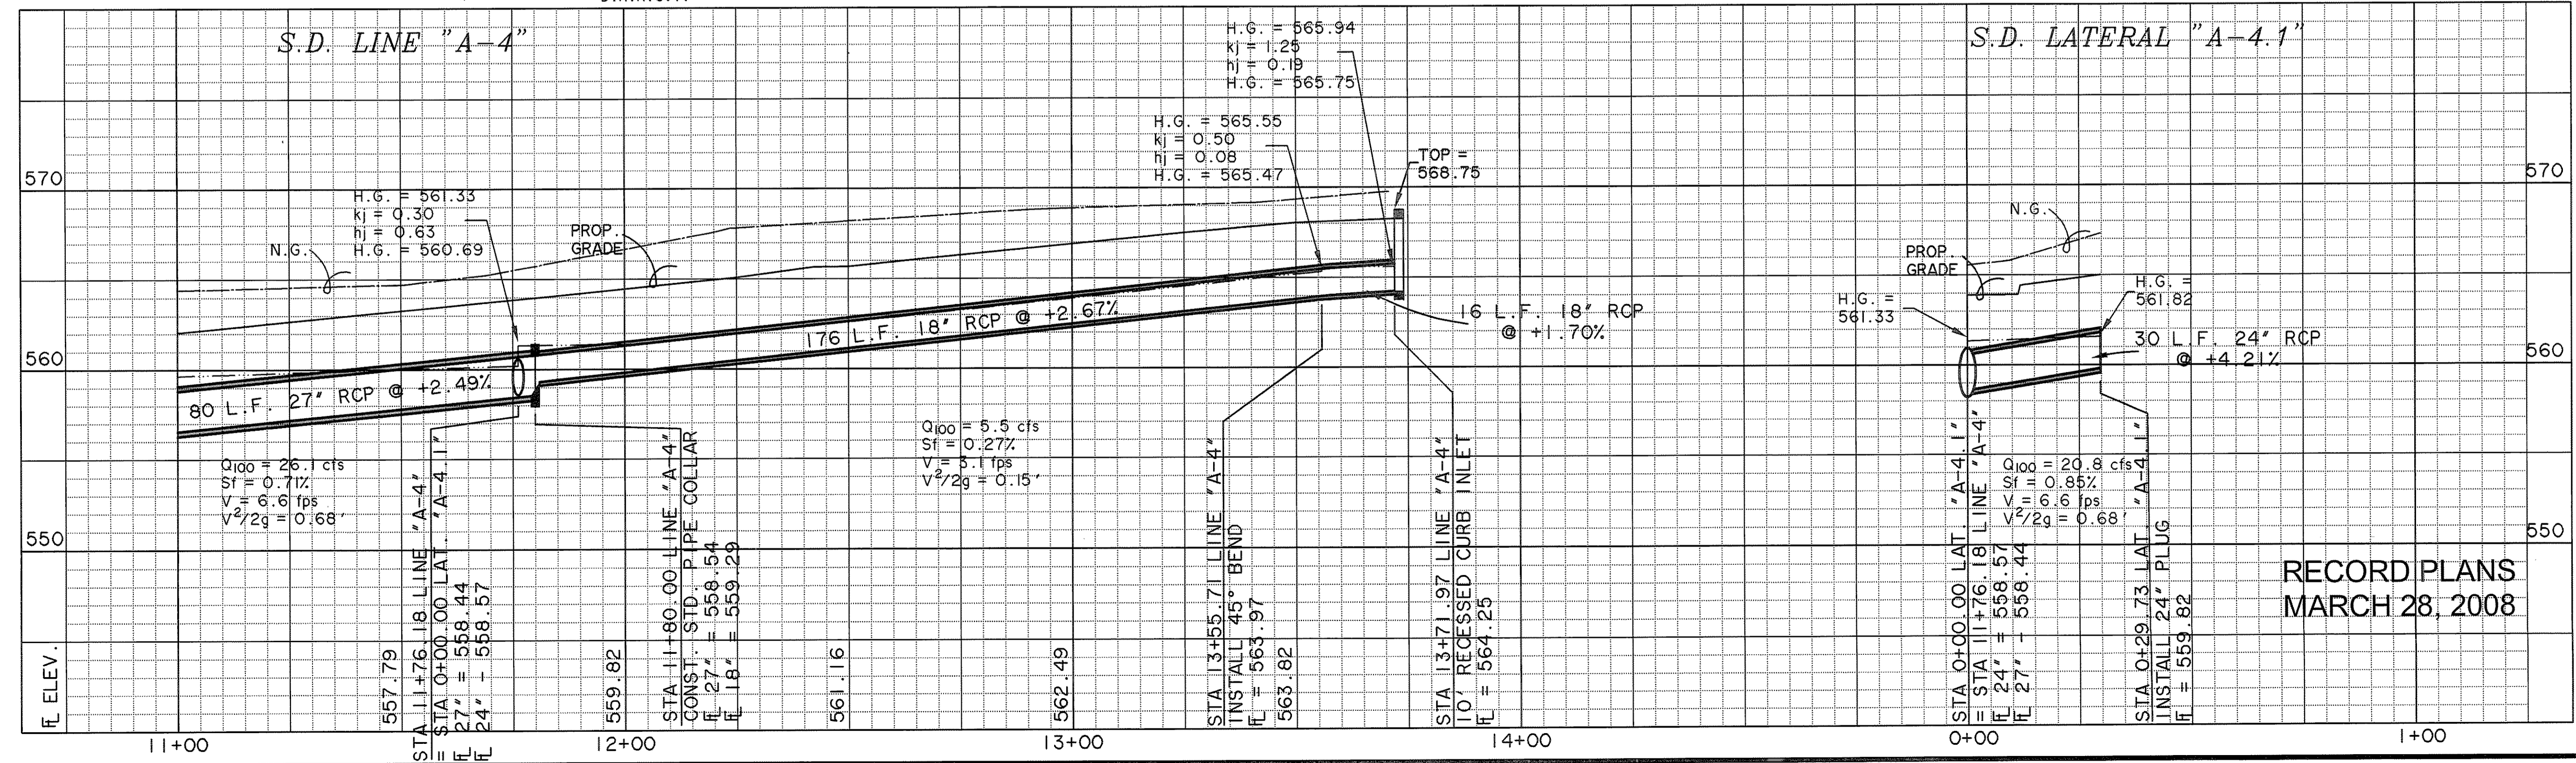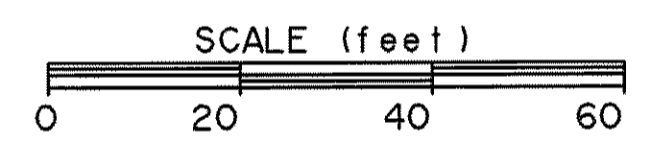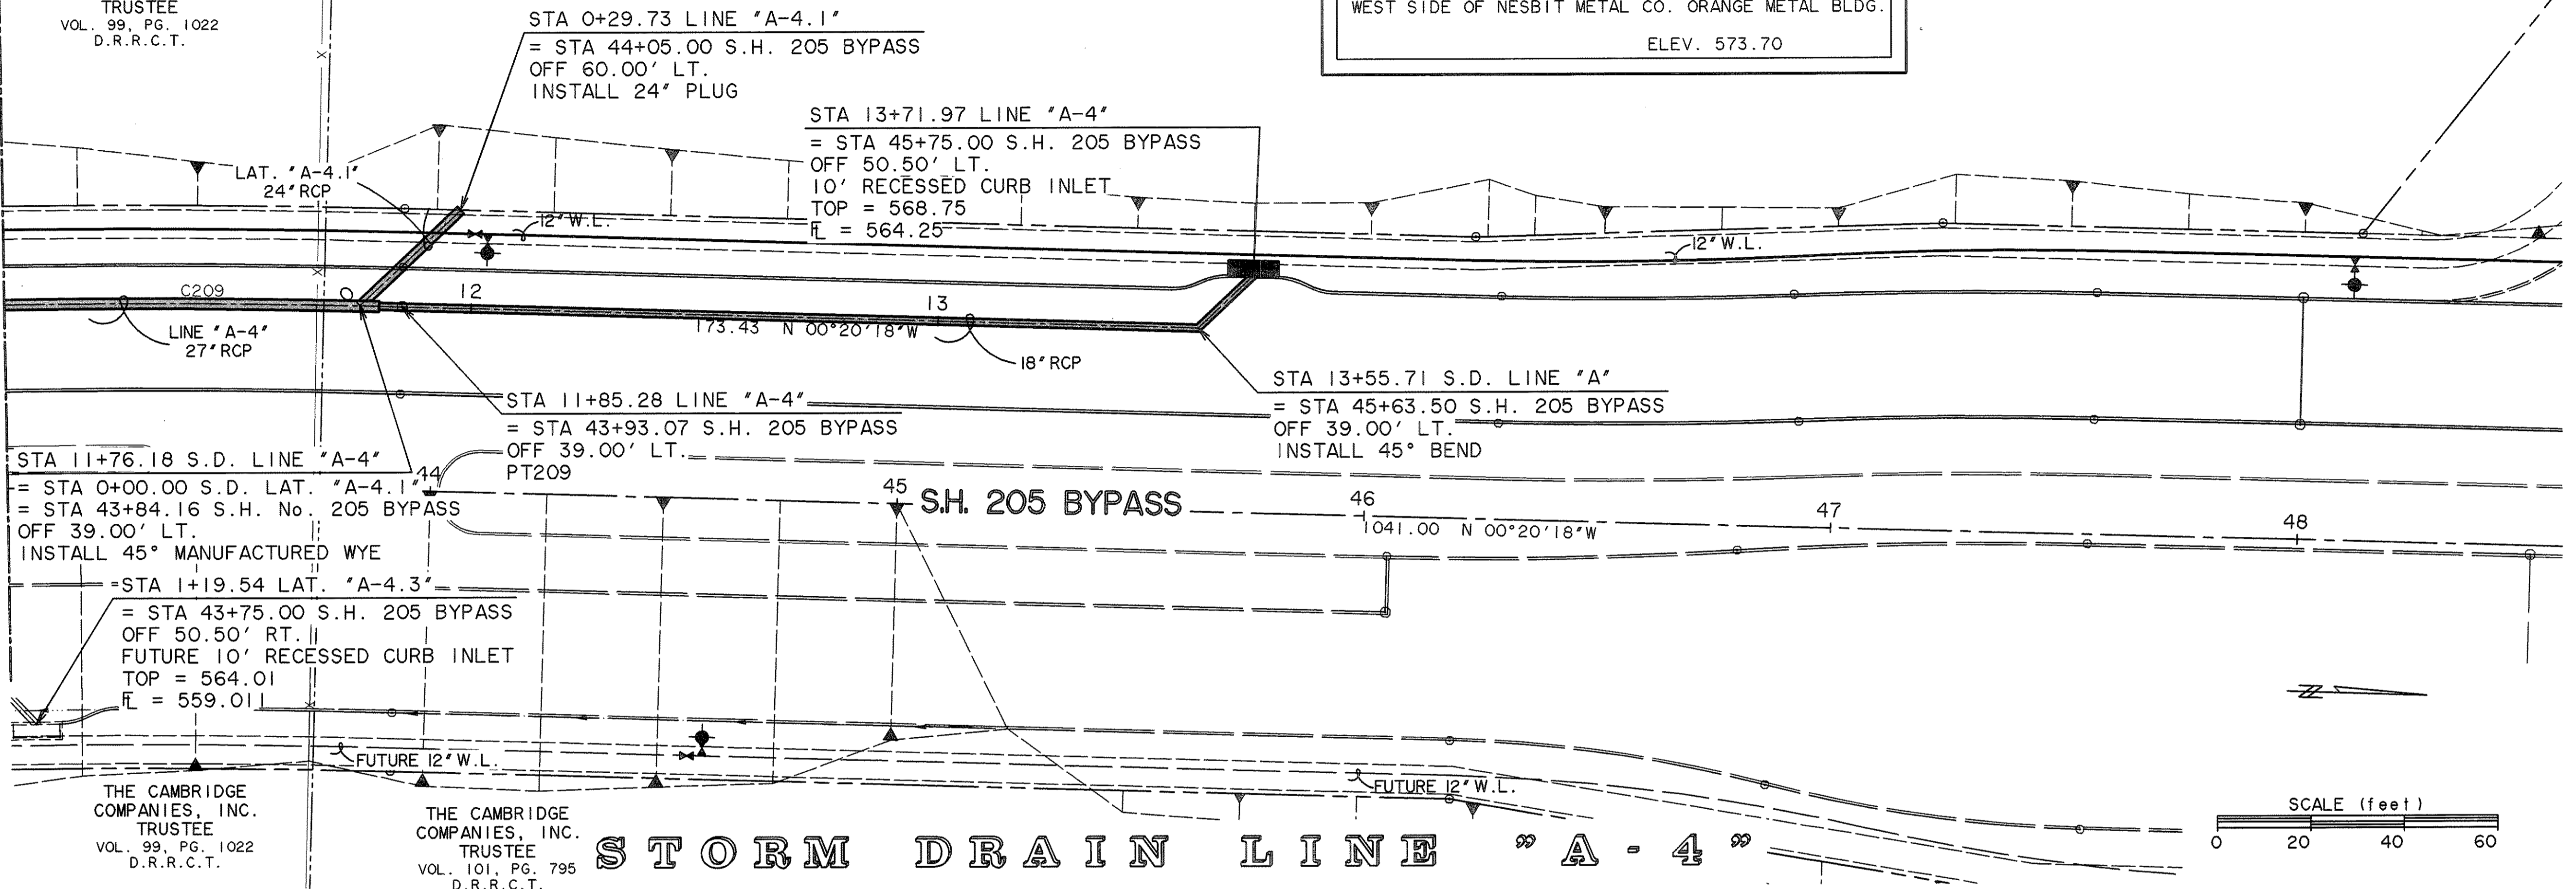

**RECORD PLANS**  
MARCH 28, 2008



TIME 11:14 FILE: 04141-SDPP5.dwg

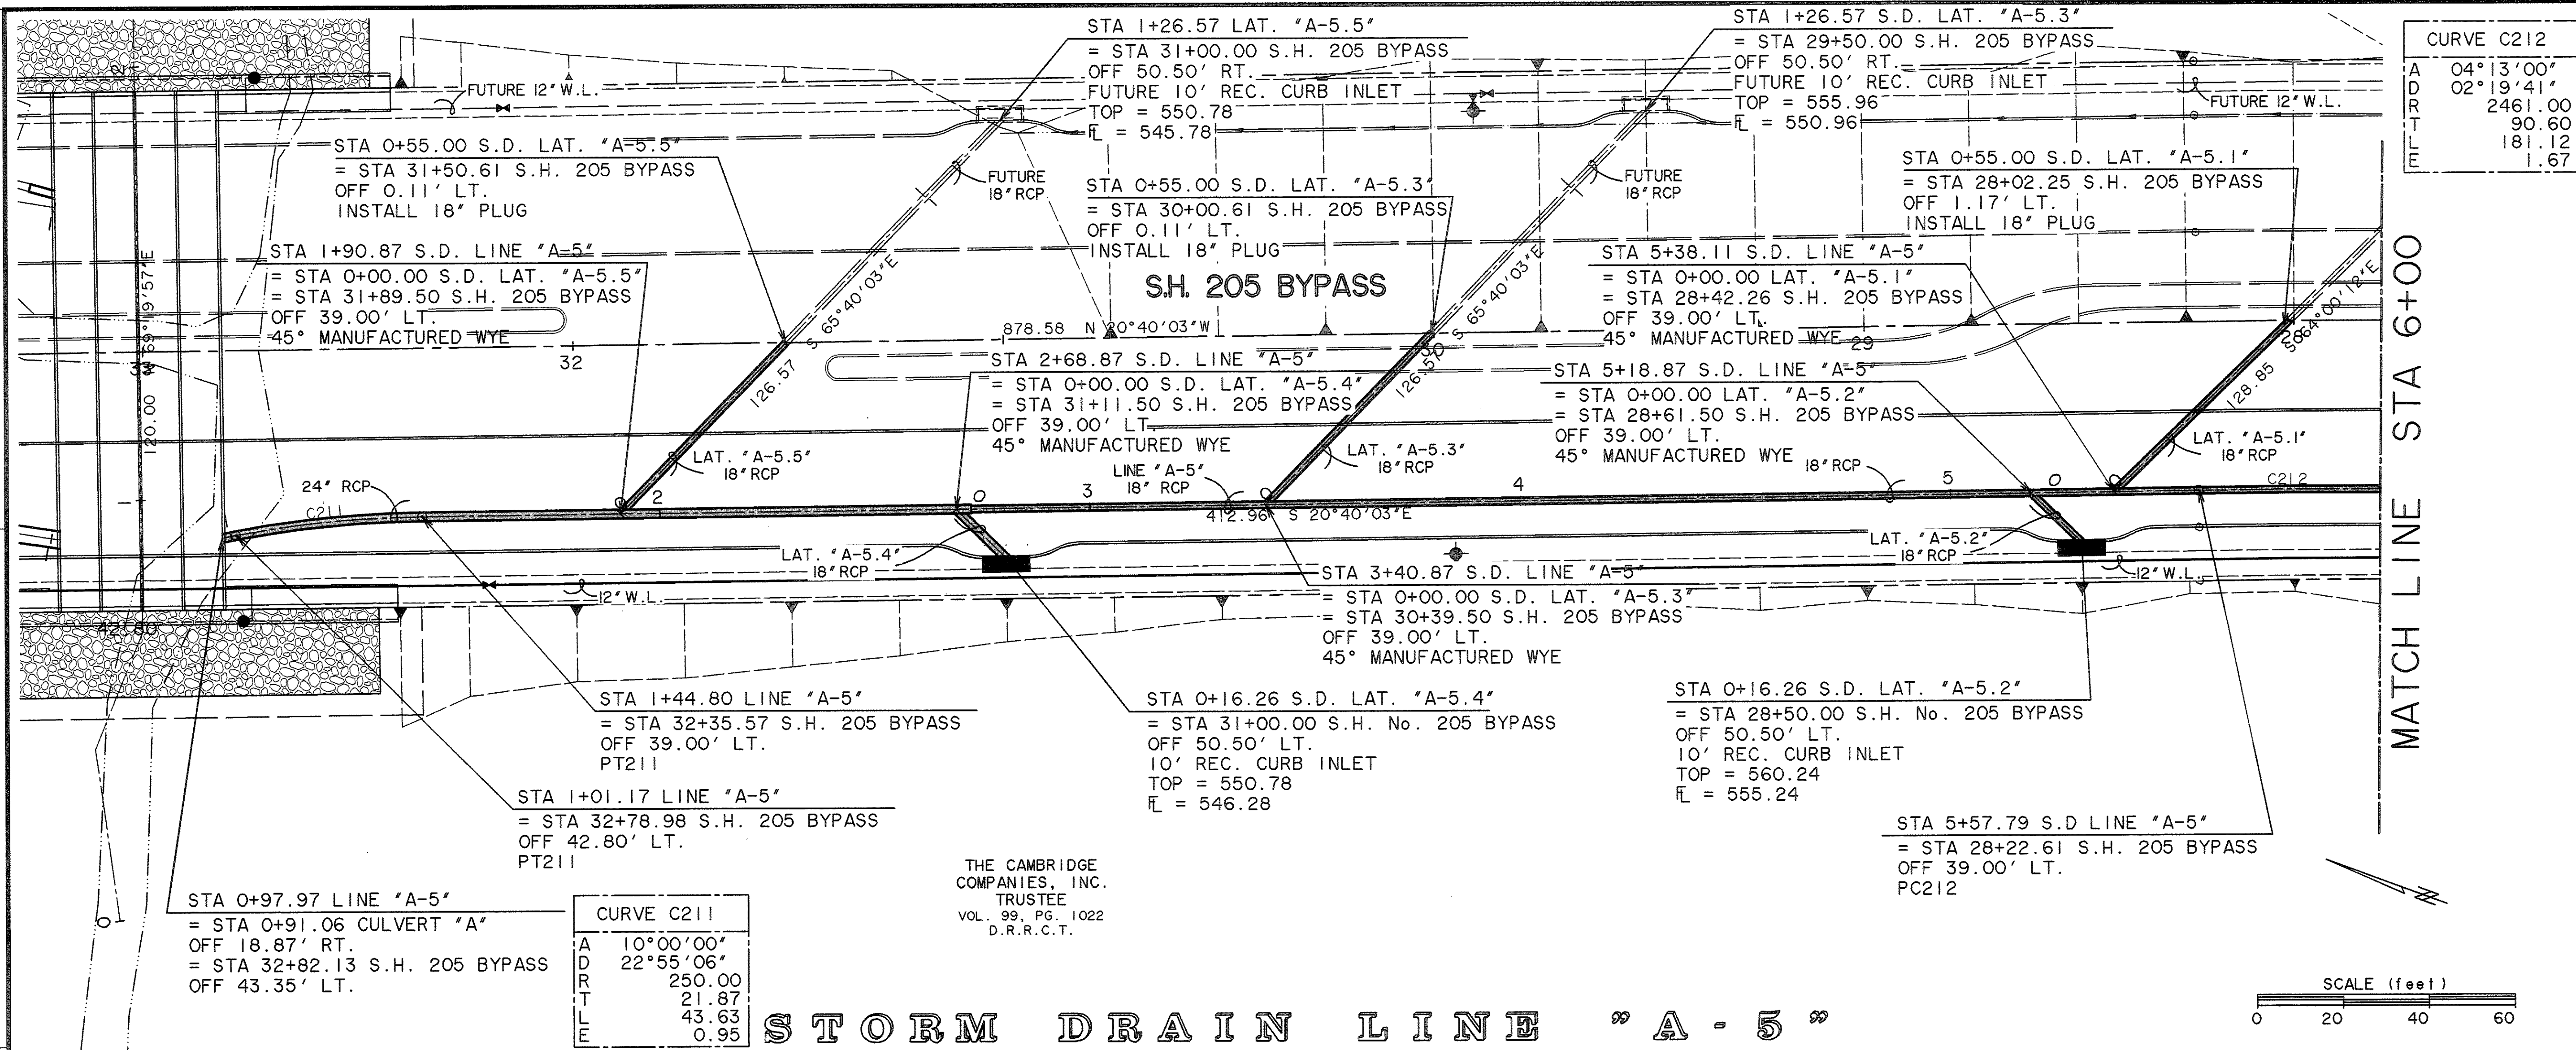



CURVE C212

A	04° 13' 00"
D	02° 19' 41"
R	2461.00
T	90.60
E	181.12
L	1.67

CURVE C211

A	10° 00' 00"
D	22° 55' 06"
R	250.00
T	21.87
E	43.63
L	0.95

THE CAMBRIDGE COMPANIES, INC. TRUSTEE  
VOL. 99, PG. 1022  
D.R.R.C.T.

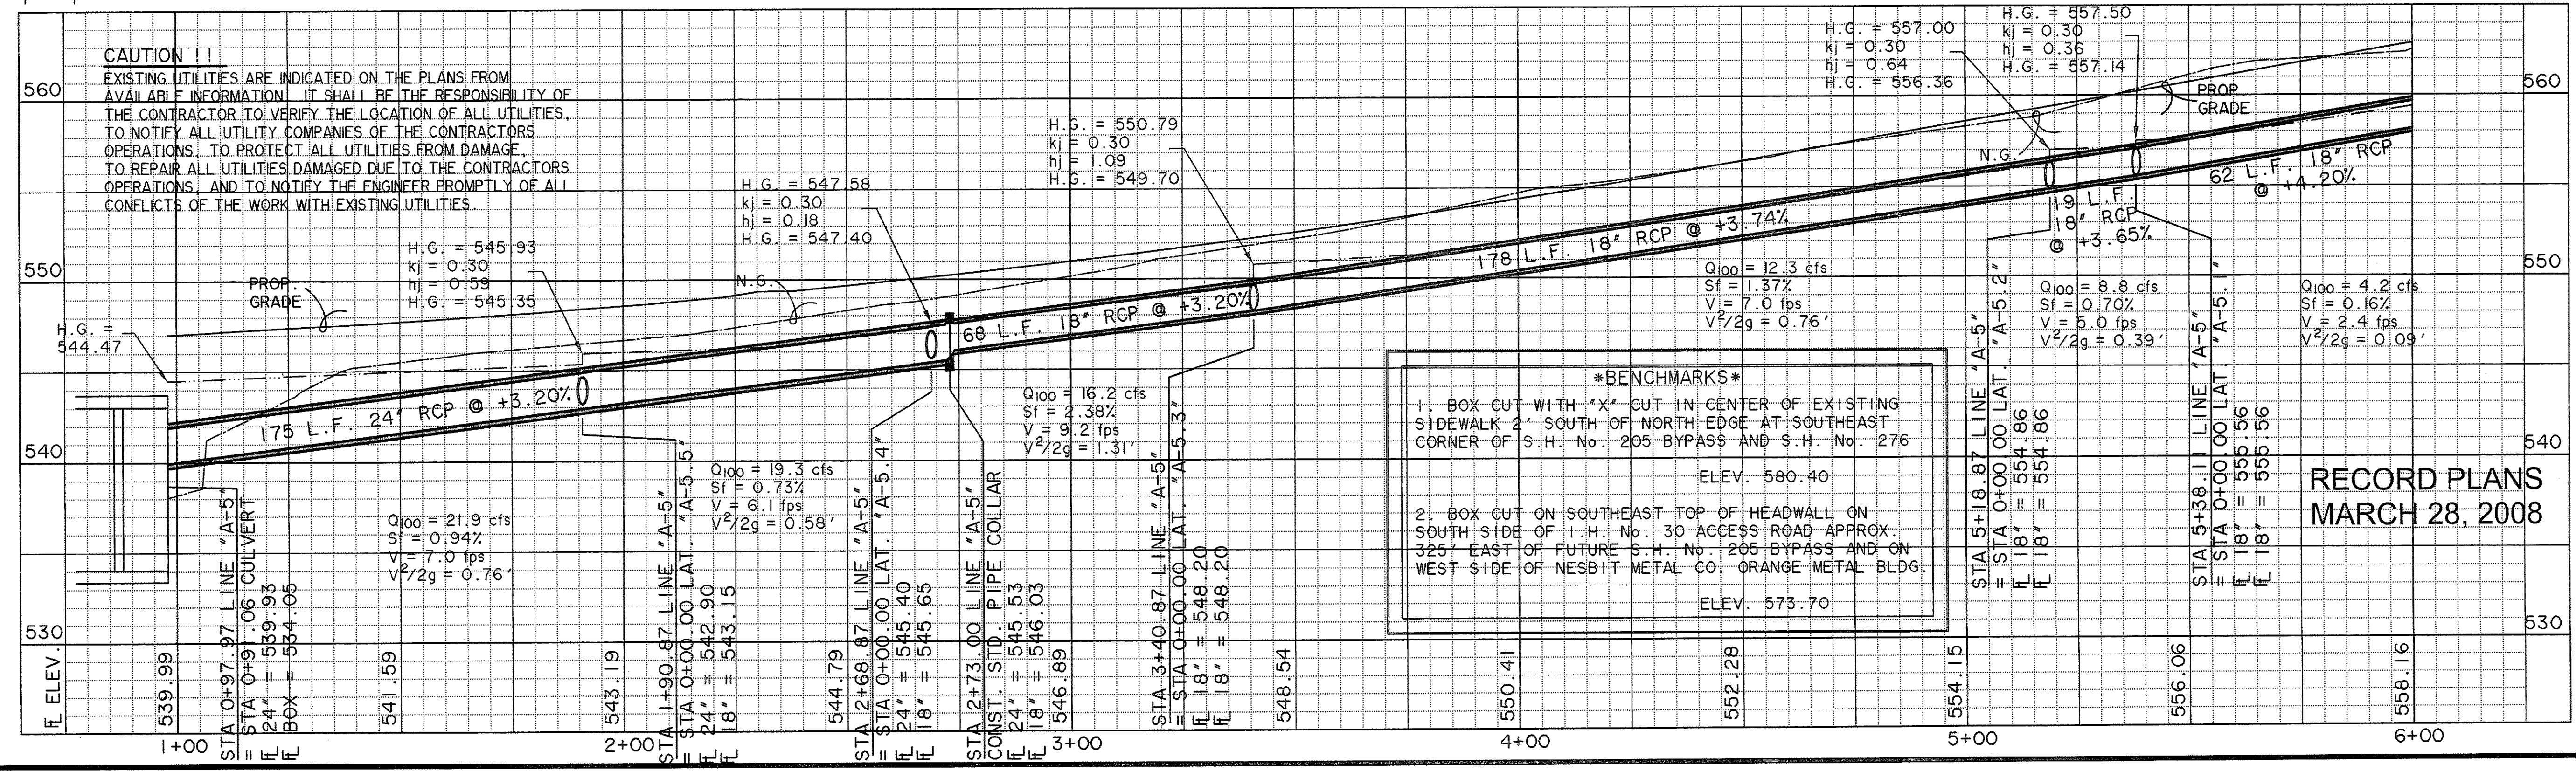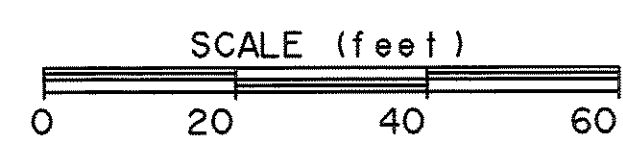


**CAUTION !!**  
EXISTING UTILITIES ARE INDICATED ON THE PLANS FROM AVAILABLE INFORMATION. IT SHALL BE THE RESPONSIBILITY OF THE CONTRACTOR TO VERIFY THE LOCATION OF ALL UTILITIES, TO NOTIFY ALL UTILITY COMPANIES OF THE CONTRACTOR'S OPERATIONS, TO PROTECT ALL UTILITIES FROM DAMAGE, TO REPAIR ALL UTILITIES DAMAGED DUE TO THE CONTRACTOR'S OPERATIONS, AND TO NOTIFY THE ENGINEER PROMPTLY OF ALL CONFLICTS OF THE WORK WITH EXISTING UTILITIES.


***BENCHMARKS***  
1. BOX CUT WITH "X" CUT IN CENTER OF EXISTING SIDEWALK 2' SOUTH OF NORTH EDGE AT SOUTHEAST CORNER OF S.H. No. 205 BYPASS AND S.H. No. 276  
ELEV. 580.40  
2. BOX CUT ON SOUTHEAST TOP OF HEADWALL ON SOUTH SIDE OF I.H. No. 30 ACCESS ROAD APPROX. 325' EAST OF FUTURE S.H. No. 205 BYPASS AND ON WEST SIDE OF NESBIT METAL CO. ORANGE METAL BLDG.  
ELEV. 573.70

RECORD PLANS  
MARCH 28, 2008


PREPARED BY:  
**VIA WIER & ASSOCIATES, INC.**  
ENGINEERS SURVEYORS LAND PLANNERS  
4300 BELTWAY PLACE SUITE 130 ARLINGTON, TEXAS 76018 METRO (817) 467-7700  
1390 U.S. HIGHWAY 287 N. SUITE 101 MANFELD, TEXAS 76063 METRO (817) 477-6700  
6849 ELM STREET FRISCO, TEXAS 75034 METRO (214) 387-8000  
www.viawier.com

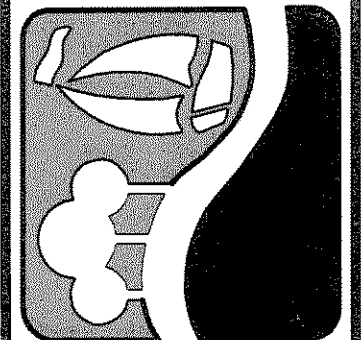

PHASE I S.H. 205 BYPASS  
FROM S.H. 276 TO INTERSTATE 30  
STORM DRAIN LINE "A-5"  
PLAN & PROFILE  
STA 1+00 TO 6+00

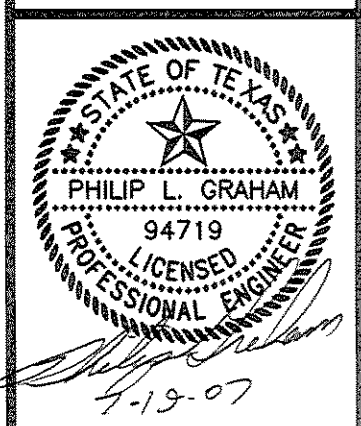

COPYRIGHT ©  
WIER & ASSOCIATES, INC.  
LAST SHEET EDIT  
DATE 07-19-2007  
WA# 04141  
SHEET NO.  
D108

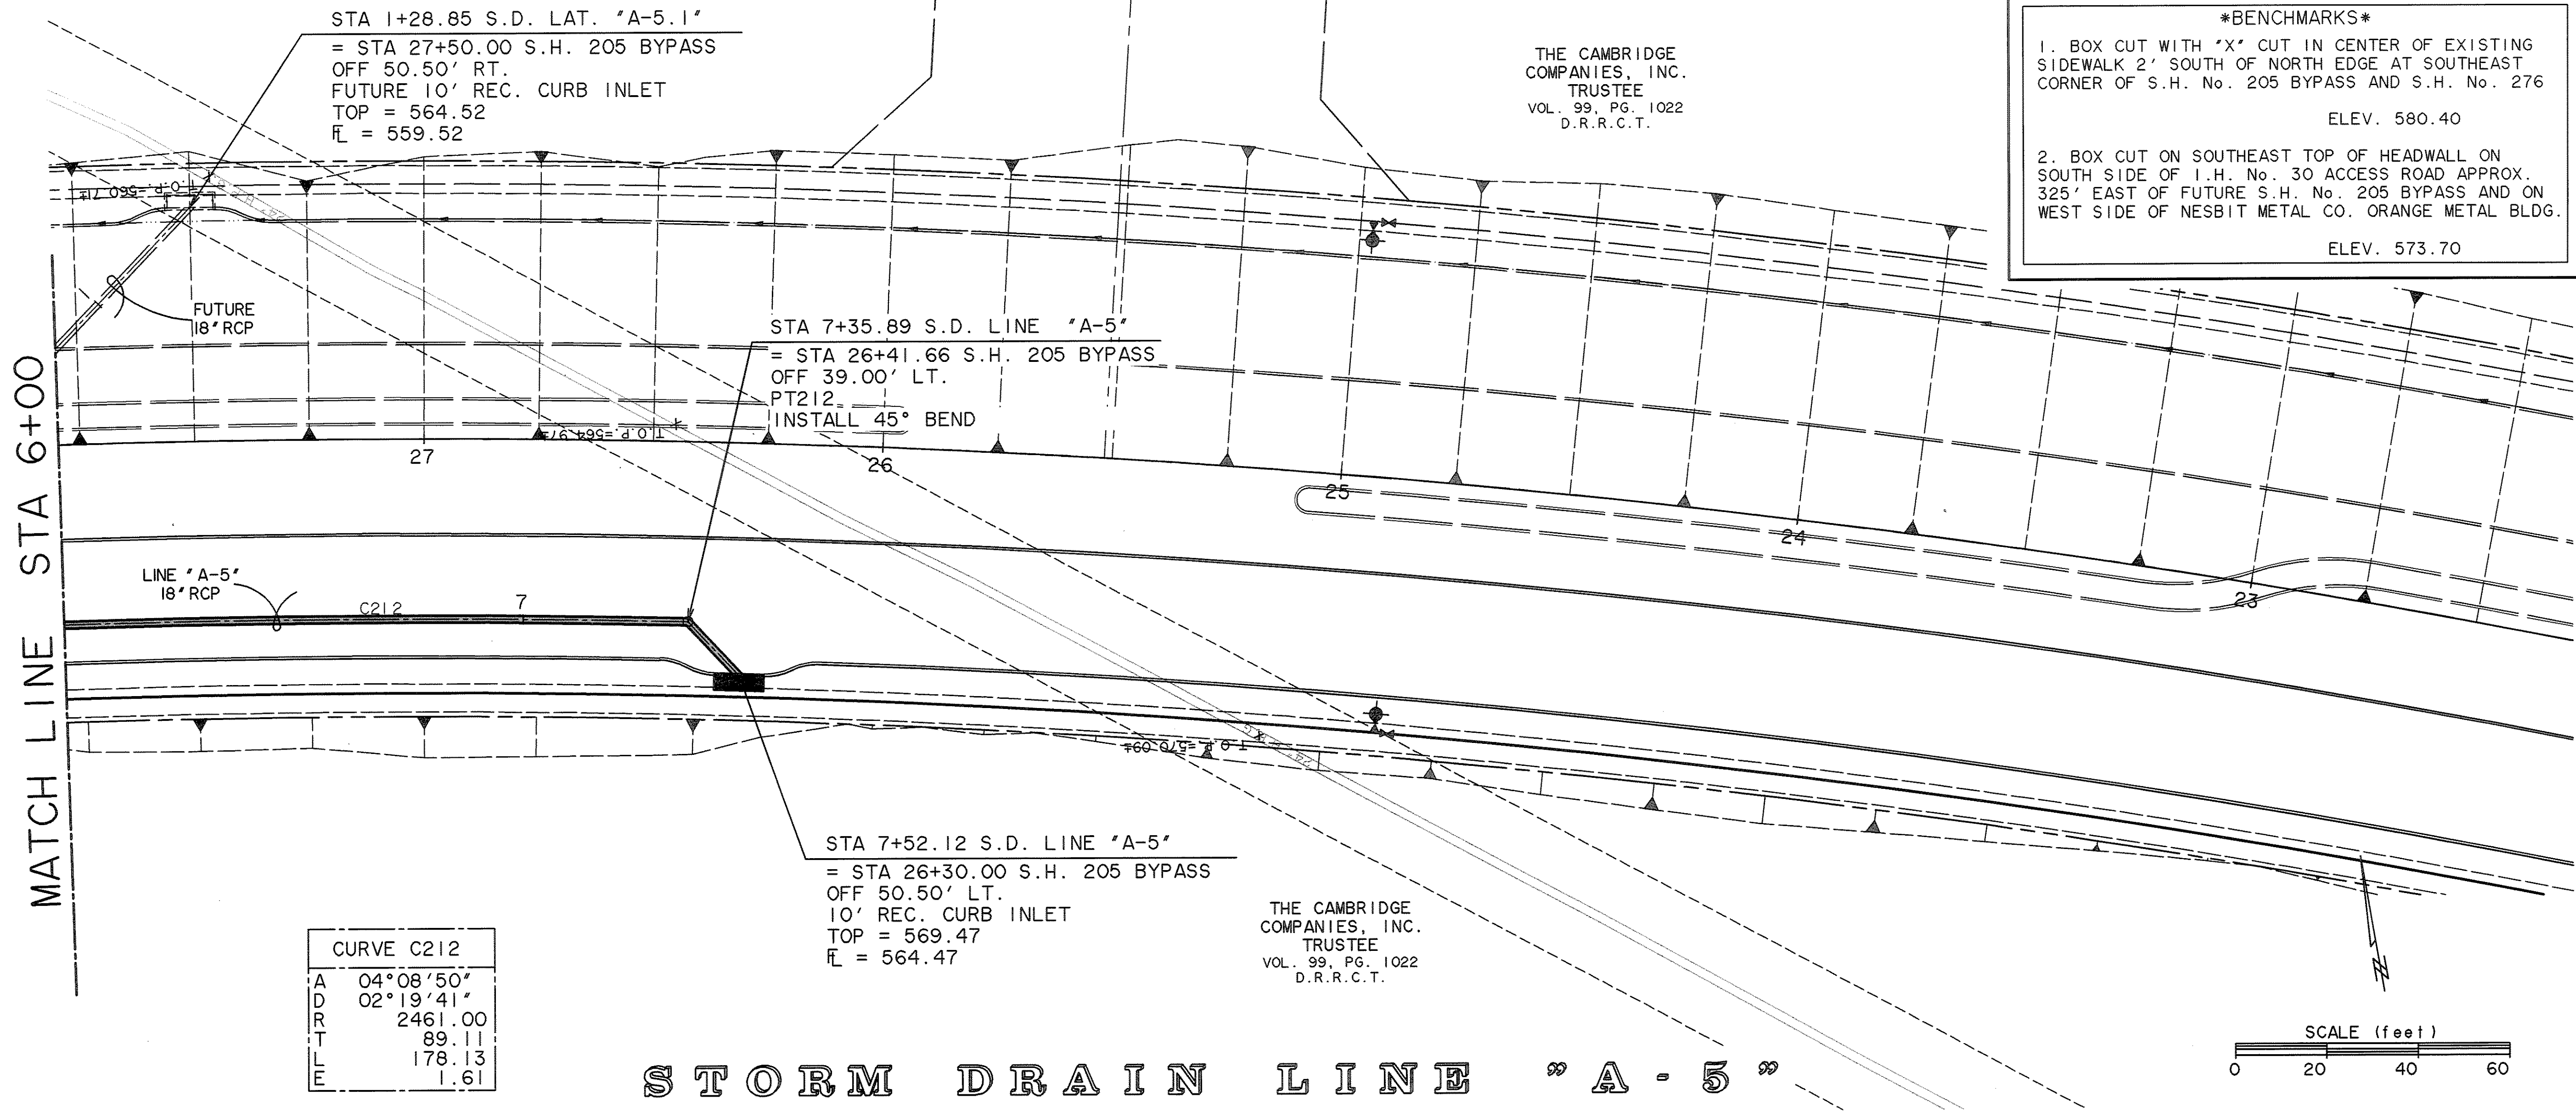

***BENCHMARK***

1. BOX CUT WITH "X" CUT IN CENTER OF EXISTING SIDEWALK 2' SOUTH OF NORTH EDGE AT SOUTHEAST CORNER OF S.H. No. 205 BYPASS AND S.H. No. 276  
ELEV. 580.40



2. BOX CUT ON SOUTHEAST TOP OF HEADWALL ON SOUTH SIDE OF I.H. No. 30 ACCESS ROAD APPROX. 325' EAST OF FUTURE S.H. No. 205 BYPASS AND ON WEST SIDE OF NESBIT METAL CO. ORANGE METAL BLDG.  
ELEV. 573.70

THE CAMBRIDGE COMPANIES, INC.  
TRUSTEE  
VOL. 99, PG. 1022  
D.R.R.C.T.

THE CAMBRIDGE COMPANIES, INC.  
TRUSTEE  
VOL. 99, PG. 1022  
D.R.R.C.T.


CURVE C212	
A	04°08'50"
D	02°19'41"
RT	2461.00
T	89.11
E	178.13
L	1.61

**STORM DRAIN LINE "A-5"**

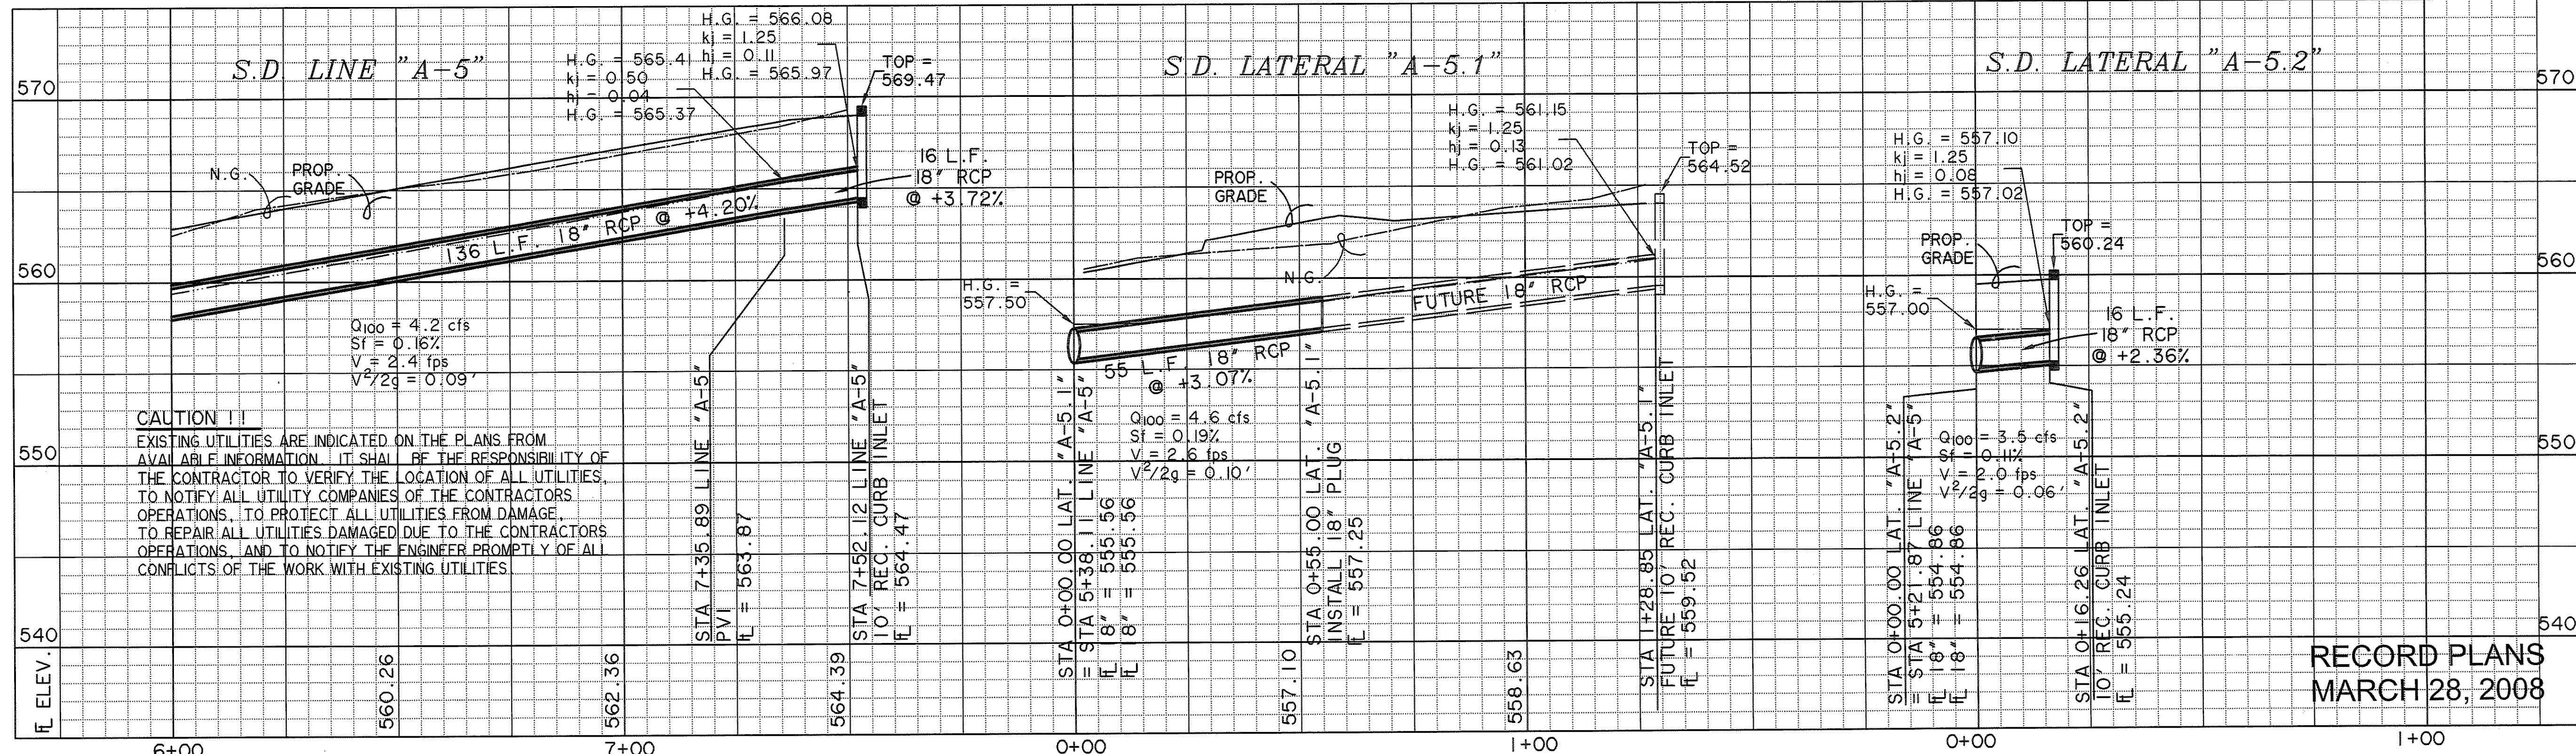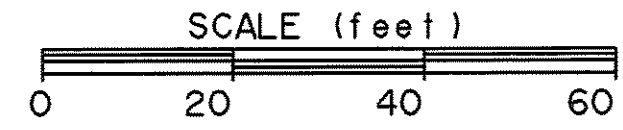


**CAUTION !!**  
EXISTING UTILITIES ARE INDICATED ON THE PLANS FROM AVAILABLE INFORMATION. IT SHALL BE THE RESPONSIBILITY OF THE CONTRACTOR TO VERIFY THE LOCATION OF ALL UTILITIES, TO NOTIFY ALL UTILITY COMPANIES OF THE CONTRACTORS OPERATIONS, TO PROTECT ALL UTILITIES FROM DAMAGE, TO REPAIR ALL UTILITIES DAMAGED DUE TO THE CONTRACTORS OPERATIONS, AND TO NOTIFY THE ENGINEER PROMPTLY OF ALL CONFLICTS OF THE WORK WITH EXISTING UTILITIES.

PREPARED BY:  
**VIA WIER & ASSOCIATES, INC.**  
ENGINEERS SURVEYORS LAND PLANNERS  
4300 BELTWAY PLACE SUITE 130 ARLINGTON, TEXAS 76018 METRO (817)467-7700  
1390 U.S. HIGHWAY 287 N. SUITE 101 WANSFELD, TEXAS 76063 METRO (817)477-8700  
6849 ELM STREET PRISCO, TEXAS 75034 METRO (214)387-8000  
www.via-wier.com

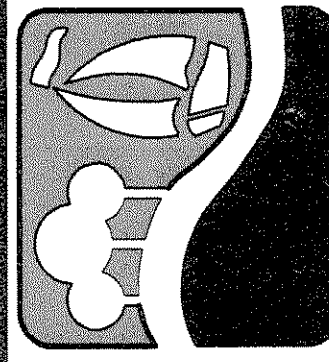

**PHASE I S.H. 205 BYPASS  
FROM S.H. 276 TO INTERSTATE 30  
STORM DRAIN LINE "A-5"  
PLAN & PROFILE  
STA 6+00 TO END**

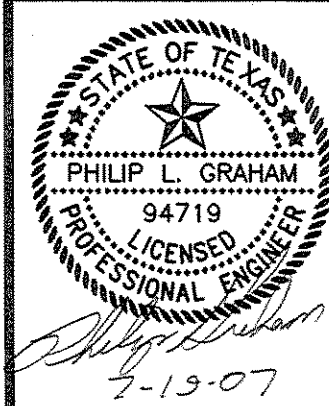

RECORD PLANS  
MARCH 28, 2008


COPYRIGHT ©  
WIER & ASSOCIATES, INC.  
LAST SHEET EDIT  
DATE 07-19-2007  
WA# 04141  
SHEET NO.  
D109

10-31-07	REDESIGNED S.H. 276 CONNECTION & CHANGED S.H. 205 BYPASS TO CITY SECTION	JRA	
NO.	DATE	DESCRIPTION	BY

**CAUTION !!**  
 EXISTING UTILITIES ARE INDICATED ON THE PLANS FROM AVAILABLE INFORMATION. IT SHALL BE THE RESPONSIBILITY OF THE CONTRACTOR TO VERIFY THE LOCATION OF ALL UTILITIES, TO NOTIFY ALL UTILITY COMPANIES OF THE CONTRACTORS OPERATIONS, TO PROTECT ALL UTILITIES FROM DAMAGE, TO REPAIR ALL UTILITIES DAMAGED DUE TO THE CONTRACTORS OPERATIONS, AND TO NOTIFY THE ENGINEER PROMPTLY OF ALL CONFLICTS OF THE WORK WITH EXISTING UTILITIES.

***BENCHMARK***  
 1. BOX CUT WITH "X" CUT IN CENTER OF EXISTING SIDEWALK 2' SOUTH OF NORTH EDGE AT SOUTHEAST CORNER OF S.H. No. 205 BYPASS AND S.H. No. 276  
 ELEV. 580.40  
 2. BOX CUT ON SOUTHEAST TOP OF HEADWALL ON SOUTH SIDE OF I.H. No. 30 ACCESS ROAD APPROX. 325' EAST OF FUTURE S.H. No. 205 BYPASS AND ON WEST SIDE OF NESBIT METAL CO. ORANGE METAL BLDG.  
 ELEV. 573.70

THE CAMBRIDGE COMPANIES, INC. TRUSTEE  
 VOL. 99, PG. 1022  
 D.R.R.C.T.

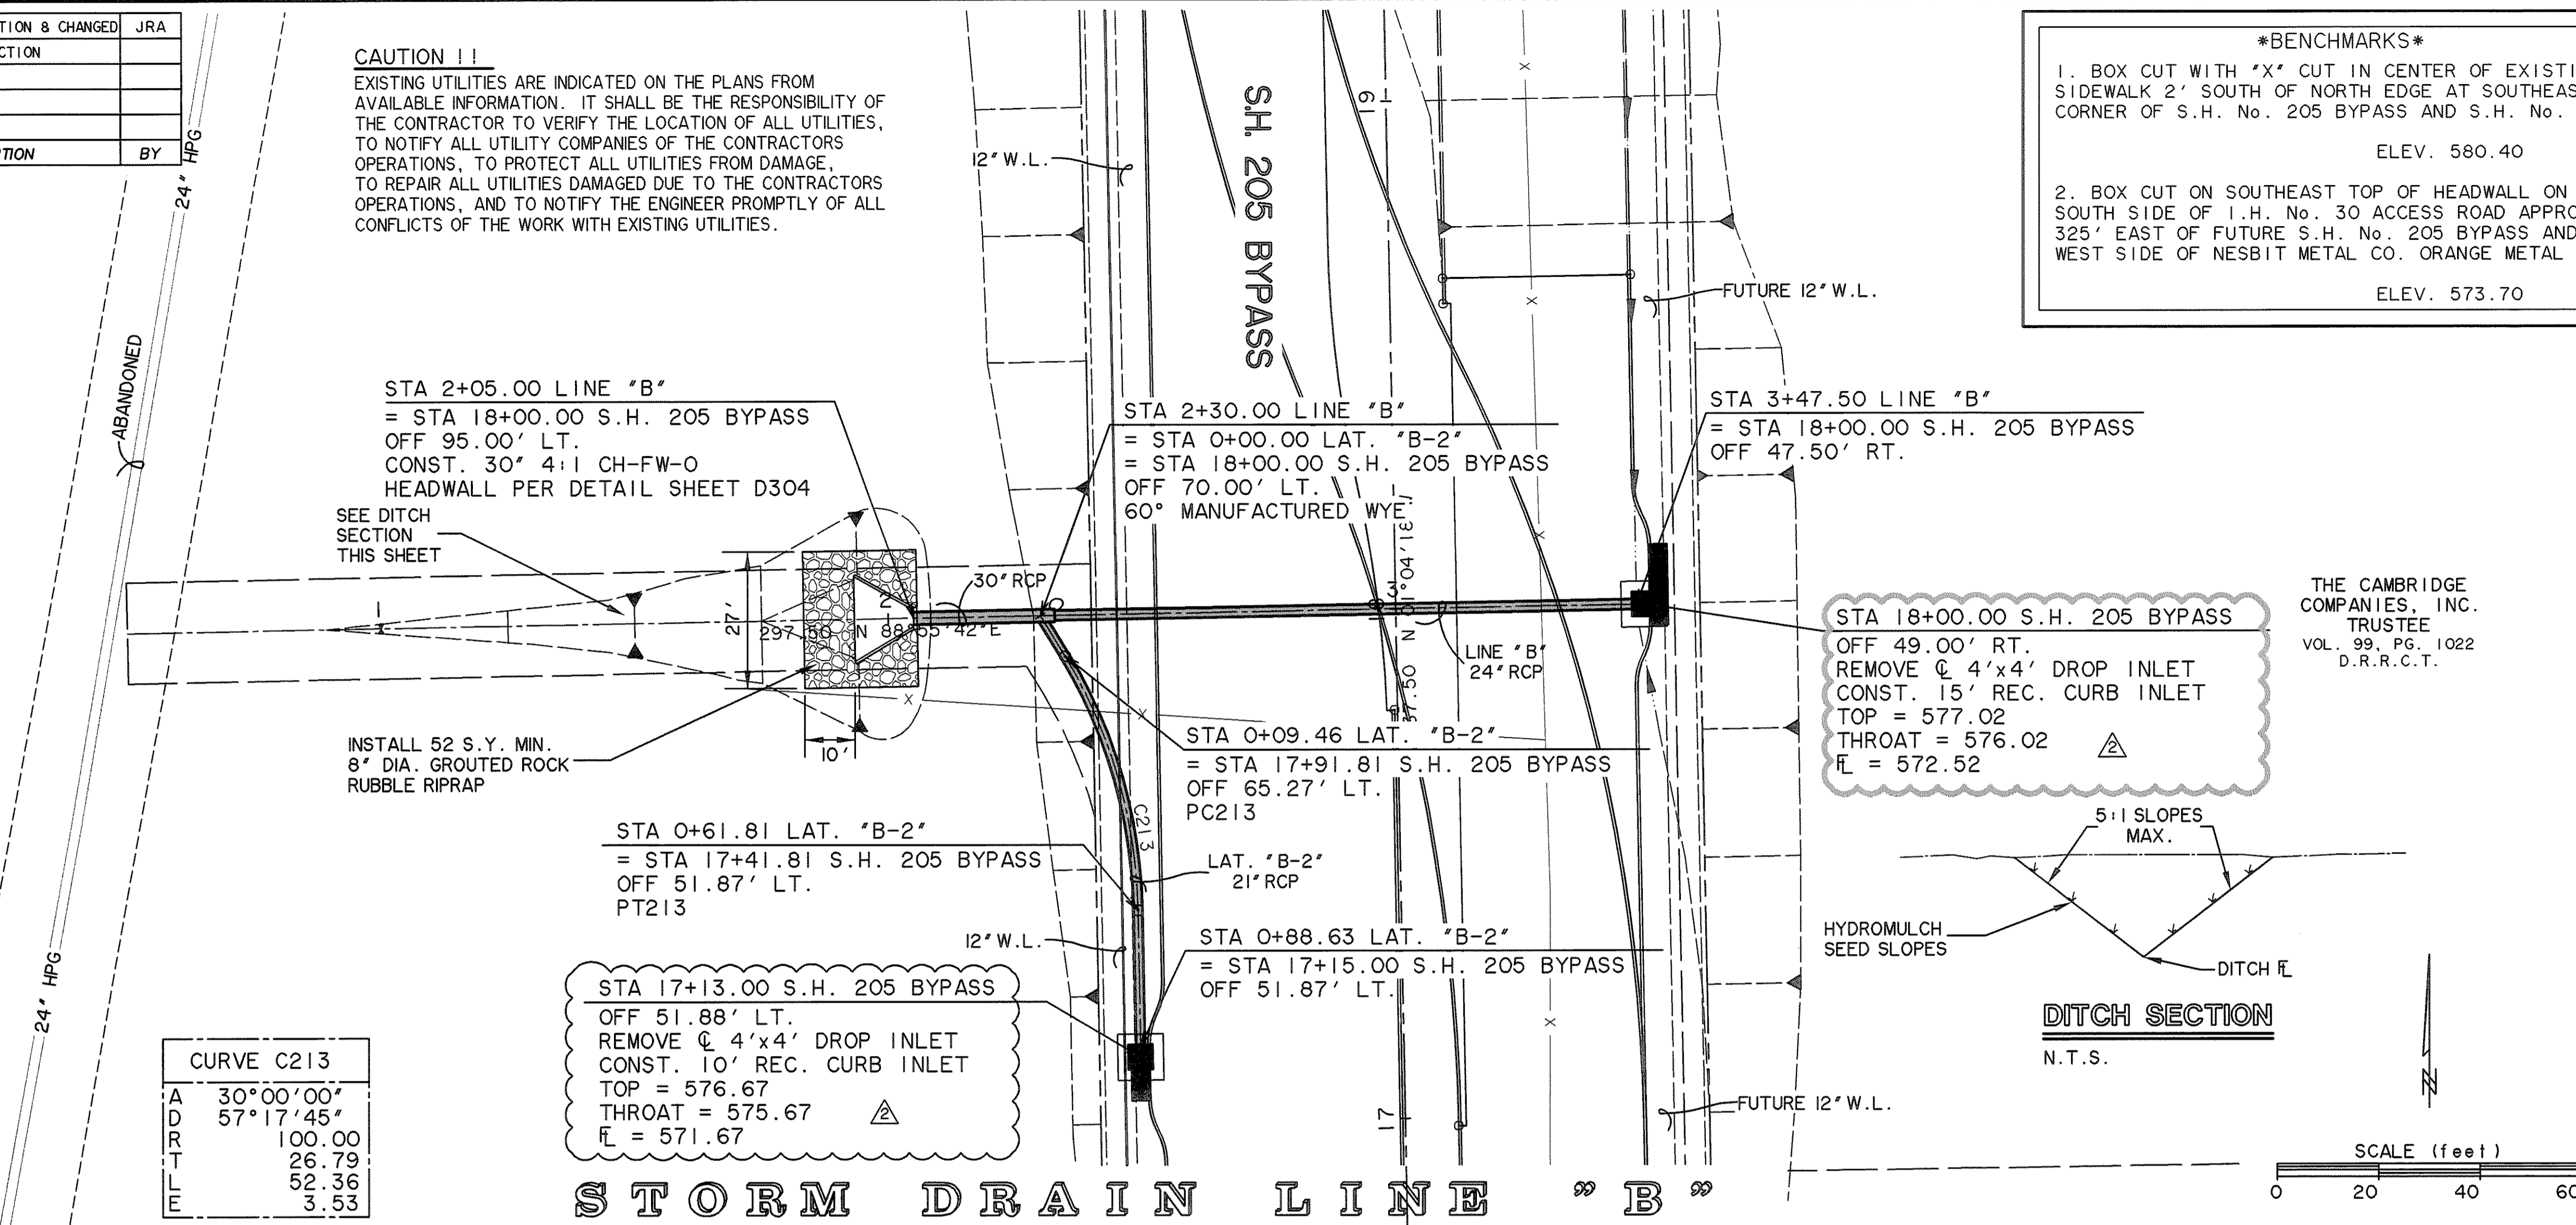


**CURVE C213**

A	30°00'00"
D	57°17'45"
R	100.00
T	26.79
M	52.36
E	3.53


STA 17+13.00 S.H. 205 BYPASS  
 OFF 51.88' LT.  
 REMOVE 4'x4' DROP INLET  
 CONST. 10' REC. CURB INLET  
 TOP = 576.67  
 THROAT = 575.67  
 FL = 571.67

STA 18+00.00 S.H. 205 BYPASS  
 OFF 49.00' RT.  
 REMOVE 4'x4' DROP INLET  
 CONST. 15' REC. CURB INLET  
 TOP = 577.02  
 THROAT = 576.02  
 FL = 572.52

THE CAMBRIDGE COMPANIES, INC. TRUSTEE  
 VOL. 99, PG. 1022  
 D.R.R.C.T.

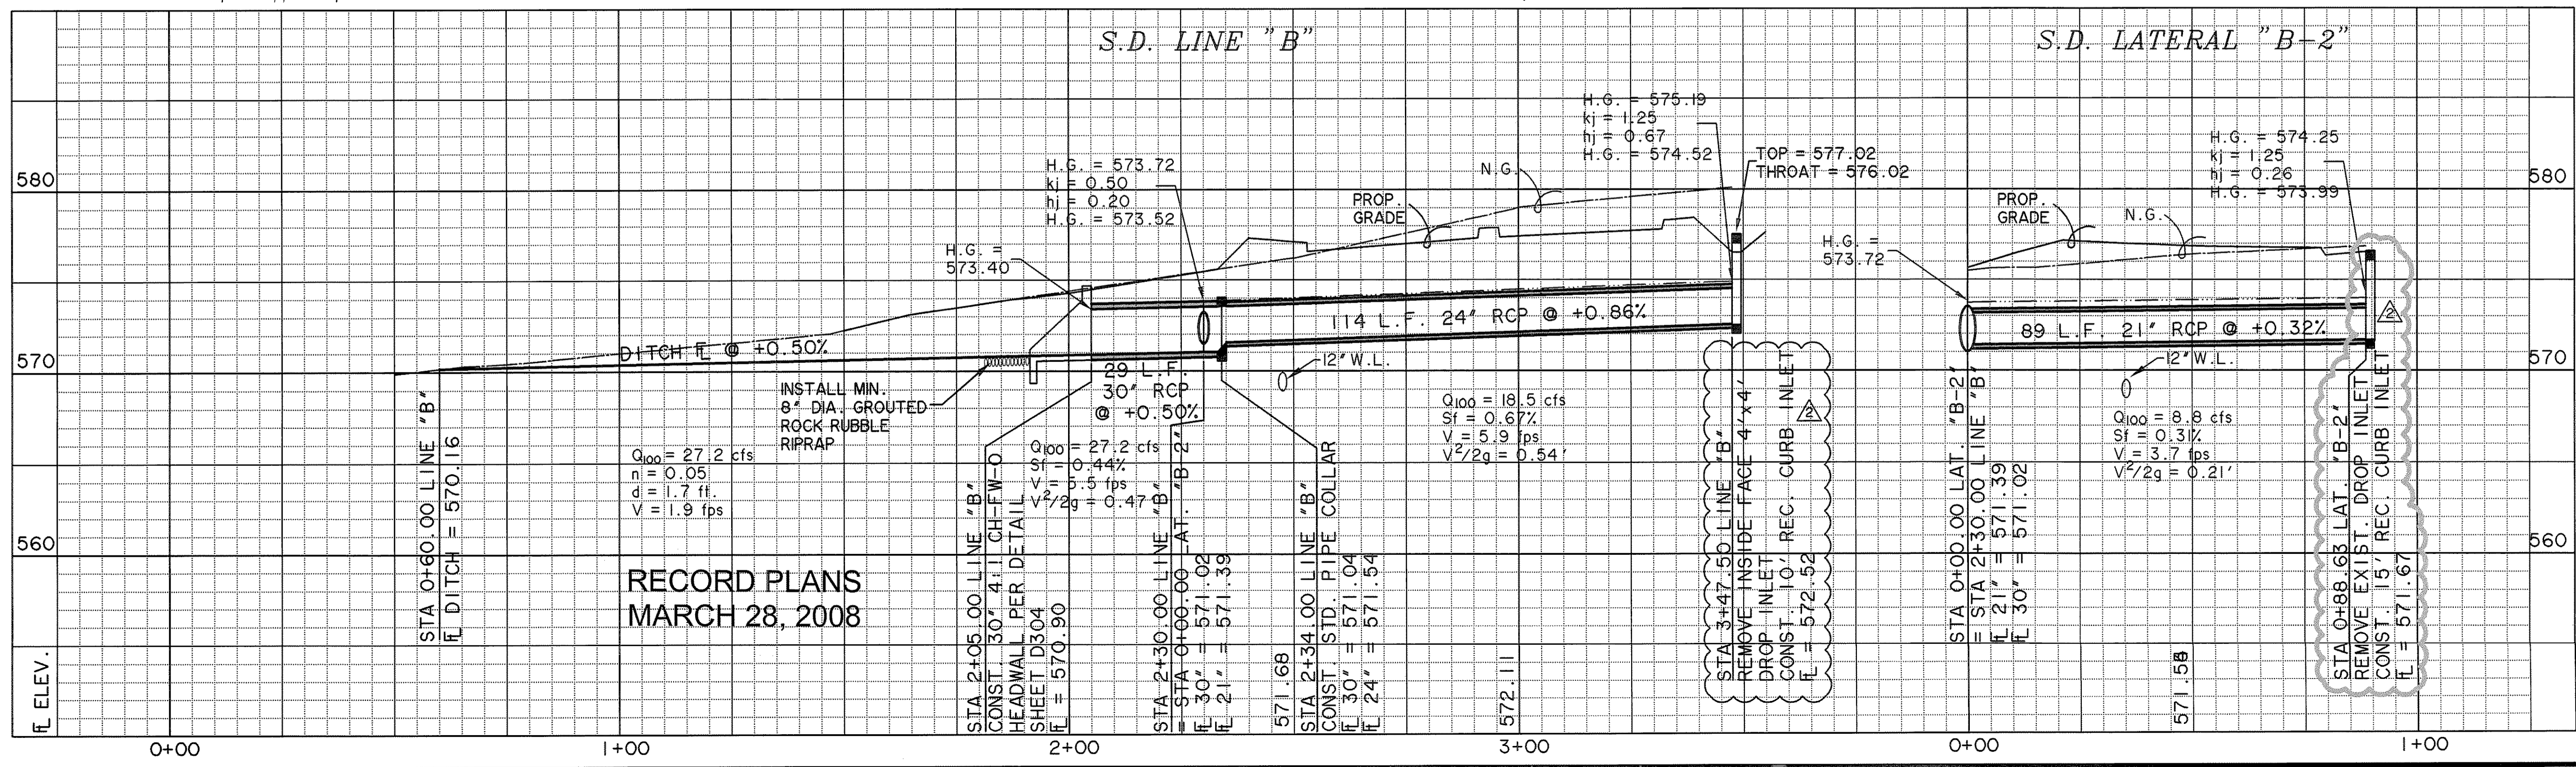

PREPARED BY:  
**WIER & ASSOCIATES, INC.**  
 ENGINEERS SURVEYORS LAND PLANNERS  
 4300 BELWAY PLACE SUITE 130 ARLINGTON, TEXAS 76018 METRO (817)467-7700  
 1380 U.S. HIGHWAY 287 N. SUITE 107 MANSFIELD, TEXAS 76063 METRO (817)477-6700  
 6849 ELM STREET FRSO, TEXAS 75034 METRO (214)397-8000  
 www.wierassociates.com

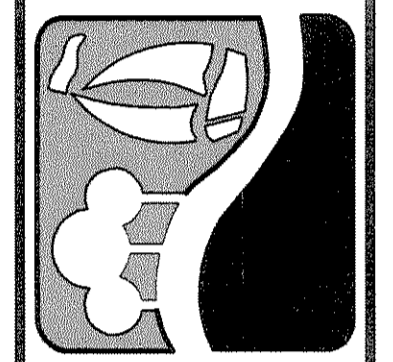

PHASE I S.H. 205 BYPASS  
 FROM S.H. 276 TO INTERSTATE 30  
**STORM DRAIN LINE "B"**  
 PLAN & PROFILE  
 STA 0+00 TO END


STATE OF TEXAS  
 PHILIP L. GRAHAM  
 94719  
 LICENSED PROFESSIONAL ENGINEER  
 4/1/30/2007  
 COPYRIGHT ©  
 WIER & ASSOCIATES, INC.  
 LAST SHEET EDIT  
 DATE: 11-30-2007  
 WA# 04141  
**SHEET NO. D110**

**CAUTION !!**  
 EXISTING UTILITIES ARE INDICATED ON THE PLANS FROM AVAILABLE INFORMATION. IT SHALL BE THE RESPONSIBILITY OF THE CONTRACTOR TO VERIFY THE LOCATION OF ALL UTILITIES, TO NOTIFY ALL UTILITY COMPANIES OF THE CONTRACTORS OPERATIONS, TO PROTECT ALL UTILITIES FROM DAMAGE, TO REPAIR ALL UTILITIES DAMAGED DUE TO THE CONTRACTORS OPERATIONS, AND TO NOTIFY THE ENGINEER PROMPTLY OF ALL CONFLICTS OF THE WORK WITH EXISTING UTILITIES.

THE CAMBRIDGE COMPANIES, INC. TRUSTEE  
 VOL. 99, PG. 1022  
 D.R.R.C.T.

50' TXU GAS COMPANY EASEMENT  
 24" H.P.G.

15' UTILITY EASEMENT

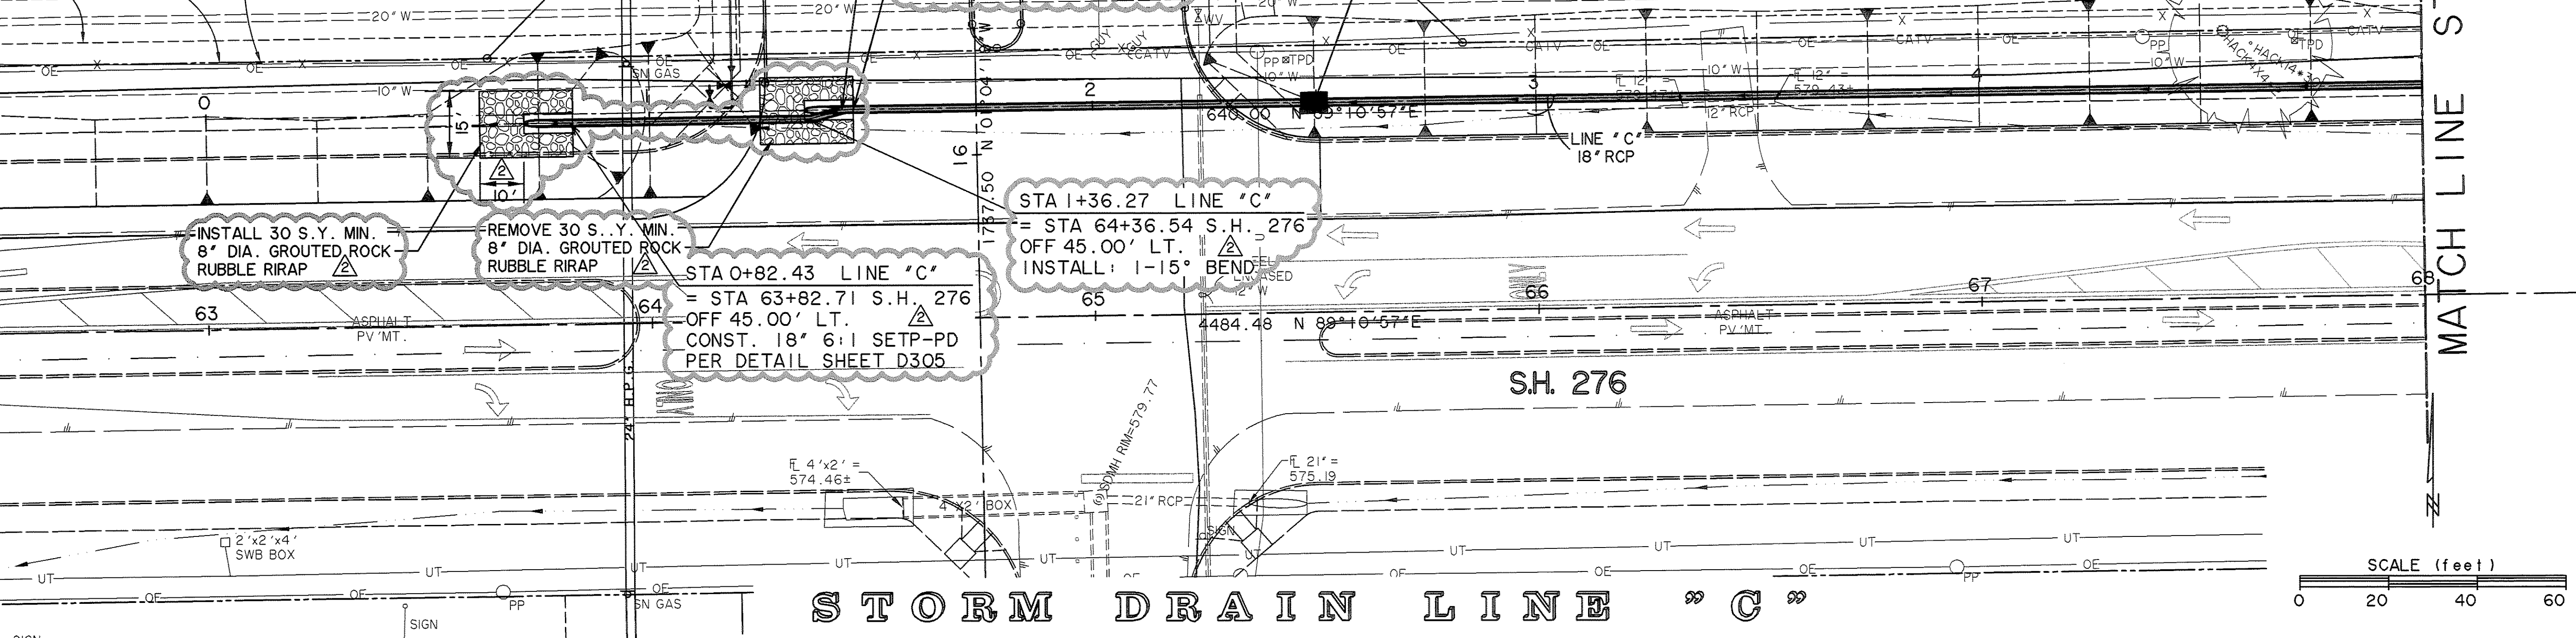


NO.	DATE	DESCRIPTION	BY
10-31-07		REDESIGNED S.H. 276 CONNECTION & CHANGED S.H. 205 BYPASS TO CITY SECTION	JRA

***BENCHMARK***


- BOX CUT WITH 'X' CUT IN CENTER OF EXISTING SIDEWALK 2' SOUTH OF NORTH EDGE AT SOUTHEAST CORNER OF S.H. No. 205 BYPASS AND S.H. No. 276  
 ELEV. 580.40
- BOX CUT ON SOUTHEAST TOP OF HEADWALL ON SOUTH SIDE OF I.H. No. 30 ACCESS ROAD APPROX. 325' EAST OF FUTURE S.H. No. 205 BYPASS AND ON WEST SIDE OF NESBIT METAL CO. ORANGE METAL BLDG.  
 ELEV. 573.70

THE CAMBRIDGE COMPANIES, INC. TRUSTEE  
 VOL. 99, PG. 1022  
 D.R.R.C.T.

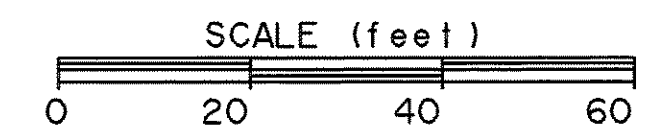


**STORM DRAIN LINE "C"**

MATCH LINE STA 5+00

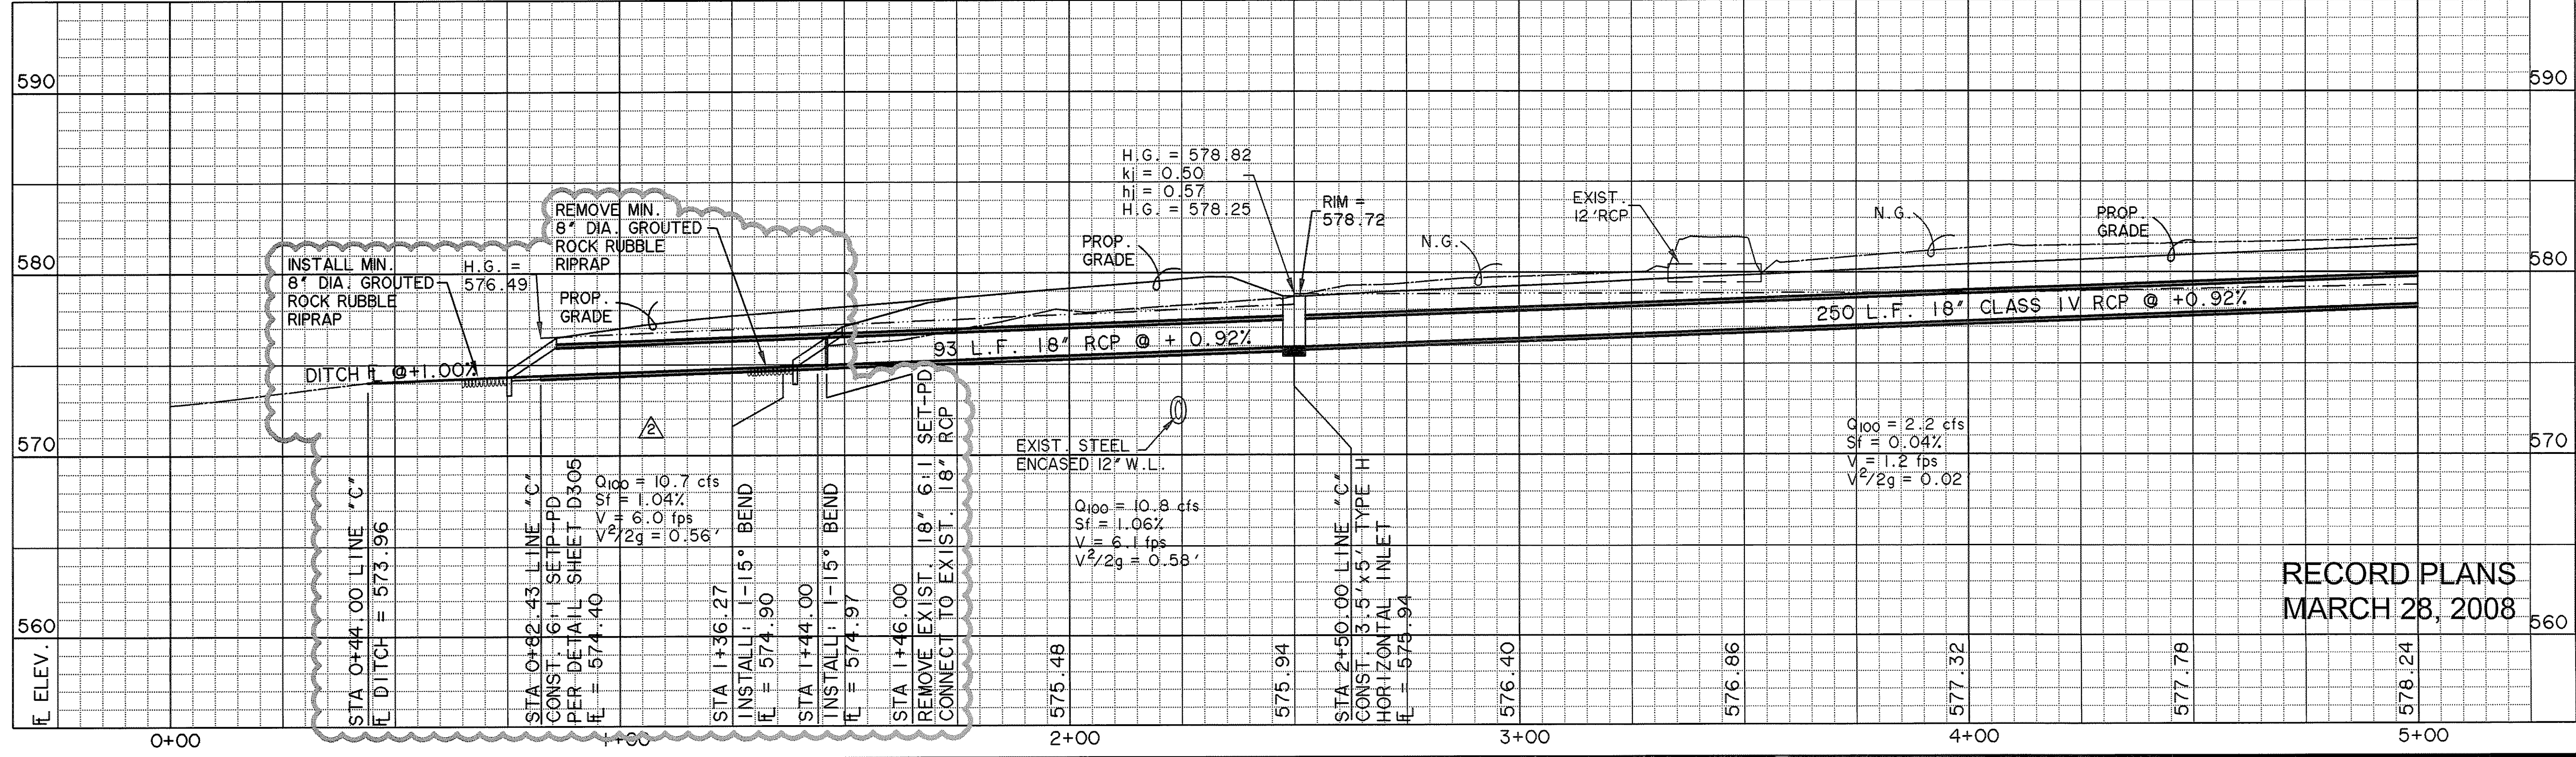


RECORD PLANS  
 MARCH 28, 2008

PREPARED BY:  
**WIER & ASSOCIATES, INC.**  
 ENGINEERS SURVEYORS LAND PLANNERS  
 4300 BELWAY PLACE SUITE 130 ARLINGTON, TEXAS 76018 METRO (817)467-7700  
 1380 U.S. HIGHWAY 287 N. SUITE 101 MANSFIELD, TEXAS 76063 METRO (817)477-8700  
 6848 ELM STREET FRODO, TEXAS 75034 METRO (214)397-8000  
 www.wierassociates.com

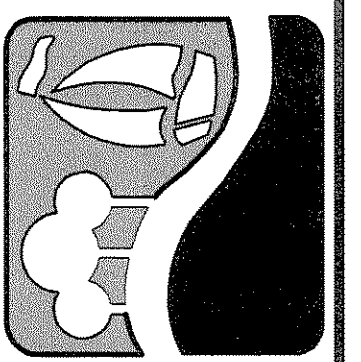

PHASE I S.H. 205 BYPASS  
 FROM S.H. 276 TO INTERSTATE 30  
**STORM DRAIN LINE "C"**  
 PLAN & PROFILE  
 STA 0+00 TO 5+00

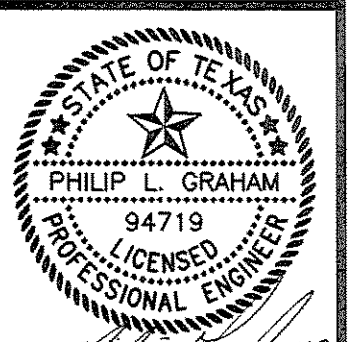

COPYRIGHT ©  
 WIER & ASSOCIATES, INC.  
 LAST SHEET EDIT  
 DATE 11-30-2007  
 WA# 04141  
**SHEET NO. D111**


THE CAMBRIDGE COMPANIES, INC. TRUSTEE  
VOL. 99, PG. 1022  
D.R.R.C.T.

PNEUMA VENTURES, LTD.  
VOL. 2924, PG. 314  
D.R.R.C.T.


BLACKLAND WATER SUPPLY  
VOL. 77, PG. 420  
D.R.R.C.T.

***BENCHMARK***  
1. BOX CUT WITH "X" CUT IN CENTER OF EXISTING SIDEWALK 2' SOUTH OF NORTH EDGE AT SOUTHEAST CORNER OF S.H. No. 205 BYPASS AND S.H. No. 276  
ELEV. 580.40  
2. BOX CUT ON SOUTHEAST TOP OF HEADWALL ON SOUTH SIDE OF I.H. No. 30 ACCESS ROAD APPROX. 325' EAST OF FUTURE S.H. No. 205 BYPASS AND ON WEST SIDE OF NESBIT METAL CO. ORANGE METAL BLDG.  
ELEV. 573.70

MATCH LINE STA 5+00

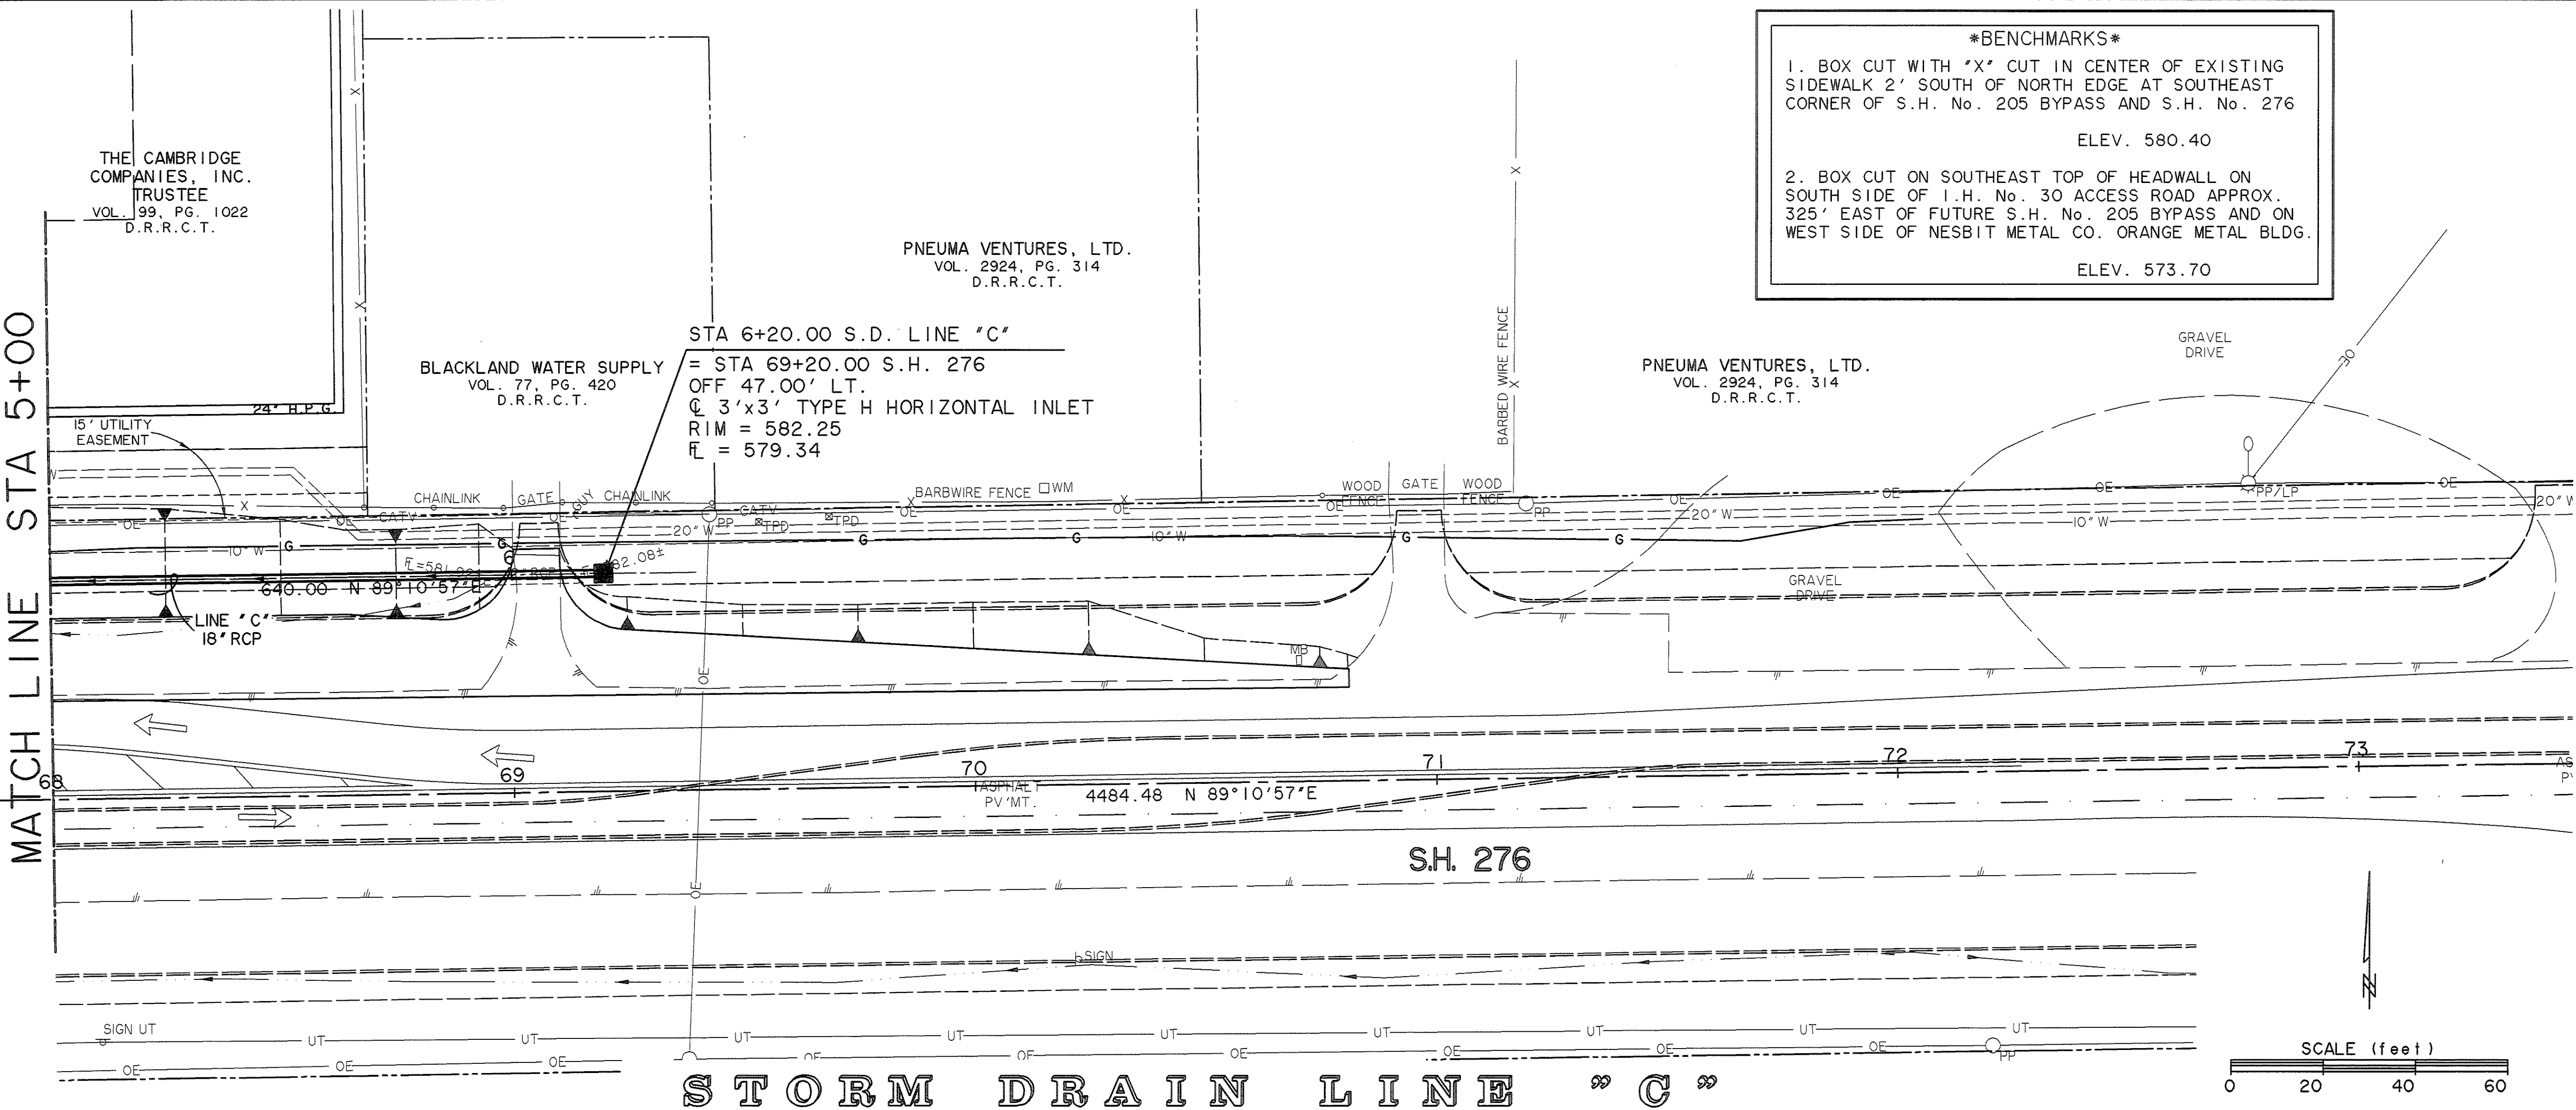


**STORM DRAIN LINE "C"**

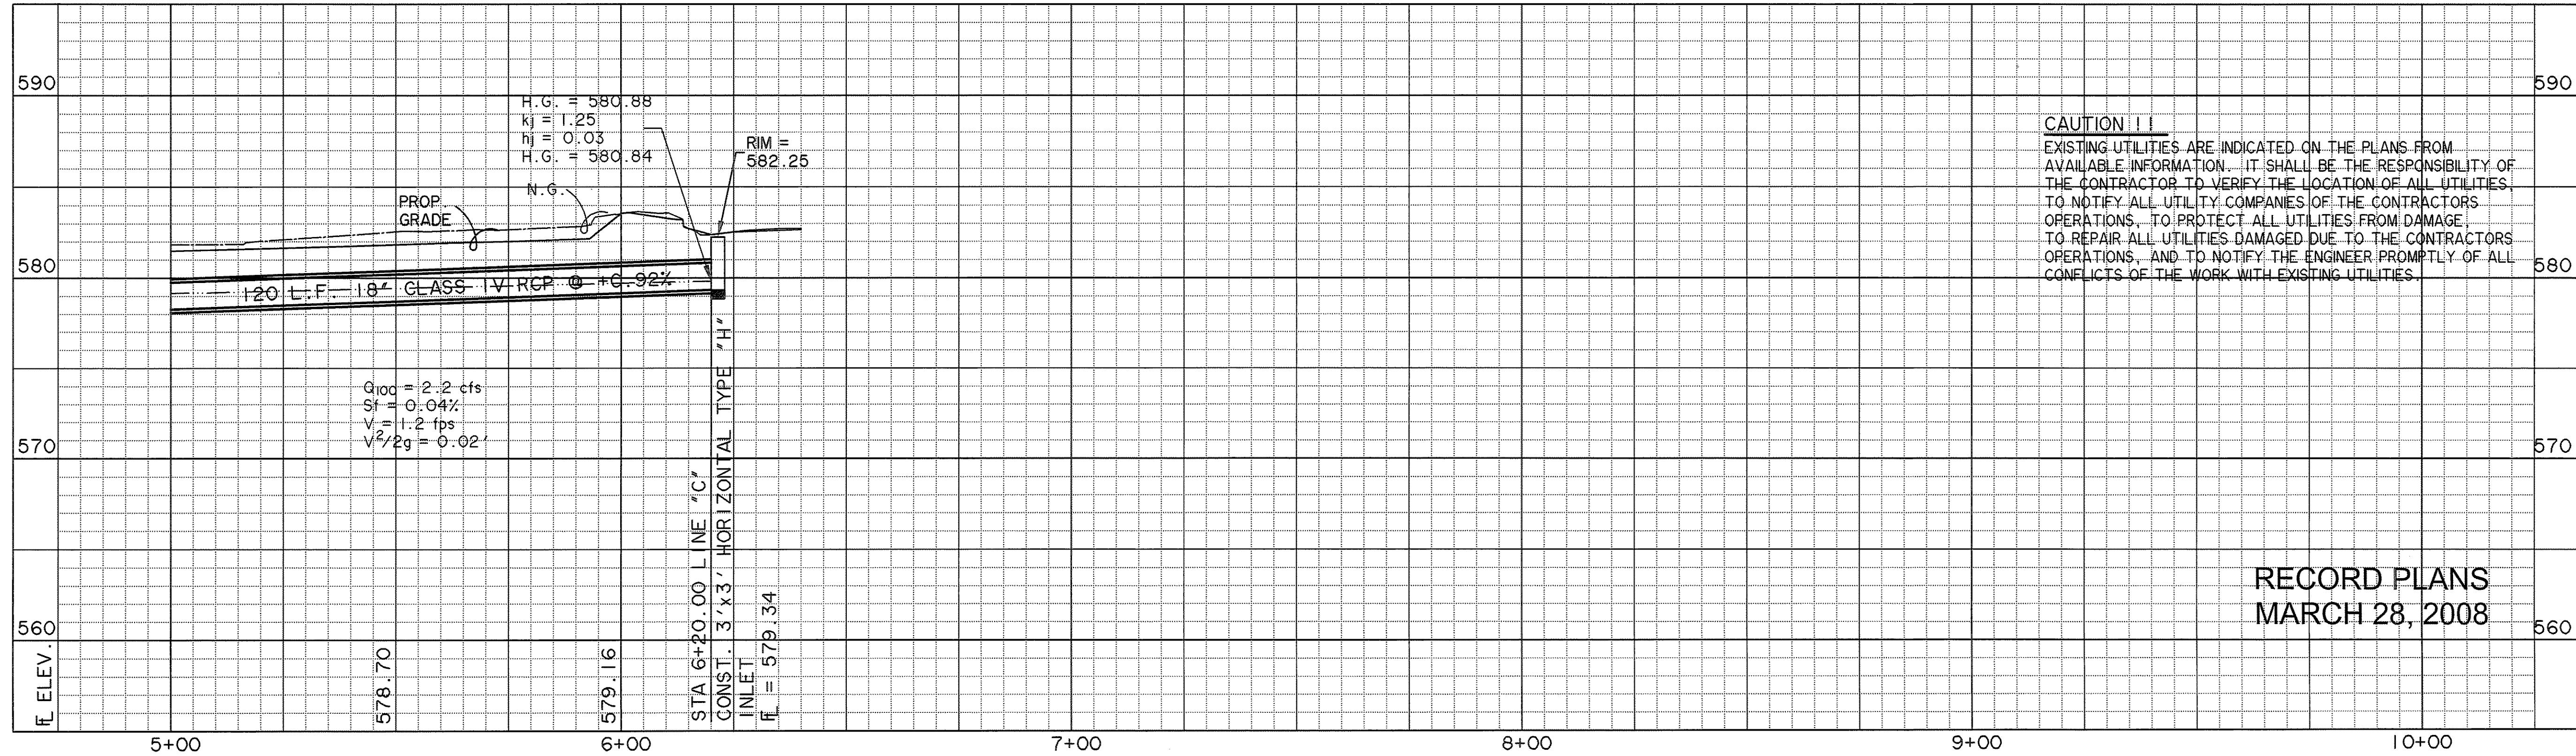


**CAUTION !!**  
EXISTING UTILITIES ARE INDICATED ON THE PLANS FROM AVAILABLE INFORMATION. IT SHALL BE THE RESPONSIBILITY OF THE CONTRACTOR TO VERIFY THE LOCATION OF ALL UTILITIES. TO NOTIFY ALL UTILITY COMPANIES OF THE CONTRACTORS OPERATIONS. TO PROTECT ALL UTILITIES FROM DAMAGE. TO REPAIR ALL UTILITIES DAMAGED DUE TO THE CONTRACTORS OPERATIONS. AND TO NOTIFY THE ENGINEER PROMPTLY OF ALL CONFLICTS OF THE WORK WITH EXISTING UTILITIES.

RECORD PLANS  
MARCH 28, 2008

PREPARED BY:  
**VIA WIER & ASSOCIATES, INC.**  
ENGINEERS SURVEYORS LAND PLANNERS  
4300 BELTWAY PLACE SUITE 130 ARLINGTON, TEXAS 76018 METRO (817)467-7700  
1380 U.S. HIGHWAY 287 N. SUITE 101 WANSFELD, TEXAS 76063 METRO (817)477-6700  
6849 ELM STREET PRISCO, TEXAS 75034 METRO (214)387-8000  
www.wierassociates.com

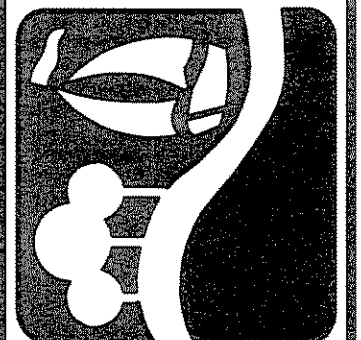


PHASE I S.H. 205 BYPASS  
FROM S.H. 276 TO INTERSTATE 30  
STORM DRAIN LINE "C"  
PLAN & PROFILE  
STA 5+00 TO END


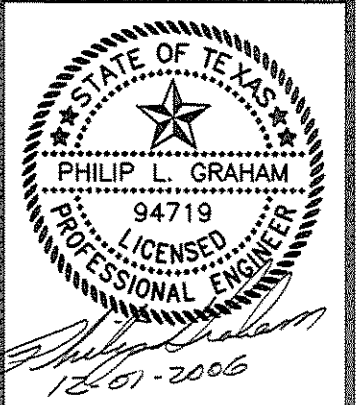


COPYRIGHT ©  
WIER & ASSOCIATES, INC.  
LAST SHEET EDIT  
DATE 11-30-2006  
WA# 04141  
SHEET NO.  
D112


TIME: 13.20 FILE: 04141-SDPP9.dwg

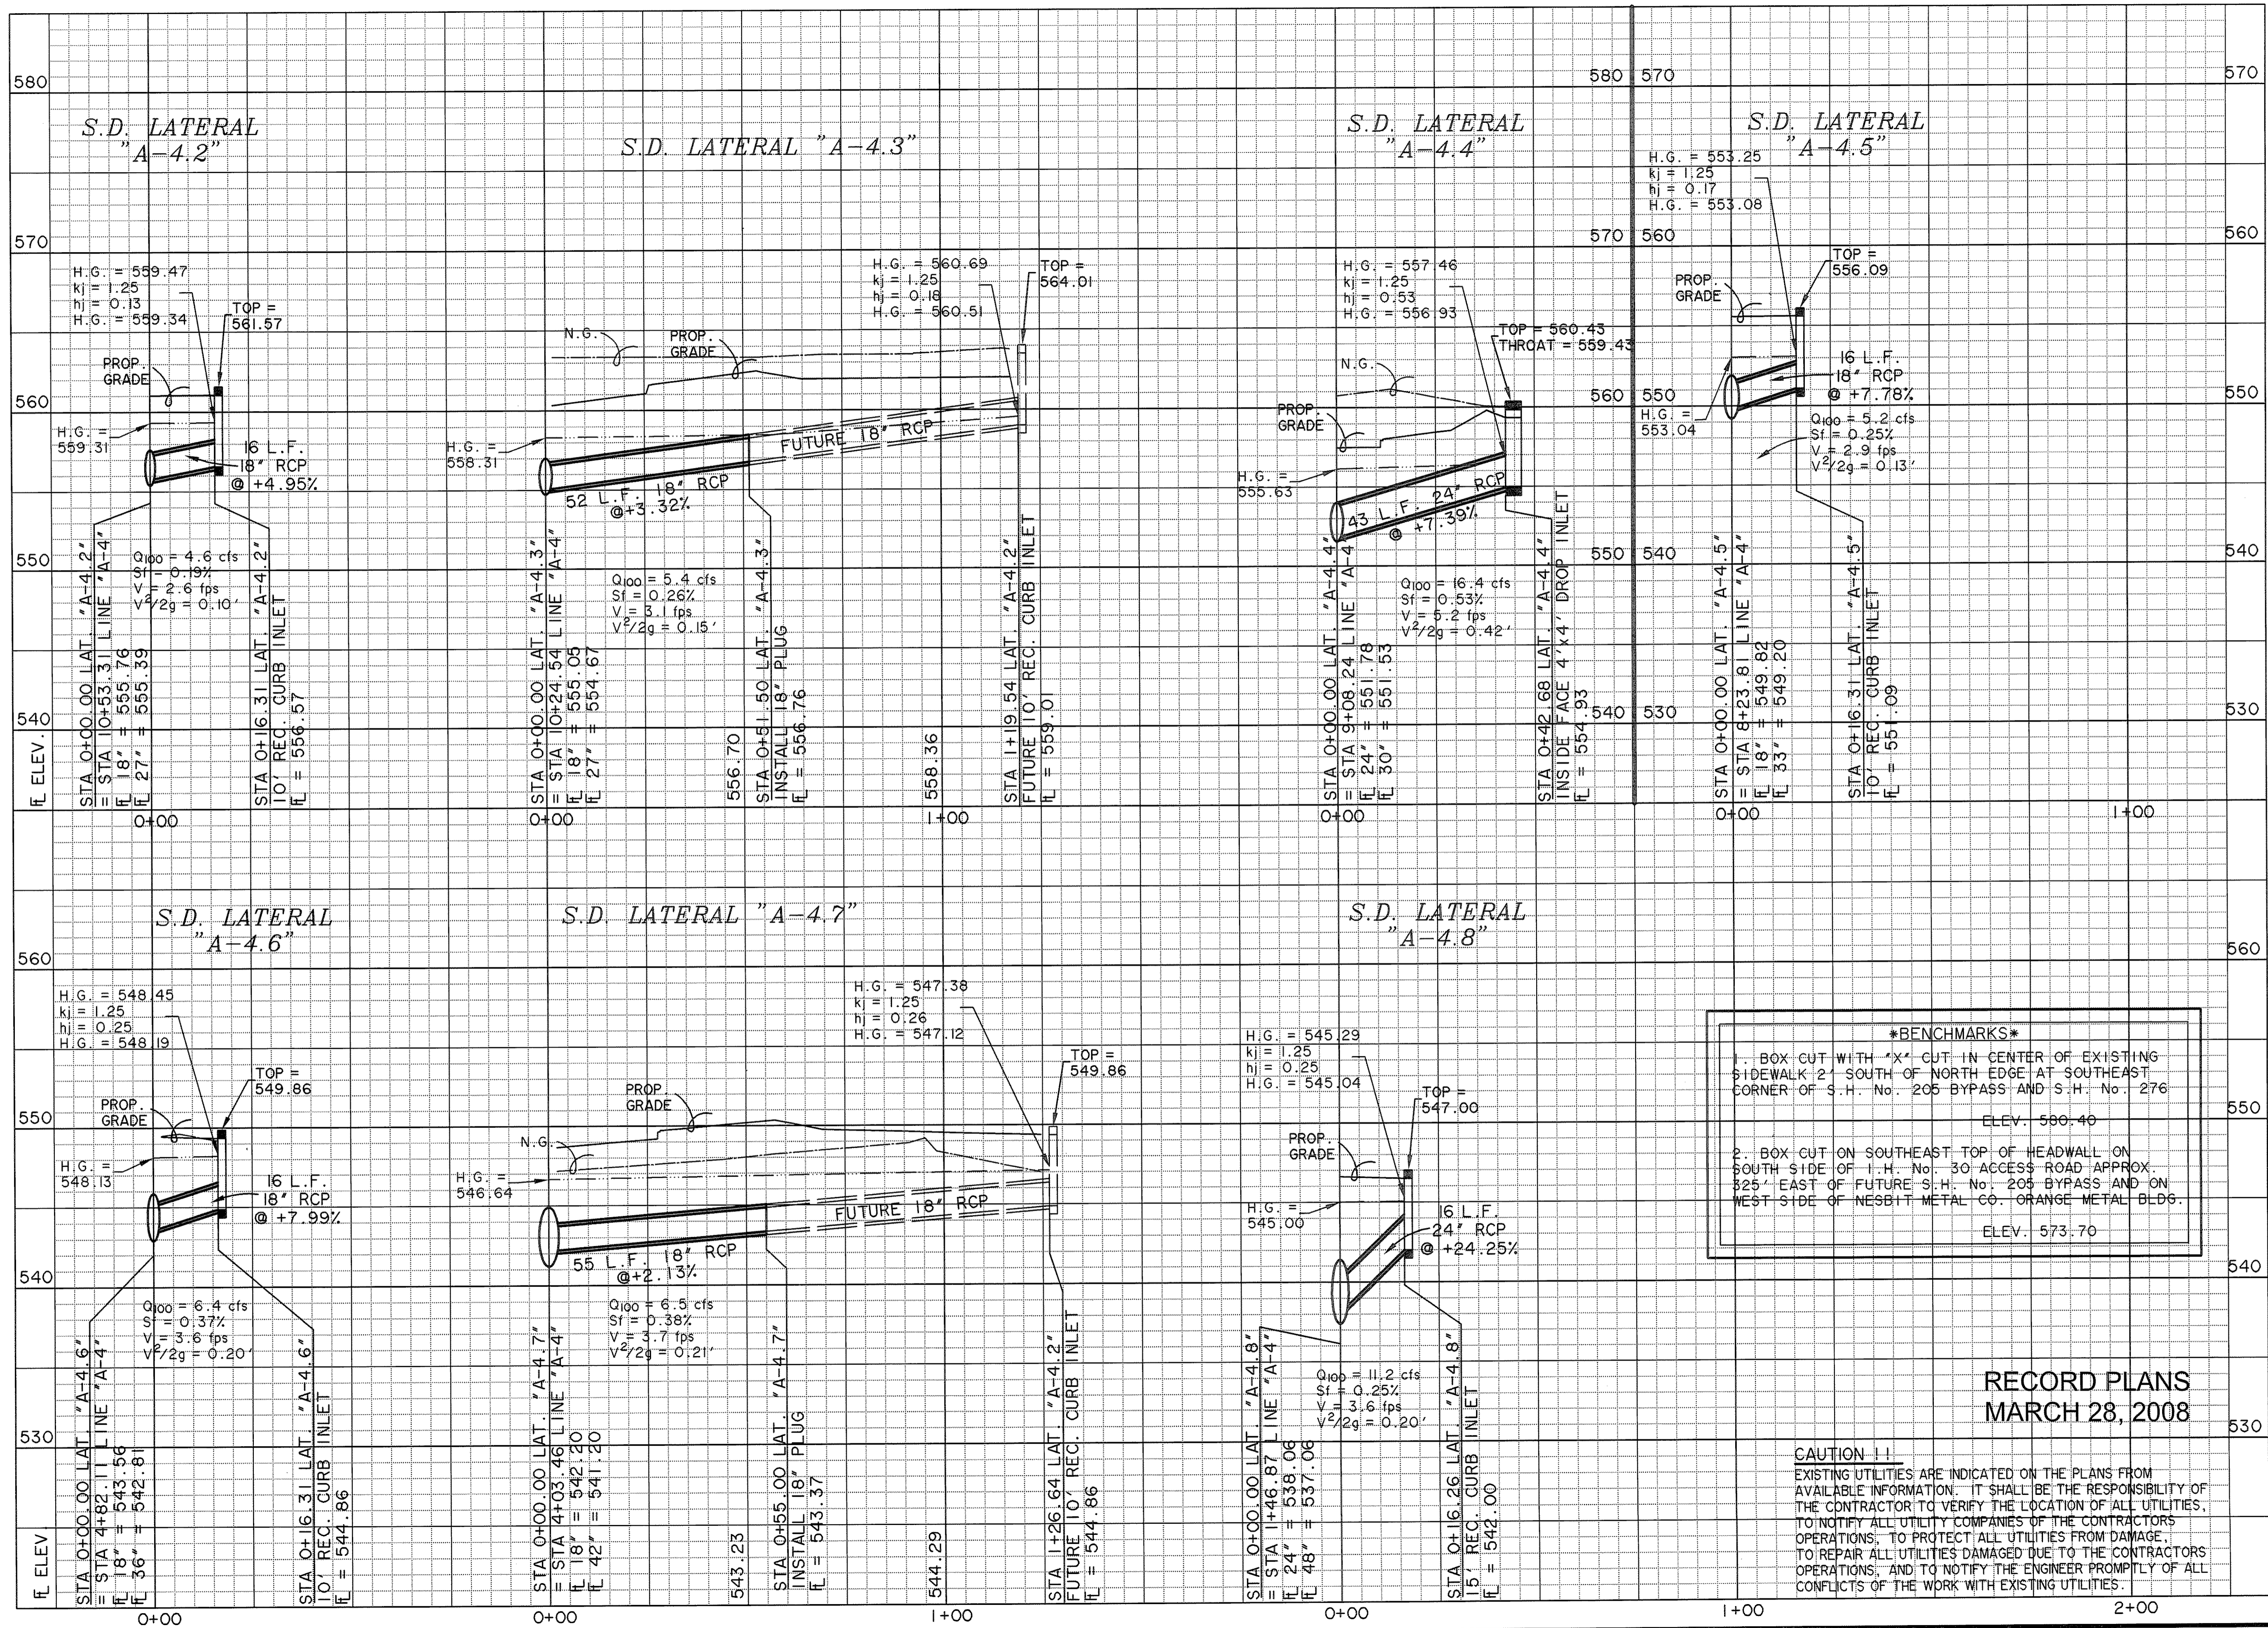

RECORD PLANS  
MARCH 28, 2008

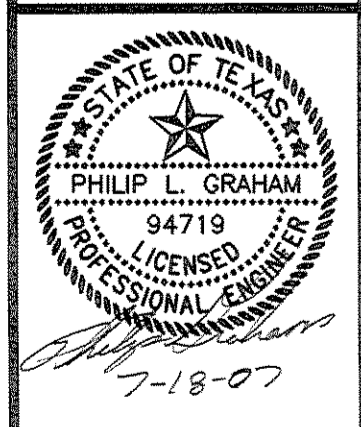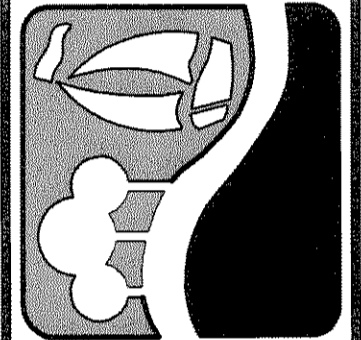


TIME: 23:55 FILE: I:\04141-SDLAT2.dwg

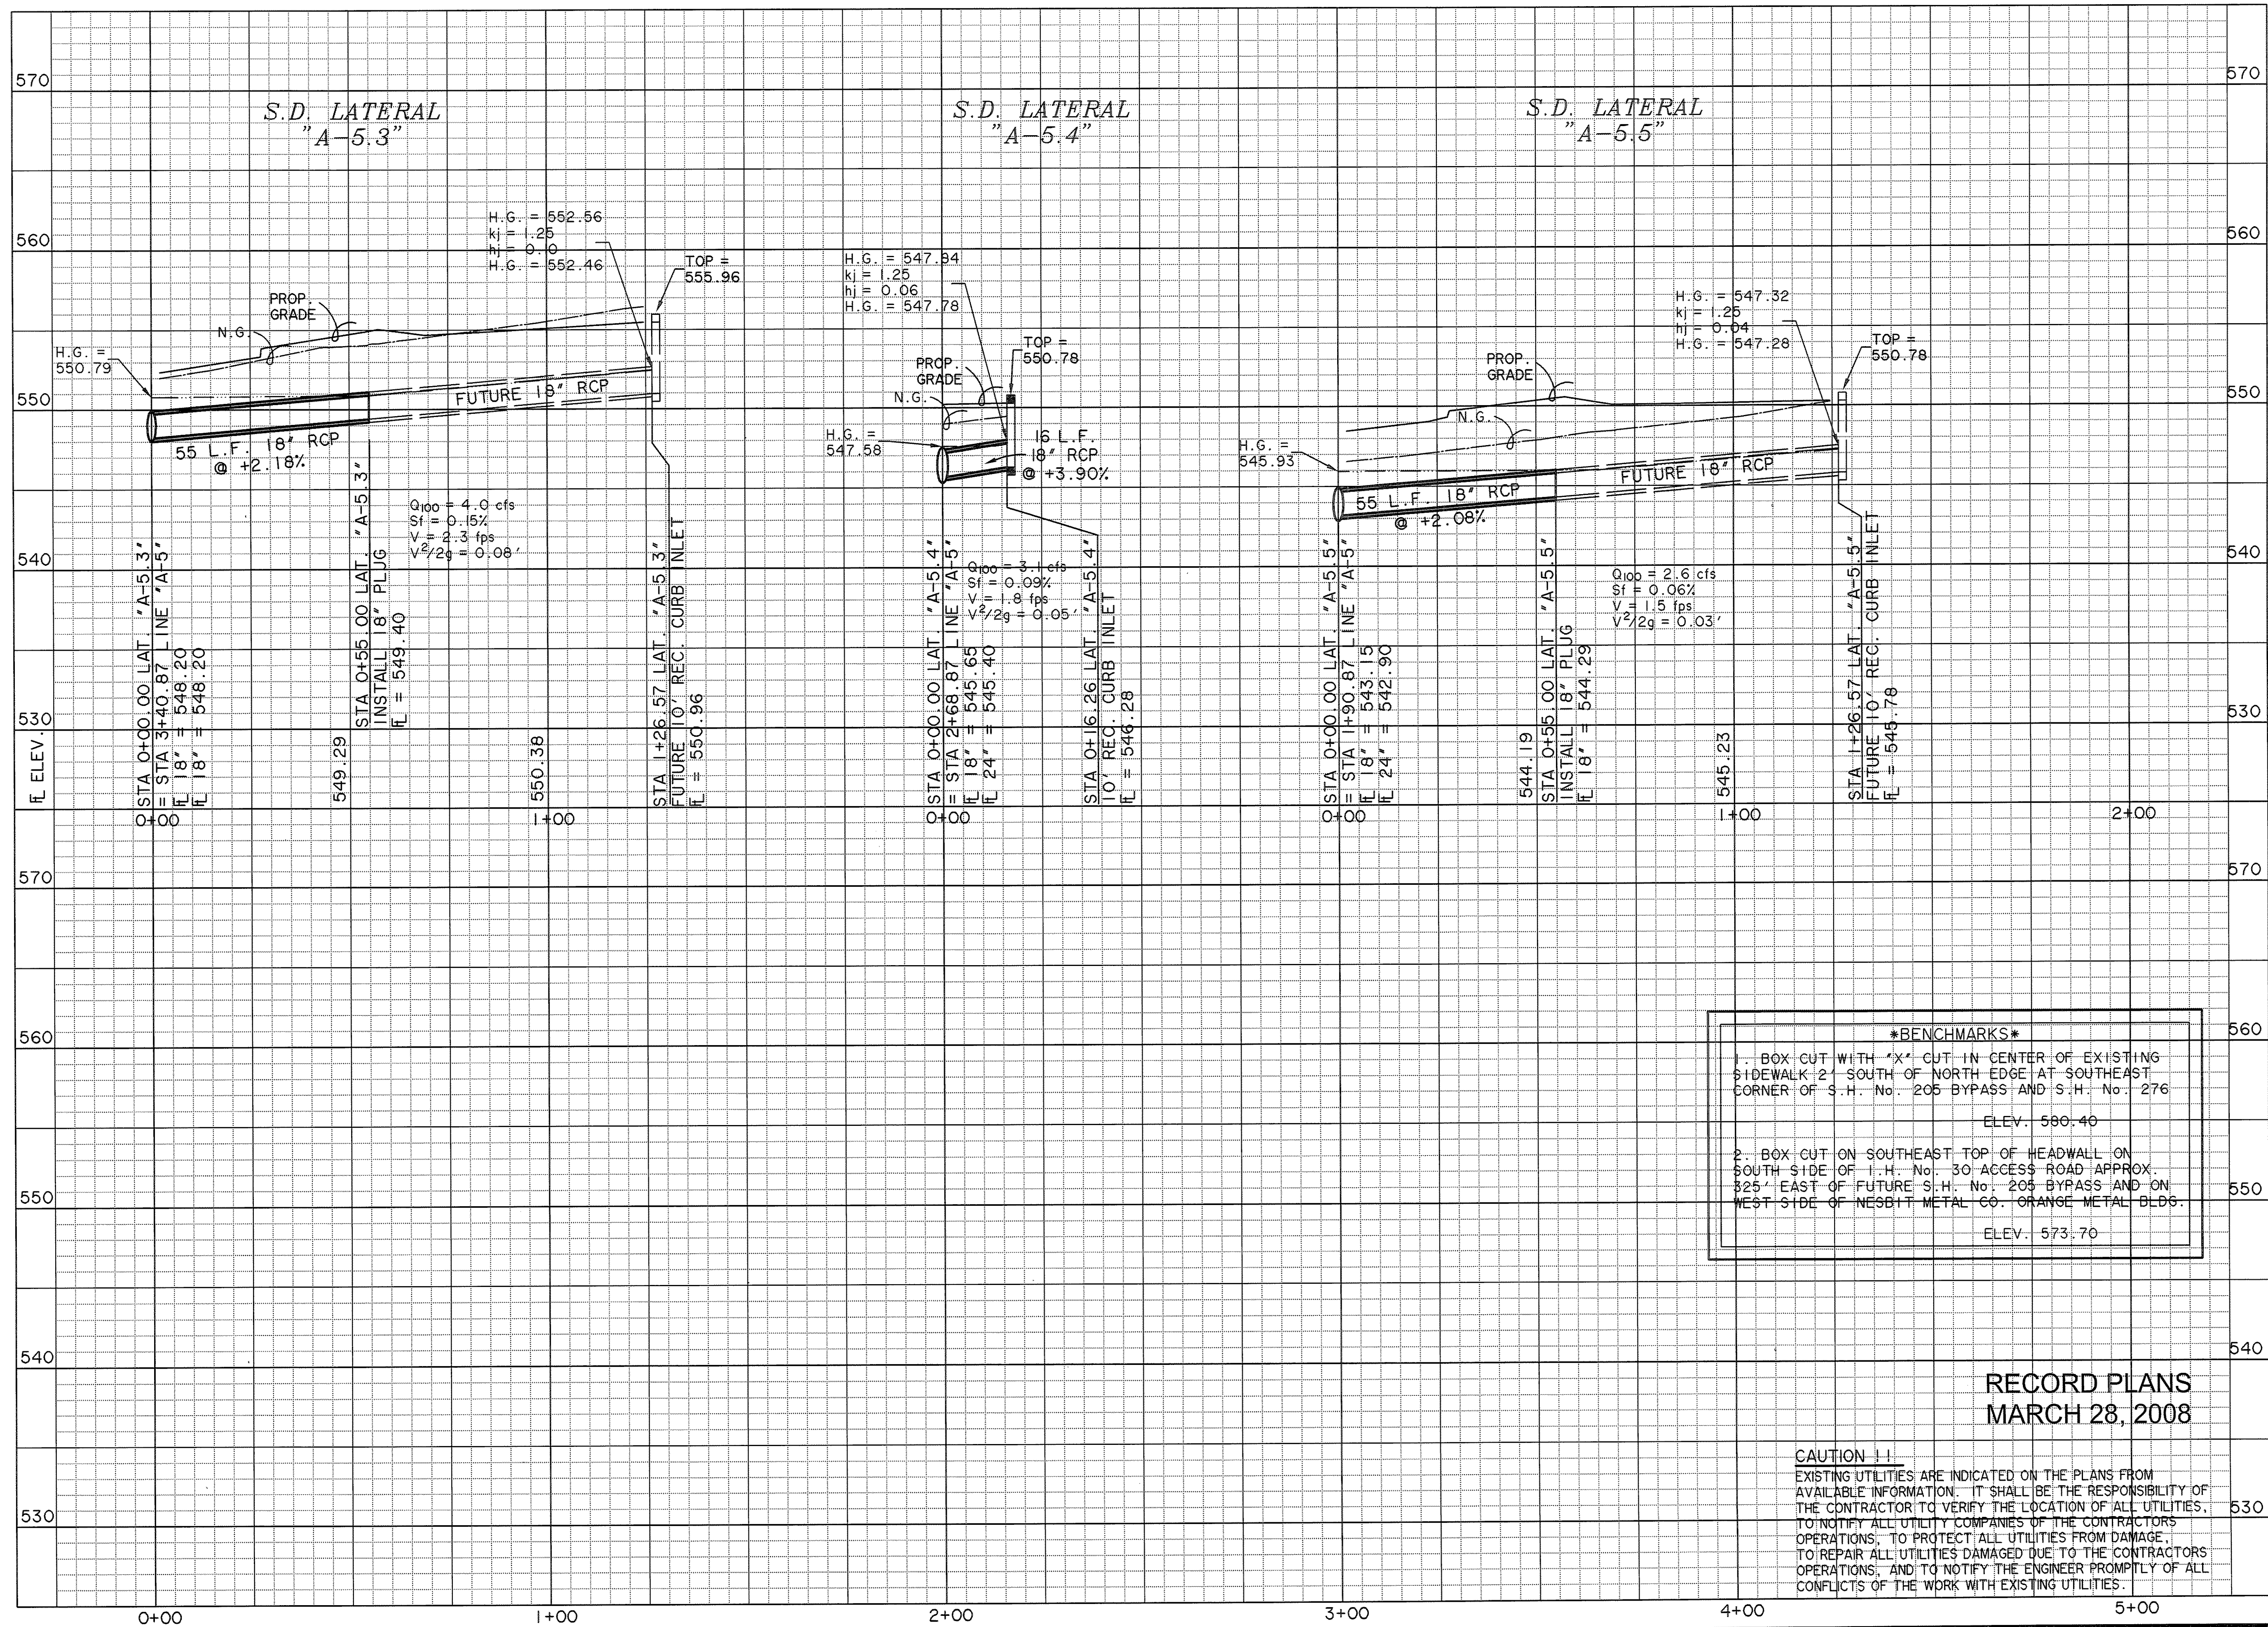


RECORD PLANS  
MARCH 28, 2008

**CAUTION !!**  
 EXISTING UTILITIES ARE INDICATED ON THE PLANS FROM AVAILABLE INFORMATION. IT SHALL BE THE RESPONSIBILITY OF THE CONTRACTOR TO VERIFY THE LOCATION OF ALL UTILITIES, TO NOTIFY ALL UTILITY COMPANIES OF THE CONTRACTORS OPERATIONS, TO PROTECT ALL UTILITIES FROM DAMAGE, TO REPAIR ALL UTILITIES DAMAGED DUE TO THE CONTRACTORS OPERATIONS, AND TO NOTIFY THE ENGINEER PROMPTLY OF ALL CONFLICTS OF THE WORK WITH EXISTING UTILITIES.

PREPARED BY:  
**WIA WIER & ASSOCIATES, INC.**  
 ENGINEERS SURVEYORS LAND PLANNERS  
 4300 BELTWAY PLACE SUITE 130 ARLINGTON, TEXAS 76018 METRO (817)467-7700  
 1380 U.S. HIGHWAY 287 N. SUITE 101 MANSFIELD, TEXAS 76063 METRO (817)477-0700  
 6848 ELM STREET FRISCO, TEXAS 75034 METRO (214)387-8800  
 www.wierassociates.com

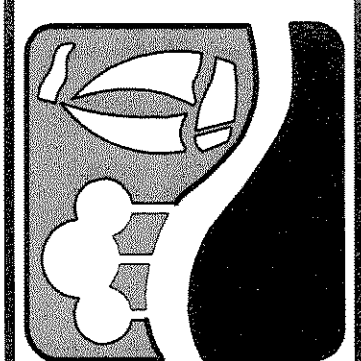


PHASE I S.H. 205 BYPASS  
 FROM S.H. 276 TO INTERSTATE 30  
 STORM DRAIN  
 LATERAL PROFILES

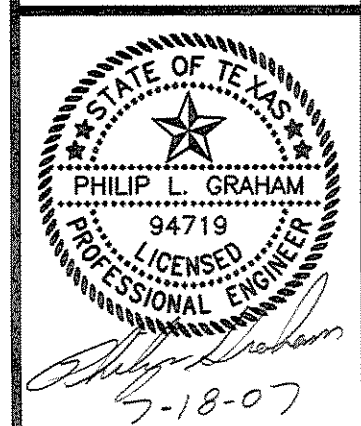

COPYRIGHT ©  
 WIER & ASSOCIATES, INC.  
 LAST SHEET EDIT  
 DATE 07-18-2007  
 WA# 04141  
**SHEET NO.**  
 D202

FILE: 04141-CULVERT-GRADE.dwg

TIME: 11:58

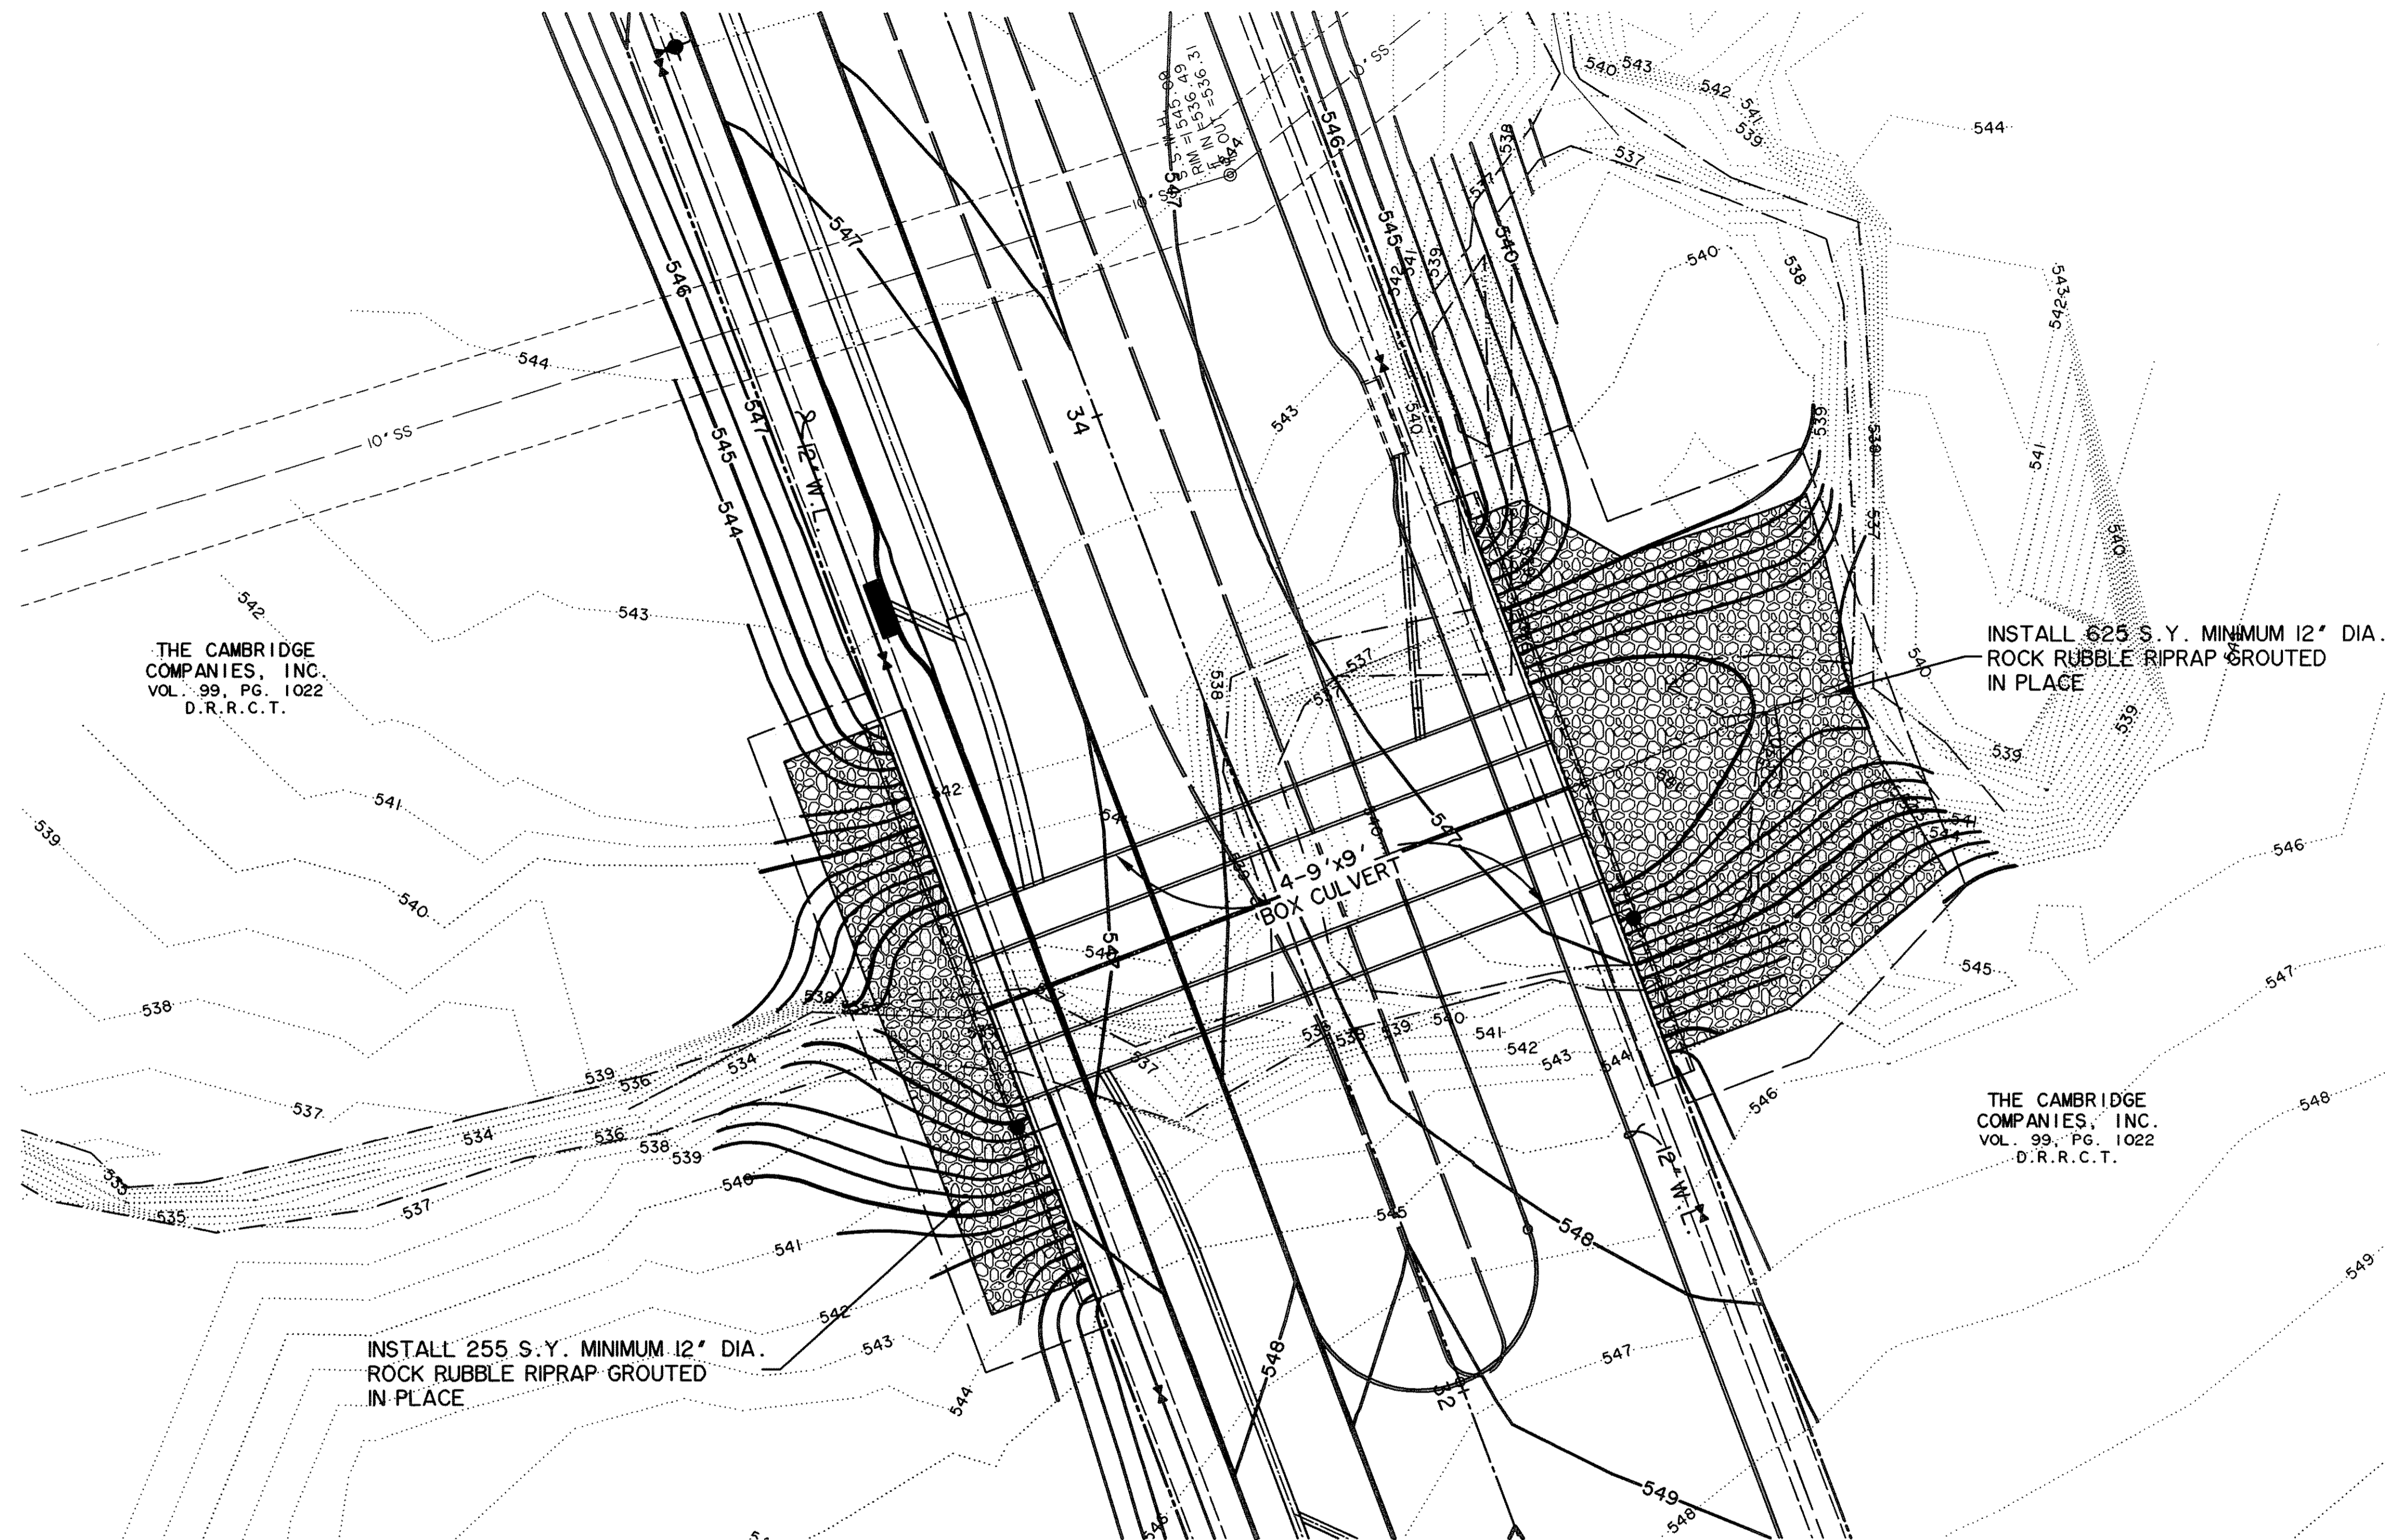

THE CAMBRIDGE  
COMPANIES, INC.  
VOL. 99, PG. 1022  
D.R.R.C.T.

INSTALL 625 S.Y. MINIMUM 12" DIA.  
ROCK RUBBLE RIPRAP GROUTED  
IN PLACE

THE CAMBRIDGE  
COMPANIES, INC.  
VOL. 99, PG. 1022  
D.R.R.C.T.

INSTALL 255 S.Y. MINIMUM 12" DIA.  
ROCK RUBBLE RIPRAP GROUTED  
IN PLACE

**CAUTION !!**

EXISTING UTILITIES ARE INDICATED ON THE PLANS FROM AVAILABLE INFORMATION. IT SHALL BE THE RESPONSIBILITY OF THE CONTRACTOR TO VERIFY THE LOCATION OF ALL UTILITIES, TO NOTIFY ALL UTILITY COMPANIES OF THE CONTRACTORS OPERATIONS, TO PROTECT ALL UTILITIES FROM DAMAGE, TO REPAIR ALL UTILITIES DAMAGED DUE TO THE CONTRACTORS OPERATIONS, AND TO NOTIFY THE ENGINEER PROMPTLY OF ALL CONFLICTS OF THE WORK WITH EXISTING UTILITIES.

***BENCHMARKS***


1. BOX CUT WITH "X" CUT IN CENTER OF EXISTING SIDEWALK 2' SOUTH OF NORTH EDGE AT SOUTHEAST CORNER OF S.H. No. 205 BYPASS AND S.H. No. 276

ELEV. 580.40


2. BOX CUT ON SOUTHEAST TOP OF HEADWALL ON SOUTH SIDE OF I.H. No. 30 ACCESS ROAD APPROX. 325' EAST OF FUTURE S.H. No. 205 BYPASS AND ON WEST SIDE OF NESBIT METAL CO. ORANGE METAL BLDG.

ELEV. 573.70


**RECORD PLANS  
MARCH 28, 2008**

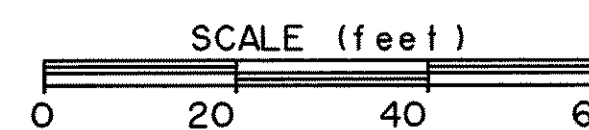

PREPARED BY:  
**WIA WIER & ASSOCIATES, INC.**  
ENGINEERS SURVEYORS LAND PLANNERS  
4300 BELTWAY PLACE SUITE 130 ARLINGTON, TEXAS 76018 METRO (817)467-7700  
1380 U.S. HIGHWAY 287 N. SUITE 101 MANSFIELD, TEXAS 76063 METRO (817)477-8700  
6848 ELA STREET PERCO, TEXAS 75084 METRO (214)387-8000  
www.wierassociates.com

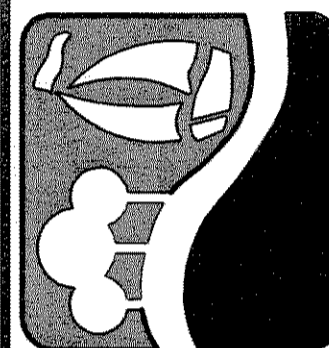

**PHASE I S.H. 205 BYPASS  
FROM S.H. 276 TO INTERSTATE 30  
BOX CULVERT GRADING PLAN**

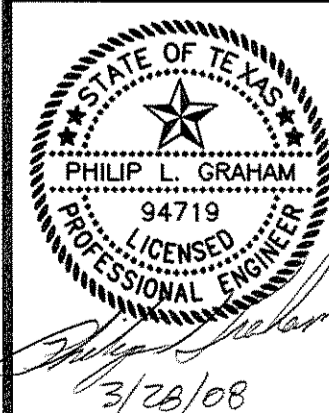

COPYRIGHT ©  
WIER & ASSOCIATES, INC.  
LAST SHEET EDIT  
DATE 12-01-2006  
WA# 04141

**SHEET NO.  
D203**





**BILLS OF REINFORCING STEEL (For Box Length = 40 feet)**

NUMBER OF SPANS	SECTION DIMENSIONS		BILLS OF REINFORCING STEEL (For Box Length = 40 feet)																				QUANTITIES																							
			Bars B				Bars C & D				Bars E				Bars F ₁ ~#4		Bars F ₂ ~#4 at 1'-6" Max		Bars M ~#4 at 1'-6" Max		Bars Y & Z ~#4 at 9" Max				Bars H 4~#4		Bars K		Per foot of Barrel		Curb		Total													
	S	H	T	U	No.	Size	Spa	Length	Wt	No.	Size	Spa	Length	Wt	No.	Size	Spa	Length	Wt	No.	Spa	Length	Wt	No.	Length	Wt	No.	Length	Wt	No.	Bar Y Length	Bar Y Wt	Bar Z Length	Bar Z Wt	Length	Weight	No.	Weight	Conc (CY)	Reinf (Lb)	Conc (CY)	Reinf (Lb)	Conc (CY)	Reinf (Lb)		
2	9'-0"	5'-0"	8"	7"	194	#5	5"	19'-6"	3,946	194	#4	5"	13'-0"	1,685	9'-9"	1,264	194	#6	5"	8'-10"	2,574	24	9"	39'-9"	637	68	39'-9"	1,806	56	5'-0"	187	54	4'-8"	168	11'-2"	403	19'-6"	52	42	119	1,299	316.8	1.5	171	53.5	12,841



DISCLAIMER: The use of this standard is governed by the "Texas Engineering Practice Act". No warranty of any kind is made by TxDOT for any purpose whatsoever. TxDOT assumes no responsibility for the conversion of this standard to other formats or for incorrect results or damages resulting from its use.

H	Bar Dimensions	
	"X"	"Y"
5'-0"	5'-6"	2'-3"
6'-0"	6'-6"	2'-3"
7'-0"	7'-6"	2'-8"
8'-0"	8'-6"	2'-8"
9'-0"	9'-6"	2'-8"

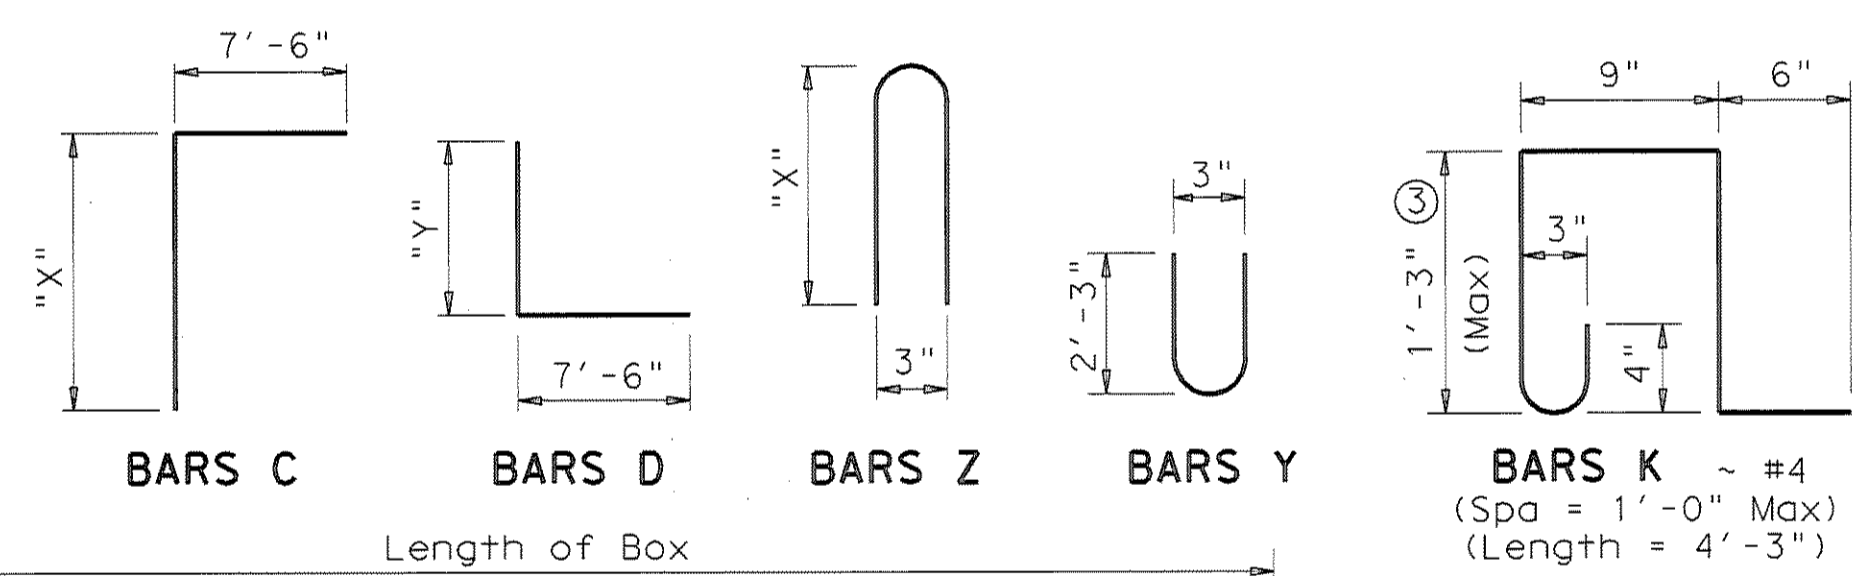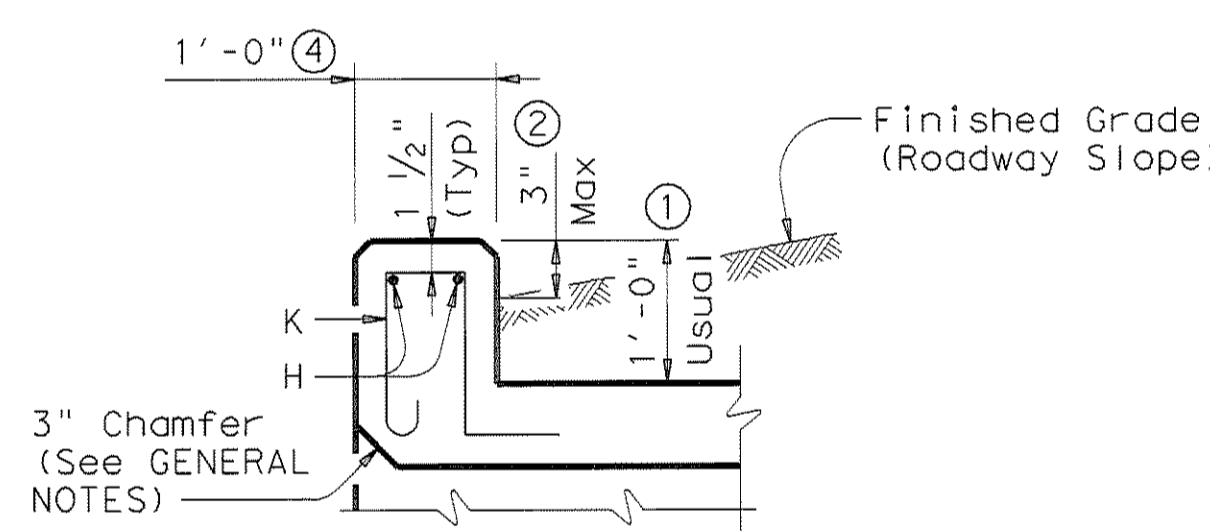

**GENERAL NOTES:**

Designed according to current AASHTO Standard and Interim Specifications. Designed to the maximum fill height shown. All reinforcing steel shall be Grade 60. All concrete shall be Class "C" with these exceptions: use Class "S" for top slabs of culverts with overlay, with 1-to-2 course surface treatment, or with the top slab as the final riding surface. Class "C" concrete shall have a minimum compressive strength of 3,600 psi. Class "S" concrete shall have a minimum compressive strength of 4,000 psi. The use of permanent forms is not allowed. The bottom edge of the top slab shall be chamfered 3" at the entrance. Reinforcing bars shall be adjusted to provide a minimum of 1/4" clear cover. Construction joints shown at the flow line may be raised a maximum of 6" at the Contractor's option. If this option is used, Bars M may be cut off or raised, Bars C and D may be reversed, and Bars Y and Z may be reversed. See standard MC-MD for skewed ends, angle sections and lengthening details.

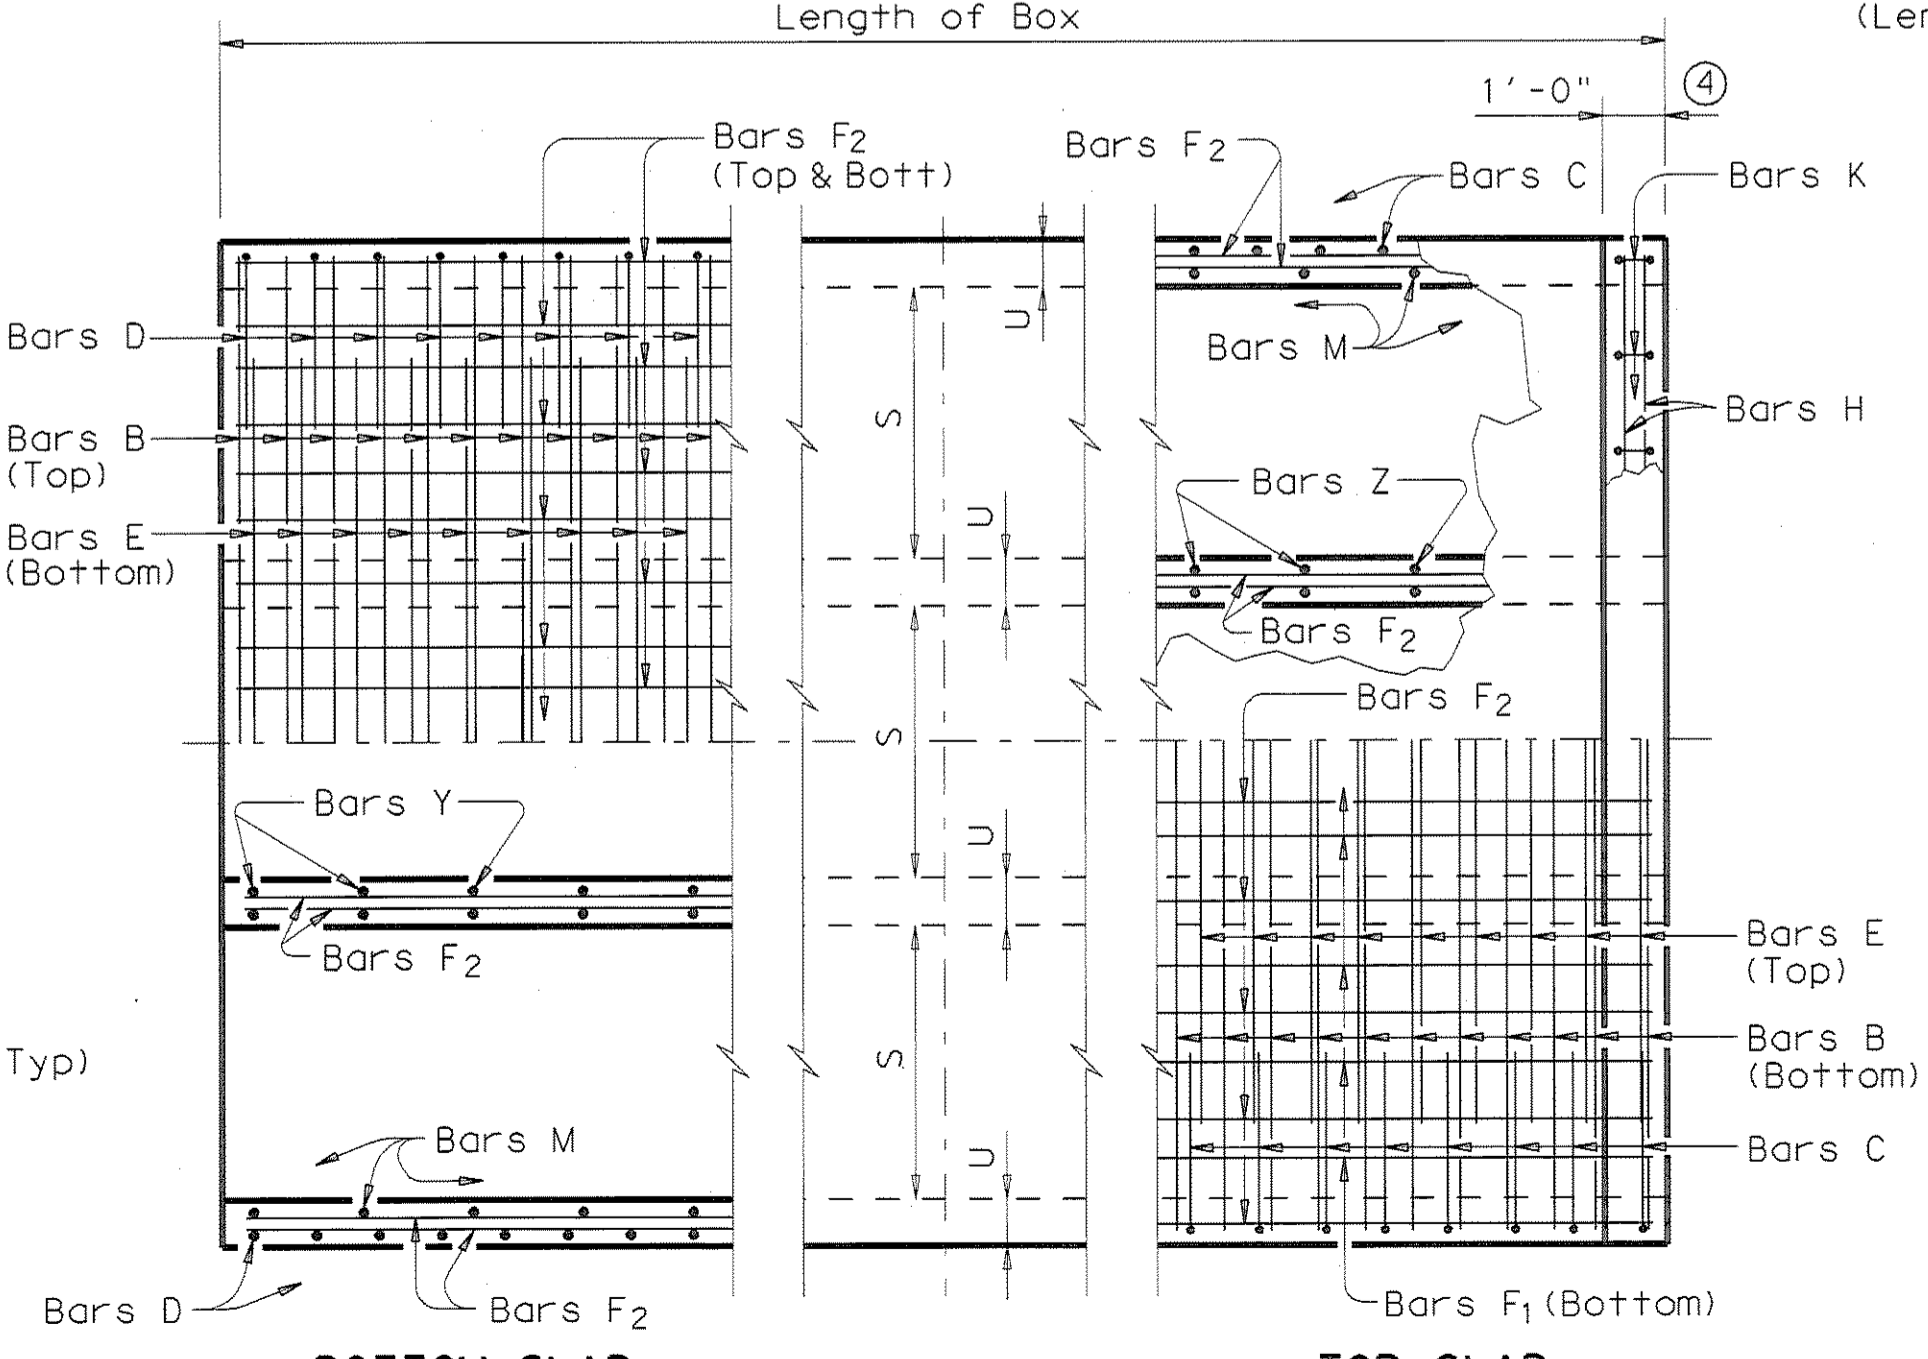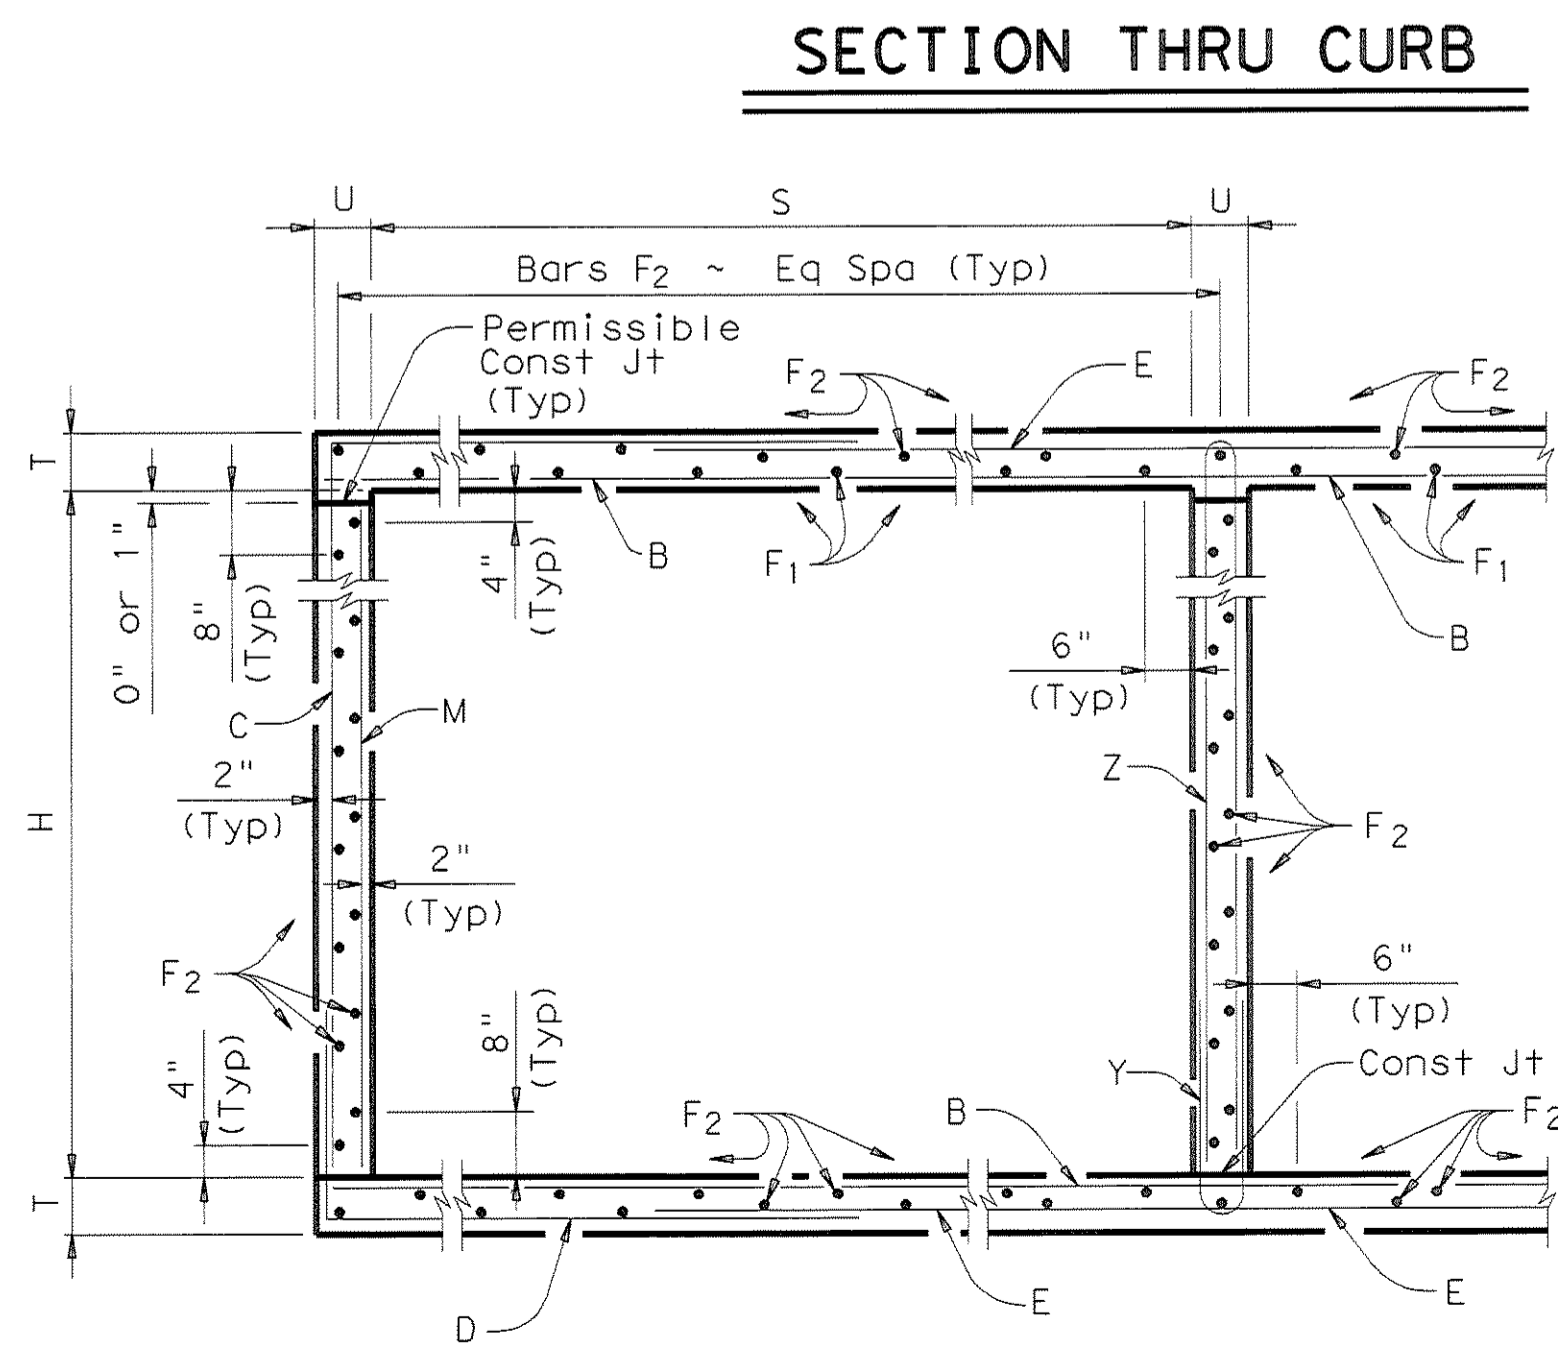

- 0" min to 5'-0" max. Estimated curb heights are shown elsewhere in the plans. For structures without railing and curbs taller than 1'-0", refer to ECD standard. For structures with T6 bridge rail, refer to T6-CM standard. For structures with bridge rail, other than T6, refer to RAC standard.
- For vehicle safety, the following requirements must be met:
  - For structures without bridge rail, curbs shall project no more than 3" above finished grade.
  - For structures with bridge rail, curbs shall be flush with finished grade. Curb heights shall be reduced, if necessary, to meet the above requirements. No changes will be made in quantities and no additional compensation will be allowed for this work.
- For curbs less than 1'-0" high, tilt bars K or reduce bar height as necessary to maintain cover. For curbs less than 3" high, bars K may be omitted.
- 1'-0" typical. 2'-0" when RAC standard is referred to elsewhere in the plans.

**RECORD PLANS  
MARCH 28, 2008**

HS20 LOADING  
  
 Bridge Division  
**MULTIPLE BOX CULVERTS  
CAST-IN-PLACE**  
 9'-0" SPAN  
 0' TO 10' FILL  
**MC-9-10**

FILE: mc910ste.dgn	DN: GAF	CK: LMW	DW: BWH/TxDOT	CK: GAF
© TxDOT May 2005	DISTRICT	FEDERAL AID PROJECT	SHEET <b>D307</b>	
REVISIONS	COUNTY	CONTROL SECT	JOB	HIGHWAY

LEVELS DISPLAYED	
1	

**TABLE OF DIMENSIONS & REINFORCING STEEL**  
(Wings for One Structure End)

Dimensions	Variable Reinforcing				Estimated Quantities per ft of wing (2-Wings)		Estimated Quantities per ft of Toewall (1-Toewall)	
	W	X	Y	Z	Bars J1 Size Spa	Bars J2 Size Spa	Reinf (Lb/Ft) Conc (CY/Ft)	Reinf (Lb/Ft) Conc (CY/Ft)
2'-6"	2'-10"	10"	1'-0"	7"	#4 1'-0"	#4 1'-0"	43.13 0.406	6.85 0.071
2'-9"	2'-10"	10"	1'-0"	7"	#4 1'-0"	#4 1'-0"	43.80 0.424	6.85 0.071
3'-0"	2'-10"	10"	1'-0"	7"	#4 1'-0"	#4 1'-0"	44.47 0.444	6.85 0.071
3'-3"	2'-10"	10"	1'-0"	7"	#4 1'-0"	#4 1'-0"	47.81 0.462	6.85 0.071
3'-6"	2'-10"	10"	1'-0"	7"	#4 1'-0"	#4 1'-0"	48.48 0.480	6.85 0.071
4'-0"	3'-2"	1'-2"	1'-0"	7"	#4 1'-0"	#4 1'-0"	50.26 0.532	6.85 0.071
4'-6"	3'-2"	1'-2"	1'-0"	7"	#4 1'-0"	#4 1'-0"	54.27 0.568	6.85 0.071
5'-0"	3'-9"	1'-7"	1'-2"	7"	#4 1'-0"	#4 1'-0"	57.94 0.632	6.96 0.075
5'-6"	3'-9"	1'-7"	1'-2"	7"	#4 1'-0"	#4 1'-0"	61.95 0.668	6.96 0.075
6'-0"	4'-4"	2'-0"	1'-4"	7"	#5 1'-0"	#5 1'-0"	75.16 0.730	7.07 0.078
6'-6"	4'-4"	2'-0"	1'-4"	7"	#5 1'-0"	#5 1'-0"	79.54 0.768	7.07 0.078
7'-0"	5'-0"	2'-3"	1'-9"	8"	#5 1'-0"	#5 1'-0"	86.65 0.864	8.07 0.093
7'-6"	5'-0"	2'-3"	1'-9"	8"	#5 1'-0"	#5 1'-0"	91.03 0.902	8.07 0.093
8'-0"	5'-6"	2'-8"	1'-10"	8"	#5 6"	#5 6"	133.54 0.962	8.13 0.095
8'-6"	5'-6"	2'-8"	1'-10"	8"	#5 6"	#5 6"	138.96 1.000	8.13 0.095
9'-0"	6'-0"	2'-10"	2'-2"	9"	#5 6"	#5 6"	151.43 1.136	8.41 0.110
10'-0"	6'-5"	3'-0"	2'-5"	9"	#6 6"	#5 6"	190.76 1.234	8.57 0.117
11'-6"	7'-2"	3'-6"	2'-8"	11"	#6 6"	#6 6"	224.62 1.438	9.52 0.140
12'-6"	7'-8"	3'-9"	2'-11"	1'-0"	#7 6"	#6 6"	277.90 1.592	9.74 0.157
13'-6"	8'-2"	4'-0"	3'-2"	1'-2"	#8 6"	#6 6"	343.21 1.804	10.02 0.186
14'-6"	8'-10"	4'-5"	3'-5"	1'-4"	#9 6"	#6 6"	427.43 2.046	10.30 0.218
15'-6"	9'-6"	4'-10"	3'-8"	1'-6"	#9 6"	#7 6"	484.01 2.302	11.24 0.253
16'-0"	9'-11"	5'-0"	3'-11"	1'-7"	#9 6"	#7 6"	500.21 2.448	11.47 0.279

**TABLE OF WINGWALL REINFORCING**  
(2-Wings)

Bar	Size	No.	Spa
D1	#5	~	1'-0"
D2	#5	~	1'-0"
E1	#4	~	1'-0"
F	#4	~	1'-0"
G	#5	~	1'-0"
M1	#4	4	~
P	#4	~	1'-0"
V	#4	~	1'-0"




**TABLE OF TOEWALL REINFORCING**

Bar	Size	No.	Spa
J3	#4	~	1'-0"
M2	#4	2	~
E2	#4	~	1'-0"

**WING DIMENSION CALCULATIONS:**

Formulas: (All values are in Feet)  
 $Hw = H + T + C$   
 $Lw = (Hw) (SL) \div \text{Cosine } (\phi)$   
 For Cast-in-place culverts:  
 $Ltw = [(N) (S) + (N + 1) (U)] \div (\text{Cosine } \phi)$   
 For Precast culverts:  
 $Ltw = [(N) (2 U + S) + (N - 1) (0.5')] \div (\text{Cosine } \phi)$   
 Total Wingwall Area (Two Wings ~ S.F.)  
 $= (2) (Hw) (Lw)$

$Hw$  = Height of Wingwall  
 $Lw$  = Length of Wingwall  
 $Ltw$  = Culvert Toewall Length  
 $N$  = Number of Culvert Spans  
 $SL:1$  = Channel Slope ratio. (Horizontal: 1 Vertical, Usual value is 2:1)  
 $\phi$  = Culvert Skew  
 See applicable box culvert standard for  $S, H, T$  and  $U$  values.

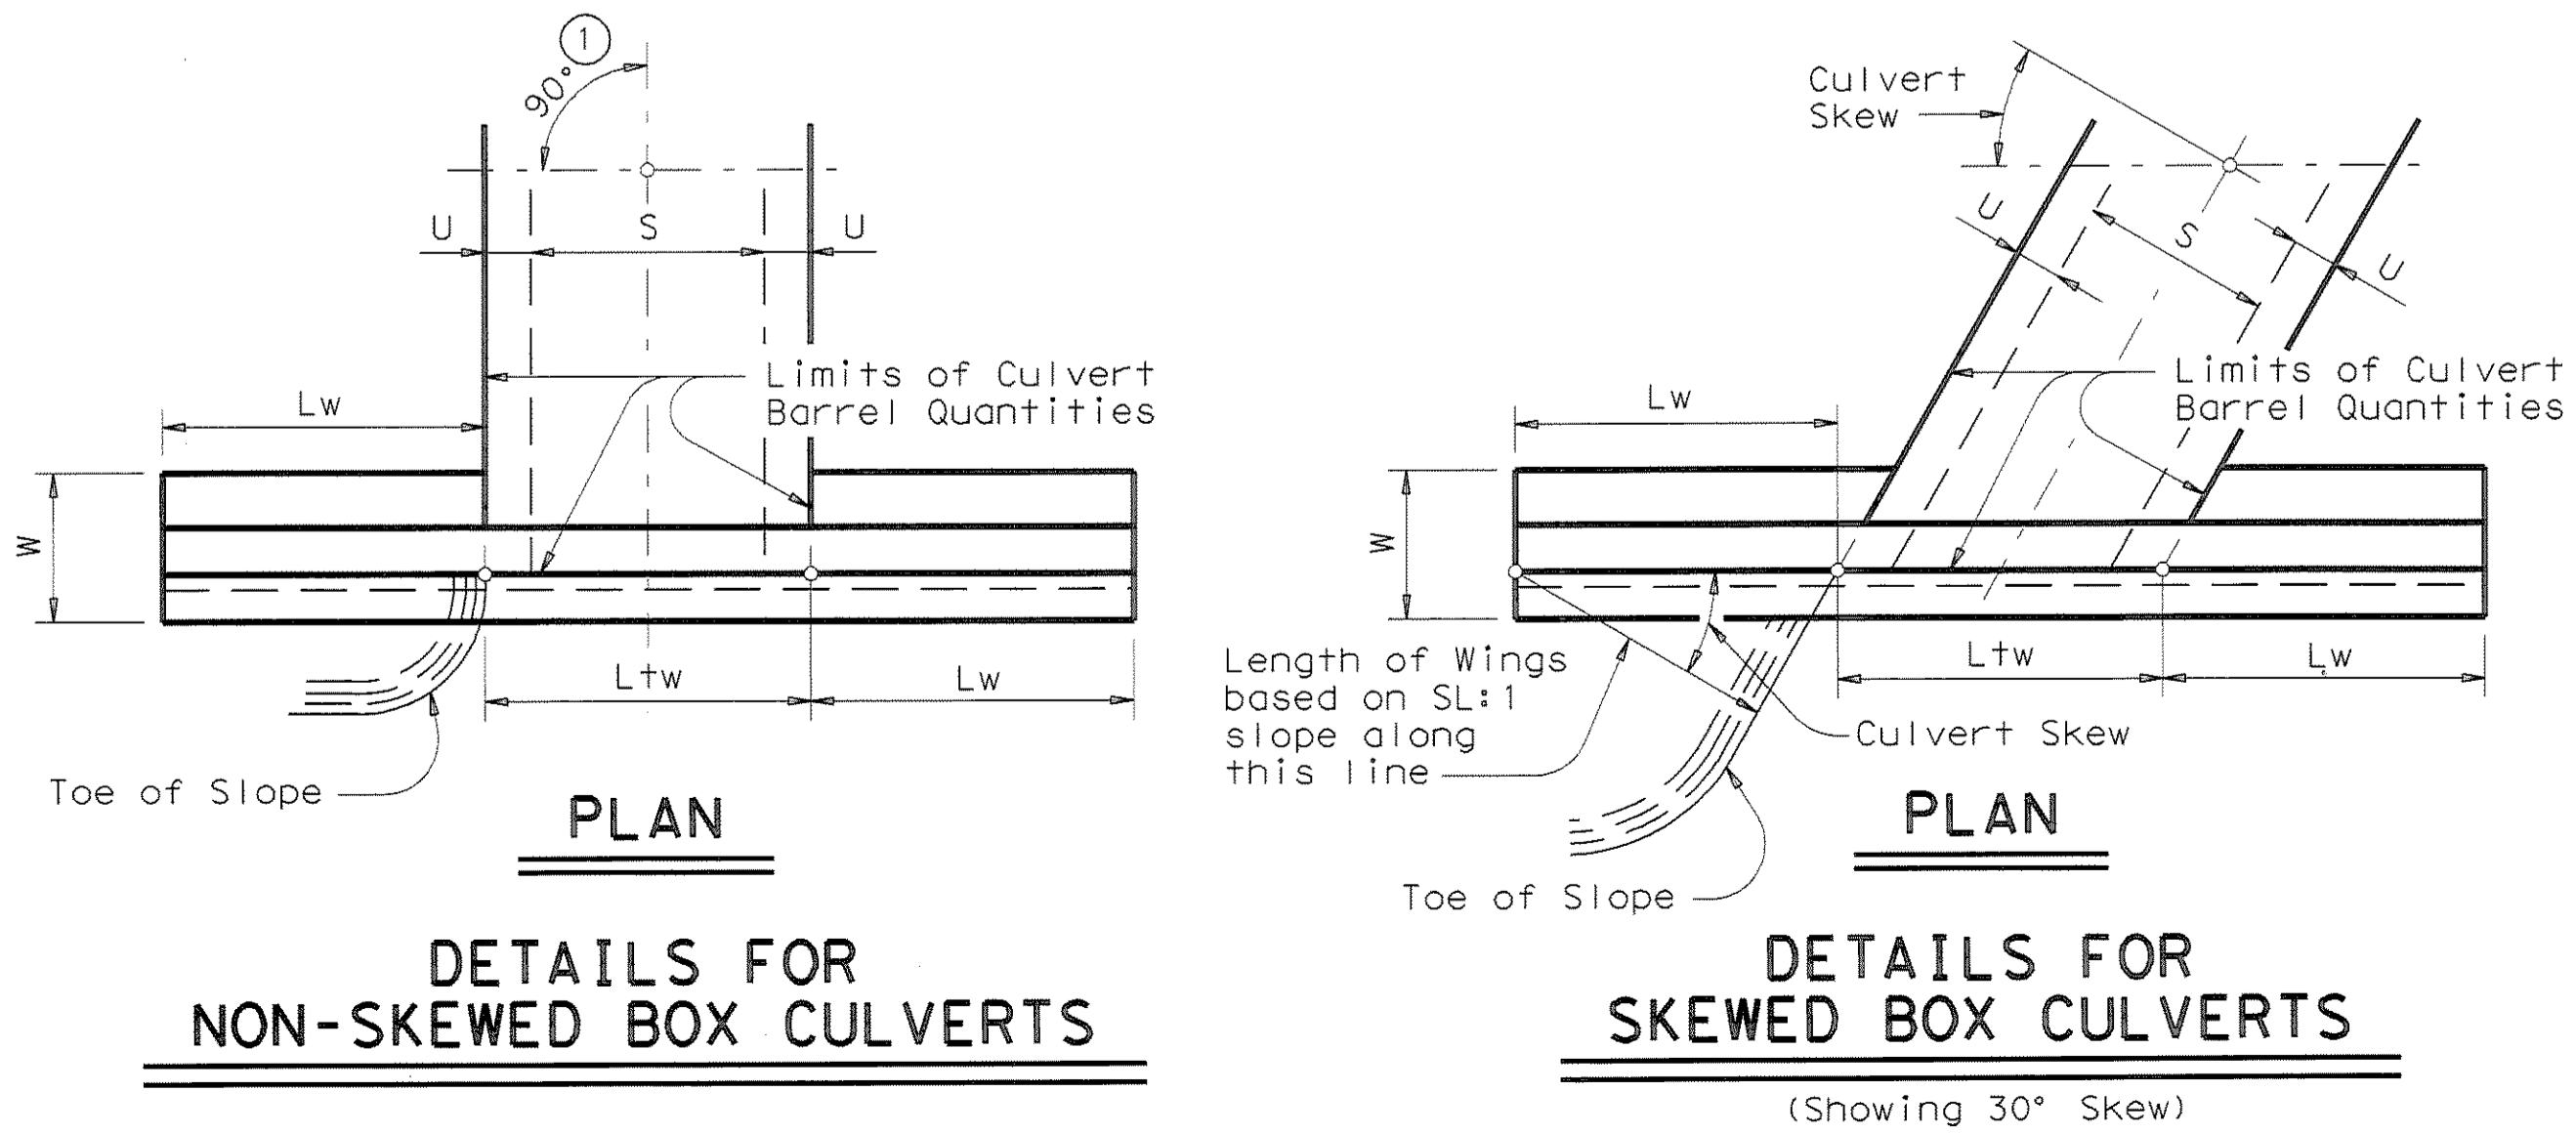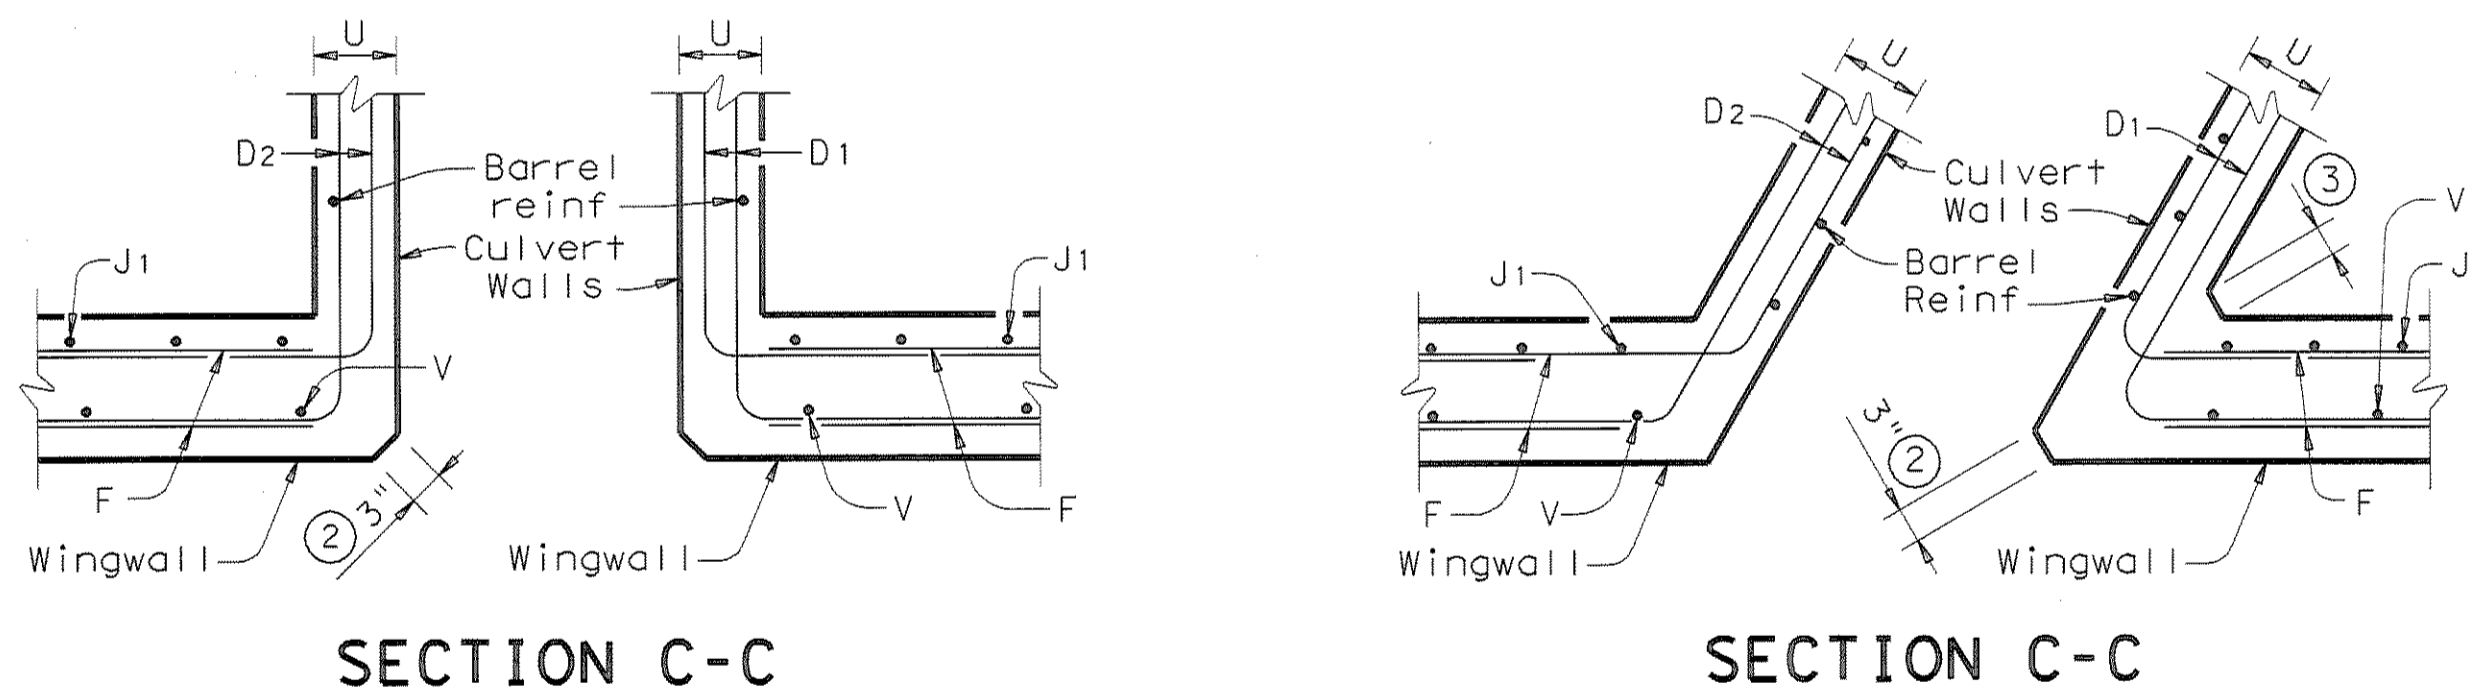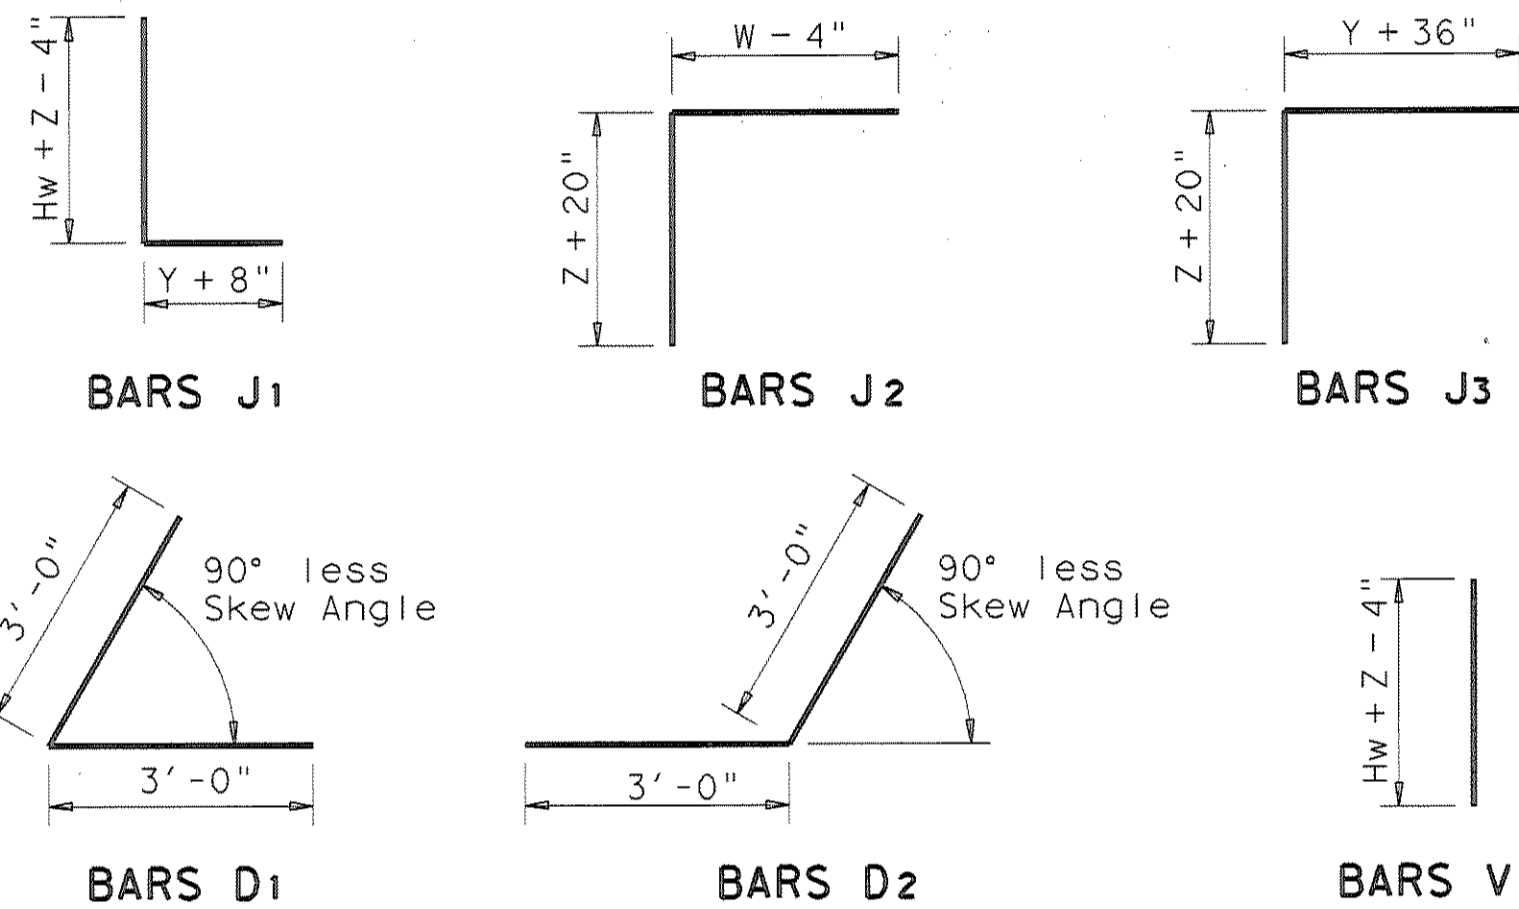

- Skew Angle = 0°
- At discharge end, chamfer may be 3/4".
- For 15° Skew ~ 1"  
For 30° Skew ~ 2"  
For 45° Skew ~ 3"
- Quantities shown are for two wings. To determine total quantities for two wings, multiply the tabulated values by  $Lw$ .
- Provide weepholes for  $Hw = 5'-0"$  and greater. Fill around weepholes with coarse gravel.
- Extend Bars  $E_1$  1'-6" minimum into the bottom slab of the culvert.
- Lap Bars  $M_1$  1'-6" minimum with Bars  $M_2$ .
- Bars  $G$  shall be equally spaced at 1'-0" maximum, placed as shown. There shall be at least 4 Bars  $G$  per wing.
- 0" min to 5'-0" max. For T6 or C6 Rail, see T6-CM standard for additional details. For all other rail types, refer to the RAC standard. For curbs without rail and greater than 1'-0" high, see ECD standard for additional details. Estimated curb heights are shown elsewhere in the plans.
- For vehicle safety, the following requirements must be met:  
  - For structures without bridge rail, curbs shall project no more than 3" above finished grade.
  - For structures with bridge rail, curbs shall be flush with finished grade.
 Curb heights shall be reduced, if necessary, to meet the above requirements. No changes will be made in quantities and no additional compensation will be allowed for this work.
- 1'-0" typical. 2'-0" typical when RAC standard is referenced elsewhere in the plans.

**GENERAL NOTES:**

Designed according to current AASHTO Standard and Interim Specifications.  
 All reinforcing steel shall be Grade 60.  
 All concrete shall be Class "C" and shall have a minimum compressive strength of 3600 psi.  
 All reinforcing bars shall be adjusted to provide a minimum of 1 1/4" clear cover.  
 When structure is founded on solid rock, depth of toewalls for culverts and wingwalls may be reduced or eliminated as directed by the Engineer.  
 See BCS sheet for additional dimensions and information.  
 The quantities for concrete and reinforcing steel resulting from the formulas given on this sheet are for Contractor's information only.

RECORD PLANS  
MARCH 28, 2008

Texas Department of Transportation  
Bridge Division

**CONCRETE WINGWALLS WITH PARALLEL WINGS FOR SKEWED AND NON-SKEWED BOX CULVERTS**

PW


FILE: pwstd01.dgn	DWG: GAF	CHK: CAT	DATE: TxDOT	CHK: GAF
© TxDOT May 2005	DISTRICT:	FEDERAL AID PROJECT:	SHEET	
REVISIONS	COUNTY:	CONTROL SECT:	JOB   HIGHWAY	

DISCLAIMER: The use of this standard is governed by the Texas Engineering Practice Act. No warranty of any kind is made by TxDOT for any purpose whatsoever. TxDOT assumes no responsibility for the conversion of this standard to other formats or for incorrect results or damages resulting from its use.

LEVELS DISPLAYED


ACC:					
1					

TABLE OF ESTIMATED CURB QUANTITIES ⑧		
Curb Height "C"	Conc (CY/LF)	Reinf Steel (Lb/LF)
1'-0"	0.037	8.9
1'-6"	0.056	14.3
2'-0"	0.074	15.4
2'-6"	0.093	17.7
3'-0"	0.111	18.8
3'-6"	0.130	21.2
4'-0"	0.148	22.2
4'-6"	0.167	24.6
5'-0"	0.185	25.6

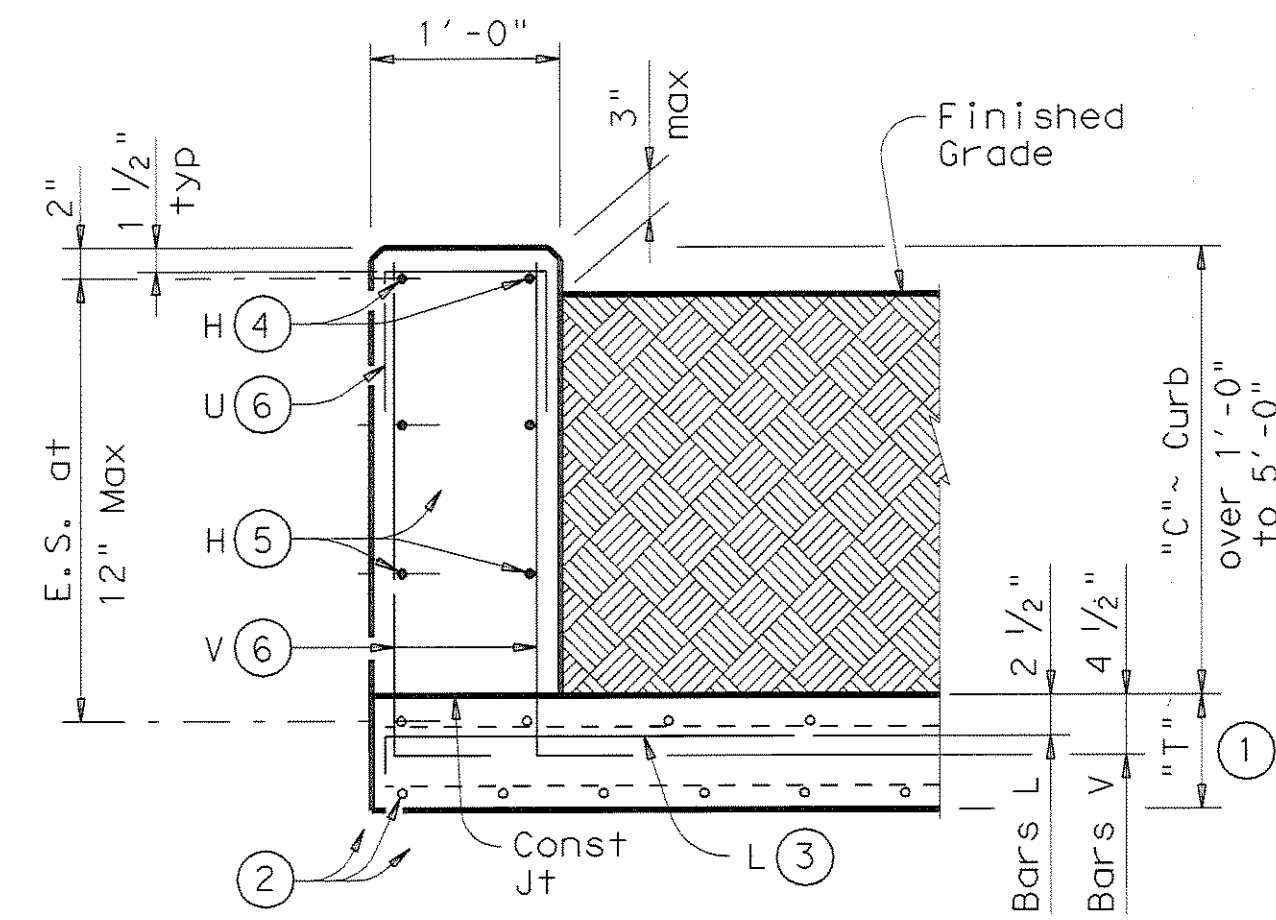


**TYPICAL SECTION**


Used for Curbs over 1'-0" to 5'-0"

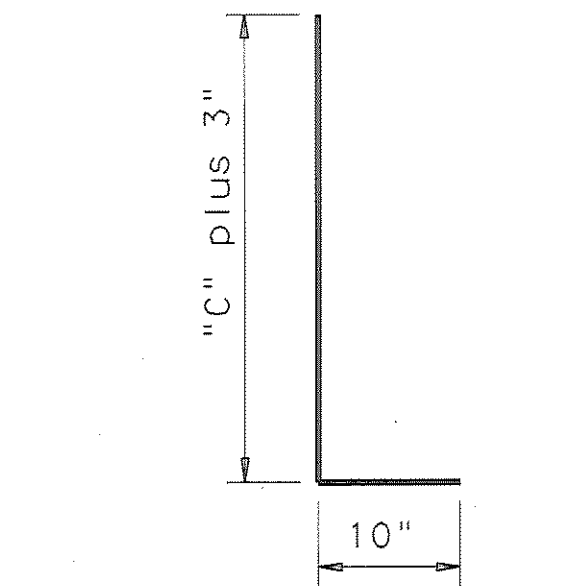


**BARS V (#5)**  
Spaced at 12" max

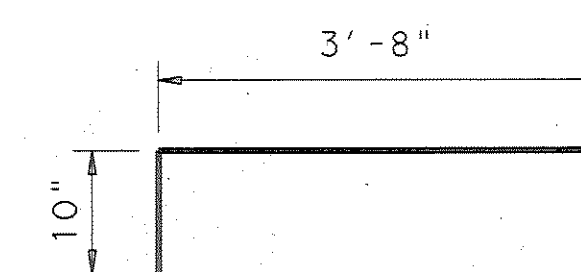

**BARS L (#5)**  
Spaced at 12" max

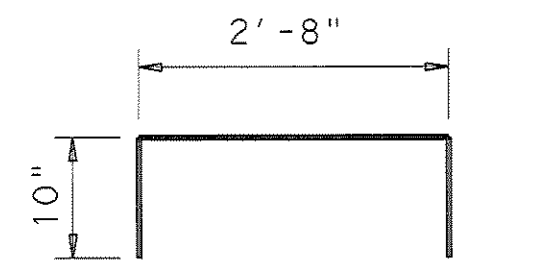

**OPTIONAL BARS L (#5)**  
Spaced at 12" max

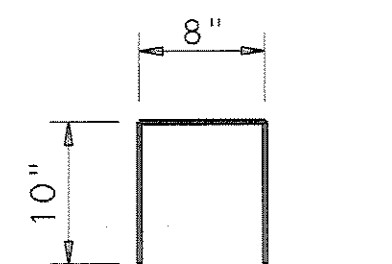

**BARS U (#4)**  
Spaced at 12" max

- ① "T" is equal to the culvert top slab thickness. For Precast Boxes with slabs less than 7", see SCP-MD Standard for additional details.
- ② Normal culvert slab bars adjusted as necessary to clear obstructions.
- ③ Place bars L as shown. Tilt hook as necessary to maintain cover.
- ④ Place normal culvert curb bars H (#4) as shown. Adjust as necessary to clear obstructions.
- ⑤ Additional bars H (#4) as required to maintain 12" max spa.
- ⑥ Replace normal culvert curb bars K with one bar U and two bars V as shown spaced at 12" max. Adjust length of bars V as necessary to maintain clear cover.
- ⑦ Optional bars L are to be used only for precast box culverts with 3'-0" closure pour.
- ⑧ Quantities shown are for contractor's information only. Quantities are per linear foot of curb length. The values for each section type in table can be interpolated for intermediate values of curb height, "C". Quantity includes bars K (when applicable).

**GENERAL NOTES:**

Designed according to current AASHTO Standard and Interim Specifications.  
 These extended curb details have sufficient strength to allow for future retrofit of Type T6 railing. These details are not suitable for the mounting of other rail types. For new construction using T6 railing, use the T6-CM standards.  
 All reinforcing shall be Grade 60. Adjust reinforcing as necessary to provide 1/4" cover.  
 All concrete for curbs shall be Class "C" with a minimum compressive strength of 3600 psi.  
 This Curb shall be considered as part of the Box Culvert for payment.  
 For vehicle safety, the top of the curb shall project no more than 3" above the finished grade.

DISCLAIMER: The use of this standard is governed by the "Texas Engineering Practice Act". No warranty of any kind is made by TxDOT for any purpose whatsoever. TxDOT assumes no responsibility for the conversion of this standard to other formats or for incorrect results or damages resulting from its use.

LEVELS DISPLAYED	PATH
1	

RECORD PLANS  
MARCH 28, 2008

**EXTENDED CURB DETAILS**  
FOR BOX CULVERTS WITH CURBS OVER 1'-0" TO 5'-0" TALL


**ECD**

FILE: ecdstgdl.dgn	DN: GAF	CK:	DN: TxDOT	CK: GAF
© TxDOT May 2005	DISTRICT	FEDERAL AID PROJECT	SHEET	
REVISIONS			<b>D303</b>	
	COUNTY	CONTROL SECT	JOB	HIGHWAY




DISCLAIMER: The use of this standard is governed by the "Texas Engineering Practice Act". No warranty of any kind is made by TxDOT for any purpose whatsoever. TxDOT assumes no responsibility for the conversion of this standard to other formats or for incorrect results or damages resulting from its use.

ACC: LEVELS DISPLAYED

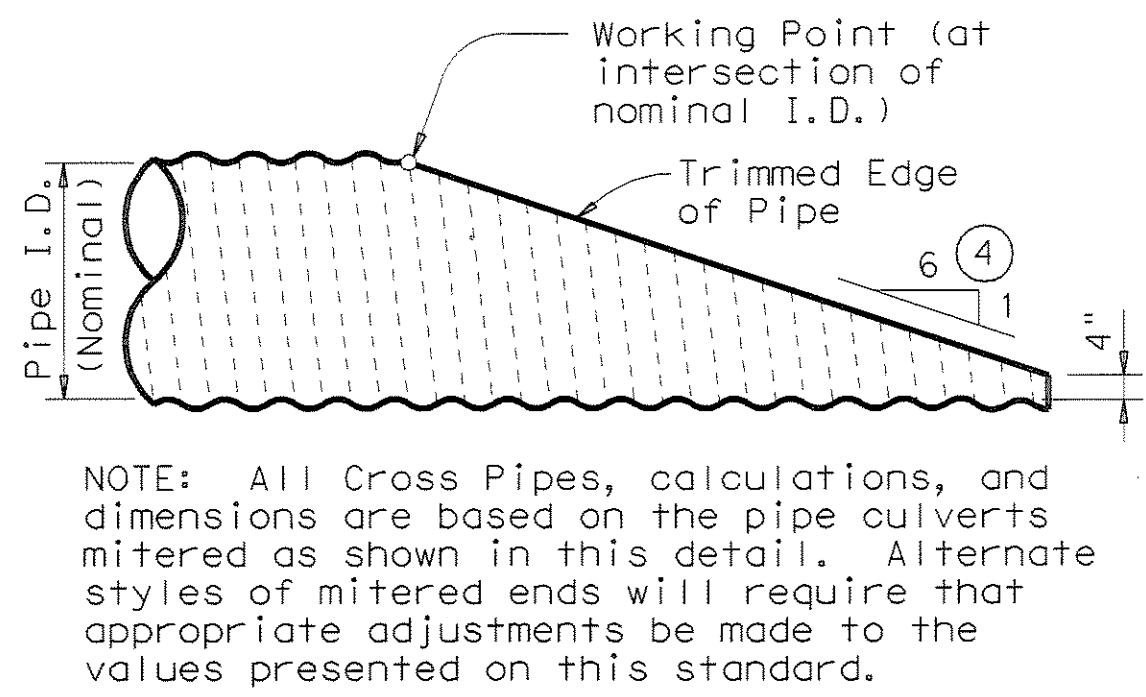


**SIDE ELEVATION OF TYPICAL PIPE CULVERT MITER**

(Showing Corrugated Metal Pipe Culvert.)  
 (Details at Concrete Pipe Culvert are similar.)

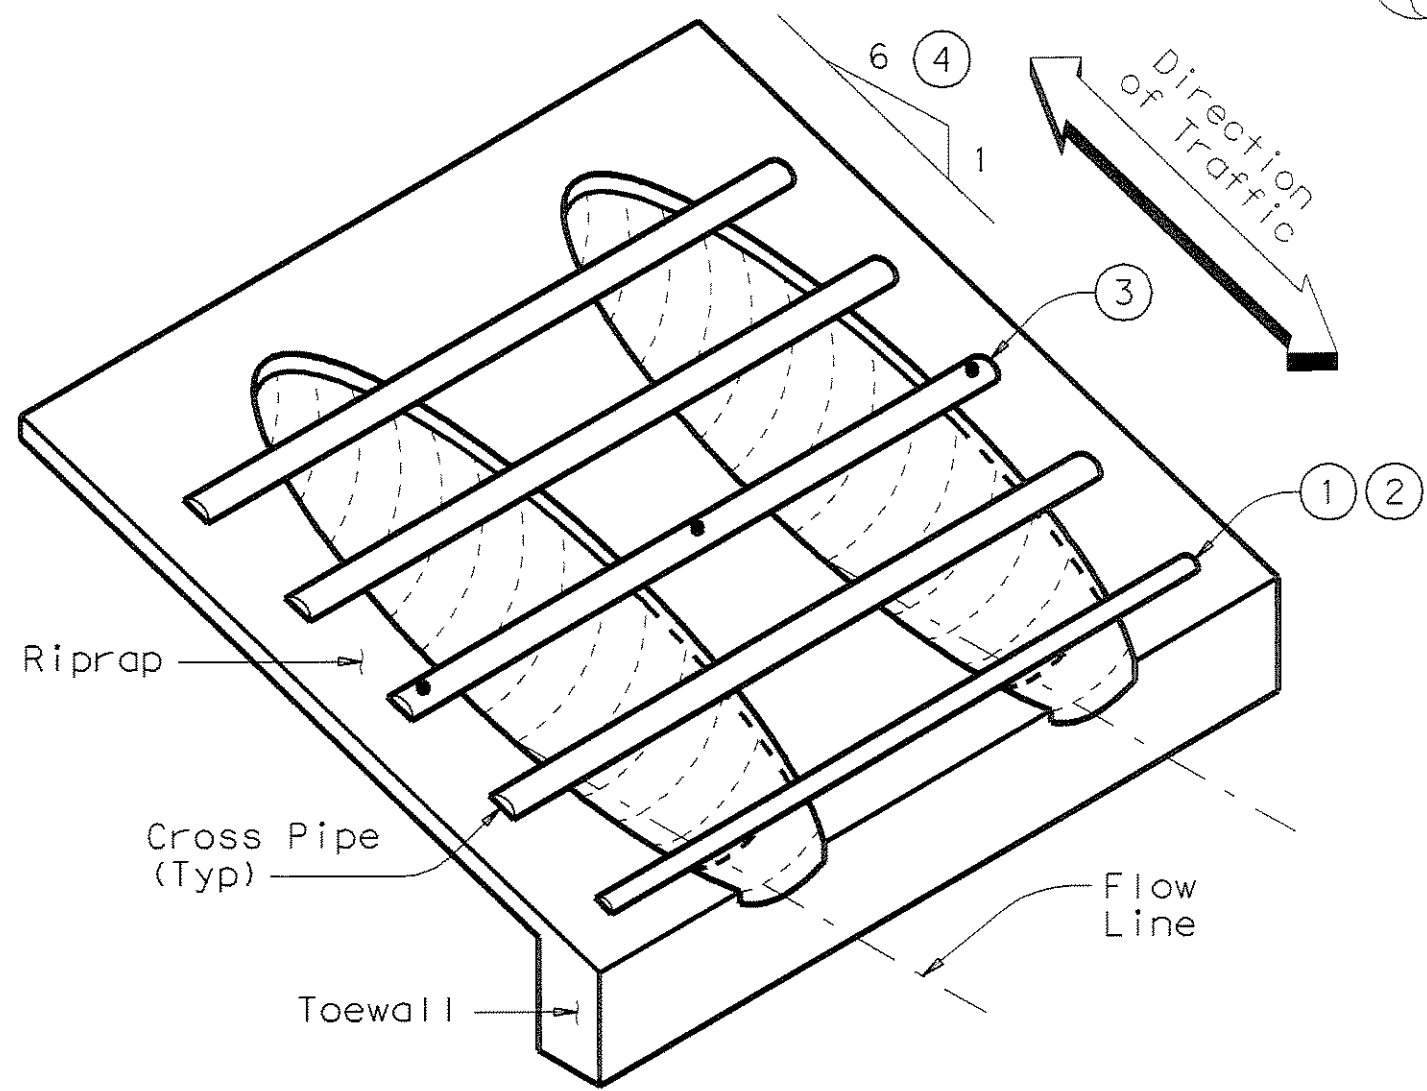


**ISOMETRIC VIEW OF TYPICAL INSTALLATION**

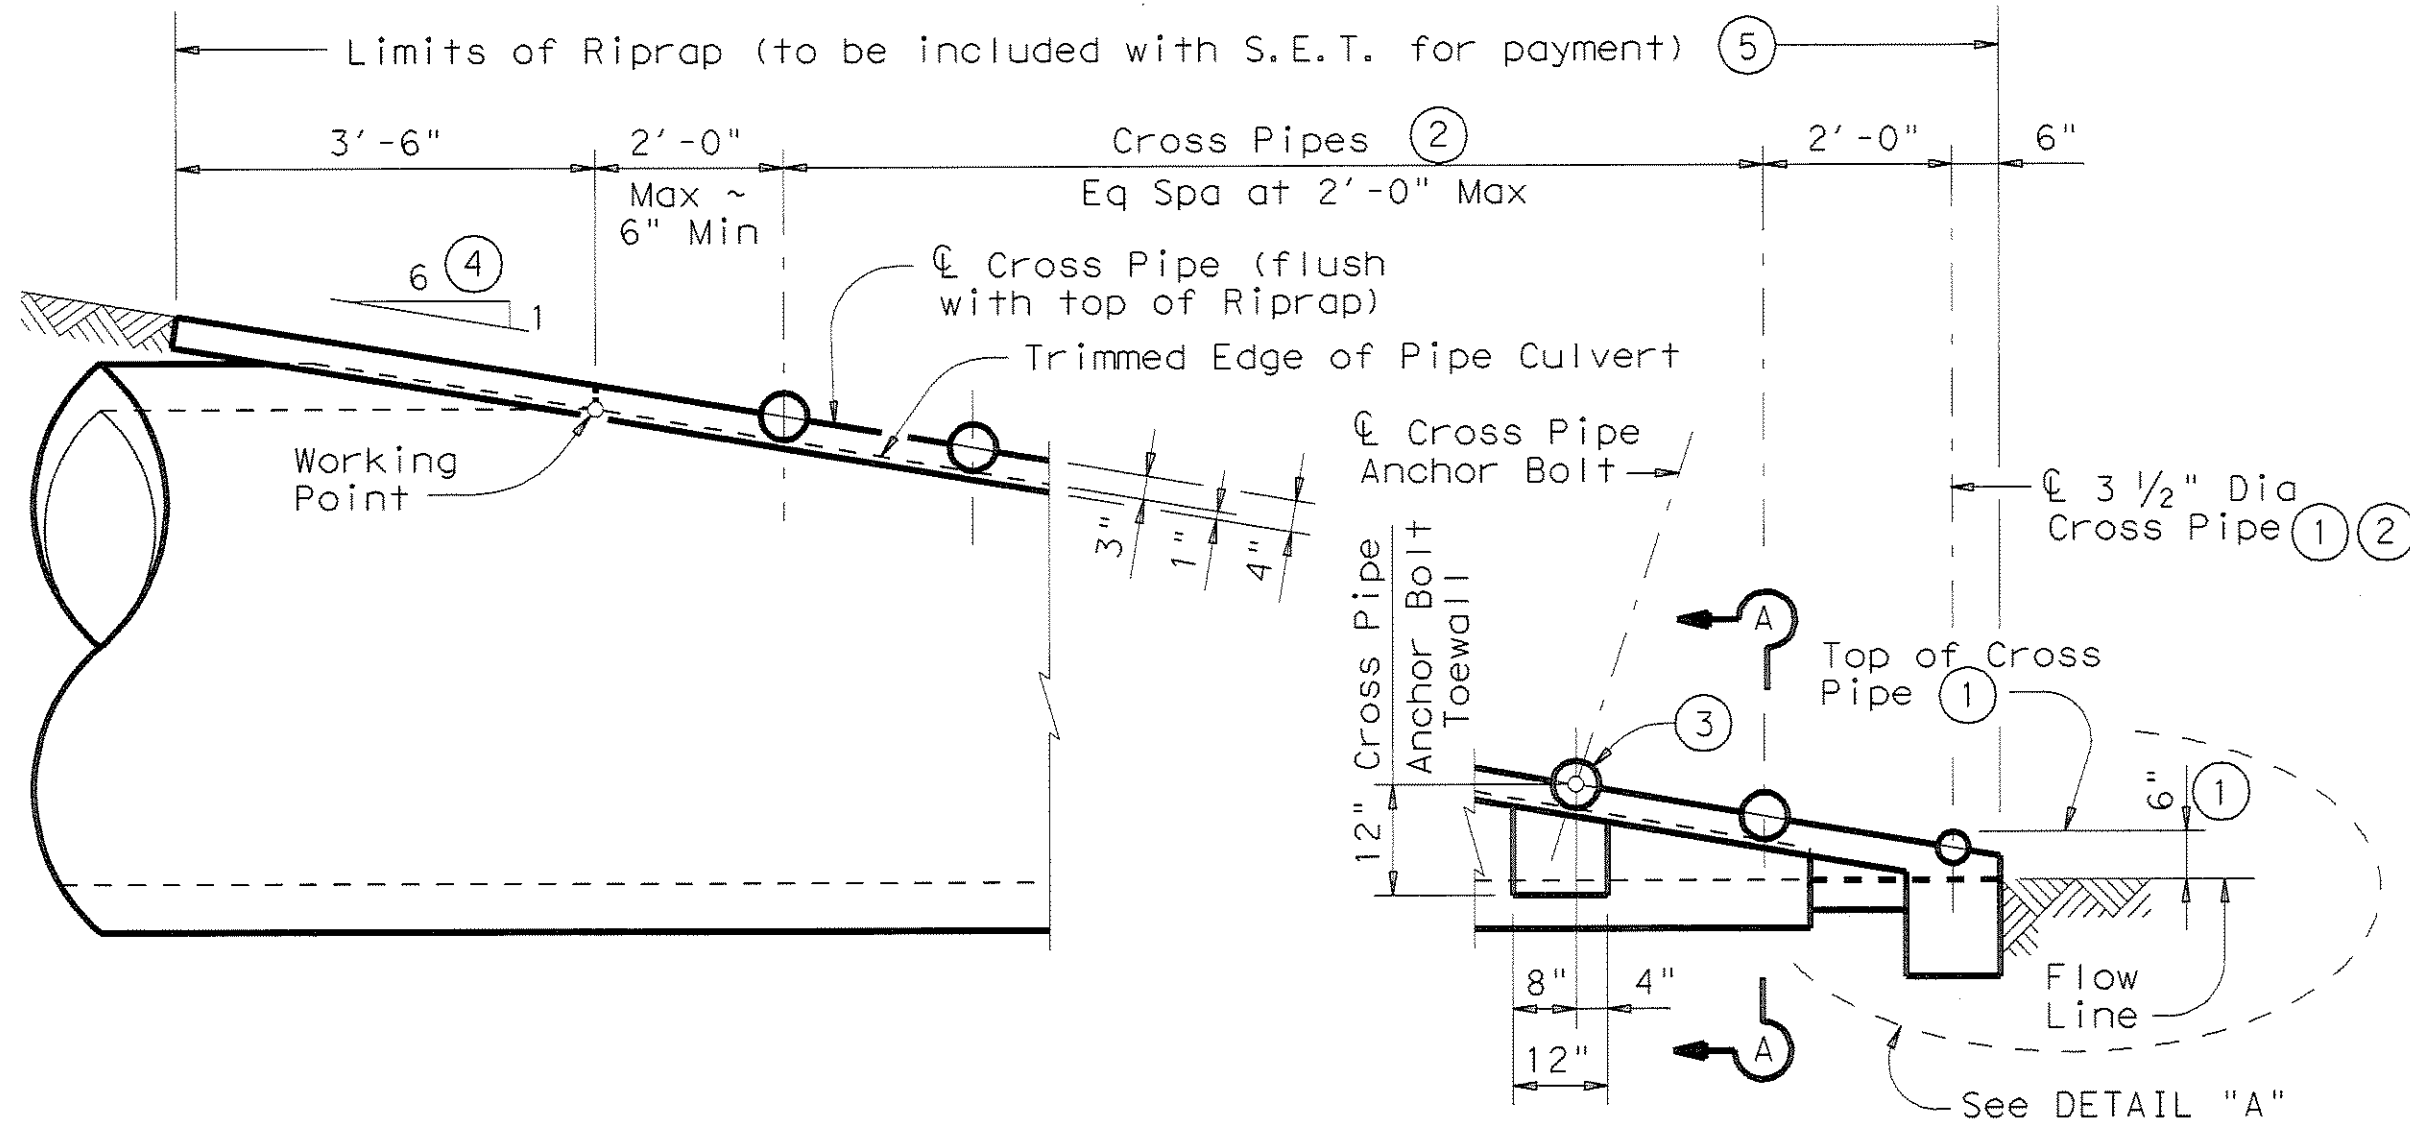


**SIDE ELEVATION OF CAST-IN-PLACE CONCRETE**


(Showing Concrete Pipe Culvert.)  
 (Details at Corrugated Metal Pipe Culvert are similar.)

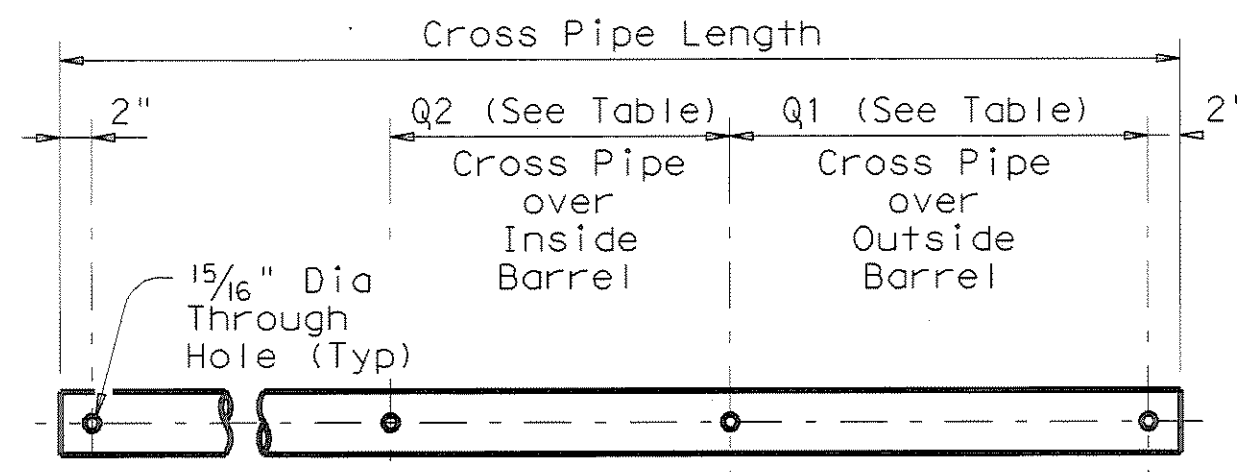

**PIPE W/ BOLTED ANCHOR**

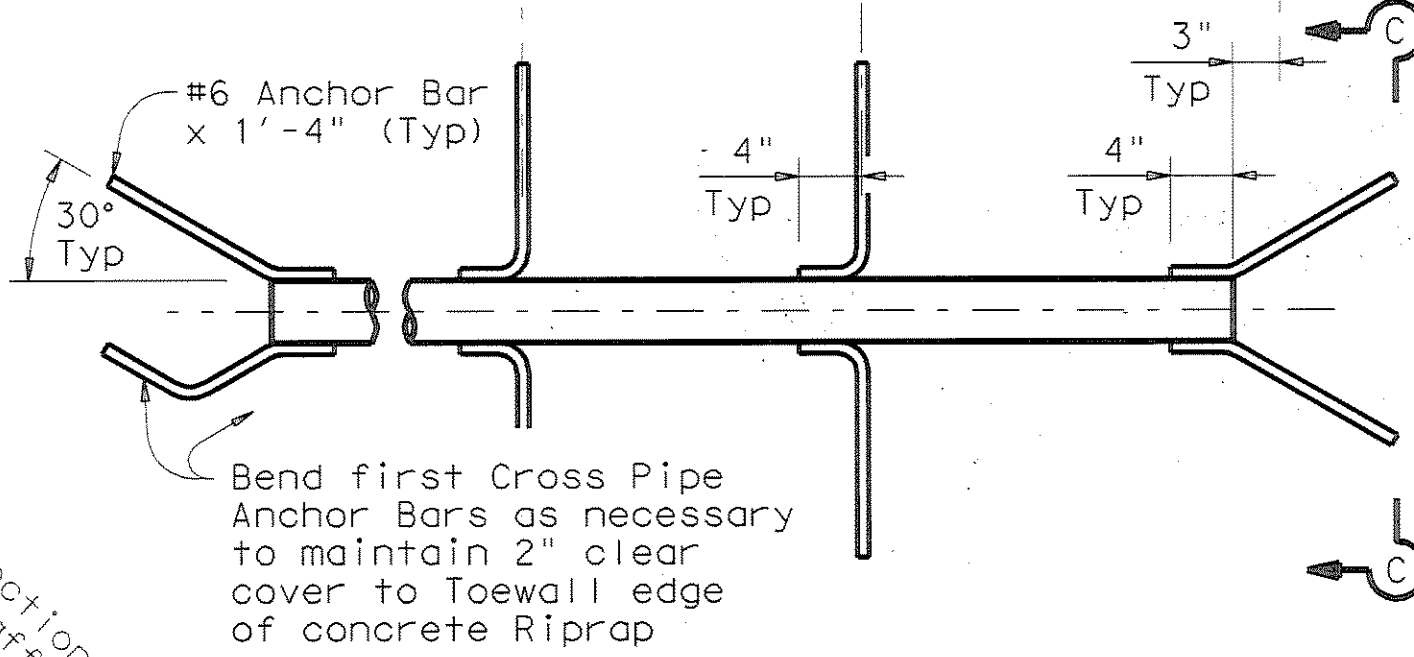


**PIPE W/ ANCHOR BARS**

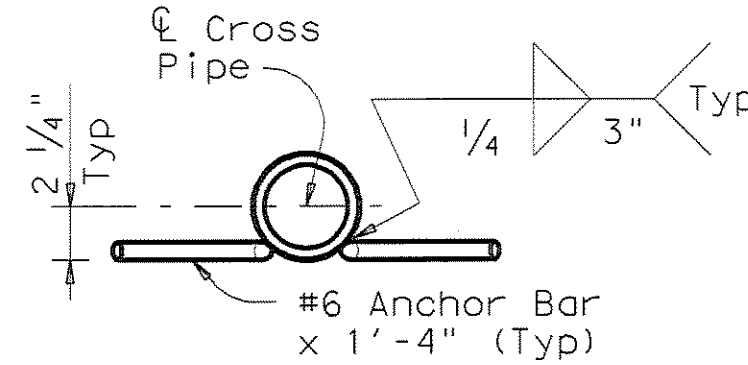


**SECTION C-C**


**CROSS PIPE DETAILS**

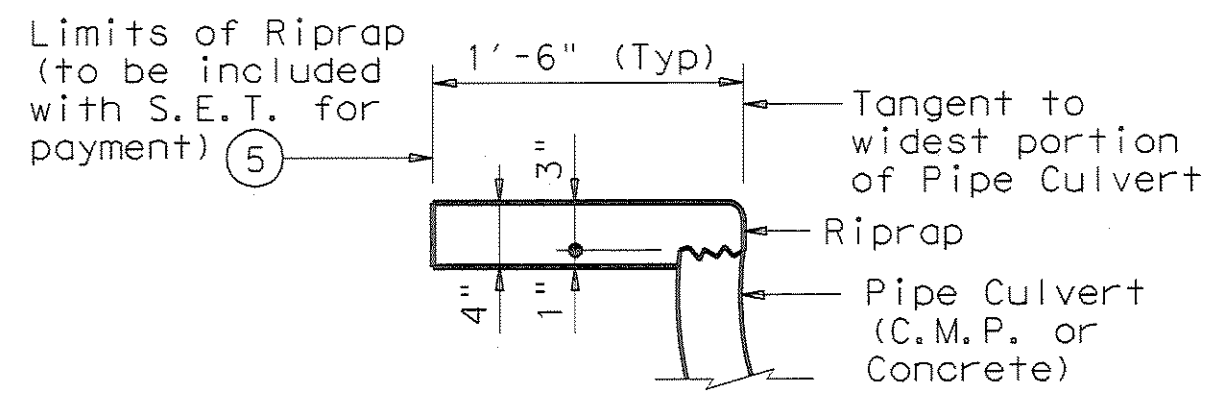

**SHOWING TYPICAL PIPE CULVERT & RIPRAP**

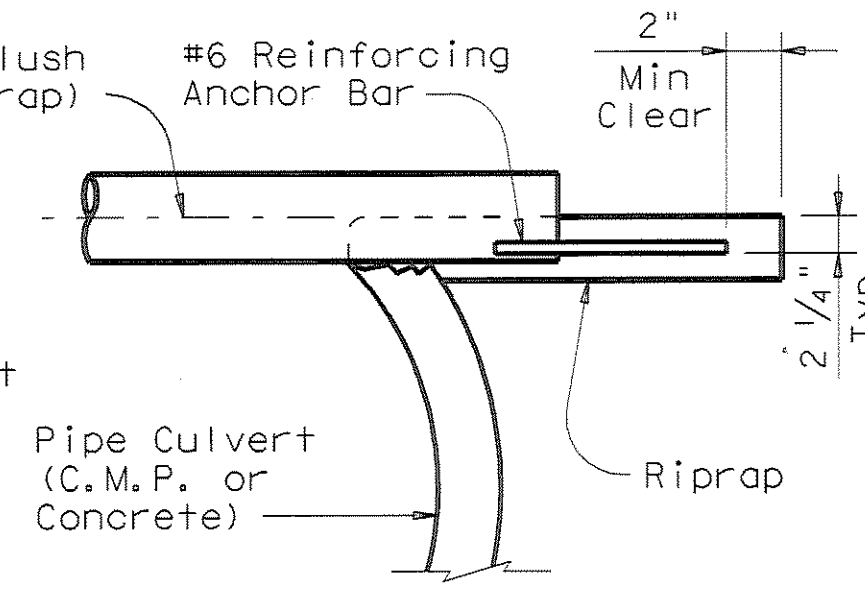

**SHOWING CROSS PIPE WITH ANCHOR BAR**

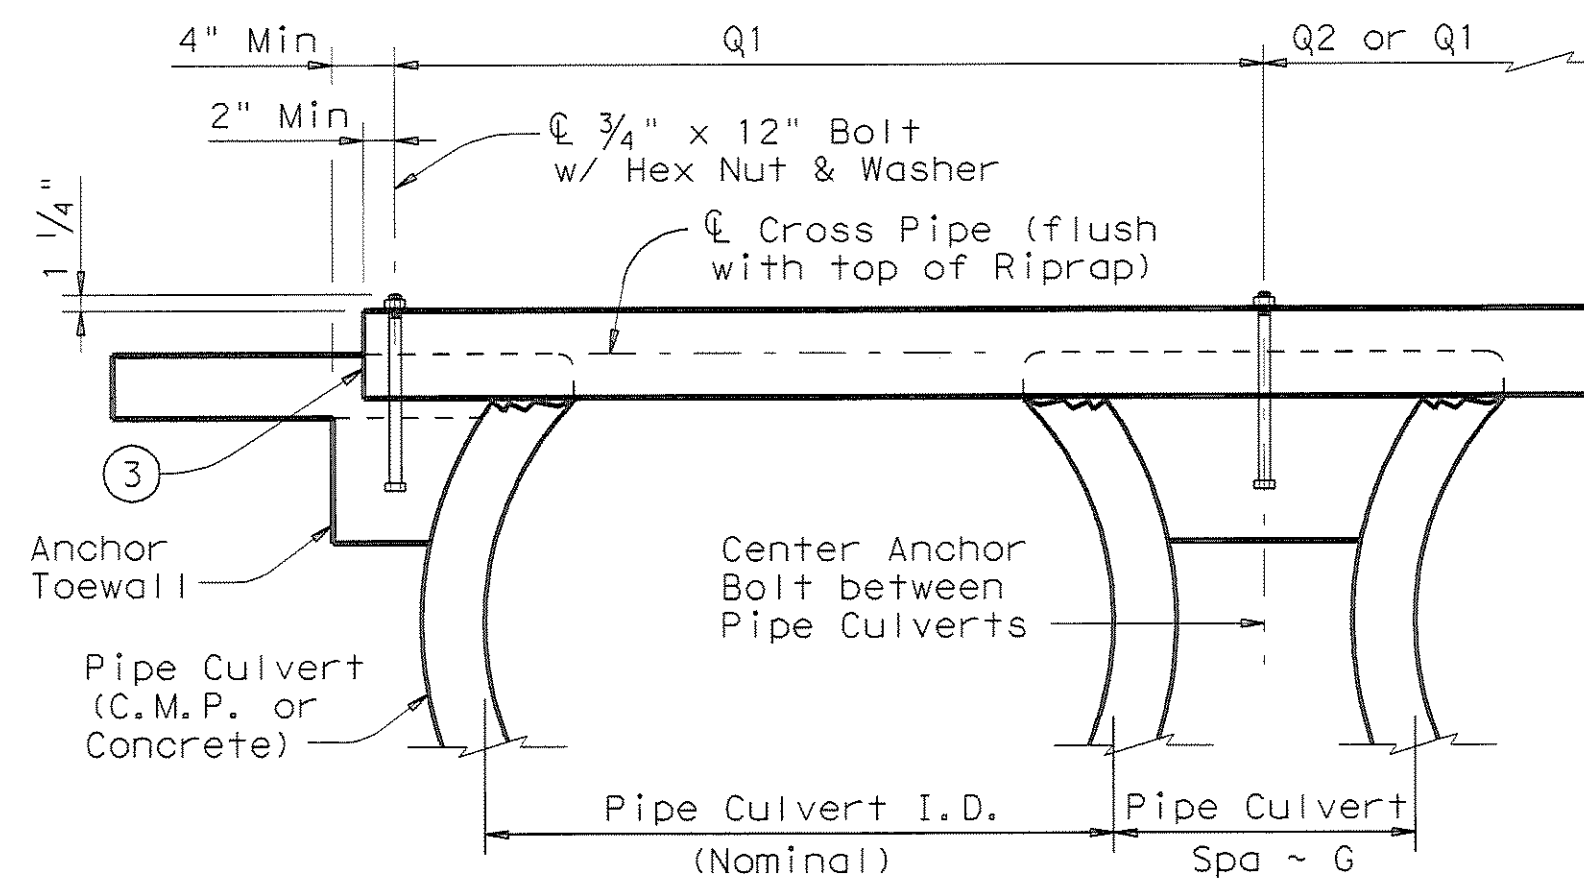

**SHOWING CROSS PIPE WITH BOLTED ANCHOR**

**SECTION A-A**

**CROSS PIPE LENGTHS, REQUIRED PIPE SIZES, & RIPRAP QUANTITIES** (2)

Nominal Culvert I.D.	Conc Riprap (CY) (6)	Pipe Culvert Spa ~ G	Single Barrel ~ Q1	Multi-Barrel ~ Q1	Q2	Conditions for use of Cross Pipes	Cross Pipe Size
12"	0.6	9"	N/A	2' - 1"	1' - 9"	3 or more Pipe Culverts	3" Std (3,500" O.D.)
15"	0.7	11"	N/A	2' - 5"	2' - 2"		
18"	0.8	1' - 2"	N/A	2' - 10"	2' - 8"		
21"	0.9	1' - 4"	N/A	3' - 2"	3' - 1"		
24"	0.9	1' - 7"	N/A	3' - 6"	3' - 7"	3 or more Pipe Culverts	3 1/2" Std (4,000" O.D.)
27"	1.0	1' - 8"	N/A	3' - 10"	3' - 11"		
30"	1.1	1' - 10"	N/A	4' - 2"	4' - 4"	2 or more Pipe Culverts	4" Std (4,500" O.D.)
33"	1.2	1' - 11"	4' - 2"	4' - 5"	4' - 8"	All Pipe Culverts	
36"	1.3	2' - 1"	4' - 5"	4' - 9"	5' - 1"	All Pipe Culverts	5" Std (5,563" O.D.)
42"	1.5	2' - 4"	4' - 11"	5' - 5"	5' - 10"		
48"	1.7	2' - 7"	5' - 5"	6' - 0"	6' - 7"		
54"	2.0	3' - 0"	5' - 11"	6' - 9"	7' - 6"		
60"	2.2	3' - 3"	6' - 5"	7' - 4"	8' - 3"	All Pipe Culverts	
66"	2.4	3' - 3"	6' - 11"	7' - 10"	8' - 9"		
72"	2.7	3' - 4"	7' - 5"	8' - 5"	9' - 4"		

- The proper installation of the first Cross Pipe is critical for vehicle safety. The top of the first Cross Pipe must be placed at no more than 6" above the flow line.
- Size of Cross Pipes, except the first bottom pipe, shall be as shown in the PIPE SIZE table. The first bottom pipe shall be 3 1/2" Standard Pipe (4" O.D.).
- The third Cross Pipe from the bottom of the Culvert shall always be installed using a bolted connection. Care shall be taken to ensure that Riprap concrete does not flow into the Cross Pipe so as to permit disassembly of the bolted connection to allow cleanout access. At the Contractor's option, all other Cross Pipes may also be installed using the bolted connection details.
- Match Cross Slope as shown elsewhere in the plans. Cross Slope of 6:1 or flatter is required for vehicle safety.
- Riprap placed beyond the limits shown will be paid as Concrete Riprap in accordance with Item 432, "Riprap".
- Quantities shown are for one end of one reinforced Concrete Pipe Culvert. For multiple pipe culverts or for Corrugated Metal Pipe Culverts, quantities will need to be adjusted. Riprap quantities are for Contractor's information only.

**GENERAL NOTES:**

Cross Pipes are designed for a traversing load of 10,000 pounds at yield as recommended by Research Report 280-2F, "Safety Treatment of Roadside Parallel-Drainage Structures", Texas Transportation Institute, March 1981.

Safety End Treatments shown herein are intended for use in those installations where out of control vehicles are likely to traverse the openings approximately perpendicular to the Cross Pipes. Riprap and all necessary inverts shall be Concrete Riprap conforming to the requirements of Item 432, "Riprap".

Payment for riprap and toewall is included in the Price Bid for each Safety End Treatment. Cross Pipes shall conform to the requirements of ASTM A53 (Type E or S, Grade B), ASTM A500 (Grade B), or API 5LX52.

Bolts and nuts shall conform to ASTM A307. All steel components, except concrete reinforcing, shall be galvanized after fabrication. Galvanizing damaged during transport or construction shall be repaired in accordance with the specifications.

**RECORD PLANS  
 MARCH 28, 2008**


Texas Department of Transportation  
 Bridge Division  
**SAFETY END TREATMENT  
 FOR 12" DIA TO 72" DIA  
 PIPE CULVERTS  
 TYPE II ~ PARALLEL DRAINAGE**

**SETP-PD**


FILE: setppdse.dgn	DN: GAF	CK: CAT	DW: JRP	CK: GAF
© TxDOT May 2005	DISTRICT	FEDERAL AID PROJECT	SHEET	
REVISIONS	COUNTY	CONTROL SECT	JOB HIGHWAY	

DISCLAIMER: The use of this standard is governed by the "Texas Engineering Practice Act". No warranty of any kind is made by TxDOT for any purpose whatsoever. TxDOT assumes no responsibility for the conversion of this standard to other formats or for incorrect results or damages resulting from its use.

LEVELS DISPLAYED  
 PATH:  
 1

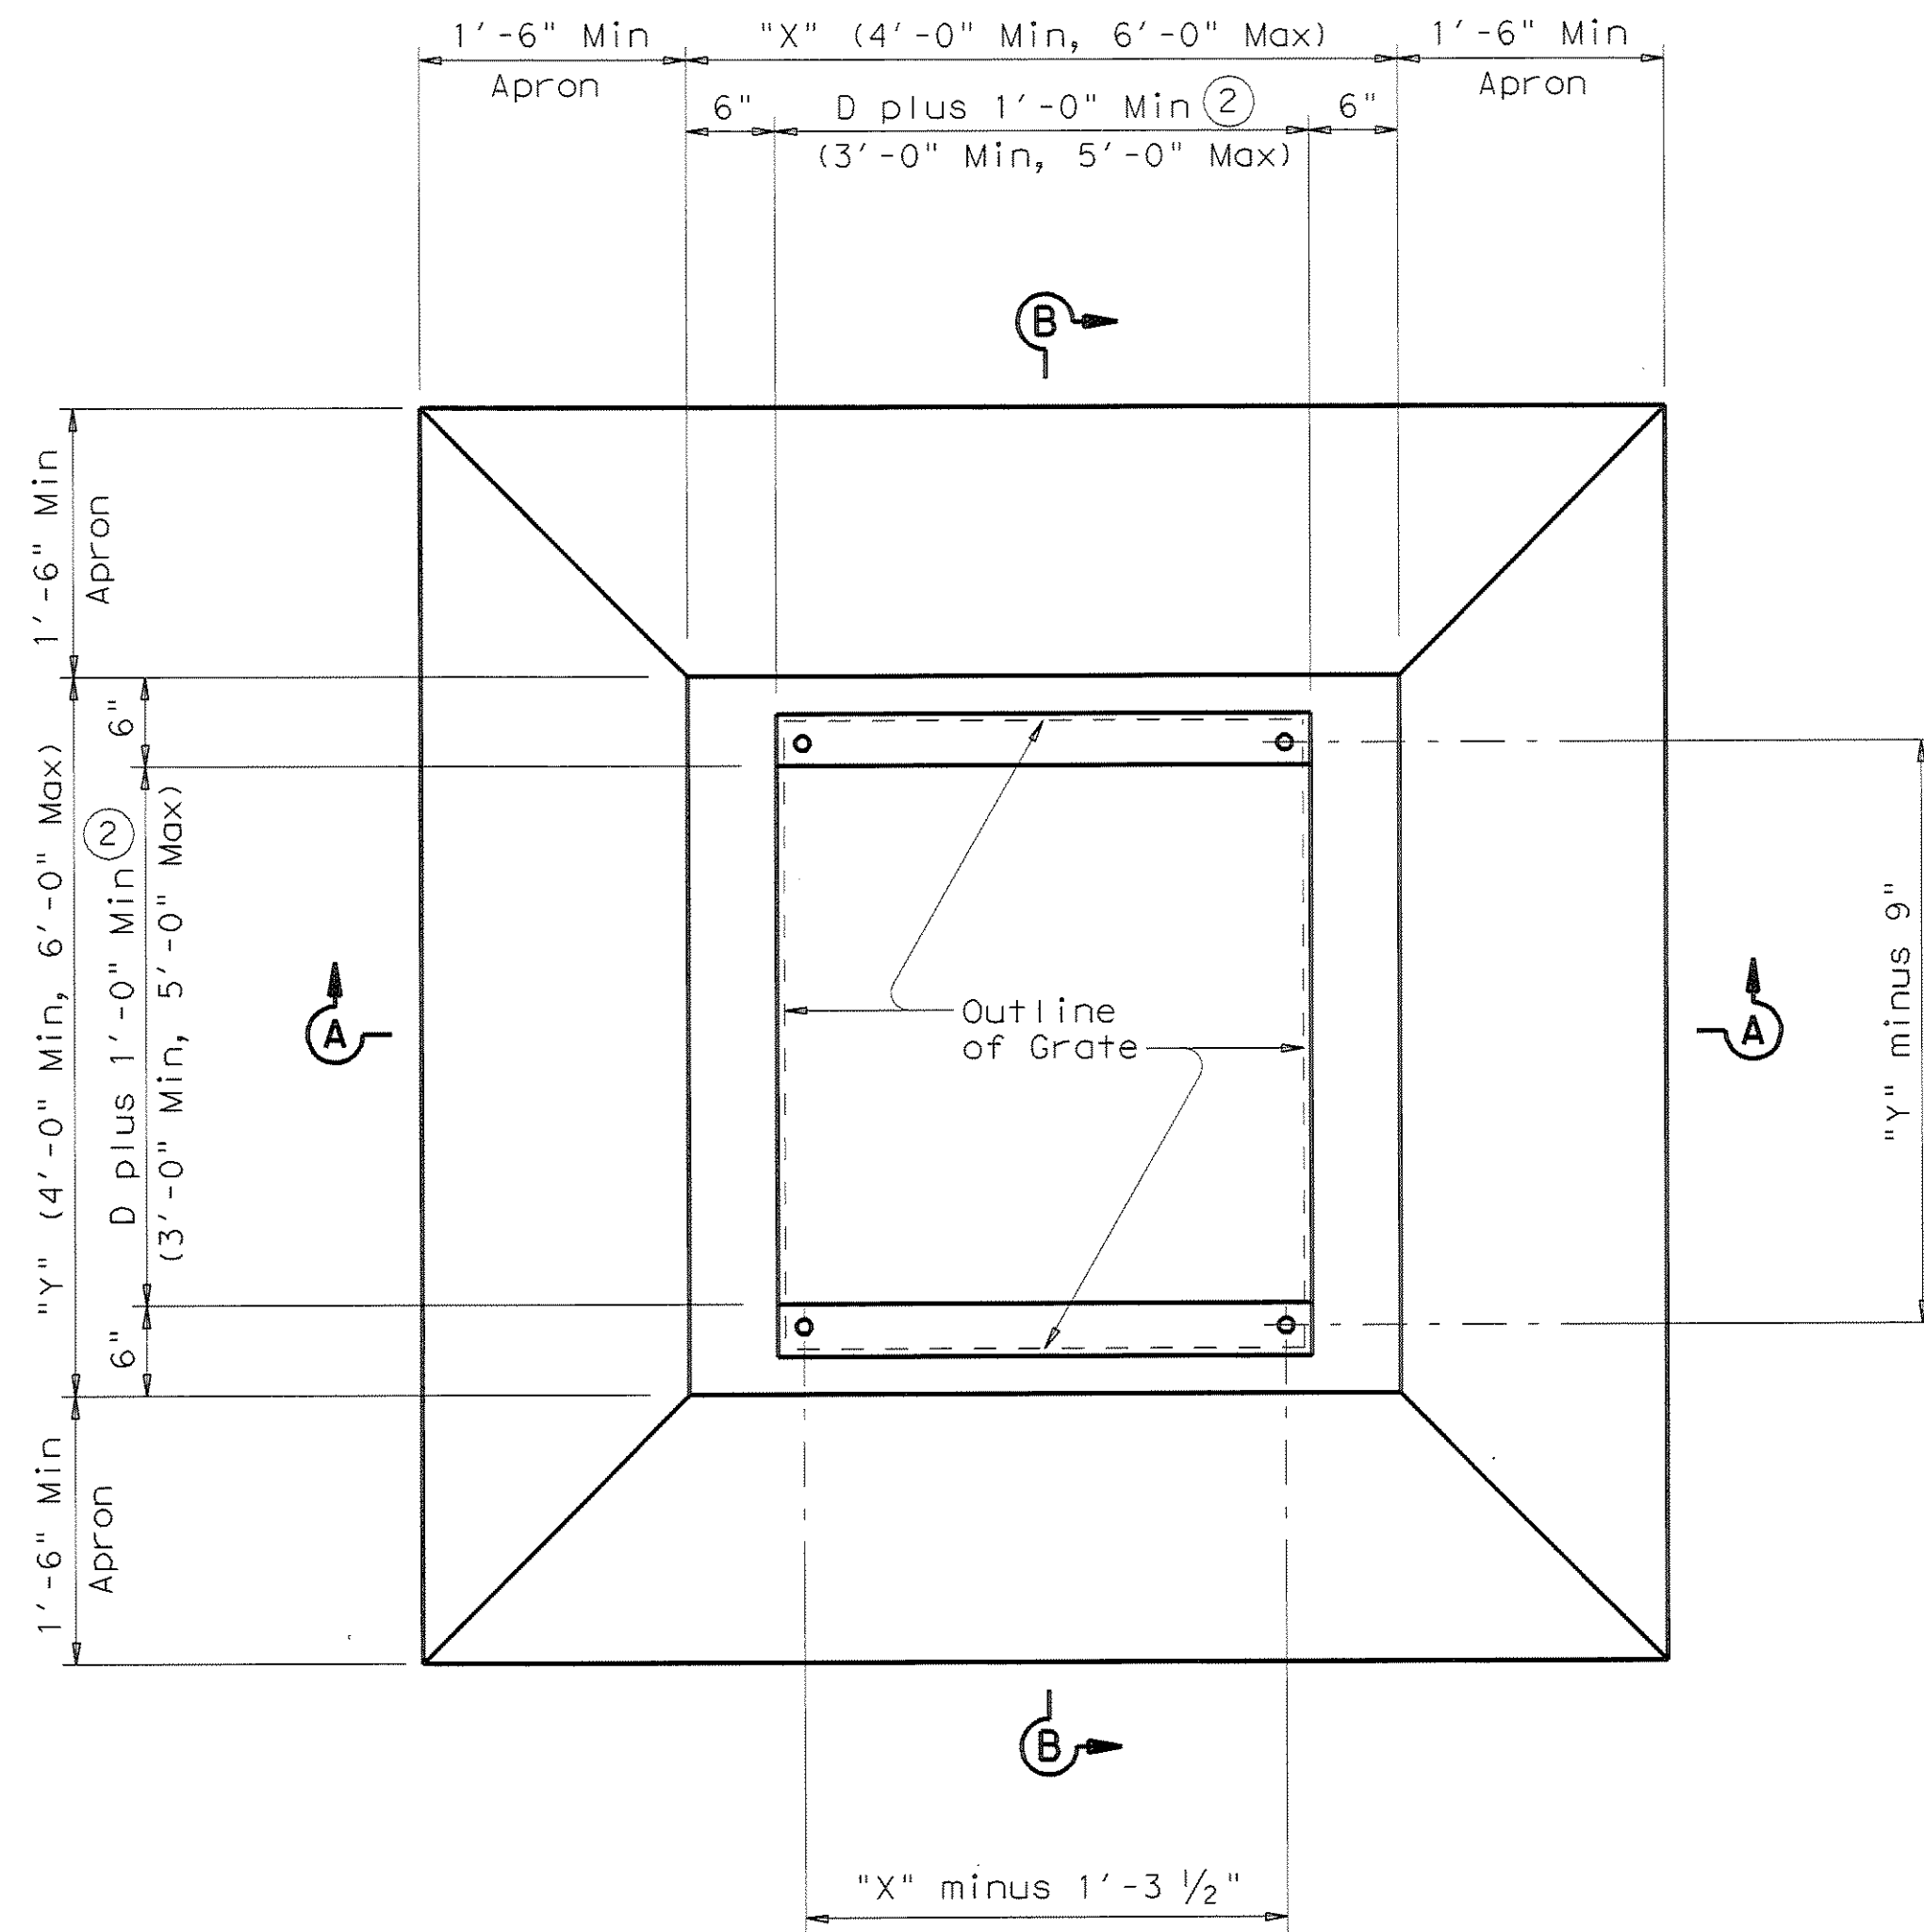


**PLAN**

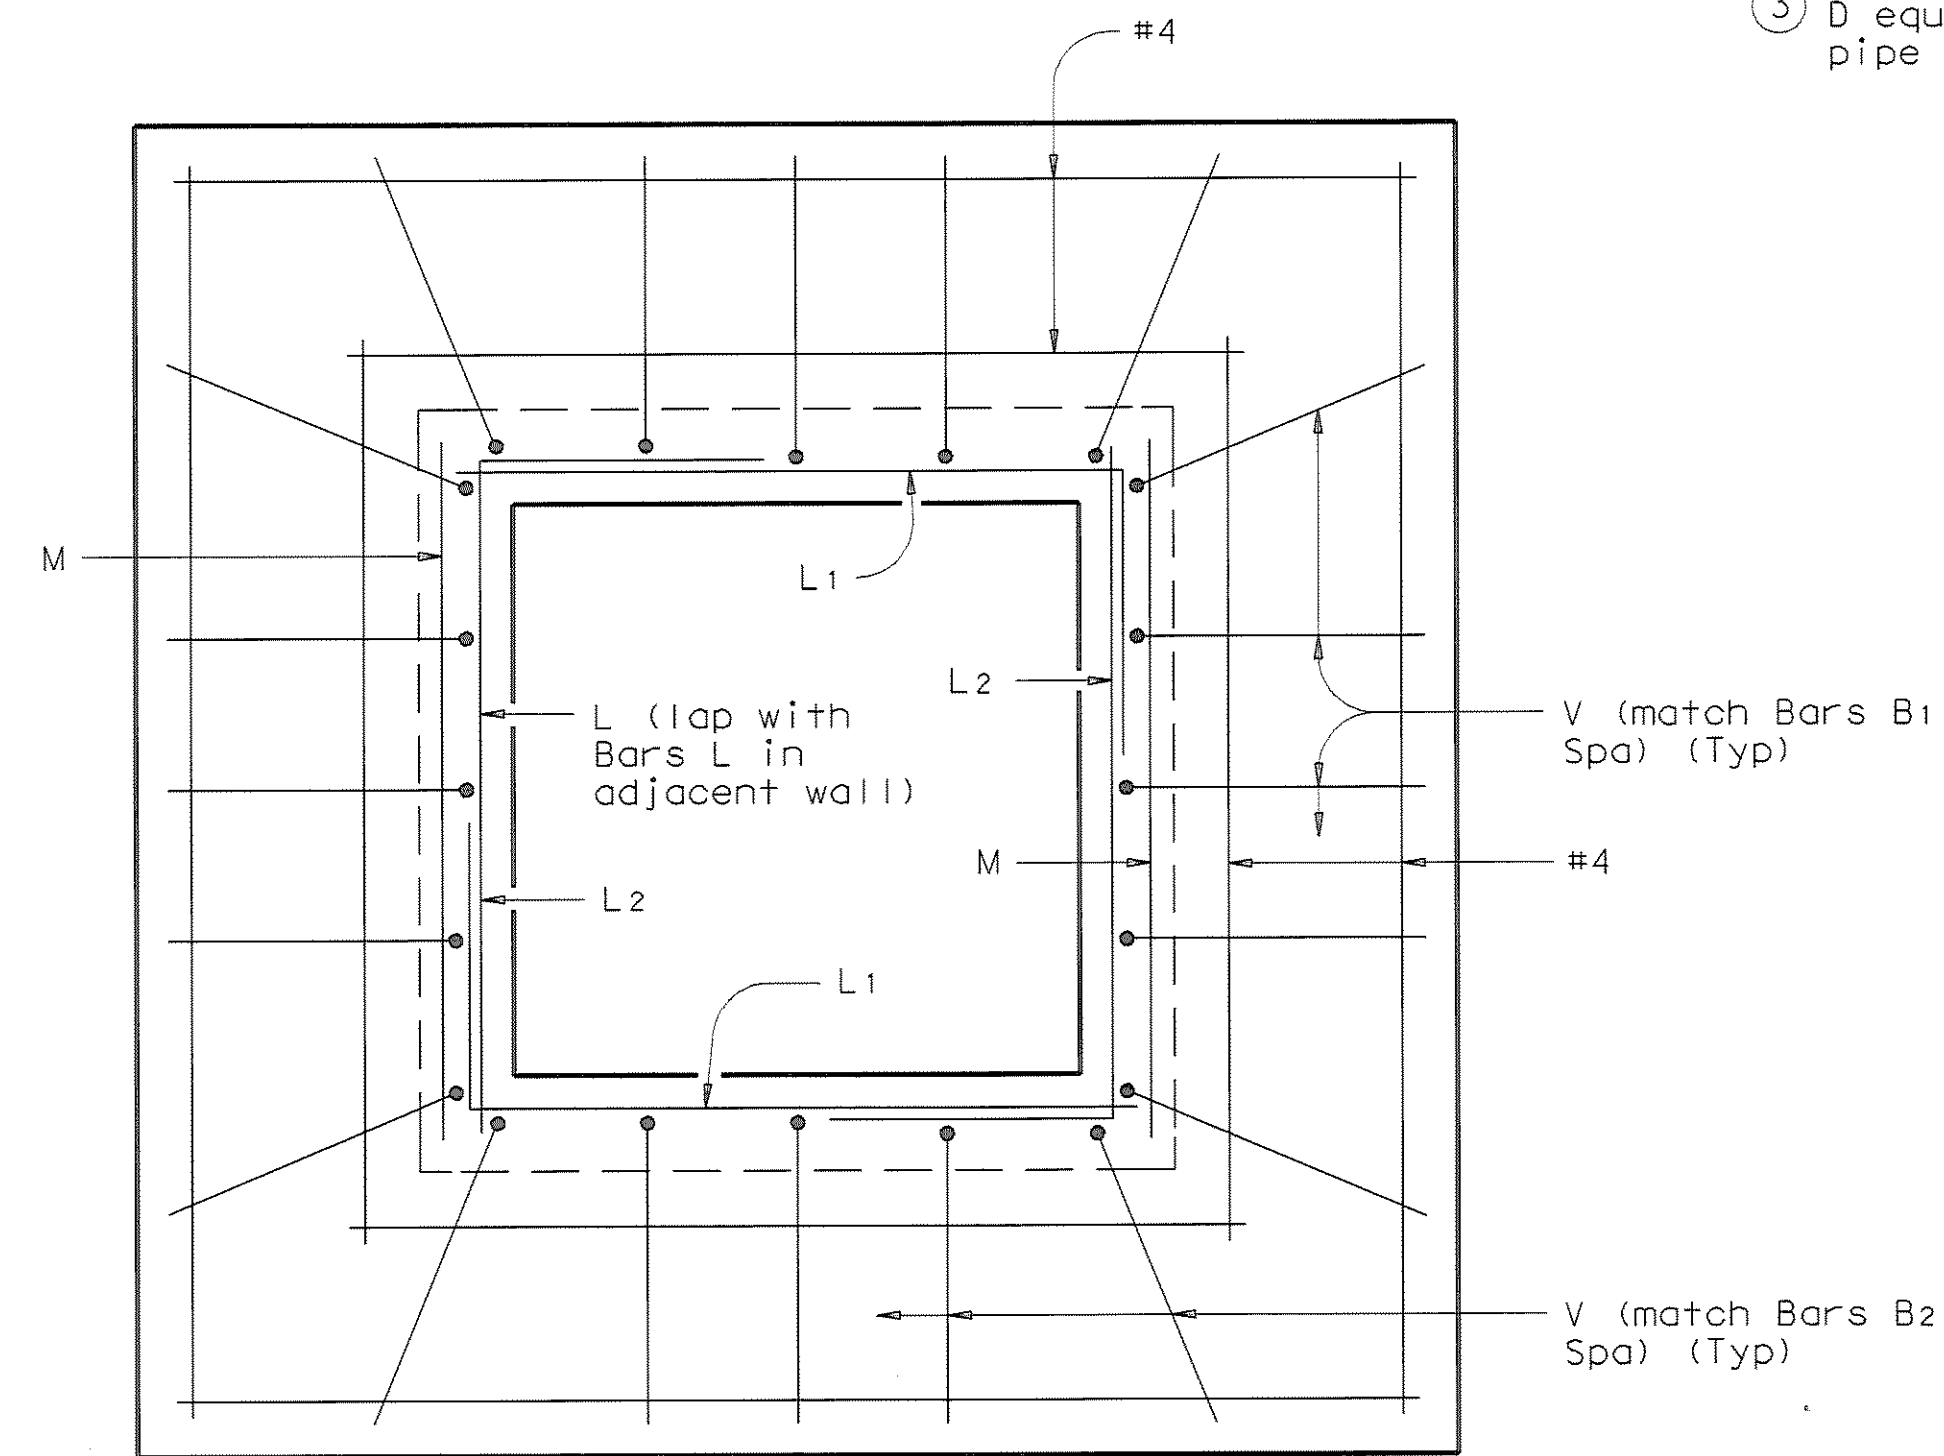


**TYPICAL APRON PLAN**

(Showing reinforcing in walls and in apron)


- ① May be changed as directed by the Engineer.
- ② D equals the maximum inside diameter of any pipe entering the wall shown or the opposite wall.
- ③ D equals the maximum inside diameter of any pipe entering the inlet.

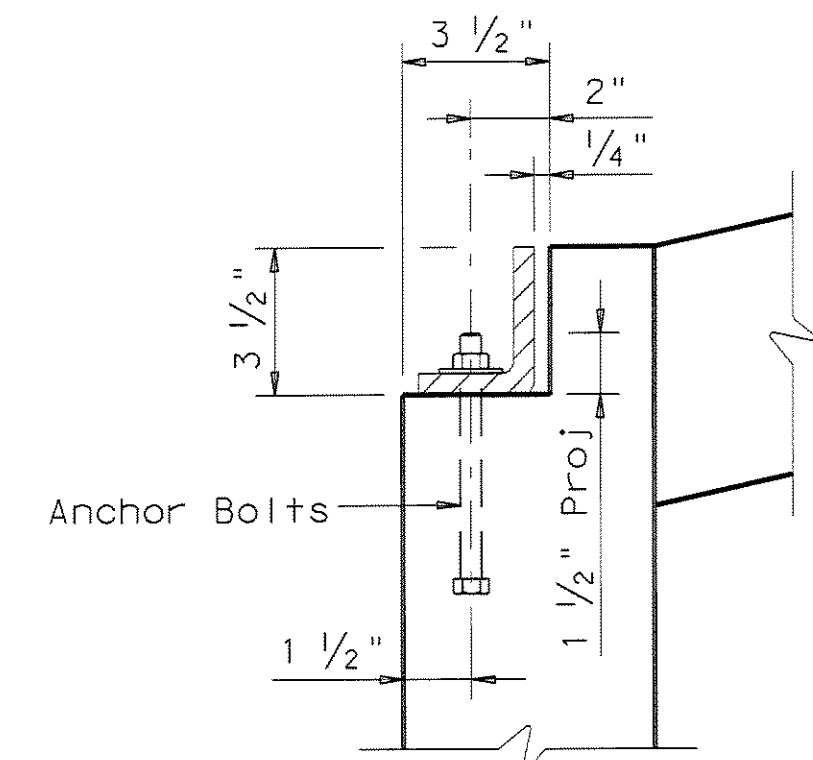


**GRATE MOUNTING DETAIL**

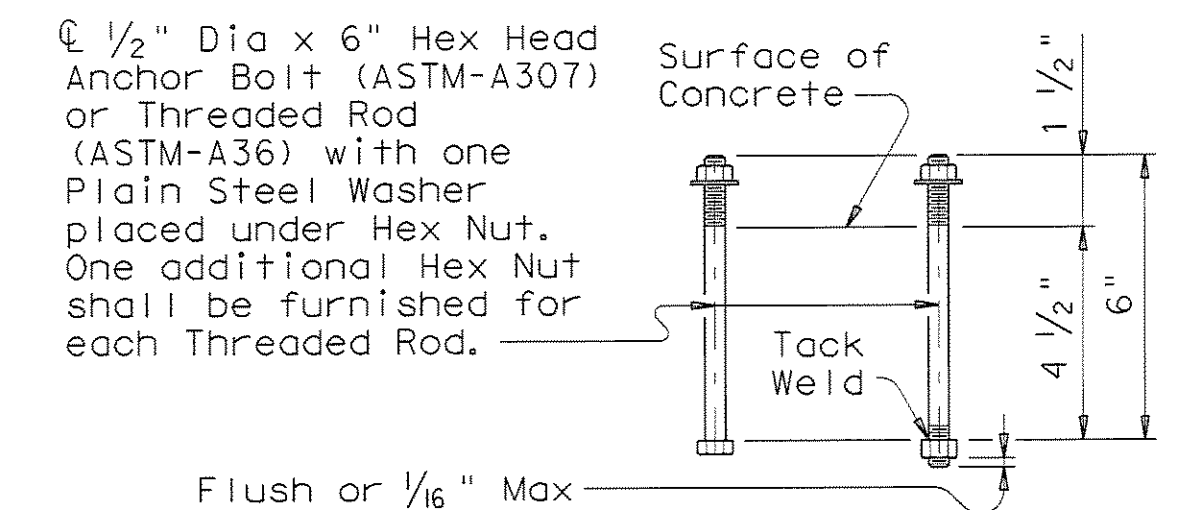

**ANCHOR BOLT OPTIONS**

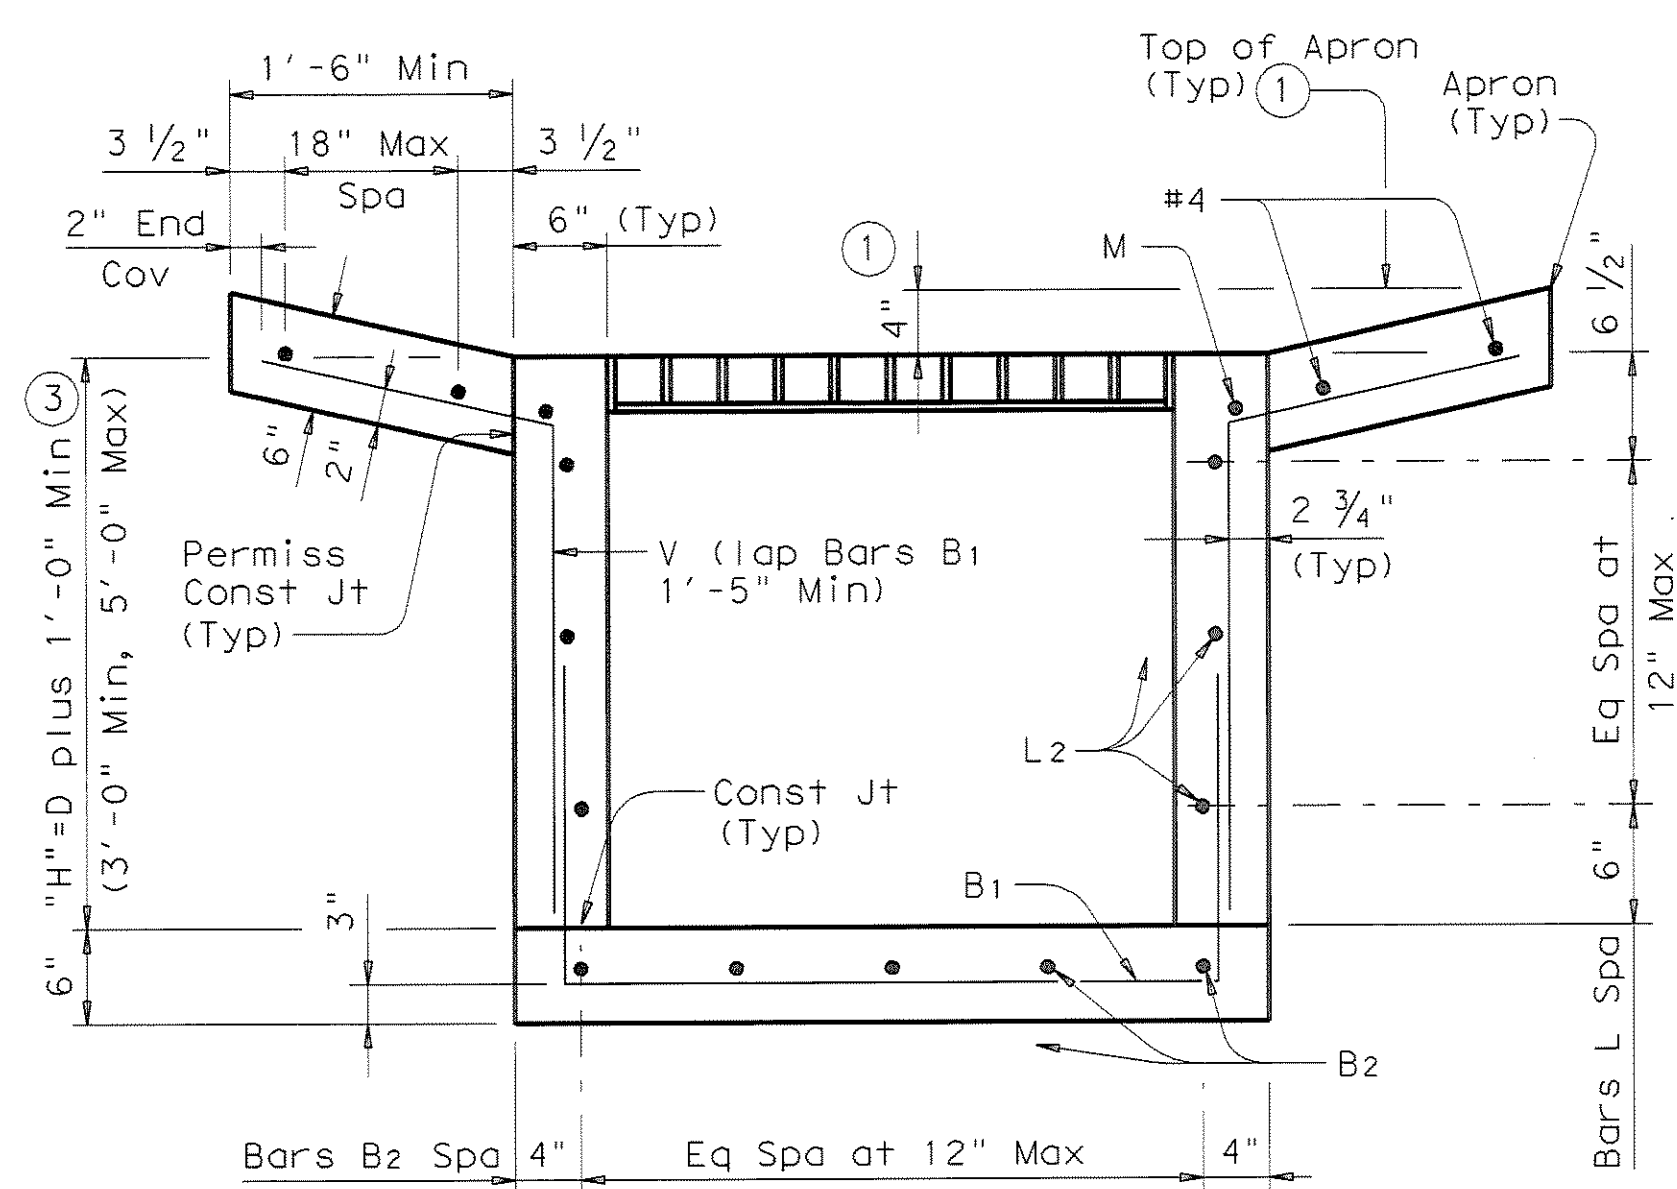

**SECTION A-A**

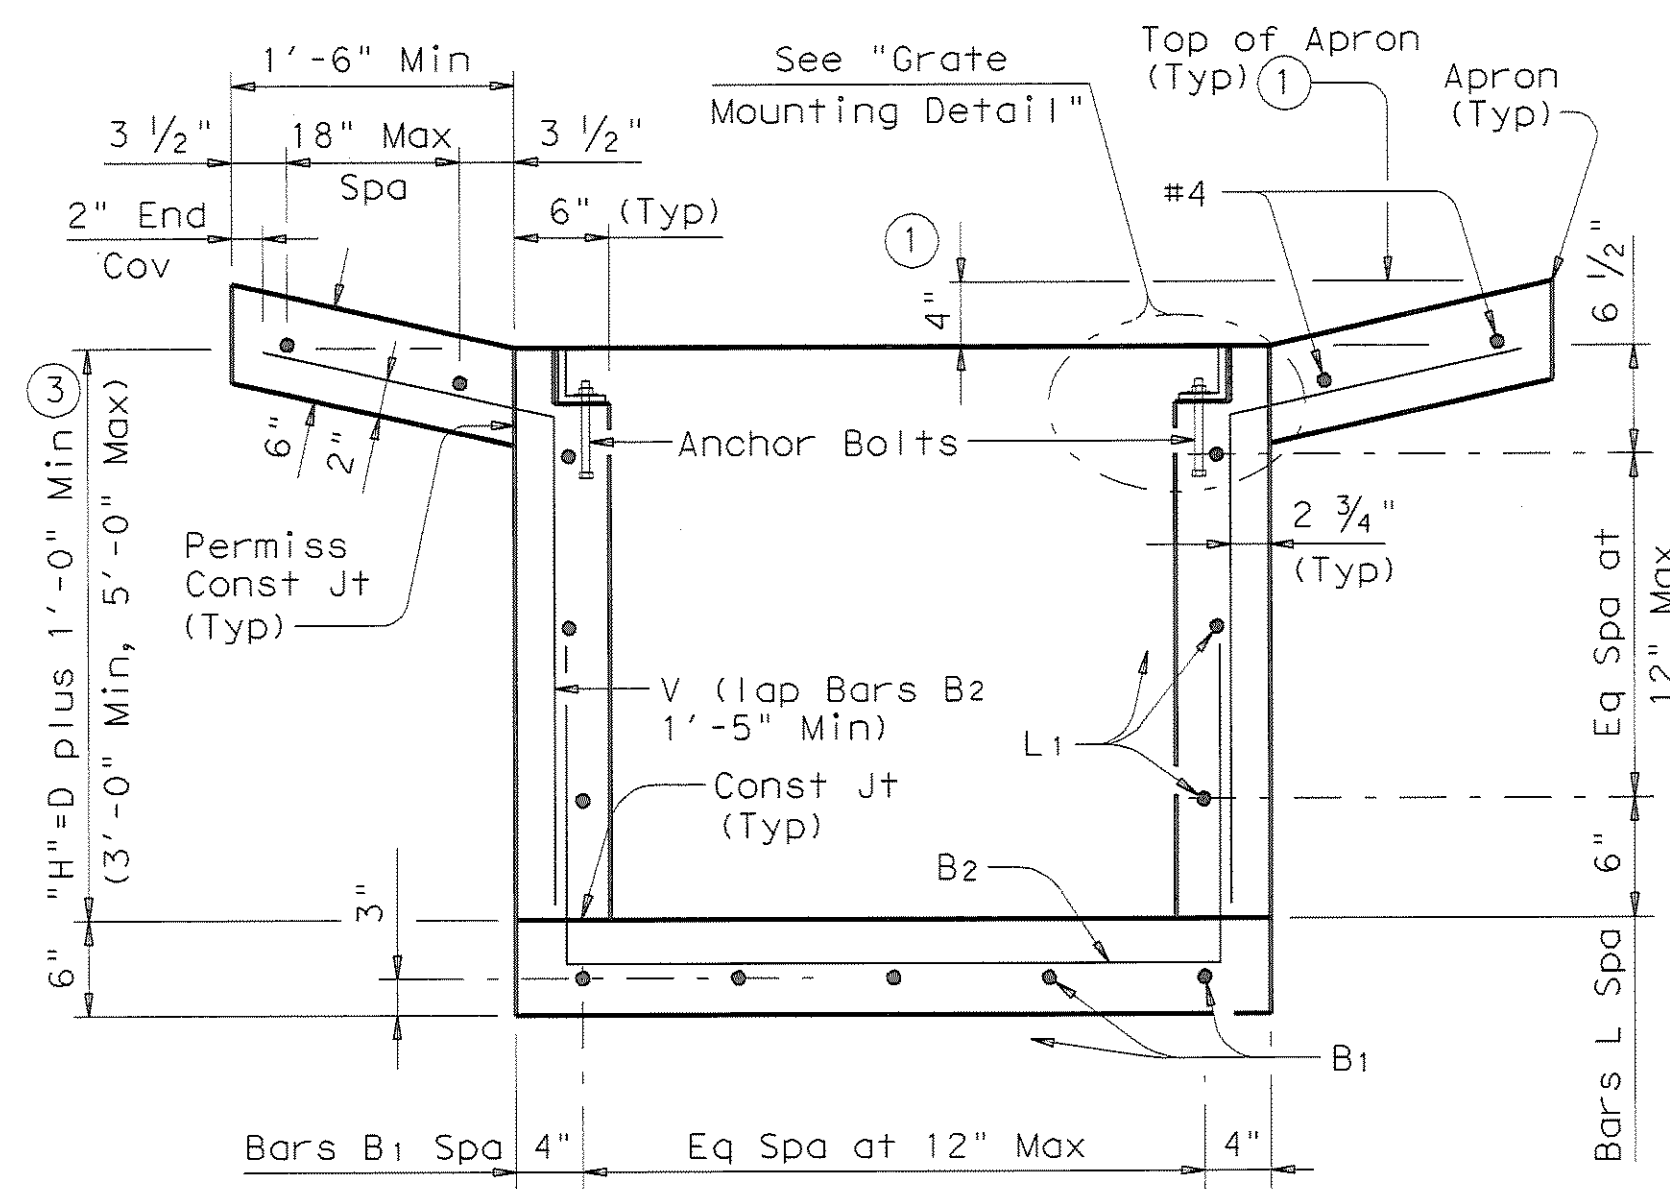

**SECTION B-B**

RECORD PLANS  
 MARCH 28, 2008


**HORIZONTAL INLET  
 TYPE H WITH GRATE  
 (MAX 48" DIA PIPES)**

**IL-H-G**


FILE: ihste01.dgn	DW: TxDOT	CK: TxDOT	DR: TxDOT	CR: TxDOT
© TxDOT May 2005	DISTRICT	FEDERAL AID PROJECT	SHEET	
REVISIONS		D306		
COUNTY	CONTROL	SECT	JOB	HIGHWAY

DISCLAIMER: The use of this standard is governed by the "Texas Engineering Practice Act". No warranty of any kind is made by TxDOT for any purpose whatsoever. TxDOT assumes no responsibility for the conversion of this standard to other formats or for incorrect results or damages resulting from its use.


LEVELS DISPLAYED	
1	

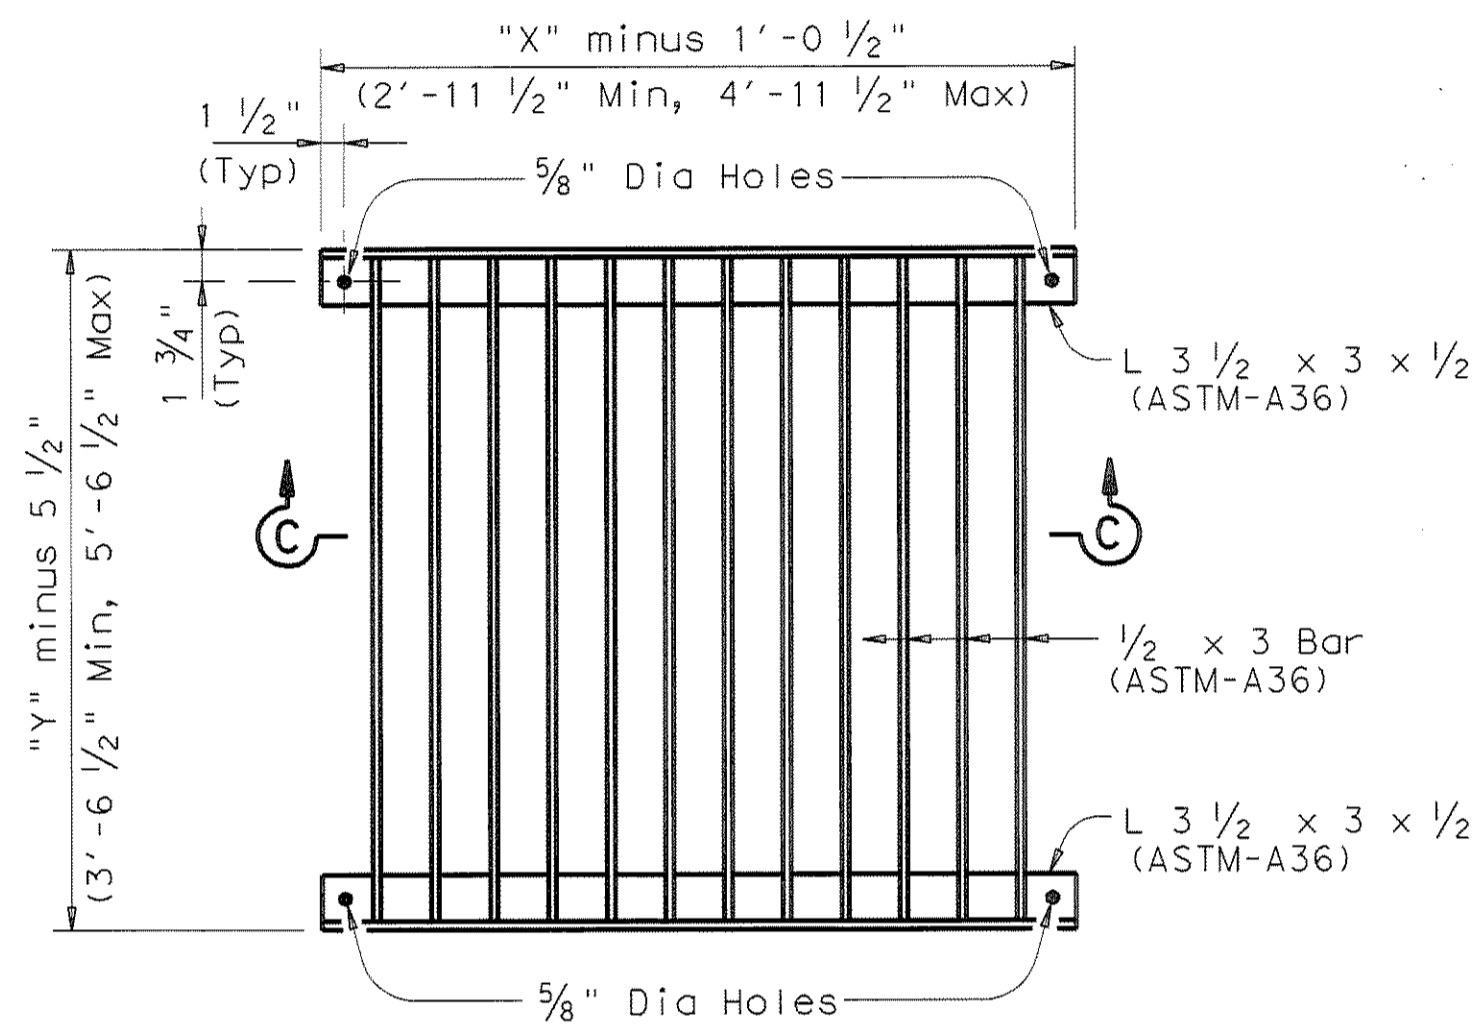


**TYPICAL GRATE PLAN**

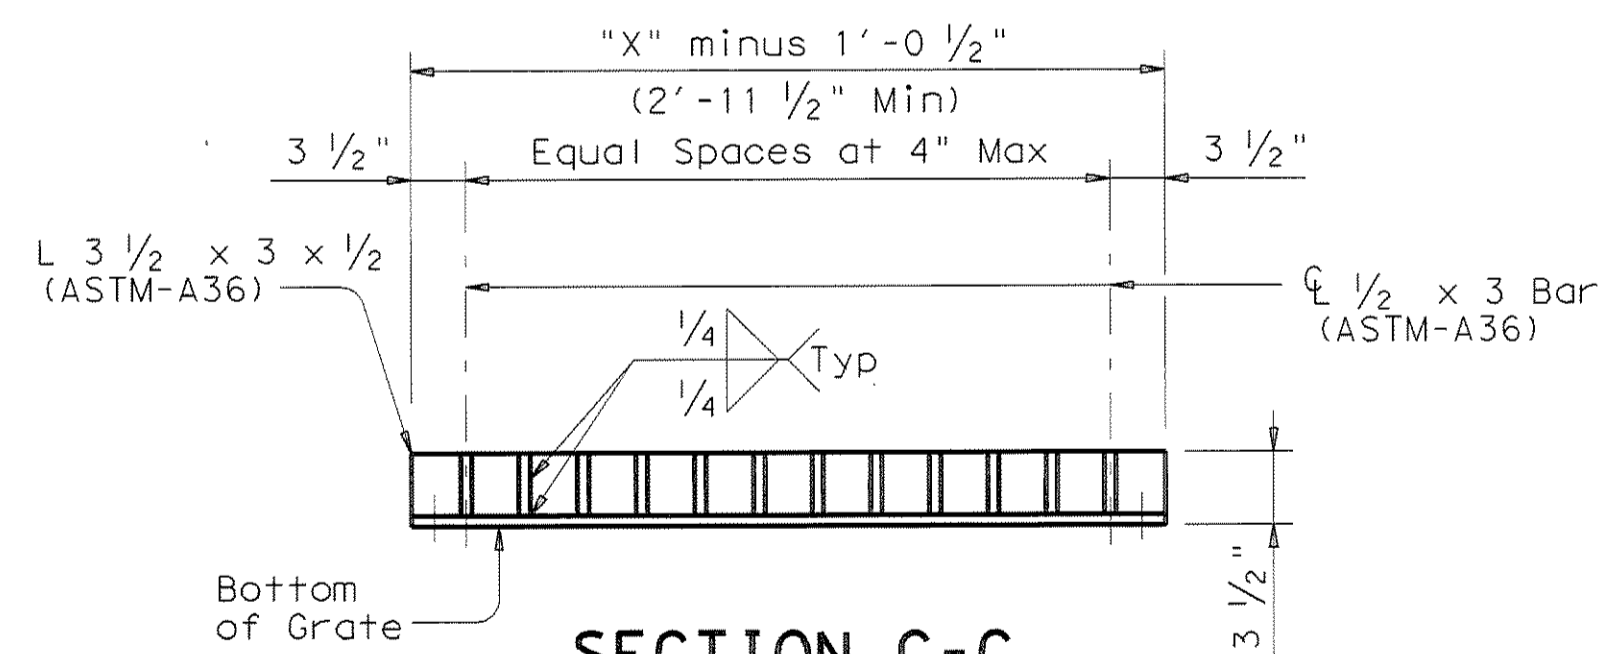

**SECTION C-C**

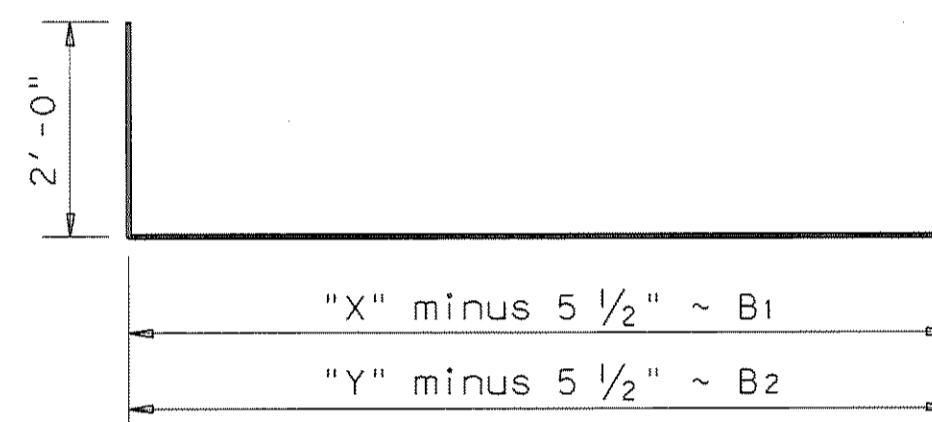


**BARS B (#4)**

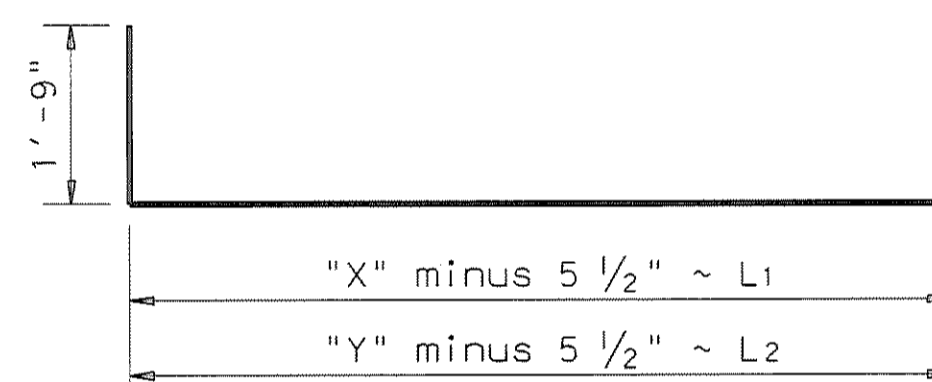


**BARS L (#4)**



**BARS M (#4)**

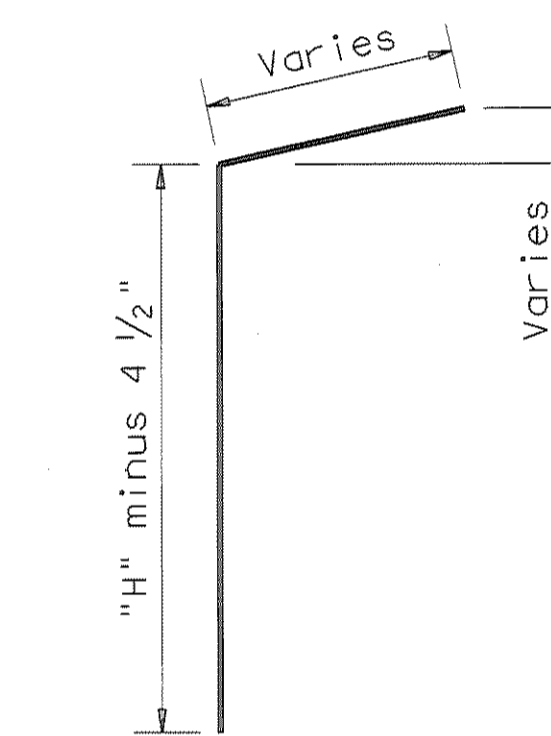


**BARS V (#4)**

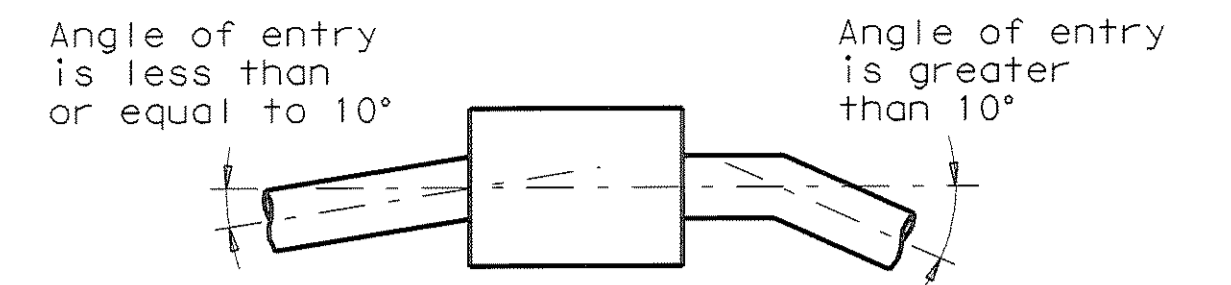

**PIPE CONNECTION DETAIL**

Connecting pipes should enter within 10° of normal to inlet wall. If necessary, pipe elbow or curved approach alignment should be used to stay within this limit.

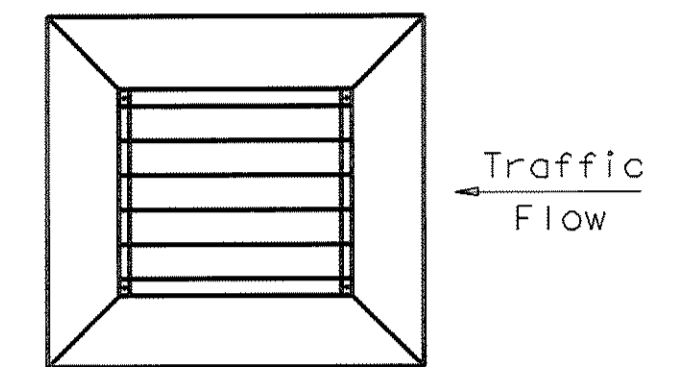

**GRATE ORIENTATION DETAIL**

If possible, horizontal grate inlet should be oriented such that both traffic and ditch water approach parallel to bars on grate. If this is not possible, orientation must favor traffic flow. Grate is not to be used under direct traffic, rather it is to be used in ditches and medians away from the roadway.

**GENERAL NOTES:**

When approved, precast inlets with equivalent structural capacity may be furnished. Sealed engineering calculations and drawings shall be submitted for approval prior to construction. Shop drawings will not be required.

Apron shall be cast-in-place. In areas of conflict between reinforcing steel, blockouts, pipes, anchor bolts or other reinforcing steel, the reinforcement shall be bent or adjusted to clear as directed by the Engineer.

Anchor Bolts are 1/2" Dia ASTM A307 Grade A bolts (or A36 threaded rods with one tack welded hex head nut each) with one hex head nut and one plain steel washer.

Structural Steel for grates shall conform to the requirements of ASTM Designation A-36 or AISI Designation M1010-M1020.

All reinforcing steel shall be Grade 60 unless otherwise noted.

All steel components except reinforcing, shall be galvanized after fabrication. Galvanizing damaged during transport or construction shall be repaired in accordance with the specifications.

All concrete shall be Class "A" (f'c = 3,000 psi).



**HORIZONTAL INLET  
TYPE H WITH GRATE  
(MAX 48" DIA PIPES)**


**IL-H-G**

RECORD PLANS  
MARCH 28, 2008

FILE: i1nste01.dgn	DN: TxDOT	CK: TxDOT	DW: TxDOT	CR: TxDOT
© TxDOT May 2005	DISTRICT	FEDERAL AID PROJECT	SHEET	
REVISIONS	COUNTY	CONTROL SECT	JOB	HIGHWAY

U307

DISCLAIMER: The use of this standard is governed by the "Texas Engineering Practice Act". The user of this standard is made by TxDOT for any purpose whatsoever. TxDOT assumes no responsibility for the conversion of this standard to other formats or for incorrect results or damages resulting from its use.

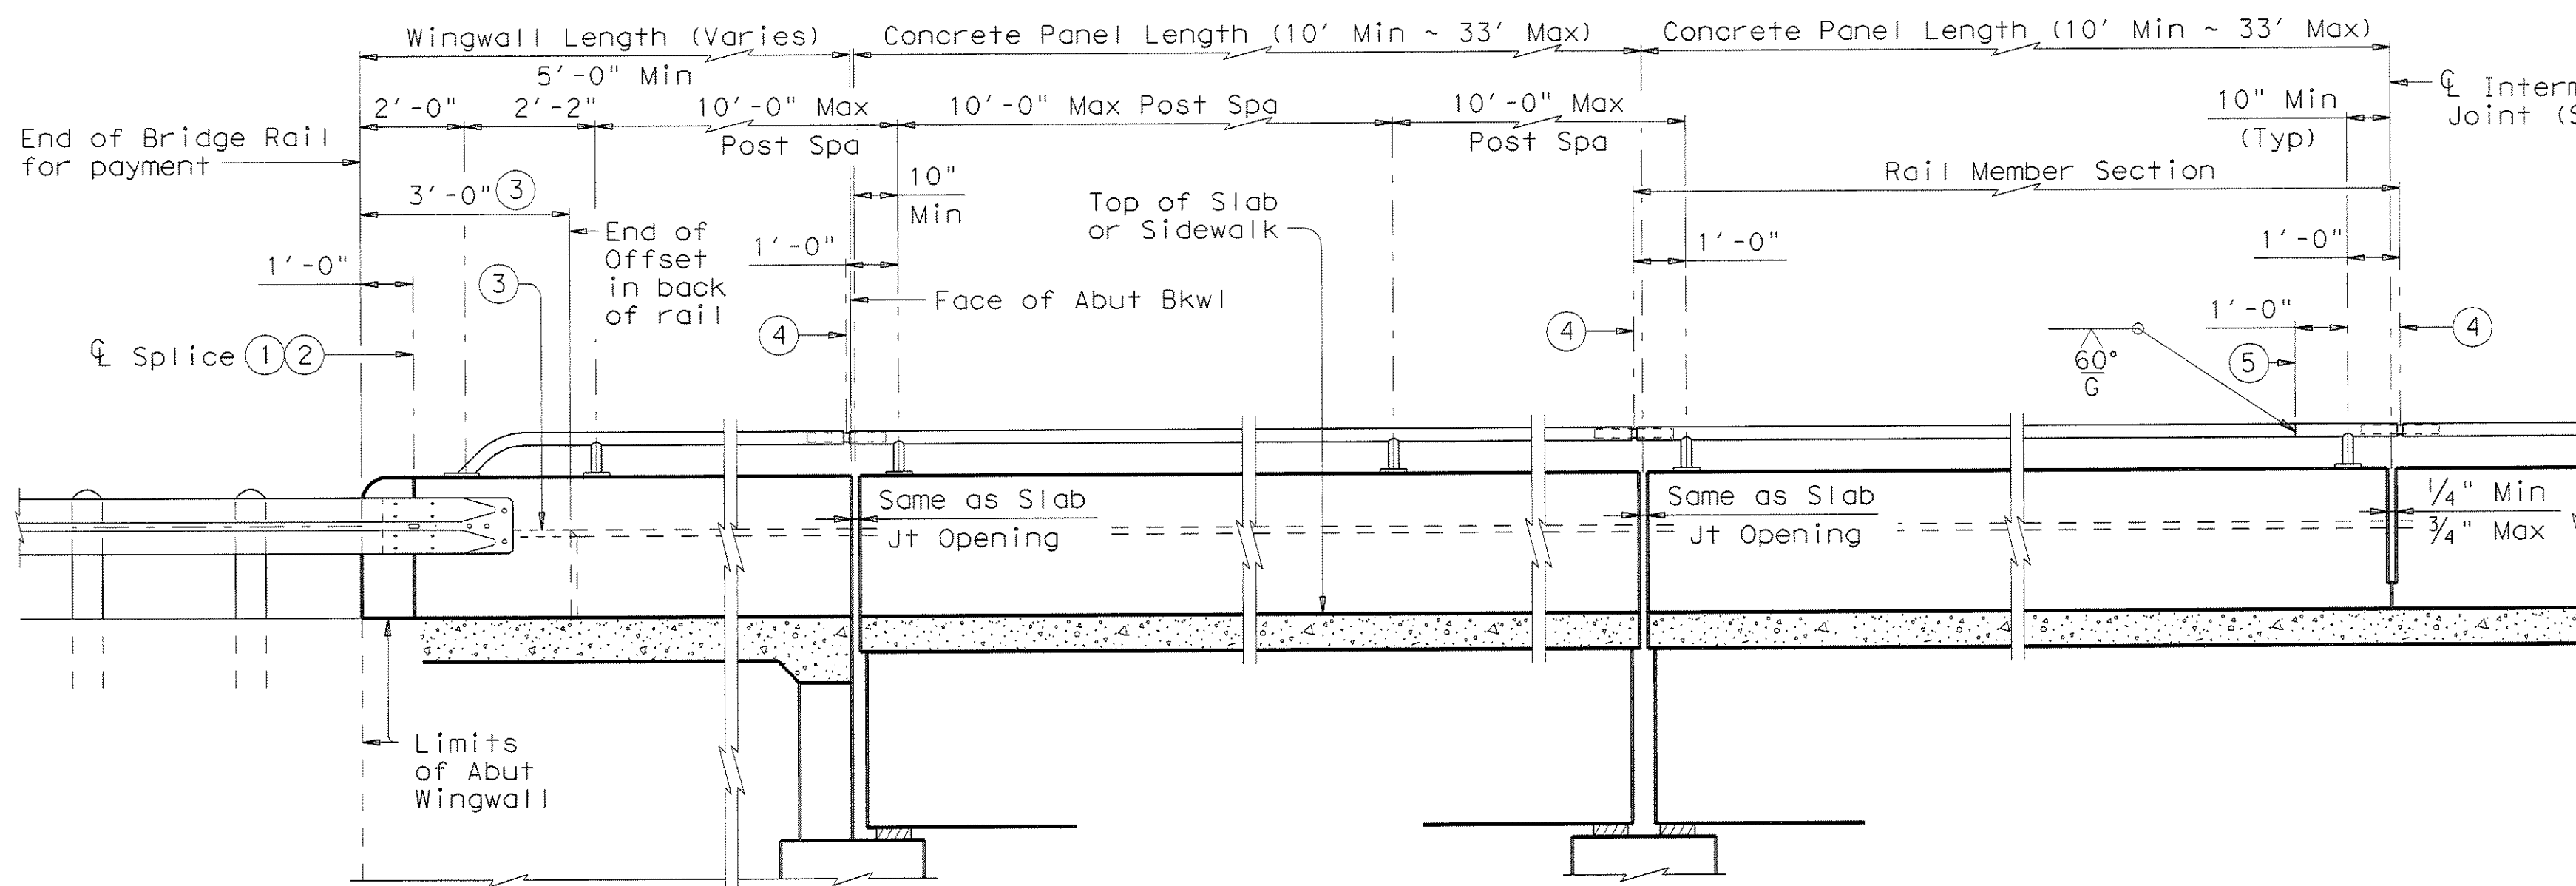

**AT ABUTMENT BENTS**  
 Showing TL-2 Transition

**AT SLAB EXP JOINTS**

**AT INTERMEDIATE WALL JOINTS**


**ROADWAY ELEVATION OF RAIL**

Form to here. Optionally, joint may be formed to top of slab. Fill bottom 6" of joint with concrete if this option is used.


**INTERMEDIATE WALL JOINT DETAIL**

Note: Provide intermediate wall joints over all slab construction joints, over interior supports on continuous units, and at equal intervals in between as necessary to maintain a 33' maximum length of unbroken wall.


- ① Metal Beam Guard Fence Transitions must be attached to the bridge rail and extended along the embankment unless otherwise shown in the plans.
- ② Terminal Connector and associated hardware are to be paid for under the Item "Metal Beam Guard Fence".
- ③ Back of rail offset may, with Engineer's approval be continued to the end of the railing.
- ④ Exp Joint or Splice Joint as required.
- ⑤ One shop splice per rail member section is permitted with minimum 85 percent penetration. The weld may be square groove, or single vee groove. Grind smooth.
- ⑥ Increase 2" for structures with overlay.
- ⑦ Bolts shall be of sufficient length to extend 1/2" to 3/4" beyond nut.
- ⑧ Bolt recesses are only required when pedestrian sidewalks are adjacent to back of rail.
- ⑨ 4 additional Bars R(#5) 3'-8" in length shall be placed inside Bars S(#5) and centered 2'-0" from end of rail when Terminal Connections are required. Field bend as needed.
- ⑩ 2 1/2" Std Pipe (2.875" O.D., 0.203" wall thickness)
- ⑪ 2" Std Pipe (2.375" O.D., 0.154" wall thickness)
- ⑫ 3/8" Dia Hole in bottom of pipe or tube (Minimum 1 hole between posts ~ Typ)

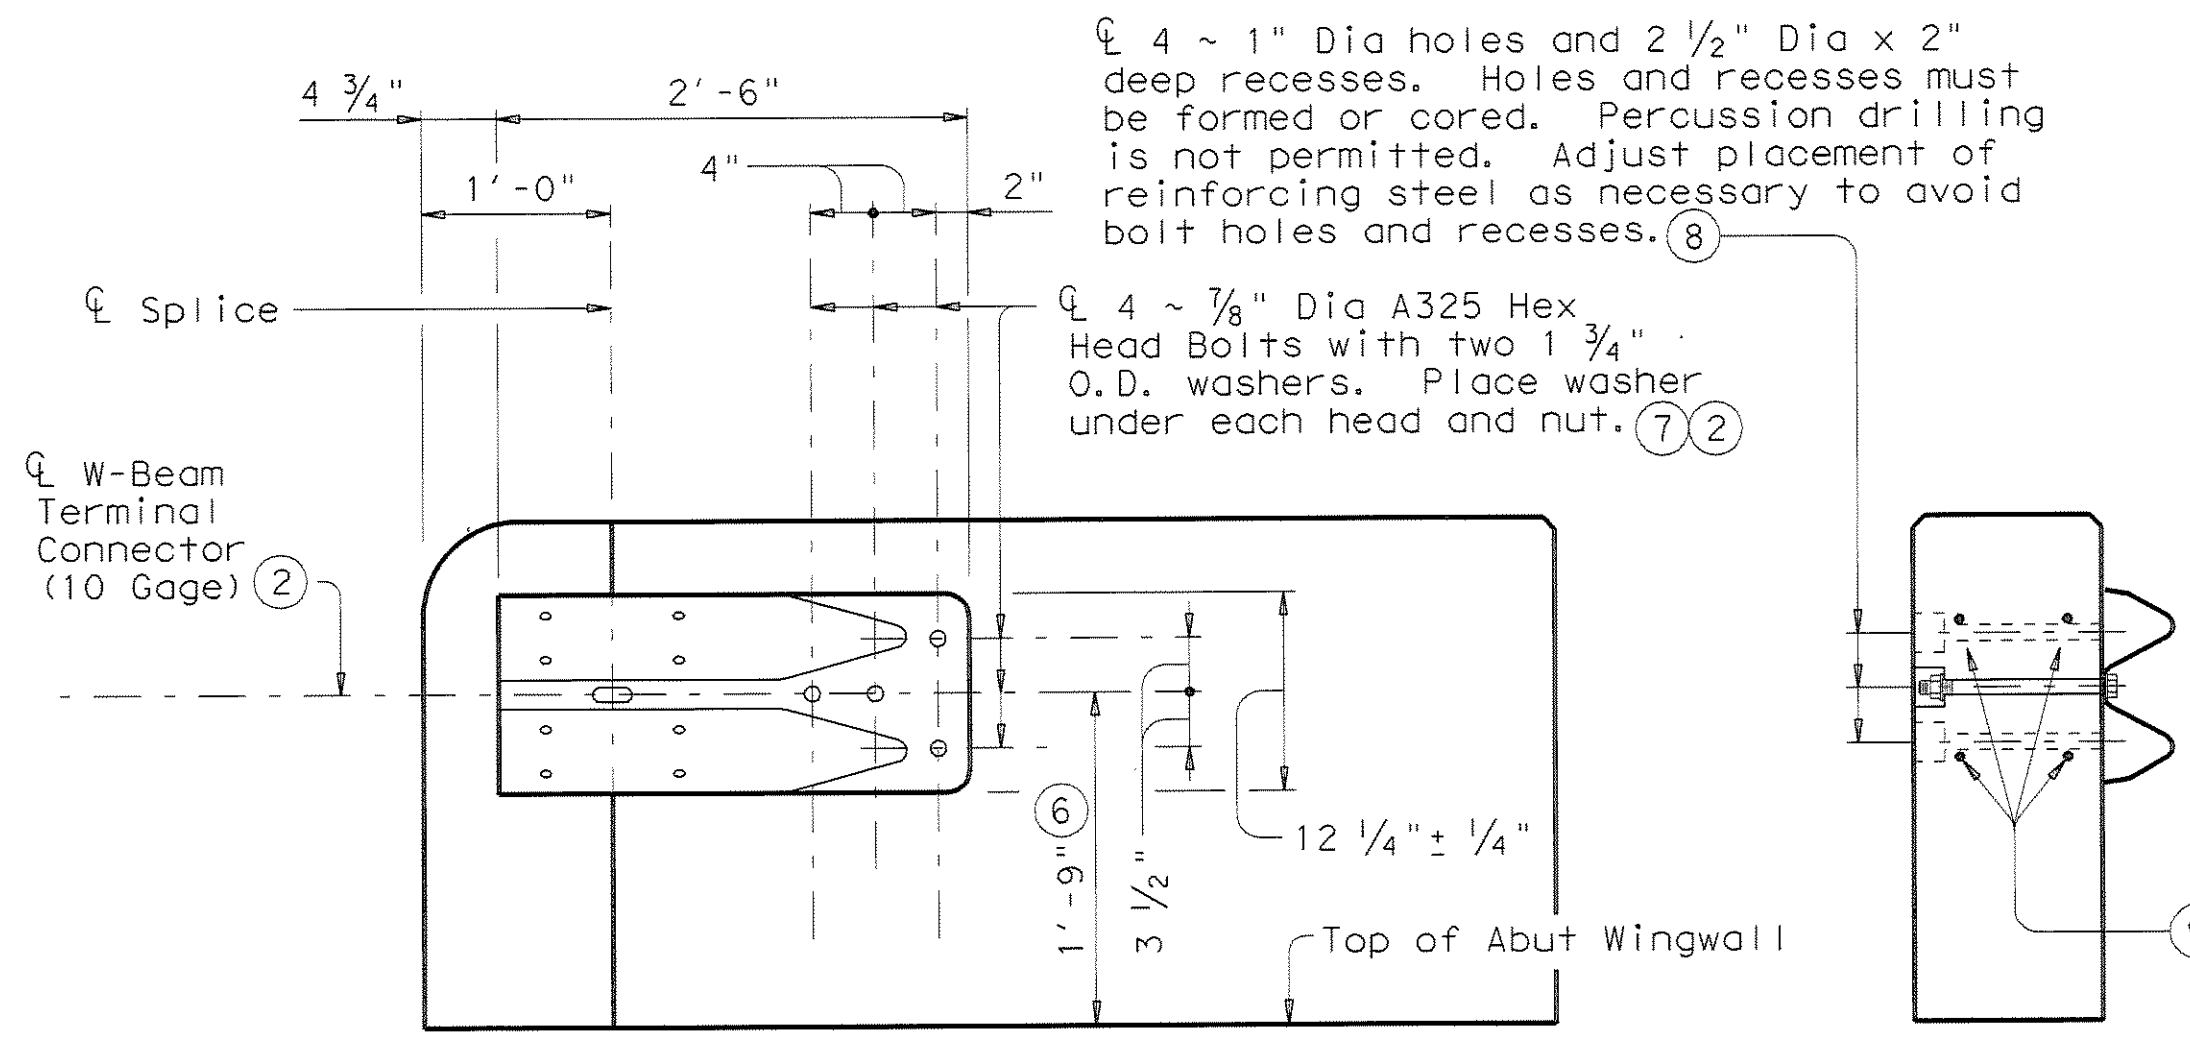


**ELEVATION**  
**SECTION**  
**TL-2 TERMINAL CONNECTION DETAILS**

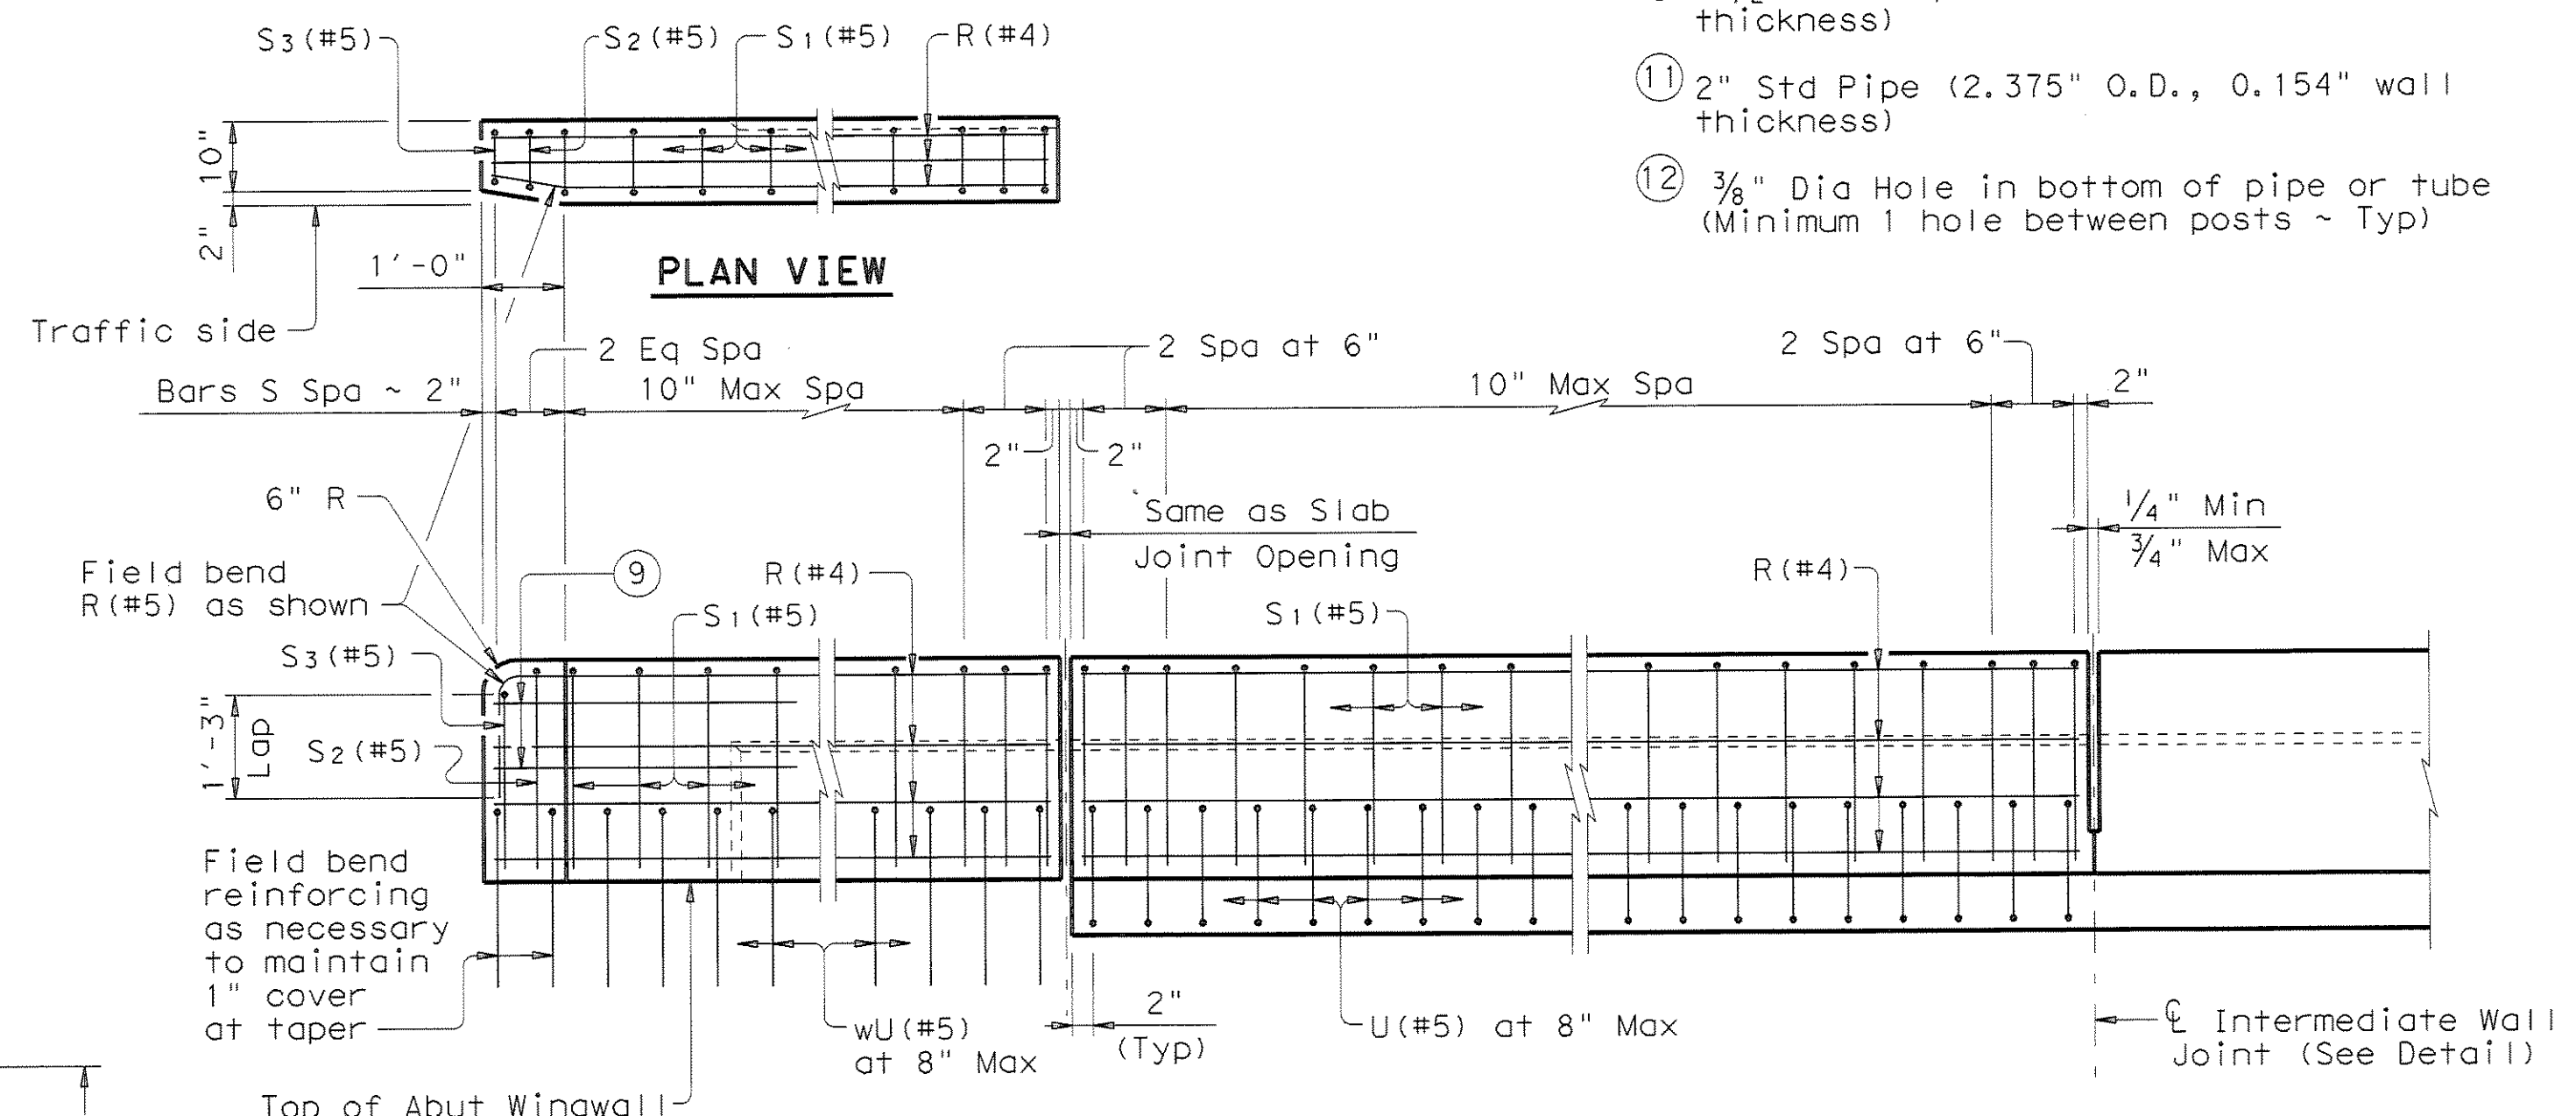

**ELEVATION SHOWING TYPICAL REINFORCING PLACEMENT**

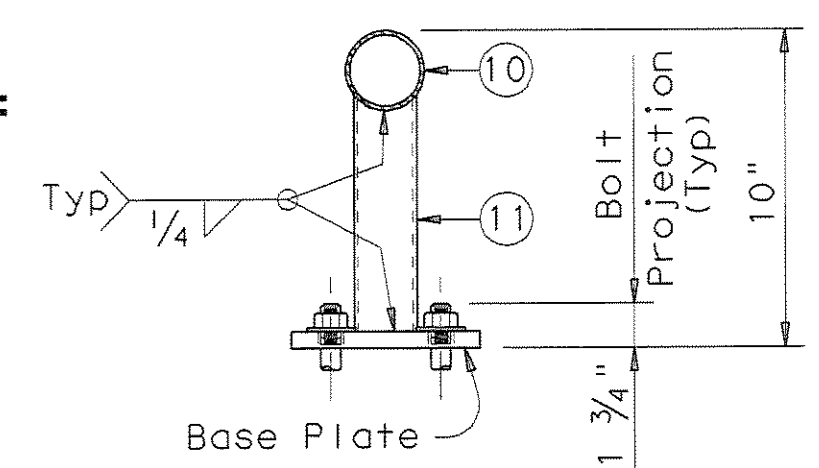


**TRANSVERSE SECTION**

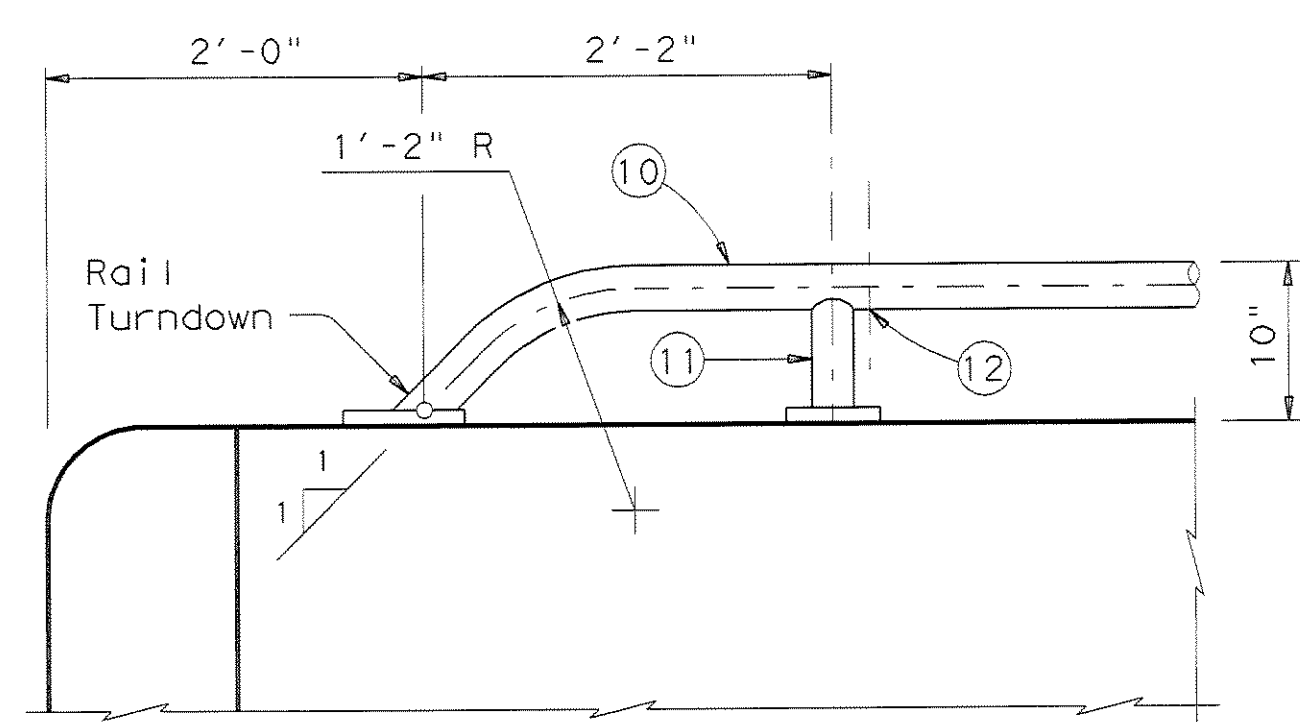

Note that at least two anchor points (as shown) are required for the Bridge Rail on the Abutment Wingwall. Longer Wingwalls may require more than two Rail anchorages.

**PIPE RAIL TERMINAL DETAIL**

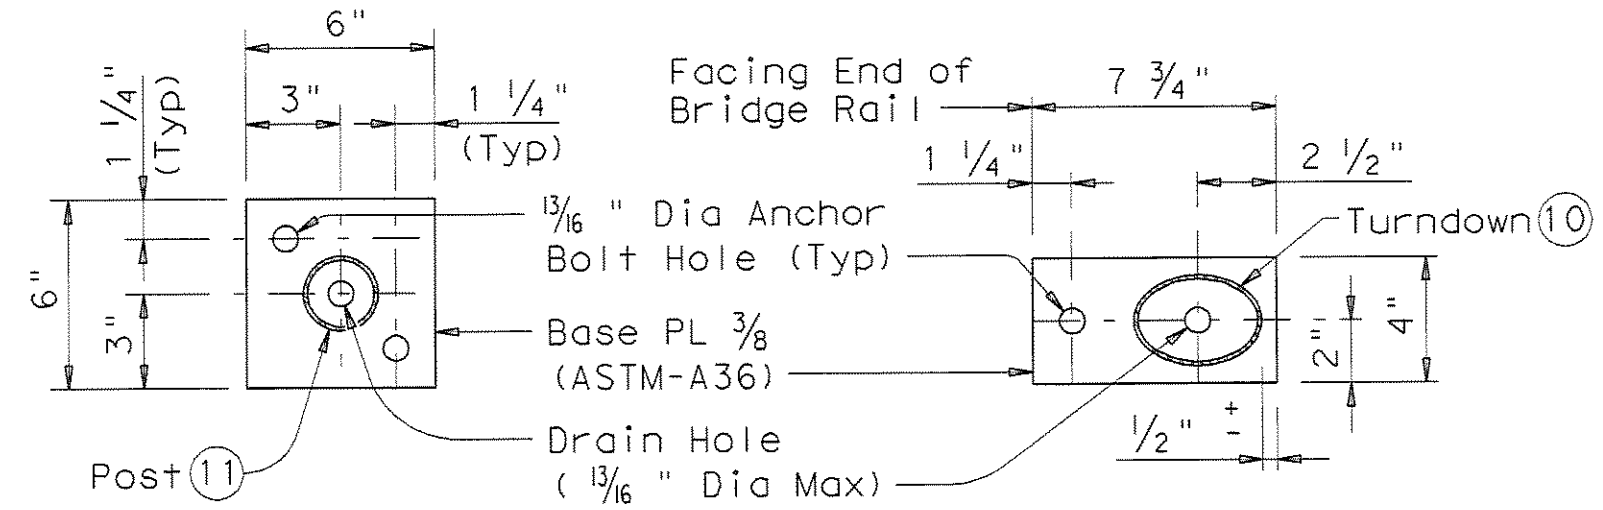

**POST BASE PLATE PLAN**  
**RAIL TURNDOWN BASE PLATE PLAN**

**PIPE RAIL DETAILS**

The use of this railing is restricted to design speeds of 45 mph or less.

RECORD PLANS  
 MARCH 28, 2008

SHEET 1 OF 2

Texas Department of Transportation  
 Bridge Division

**TRAFFIC RAIL**

**TYPE C221**

REVISIONS:  
 08-06: Changed Base Plate Thickness, Rail Turndown and Rail Turndown Base Plate.  
 03-06: Changed 2'-6" to 2'-2" and removed 1" dimension on Pipe Rail Terminal Detail.


FILE: r1std27.dgn	DW: TxDOT	CK: TxDOT	DR: JTR	CR: TxDOT
© TxDOT April 2005	DISTRICT	FEDERAL AID PROJECT	SHEET D308	
COUNTY	CONTROL	SECT	JOB	HIGHWAY

ACC:

LEVELS DISPLAYED	
1	



DISCLAIMER: The use of this standard is governed by the "Texas Engineering Practice Act". No warranty of any kind is made by TxDOT for any purpose whatsoever. TxDOT assumes no responsibility for the conversion of units or for other errors or for incorrect results or damages resulting from its use.

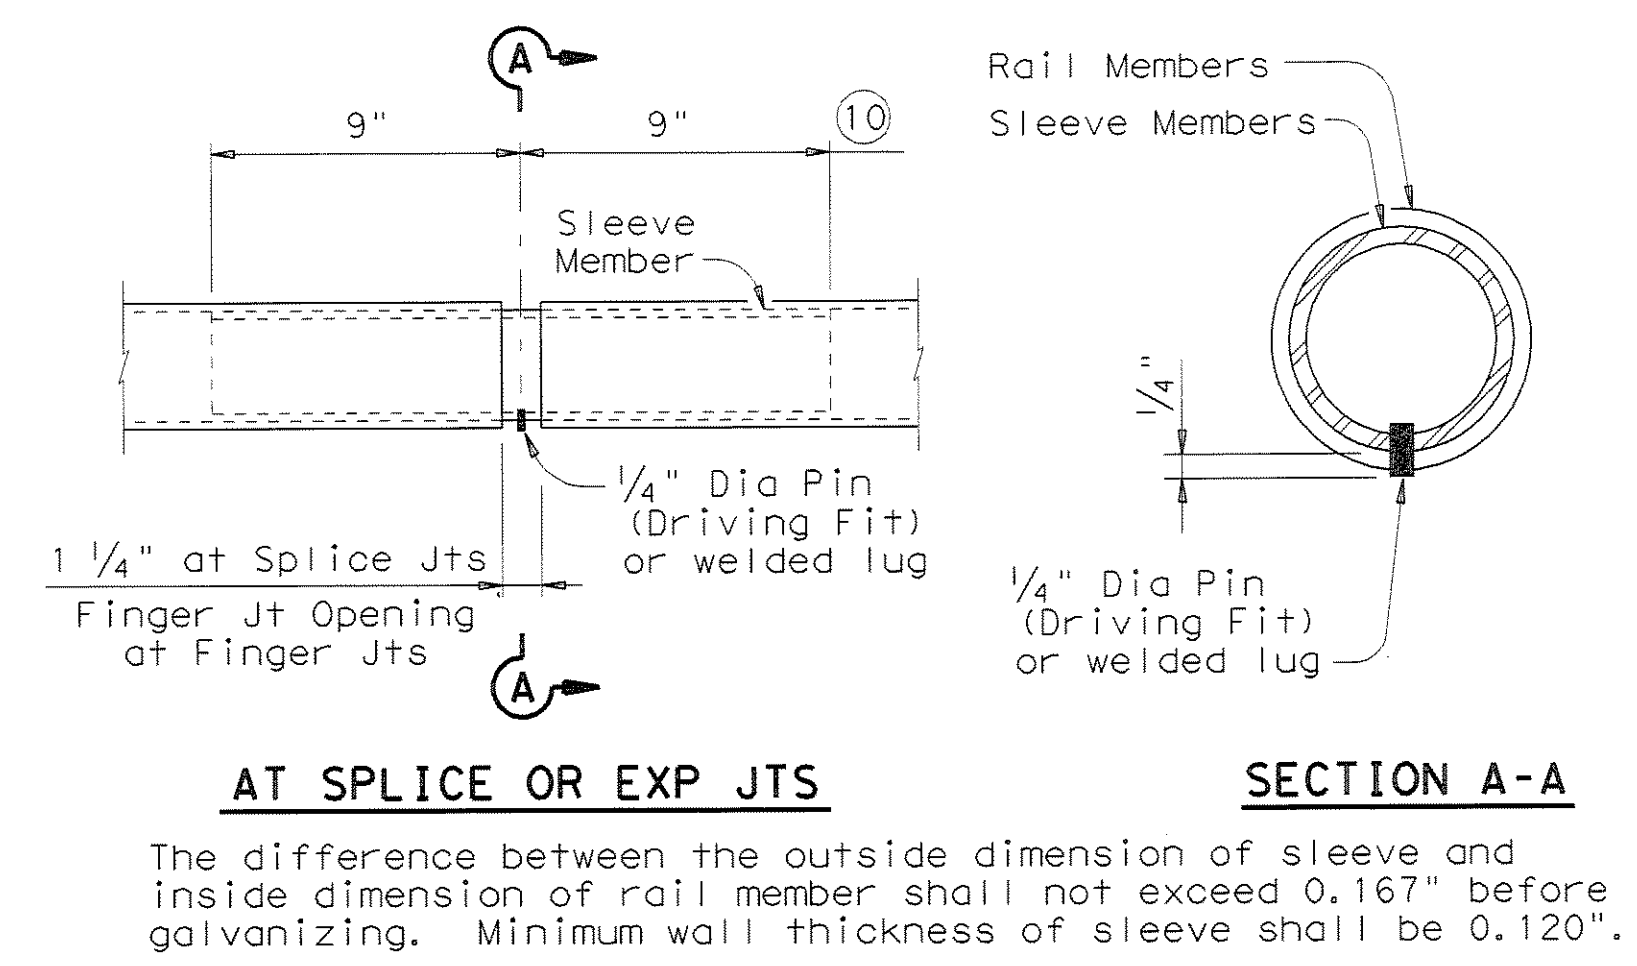


AT SPLICE OR EXP JTS


SECTION A-A

The difference between the outside dimension of sleeve and inside dimension of rail member shall not exceed 0.167" before galvanizing. Minimum wall thickness of sleeve shall be 0.120".


PIPE SPLICE DETAILS

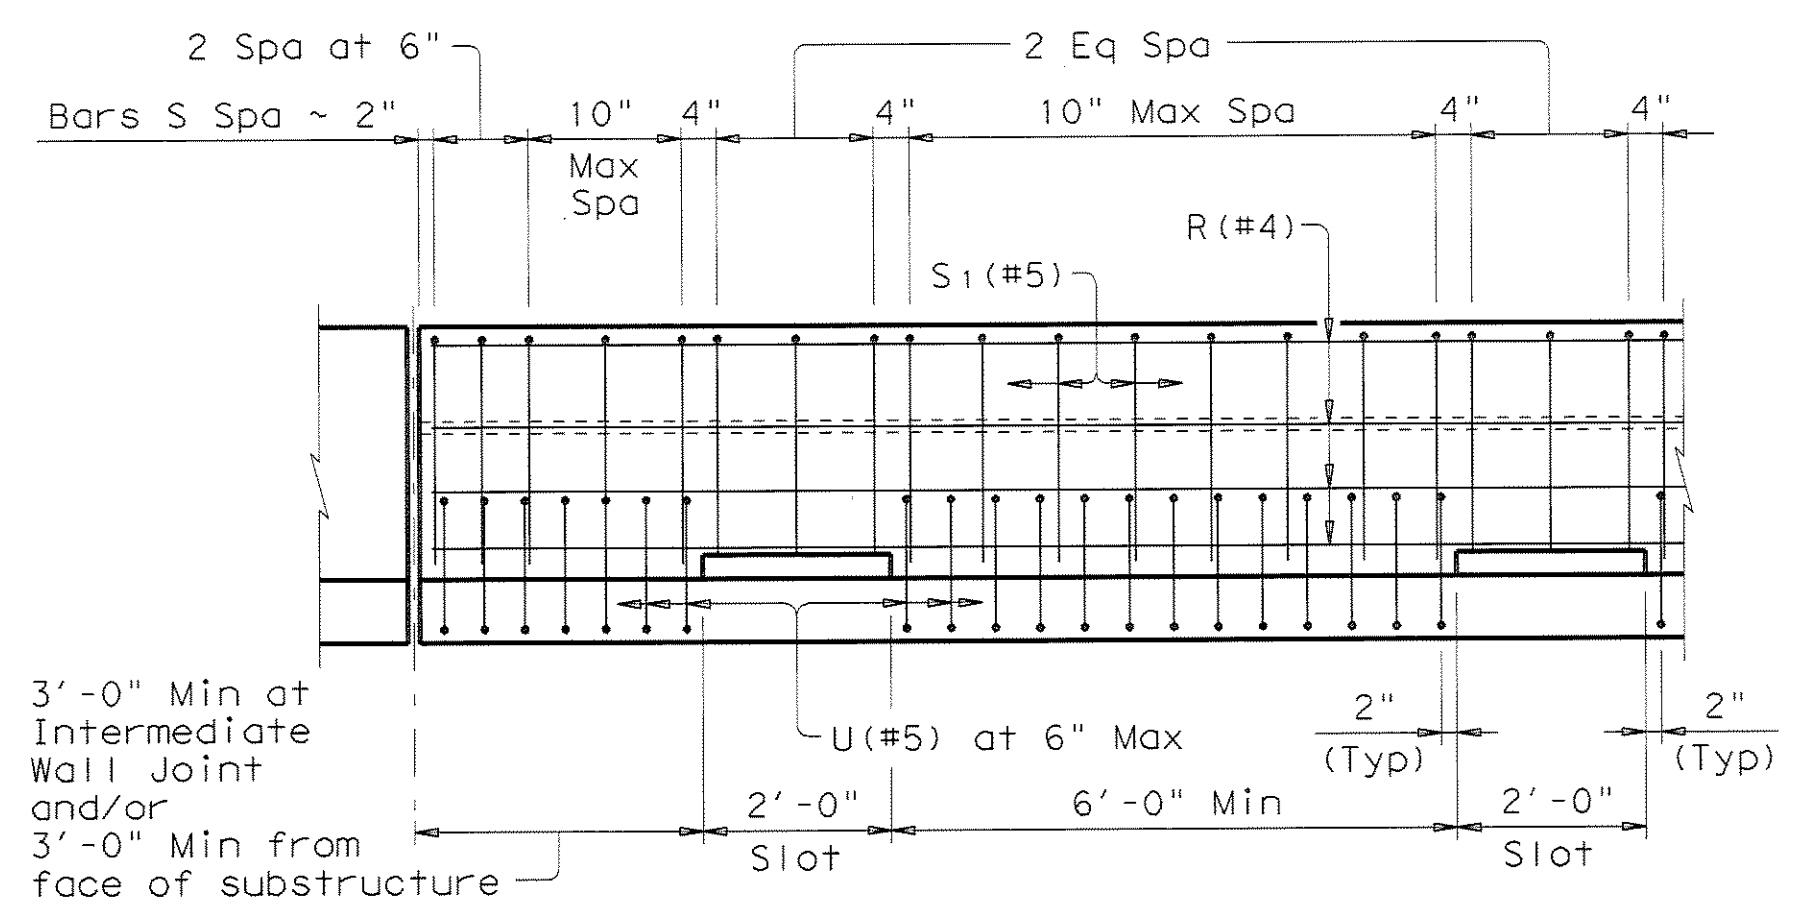


OPTIONAL SIDE SLOT DRAIN DETAIL

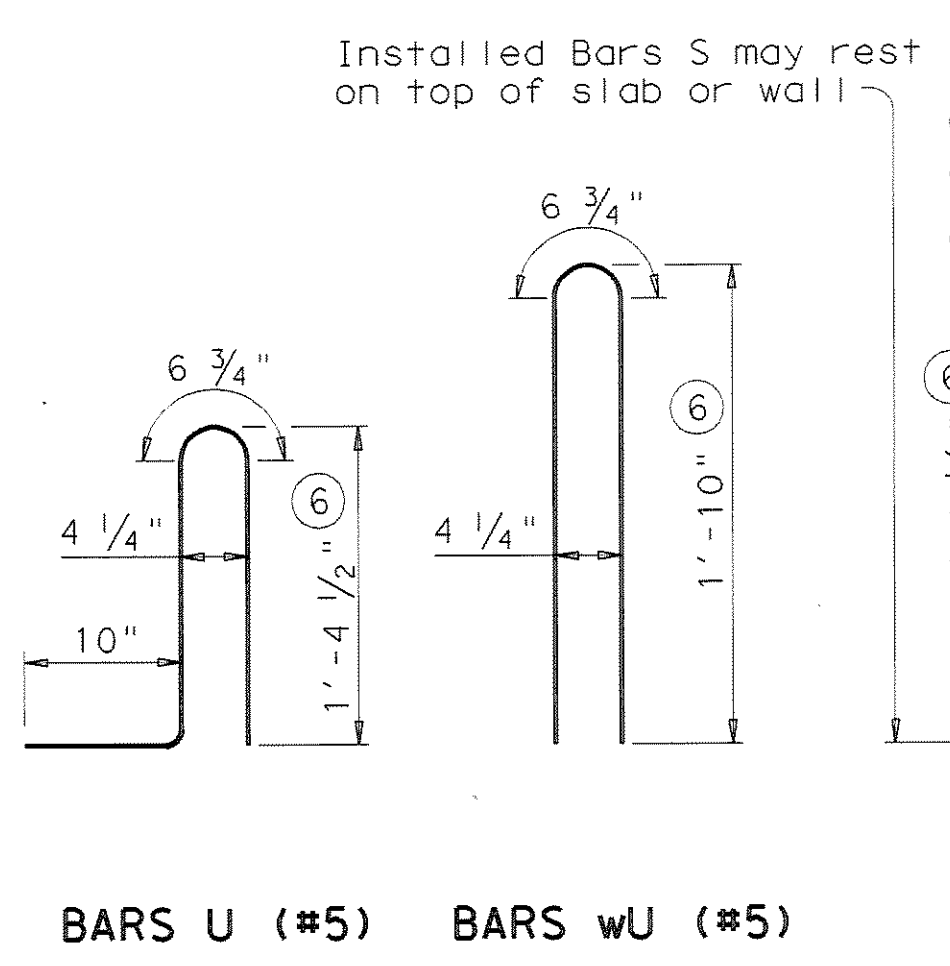

BARS U (#5) BARS wU (#5)

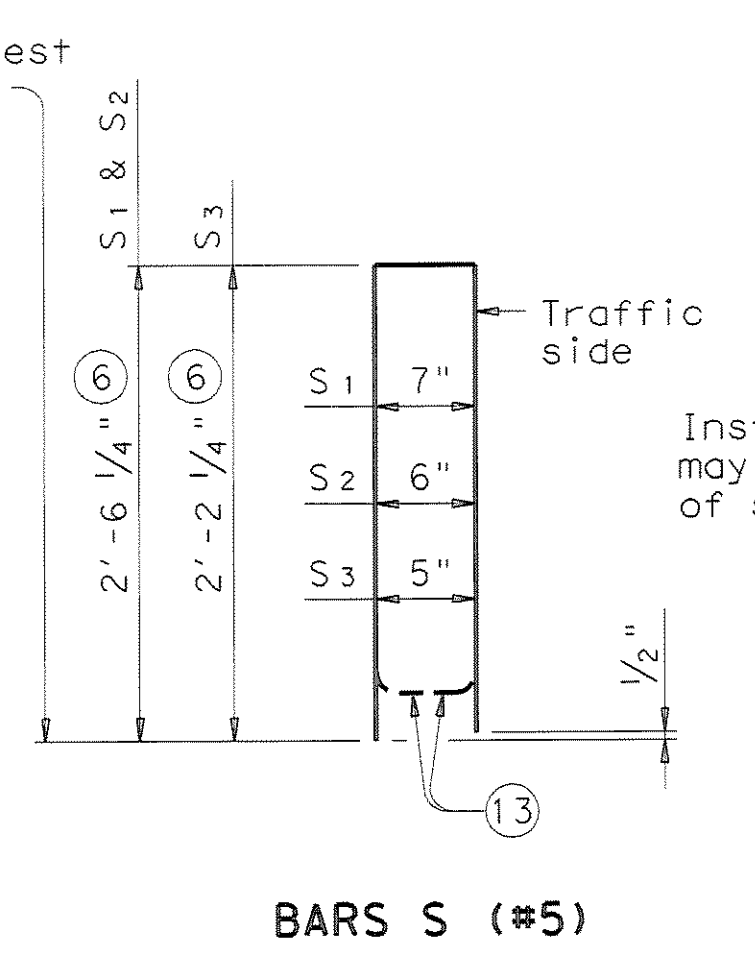


BARS S (#5)

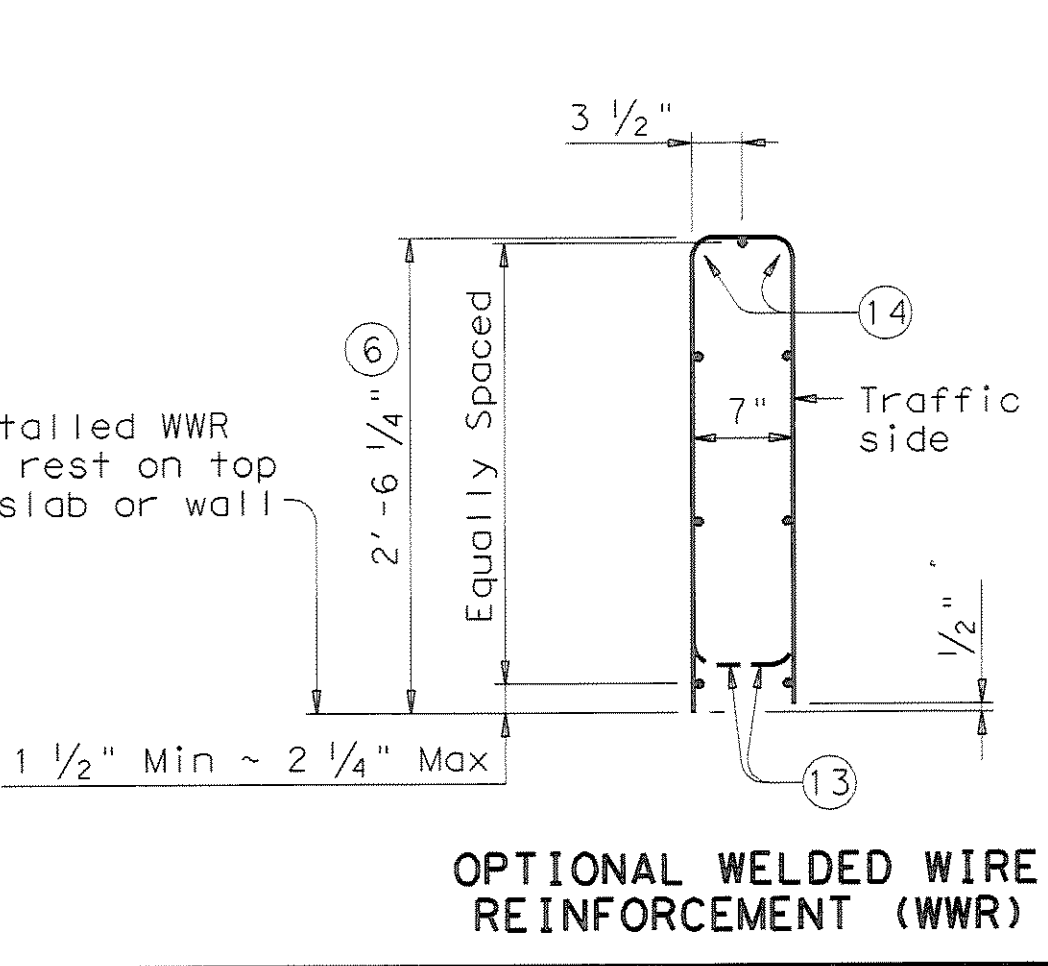


OPTIONAL WELDED WIRE REINFORCEMENT (WWR)

DESCRIPTION	LONGITUDINAL WIRES	VERTICAL WIRES
Minimum (Cumulative Total) Wire Area	0.933 Sq In.	0.248 Sq In. per Ft
Minimum Maximum	No. of Wires 7 11	Spacing 4" 12"
Maximum Wire Size Differential	The smaller wire shall have an area of 40% or more of the larger wire.	

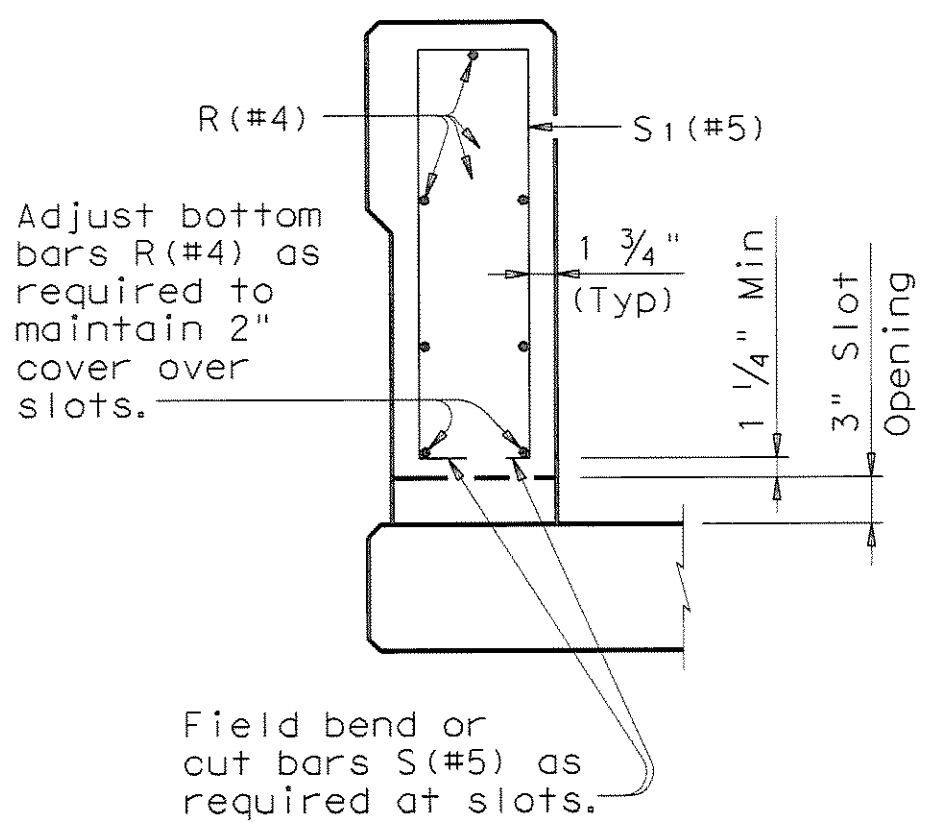

SECTION THRU OPTIONAL SIDE SLOT DRAIN

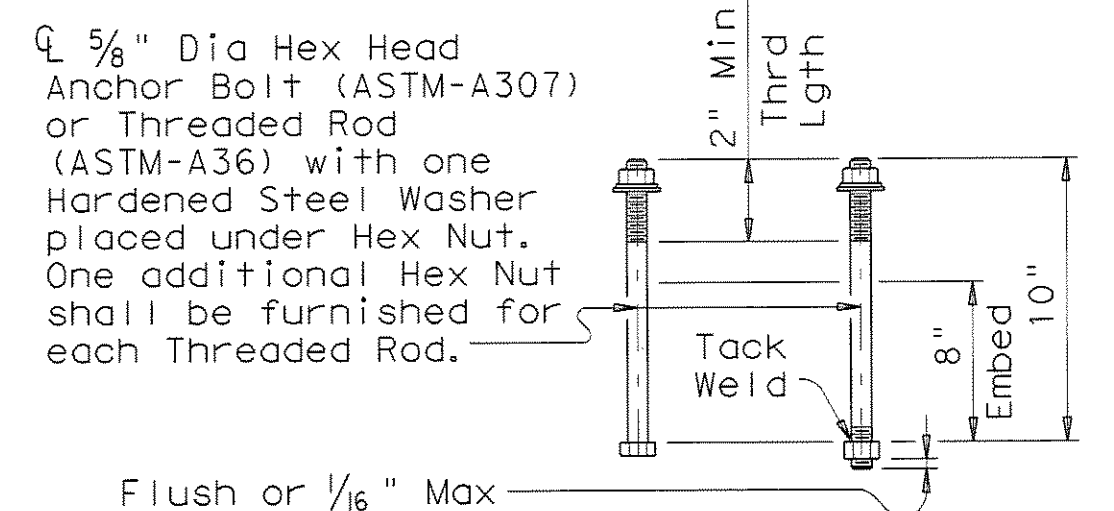

CAST-IN-PLACE ANCHOR BOLT OPTIONS

**GENERAL NOTES:**  
This rail, without the pipe rail, has been evaluated and accepted to be of equal strength to railings with like geometry, which have been crash tested to meet NCHRP Report 350 TL-3 criteria. However, its use is limited to design speeds of 45 mph and less, because the pipe rail presents an occupant compartment intrusion threat to high speed vehicular traffic.

Rail anchorage details shown on this standard may require modification for select structure types. See appropriate details elsewhere in plans for these modifications. All steel components except reinforcing shall be galvanized unless otherwise shown on plans. All concrete shall be Class "C". Chamfer all exposed corners. All reinforcing shall be Grade 60. Pipe for pipe rail shall conform to ASTM A53 Grade B or A501.

Erection drawings showing panel lengths, rail post spacing, and anchor bolt setting shall be submitted to the Engineer for approval. Anchor bolts shall be 5/8" Dia ASTM A36 threaded rods with one hex nut and one hardened steel washer at each bolt. Embed threaded rods into parapet wall with an epoxy anchorage system. Estimated required embedment depth is 3". Core drill holes (percussion drilling not permitted). Anchorage system chosen must be able to achieve an ultimate tensile resistance of 3.9 kips. The Contractor must provide evidence to the Engineer that this can be achieved. Evidence of adequate tensile resistance can be based on the manufacturer's published values of ultimate tensile strength (anchor spacing and edge distance must be accounted for). Anchor installation, including hole size, drilling, and clean-out, must be in accordance with the manufacturer's recommendations.

At the contractor's option anchor bolts may be cast with the parapet (See Cast-in-Place Anchor Bolt Options). Optional cast-in-place anchor bolts shall be 5/8" Dia ASTM A307 Grade A bolts (or A36 threaded rods with one tack welded hex nut each) with one hex nut and one hardened steel washer at each bolt. This railing may be constructed with slip-forms when approved by the Engineer, with equipment approved by the Engineer and when epoxy adhesive anchor bolts are used. Slip-forming parapet is not allowed if anchor bolts are cast with parapet wall. Sensor control for both line and grade must be provided. Tack welding to provide bracing for slip-form operations is acceptable. Welding can be performed at a minimum spacing of 3 ft between the cage and the anchorage. It is permissible to weld to U, wU and S bars at any location on the cage. If increased bracing is needed, additional anchorage devices must be added and welding must be performed in the upper two thirds of the cage.


Face of rail, parapet shall be plumb unless otherwise approved by the Engineer. Pipe rail posts shall be square to the top of parapet. Grout may be used under pipe rail post base plates if necessary. Pipe rail sections shall not include less than two posts, and no more than four (except at Abutments). Exposed edges of pipe rail and pipe rail posts shall be rounded or chamfered to approximately 1/16" by grinding. Deformed welded wire reinforcement (WWR) may be used as an option to conventional reinforcing and shall be made in accordance with ASTM A497 (Deformed Wire). Combinations of Reinforcing Steel and WWR or configurations of WWR other than shown will be permitted when the conditions in the table are satisfied and the dimension from end of section to first welded vertical wire does not exceed 3". Epoxy coat bars U and wU if slab bars are epoxy coated. Average weight of railing with no overlay: 370 plf (Conc) 10 plf (Steel)

- ⑥ Increase 2" for structures with overlay.
- ⑩ 2 1/2" Std Pipe (2.875" O.D. 0.203" wall thickness)
- ⑬ Bend or cut as required to clear drain slots.
- ⑭ No longitudinal wires may be within upper bend.
- ⑮ Side Slot Drains may be used where shown elsewhere on the plans or as directed by the Engineer. Drains should not be placed over railroad tracks, lower roadways, or sidewalks. When this rail is used as a separator between a roadway surface and a sidewalk surface, side drain slots will not be permitted.
- ⑯ 5 1/2" when vertical reinforcing has closer clear cover over horizontal reinforcing in abutment wingwalls or retaining walls on traffic side of wall.
- ⑰ As an aid in supporting reinforcement, additional longitudinal bars may be used in the slab with the approval of the Engineer. Such bars shall be furnished at the Contractors expense.
- ⑱ Top longitudinal slab bar may be adjusted laterally 3" ± to tie reinforcing.
- ⑲ See "General Notes" for anchor bolt information.
- ⑳ Shop drawings required for tubular steel sections (may be submitted as 11"x 17" prints, provided they are clearly legible).

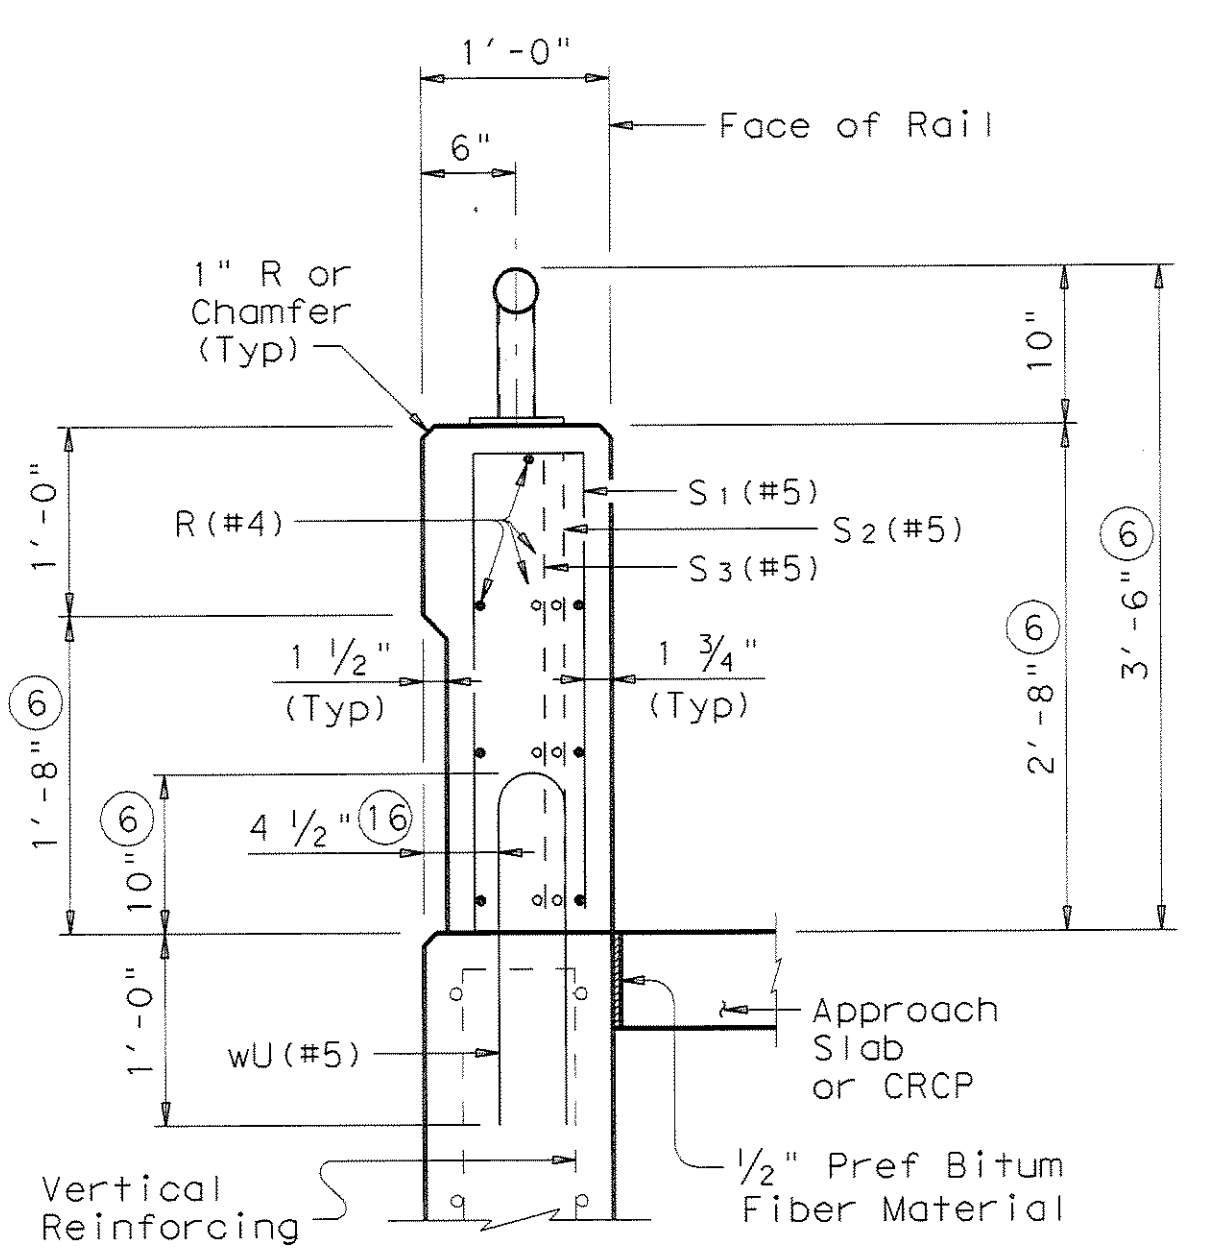

ON ABUTMENT WINGWALLS OR CIP RETAINING WALLS

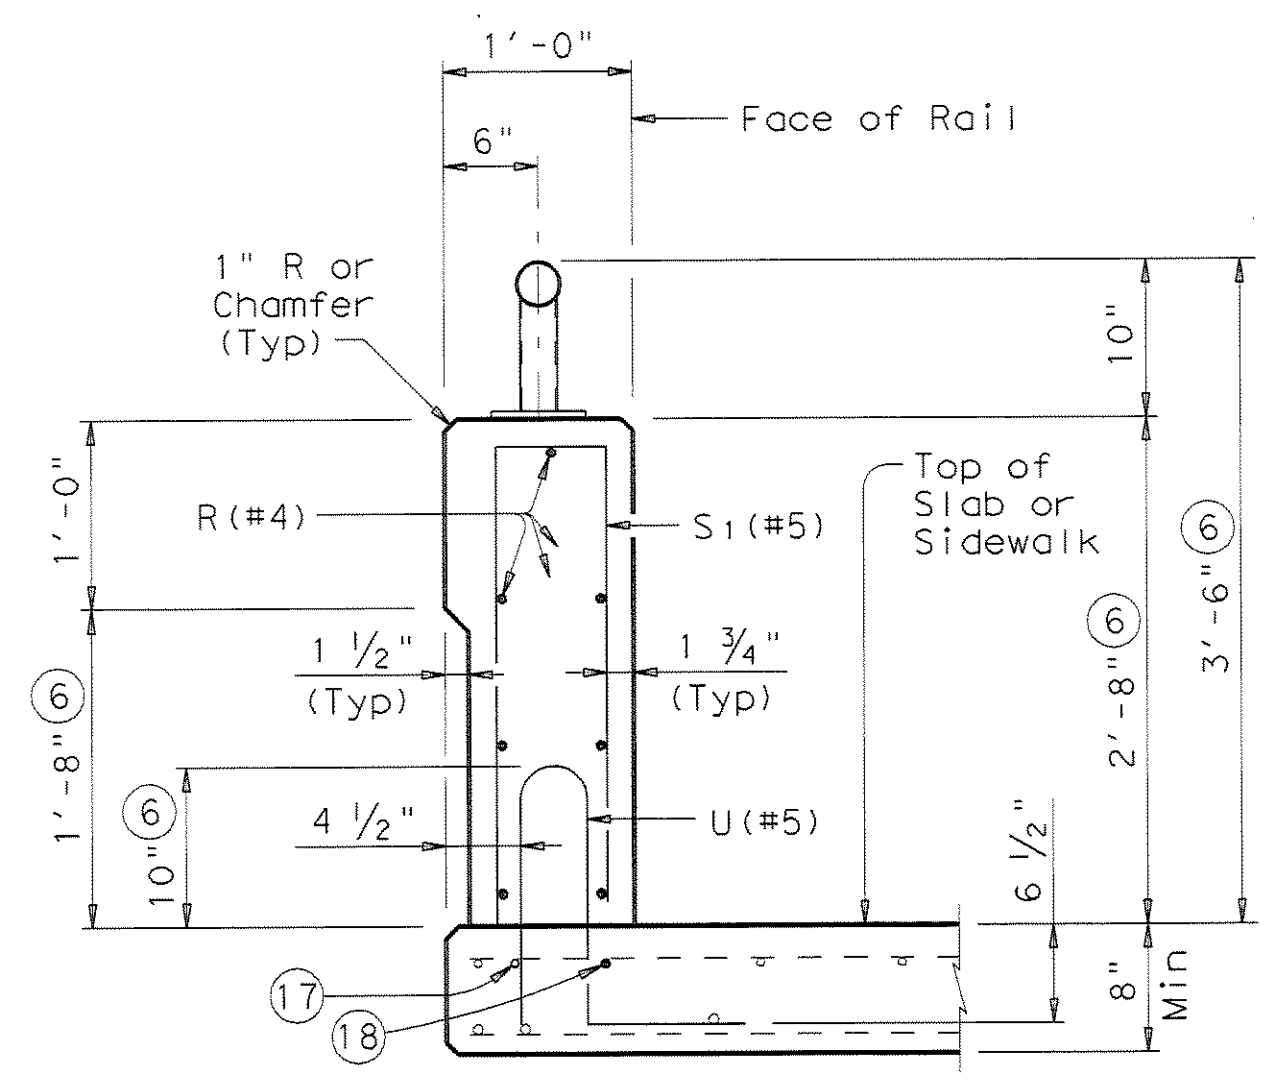

ON BRIDGE SLAB

SECTIONS THRU RAIL

RAIL DATA FOR HORIZONTAL CURVES		
RADIUS TO FACE OF RAIL	MAX CHORD LENGTH	CONSTRUCT OR FABRICATE
Over 2800'	29'-0"	Straight rail panels
Over 1400' thru 2800'	14'-6"	To required radius or to chords shown
Over 700' thru 1400'	7'-3"	To required radius
Thru 700'	Zero	To required radius

RECORD PLANS  
MARCH 28, 2008

SHEET 2 OF 2

**Texas Department of Transportation**  
Bridge Division

**TRAFFIC RAIL**

**TYPE C221**

FILE: r1std27.dgn    DN: TxDOT    CR: TxDOT    DW: JTR    CR: TxDOT


© TxDOT April 2005    DISTRICT    FEDERAL AID PROJECT    SHEET

REVISIONS:    03-06: Changed Base Plate Thickness, Rail Turndown and Rail Turndown Base Plate.

03-06: Changed 2'-6" to 2'-2" and removed 1" dimension on Pipe Rail Terminal Detail.

D309

TIME: 7:41 FILE: 04141-WLPP1.dwg


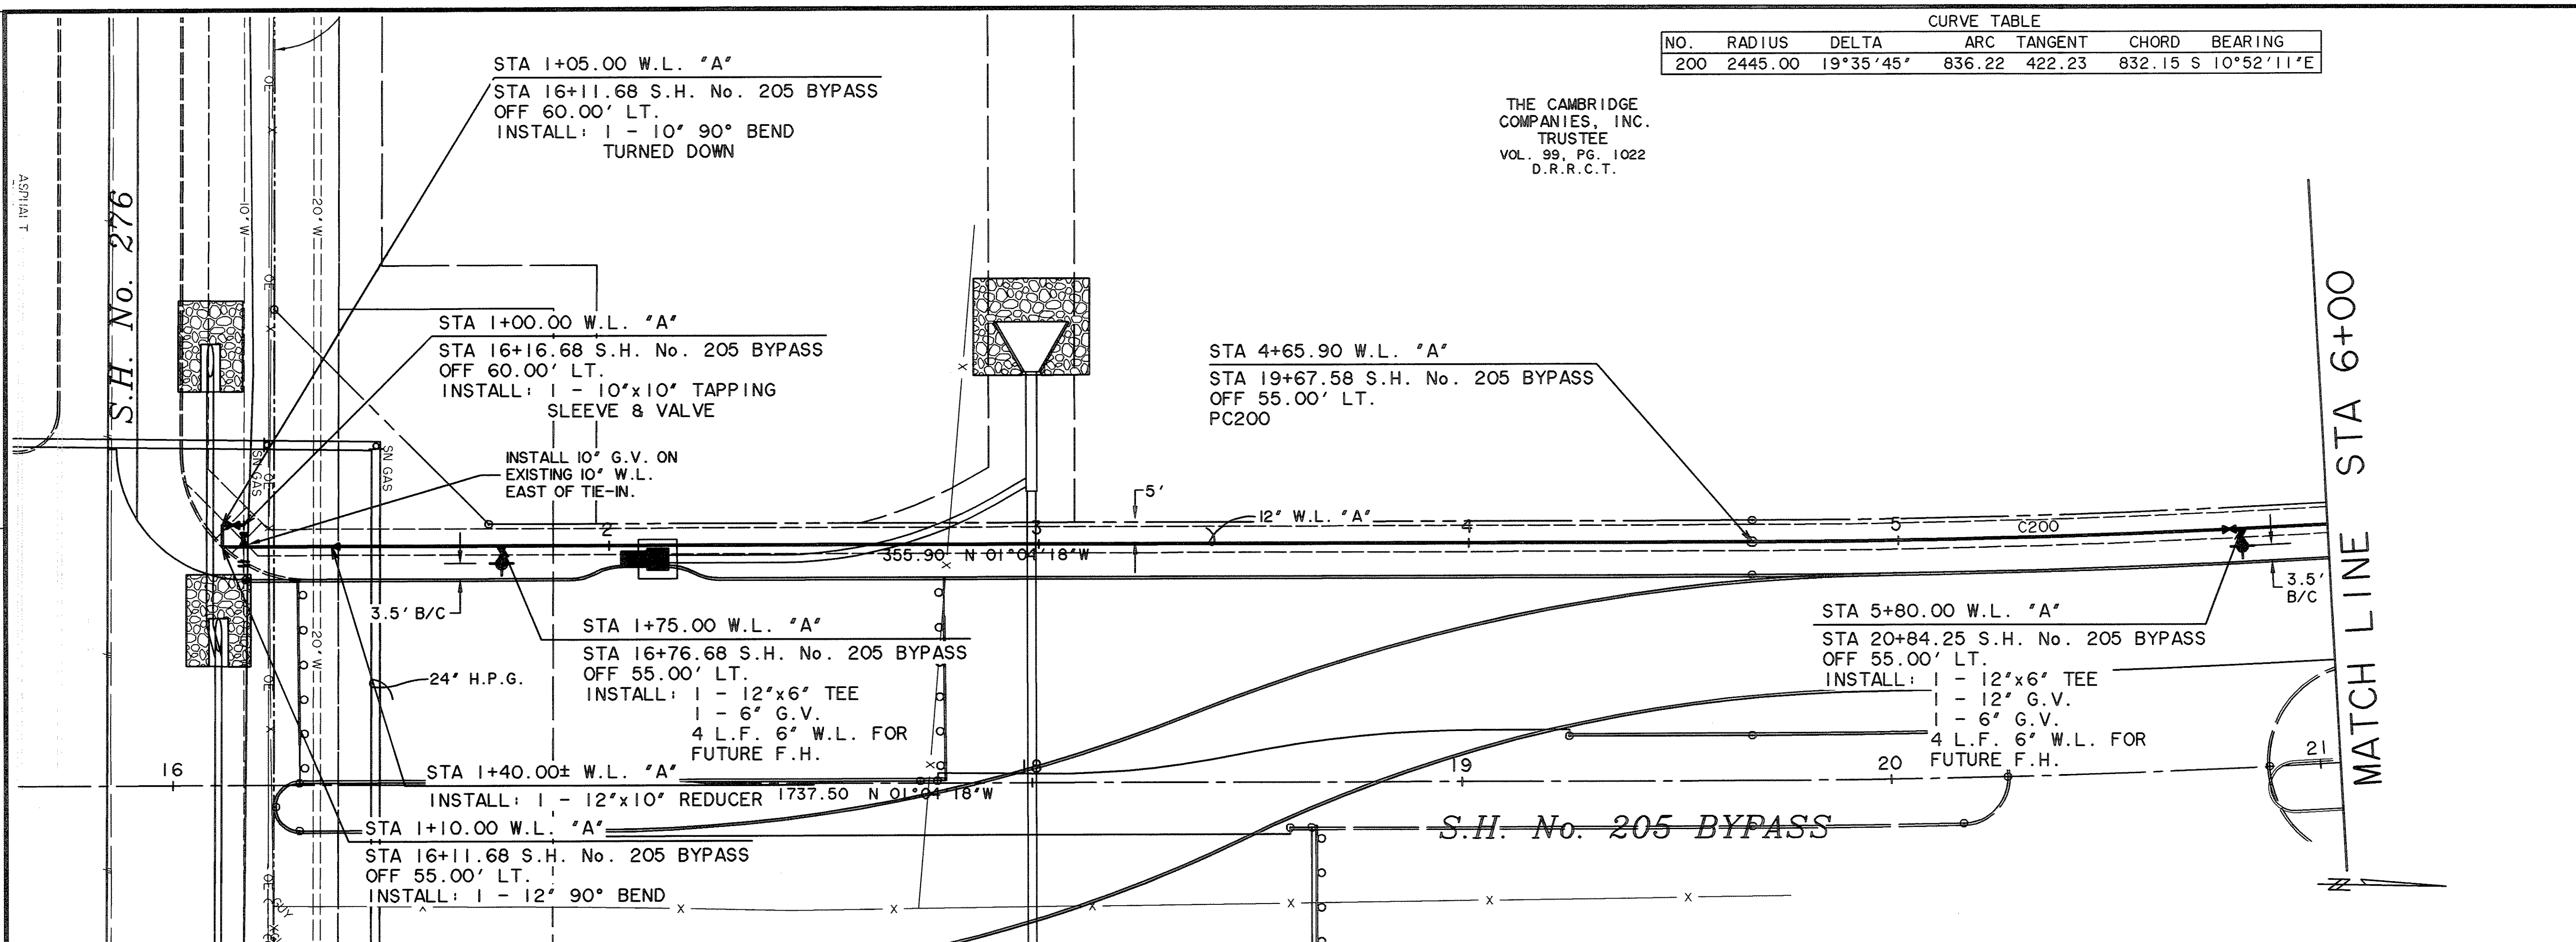


CURVE TABLE

NO.	RADIUS	DELTA	ARC TANGENT	CHORD	BEARING
200	2445.00	19°35'45"	836.22	422.23	832.15 S 10°52'11"E


THE CAMBRIDGE COMPANIES, INC. TRUSTEE  
VOL. 99, PG. 1022  
D.R.R.C.T.

NOTE: ALL PVC WATER LINES SHALL BE C-900 CLASS 200 PIPE. ALL CHANGES IN WATER LINE DIRECTION (BENDS) SHALL BE RESTRAINED (MEGA-LUG OR EQUAL) AND CONCRETE BLOCKED. THE NEXT JOINT EITHER SIDE OF THE CHANGE OF DIRECTION SHALL ALSO BE RESTRAINED.

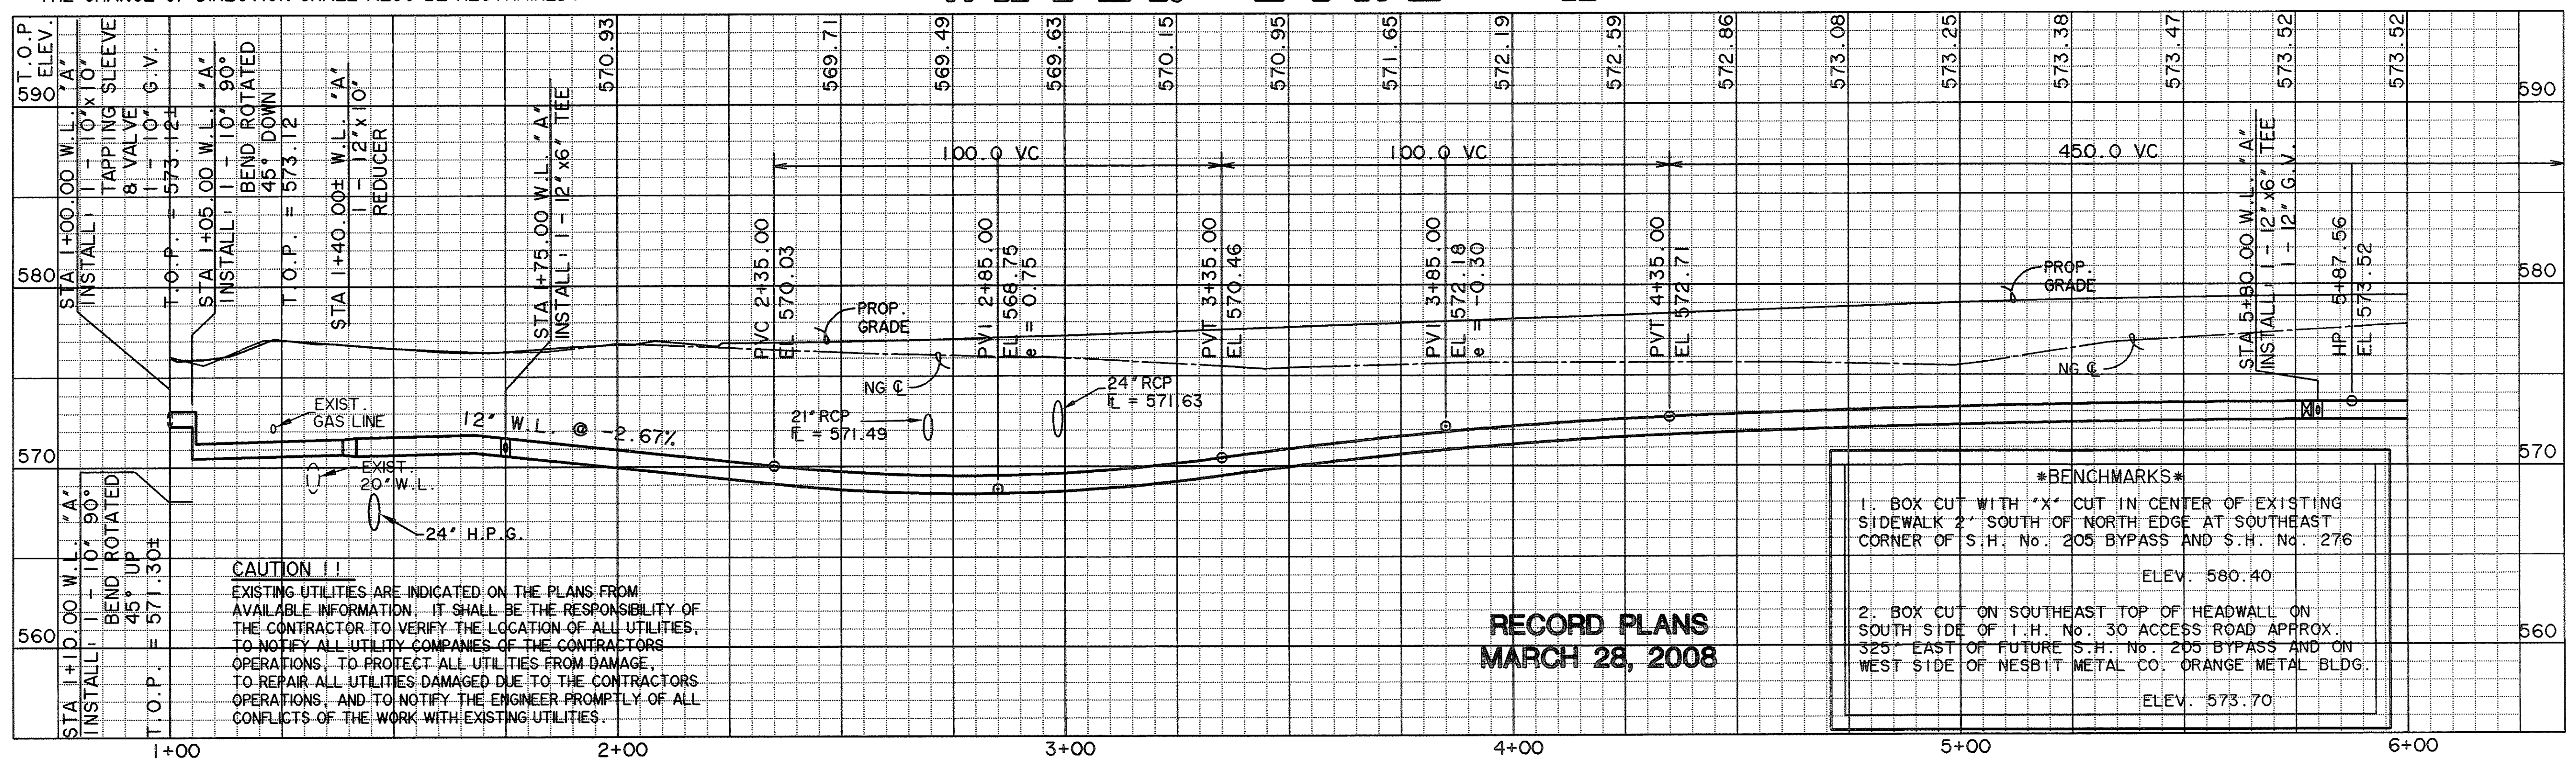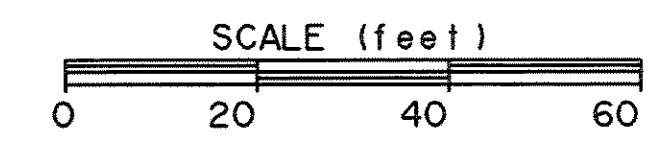

RECORD PLANS  
MARCH 28, 2008

PREPARED BY:  
**VIA WIER & ASSOCIATES, INC.**  
ENGINEERS SURVEYORS LAND PLANNERS  
4300 BELTWAY PLACE SUITE 130 ARLINGTON, TEXAS 76016 METRO (817)467-7700  
1380 U.S. HIGHWAY 287 N. SUITE 101 MANSFIELD, TEXAS 76063 METRO (817)477-6700  
6848 ELM STREET FRISCO, TEXAS 75034 METRO (214)387-8000  
www.viaassociates.com

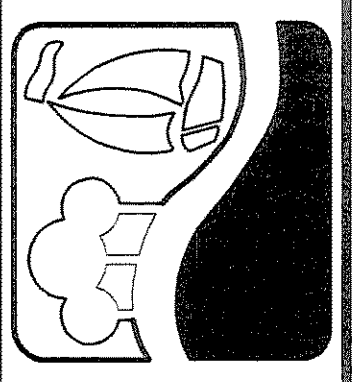

PHASE I SH. 205 BYPASS  
FROM SH. 276 TO INTERSTATE 30  
WATER LINE "A"  
PLAN & PROFILE  
STA 1+00 TO 6+00

STATE OF TEXAS  
PHILIP L. GRAHAM  
94719  
LICENSED PROFESSIONAL ENGINEER  
3/28/08  
COPYRIGHT ©  
WIER & ASSOCIATES, INC.  
LAST SHEET EDIT  
DATE 03-28-2008  
WA# 04141  
SHEET NO.  
U101

TIME 9:27 FILE: 04141-WLPP2.dwg




CURVE TABLE						
NO.	RADIUS	DELTA	ARC TANGENT	CHORD	BEARING	
200	2445.00	19°35'45"	836.22	422.23	832.15	S 10°52'11"E

NOTE: ALL PVC WATER LINES SHALL BE C-900 CLASS 200 PIPE. ALL CHANGES IN WATER LINE DIRECTION (BENDS) SHALL BE RESTRAINED (MEGA-LUG OR EQUAL) AND CONCRETE BLOCKED. THE NEXT JOINT EITHER SIDE OF THE CHANGE OF DIRECTION SHALL ALSO BE RESTRAINED.

***BENCHMARK***  
 1. BOX CUT WITH "X" CUT IN CENTER OF EXISTING SIDEWALK 2' SOUTH OF NORTH EDGE AT SOUTHEAST CORNER OF S.H. No. 205 BYPASS AND S.H. No. 276  
 ELEV. 580.40  
 2. BOX CUT ON SOUTHEAST TOP OF HEADWALL ON SOUTH SIDE OF I.H. No. 30 ACCESS ROAD APPROX. 325' EAST OF FUTURE S.H. No. 205 BYPASS AND ON WEST SIDE OF NESBIT METAL CO. ORANGE METAL BLDG.  
 ELEV. 573.70

THE CAMBRIDGE COMPANIES, INC. TRUSTEE  
 VOL. 99, PG. 1022  
 D.R.R.C.T.

STA 9+75.00 W.L. "A"  
 STA 24+88.13 S.H. No. 205 BYPASS OFF 55.00 LT.  
 INSTALL: 1 - 12"x6" TEE  
 1 - 12" G.V.  
 1 - 6" G.V.  
 4 L.F. 6" W.L. FOR FUTURE F.H.

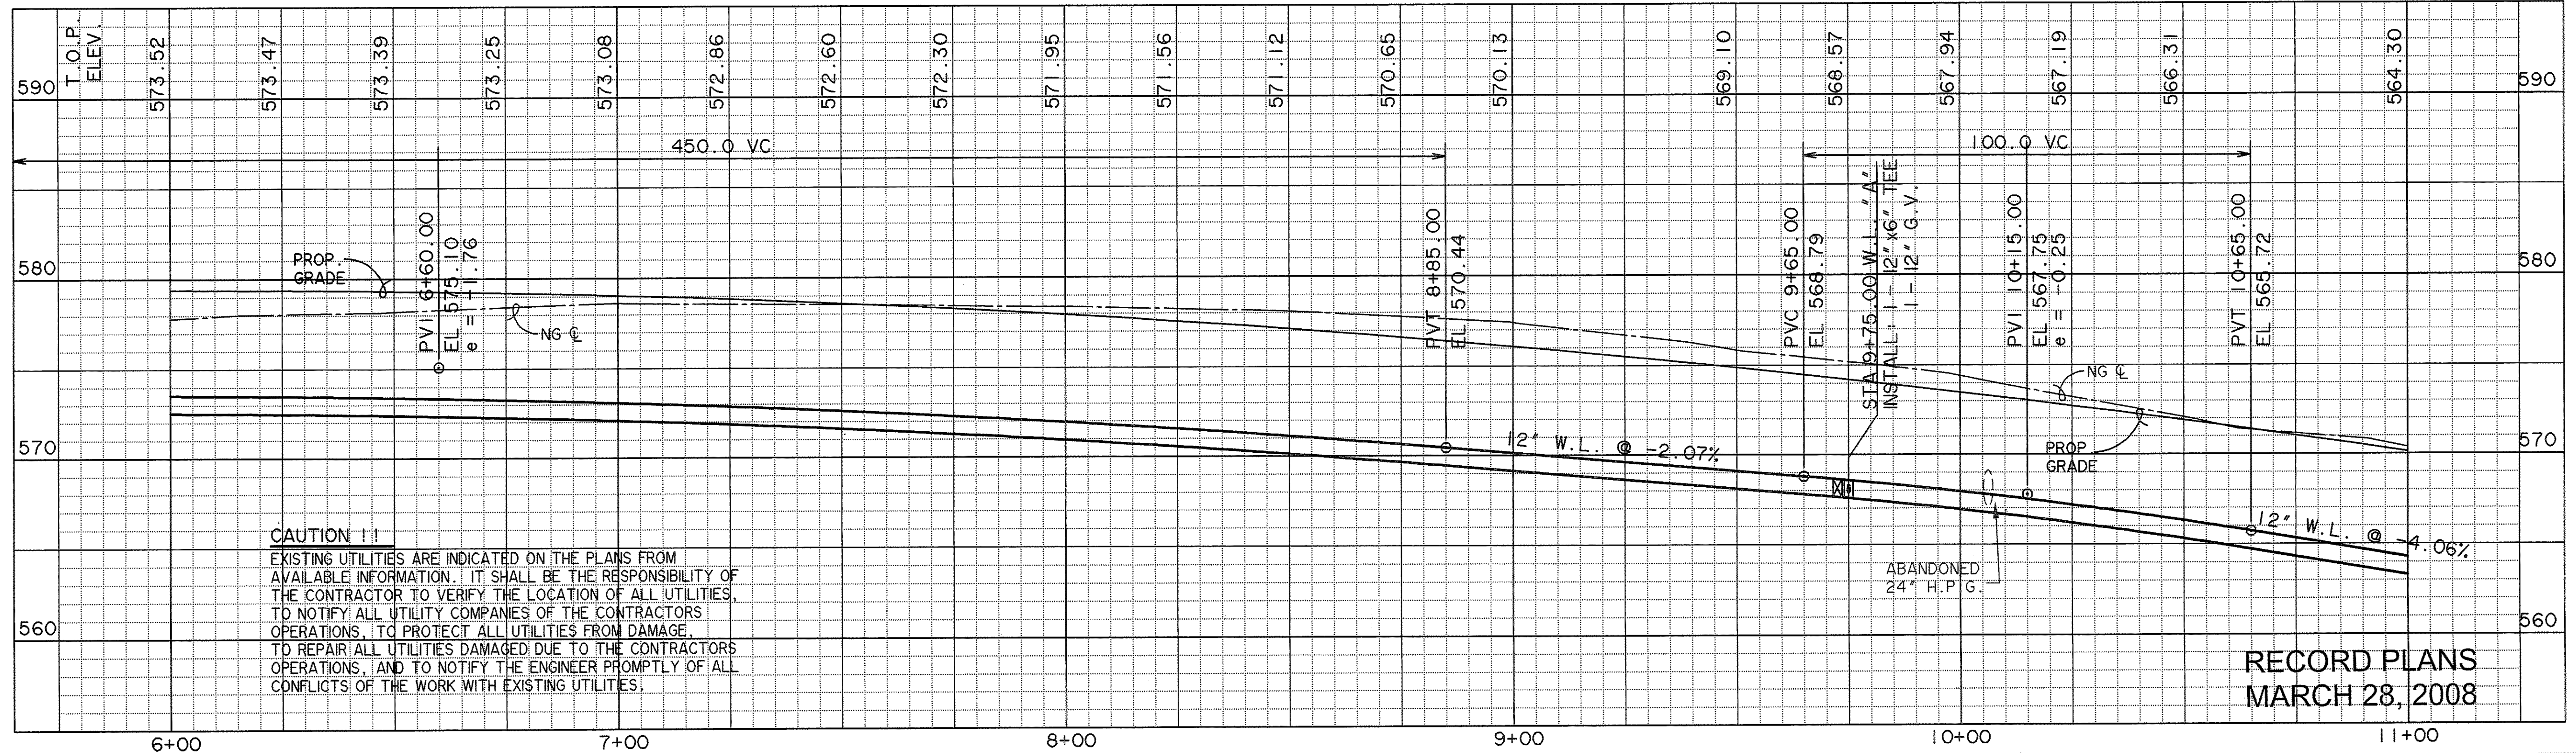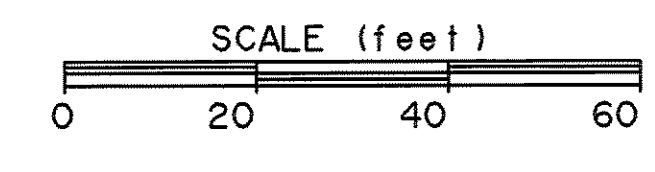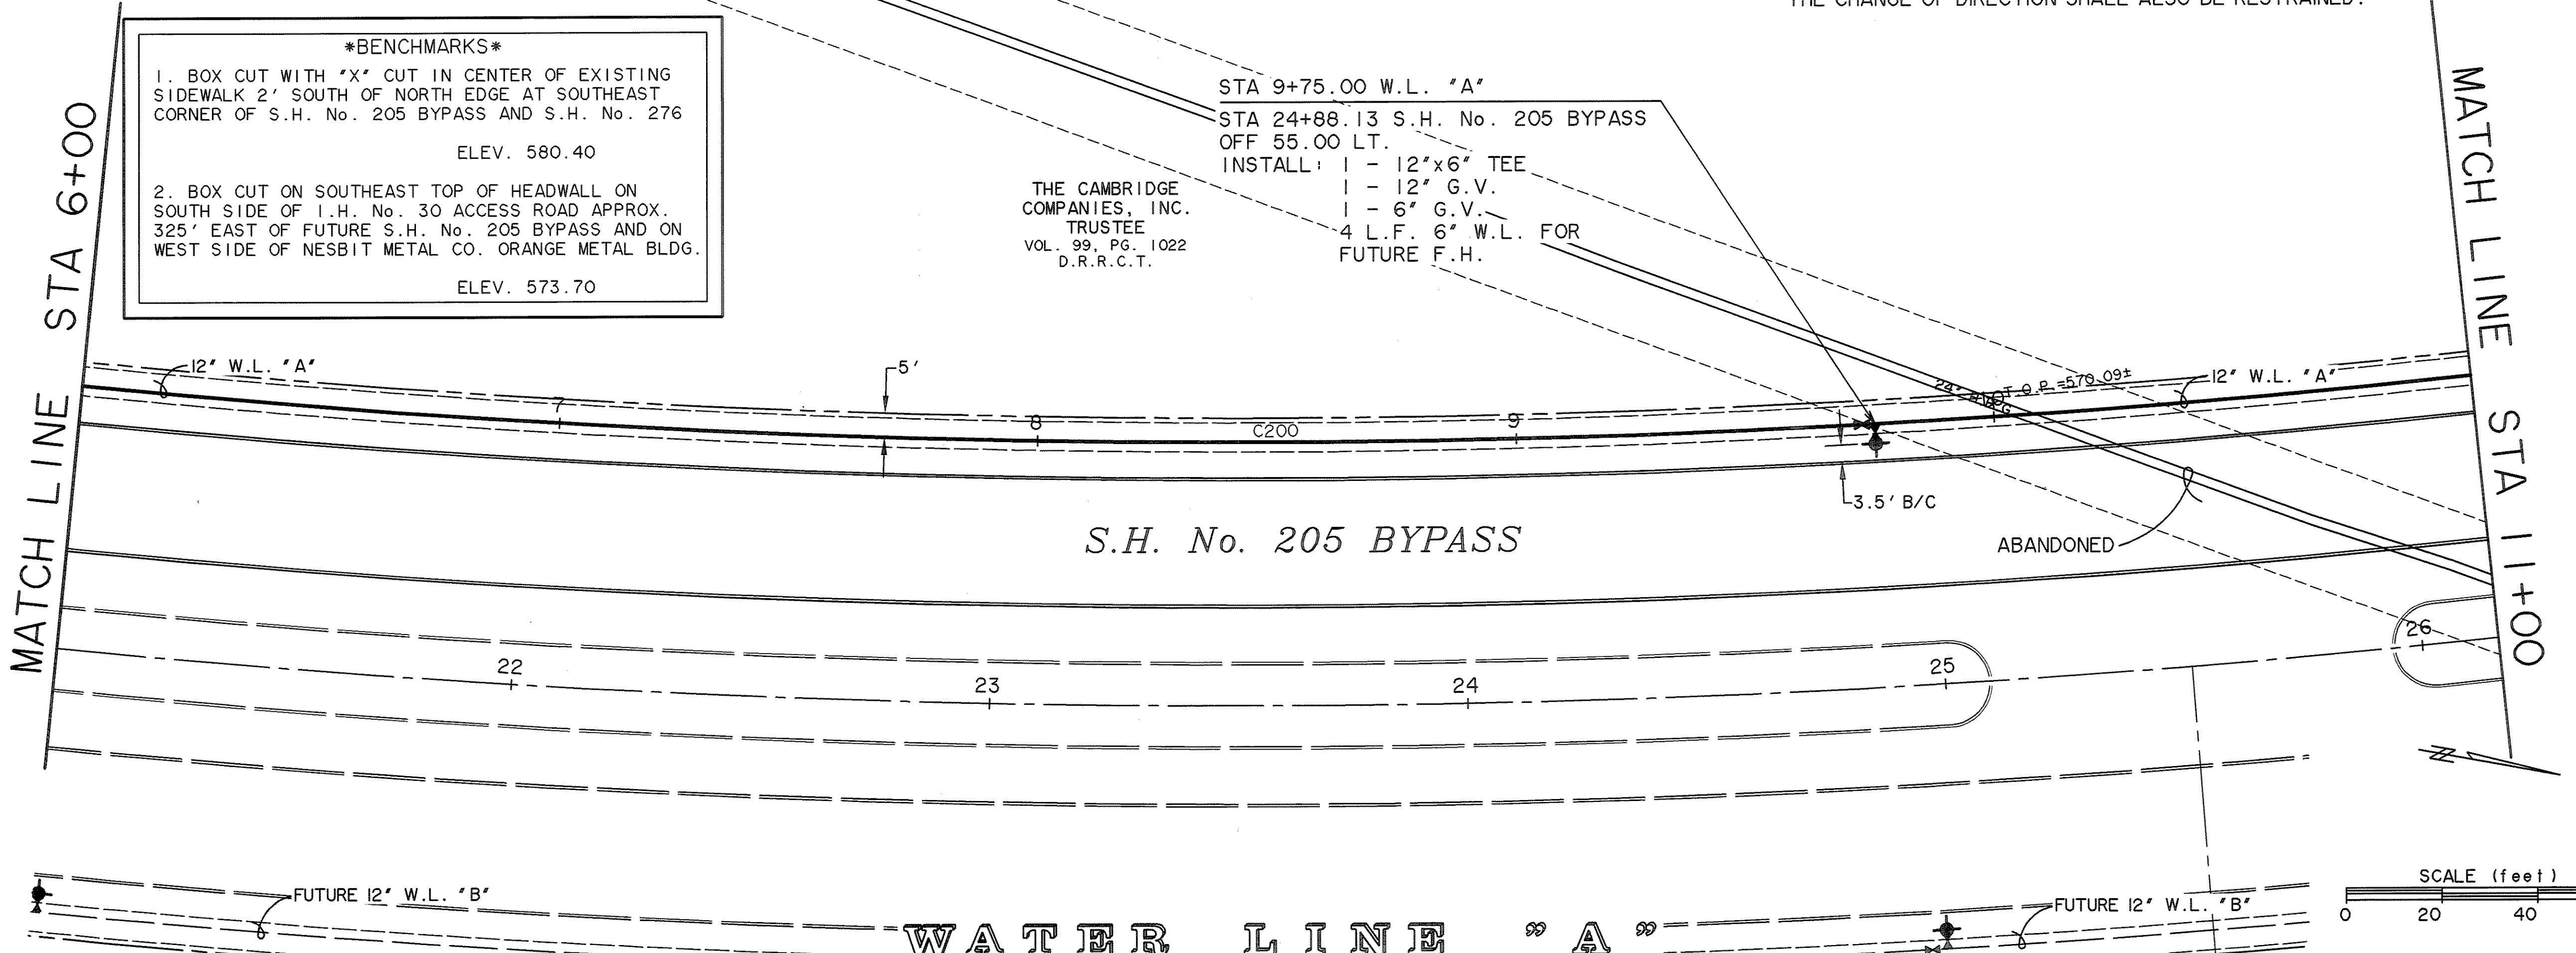


**CAUTION !!!**  
 EXISTING UTILITIES ARE INDICATED ON THE PLANS FROM AVAILABLE INFORMATION. IT SHALL BE THE RESPONSIBILITY OF THE CONTRACTOR TO VERIFY THE LOCATION OF ALL UTILITIES, TO NOTIFY ALL UTILITY COMPANIES OF THE CONTRACTORS OPERATIONS, TO PROTECT ALL UTILITIES FROM DAMAGE, TO REPAIR ALL UTILITIES DAMAGED DUE TO THE CONTRACTORS OPERATIONS, AND TO NOTIFY THE ENGINEER PROMPTLY OF ALL CONFLICTS OF THE WORK WITH EXISTING UTILITIES.

RECORD PLANS  
 MARCH 28, 2008

PREPARED BY:  
**WIA WIER & ASSOCIATES, INC.**  
 ENGINEERS SURVEYORS LAND PLANNERS  
 4300 BELTWAY PLACE SUITE 130 ARLINGTON, TEXAS 76018 METRO (817)467-7700  
 1380 U.S. HIGHWAY 287 N. SUITE 101 MANSFIELD, TEXAS 76063 METRO (817)477-8700  
 6848 ELM STREET FRISCO, TEXAS 75034 METRO (214)397-8000  
 www.wiaassociates.com



PHASE I S.H. 205 BYPASS  
 FROM S.H. 276 TO INTERSTATE 30  
**WATER LINE "A"**  
 PLAN & PROFILE  
 STA 6+00 TO 11+00

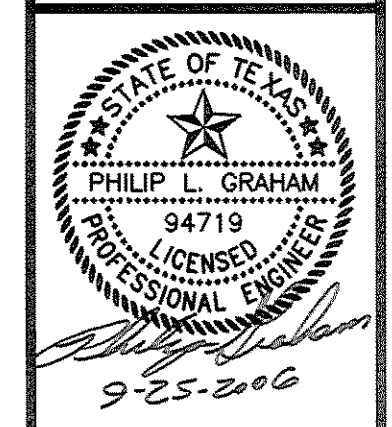



COPYRIGHT ©  
 WIER & ASSOCIATES, INC.  
 LAST SHEET EDIT  
 DATE 09-15-2006  
 WA# 04141  
 SHEET NO.  
 U102

CURVE TABLE					
NO.	RADIUS	DELTA	ARC TANGENT	CHORD	BEARING
200	2445.00	19°35'45"	836.22	422.23	832.15 S 10°52'11"E

NOTE: ALL PVC WATER LINES SHALL BE C-900 CLASS 200 PIPE. ALL CHANGES IN WATER LINE DIRECTION (BENDS) SHALL BE RESTRAINED (MEGA-LUG OR EQUAL) AND CONCRETE BLOCKED. THE NEXT JOINT EITHER SIDE OF THE CHANGE OF DIRECTION SHALL ALSO BE RESTRAINED.

THE CAMBRIDGE COMPANIES, INC.  
TRUSTEE  
VOL. 99, PG. 1022  
D.R.R.C.T.


***BENCHMARK***  
1. BOX CUT WITH "X" CUT IN CENTER OF EXISTING SIDEWALK 2' SOUTH OF NORTH EDGE AT SOUTHEAST CORNER OF S.H. No. 205 BYPASS AND S.H. No. 276  
ELEV. 580.40  
2. BOX CUT ON SOUTHEAST TOP OF HEADWALL ON SOUTH SIDE OF I.H. No. 30 ACCESS ROAD APPROX. 325' EAST OF FUTURE S.H. No. 205 BYPASS AND ON WEST SIDE OF NESBIT METAL CO. ORANGE METAL BLDG.  
ELEV. 573.70

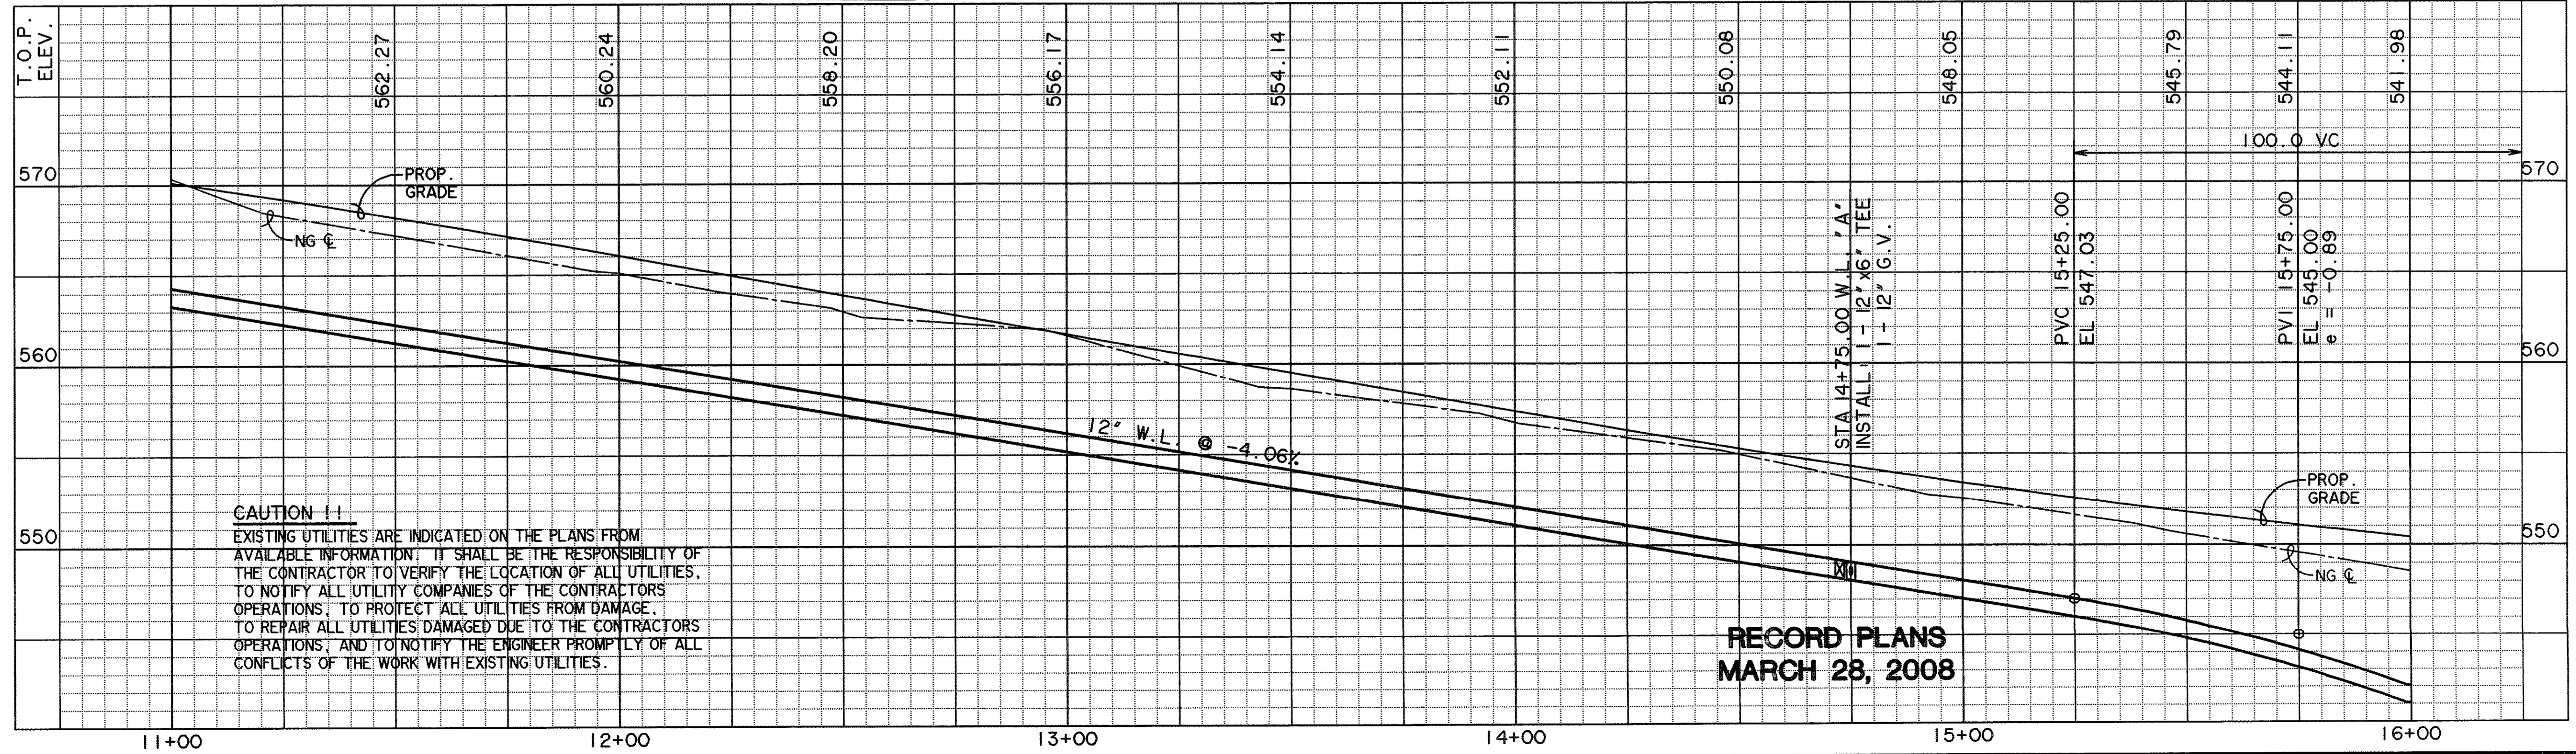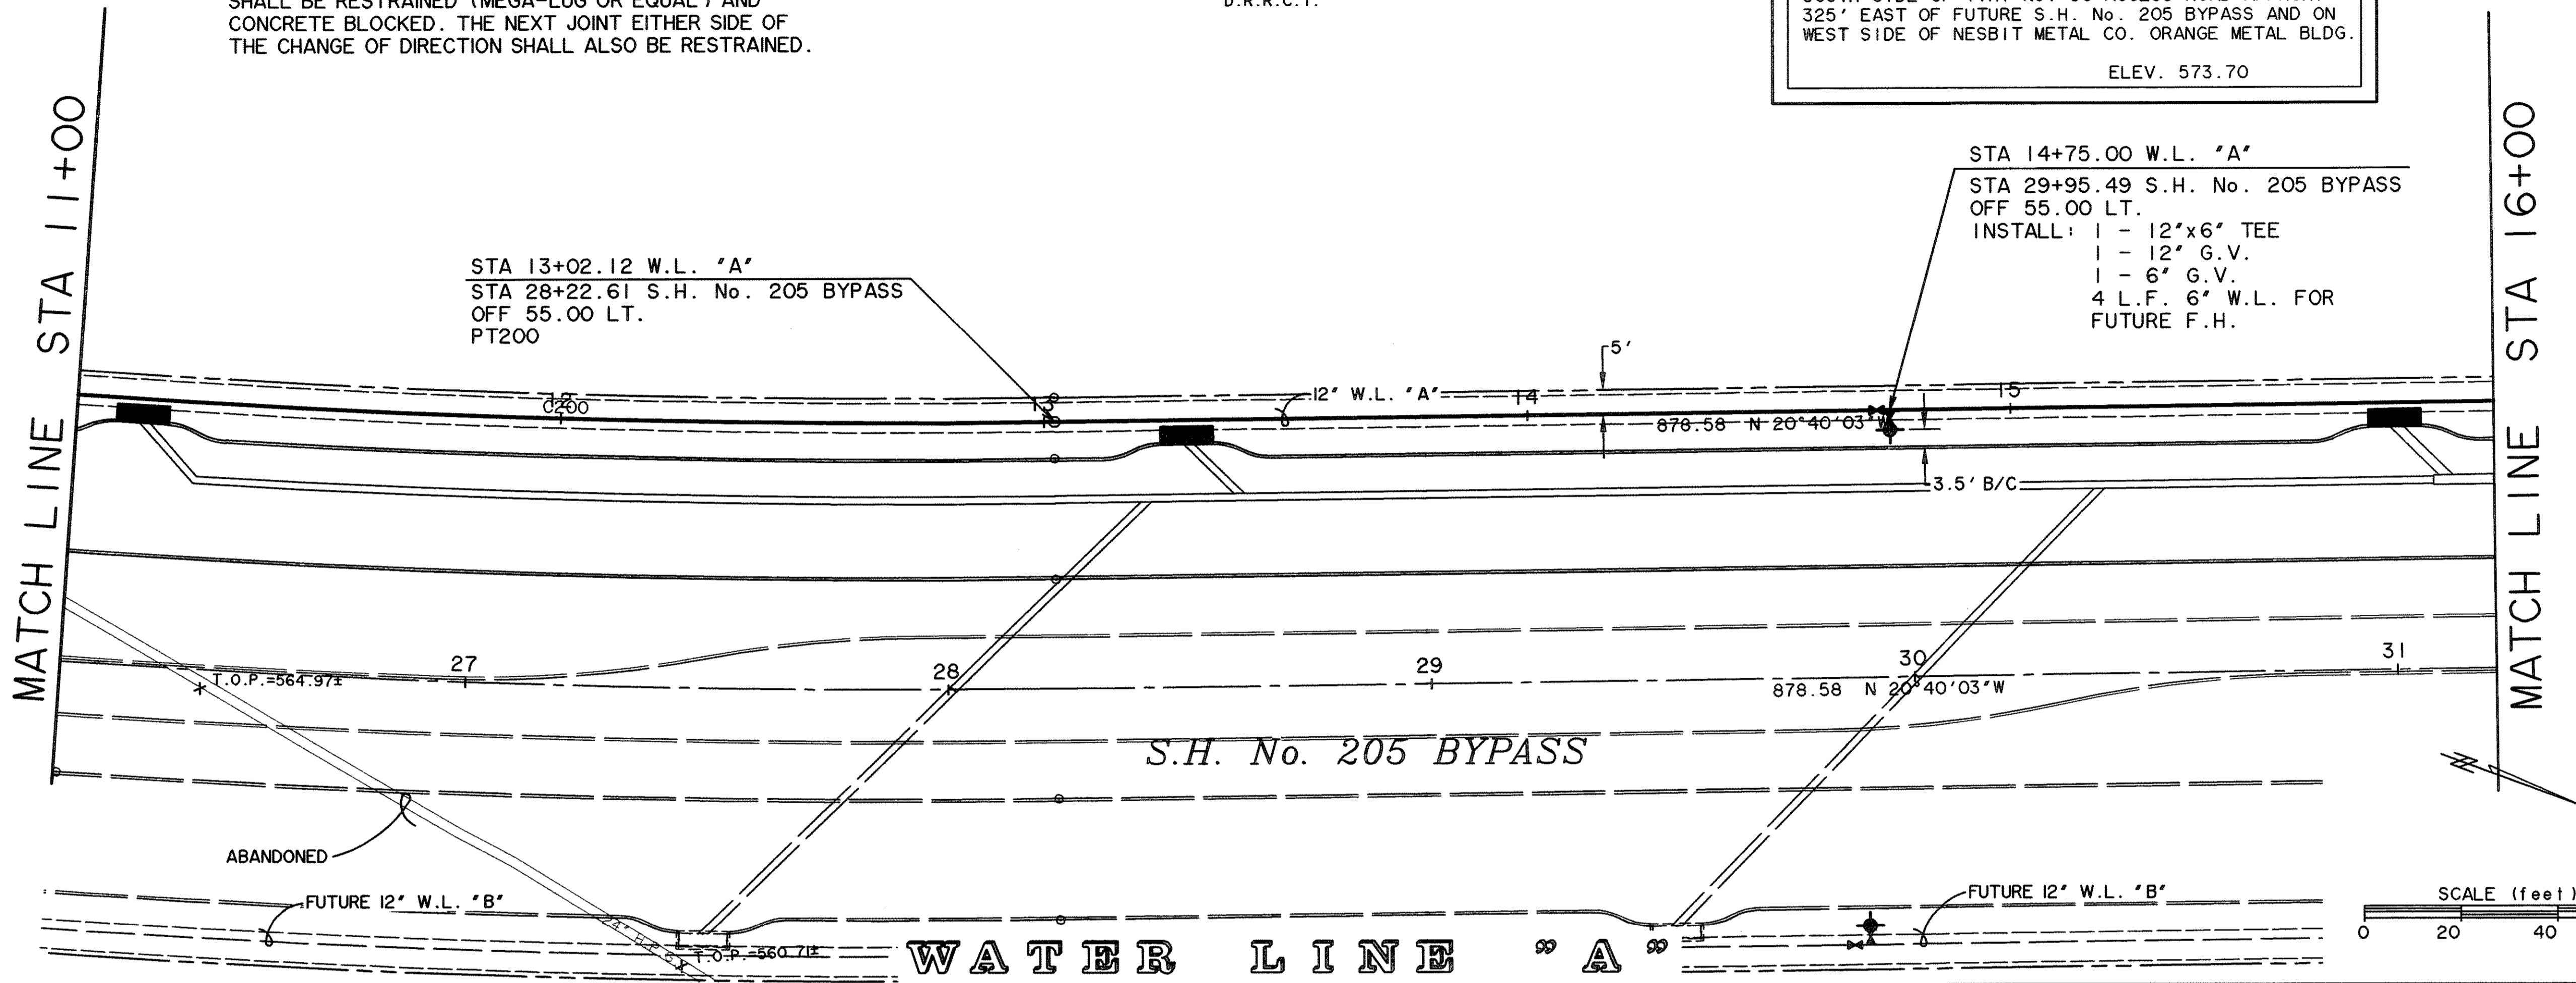


**CAUTION !!**  
EXISTING UTILITIES ARE INDICATED ON THE PLANS FROM AVAILABLE INFORMATION. IT SHALL BE THE RESPONSIBILITY OF THE CONTRACTOR TO VERIFY THE LOCATION OF ALL UTILITIES, TO NOTIFY ALL UTILITY COMPANIES OF THE CONTRACTORS OPERATIONS, TO PROTECT ALL UTILITIES FROM DAMAGE, TO REPAIR ALL UTILITIES DAMAGED DUE TO THE CONTRACTORS OPERATIONS, AND TO NOTIFY THE ENGINEER PROMPTLY OF ALL CONFLICTS OF THE WORK WITH EXISTING UTILITIES.

**RECORD PLANS  
MARCH 28, 2008**

PREPARED BY:  
**WIA WIER & ASSOCIATES, INC.**  
ENGINEERS SURVEYORS LAND PLANNERS  
4300 BELTWAY PLACE SUITE 130 ARLINGTON, TEXAS 76018 METRO (817)467-7700  
1380 U.S. HIGHWAY 287 N. SUITE 101 WANSFELD, TEXAS 76063 METRO (817)477-8700  
6848 ELM STREET FRISCO, TEXAS 75034 METRO (214)387-8800  
www.wiaassociates.com

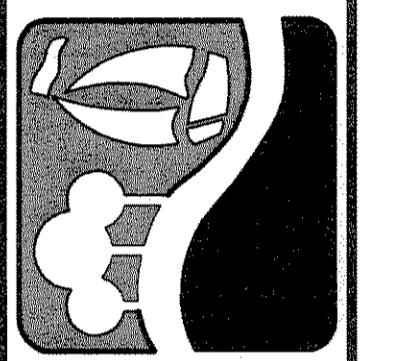

**PHASE I S.H. 205 BYPASS  
FROM S.H. 276 TO INTERSTATE 30  
WATER LINE "A"  
PLAN & PROFILE  
STA 11+00 TO 16+00**

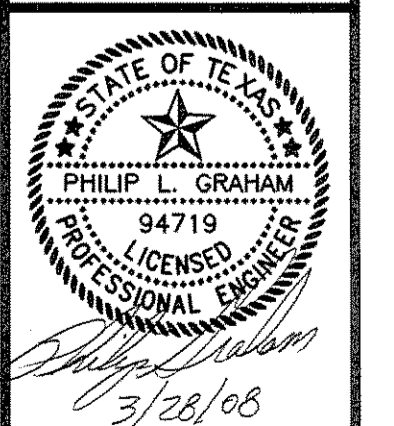

COPYRIGHT ©  
WIER & ASSOCIATES, INC.  
LAST SHEET EDIT  
DATE 09-15-2006  
WA# 04141  
**SHEET NO.  
U103**

TIME 9:28 FILE 04141-WLPP3.dwg

***BENCHMARK***


1. BOX CUT WITH "X" CUT IN CENTER OF EXISTING SIDEWALK 2' SOUTH OF NORTH EDGE AT SOUTHEAST CORNER OF S.H. No. 205 BYPASS AND S.H. No. 276  
ELEV. 580.40

2. BOX CUT ON SOUTHEAST TOP OF HEADWALL ON SOUTH SIDE OF I.H. No. 30 ACCESS ROAD APPROX. 325' EAST OF FUTURE S.H. No. 205 BYPASS AND ON WEST SIDE OF NESBIT METAL CO. ORANGE METAL BLDG.  
ELEV. 573.70



THE CAMBRIDGE COMPANIES, INC.  
TRUSTEE  
VOL. 99, PG. 1022  
D.R.R.C.T.

MATCH LINE STA 16+00

MATCH LINE STA 21+00

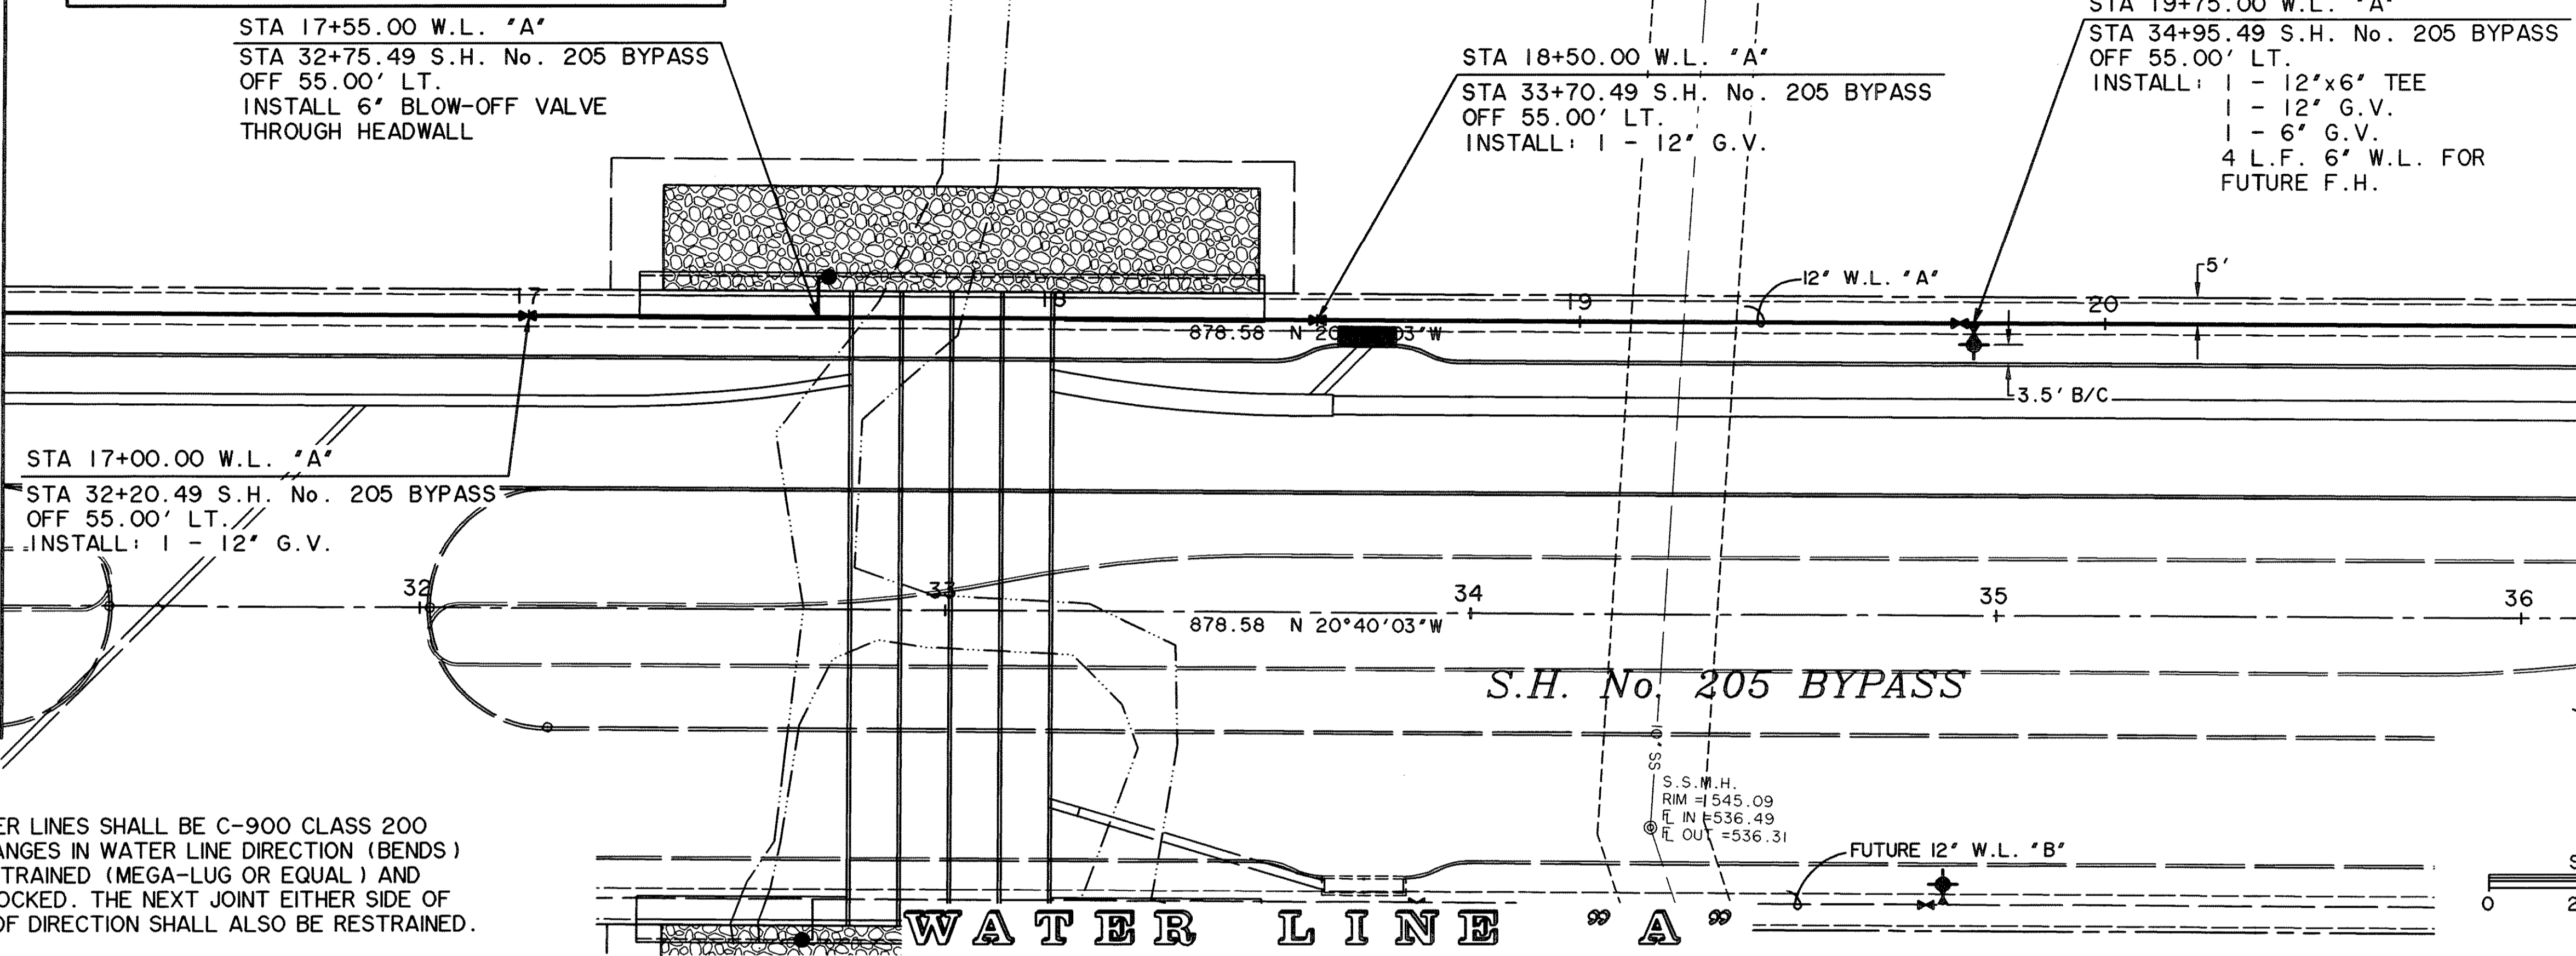


NOTE: ALL PVC WATER LINES SHALL BE C-900 CLASS 200 PIPE. ALL CHANGES IN WATER LINE DIRECTION (BENDS) SHALL BE RESTRAINED (MEGA-LUG OR EQUAL) AND CONCRETE BLOCKED. THE NEXT JOINT EITHER SIDE OF THE CHANGE OF DIRECTION SHALL ALSO BE RESTRAINED.

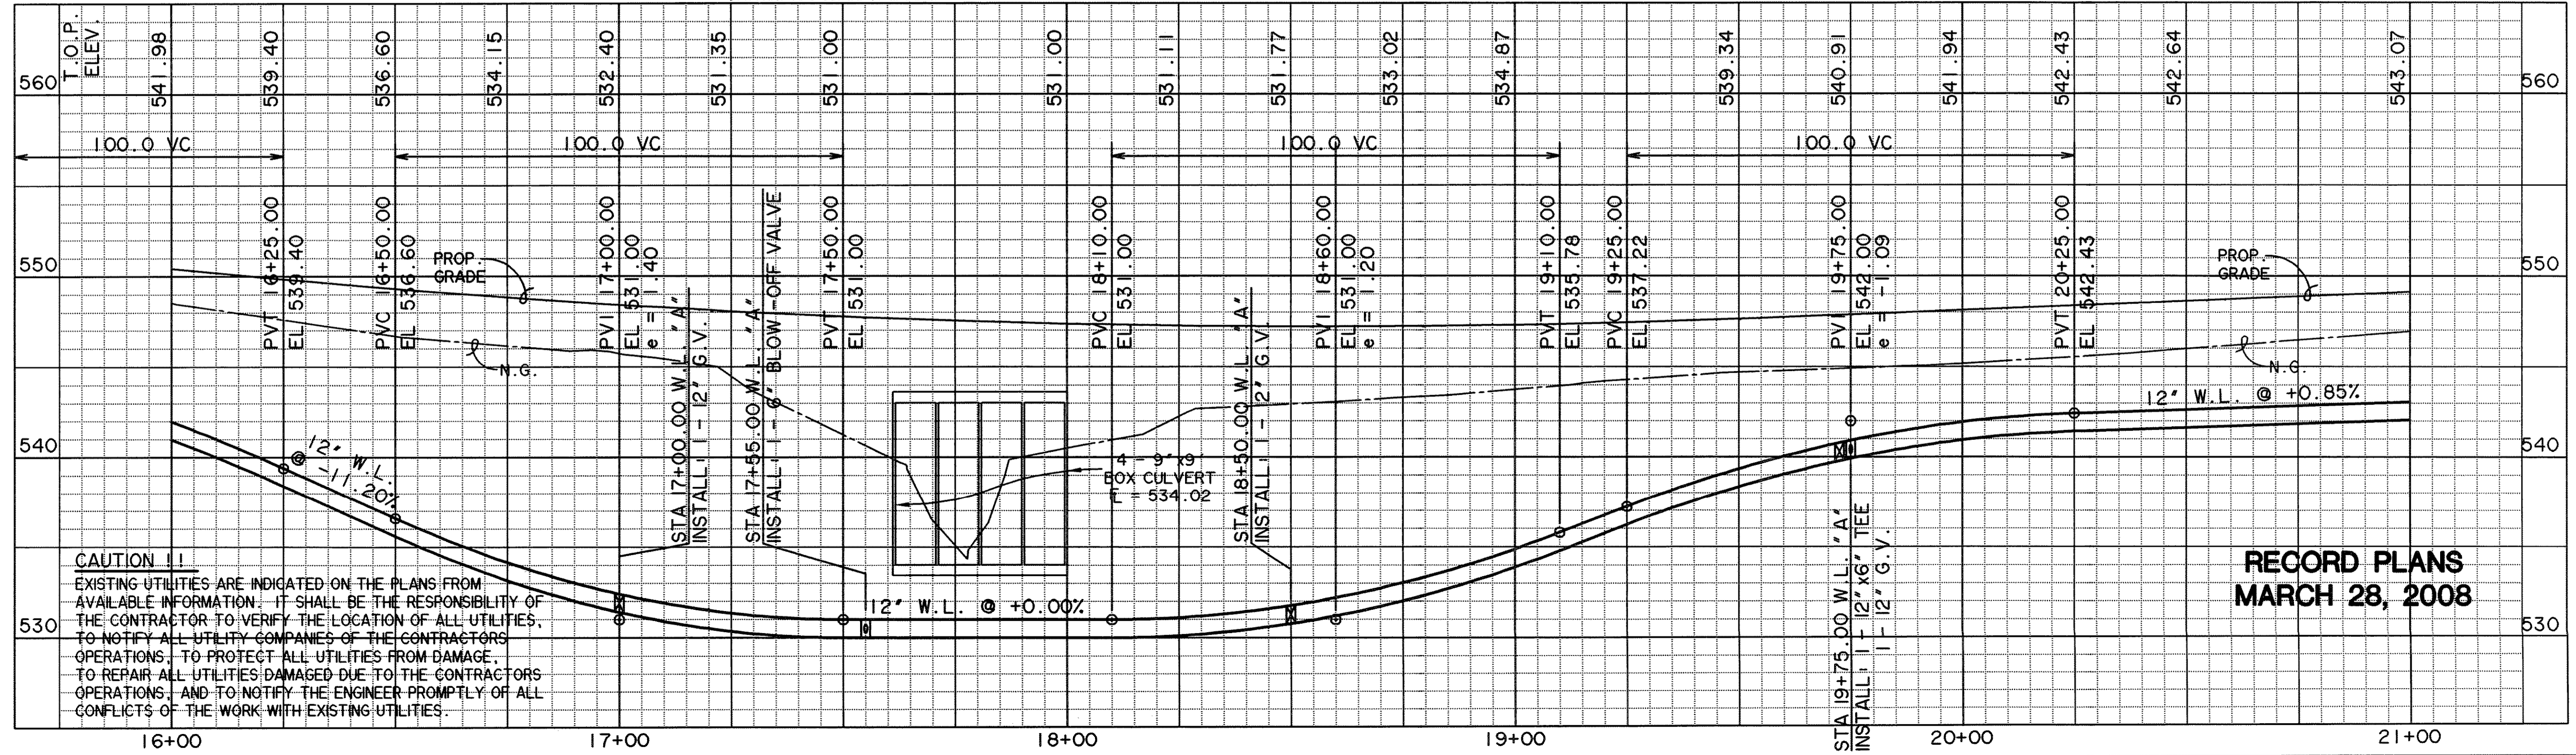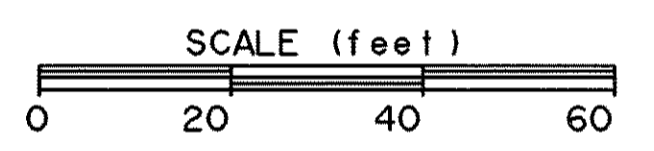


**CAUTION !!**  
EXISTING UTILITIES ARE INDICATED ON THE PLANS FROM AVAILABLE INFORMATION. IT SHALL BE THE RESPONSIBILITY OF THE CONTRACTOR TO VERIFY THE LOCATION OF ALL UTILITIES, TO NOTIFY ALL UTILITY COMPANIES OF THE CONTRACTOR'S OPERATIONS, TO PROTECT ALL UTILITIES FROM DAMAGE, TO REPAIR ALL UTILITIES DAMAGED DUE TO THE CONTRACTOR'S OPERATIONS, AND TO NOTIFY THE ENGINEER PROMPTLY OF ALL CONFLICTS OF THE WORK WITH EXISTING UTILITIES.

RECORD PLANS  
MARCH 28, 2008

PREPARED BY:  
**WIA WIER & ASSOCIATES, INC.**  
ENGINEERS SURVEYORS LAND PLANNERS  
4300 BELWAY PLACE SUITE 130 ARLINGTON, TEXAS 76018 METRO (817)467-7700  
1380 U.S. HIGHWAY 287 N. SUITE 101 HANFORD, TEXAS 76063 METRO (817)477-8700  
6849 ELM STREET FRISCO, TEXAS 75034 METRO (214)397-8000  
www.wierassociates.com

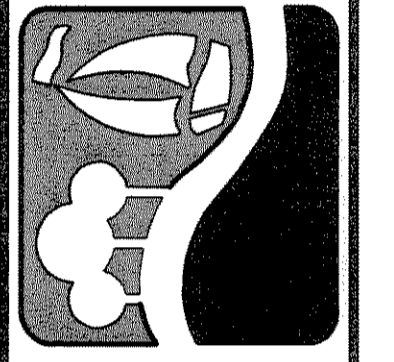

PHASE I S.H. 205 BYPASS  
FROM S.H. 276 TO INTERSTATE 30  
WATER LINE "A"  
PLAN & PROFILE  
STA 16+00 TO 21+00

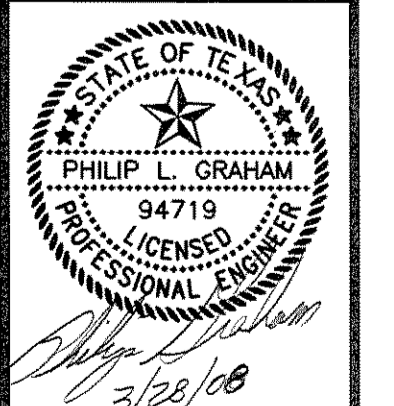

COPYRIGHT ©  
WIER & ASSOCIATES, INC.  
LAST SHEET EDIT  
DATE 09-15-2006  
WA# 04141  
SHEET NO.  
U104

NO.	RADIUS	DELTA	ARC TANGENT	CHORD	BEARING
201	2005.00	20°19'45"	711.39	359.48	707.67 N 10°30'11"W



***BENCHMARKS***

1. BOX CUT WITH "X" CUT IN CENTER OF EXISTING SIDEWALK 2' SOUTH OF NORTH EDGE AT SOUTHEAST CORNER OF S.H. No. 205 BYPASS AND S.H. No. 276  
ELEV. 580.40


2. BOX CUT ON SOUTHEAST TOP OF HEADWALL ON SOUTH SIDE OF I.H. No. 30 ACCESS ROAD APPROX. 325' EAST OF FUTURE S.H. No. 205 BYPASS AND ON WEST SIDE OF NESBIT METAL CO. ORANGE METAL BLDG.  
ELEV. 573.70

THE CAMBRIDGE COMPANIES, INC. TRUSTEE  
VOL. 99, PG. 1022  
D.R.R.C.T.


NOTE: ALL PVC WATER LINES SHALL BE C-900 CLASS 200 PIPE. ALL CHANGES IN WATER LINE DIRECTION (BENDS) SHALL BE RESTRAINED (MEGA-LUG OR EQUAL) AND CONCRETE BLOCKED. THE NEXT JOINT EITHER SIDE OF THE CHANGE OF DIRECTION SHALL ALSO BE RESTRAINED.

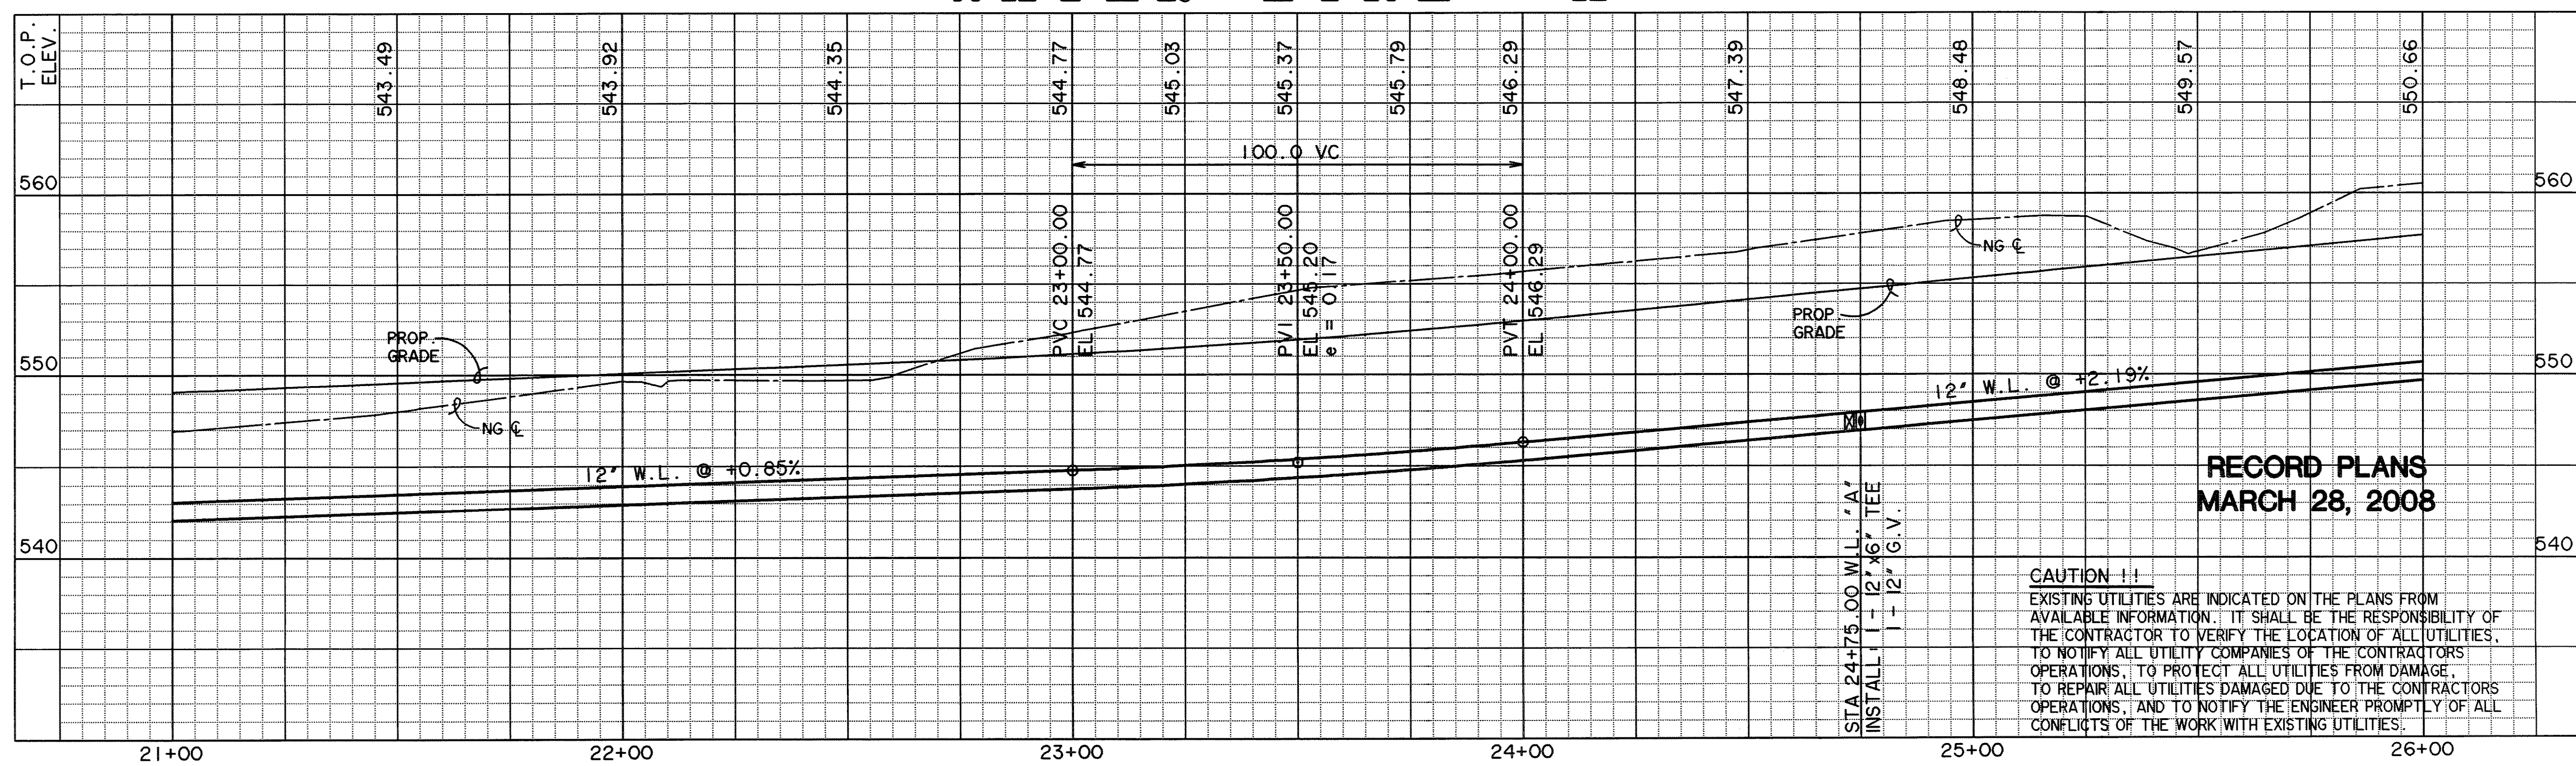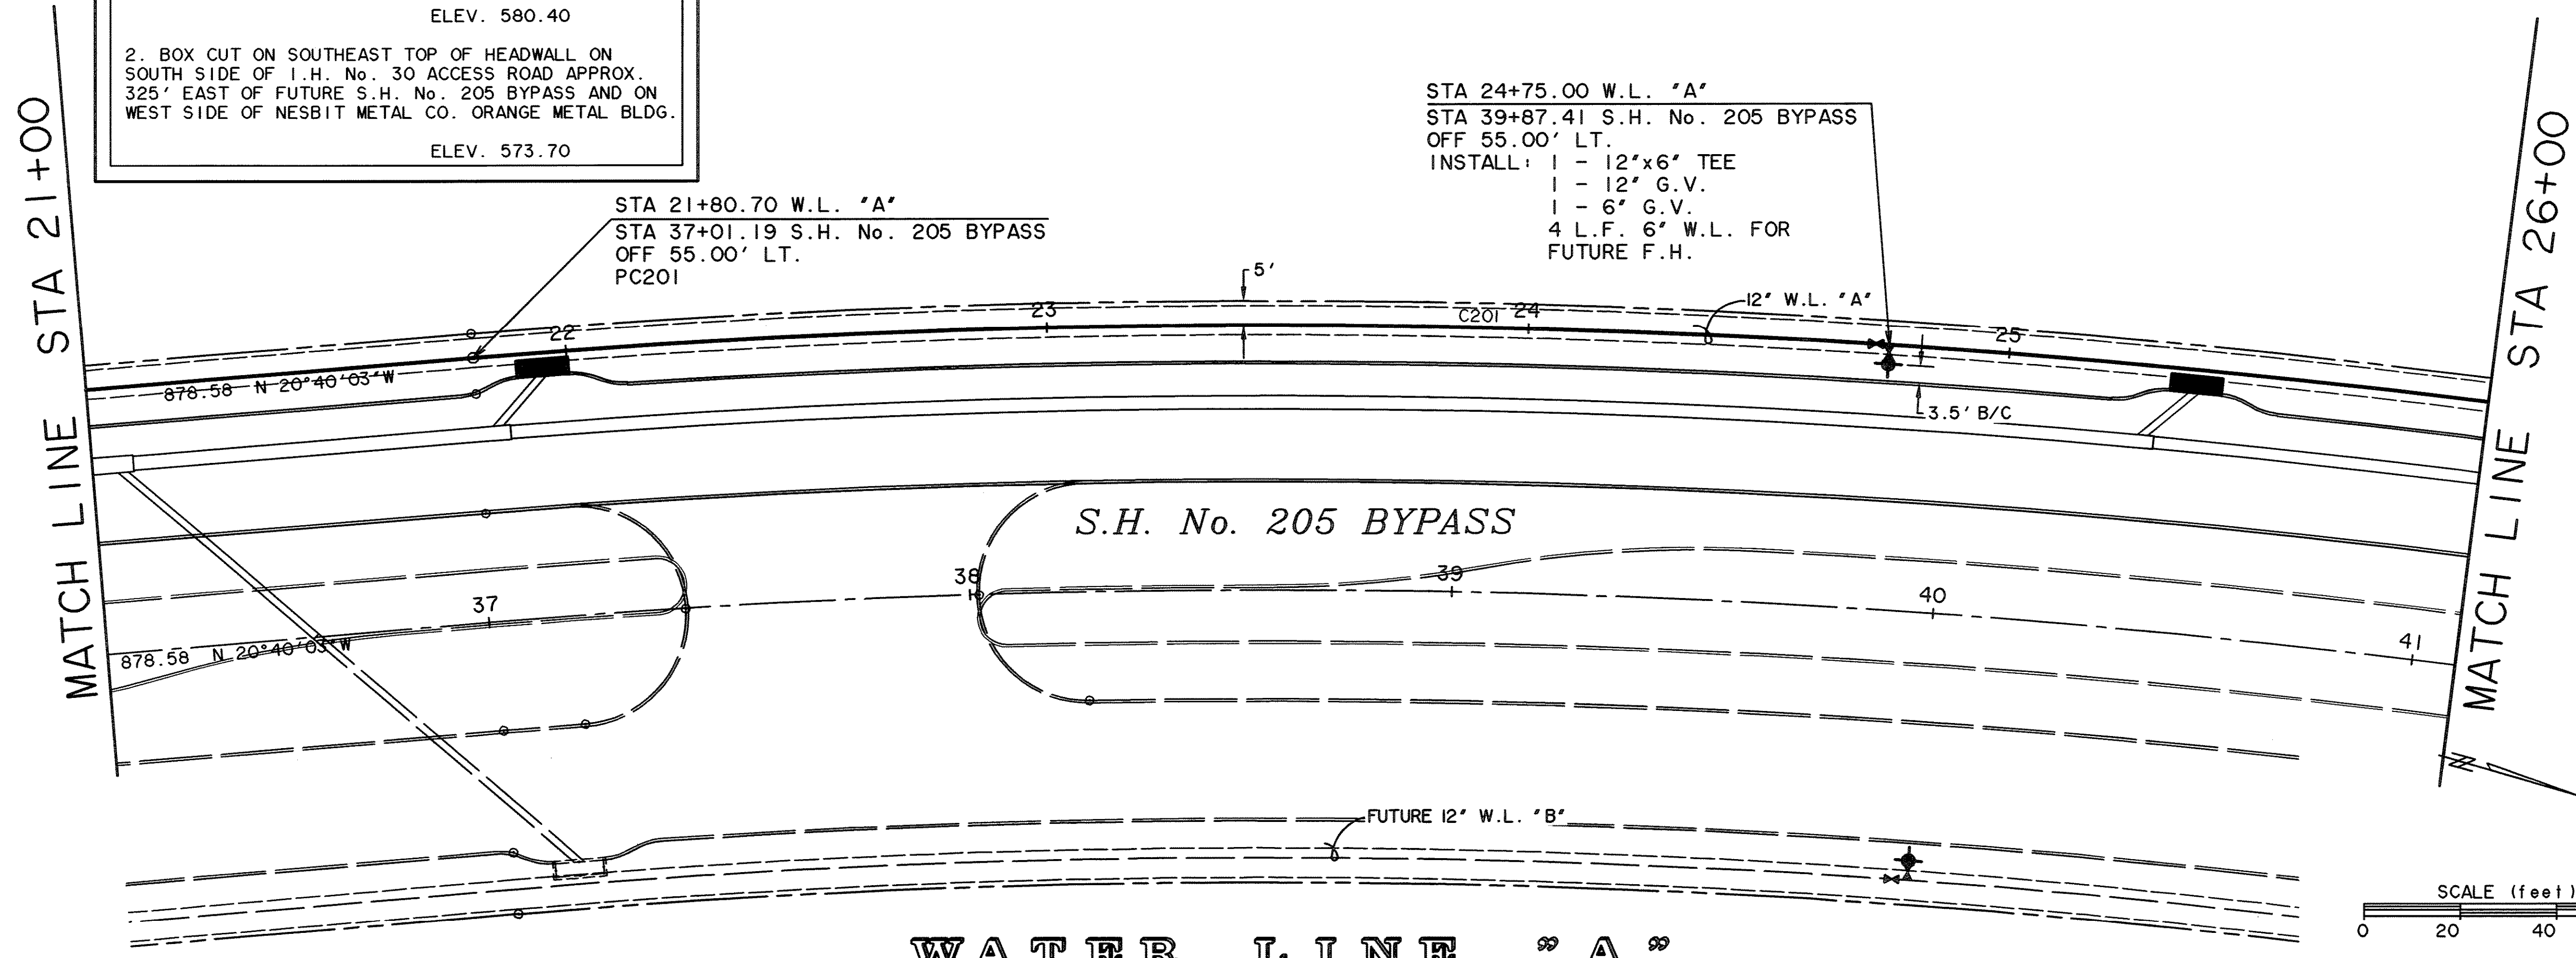

PREPARED BY:  
**WIA WIER & ASSOCIATES, INC.**  
ENGINEERS SURVEYORS LAND PLANNERS  
4300 BELTWAY PLACE SUITE 130 ARLINGTON, TEXAS 76018 METRO (817)467-7700  
1380 U.S. HIGHWAY 287 N. SUITE 101 WANSFELD, TEXAS 76063 METRO (817)477-8700  
6849 ELM STREET FRISCO, TEXAS 75034 METRO (214)387-8000  
www.wierassociates.com

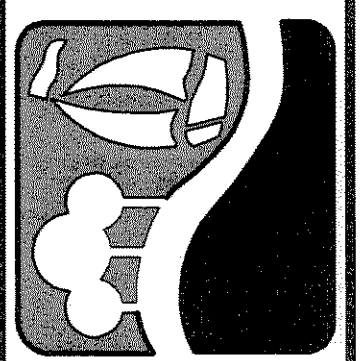

PHASE I S.H. 205 BYPASS  
FROM S.H. 276 TO INTERSTATE 30  
**WATER LINE "A"**  
PLAN & PROFILE  
STA 21+00 TO 26+00

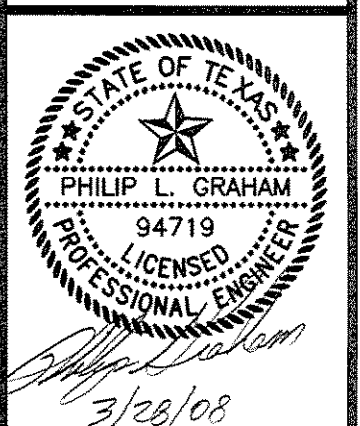

COPYRIGHT ©  
WIER & ASSOCIATES, INC.  
LAST SHEET EDIT  
DATE 09-15-2006  
WA# 04141  
**SHEET NO. 1105**

TIME: 9:39 FILE: 04141-WLPFS.dwg




CURVE TABLE						
NO.	RADIUS	DELTA	ARC TANGENT	CHORD	BEARING	
201	2005.00	20°19'45"	711.39	359.48	707.67 N 10°30'11"W	

PIPE. ALL CHANGES IN WATER LINE DIRECTION (BENDS) SHALL BE RESTRAINED (MEGA-LUG OR EQUAL) AND CONCRETE BLOCKED. THE NEXT JOINT EITHER SIDE OF THE CHANGE OF DIRECTION SHALL ALSO BE RESTRAINED.

THE CAMBRIDGE COMPANIES, INC.  
TRUSTEE  
VOL. 99, PG. 1022  
D.R.R.C.T.

***BENCHMARK***  
1. BOX CUT WITH 'X' CUT IN CENTER OF EXISTING SIDEWALK 2' SOUTH OF NORTH EDGE AT SOUTHEAST CORNER OF S.H. No. 205 BYPASS AND S.H. No. 276  
ELEV. 580.40  
2. BOX CUT ON SOUTHEAST TOP OF HEADWALL ON SOUTH SIDE OF I.H. No. 30 ACCESS ROAD APPROX. 325' EAST OF FUTURE S.H. No. 205 BYPASS AND ON WEST SIDE OF NESBIT METAL CO. ORANGE METAL BLDG.  
ELEV. 573.70


THE CAMBRIDGE COMPANIES, INC.  
TRUSTEE  
VOL. 101, PG. 795  
D.R.R.C.T.

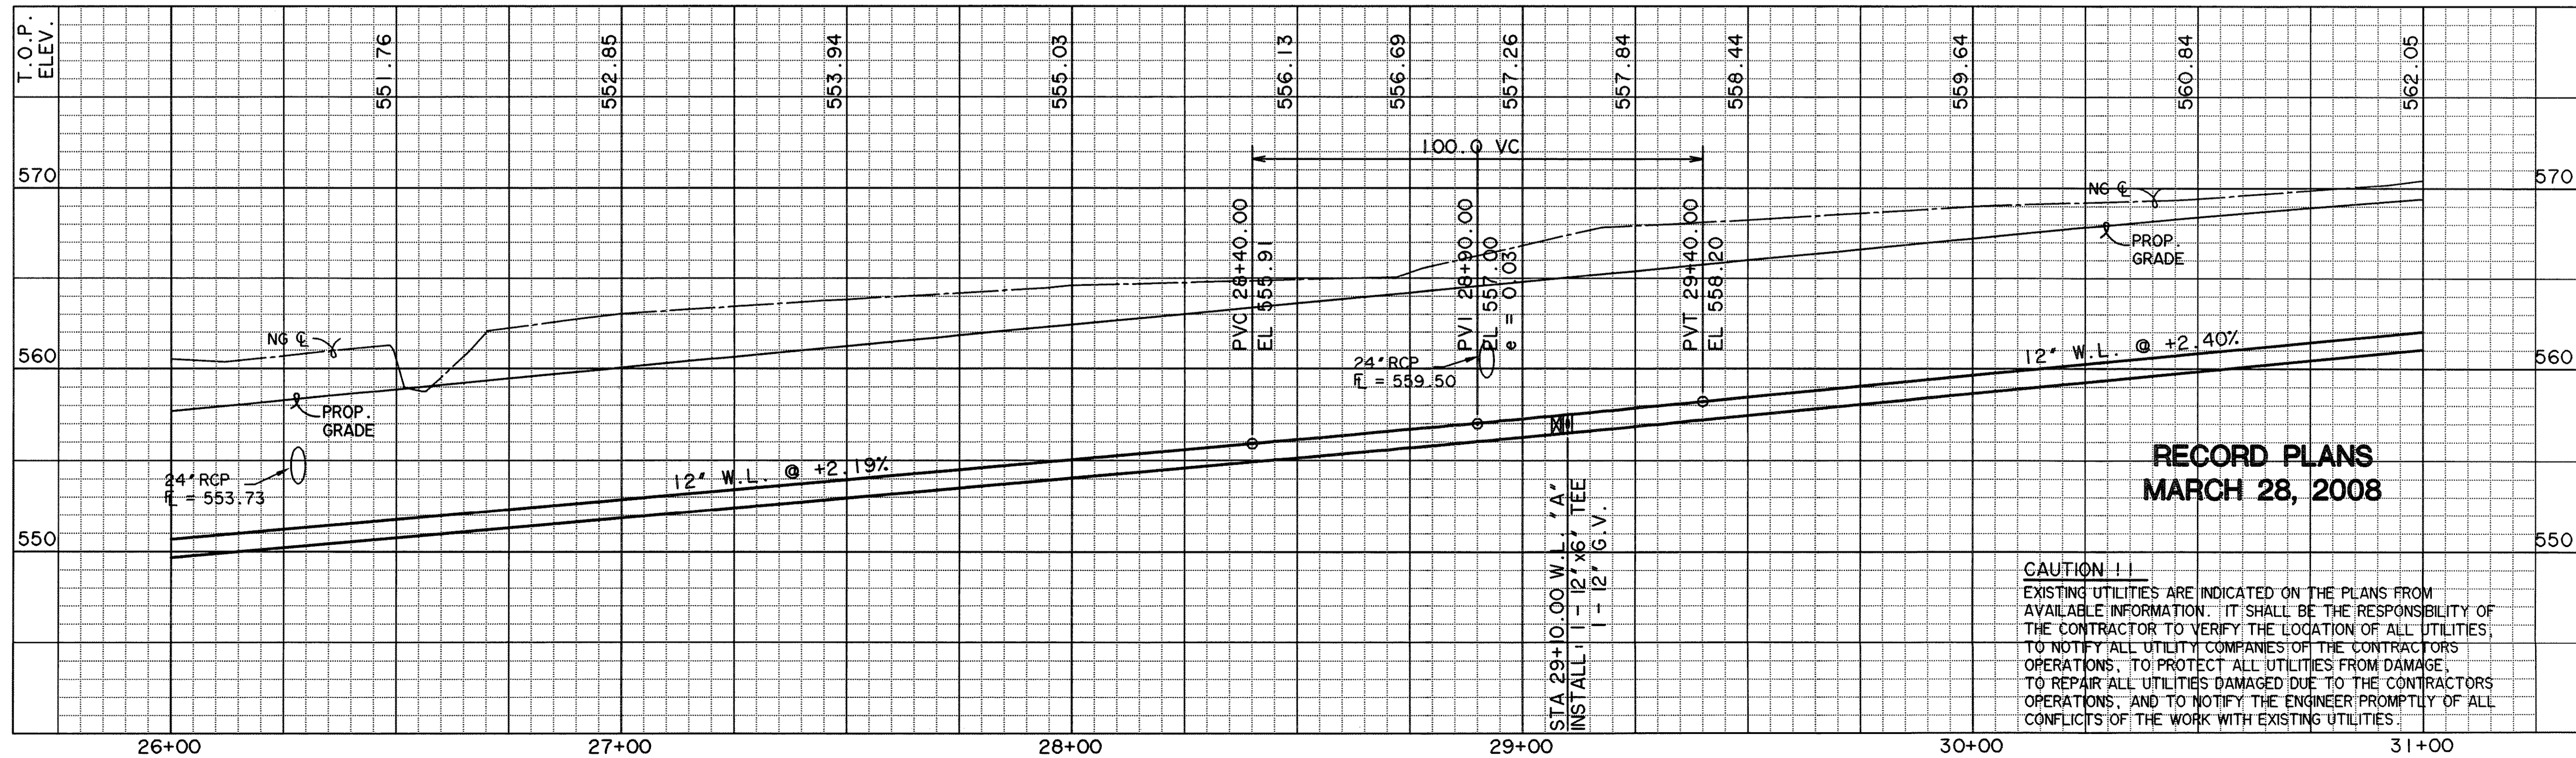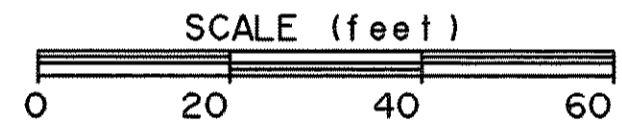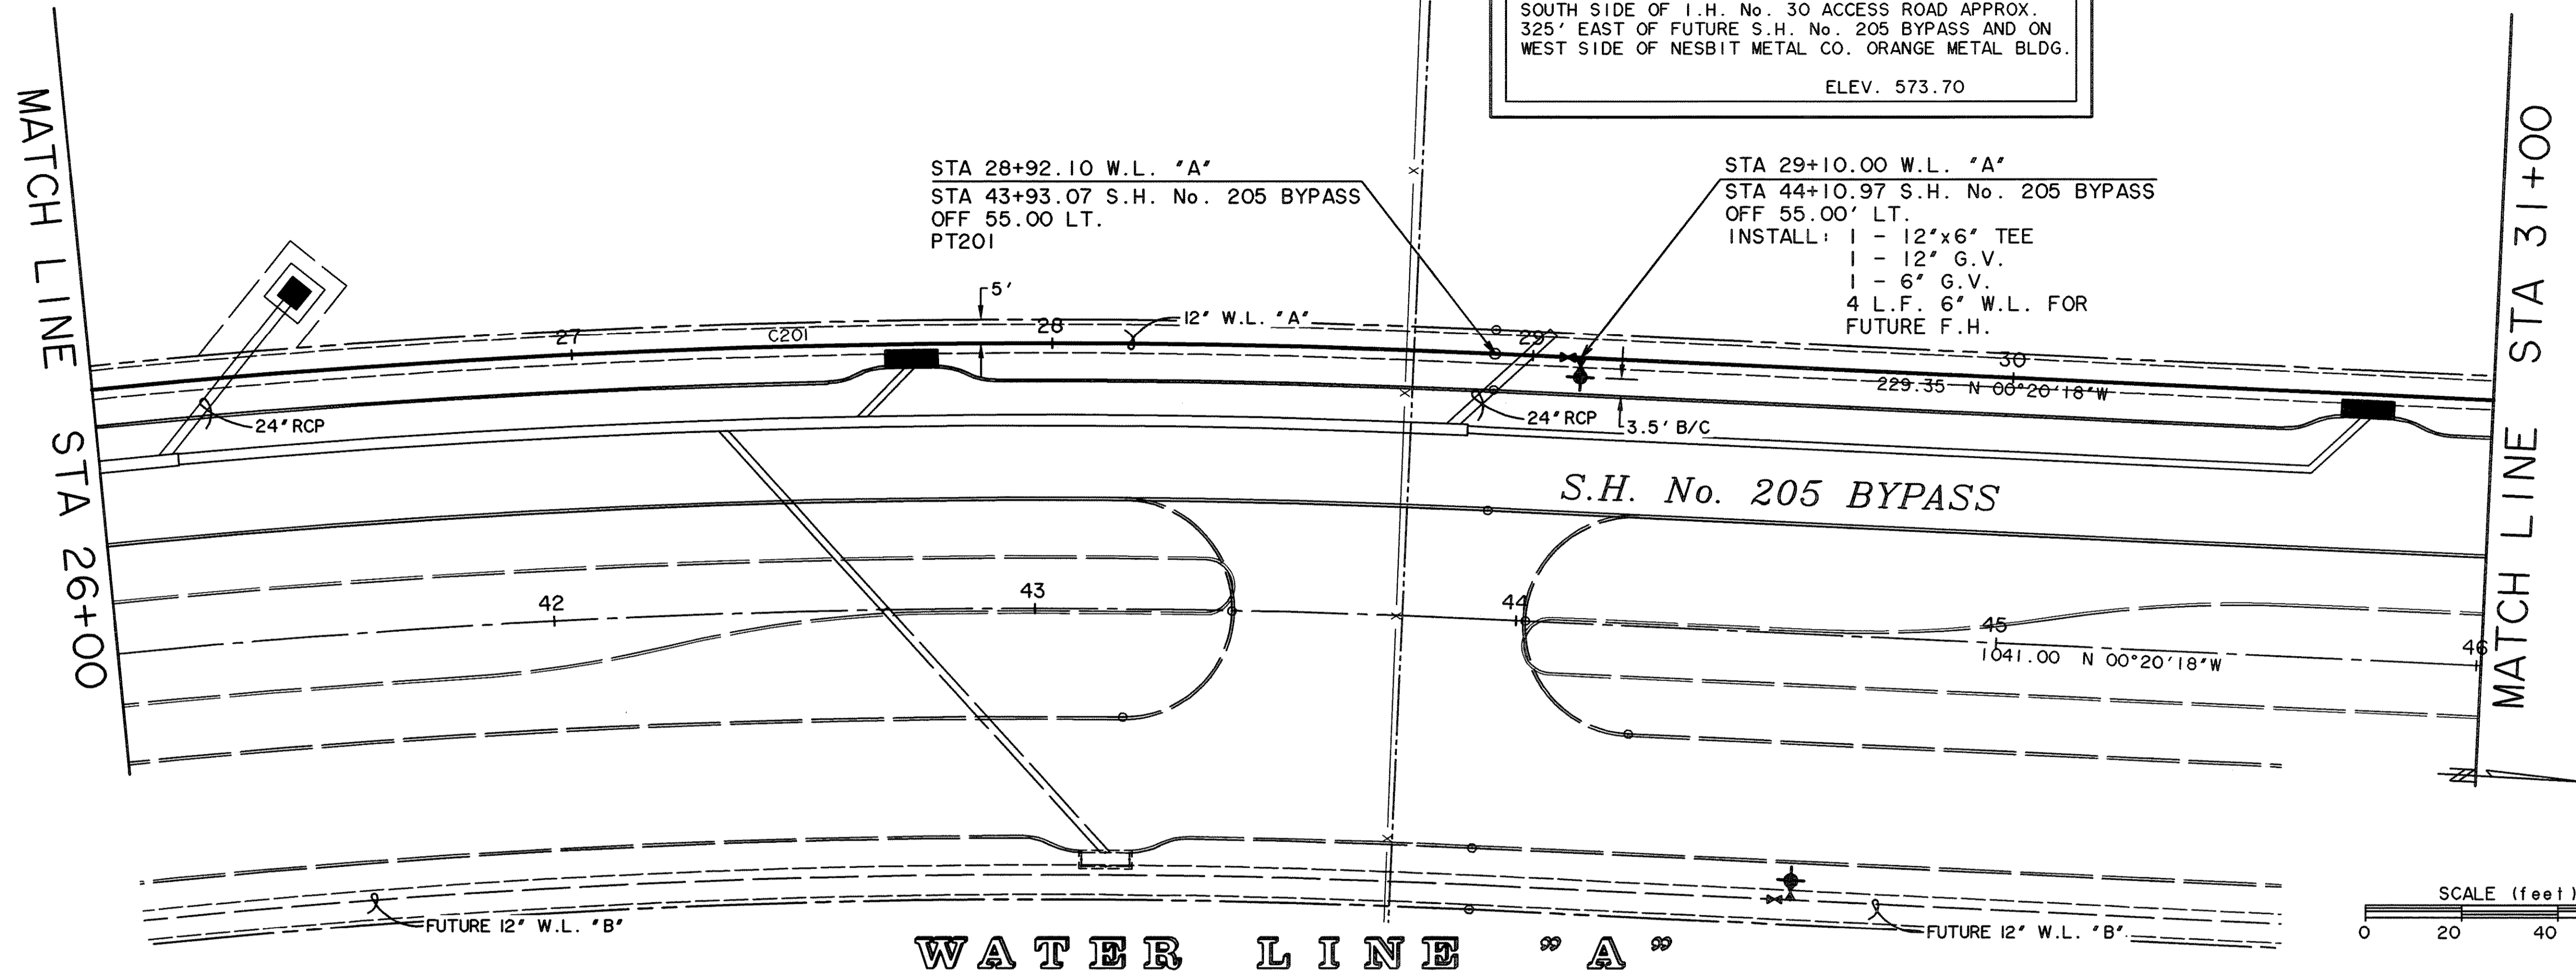


**RECORD PLANS  
MARCH 28, 2008**

**CAUTION !!**  
EXISTING UTILITIES ARE INDICATED ON THE PLANS FROM AVAILABLE INFORMATION. IT SHALL BE THE RESPONSIBILITY OF THE CONTRACTOR TO VERIFY THE LOCATION OF ALL UTILITIES, TO NOTIFY ALL UTILITY COMPANIES OF THE CONTRACTORS OPERATIONS, TO PROTECT ALL UTILITIES FROM DAMAGE, TO REPAIR ALL UTILITIES DAMAGED DUE TO THE CONTRACTORS OPERATIONS, AND TO NOTIFY THE ENGINEER PROMPTLY OF ALL CONFLICTS OF THE WORK WITH EXISTING UTILITIES.

PREPARED BY:  
**WIER & ASSOCIATES, INC.**  
ENGINEERS SURVEYORS LAND PLANNERS  
4300 BELTWAY PLACE SUITE 130 ARLINGTON, TEXAS 76018 METRO (817)467-7700  
1380 U.S. HIGHWAY 207 N. SUITE 101 HANFELD, TEXAS 76063 METRO (817)477-8700  
8849 ELM STREET FRISCO, TEXAS 75034 METRO (214)387-8000  
www.wierassociates.com

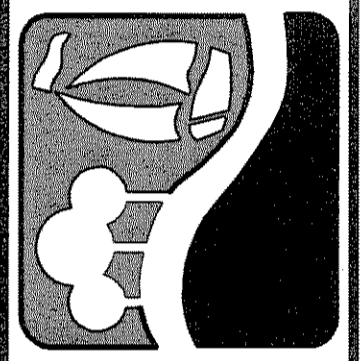

PHASE I S.H. 205 BYPASS  
FROM S.H. 276 TO INTERSTATE 30  
**WATER LINE "A"**  
**PLAN & PROFILE**  
STA 26+00 TO 31+00

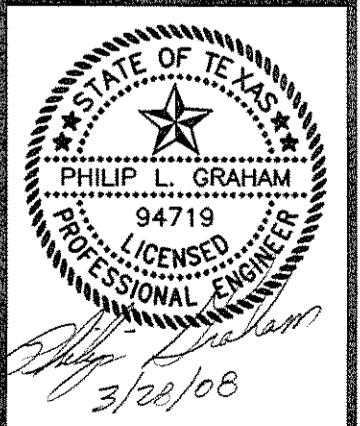

COPYRIGHT ©  
WIER & ASSOCIATES, INC.  
LAST SHEET EDIT  
DATE 11-30-2006  
WA# 04141  
**SHEET NO.  
106**

CURVE TABLE						
NO.	RADIUS	DELTA	ARC TANGENT	CHORD	BEARING	
202	911.50	04°27'06"	70.82	35.43	70.80	S 02°33'51"E
203	911.50	04°27'06"	70.82	35.43	70.80	N 02°33'51"W

NOTE: ALL PVC WATER LINES SHALL BE C-900 CLASS 200 PIPE. ALL CHANGES IN WATER LINE DIRECTION (BENDS) SHALL BE RESTRAINED (MEGA-LUG OR EQUAL) AND CONCRETE BLOCKED. THE NEXT JOINT EITHER SIDE OF THE CHANGE OF DIRECTION SHALL ALSO BE RESTRAINED.

NO.	DATE	DESCRIPTION	BY
	11/02/07	REVISE W.L. ALIGNMENT & PROFILE	PLG

MATCH LINE STA 31+00

STA 31+92.27 W.L. "A"  
STA 46+93.18 S.H. No. 205 BYPASS  
OFF 57.75' LT.  
PRC

THE CAMBRIDGE  
COMPANIES, INC.  
TRUSTEE  
VOL. 101, PG. 795  
D.R.R.C.T.

STA 32+63.10 W.L. "A"  
STA 47+63.93 S.H. No. 205 BYPASS  
OFF 60.50' LT.  
PT203

STA 31+21.45 W.L. "A"  
STA 46+22.42 S.H. No. 205 BYPASS  
OFF 55.00' LT.  
PC202

STA 33+10.00 W.L. "A"  
STA 48+10.83 S.H. No. 205 BYPASS  
OFF 60.50' LT.  
INSTALL: 1 - 12"x6" TEE  
1 - 6" G.V.  
6 L.F. 6" W.L. FOR  
FUTURE F.H.

STA 34+98.91 W.L. "A"  
STA 48+68.98 S.H. No. 205 BYPASS  
OFF 122.85' LT.  
INSTALL: 1 - 12" 22-1/2° BEND

STA 33+20.36 W.L. "A"  
STA 48+84.56 S.H. No. 205 BYPASS  
OFF 60.50' LT.  
INSTALL: 1 - 12" 45° BEND  
1 - 12" 22-1/2° BEND



STA 34+04.24± W.L. "A"  
STA 48+73.85 S.H. No. 205 BYPASS  
OFF 125.02± LT.  
MAKE DRY CONNECTION TO EXIST. 12" W.L.

STA 34+03.72 W.L. "A"  
STA 49+02.83 S.H. No. 205 BYPASS  
OFF 68.62' LT.  
INSTALL: 1 - 16"x12" TAPPING  
SLEEVE & VALVE  
1-12"x2" TAPPED PLUG  
2" SERVICE LINE &  
METER BOX FOR BLOW-OFF

FUTURE 12" W.L. "B"

S.H. No. 205 BYPASS

WATER LINE "A"

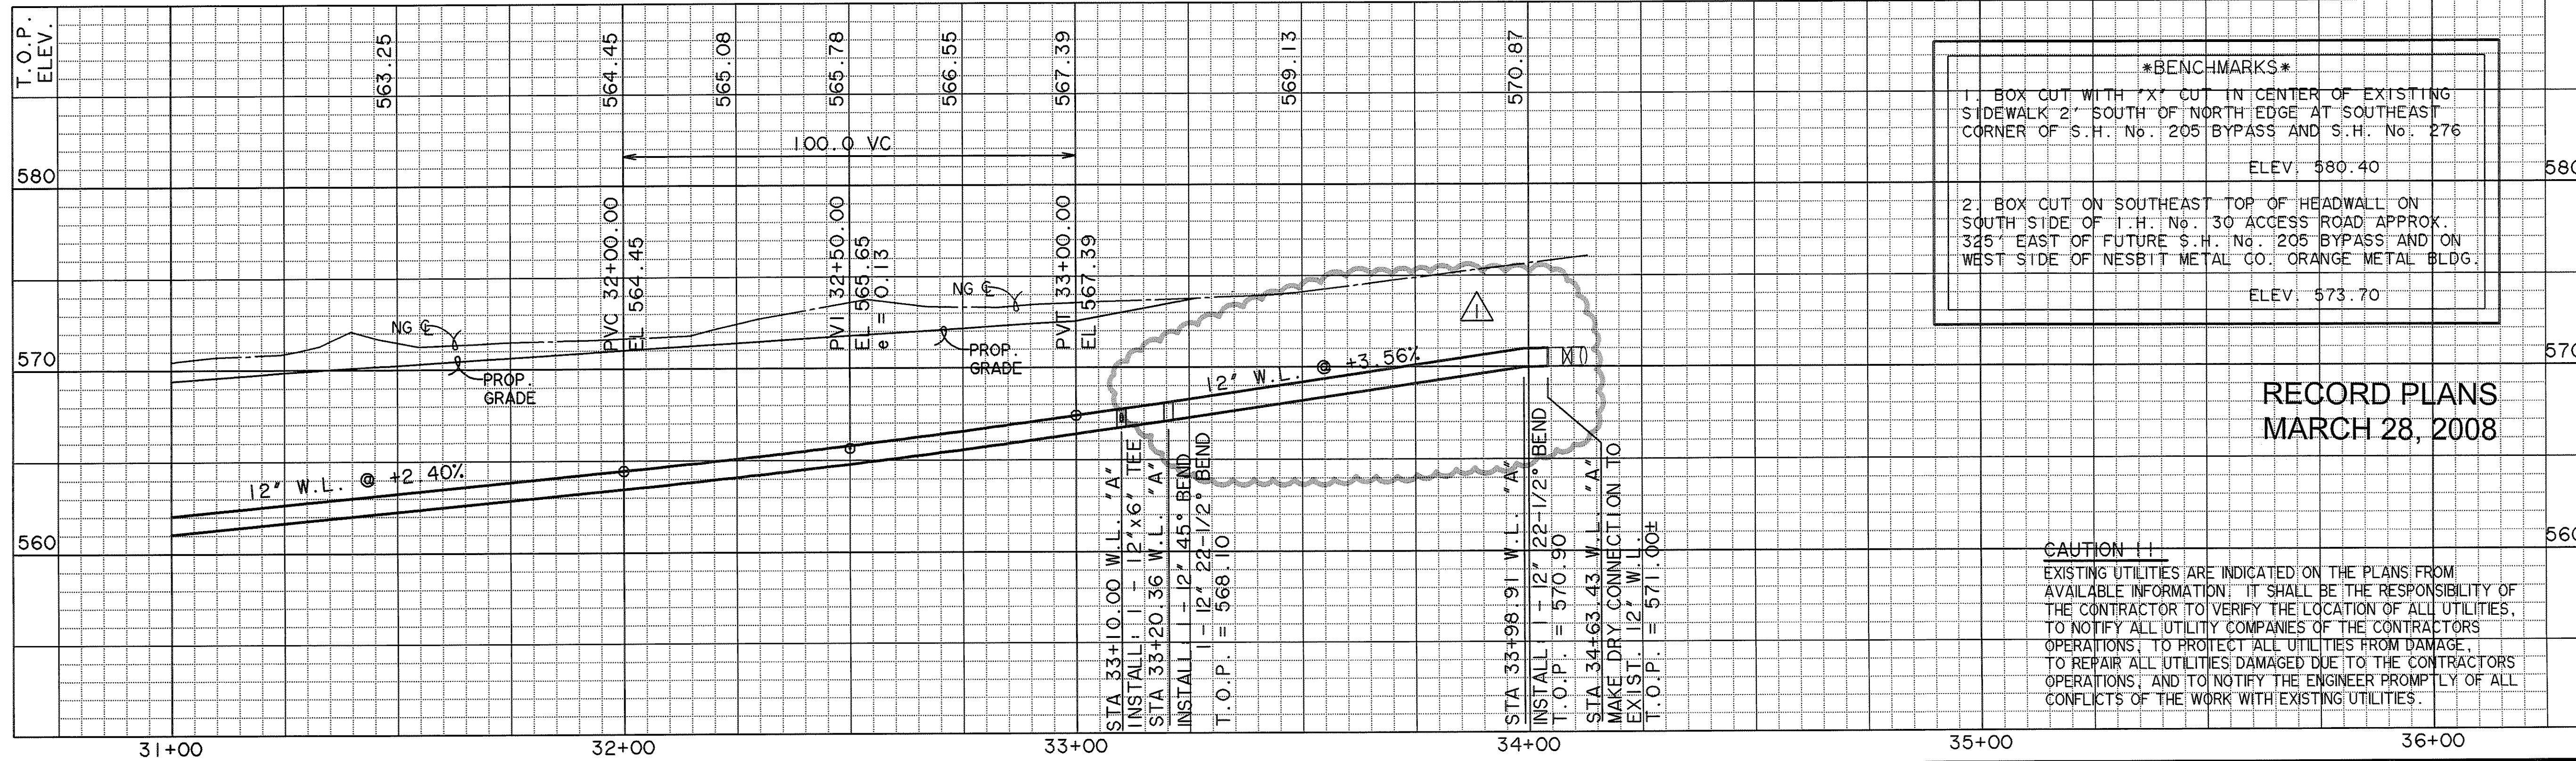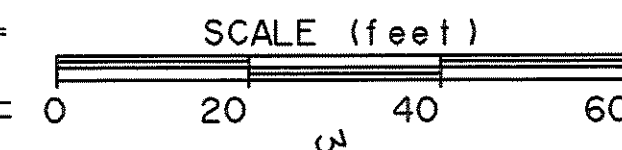


- *BENCHMARKS***
- BOX CUT WITH "X" CUT IN CENTER OF EXISTING SIDEWALK 2' SOUTH OF NORTH EDGE AT SOUTHEAST CORNER OF S.H. No. 205 BYPASS AND S.H. No. 276  
ELEV. 580.40
  - BOX CUT ON SOUTHEAST TOP OF HEADWALL ON SOUTH SIDE OF I.H. No. 30 ACCESS ROAD, APPROX. 325' EAST OF FUTURE S.H. No. 205 BYPASS AND ON WEST SIDE OF NESBIT METAL CO. ORANGE METAL BLDG.  
ELEV. 573.70


RECORD PLANS  
MARCH 28, 2008

**CAUTION !!**  
EXISTING UTILITIES ARE INDICATED ON THE PLANS FROM AVAILABLE INFORMATION. IT SHALL BE THE RESPONSIBILITY OF THE CONTRACTOR TO VERIFY THE LOCATION OF ALL UTILITIES, TO NOTIFY ALL UTILITY COMPANIES OF THE CONTRACTORS OPERATIONS, TO PROTECT ALL UTILITIES FROM DAMAGE, TO REPAIR ALL UTILITIES DAMAGED DUE TO THE CONTRACTORS OPERATIONS, AND TO NOTIFY THE ENGINEER PROMPTLY OF ALL CONFLICTS OF THE WORK WITH EXISTING UTILITIES.

PREPARED BY:  
**VIA WIER & ASSOCIATES, INC.**  
ENGINEERS SURVEYORS LAND PLANNERS  
4300 BELTWAY PLACE, SUITE 130, ARLINGTON, TEXAS 76018 METRO (817)457-7700  
1380 U.S. HIGHWAY 287 N., SUITE 101, WANSFIELD, TEXAS 76083 METRO (817)477-5700  
6849 ELM STREET FRISCO, TEXAS 75034 METRO (214)387-8000  
www.viawier.com

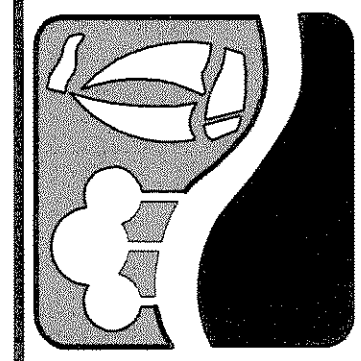


PHASE I S.H. 205 BYPASS  
FROM S.H. 276 TO INTERSTATE 30  
WATER LINE "A"  
PLAN & PROFILE  
STA 31+00 TO END

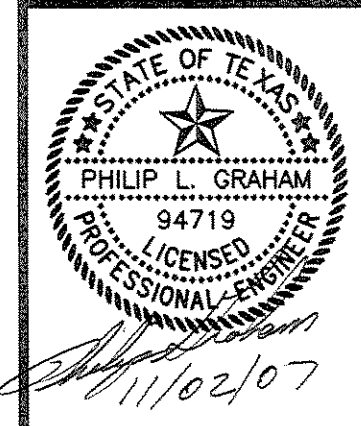

COPYRIGHT ©  
WIER & ASSOCIATES, INC.  
LAST SHEET EDIT  
DATE 11-02-2007  
WA# 04141  
SHEET NO.  
U107




NO.	RADIUS	DELTA	ARC TANGENT	CHORD	BEARING
204	2555.00	19°35'45"	873.84	441.23	869.59 S 10°52'11"E

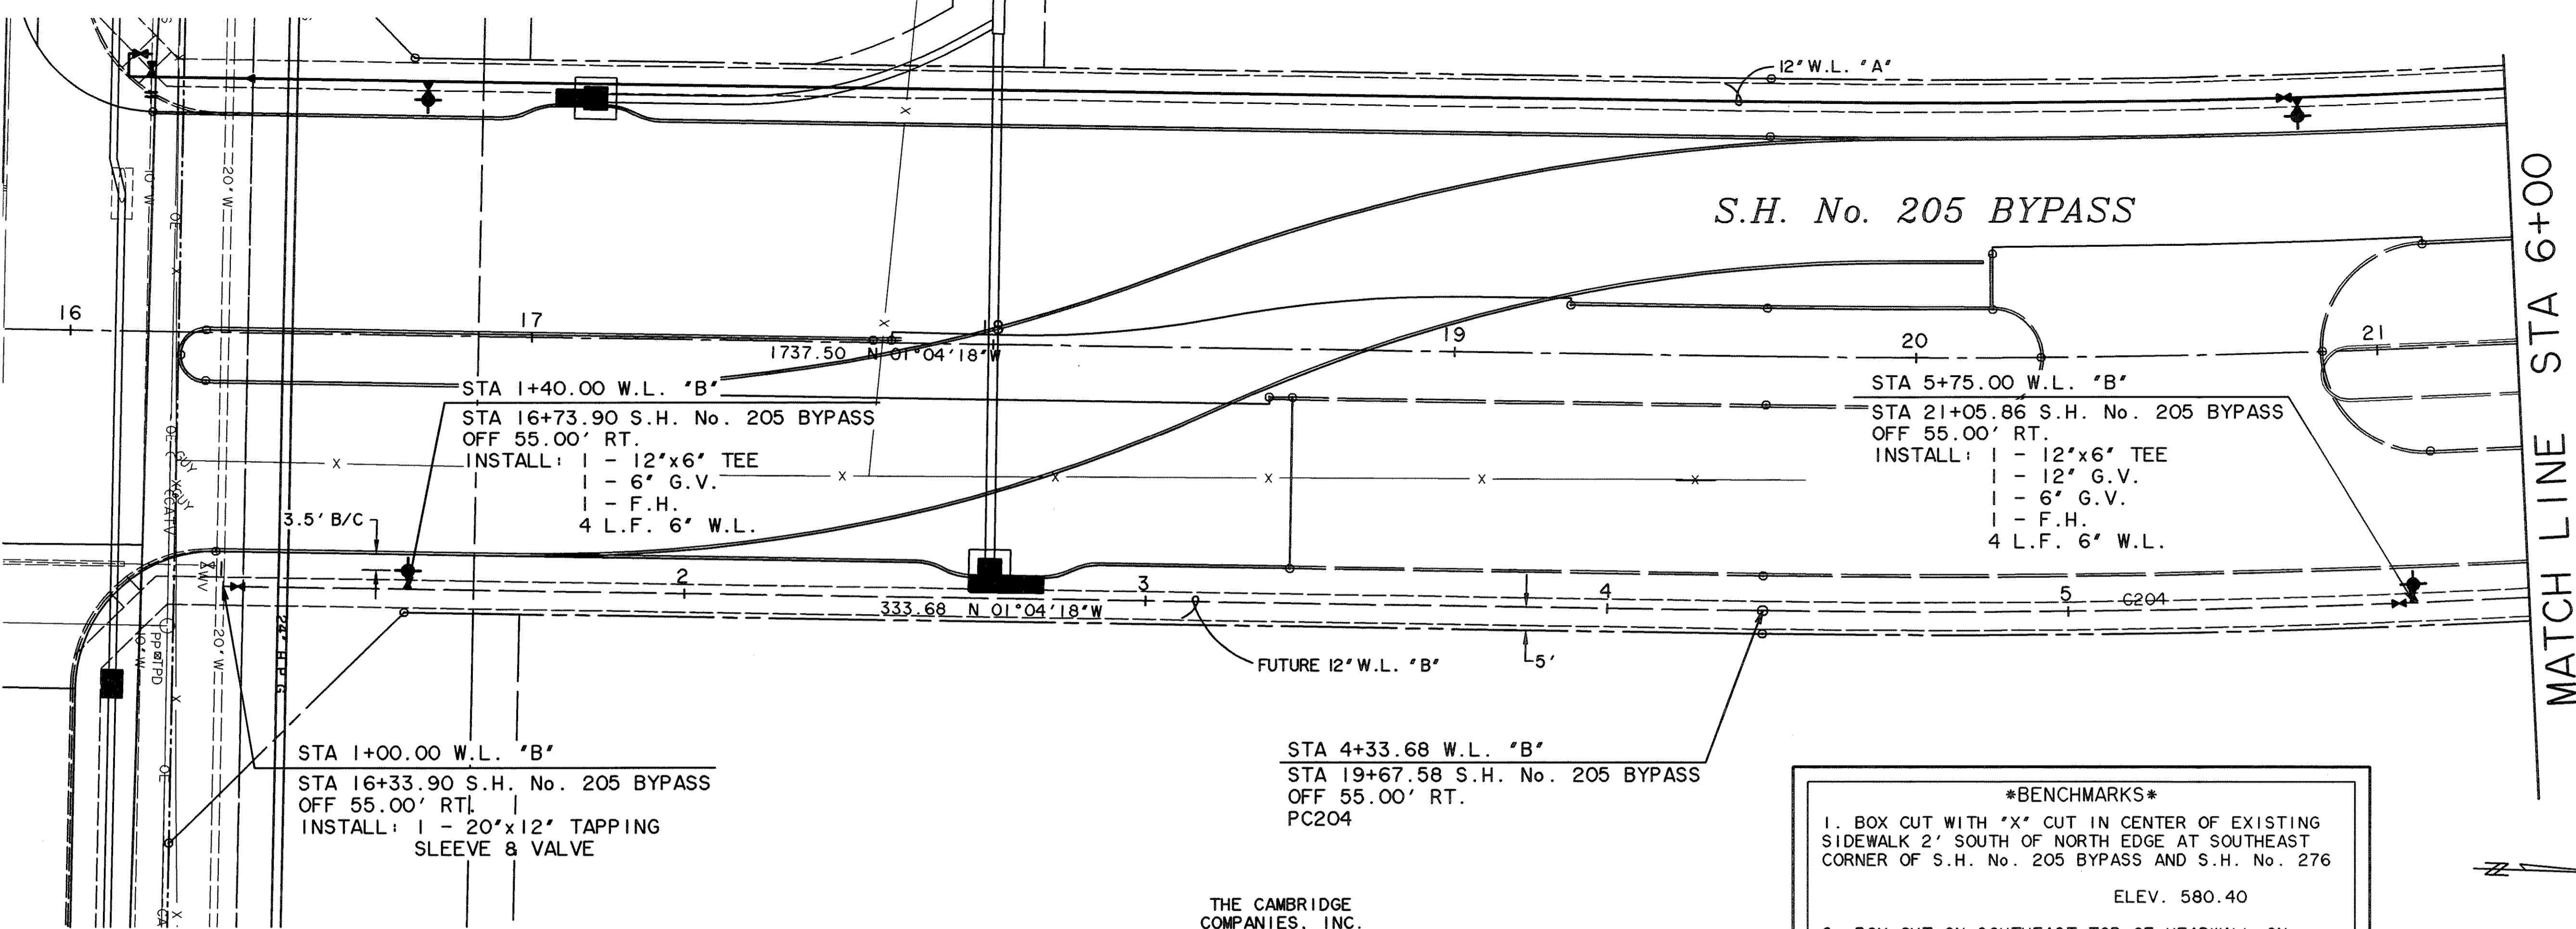


NOTE: ALL PVC WATER LINES SHALL BE C-900 CLASS 200 PIPE. ALL CHANGES IN WATER LINE DIRECTION (BENDS) SHALL BE RESTRAINED (MEGA-LUG OR EQUAL) AND CONCRETE BLOCKED. THE NEXT JOINT EITHER SIDE OF THE CHANGE OF DIRECTION SHALL ALSO BE RESTRAINED.

THE CAMBRIDGE COMPANIES, INC. TRUSTEE  
VOL. 99, PG. 1022  
D.R.R.C.T.

***BENCHMARKS***  
1. BOX CUT WITH 'X' CUT IN CENTER OF EXISTING SIDEWALK 2' SOUTH OF NORTH EDGE AT SOUTHEAST CORNER OF S.H. No. 205 BYPASS AND S.H. No. 276  
ELEV. 580.40  
2. BOX CUT ON SOUTHEAST TOP OF HEADWALL ON SOUTH SIDE OF I.H. No. 30 ACCESS ROAD APPROX. 325' EAST OF FUTURE S.H. No. 205 BYPASS AND ON WEST SIDE OF NESBIT METAL CO. ORANGE METAL BLDG.  
ELEV. 573.70

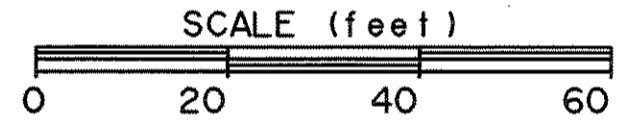


## WATER LINE "B"

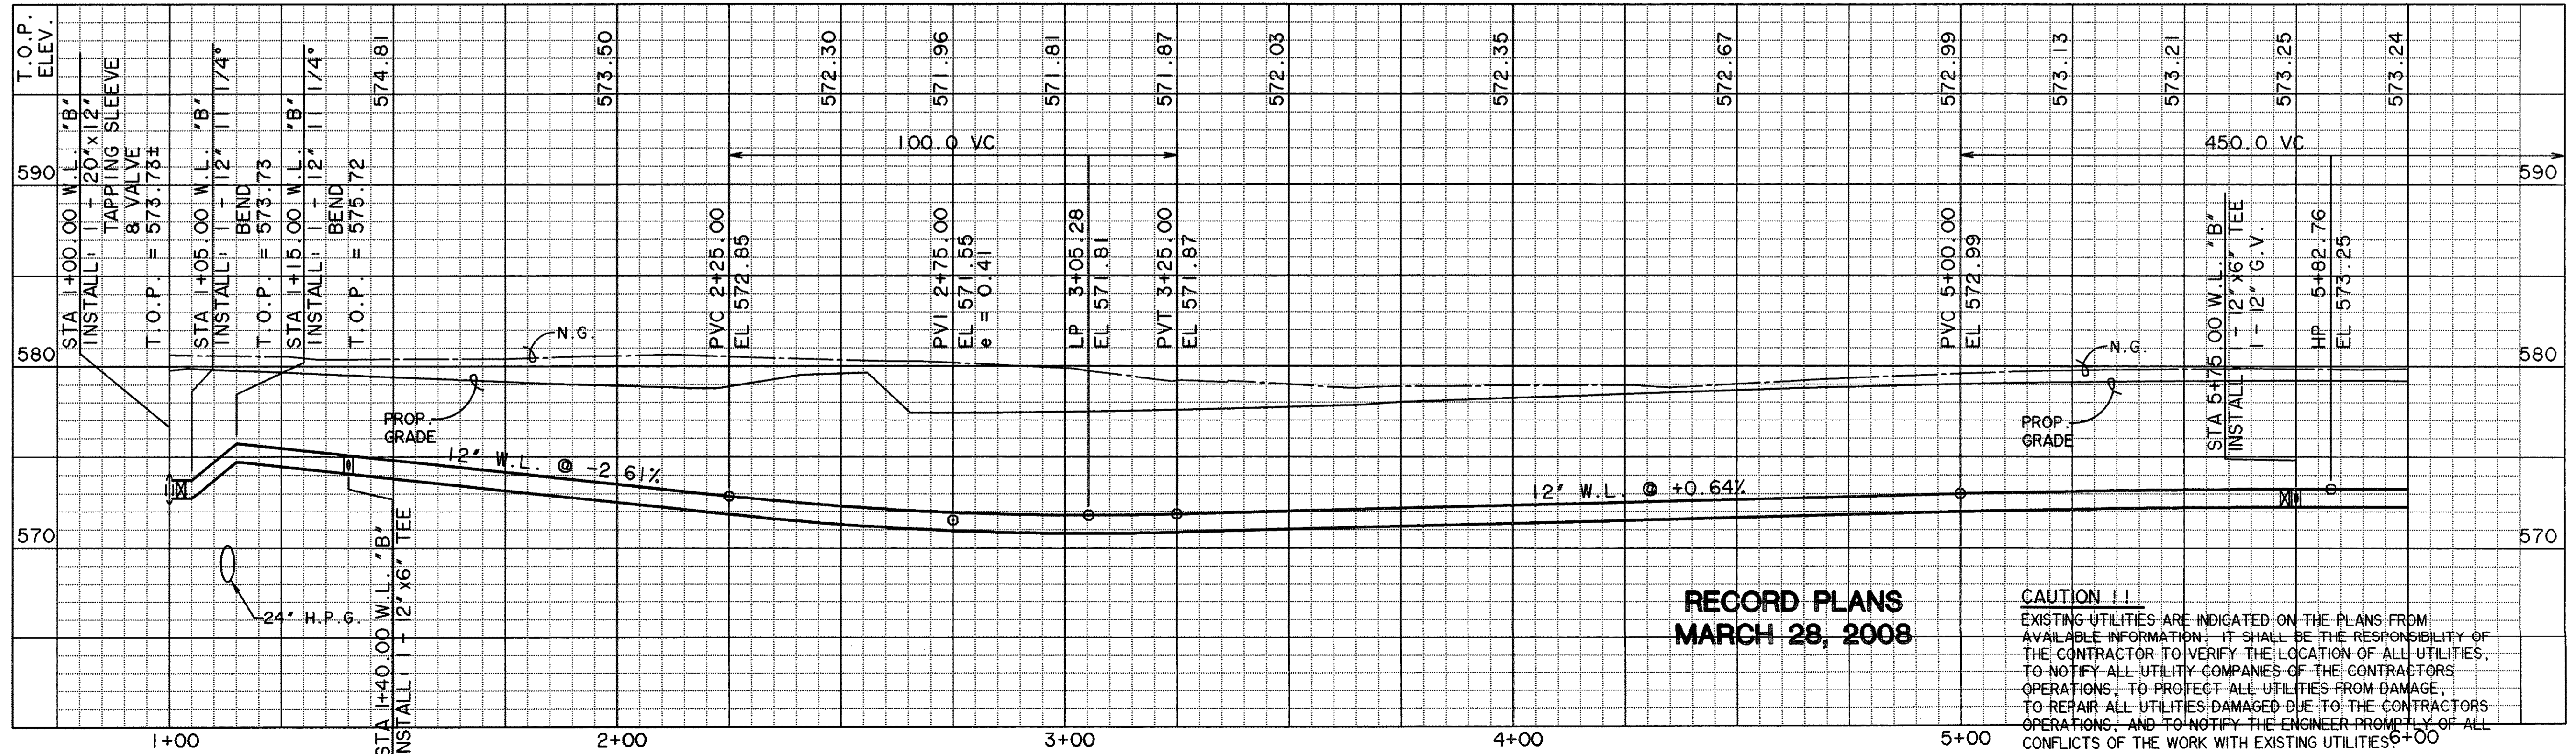


**RECORD PLANS  
MARCH 28, 2008**

**CAUTION !!**  
EXISTING UTILITIES ARE INDICATED ON THE PLANS FROM AVAILABLE INFORMATION. IT SHALL BE THE RESPONSIBILITY OF THE CONTRACTOR TO VERIFY THE LOCATION OF ALL UTILITIES, TO NOTIFY ALL UTILITY COMPANIES OF THE CONTRACTORS OPERATIONS, TO PROTECT ALL UTILITIES FROM DAMAGE, TO REPAIR ALL UTILITIES DAMAGED DUE TO THE CONTRACTORS OPERATIONS, AND TO NOTIFY THE ENGINEER PROMPTLY OF ALL CONFLICTS OF THE WORK WITH EXISTING UTILITIES.

PREPARED BY:  
**VIA WIER & ASSOCIATES, INC.**  
ENGINEERS SURVEYORS LAND PLANNERS  
4300 BELTWAY PLACE SUITE 130 ARLINGTON, TEXAS 76010 METRO (817)467-7700  
1390 U.S. HIGHWAY 287 N. SUITE 101 MANSFIELD, TEXAS 76063 METRO (817)477-6700  
6849 ELM STREET FRISCO, TEXAS 75034 METRO (214)387-8000  
www.viaassociates.com

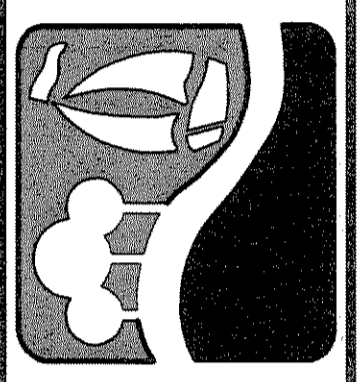


PHASE I S.H. 205 BYPASS  
FROM S.H. 276 TO INTERSTATE 30  
FUTURE WATER LINE "B"  
PLAN & PROFILE  
STA 1+00 TO 6+00

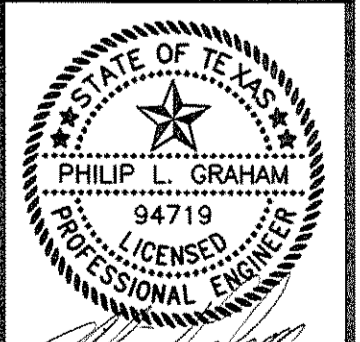

COPYRIGHT ©  
WIER & ASSOCIATES, INC.  
LAST SHEET EDIT  
DATE 11-30-2006  
WA# 04141  
**SHEET NO.  
108**

CURVE TABLE					
NO.	RADIUS	DELTA	ARC TANGENT	CHORD	BEARING
204	2555.00	19°35'45"	873.84	441.23	869.59 S 10°52'11"E

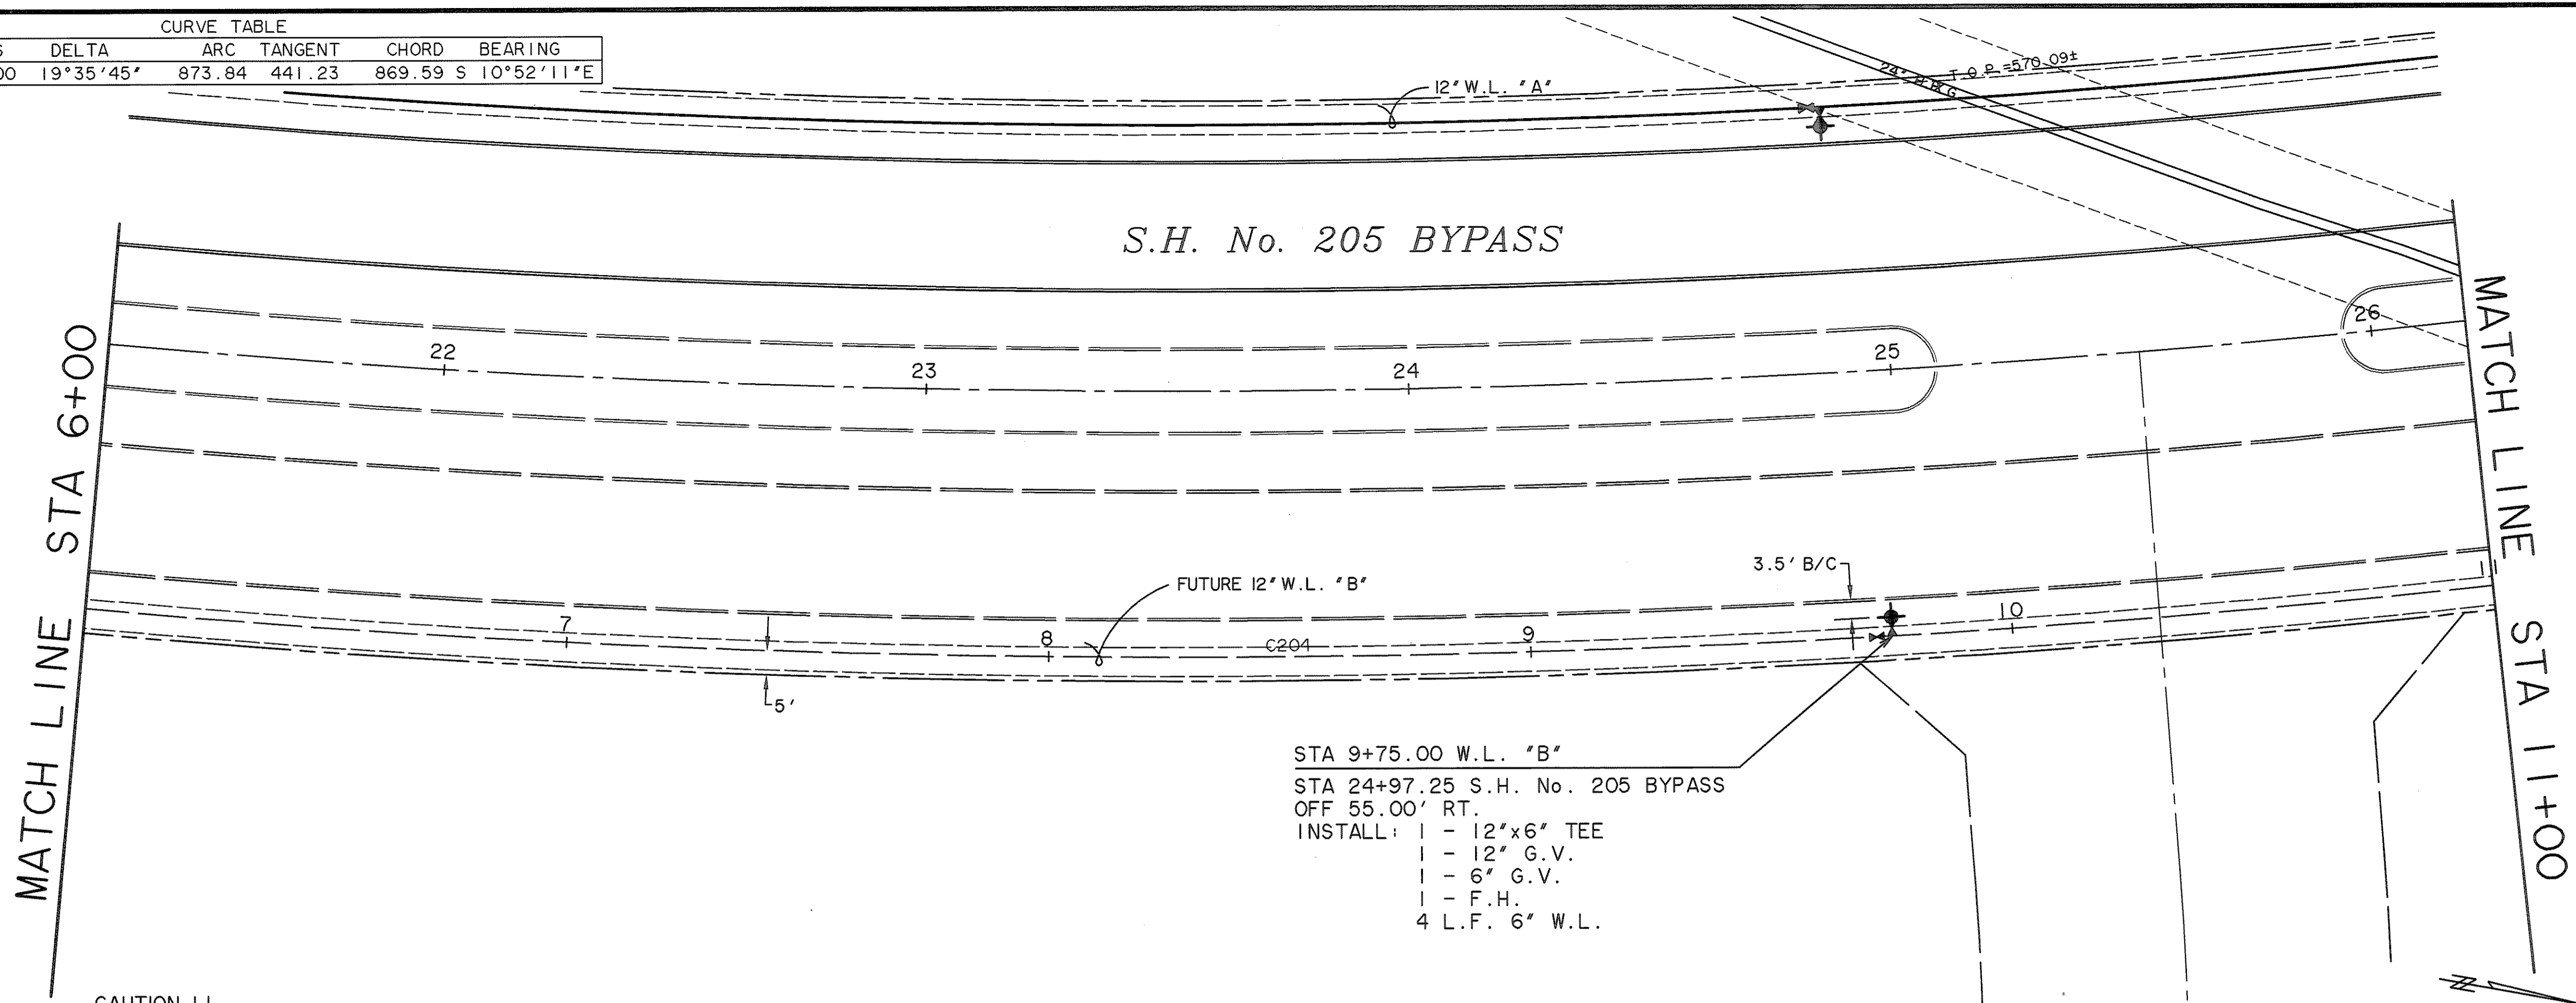


STA 9+75.00 W.L. "B"  
 STA 24+97.25 S.H. No. 205 BYPASS  
 OFF 55.00' RT.  
 INSTALL: 1 - 12"x6" TEE  
 1 - 12" G.V.  
 1 - 6" G.V.  
 1 - F.H.  
 4 L.F. 6" W.L.


**CAUTION !!**  
 EXISTING UTILITIES ARE INDICATED ON THE PLANS FROM AVAILABLE INFORMATION. IT SHALL BE THE RESPONSIBILITY OF THE CONTRACTOR TO VERIFY THE LOCATION OF ALL UTILITIES, TO NOTIFY ALL UTILITY COMPANIES OF THE CONTRACTORS OPERATIONS, TO PROTECT ALL UTILITIES FROM DAMAGE, TO REPAIR ALL UTILITIES DAMAGED DUE TO THE CONTRACTORS OPERATIONS, AND TO NOTIFY THE ENGINEER PROMPTLY OF ALL CONFLICTS OF THE WORK WITH EXISTING UTILITIES.

THE CAMBRIDGE  
 COMPANIES, INC.  
 TRUSTEE  
 VOL. 99, PG. 1022  
 D.R.R.C.T.

NOTE: ALL PVC WATER LINES SHALL BE C-900 CLASS 200 PIPE. ALL CHANGES IN WATER LINE DIRECTION (BENDS) SHALL BE RESTRAINED (MEGA-LUG OR EQUAL) AND CONCRETE BLOCKED. THE NEXT JOINT EITHER SIDE OF THE CHANGE OF DIRECTION SHALL ALSO BE RESTRAINED.

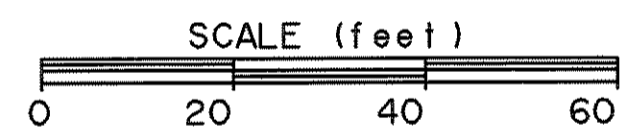

## WATER LINE "B"

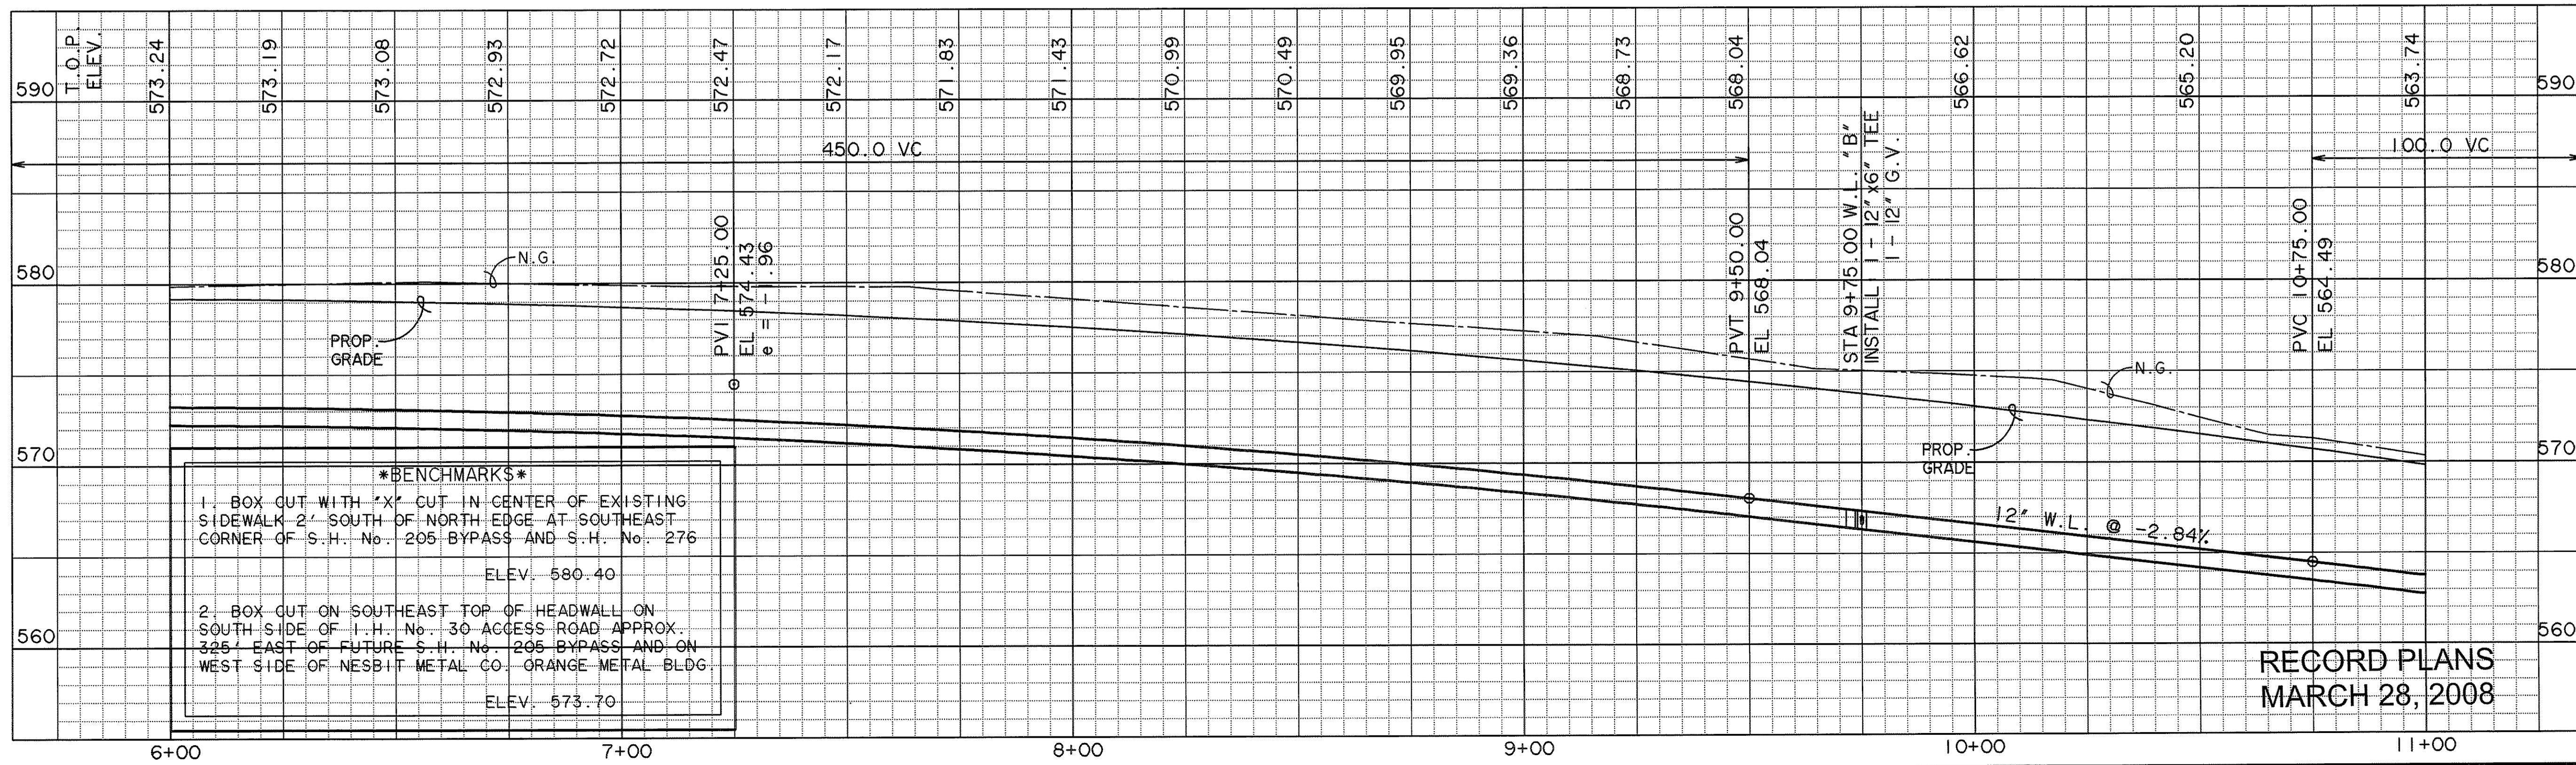


***BENCHMARKS***  
 1. BOX CUT WITH "X" CUT IN CENTER OF EXISTING SIDEWALK 2' SOUTH OF NORTH EDGE AT SOUTHEAST CORNER OF S.H. No. 205 BYPASS AND S.H. No. 276  
 ELEV. 580.40  
 2. BOX CUT ON SOUTHEAST TOP OF HEADWALL ON SOUTH SIDE OF I.H. No. 30 ACCESS ROAD APPROX. 325' EAST OF FUTURE S.H. No. 205 BYPASS AND ON WEST SIDE OF NESBIT METAL CO. ORANGE METAL BLDG.  
 ELEV. 573.70

RECORD PLANS  
 MARCH 28, 2008

PREPARED BY:  
**WIA WIER & ASSOCIATES, INC.**  
 ENGINEERS SURVEYORS LAND PLANNERS  
 4300 BELTWAY PLACE SUITE 130 ARLINGTON, TEXAS 76018 METRO (817)467-7700  
 1380 U.S. HIGHWAY 287 N. SUITE 101 WANSFELD, TEXAS 76063 METRO (817)477-8700  
 6849 ELM STREET FRISCO, TEXAS 75034 METRO (214)387-8000  
 www.wierassociates.com




PHASE I S.H. 205 BYPASS  
 FROM S.H. 276 TO INTERSTATE 30  
 FUTURE WATER LINE "B"  
 PLAN & PROFILE  
 STA 6+00 TO 11+00

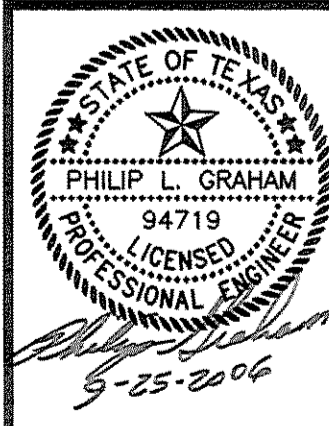

COPYRIGHT ©  
 WIER & ASSOCIATES, INC.  
 LAST SHEET EDIT  
 DATE 03-15-2008  
 WA# 04141  
 SHEET NO.  
 U109

CURVE TABLE						
NO.	RADIUS	DELTA	ARC TANGENT	CHORD	BEARING	
204	2555.00	19°35'45"	873.84	441.23	869.59	S 10°52'11"E

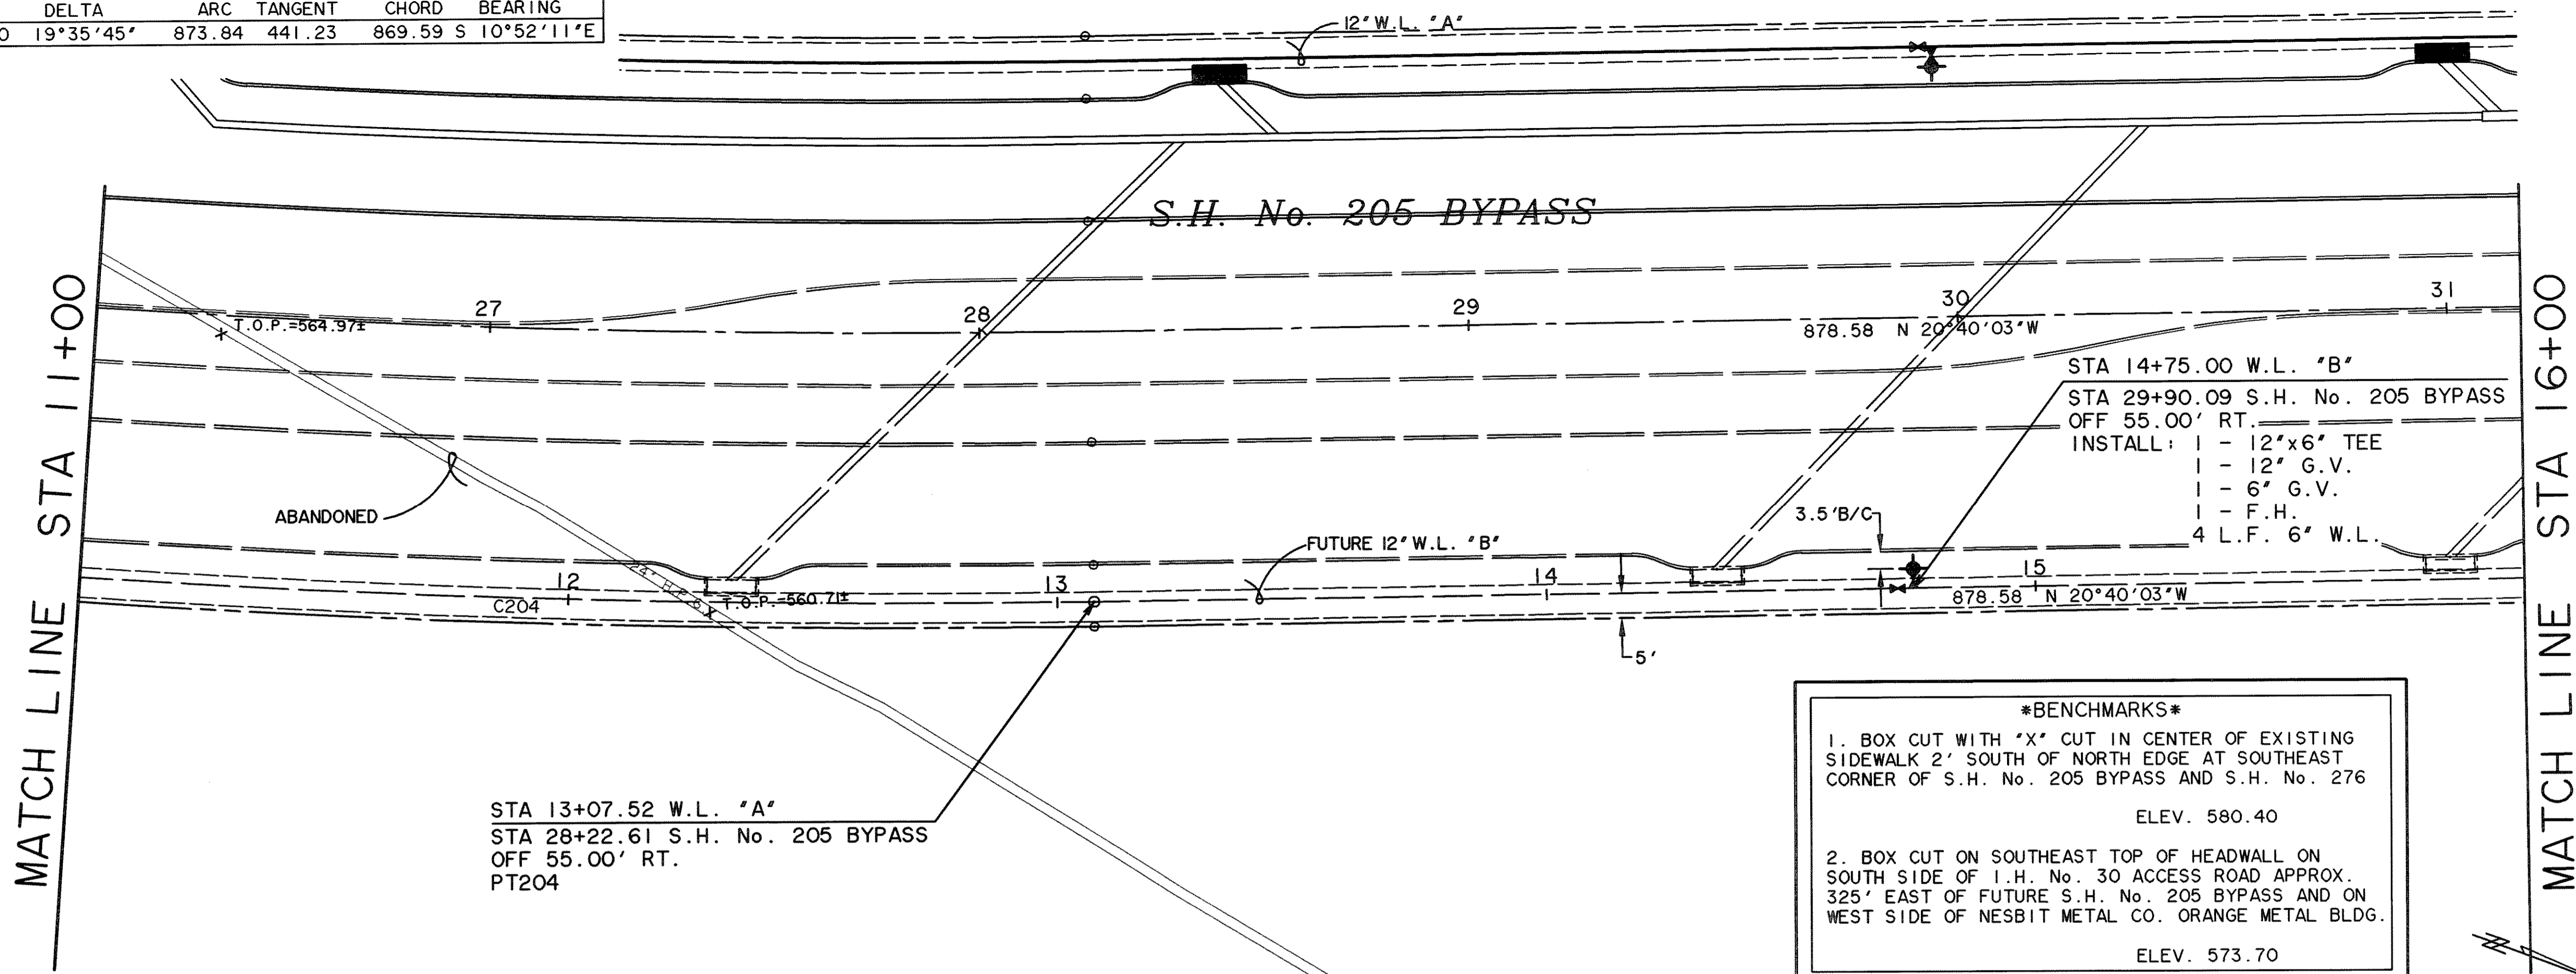

STA 13+07.52 W.L. "A"  
 STA 28+22.61 S.H. No. 205 BYPASS  
 OFF 55.00' RT.  
 PT204

STA 14+75.00 W.L. "B"  
 STA 29+90.09 S.H. No. 205 BYPASS  
 OFF 55.00' RT.  
 INSTALL: 1 - 12"x6" TEE  
 1 - 12" G.V.  
 1 - 6" G.V.  
 1 - F.H.  
 4 L.F. 6" W.L.


***BENCHMARKS***

- BOX CUT WITH "X" CUT IN CENTER OF EXISTING SIDEWALK 2' SOUTH OF NORTH EDGE AT SOUTHEAST CORNER OF S.H. No. 205 BYPASS AND S.H. No. 276  
 ELEV. 580.40
- BOX CUT ON SOUTHEAST TOP OF HEADWALL ON SOUTH SIDE OF I.H. No. 30 ACCESS ROAD APPROX. 325' EAST OF FUTURE S.H. No. 205 BYPASS AND ON WEST SIDE OF NESBIT METAL CO. ORANGE METAL BLDG.  
 ELEV. 573.70


**CAUTION !!**  
 EXISTING UTILITIES ARE INDICATED ON THE PLANS FROM AVAILABLE INFORMATION. IT SHALL BE THE RESPONSIBILITY OF THE CONTRACTOR TO VERIFY THE LOCATION OF ALL UTILITIES, TO NOTIFY ALL UTILITY COMPANIES OF THE CONTRACTORS OPERATIONS, TO PROTECT ALL UTILITIES FROM DAMAGE, TO REPAIR ALL UTILITIES DAMAGED DUE TO THE CONTRACTORS OPERATIONS, AND TO NOTIFY THE ENGINEER PROMPTLY OF ALL CONFLICTS OF THE WORK WITH EXISTING UTILITIES.

THE CAMBRIDGE  
 COMPANIES, INC.  
 TRUSTEE  
 VOL. 99, PG. 1022  
 D.R.R.C.T.

NOTE: ALL PVC WATER LINES SHALL BE C-900 CLASS 200 PIPE. ALL CHANGES IN WATER LINE DIRECTION (BENDS) SHALL BE RESTRAINED (MEGA-LUG OR EQUAL) AND CONCRETE BLOCKED. THE NEXT JOINT EITHER SIDE OF THE CHANGE OF DIRECTION SHALL ALSO BE RESTRAINED.

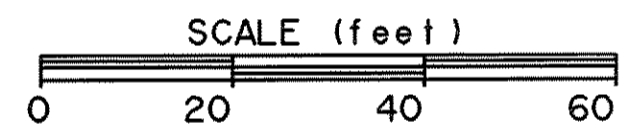


**WATER LINE "B"**

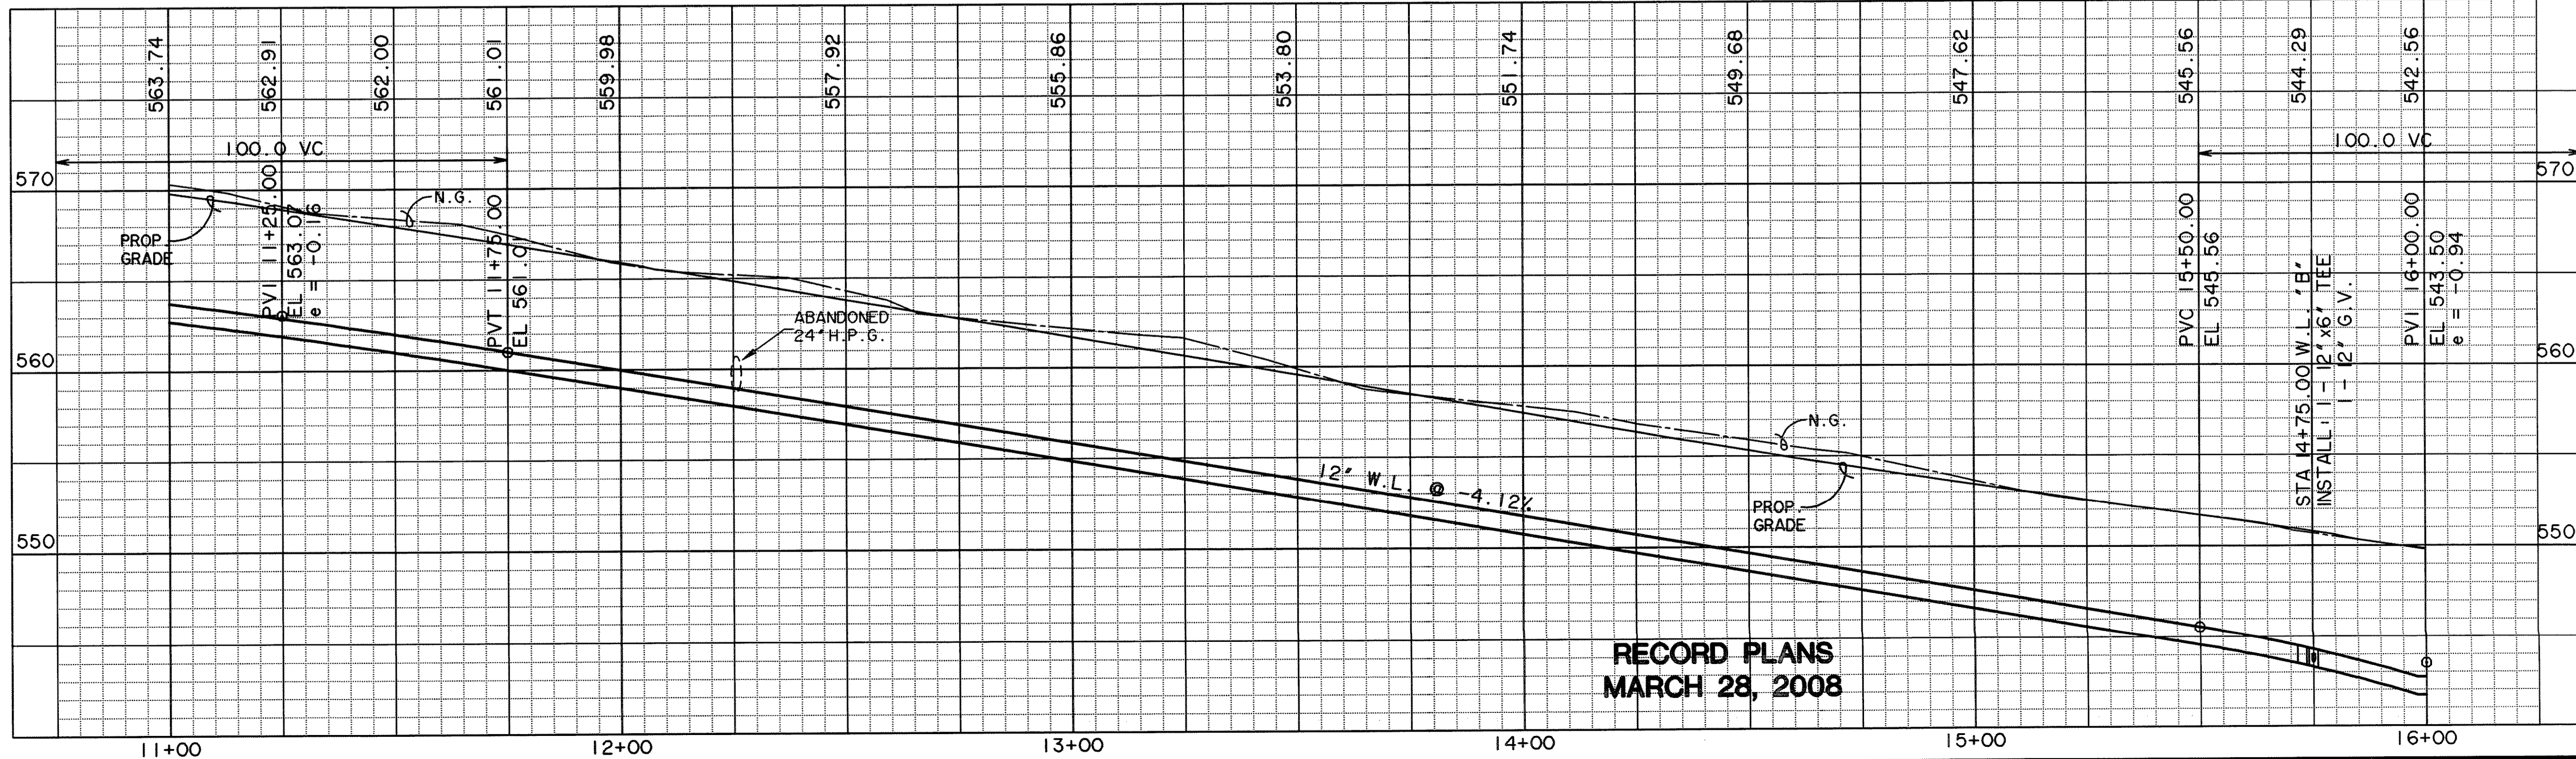


**RECORD PLANS  
 MARCH 28, 2008**

PREPARED BY:  
**VIA WIER & ASSOCIATES, INC.**  
**ENGINEERS SURVEYORS LAND PLANNERS**  
 4300 BELTWAY PLACE SUITE 130 ARLINGTON, TEXAS 76018 METRO (817)467-7700  
 1300 U.S. HIGHWAY 207 N. SUITE 101 WANSFELD, TEXAS 76063 METRO (817)477-0700  
 6849 ELM STREET FRISCO, TEXAS 75034 METRO (214)387-8000  
 www.viawerassociates.com


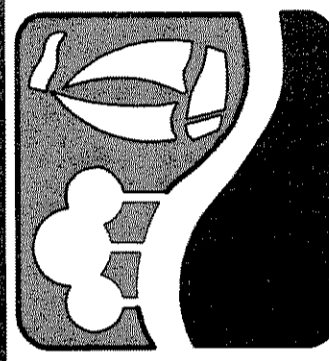


**PHASE I S.H. 205 BYPASS  
 FROM S.H. 276 TO INTERSTATE 30  
 FUTURE WATER LINE "B"  
 PLAN & PROFILE  
 STA 11+00 TO 16+00**

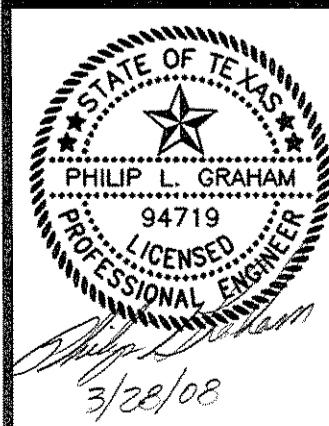


COPYRIGHT ©  
 WIER & ASSOCIATES, INC.  
 LAST SHEET EDIT  
 DATE 09-15-2006  
 WA# 04141  
**SHEET NO.  
 U110**

TIME 9:59 FILE: 04141-WL.PPC.dwg

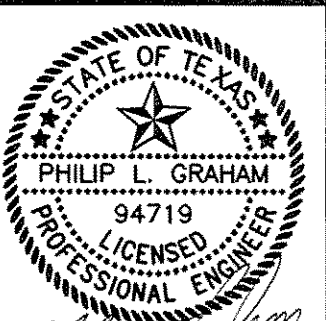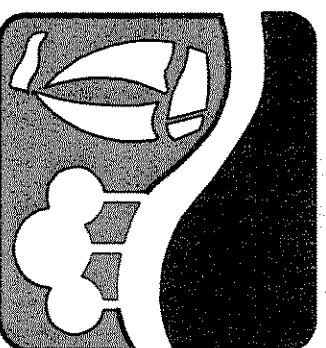


***BENCHMARK***  
 1. BOX CUT WITH "X" CUT IN CENTER OF EXISTING SIDEWALK 2' SOUTH OF NORTH EDGE AT SOUTHEAST CORNER OF S.H. No. 205 BYPASS AND S.H. No. 276  
 ELEV. 580.40  
 2. BOX CUT ON SOUTHEAST TOP OF HEADWALL ON SOUTH SIDE OF I.H. No. 30 ACCESS ROAD APPROX. 325' EAST OF FUTURE S.H. No. 205 BYPASS AND ON WEST SIDE OF NESBIT METAL CO. ORANGE METAL BLDG.  
 ELEV. 573.70

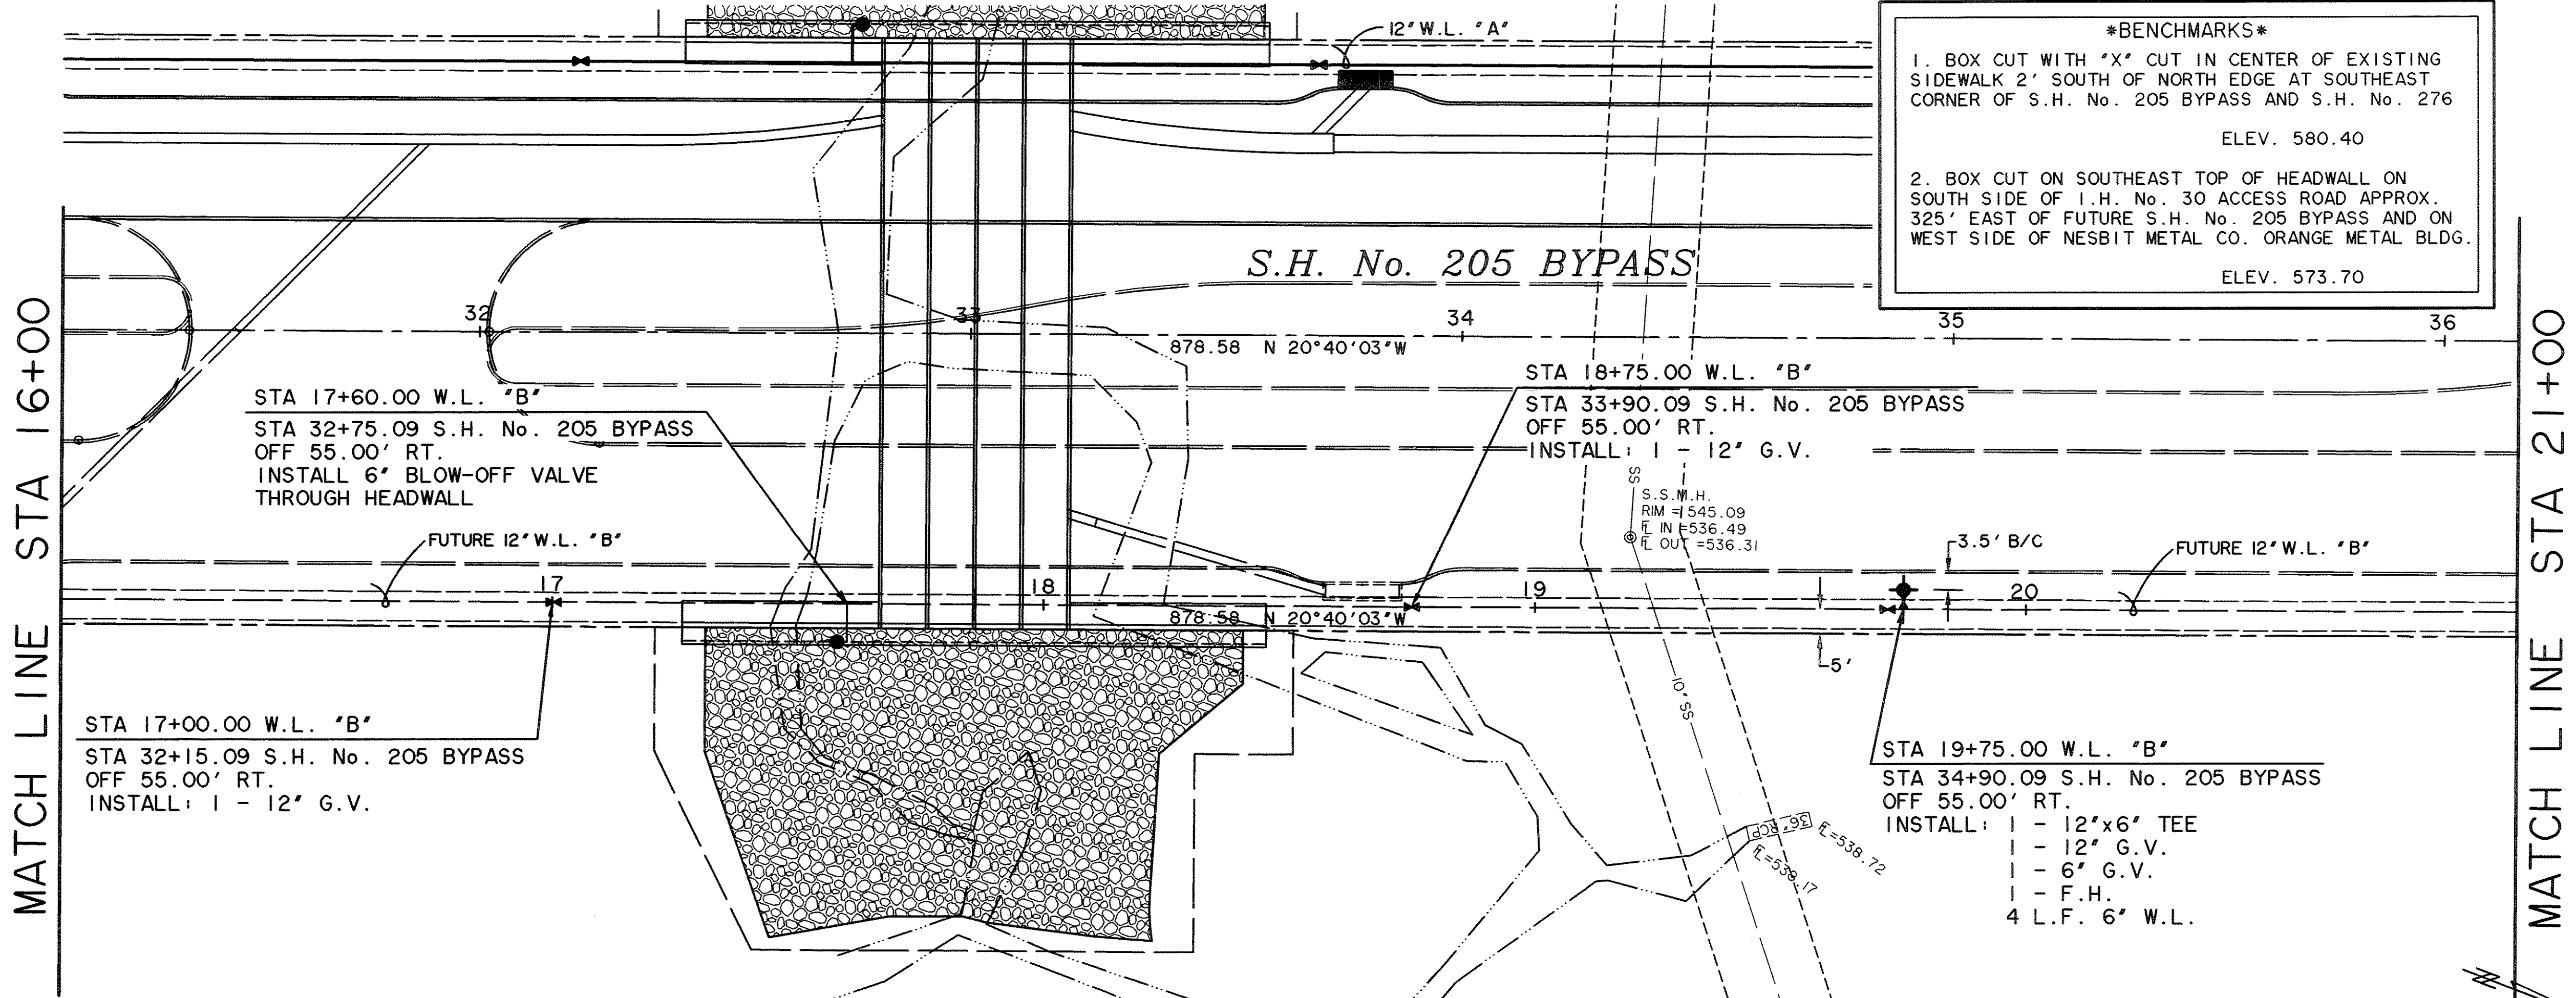


**CAUTION !!**  
 EXISTING UTILITIES ARE INDICATED ON THE PLANS FROM AVAILABLE INFORMATION. IT SHALL BE THE RESPONSIBILITY OF THE CONTRACTOR TO VERIFY THE LOCATION OF ALL UTILITIES, TO NOTIFY ALL UTILITY COMPANIES OF THE CONTRACTORS OPERATIONS, TO PROTECT ALL UTILITIES FROM DAMAGE, TO REPAIR ALL UTILITIES DAMAGED DUE TO THE CONTRACTORS OPERATIONS, AND TO NOTIFY THE ENGINEER PROMPTLY OF ALL CONFLICTS OF THE WORK WITH EXISTING UTILITIES.

THE CAMBRIDGE  
 COMPANIES, INC.  
 TRUSTEE  
 VOL. 99, PG. 1022  
 D.R.R.C.T.

NOTE: ALL PVC WATER LINES SHALL BE C-900 CLASS 200 PIPE. ALL CHANGES IN WATER LINE DIRECTION (BENDS) SHALL BE RESTRAINED (MEGA-LUG OR EQUAL) AND CONCRETE BLOCKED. THE NEXT JOINT EITHER SIDE OF THE CHANGE OF DIRECTION SHALL ALSO BE RESTRAINED.

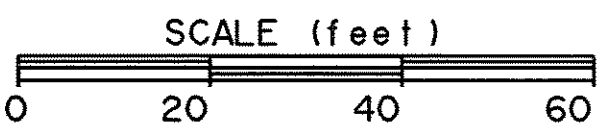

**WATER LINE "B"**

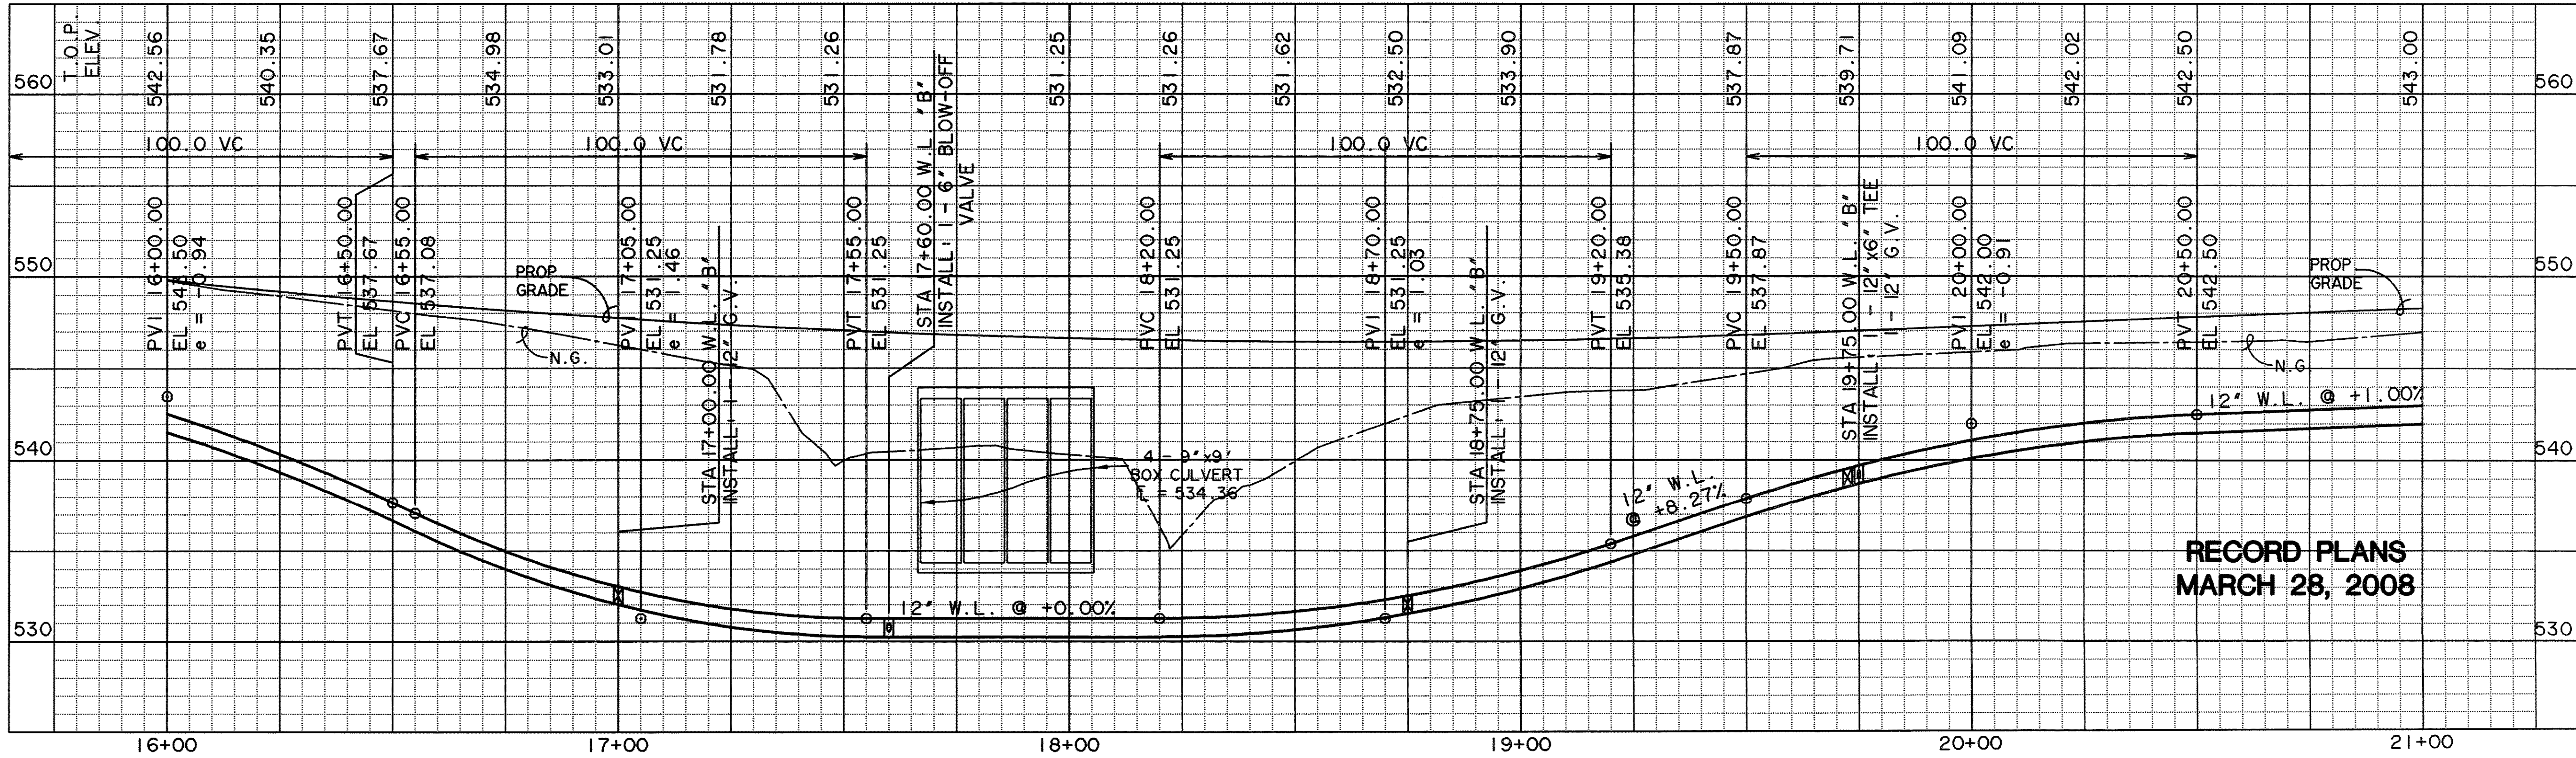

**RECORD PLANS**  
**MARCH 28, 2008**

NO.	RADIUS	DELTA	ARC TANGENT	CHORD	BEARING
205	1895.00	20°19'45"	672.36	339.75	668.84 N 10°30'11"W

CURVE TABLE

MATCH LINE STA 21+00

MATCH LINE STA 26+00

S.H. No. 205 BYPASS

STA 21+86.10 W.L. 'B'  
 STA 37+01.19 S.H. No. 205 BYPASS  
 OFF 55.00' RT.  
 PC205

STA 24+75.00 W.L. 'B'  
 STA 39+98.48 S.H. No. 205 BYPASS  
 OFF 55.00' RT.  
 INSTALL: 1 - 12"x6" TEE  
 1 - 12" G.V.  
 1 - 6" G.V.  
 1 - F.H.  
 4 L.F. 6" W.L.

***BENCHMARK***


1. BOX CUT WITH 'X' CUT IN CENTER OF EXISTING SIDEWALK 2' SOUTH OF NORTH EDGE AT SOUTHEAST CORNER OF S.H. No. 205 BYPASS AND S.H. No. 276  
 ELEV. 580.40

2. BOX CUT ON SOUTHEAST TOP OF HEADWALL ON SOUTH SIDE OF I.H. No. 30 ACCESS ROAD APPROX. 325' EAST OF FUTURE S.H. No. 205 BYPASS AND ON WEST SIDE OF NESBIT METAL CO. ORANGE METAL BLDG.  
 ELEV. 573.70


THE CAMBRIDGE COMPANIES, INC.  
 TRUSTEE  
 VOL. 99, PG. 1022  
 D.R.R.C.T.

**CAUTION !!**  
 EXISTING UTILITIES ARE INDICATED ON THE PLANS FROM AVAILABLE INFORMATION. IT SHALL BE THE RESPONSIBILITY OF THE CONTRACTOR TO VERIFY THE LOCATION OF ALL UTILITIES, TO NOTIFY ALL UTILITY COMPANIES OF THE CONTRACTORS OPERATIONS, TO PROTECT ALL UTILITIES FROM DAMAGE, TO REPAIR ALL UTILITIES DAMAGED DUE TO THE CONTRACTORS OPERATIONS, AND TO NOTIFY THE ENGINEER PROMPTLY OF ALL CONFLICTS OF THE WORK WITH EXISTING UTILITIES.

NOTE: ALL PVC WATER LINES SHALL BE C-900 CLASS 200 PIPE. ALL CHANGES IN WATER LINE DIRECTION (BENDS) SHALL BE RESTRAINED (MEGA-LUG OR EQUAL) AND CONCRETE BLOCKED. THE NEXT JOINT EITHER SIDE OF THE CHANGE OF DIRECTION SHALL ALSO BE RESTRAINED.

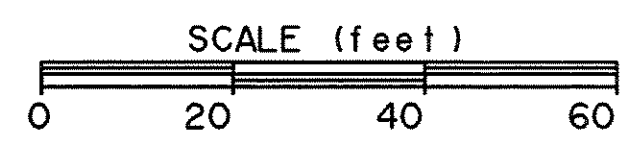


WATER LINE "B"

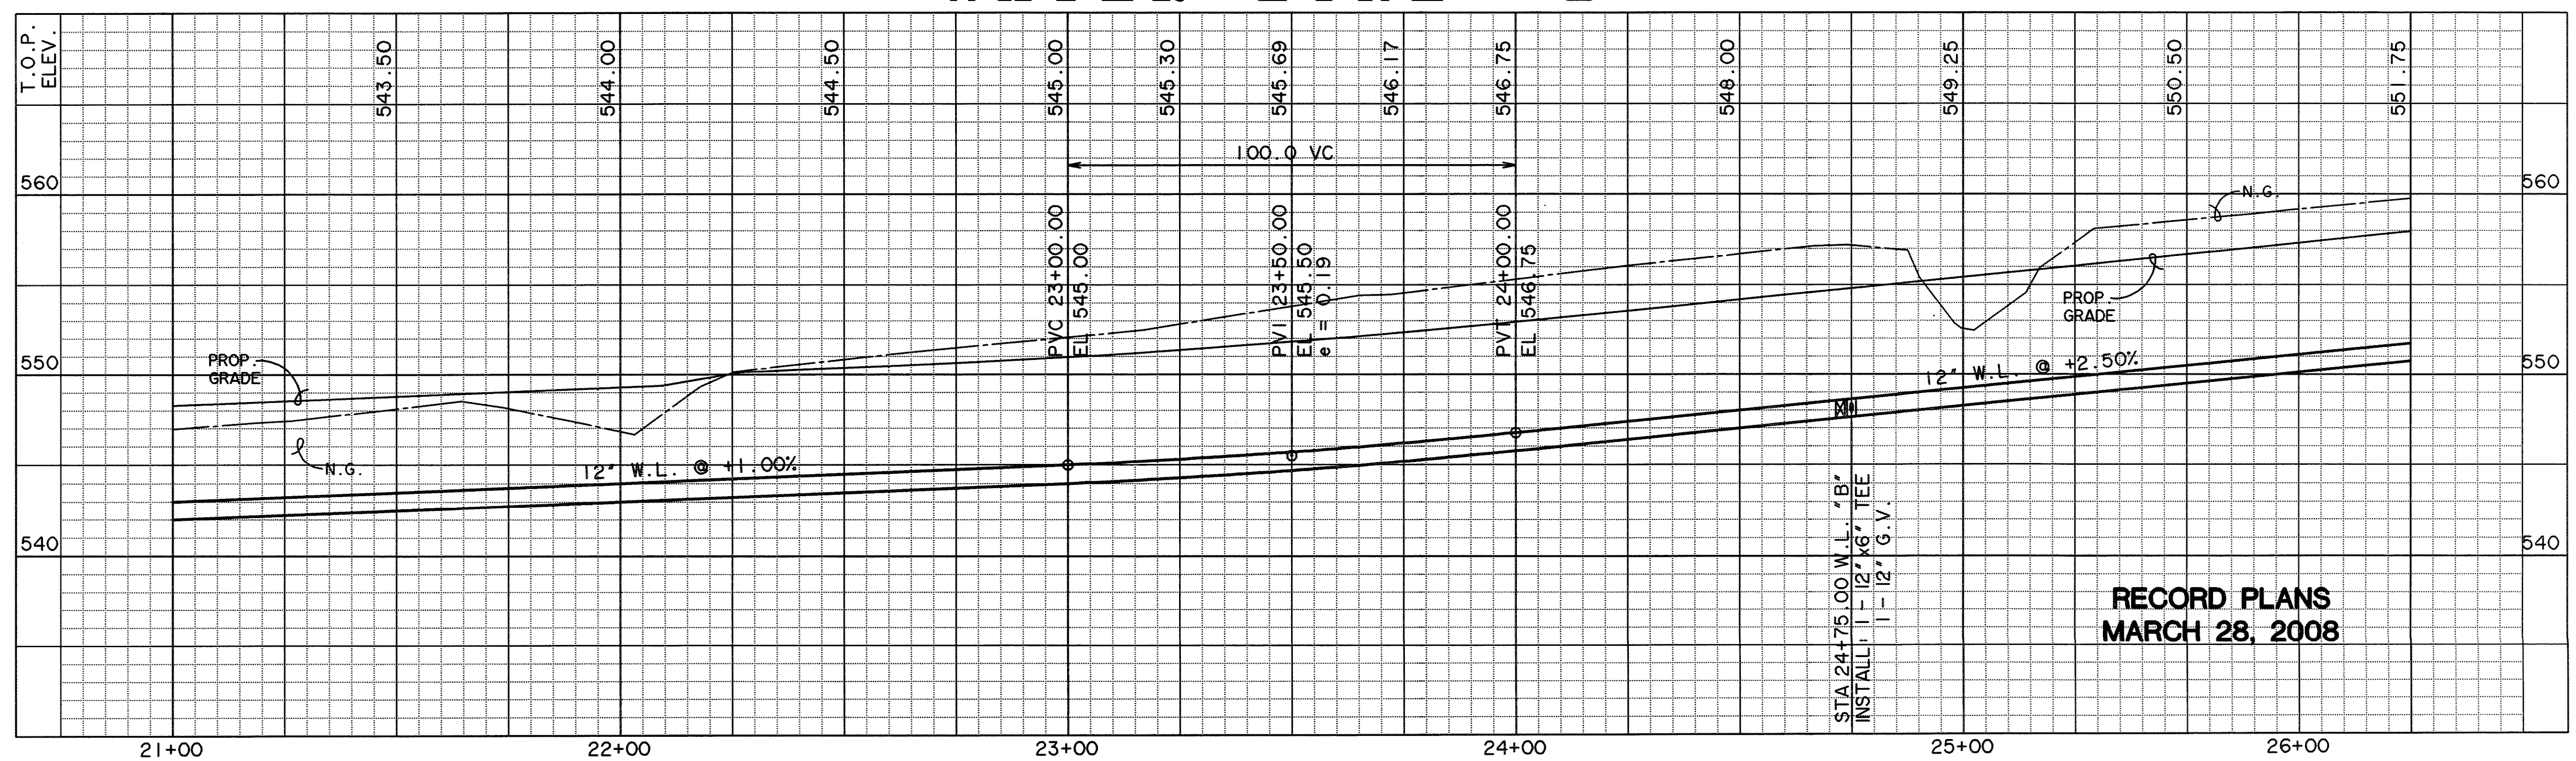


RECORD PLANS  
 MARCH 28, 2008

PREPARED BY:  
**WIER & ASSOCIATES, INC.**  
 ENGINEERS SURVEYORS LAND PLANNERS  
 4300 BELWAY PLACE SUITE 130 ARLINGTON, TEXAS 76018 METRO (817)467-7700  
 1380 U.S. HIGHWAY 287 N. SUITE 101 MANSFIELD, TEXAS 76063 METRO (817)477-8700  
 6848 ELA STREET PRISCO, TEXAS 75034 METRO (214)387-8000  
 www.wierassociates.com

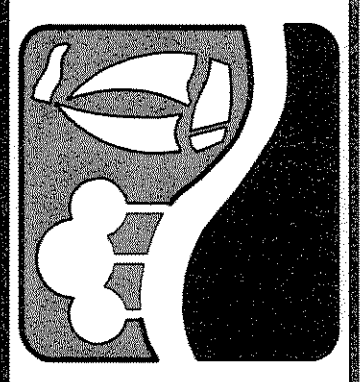

PHASE I S.H. 205 BYPASS  
 FROM SH. 276 TO INTERSTATE 30  
 FUTURE WATER LINE "B"  
 PLAN & PROFILE  
 STA 21+00 TO 26+00

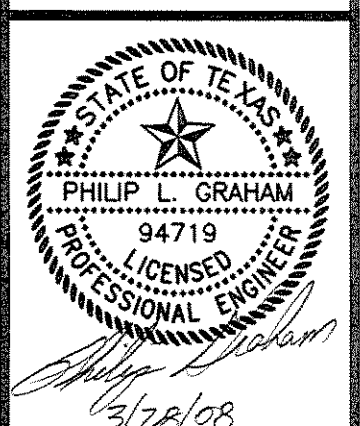

3/28/08  
 COPYRIGHT ©  
 WIER & ASSOCIATES, INC.  
 LAST SHEET EDIT  
 DATE 09-15-2006  
 WA# 04141  
 SHEET NO.  
 U112

CURVE TABLE						
NO.	RADIUS	DELTA	ARC	TANGENT	CHORD	BEARING
205	1895.00	20°19'45"	672.36	339.75	668.84	N 10°30'11"W
206	455.00	11°15'17"	89.38	44.83	89.23	N 05°17'20"E

MATCH LINE STA 26+00

MATCH LINE STA 31+00

S.H. No. 205 BYPASS


**CAUTION !!**  
 EXISTING UTILITIES ARE INDICATED ON THE PLANS FROM AVAILABLE INFORMATION. IT SHALL BE THE RESPONSIBILITY OF THE CONTRACTOR TO VERIFY THE LOCATION OF ALL UTILITIES, TO NOTIFY ALL UTILITY COMPANIES OF THE CONTRACTORS OPERATIONS, TO PROTECT ALL UTILITIES FROM DAMAGE, TO REPAIR ALL UTILITIES DAMAGED DUE TO THE CONTRACTORS OPERATIONS, AND TO NOTIFY THE ENGINEER PROMPTLY OF ALL CONFLICTS OF THE WORK WITH EXISTING UTILITIES.

**NOTE:** ALL PVC WATER LINES SHALL BE C-900 CLASS 200 PIPE. ALL CHANGES IN WATER LINE DIRECTION (BENDS) SHALL BE RESTRAINED (MEGA-LUG OR EQUAL) AND CONCRETE BLOCKED. THE NEXT JOINT EITHER SIDE OF THE CHANGE OF DIRECTION SHALL ALSO BE RESTRAINED.


THE CAMBRIDGE COMPANIES, INC.  
 TRUSTEE  
 VOL. 99, PG. 1022  
 D.R.R.C.T.

THE CAMBRIDGE COMPANIES, INC.  
 TRUSTEE  
 VOL. 101, PG. 795  
 D.R.R.C.T.

***BENCHMARKS***  
 1. BOX CUT WITH "X" CUT IN CENTER OF EXISTING SIDEWALK 2' SOUTH OF NORTH EDGE AT SOUTHEAST CORNER OF S.H. No. 205 BYPASS AND S.H. No. 276  
 ELEV. 580.40  
 2. BOX CUT ON SOUTHEAST TOP OF HEADWALL ON SOUTH SIDE OF I.H. No. 30 ACCESS ROAD APPROX. 325' EAST OF FUTURE S.H. No. 205 BYPASS AND ON WEST SIDE OF NESBIT METAL CO. ORANGE METAL BLDG.  
 ELEV. 573.70

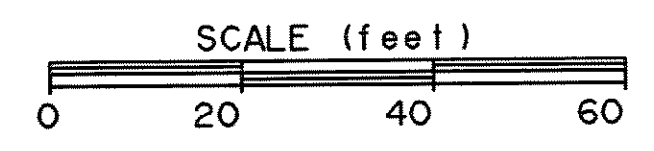


WATER LINE "B"

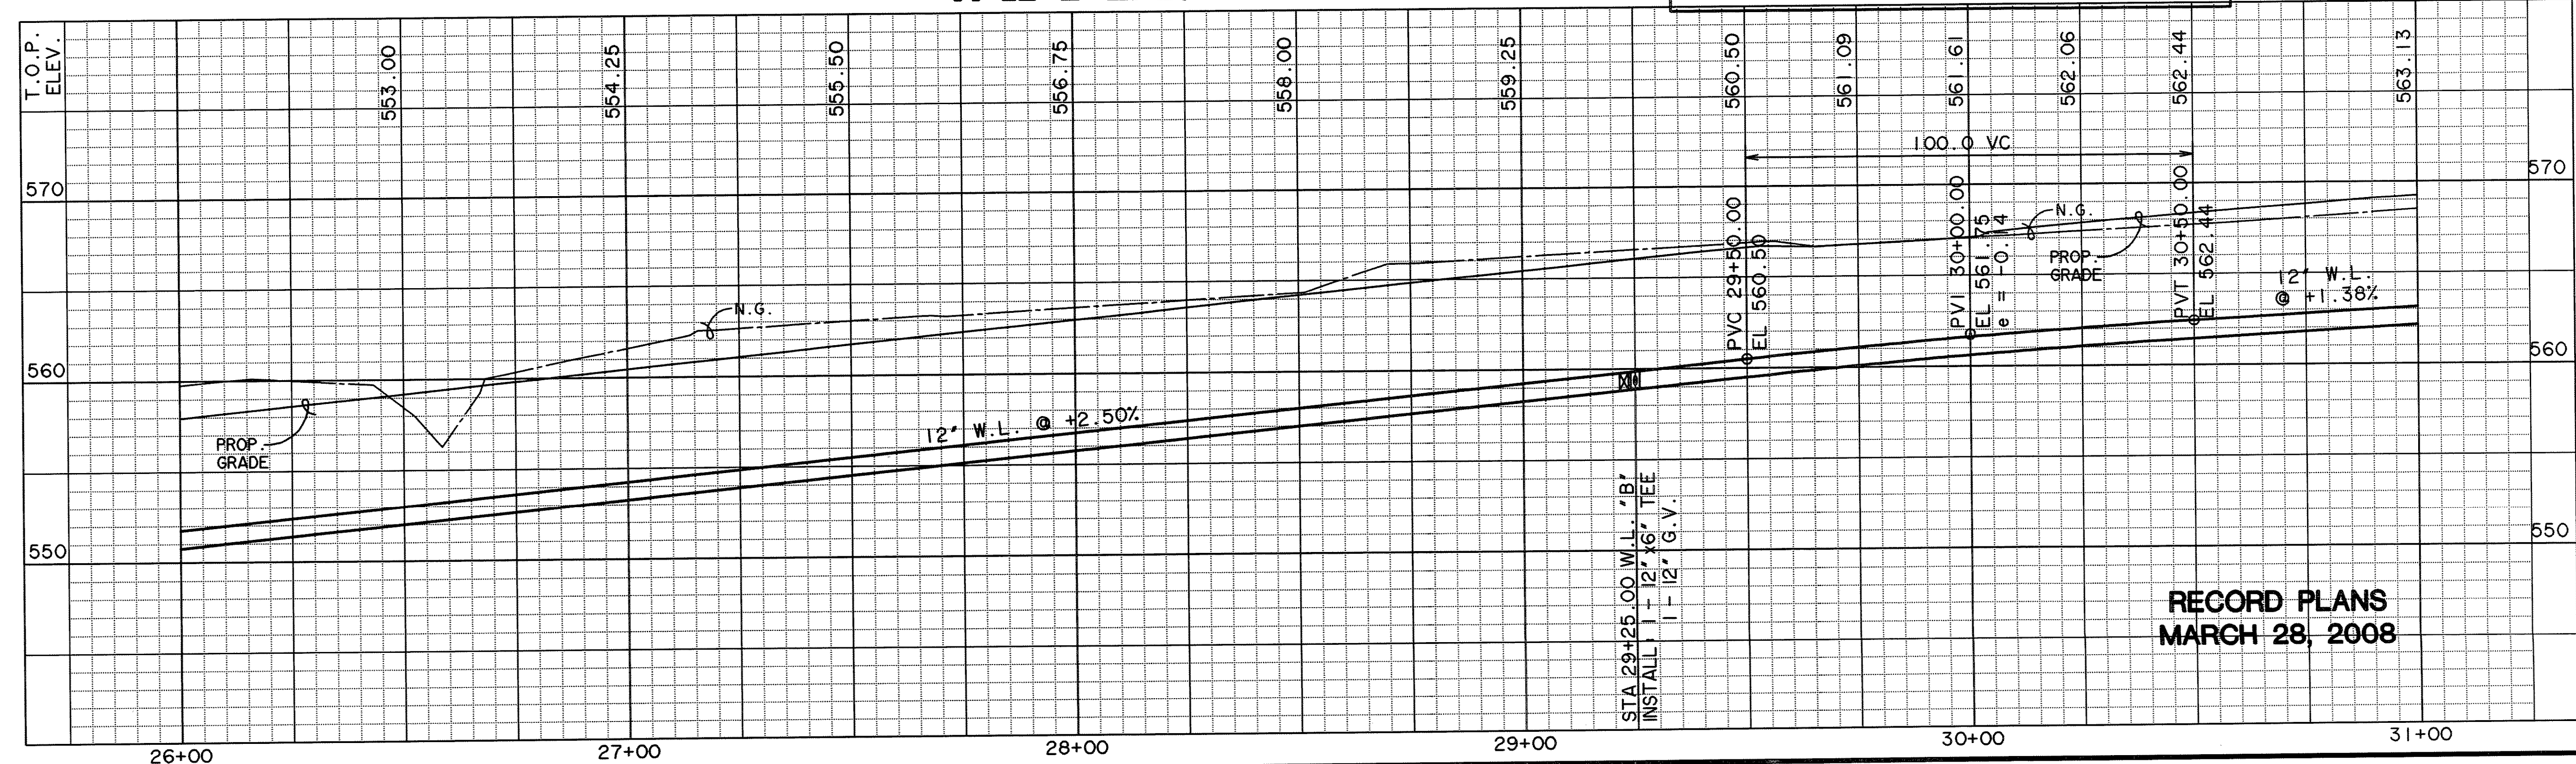


STA 29+25.00 W.L. "B"  
 INSTALL 1 - 12"x6" TEE  
 1 - 12" G.V.

RECORD PLANS  
 MARCH 28, 2008

PREPARED BY:  
**WIA WIER & ASSOCIATES, INC.**  
 ENGINEERS SURVEYORS LAND PLANNERS  
 4300 BELTWAY PLACE SUITE 130 ARLINGTON, TEXAS 76018 METRO (817)467-7700  
 1380 U.S. HIGHWAY 287 N. SUITE 101 MANSFIELD, TEXAS 76063 METRO (817)477-8700  
 6849 ELM STREET FRISCO, TEXAS 75034 METRO (214)387-8000  
 www.wierassociates.com

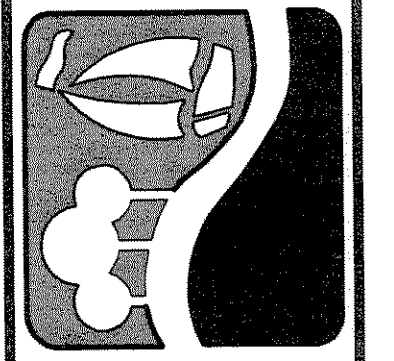



PHASE I S.H. 205 BYPASS  
 FROM S.H. 276 TO INTERSTATE 30  
 FUTURE WATER LINE "B"  
 PLAN & PROFILE  
 STA 26+00 TO 31+00

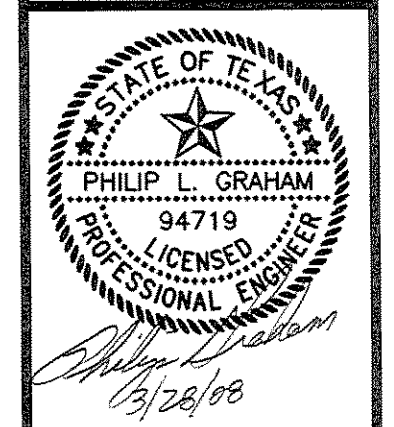

COPYRIGHT ©  
 WIER & ASSOCIATES, INC.  
 LAST SHEET EDIT  
 DATE 09-15-2006  
 WA# 04141  
 SHEET NO.  
 U113


TIME: 0:53 FILE: I:\04141-WLPP13.dwg

CURVE TABLE					
NO.	RADIUS	DELTA	ARC TANGENT	CHORD	BEARING
206	455.00	11°15'17"	89.38	44.83	89.23 N 05°17'20"E
207	455.00	11°15'17"	89.38	44.83	89.23 S 05°17'20"W

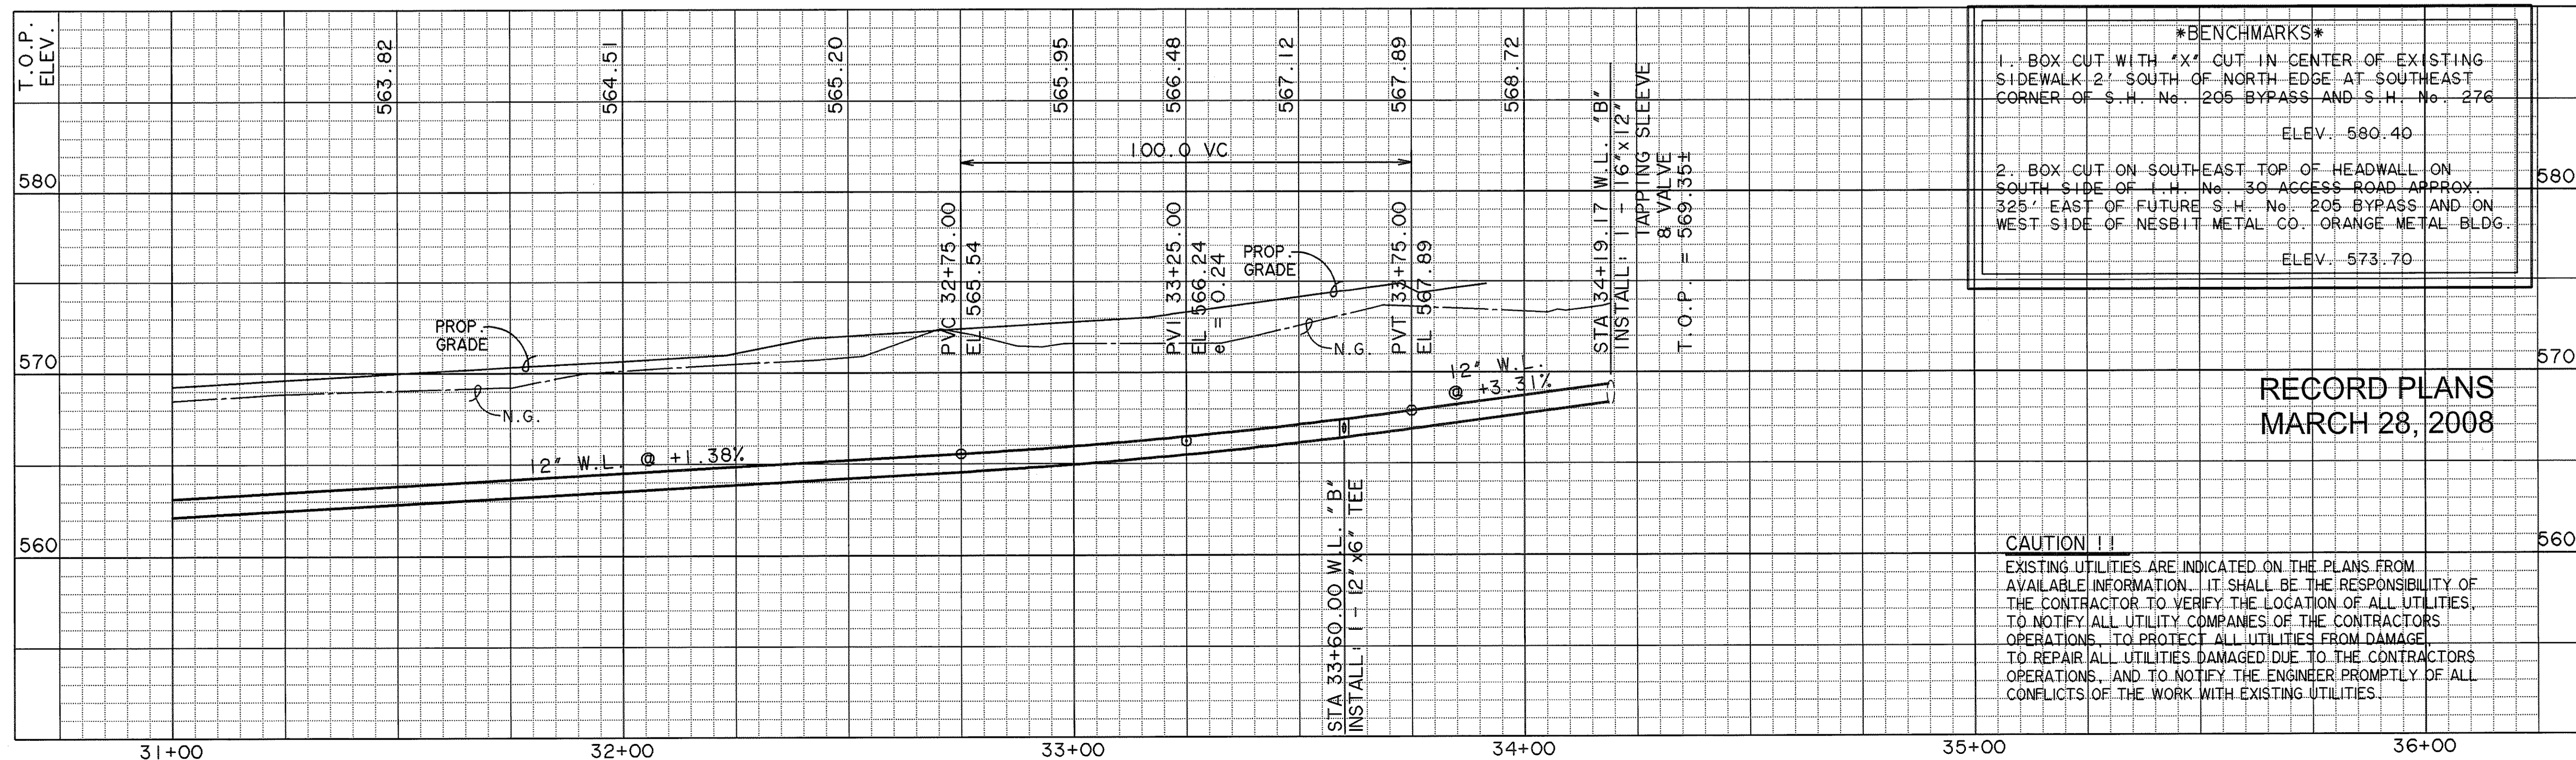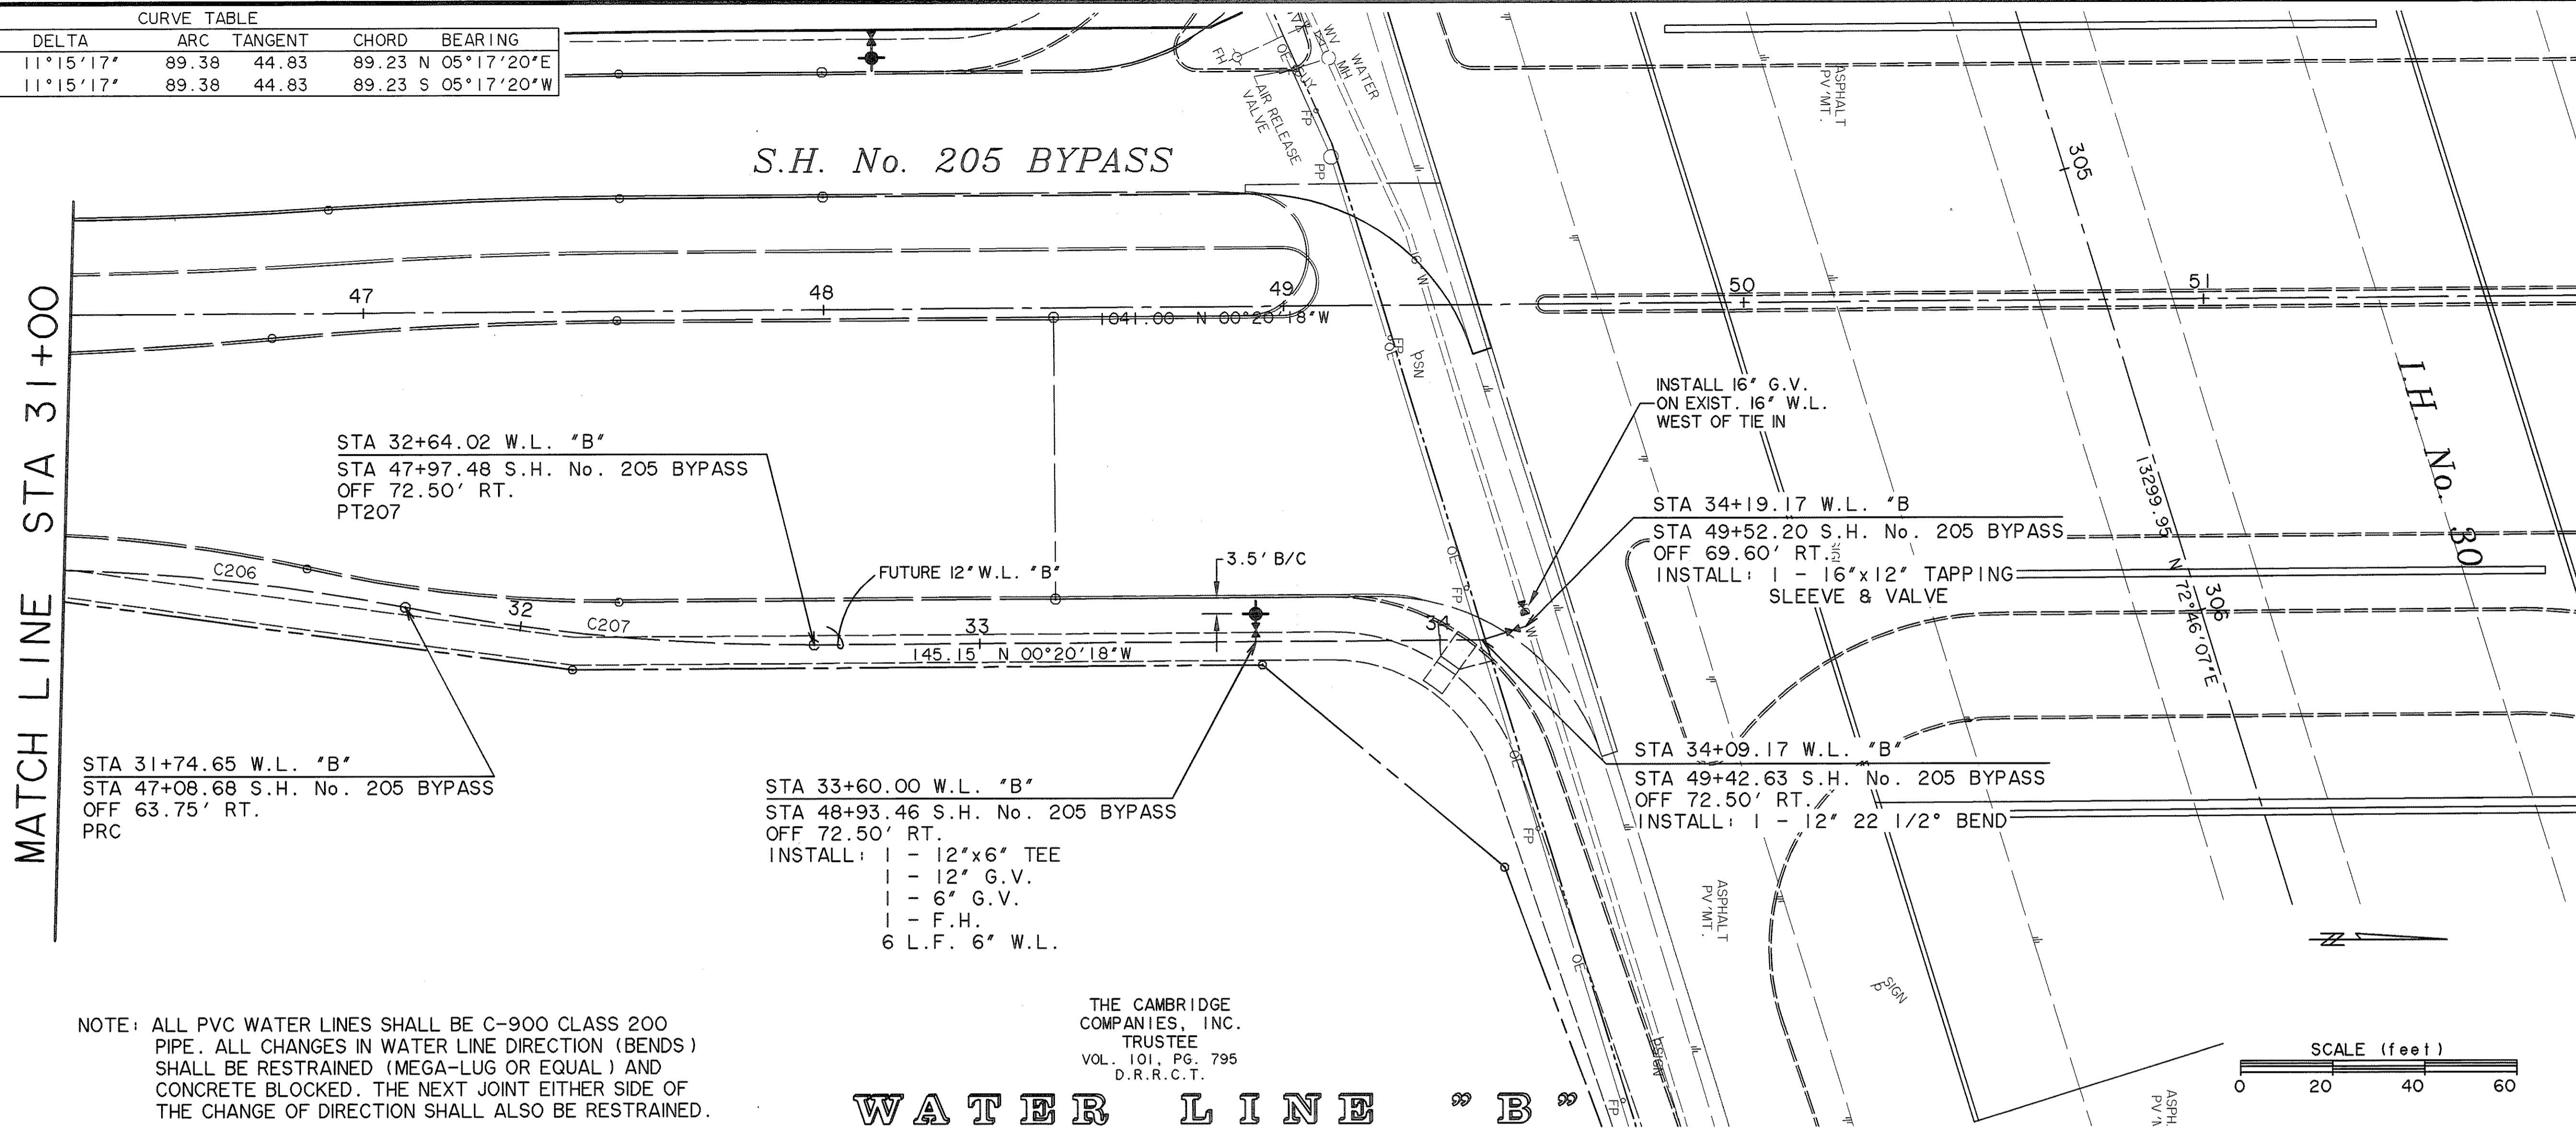


TIME 9:55 FILE: 04141-WLPP14.dwg

PREPARED BY:  
**WIA WIER & ASSOCIATES, INC.**  
ENGINEERS SURVEYORS LAND PLANNERS  
4300 BELTWAY PLACE SUITE 130 ARLINGTON, TEXAS 76018 METRO (817)461-7700  
1380 U.S. HIGHWAY 287 N. SUITE 101 MANSFIELD, TEXAS 76063 METRO (817)477-8700  
6848 ELA STREET FRISCO, TEXAS 75034 METRO (214)387-8000  
www.wierassociates.com

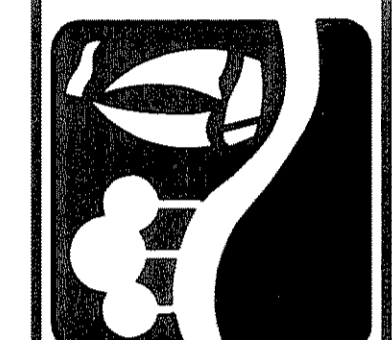

PHASE I S.H. 205 BYPASS  
FROM S.H. 276 TO INTERSTATE 30  
FUTURE WATER LINE "B"  
PLAN & PROFILE  
STA 31+00 TO END

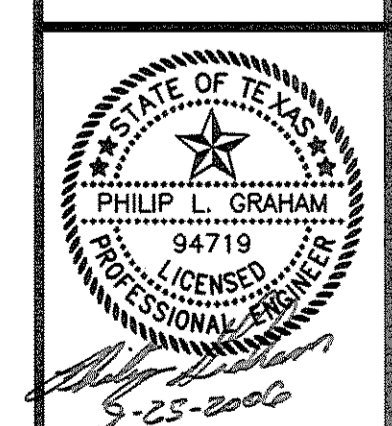

COPYRIGHT ©  
WIER & ASSOCIATES, INC.  
LAST SHEET EDIT  
DATE 09-15-2006  
WA# 0414  
**SHEET NO. U114**

1. THE CONTRACTOR AND SUB-CONTRACTORS WORKING ON THIS SITE SHALL THOROUGHLY REVIEW AND UNDERSTAND THE APPLICABLE REGULATIONS UNDER SECTION 402 OF THE CLEAN WATER ACT AND CHAPTER 26 OF THE TEXAS WATER CODE REGARDING GENERAL PERMIT PROVISIONS TO DISCHARGE WASTE UNDER TPDES CONSTRUCTION GENERAL PERMIT NO. TXR150000 ISSUED AND EFFECTIVE MARCH 5, 2003 BY THE TEXAS COMMISSION ON ENVIRONMENTAL QUALITY. REGULATIONS, PERMIT FORMS AND SUPPORT INFORMATION CAN BE OBTAINED BY CONTACTING THE TEXAS COMMISSION ON ENVIRONMENTAL QUALITY (TCEQ) STORM WATER PROGRAM AT (512)239-4671 OR "STORM WATER" ON THE TCEQ WEB SITE AT [www.tceq.state.tx.us](http://www.tceq.state.tx.us).

2. SITE OPERATORS:

BY DEFINITION AN OPERATOR IS THE PERSON OR PERSONS ASSOCIATED WITH A LARGE OR SMALL CONSTRUCTION ACTIVITY THAT MEETS EITHER OF THE FOLLOWING CRITERIA:

- A. THE PERSON OR PERSONS HAVE OPERATIONAL CONTROL OVER CONSTRUCTION PLANS AND SPECIFICATIONS TO THE EXTENT NECESSARY TO MEET THE REQUIREMENTS AND CONDITIONS OF THE TPDES GENERAL PERMIT, OR
- B. THE PERSON OR PERSONS HAVE DAY-TO-DAY OPERATIONAL CONTROL OF THOSE ACTIVITIES AT A CONSTRUCTION SITE WHICH ARE NECESSARY TO ENSURE COMPLIANCE WITH A STORM WATER POLLUTION PREVENTION PLAN FOR THE SITE OR OTHER PERMIT CONDITIONS (E.G. THEY ARE AUTHORIZED TO DIRECT WORKERS AT A SITE TO CARRY OUT ACTIVITIES REQUIRED BY THE SWP3 OR COMPLY WITH OTHER PERMIT CONDITIONS).

(SIGNATURE)	(SIGNATURE)
OWNER OPERATOR IN CONTROL OF PLANS & SITE SPECIFICATIONS CHUCK TODD, P.E. CITY ENGINEER CITY OF ROCKWALL 385 SOUTH GOLIAD ROCKWALL, TEXAS 75087 972-771-7746	CONTRACTOR OPERATOR IN CONTROL OF DAY-TO-DAY ACTIVITIES NAME & TITLE COMPANY NAME ADDRESS PHONE

THE SWP3 SHALL BE SIGNED BY ALL SITE OPERATORS IN COMPLIANCE WITH TXR150000 PART III.A.1.

3. RESPONSIBILITIES OF ALL SITE OPERATORS:

EACH OPERATOR MUST:

- A. SIGN THE SWP3 PLAN SHEETS IN THE LOCATIONS PROVIDED. SIGNATORIES MUST MEET THE REQUIREMENTS AS SET FORTH IN 30 TEXAS ADMINISTRATIVE CODE 305.44.
- B. FOR SMALL CONSTRUCTION SITES WITH ONE TO LESS THAN FIVE ACRES OF DISTURBANCE, COMPLETE AND CERTIFY A CONSTRUCTION SITE NOTICE FOR SMALL CONSTRUCTION SITES. A COPY OF THE CONSTRUCTION SITE NOTICE MAY BE FOUND IN THE CONTRACT DOCUMENTS. A COPY OF THE SIGNED AND CERTIFIED CONSTRUCTION SITE NOTICE MUST BE POSTED IN A LOCATION WHERE IT IS READILY AVAILABLE FOR VIEWING BY THE GENERAL PUBLIC, LOCAL, STATE, AND FEDERAL AUTHORITIES PRIOR TO COMMENCING CONSTRUCTION ACTIVITIES, AND MAINTAINED IN THAT LOCATION UNTIL COMPLETION OF THE CONSTRUCTION ACTIVITY. A COPY OF THE SIGNED AND CERTIFIED CONSTRUCTION SITE NOTICE MUST ALSO BE PROVIDED TO THE OPERATOR OF ANY MS4 RECEIVING THE DISCHARGE AT LEAST TWO DAYS PRIOR TO COMMENCEMENT OF CONSTRUCTION ACTIVITIES.
- C. FOR LARGE CONSTRUCTION SITES WITH FIVE OR MORE ACRES OF DISTURBANCE, COMPLETE A CONSTRUCTION SITE NOTICE FOR LARGE CONSTRUCTION SITES. A COPY OF THE CONSTRUCTION SITE NOTICE MAY BE FOUND IN THE CONTRACT DOCUMENTS. EACH OPERATOR MUST SUBMIT A NOTICE OF INTENT (N.O.I.) TO THE TCEQ USING THE FORM PROVIDED BY THE EXECUTIVE DIRECTOR, AT LEAST TWO DAYS PRIOR TO COMMENCING CONSTRUCTION ACTIVITIES. A COPY OF THE SIGNED N.O.I. MUST BE POSTED ALONG WITH THE CONSTRUCTION SITE NOTICE IN A LOCATION WHERE IT IS READILY AVAILABLE FOR VIEWING PRIOR TO COMMENCING CONSTRUCTION ACTIVITIES, AND MAINTAIN THE NOTICE IN THAT LOCATION UNTIL COMPLETION OF THE CONSTRUCTION ACTIVITY. A COPY OF THE CONSTRUCTION SITE NOTICE AND SIGNED N.O.I. MUST ALSO BE PROVIDED TO THE OPERATOR OF ANY MS4 RECEIVING THE DISCHARGE AT LEAST TWO DAYS PRIOR TO COMMENCEMENT OF CONSTRUCTION ACTIVITIES. IF THE OPERATOR CHANGES, OR AN ADDITIONAL OPERATOR IS ADDED AFTER THE INITIAL N.O.I. IS SUBMITTED, THE NEW OPERATOR MUST SUBMIT AN NOI AT LEAST TWO DAYS PRIOR TO ASSUMING OPERATIONAL CONTROL.
- D. DELEGATE AUTHORITY TO THE SPECIFICALLY DESCRIBED POSITION OR PERSON PERFORMING INSPECTIONS, AS PROVIDED BY 30 TAC 305.128, AS AN AUTHORIZED PERSON FOR SIGNING REPORTS AND PERFORMING CERTAIN ACTIVITIES REQUESTED BY THE DIRECTOR OR REQUIRED BY THE TPDES GENERAL PERMIT. THIS DELEGATION OF AUTHORITY MUST BE PROVIDED TO THE DIRECTOR OF TCEQ IN WRITING AND A COPY SHALL BE KEPT ALONG WITH THE SIGNED EFFECTIVE COPY OF THE SWP3. AN EXAMPLE DELEGATION LETTER IS PROVIDED IN THE CONTRACT DOCUMENTS.
- E. RETAIN THE FOLLOWING RECORDS FOR A MINIMUM OF THREE YEARS FROM THE DATE THAT AN N.O.T. IS SUBMITTED. ON SMALL PROJECT SITES WHERE AN N.O.T. IS NOT REQUIRED, RECORDS SHALL BE KEPT FOR A PERIOD OF LEAST THREE YEARS FROM THE DATE OF FINAL STABILIZATION OR CHANGE OF OPERATOR.
  - 1. A COPY OF THE SWP3 PLAN.
  - 2. ALL REPORTS AND ACTIONS REQUIRED BY THE TPDES GENERAL PERMIT, INCLUDING A COPY OF THE CONSTRUCTION SITE NOTICE.
  - 3. ALL DATA USED TO COMPLETE THE N.O.I., IF AN N.O.I. IS REQUIRED.

4. RESPONSIBILITIES OF THE OWNER (OPERATOR IN CONTROL OF PLANS & SITE SPECIFICATIONS):

- A. ENSURE THE PROJECT SPECIFICATIONS ALLOW OR PROVIDE THAT ADEQUATE BMPs MAY BE DEVELOPED TO MEET THE REQUIREMENTS OF PART III OF THE TPDES GENERAL PERMIT.
- B. ENSURE THAT THE SWP3 INDICATES THE AREAS OF THE PROJECT WHERE THEY HAVE OPERATIONAL CONTROL.
- C. ENSURE ALL OTHER OPERATORS AFFECTED BY MODIFICATIONS IN PROJECT SPECIFICATIONS ARE NOTIFIED IN A TIMELY MANNER SUCH THAT THOSE OPERATORS MAY MODIFY BMPs AS ARE NECESSARY TO REMAIN COMPLIANT WITH THE CONDITIONS OF THE TPDES GENERAL PERMIT.
- D. ENSURE THAT THE SWP3 FOR PORTIONS OF THE PROJECT WHERE THEY ARE OPERATORS INDICATES THE NAME AND TPDES PERMIT NUMBERS FOR PERMITTEES WITH THE DAY-TO-DAY OPERATIONAL CONTROL OVER THOSE ACTIVITIES NECESSARY TO ENSURE COMPLIANCE WITH THE SWP3 AND OTHER PERMIT CONDITIONS. IN THE CASE THAT RESPONSIBLE PARTIES HAVE NOT BEEN IDENTIFIED, THE PERMITTEE WITH OPERATIONAL CONTROL OVER PROJECT SPECIFICATIONS MUST BE CONSIDERED TO BE THE RESPONSIBLE PARTY UNTIL SUCH TIME AS THE AUTHORITY IS TRANSFERRED TO ANOTHER PARTY AND THE PLAN IS UPDATED.

5. RESPONSIBILITIES OF THE CONTRACTOR (OPERATOR IN CONTROL OF DAY-TO-DAY ACTIVITIES):

- A. PREPARE A STANDARD THREE RING NOTEBOOK ENTITLED "SWP3 PLAN FOR PAVING, DRAINAGE AND WATER IMPROVEMENTS TO SERVE S.H. 205 BYPASS, ROCKWALL, TEXAS" TO KEEP TOGETHER THE EFFECTIVE SIGNED COPY OF THE SWP3 AND ALL RELATED DOCUMENTS. THE NOTEBOOK SHALL CONTAIN THE FOLLOWING:
  - 1. PLAN SHEETS INCLUDING, BUT NOT LIMITED TO, SIGNED COPY OF SWP3 NOTES (E001 THROUGH E004), SIGNED COPY SWP3 LAYOUT PLAN (E101), SWP3 DETAILS (E201 AND E202), AND EROSION CONTROL PLANS (E102 AND E103).
  - 2. COPY OF TPDES GENERAL PERMIT TXR150000.
  - 3. COPY OF A SIGNED N.O.I. FOR EACH OPERATOR, IF AN N.O.I. IS REQUIRED.
  - 4. COPY OF A SIGNED CONSTRUCTION SITE NOTICE FOR EACH OPERATOR.
  - 5. INSPECTION REPORTS.
  - 6. COPY OF A SIGNED DELEGATION LETTER FROM EACH OPERATOR.
  - 7. ALL UPDATES REQUIRED IN ITEM F. BELOW.
  - 8. ALL WORKSHEETS COMPLETED AND UPDATED AS REQUIRED IN ITEMS K THROUGH O BELOW.
- B. AFTER AN N.O.T. IS SUBMITTED, OR ON SMALL PROJECT SITES WHERE AN N.O.T. IS NOT REQUIRED, AFTER FINAL STABILIZATION OR CHANGE OF OPERATOR, THE CONTRACTOR SHALL FORWARD ALL ORIGINALS TO THE OWNER, BUT SHALL MAINTAIN A COPY FOR THEIR RECORDS AS STIPULATED IN 3.D. ABOVE.
- C. IMPLEMENT THE SWP3 MEASURES PRIOR TO COMMENCING CONSTRUCTION ACTIVITIES THAT RESULT IN SOIL DISTURBANCE AT ANY TIME DURING THE PROJECT DURATION UNTIL RE-VEGETATION HAS OCCURRED.
- D. RETAIN THE SWP3 NOTEBOOK ON-SITE AT THE CONSTRUCTION SITE OR, IF THE SITE IS INACTIVE OR DOES NOT HAVE AN ON-SITE LOCATION TO STORE THE PLAN, A NOTICE MUST BE POSTED DESCRIBING THE LOCATION OF THE SWP3.
- E. MAKE THE SWP3 NOTEBOOK READILY AVAILABLE AT THE TIME OF AN ON-SITE INSPECTION TO: THE EXECUTIVE DIRECTOR, A FEDERAL, STATE, OR LOCAL AGENCY APPROVING SEDIMENT AND EROSION PLANS, GRADING PLANS, OR STORM WATER MANAGEMENT PLANS, LOCAL GOVERNMENT OFFICIALS, AND THE OPERATOR OF A MS4 RECEIVING DISCHARGES FROM THE SITE.
- F. KEEP CURRENT AND UPDATE THE SWP3 AS NECESSARY FOR THE FOLLOWING CONDITIONS:
  - 1. NEW OPERATORS OR AREAS OF RESPONSIBILITY.
  - 2. CHANGES IN BEST MANAGEMENT PRACTICES.
  - 3. CHANGES IN THE DESIGN, CONSTRUCTION, OPERATION, OR MAINTENANCE THAT HAS A SIGNIFICANT EFFECT ON THE DISCHARGE OF POLLUTANTS AND THAT HAS NOT BEEN PREVIOUSLY ADDRESSED BY THE SWP3.
  - 4. RESULTS OF INSPECTIONS OR INVESTIGATIONS BY SITE OPERATORS, OPERATORS OF A MS4 RECEIVING THE DISCHARGE, AUTHORIZED TCEQ PERSONNEL, OR A FEDERAL, STATE, OR LOCAL AGENCY APPROVING SEDIMENT AND EROSION PLANS INDICATE THE SWP3 IS PROVIDING INEFFECTIVE IN ELIMINATING OR SIGNIFICANTLY MINIMIZING POLLUTANTS IN DISCHARGES AUTHORIZED UNDER THE TPDES GENERAL PERMIT.
  - 5. CHANGES APPLICABLE TO PROTECTING SURFACE WATER RESOURCES IN SEDIMENT EROSION SITE PLANS OR SITE PERMITS, OR STORM WATER MANAGEMENT SITE PLANS OR SITE PERMITS APPROVED BY STATE OR LOCAL OFFICIAL FOR WHICH THE PERMITTEE RECEIVES WRITTEN NOTICE.
- G. ENSURE THAT THE SWP3 FOR PORTIONS OF THE PROJECT WHERE THEY ARE OPERATORS MEETS THE REQUIREMENTS OF THE TPDES GENERAL PERMIT AND ARE CONSISTENT WITH REQUIREMENTS SPECIFIED IN APPLICABLE SEDIMENT AND EROSION SITE PLANS OR SITE PERMITS, OR STORM WATER MANAGEMENT SITE PLANS OR SITE PERMITS APPROVED BY FEDERAL, STATE, OR LOCAL OFFICIALS.
- H. ENSURE THAT THE SWP3 IDENTIFIES THE PARTIES RESPONSIBLE FOR IMPLEMENTATION OF BMPs DESCRIBED IN THE PLAN.
- I. ENSURE THAT THE SWP3 INDICATES THE AREAS OF THE PROJECT WHERE THEY HAVE OPERATIONAL CONTROL.
- J. ENSURE THAT THE SWP3 FOR PORTIONS OF THE PROJECT WHERE THEY ARE OPERATORS INDICATES THE NAME AND TPDES PERMIT NUMBERS FOR PERMITTEES WITH THE DAY-TO-DAY OPERATIONAL CONTROL OVER THOSE ACTIVITIES NECESSARY TO ENSURE COMPLIANCE WITH THE SWP3 AND OTHER PERMIT CONDITIONS.
- K. MAINTAIN ALONG WITH THE EFFECTIVE COPY OF SWP3 DRAWINGS AN UPDATEABLE LIST OF ALL CONSTRUCTION AND WASTE MATERIALS TO BE STORED ON-SITE, AND A DESCRIPTION OF THE LOCATION. A WORKSHEET IS PROVIDED IN THE PLANS.

- L. MAINTAIN ALONG WITH THE SIGNED EFFECTIVE COPY OF SWP3 DRAWINGS AN UPDATEABLE LIST IDENTIFYING ALL POTENTIAL SOURCES OF POLLUTION INCLUDING PORTA-POTTYS, FUEL TANKS, STAGING AREAS, WASTE CONTAINERS, CHEMICAL STORAGE AREAS, CONCRETE CURE, PAINTS SOLVENTS, ETC., AND A DESCRIPTION OF THE LOCATION. A WORKSHEET IS PROVIDED IN THE PLANS.
- M. MAINTAIN ALONG WITH THE SIGNED EFFECTIVE COPY OF SWP3 DRAWINGS AN UPDATEABLE LIST IDENTIFYING GOOD HOUSEKEEPING PRACTICES IMPLEMENTED TO LIMIT THE OFF-SITE TRANSPORT OF LITTER, CONSTRUCTION DEBRIS, AND CONSTRUCTION MATERIALS, AND A DESCRIPTION OF THE LOCATION. A WORKSHEET IS PROVIDED IN THE PLANS.
- N. MAINTAIN ALONG WITH THE SIGNED EFFECTIVE COPY OF SWP3 DRAWINGS AN UPDATEABLE LIST IDENTIFYING ALL ELIGIBLE NON-STORM WATER DISCHARGES AND ENSURE THE IMPLEMENTATION OF APPROPRIATE POLLUTION PREVENTION MEASURES. A WORKSHEET IS PROVIDED IN THE PLANS.
- O. MAINTAIN ALONG WITH THE SIGNED EFFECTIVE COPY OF THE SWP3 A RECORD OF THE DATES OF MAJOR GRADING ACTIVITIES, THE DATES CONSTRUCTION IS TEMPORARILY OR PERMANENTLY CEASED, AND THE DATES STABILIZATION MEASURES ARE INITIATED. A WORKSHEET IS PROVIDED IN THE PLANS.

6. BATCH PLANT PERMITS:

THIS SWP3 DOES NOT ADDRESS PERMITTING OF ON-SITE OR OFF-SITE BATCH PLANTS. THE SWP3 MAY INDICATE LOCATIONS WHERE BATCH PLANTS CAN BE SET UP ON THE SITE APPROVED BY THE OWNER, BUT THE CONTRACTOR SHALL OBTAIN HIS OWN SEPARATE PERMITS THROUGH THE TCEQ. CONSTRUCTION SITE OPERATORS SHOULD ALSO BE AWARE OF TEXAS 401 CERTIFICATION SPECIAL PERMIT CONDITIONS CONTAINED IN THE EPA REGION 6 CGP. THESE SPECIAL PERMIT CONDITIONS ADDRESS SPECIAL NUMERIC LIMITATIONS FOR DISCHARGES FROM READY-MIXED CONCRETE PLANTS (ALSO FOUND IN VOLUME 63 OF THE FEDERAL REGISTER ON PAGE 36511). THE CONTRACTOR SHALL FORWARD A COPY OF THE PERMIT, SWP3 PLANS, AND ANY REVISIONS OF SAME TO THE OWNER'S ENGINEER OR PROJECT MANAGER WITHIN 48 HOURS OF RECEIPT OF PERMITS OR REVISIONS TO SWP3 PLANS. PERMITTING FOR BATCH PLANT SITES SHALL BE INCIDENTAL WORK AT NO EXTRA COST TO THE OWNER. IT SHALL BE THE CONTRACTOR'S RESPONSIBILITY TO ACT AS OPERATOR AND ASSURE FULL COMPLIANCE WITH THE BATCH PLANT SITE.

7. RELATED OFF-SITE ACTIVITIES:

IF THE CONTRACTOR ELECTS TO CREATE NEW OFF-SITE MATERIAL STORAGE AREAS, STOCKPILES OF DIRT/TOPSOIL, BORROW AREAS, VEHICLE REPAIR AREAS, FUELING AREAS, ETC. CREATED SOLELY FOR OR BY THE PERMITTED PROJECT, THESE SITES SHALL COMPLY WITH TCEQ REGULATIONS FOR STORM WATER POLLUTION PREVENTION. THE CONTRACTOR AT NO ADDITIONAL COST TO THE OWNER SHALL PROVIDE DOCUMENTATION TO THE OWNER OR THE OWNER'S PROJECT REPRESENTATIVE THAT THE OFFSITE ACTIVITIES ARE PERMITTED IF REQUIRED BY TCEQ REGULATIONS. VERIFICATION OF PROPER OFF-SITE PERMITTING BY THE CONTRACTOR MUST BE PROVIDED AT LEAST 48 HOURS IN ADVANCE OF THE CONTRACTOR INCORPORATING THE SITE INTO SERVICE FOR THE SUBJECT PROJECT.

8. SIGN & NOTICE POSTINGS:

ALL SITE OPERATORS SHALL CERTIFY AND POST A CONSTRUCTION SITE NOTICE IN COMPLIANCE WITH PART II.D.2 AND PART II.D.3 OF THE TPDES GENERAL PERMIT NUMBER TXR150000.


ON SMALL PROJECT SITES WITH ONE TO LESS THAN FIVE ACRES OF DISTURBANCE, THE CONTRACTOR MUST POST CERTIFIED CONSTRUCTION SITE NOTICE(S) IN A LOCATION WHERE IT IS READILY AVAILABLE FOR VIEWING BY THE GENERAL PUBLIC, LOCAL, STATE, AND FEDERAL AUTHORITIES, PRIOR TO COMMENCING CONSTRUCTION ACTIVITIES, AND MAINTAIN THE NOTICE IN THAT LOCATION UNTIL COMPLETION OF THE CONSTRUCTION ACTIVITY. IF THERE IS NO LOCATION TO STORE THE SWP3 AT THE SITE, THE CONSTRUCTION SITE NOTICE MUST IDENTIFY THE LOCATION WHERE A SWP3 CAN BE READILY OBTAINED FOR VIEWING ALONG WITH CONTACT INFORMATION.

ON LARGE PROJECT SITES WITH 5 OR MORE ACRES OF DISTURBANCE, THE CONSTRUCTION SITE NOTICE(S) AND N.O.I.(S) MUST BE POSTED IN A LOCATION WHERE IT IS READILY AVAILABLE FOR VIEWING NEAR THE MAIN ENTRANCE OF THE CONSTRUCTION SITE PRIOR TO COMMENCING CONSTRUCTION ACTIVITIES, AND MAINTAIN THE NOTICE IN THAT LOCATION UNTIL COMPLETION OF THE CONSTRUCTION ACTIVITY. THE CONSTRUCTION SITE NOTICE SHALL CONTAIN THE INFORMATION BELOW:

- (A) TPDES GENERAL PERMIT NUMBER FOR THE PROJECT OR A COPY OF THE N.O.I. IF A PERMIT NUMBER HAS NOT YET BEEN ASSIGNED.
- (B) NAME AND TELEPHONE NUMBER OF A REPRESENTATIVE FOR THE OPERATOR.
- (C) BRIEF DESCRIPTION OF THE PROJECT.
- (D) LOCATION OF THE SWP3 ON OR OFF-SITE.

LINEAR CONSTRUCTION SITES SHALL POST CONSTRUCTION SITE NOTICE IN A PUBLICLY ACCESSIBLE LOCATION NEAR WHERE CONSTRUCTION IS ACTIVELY UNDERWAY. NOTICE FOR THESE LINEAR SITES MAY BE RELOCATED, AS NECESSARY, ALONG THE LENGTH OF THE PROJECT. THE NOTICE MUST BE READILY AVAILABLE FOR VIEWING BY THE GENERAL PUBLIC, LOCAL, STATE, AND FEDERAL AUTHORITIES, AND CONTAIN ALL INFORMATION REQUIRED ABOVE.

PREPARED BY:  
**VIA WIER & ASSOCIATES, INC.**  
 ENGINEERS SURVEYORS LAND PLANNERS  
 4300 BELTWAY PLACE SUITE 130 ARLINGTON, TEXAS 76018 METRO (817)467-7700  
 1380 U.S. HIGHWAY 287 N. SUITE 101 WAXFORD, TEXAS 76693 METRO (817)477-8700  
 6849 ELM STREET FORT COCK, TEXAS 75034 METRO (214)387-8000  
[www.viawier.com](http://www.viawier.com)

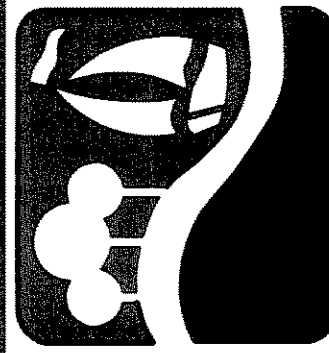

**PHASE I S.H. 205 BYPASS  
 FROM S.H. 276 TO INTERSTATE 30  
 SWP3 - STORM WATER  
 POLLUTION PREVENTION NOTES**

STATE OF TEXAS  
  
**PHILIP L. GRAHAM**  
 84718  
 LICENSED PROFESSIONAL ENGINEER

COPYRIGHT ©  
 WIER & ASSOCIATES, INC.  
 LAST SHEET EDIT  
 DATE 08-23-2006  
 WA# 04141

**RECORD PLANS  
 MARCH 28, 2008**

**SHEET NO.  
 E001**



9. EROSION AND SEDIMENT CONTROLS:

REFER TO THE SWP3 LAYOUT PLAN AND DETAILS FOR A DESCRIPTION OF THE BMPs THAT WILL BE USED TO RETAIN SEDIMENT ON-SITE. REFER TO THE SITE AND OR PROJECT DESCRIPTION DATA IN THESE NOTES FOR A GENERAL TIMING OR SEQUENCE FOR IMPLEMENTATION.

EROSION CONTROL FACILITIES SHALL BE INSTALLED AND MAINTAINED ON THE SITE DURING ALL PHASES OF CONSTRUCTION UNTIL PAVING IS COMPLETE AND VEGETATION ESTABLISHED ON OPEN AREAS. THE METHODS AND SEQUENCE OF IMPROVEMENTS AS DESCRIBED HEREIN SHALL BE CONSIDERED MINIMUM IMPROVEMENTS. THE CONTRACTORS SEQUENCE OF CONSTRUCTION AND WEATHER CONDITIONS MAY DICTATE CONSTRUCTION OF DIFFERENT STORM WATER MANAGEMENT FACILITIES. COORDINATE WITH THE ENGINEER IF SUBSTANTIALLY DIFFERENT METHODS AND FACILITIES ARE ANTICIPATED AT ANY TIME DURING CONSTRUCTION.

TECHNIQUES TO BE USED: TECHNIQUES TO BE USED SHALL BE AS INDICATED BY THE STORM WATER POLLUTION PREVENTION PLAN AND DETAILS. THE GOALS FOR CONTROLLING EROSION SHALL COMPLY WITH THIS PLAN AND SPECIFICATIONS AND SHALL INCLUDE THE FOLLOWING:

- A. WHERE FEASIBLE AND COST EFFECTIVE DIVERT UPSLOPE WATER AROUND DISTURBED AREAS.
- B. LIMIT THE EXPOSURE OF DISTURBED AREAS TO THE SHORTEST DURATION POSSIBLE.
- C. REMOVE SEDIMENT FROM STORM WATER BEFORE IT LEAVES THE SITE BY STABILIZATION OR STRUCTURAL METHODS.

THE CONTRACTOR SHALL MAINTAIN ALONG WITH THE SIGNED EFFECTIVE COPY OF SWP3 DRAWINGS AN UPDATEABLE LIST IDENTIFYING GOOD HOUSEKEEPING PRACTICES IMPLEMENTED TO LIMIT THE OFF-SITE TRANSPORT OF LITTER, CONSTRUCTION DEBRIS, AND CONSTRUCTION MATERIALS.

10. STABILIZATION PRACTICES:

REFER TO THE SWP3 LAYOUT PLAN FOR A DESCRIPTION OF INTERIM AND PERMANENT STABILIZATION PRACTICES FOR THE SITE, INCLUDING A SCHEDULE OF WHEN THE PRACTICES WILL BE IMPLEMENTED.

STABILIZATION PRACTICES SHALL INCLUDE THE FOLLOWING:

- A. PRESERVE EXISTING VEGETATION WHERE POSSIBLE.
- B. STABILIZE DISTURBED AREAS AS SOON AS POSSIBLE, BUT NO MORE THAN 14 DAYS AFTER CONSTRUCTION ACTIVITY HAS CEASED UNLESS CONSTRUCTION WILL RESUME ON THE PORTION OF THE SITE WITHIN 21 DAYS.
- C. PERMANENT STABILIZATION TECHNIQUES SHALL BE AS IDENTIFIED ON THE PLANS. INTERIM STABILIZATION METHODS MAY INCLUDE TEMPORARY SEEDING, PERMANENT SEEDING, MULCHING, GEOTEXTILES, SOD STABILIZATION, VEGETATION BUFFER STRIPS, PRESERVATION OF MATURE VEGETATIVE BUFFER STRIPS, AND OTHER APPROPRIATE MEASURES. IF CLEARING OF TREES OCCURS ON THE SITE AND MULCHING IS TO BE USED, THE CONTRACTOR MUST CONTACT THE PROJECT ENGINEER TO CONSIDER FEASIBLE AREAS WHERE MULCH CAN BE USED FOR TEMPORARY EROSION CONTROL.

THE CONTRACTOR SHALL MAINTAIN ALONG WITH THE SIGNED EFFECTIVE COPY OF THE SWP3 A RECORD OF THE DATES OF MAJOR GRADING ACTIVITIES, THE DATES CONSTRUCTION IS TEMPORARILY OR PERMANENTLY CEASED, AND THE DATES STABILIZATION MEASURES ARE INITIATED.

11. STRUCTURAL CONTROL PRACTICES:

REFER TO THE SWP3 LAYOUT PLAN AND DETAILS FOR A DESCRIPTION, ENGINEERING CALCULATIONS AND SPECIFIC LOCATION OF ANY STRUCTURAL CONTROL PRACTICES USED TO DIVERT FLOWS AWAY FROM EXPOSED SOILS, TO LIMIT THE CONTACT OF RUNOFF WITH DISTURBED AREAS, OR TO LESSEN THE OFF-SITE TRANSPORT OF ERODED SOILS.

12. PERMANENT STORM WATER CONTROLS:

REFER TO THE SWP3 LAYOUT PLAN AND DETAILS FOR A DESCRIPTION AND SPECIFIC LOCATION OF ANY MEASURES THAT WILL BE INSTALLED DURING THE CONSTRUCTION PROCESS TO CONTROL POLLUTANTS IN STORM WATER DISCHARGES THAT WILL OCCUR AFTER CONSTRUCTION OPERATIONS HAVE BEEN COMPLETED.

13. OTHER CONTROLS:

- A. MATERIAL STORAGE: STORE ONLY ENOUGH OF A MATERIAL TO DO THE JOB. KEEP MATERIALS IN ORIGINAL CONTAINER IF POSSIBLE. WHEN NOT POSSIBLE, ORIGINAL LABEL SHALL BE KEPT WITH THE PRODUCT. CONTRACTOR SHALL MAINTAIN ALONG WITH THE EFFECTIVE COPY OF SWP3 DRAWINGS AN UPDATEABLE LIST OF ALL MATERIALS TO BE STORED ON-SITE, AND A DESCRIPTION OF THE LOCATION.
- B. FUEL & EQUIPMENT MAINTENANCE AND STORAGE: WHERE FUELS ARE STORED, MAINTENANCE OF EQUIPMENT AND LUBRICATING MAINTENANCE ARE PROVIDED ON THE SITE, THE AREA (FUELING OR LUBRICATING) SHALL CONTAIN A MINIMUM 18" BERM AND PLASTIC COVER TO PREVENT STORM WATER FROM CARRYING PETRO CHEMICAL PRODUCTS INTO STORM WATER OR SOILS. VEHICLES ARE TO RECEIVE REGULAR PREVENTIVE MAINTENANCE. IF LOCATION IS PAVEMENT, A 6' HIGH TEMPORARY CONCRETE CURB MAY BE PLACED AROUND THE FUEL SITE IN LIEU OF EARTHEN BERM.
- C. PROVIDE COVERED PROTECTED AREAS FOR STORAGE OF CHEMICALS, PAINTS, SOLVENTS, FERTILIZERS, AND OTHER POTENTIALLY TOXIC MATERIALS SUCH THAT MATERIALS ARE NOT IN CONTACT WITH STORM WATER. MATERIALS SHALL BE APPLIED ONLY IN THE MINIMUM AMOUNTS RECOMMENDED BY MANUFACTURER.

- D. IF PUBLIC SANITARY FACILITIES ARE NOT AVAILABLE, PROVIDE SELF CONTAINED SANITARY FACILITIES AT THE CONSTRUCTION SITE FOR COLLECTION OF HUMAN WASTE. MAINTAIN FACILITIES AT REGULAR INTERVAL TO PREVENT OVERFLOW.
- E. VEHICLE TRACKING: THE MAJORITY OF THIS PROJECT IS LINEAR CONSTRUCTION. CONSTRUCTION WILL BE ACCESSED FROM STATE HIGHWAY No. 276 AND INTERSTATE HIGHWAY No. 30 EASTBOUND FRONTAGE ROAD ADJACENT TO THE SITE.
- F. DUST CONTROL: THE DISTURBED AREAS ON SITE SHALL BE REGULARLY WATERED DURING DRY PERIODS TO PREVENT DUST LEAVING THE SITE.

14. THE CONTRACTOR SHALL PERFORM CONSTRUCTION OPERATIONS IN ACCORDANCE WITH BEST MANAGEMENT PRACTICES TO CONTROL POLLUTANTS IN STORM WATER DISCHARGES DURING CONSTRUCTION. THE CONTRACTOR SHALL CONFORM TO THE APPLICABLE LOCAL, STATE AND FEDERAL REGULATIONS TO CONTROL STORM WATER POLLUTANTS, AND TO CONTROL EROSION AND SEDIMENT FROM LEAVING THE SITE, INCLUDING DUST AND LITTER CONTROL. TRASH RECEPTACLES SHALL BE PROVIDED ON-SITE AND EMPTIED AT REGULAR INTERVALS.

15. THE CONTRACTOR SHALL LIMIT THE AREAS DISTURBED ON THE PROJECT SITE TO THE AREA NECESSARY FOR CONSTRUCTION OF THE PROPOSED IMPROVEMENTS. THE CONTRACTOR SHALL PREVENT PERSONNEL, SUPPLIERS, AND SUBCONTRACTORS FROM DISTURBING AREAS OUTSIDE OF DESIGNATED CONSTRUCTION AREAS.

16. TECHNICAL BASIS USED:

THE CONTRACTOR SHALL UTILIZE THE LATEST COPY OF THE NORTH CENTRAL TEXAS COUNCIL OF GOVERNMENT'S STORM WATER MANAGEMENT HANDBOOK AS A GUIDE FOR THE PROPOSED STORM WATER MANAGEMENT FACILITIES AND TECHNIQUES. THE CONTRACTOR SHALL USE THE DETAILS PROVIDED FOR BUILDING THE SPECIFIED EROSION & SEDIMENTATION CONTROL STRUCTURES. THE CONTRACTOR SHALL ALSO REFER TO CONTRACT DOCUMENTS FOR TECHNICAL EVALUATION OF THESE STRUCTURES. IF SUCH STRUCTURES DO NOT MEET STANDARDS, THE ENGINEER SHALL BE CONTACTED IMMEDIATELY AND THE SITUATION REMEDIATED. CALL (817)640-3300 FOR MORE INFORMATION PERTAINING TO THE ABOVE REFERENCED HANDBOOK.

17. MAINTENANCE:

MAINTENANCE OF EROSION CONTROL FACILITIES SHALL CONSIST OF THE MINIMUM REQUIREMENTS AS FOLLOWS:

- A. IN ONGOING CONSTRUCTION AREAS INSPECT EROSION CONTROL IMPROVEMENTS TO CONFIRM FACILITIES ARE IN PLACE AND OPERABLE. WHERE FACILITIES HAVE BEEN TEMPORARILY SET ASIDE OR DAMAGED DUE TO CONSTRUCTION ACTIVITY, PLACE FACILITIES IN SERVICE BEFORE LEAVING JOB SITE.
- B. IF WEATHER FORECAST PREDICTS POSSIBILITY OF RAIN, CHECK ENTIRE FACILITIES THROUGHOUT SITE TO ASSURE FACILITIES ARE IN PLACE AND OPERABLE. IF JOB SITE WEATHER CONDITIONS INDICATE HIGH PROBABILITY OF RAIN, MAKE SPECIAL INSPECTION OF EROSION CONTROL FACILITIES.
- C. AFTER RAINFALL EVENTS REVIEW EROSION CONTROL FACILITIES AS SOON AS SITE IS ACCESSIBLE. CLEAN INLET PROTECTION, SILT PONDS, ROCK BERMS, BERM/SWALES AND OTHER STRUCTURAL FACILITIES. DETERMINE WHERE ADDITIONAL FACILITIES OR ALTERNATIVE TECHNIQUES ARE NEEDED TO CONTROL SEDIMENT LEAVING SITE.
- D. AFTER PORTIONS OF SITE HAVE BEEN SEEDED, REVIEW THESE AREAS ON REGULAR BASIS IN ACCORDANCE WITH PROJECT SPECIFICATIONS TO ASSURE PROPER WATERING UNTIL GRASS IS ESTABLISHED. RESEED AREAS WHERE GRASS IS NOT WELL ESTABLISHED.
- E. SPILLS ARE TO BE HANDLED AS SPECIFIED BY THE MANUFACTURER OF THE PRODUCT IN A TIMELY SAFE MANNER BY PERSONNEL. THE SITE SUPERINTENDENT WILL BE RESPONSIBLE FOR COORDINATING SPILL PREVENTION AND CLEANUP OPERATIONS.
- F. CONCRETE TRUCKS WILL DISCHARGE EXTRA CONCRETE OR WASH OUT DRUM ONLY AT AN APPROVED LOCATION ON SITE. RESIDUAL PRODUCT SHALL BE PROPERLY DISPOSED OF.
- G. INSPECT VEHICLE ENTRANCE AND EXITS FOR EVIDENCE OF OFF-SITE TRACKING AND CORRECT AS NEEDED.
- H. VEHICLE WASH AREAS WILL BE INSPECTED TO INSURE PROPER DRAINAGE AND MAINTENANCE.
- I. REMOVE SEDIMENT FROM TRAPS/PONDS NO LATER THAN WHEN THE DESIGN CAPACITY HAS BEEN REDUCED BY 50%.
- J. IF SEDIMENT ESCAPES THE SITE, THE CONTRACTOR WHERE FEASIBLE AND WHERE ACCESS IS AVAILABLE SHALL COLLECT AND REMOVE SEDIMENTATION MATERIAL BY APPROPRIATE NON-DAMAGING METHODS. ADDITIONALLY, THE CONTRACTOR SHALL CORRECT THE CONDITION CAUSING DISCHARGES.
- K. IF INSPECTIONS OR OTHER INFORMATION SOURCES REVEAL A CONTROL HAS BEEN USED INCORRECTLY, OR THAT A CONTROL IS PERFORMING INADEQUATELY, THE CONTRACTOR MUST REPLACE, CORRECT OR MODIFY THE CONTROL AS SOON AS PRACTICAL AFTER DISCOVERY OF THE DEFICIENCY.

18. INSPECTION:

INSPECTIONS SHALL BE CONDUCTED BY QUALIFIED REPRESENTATIVES OF THE CONTRACTOR ACTING ON BEHALF OF THE OWNER OR A DESIGNATED PARTY IF HIRED SEPARATELY BY THE OWNER. EACH OPERATOR MUST DELEGATE AUTHORITY TO THE SPECIFICALLY DESCRIBED POSITION OR PERSON PERFORMING INSPECTIONS, AS PROVIDED BY 30 TAC 305.128, AS AN AUTHORIZED PERSON FOR SIGNING REPORTS AND PERFORMING CERTAIN ACTIVITIES REQUESTED BY THE DIRECTOR OR REQUIRED BY THE TPDES GENERAL PERMIT. THIS DELEGATION OF AUTHORITY MUST BE PROVIDED TO THE DIRECTOR OF TCEQ IN WRITING AND A COPY SHALL BE KEPT ALONG WITH THE SIGNED EFFECTIVE COPY OF THE SWP3. AN EXAMPLE DELEGATION LETTER IS PROVIDED IN THE CONTRACT DOCUMENTS.

INSPECTIONS MUST COMPLY WITH ONE OF THE TWO OPTIONS AS FOLLOWS:

OPTION A. AN INSPECTION SHALL OCCUR AT LEAST ONCE EVERY FOURTEEN (14) CALENDAR DAYS AND WITHIN 24 HOURS AFTER ANY STORM EVENT OF GREATER THAN 0.5 INCHES.

OPTION B. AN INSPECTION EVERY SEVEN (7) CALENDAR DAYS (THE SAME DAY FOR THE INSPECTION MUST OCCUR EACH WEEK REGARDLESS OF WEATHER CONDITIONS).

THE AUTHORIZED PARTY SHALL INSPECT ALL DISTURBED AREAS OF THE SITE, AREAS USED FOR STORAGE OF MATERIALS THAT ARE EXPOSED TO PRECIPITATION, STRUCTURAL CONTROL MEASURES, AND LOCATIONS WHERE VEHICLES ENTER OR EXIT THE SITE.

DISTURBED AREAS AND AREAS USED FOR STORAGE OF MATERIALS THAT ARE EXPOSED TO PRECIPITATION MUST BE INSPECTED FOR EVIDENCE OF, OR THE POTENTIAL FOR, POLLUTANTS ENTERING THE RUNOFF FROM THE SITE. EROSION AND SEDIMENT CONTROL MEASURES IDENTIFIED IN THE PLAN MUST BE OBSERVED TO ENSURE THAT THEY ARE OPERATING CORRECTLY. OBSERVATIONS CAN BE MADE DURING WET OR DRY WEATHER CONDITIONS. WHERE DISCHARGE LOCATIONS OR POINTS ARE ACCESSIBLE, THEY MUST BE INSPECTED TO ASCERTAIN WHETHER EROSION CONTROL MEASURES ARE EFFECTIVE IN PREVENTING SIGNIFICANT IMPACTS TO RECEIVING WATERS. THIS CAN BE DONE BY INSPECTING RECEIVING WATERS TO SEE WHETHER ANY SIGNS OR EROSION OR SEDIMENT ARE ASSOCIATED WITH THE DISCHARGE LOCATION. LOCATIONS WHERE VEHICLES ENTER OR EXIT THE SITE MUST BE INSPECTED FOR EVIDENCE OF OFF-SITE SEDIMENT TRACKING.

BASED ON THE RESULTS OF THE INSPECTION, THE SITE DESCRIPTION AND THE POLLUTION PREVENTION MEASURES IDENTIFIED IN THE PLAN MUST BE REVISED AS SOON AS POSSIBLE AFTER AN INSPECTION THAT REVEALS INADEQUACIES. THE INSPECTION AND PLAN REVIEW PROCESS MUST PROVIDE FOR TIMELY IMPLEMENTATION OF ANY CHANGES TO THE PLAN WITH 7 CALENDAR DAYS FOLLOWING THE INSPECTION.

AN INSPECTION REPORT THAT SUMMARIZES THE SCOPE OF THE INSPECTION, NAME(S) AND QUALIFICATIONS OF PERSONNEL CONDUCTING THE INSPECTION, THE DATES OF THE INSPECTION, MAJOR OBSERVATIONS RELATING TO THE IMPLEMENTATION OF THE SWP3. MAJOR OBSERVATIONS SHALL INCLUDE AS A MINIMUM LOCATION OF DISCHARGES OF SEDIMENT OR OTHER POLLUTANTS FROM THE SITE, LOCATION OF BMPs THAT NEED TO BE MAINTAINED, LOCATION OF BMPs THAT FAILED TO OPERATE AS DESIGNED OR PROVED INADEQUATE FOR A PARTICULAR LOCATION, AND LOCATIONS WHERE BMPs ARE NEEDED. ACTIONS TAKEN AS A RESULT OF THE INSPECTIONS MUST BE DESCRIBED WITHIN, AND RETAINED AS A PART OF, THE SWP3. REPORTS MUST IDENTIFY ANY INCIDENTS OF NON-COMPLIANCE. WHERE A REPORT DOES NOT IDENTIFY ANY INCIDENTS OF NON-COMPLIANCE, THE REPORT MUST CONTAIN A CERTIFICATION THAT THE FACILITY OR SITE IS IN COMPLIANCE WITH THE SWP3 AND THE TPDES GENERAL PERMIT. THE REPORT MUST BE SIGNED BY THE AUTHORIZED REPRESENTATIVE DELEGATED BY THE OPERATORS IN ACCORDANCE WITH TAC 305.128.

19. ELIGIBLE NON-STORM WATER DISCHARGE:


THE CONTRACTOR SHALL MAINTAIN ALONG WITH THE SIGNED EFFECTIVE COPY OF SWP3 DRAWINGS AN UPDATEABLE LIST IDENTIFYING ALL ELIGIBLE NON-STORM WATER DISCHARGES AND ENSURE THE IMPLEMENTATION OF APPROPRIATE POLLUTION PREVENTION MEASURES. A LISTING OF ELIGIBLE NON-STORM WATER DISCHARGE IS PROVIDED IN THE CONTRACT DOCUMENTS.

20. RETENTION OF RECORDS:


THE CONTRACTOR MUST RETAIN THE FOLLOWING RECORDS FOR A MINIMUM OF THREE YEARS FROM THE DATE THAT AN N.O.T. IS SUBMITTED. ON SMALL PROJECT SITES WHERE AN N.O.T. IS NOT REQUIRED, RECORDS SHALL BE KEPT FOR A PERIOD OF LEAST THREE YEARS FROM THE DATE OF FINAL STABILIZATION OR CHANGE OF OPERATOR. THE ORIGINALS SHALL BE FORWARDED TO THE OWNER.

- A. A COPY OF THE SWP3 PLAN.
- B. ALL REPORTS AND ACTIONS REQUIRED BY THE TPDES GENERAL PERMIT, INCLUDING A COPY OF THE CONSTRUCTION SITE NOTICE.
- C. ALL DATA USED TO COMPLETE THE N.O.I., IF AN N.O.I. IS REQUIRED.

PREPARED BY:  
**VIA WIER & ASSOCIATES, INC.**  
 ENGINEERS SURVEYORS LAND PLANNERS  
 4300 BELTWAY PLACE SUITE 130 ARLINGTON, TEXAS 76018 METRO (817)467-7700  
 1380 U.S. HIGHWAY 287 N. SUITE 101 WAXFIELD, TEXAS 76063 METRO (817)467-8700  
 6849 ELM STREET FROSCO, TEXAS 75034 METRO (214)387-8800  
 www.wierassociates.com

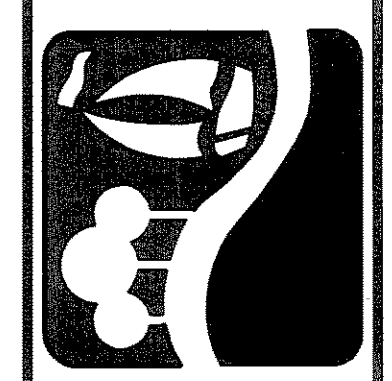

PHASE I SH. 205 BYPASS  
 FROM SH. 276 TO INTERSTATE 30  
 SWP3 - STORM WATER  
 POLLUTION PREVENTION NOTES

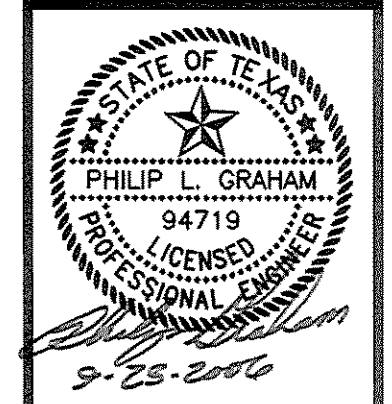

RECORD PLANS  
 MARCH 28, 2008

COPYRIGHT ©  
 WIER & ASSOCIATES, INC.  
 LAST SHEET EDIT  
 DATE 08-23-2008  
 WA# 0414  
 SHEET NO.  
 E002

SITE AND OR PROJECT DESCRIPTION DATA

1. NATURE OF THE CONSTRUCTION ACTIVITY:  
THE CONSTRUCTION ACTIVITY CONSISTS OF GRADING, DRAINAGE, WATER AND PAVING IMPROVEMENTS TO CONVERT THE SITE FROM OPEN PROPERTY TO DIVIDED BOULEVARD STREET.
2. POTENTIAL POLLUTANTS AND SOURCES:  
THE POTENTIAL SOURCES OF POLLUTION IDENTIFIED CONSIST OF STORM WATER RUNOFF FROM CONSTRUCTION ACTIVITIES. THERE ARE NO NON-STORM WATER DISCHARGES THAT ARE KNOWN TO EXIST AT THIS SITE. A SELF CONTAINED PORTABLE FACILITY WILL BE KEPT ON-SITE DURING CONSTRUCTION FOR HUMAN WASTE. CONSTRUCTION FUEL STORAGE IS NOT ANTICIPATED TO BE PROVIDED AT THE SITE. IF FUEL IS STORED AT THE SITE A BERM WILL BE PLACED AROUND THE FUEL TANK.  
  
CONTRACTOR SHALL MAINTAIN ALONG WITH THE SIGNED EFFECTIVE COPY OF SWP3 DRAWINGS AN UPDATEABLE LIST IDENTIFYING ALL POTENTIAL SOURCES OF POLLUTION INCLUDING PORTA-POTTYS, FUEL TANKS, STAGING AREAS, WASTE CONTAINERS, CHEMICAL STORAGE AREAS, CONCRETE CURE, PAINTS SOLVENTS, ETC., AND A DESCRIPTION OF THE LOCATION.
3. SEQUENCE OF MAJOR CONSTRUCTION ACTIVITIES:  
THE PROJECT SEQUENCE SHALL GENERALLY CONFORM TO THE FOLLOWING:  
PHASE I START DATE: _____ END DATE: _____  
A. CONSTRUCT TEMPORARY CONSTRUCTION ENTRANCE, ROCK BERMS, BERMS/SWALES AND SILT FENCE ACCORDING TO THE APPROXIMATE LOCATION AND DETAIL SHOWN ON EROSION CONTROL PLAN SHEETS AND SWP3 PLAN AND DETAILS.  
B. BEGIN CLEARING AND GRADING OF SITE.  
C. SEED AND RE-VEGETATE SLOPES WHERE SHOWN.  
PHASE II START DATE: _____ END DATE: _____  
A. KEEP ALL STORM WATER POLLUTION PREVENTION MEASURES IN PLACE.  
B. INSTALL WATER AND STORM DRAIN AS SPECIFIED ON PLAN SHEETS.  
C. CONSTRUCT PHASE I INLET PROTECTION AROUND OPEN STORM DRAIN INLETS ACCORDING TO THE DETAIL SHOWN ON SHEET E202 AND WHERE INDICATED ON EROSION CONTROL PLAN SHEETS E102 AND E103.  
D. CONSTRUCT ALL STORM WATER POLLUTION PREVENTION DEVICES SHOWN ON PLAN SHEETS E102 AND E103 FOR PHASE TWO CONSTRUCTION.  
PHASE III START DATE: _____ END DATE: _____  
A. KEEP ALL STORM WATER POLLUTION PREVENTION MEASURES IN PLACE.  
B. STABILIZE SUBGRADE.  
C. PAVE STREETS AS SPECIFIED ON PLAN SHEETS.  
D. CONSTRUCT STORM DRAIN PHASE II INLET TREATMENT AS SPECIFIED ON EROSION CONTROL PLAN SHEETS E102 AND E103 FOR PHASE THREE CONSTRUCTION.  
E. RE-VEGETATE PARKWAYS AND ALL DISTURBED AREAS.
4. AREA ESTIMATES:  
TOTAL AREA ONSITE: 12.7 ACRES  
ESTIMATED DISTURBED AREA ON-SITE: 11.3 ACRES  
ESTIMATED DISTURBED AREA OFF-SITE: 1.1 ACRES
5. ESTIMATED RUNOFF COEFFICIENT AFTER CONSTRUCTION IS COMPLETED:  
UNDEVELOPED C = 0.35  
DEVELOPED C = 0.90
6. SOIL AND OR QUALITY OF STORM WATER DISCHARGE DATA:  
REFER TO EFFICIENCY ESTIMATES FOR STRUCTURAL METHODS ON STANDARD MEASURES.
7. SOIL TYPE AT SITE:  
NEAR SURFACE SOILS CONSIST OF DARK BROWN, BROWN, LIGHT BROWN, DARK GRAY, GRAYISH BROWN, GRAY AND REDDISH BROWN CLAYS, SILTY CLAYS, AND SHALY CLAYS. REFER TO GEOTECHNICAL REPORT BY CMJ ENGINEERING, INC. PROVIDED IN THE SPECIFICATIONS.
8. GENERAL LOCATION MAP AND DETAILED SITE MAP:  
REFER TO SWP3 LAYOUT SHEET AND GRADING PLAN SHEETS FOR DRAINAGE PATTERNS AND APPROXIMATE SLOPES ANTICIPATED AFTER MAJOR GRADING ACTIVITIES, AREAS WHERE SOIL DISTURBANCE WILL OCCUR, SOILS DISTURBANCE AREAS, STRUCTURAL CONTROL MEASURES, NATURAL VEGETATIVE FILTERING, RE-VEGETATION, IMPROVED STABILIZATION METHODS, SURFACE WATERS INCLUDING WETLANDS, DIRECT DISCHARGE POINTS TO SURFACE WATER BODIES.
9. LOCATION AND DESCRIPTION OF OFF-SITE MATERIAL, WASTE, BORROW OR EQUIPMENT STORAGE AREAS:  
-----  
-----  
-----  
-----

10. LOCATION AND DESCRIPTION OF SUPPORT ASPHALT PLANTS AND CONCRETE PLANTS:  
-----  
-----
11. RECEIVING WATER BODY DESCRIPTION:  
BUFFALO CREEK
12. WETLANDS ACREAGE:  
0.09 ACRES OF WETLANDS ARE DISTURBED IN BUFFALO CREEK BY CONSTRUCTION.
13. TPDES GENERAL PERMIT NUMBERS:  
OWNER _____  
CONTRACTOR _____  
  
N.O.I. SUBMITTAL DATES:  
OWNER _____  
CONTRACTOR _____

EROSION AND SEDIMENT CONTROLS


BMP NO. OR LOCATION	CONDITION	BMP SELECTED	EXPLANATION
1	SHEET FLOW	REINFORCED SILT FENCE	DRAINAGE AREA TO SILT FENCE = 0.18 ac. < 0.25ac. / 100 L.F. MAX. DISTANCE OF FLOW = 80 ft. < 200 ft. PREVENTS DEBRIS AND SILT FROM LEAVING SITE VIA NON-CONCENTRATED FLOW
2	CONCENTRATED FLOW IN DITCH	12" HIGH ROCK BERM	REDUCES VELOCITY OF CONCENTRATED FLOW AND TRAPS SEDIMENT
3	SUMP DROP INLET	BLOCK & GRAVEL DROP INLET PROTECTION	FLOW = 4.9 cfs PREVENTS SILT FROM UPSTREAM GRADING FROM ENTERING STORM DRAIN SYSTEM
4	SUMP DROP INLET	BLOCK & GRAVEL DROP INLET PROTECTION	FLOW = 10.3 cfs PREVENTS SILT FROM UPSTREAM GRADING FROM ENTERING STORM DRAIN SYSTEM
5	SHEET FLOW	REINFORCED SILT FENCE	DRAINAGE AREA TO SILT FENCE = 0.25 ac. < 0.25ac. / 100 L.F. MAX. DISTANCE OF FLOW = 200 ft. < 200 ft. PREVENTS DEBRIS AND SILT FROM LEAVING SITE VIA NON-CONCENTRATED FLOW
6	SHEET FLOW	REINFORCED SILT FENCE	DRAINAGE AREA TO SILT FENCE = 0.16 ac. < 0.25ac. / 100 L.F. MAX. DISTANCE OF FLOW = 70 ft. < 200 ft. PREVENTS DEBRIS AND SILT FROM LEAVING SITE VIA NON-CONCENTRATED FLOW
7	CONCENTRATED FLOW IN WIDE SWALE	ROCK CHECK DAMS @ 150' SPACING	REDUCES VELOCITY OF CONCENTRATED FLOW AND TRAPS SEDIMENT
8	ON-GRADE CURB INLET	PHASE I FILTER FABRIC INLET PROTECTION	FLOW = 2.9 cfs PREVENTS SILT FROM UPSTREAM GRADING FROM ENTERING STORM DRAIN SYSTEM
9	ON-GRADE CURB INLET	PHASE I FILTER FABRIC INLET PROTECTION	FLOW = 1.5 cfs PREVENTS SILT FROM UPSTREAM GRADING FROM ENTERING STORM DRAIN SYSTEM
10	CONCENTRATED FLOW IN CREEK	28" HIGH EXCAVATED ROCK BERM	REDUCES VELOCITY OF CONCENTRATED FLOW AND TRAPS SEDIMENT
11	CONCENTRATED FLOW IN CREEK	18" HIGH ROCK BERM	REDUCES VELOCITY OF CONCENTRATED FLOW AND TRAPS SEDIMENT
12	ON-GRADE CURB INLET	PHASE I FILTER FABRIC INLET PROTECTION	FLOW = 1.7 cfs PREVENTS SILT FROM UPSTREAM GRADING FROM ENTERING STORM DRAIN SYSTEM
13	SUMP CURB INLET	PHASE I FILTER FABRIC INLET PROTECTION	FLOW = 3.9 cfs PREVENTS SILT FROM UPSTREAM GRADING FROM ENTERING STORM DRAIN SYSTEM
14	SHEET FLOW	REINFORCED SILT FENCE	DRAINAGE AREA TO SILT FENCE = 0.18 ac. < 0.25ac. / 100 L.F. MAX. DISTANCE OF FLOW = 80 ft. < 200 ft. PREVENTS DEBRIS AND SILT FROM LEAVING SITE VIA NON-CONCENTRATED FLOW
15	ON-GRADE CURB INLET	PHASE I FILTER FABRIC INLET PROTECTION	FLOW = 5.1 cfs PREVENTS SILT FROM UPSTREAM GRADING FROM ENTERING STORM DRAIN SYSTEM
16	SHEET FLOW	REINFORCED SILT FENCE	DRAINAGE AREA TO SILT FENCE = 0.17 ac. < 0.25ac. / 100 L.F. MAX. DISTANCE OF FLOW = 75 ft. < 200 ft. PREVENTS DEBRIS AND SILT FROM LEAVING SITE VIA NON-CONCENTRATED FLOW
17	SHEET FLOW	REINFORCED SILT FENCE	DRAINAGE AREA TO SILT FENCE = 0.17 ac. < 0.25ac. / 100 L.F. MAX. DISTANCE OF FLOW = 75 ft. < 200 ft. PREVENTS DEBRIS AND SILT FROM LEAVING SITE VIA NON-CONCENTRATED FLOW
18	CONCENTRATED FLOW IN WIDE SWALE	ROCK CHECK DAMS @ 150' SPACING	REDUCES VELOCITY OF CONCENTRATED FLOW AND TRAPS SEDIMENT
19	ON-GRADE CURB INLET	PHASE I FILTER FABRIC INLET PROTECTION	FLOW = 3.5 cfs PREVENTS SILT FROM UPSTREAM GRADING FROM ENTERING STORM DRAIN SYSTEM
20	ON-GRADE CURB INLET	PHASE I FILTER FABRIC INLET PROTECTION	FLOW = 9.1 cfs PREVENTS SILT FROM UPSTREAM GRADING FROM ENTERING STORM DRAIN SYSTEM
21	ON-GRADE CURB INLET	PHASE I FILTER FABRIC INLET PROTECTION	FLOW = 2.1 cfs PREVENTS SILT FROM UPSTREAM GRADING FROM ENTERING STORM DRAIN SYSTEM
22	ON-GRADE CURB INLET	PHASE I FILTER FABRIC INLET PROTECTION	FLOW = 4.4 cfs PREVENTS SILT FROM UPSTREAM GRADING FROM ENTERING STORM DRAIN SYSTEM
23	SHEET FLOW	REINFORCED SILT FENCE	DRAINAGE AREA TO SILT FENCE = 0.12 ac. < 0.25ac. / 100 L.F. MAX. DISTANCE OF FLOW = 50 ft. < 200 ft. PREVENTS DEBRIS AND SILT FROM LEAVING SITE VIA NON-CONCENTRATED FLOW
24	SHEET FLOW	REINFORCED SILT FENCE	DRAINAGE AREA TO SILT FENCE = 0.08 ac. < 0.25ac. / 100 L.F. MAX. DISTANCE OF FLOW = 50 ft. < 200 ft. PREVENTS DEBRIS AND SILT FROM LEAVING SITE VIA NON-CONCENTRATED FLOW
25	SHEET FLOW	REINFORCED SILT FENCE	DRAINAGE AREA TO SILT FENCE = 0.08 ac. < 0.25ac. / 100 L.F. MAX. DISTANCE OF FLOW = 50 ft. < 200 ft. PREVENTS DEBRIS AND SILT FROM LEAVING SITE VIA NON-CONCENTRATED FLOW
26	SHEET FLOW	REINFORCED SILT FENCE	DRAINAGE AREA TO SILT FENCE = 0.17 ac. < 0.25ac. / 100 L.F. MAX. DISTANCE OF FLOW = 75 ft. < 200 ft. PREVENTS DEBRIS AND SILT FROM LEAVING SITE VIA NON-CONCENTRATED FLOW
27	ENTRANCE / EXIT LOCATION	STABILIZED CONSTRUCTION ENTRANCE / EXIT	PREVENTS SILT AND DEBRIS FROM LEAVING SITE VIA CONSTRUCTION EQUIPMENT
28	SHEET FLOW	REINFORCED SILT FENCE	DRAINAGE AREA TO SILT FENCE = 0.18 ac. < 0.25ac. / 100 L.F. MAX. DISTANCE OF FLOW = 80 ft. < 200 ft. PREVENTS DEBRIS AND SILT FROM LEAVING SITE VIA NON-CONCENTRATED FLOW
29	CONCENTRATED FLOW IN DITCH	12" HIGH ROCK BERM	REDUCES VELOCITY OF CONCENTRATED FLOW AND TRAPS SEDIMENT
30	SHEET FLOW	REINFORCED SILT FENCE	DRAINAGE AREA TO SILT FENCE = 0.16 ac. < 0.25ac. / 100 L.F. MAX. DISTANCE OF FLOW = 70 ft. < 200 ft. PREVENTS DEBRIS AND SILT FROM LEAVING SITE VIA NON-CONCENTRATED FLOW
31	CONCENTRATED FLOW IN DITCH	12" HIGH ROCK BERM	REDUCES VELOCITY OF CONCENTRATED FLOW AND TRAPS SEDIMENT
32	SUMP DROP INLET	BLOCK & GRAVEL DROP INLET PROTECTION	FLOW = 4.9 cfs PREVENTS SILT FROM UPSTREAM GRADING FROM ENTERING STORM DRAIN SYSTEM
33	ENTRANCE / EXIT LOCATION	STABILIZED CONSTRUCTION ENTRANCE / EXIT	PREVENTS SILT AND DEBRIS FROM LEAVING SITE VIA CONSTRUCTION EQUIPMENT
34	SUMP DROP INLET	BLOCK & GRAVEL DROP INLET PROTECTION	FLOW = 1.2 cfs PREVENTS SILT FROM UPSTREAM GRADING FROM ENTERING STORM DRAIN SYSTEM

RECORD PLANS  
MARCH 28, 2008

PREPARED BY:  
**WIA WIER & ASSOCIATES, INC.**  
ENGINEERS SURVEYORS LAND PLANNERS  
4300 BELTWAY PLACE SUITE 130 ARLINGTON, TEXAS 76018 METRO (817)467-7700  
1380 U.S. HIGHWAY 287 N. SUITE 101 MANSFIELD, TEXAS 76063 METRO (817)477-8700  
6948 ELM STREET FROCO, TEXAS 75034 METRO (214)397-8000  
www.wiaassociates.com



PHASE I SH. 205 BYPASS  
FROM SH. 276 TO INTERSTATE 30  
SWP3 - STORM WATER  
POLLUTION PREVENTION NOTES

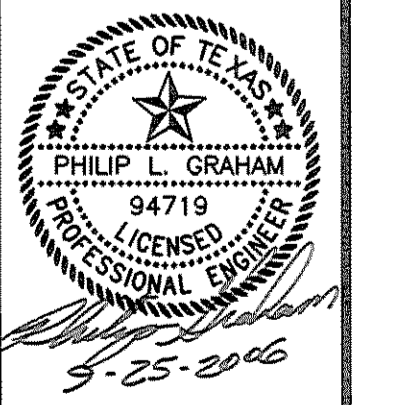

COPYRIGHT ©  
WIER & ASSOCIATES, INC.  
LAST SHEET EDIT  
DATE 09-07-2006  
WA# 04141  
SHEET NO.  
E003

STABILIZATION PRACTICES

Table with 4 columns: STABILIZATION PRACTICES, LOCATION ON-SITE, IMPLEMENTATION DATE, TEMPORARY OR PERMANENT. Rows include SOD STABILIZATION and HYDROMULCH SEEDING.

STABILIZATION PRACTICES MAY INCLUDE, BUT ARE NOT LIMITED TO: ESTABLISHING TEMPORARY OR PERMANENT VEGETATION, MULCHING, GEOTEXTILES, SOD STABILIZATION, VEGETATIVE BUFFER STRIPS, AND PROTECTING EXISTING TREES AND VEGETATION.

STRUCTURAL CONTROL PRACTICES

WILL THE PROJECT DISTURB 10 ACRES OR MORE AT ONE TIME? YES IF YES, IS IT FEASIBLE TO INSTALL A SEDIMENT BASIN? NO

PROJECT IS A LINEAR PROJECT IN WHICH ALL MAJOR DISCHARGE LOCATIONS HAVE LESS THAN 10 ACRES OF DISTURBED AREA DRAINING TO THEM. THE TOTAL PROJECT DISTURBS 12.4 ACRES.

PERMANENT STORM WATER CONTROLS

THE FOLLOWING MEASURES WILL BE CONSTRUCTED TO CONTROL POST-CONSTRUCTION RUNOFF:

Table with 3 columns: CONTROL MEASURE, LOCATION ON PROJECT SITE, CONTROL RUNOFF FROM WHAT AREAS. Rows include SOD PLACEMENT and HYDROMULCH SEEDING.

VELOCITY DISSIPATION DEVICES

THE FOLLOWING VELOCITY DISSIPATION DEVICES WILL BE PLACED AT DISCHARGE LOCATIONS AND ALONG THE LENGTH OF ANY OUTFALL CHANNEL:

Table with 3 columns: VELOCITY DISSIPATION DEVICE, OUTFALL DISCHARGING TO (MS4, BAR DITCH, CREEK/STREAM), AT OUTFALL OR CHANNEL (DISTANCE INTERVAL FOR CHANNEL). Row includes MINIMUM 12" DIAMETER GROUDED ROCK RUBBLE RIPRAP at BUFFALO CREEK.

CONSTRUCTION AND WASTE MATERIALS STORED ON-SITE

The following construction and waste materials will be stored on-site:

Table with 4 columns: Materials Stored On-Site, Average Amount Stored, Location On-Site, Controls Used to Prevent Pollutants.

POTENTIAL SOURCES OF POLLUTION

Table with 3 columns: Potential Sources of Pollution, Location On-Site, Controls Used to Prevent Pollutants.

DATES OF MAJOR GRADING AND CONSTRUCTION ACTIVITIES

If you do not list activities below, either attach documentation or state where records for the activities can be accessed:

Documents Attached?

Where can documentation be found?

Contact Person: Phone Number:

Dates when major grading activities will occur and locations on-site:

Table with 3 columns: Activity, Location, Dates Activity is Scheduled to Occur.

Dates when construction activity will temporarily or permanently cease:

Table with 4 columns: Location on-site, Date activity is to be stopped, Temporary or Permanent?, Stabilization Initiation Date.

ELIGIBLE NON-STORM WATER DISCHARGES

Table with 4 columns: Eligible Non-storm Water Discharge, Used? (Y/N), Pollution Prevention Measure(s), Implementation Date. Rows include Fire Fighting Activities, Fire Hydrant Flushings, Washing of Vehicles, Buildings, or Pavement, Dust Control, Potable Water Sources, Air Conditioning Condensate, Uncontaminated Ground/Spring Water, Other.

List any other non-storm water discharge permitted by a separate NPDES, TPDES, or TCEQ permit:

Table with 3 columns: Non-Storm Water Discharge, Pollution Prevention Measure(s), Implementation Date.

GOOD HOUSEKEEPING PRACTICES

Good Housekeeping practices implemented to limit the off-site transport of litter, construction debris, and construction materials.

Table with 2 columns: Good Housekeeping Activity, Location(s) On-Site. Section: Litter Controls:


Table with 2 columns: Good Housekeeping Activity, Location(s) On-Site. Section: Construction Debris Controls:

Table with 2 columns: Good Housekeeping Activity, Location(s) On-Site. Section: Construction Materials Controls:

WIA WIER & ASSOCIATES, INC. ENGINEERS SURVEYORS LAND PLANNERS. 1300 U.S. HIGHWAY 287 N., SUITE 101 MANSFIELD, TEXAS 76063 METRO (817)777-8700




PHASE I S.H. 205 BYPASS FROM S.H. 276 TO INTERSTATE 30 SWP3 - STORM WATER POLLUTION PREVENTION NOTES

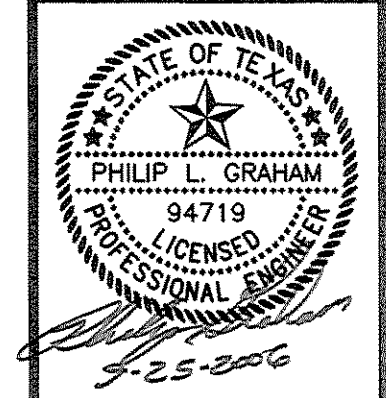

COPYRIGHT © WIER & ASSOCIATES, INC. LAST SHEET EDIT DATE 08-23-2006 WA# 04141


SHEET NO. E004

TIME: 15:04 FILE: 04141-SWP3-MAP-Phase1.dwg

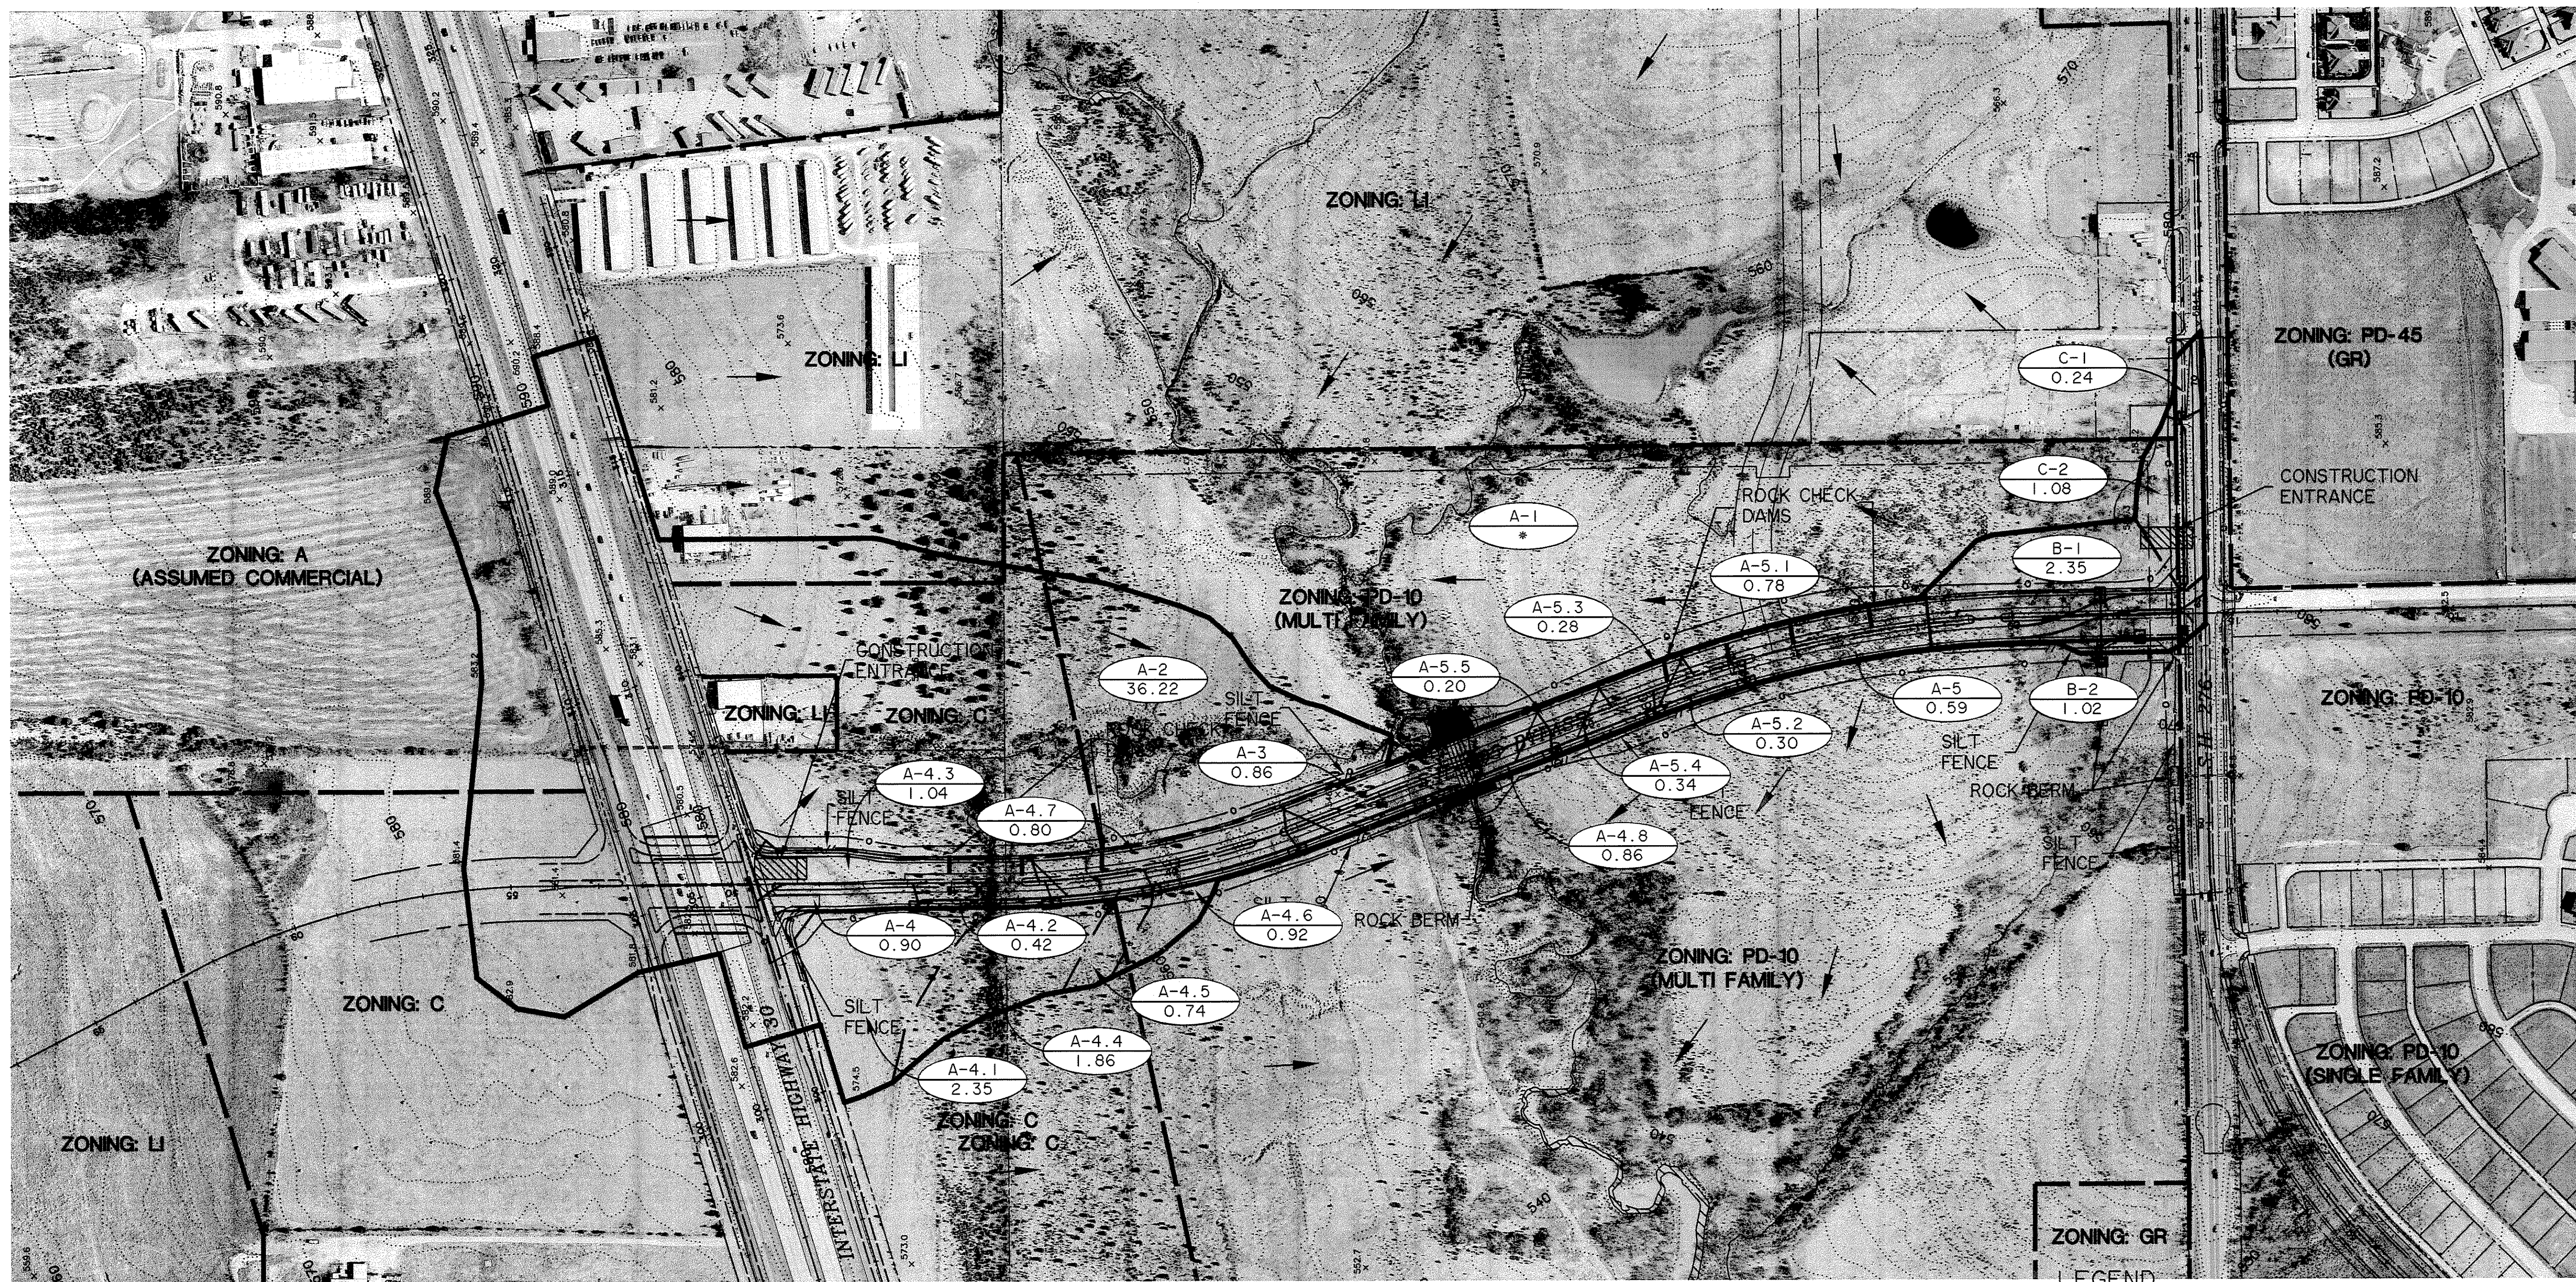


S.H. 205 BYPASS DRAINAGE AREA CALCULATIONS TABLE

DRAINAGE AREA DESIGNATION	TOTAL AREA (ACRES)	C 0.75	C 0.90	C 0.90	C 0.90	C 0.70	STREET RIGHT-OF-WAY	SCHOOLS OR CHURCHES	C x A	tc (min.)	I (In./Hr.) 2 YEAR STORM	Q (cfs) 2 YEAR STORM
A-2	36.22						11.52		31.67	13.9	4.66	147.6
A-3	0.86						0.86		0.77	10.0	5.43	4.2
A-4	0.90						0.90		0.81	10.0	5.43	4.4
A-4.1	2.35						0.42		2.12	10.0	5.43	11.5
A-4.2	0.42						1.04		0.38	10.0	5.43	2.1
A-4.3	1.04						0.90		0.94	10.0	5.43	5.1
A-4.4	1.86						0.31		1.67	10.0	5.43	9.1
A-4.5	0.74	0.13					0.47		0.65	10.0	5.43	3.5
A-4.6	0.92	0.43					0.80		0.72	10.0	5.43	4.1
A-4.7	0.80						0.86		0.76	10.0	5.43	3.9
A-4.8	0.86						0.59		0.77	10.0	5.43	4.2
A-5	0.59						0.77		0.53	10.0	5.43	2.9
A-5.1	0.78	0.01					0.30		0.27	10.0	5.43	3.8
A-5.2	0.30						0.28		0.27	10.0	5.43	1.5
A-5.3	0.28						0.34		0.25	10.0	5.43	1.4
A-5.4	0.34						0.20		0.31	10.0	5.43	1.7
A-5.5	0.20						0.86		0.18	10.0	5.43	1.0
B-1	2.35	1.49					0.90		1.89	10.0	5.43	10.3
B-2	1.02	0.12					0.22		0.22	10.0	5.43	4.9
C-1	0.24		0.02				0.54		0.22	10.0	5.43	1.2
C-2	1.08	0.50	0.04				0.90		0.90	10.0	5.43	4.9

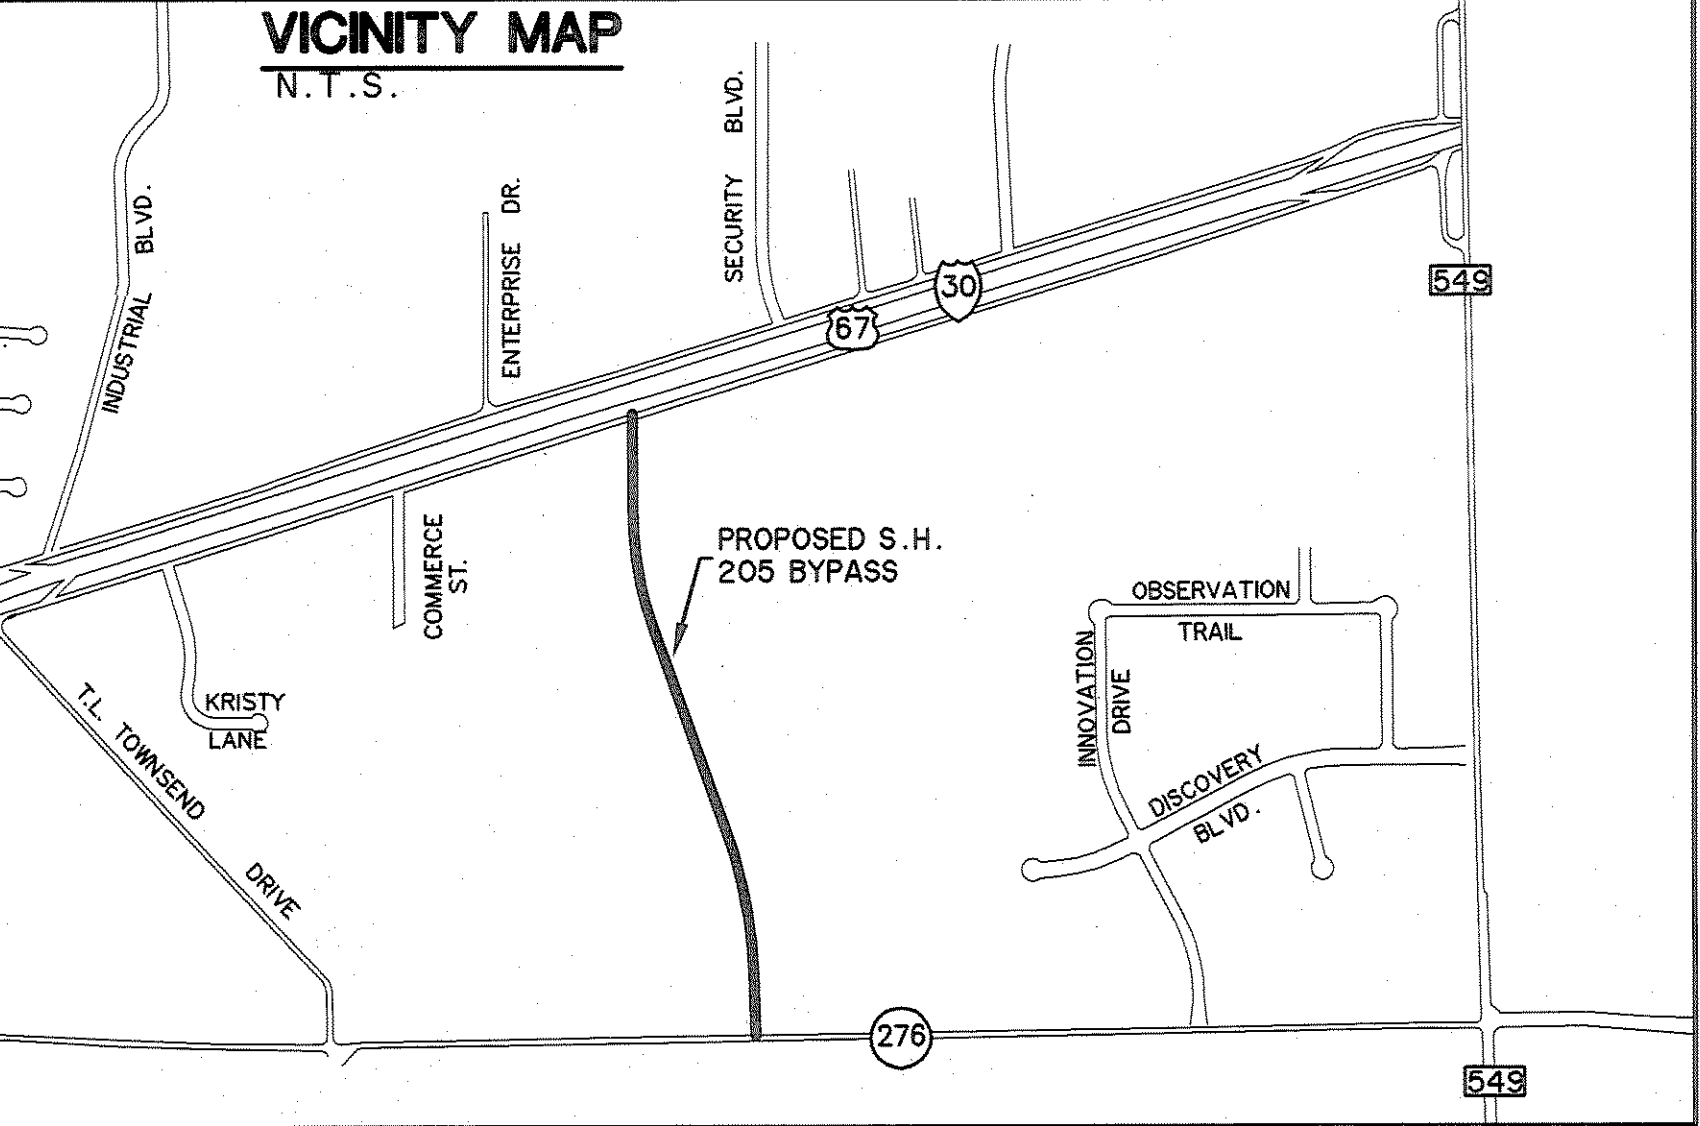


- DENOTES WATERSHED BOUNDARY
- - - DENOTES MAJOR DRAINAGE AREA DIVIDE
- · - · DENOTES MAJOR DRAINAGE AREA SUBDIVIDE
- (X-1 / XX.XX) DRAINAGE AREA DESIGNATION DRAINAGE AREA ACRES
- INLET TREATMENT
- DENOTES ZONING BOUNDARY LINE
- EXISTING CONTOUR
- PROPOSED CONTOUR
- //— SILT FENCE
- LIMITS OF OPERATOR DAY TO DAY CONTROL
- ▨ ROCK BERM

TPDES PERMIT No. _____  
 N.O.I. SUBMITTAL DATE: _____  
 OPERATOR / OWNER _____  
 OPERATOR / CONTRACTOR _____

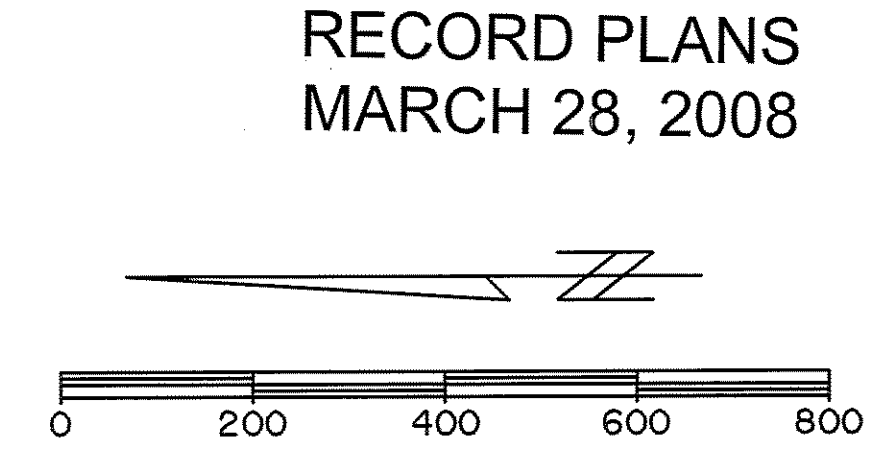


RECORD PLANS  
 MARCH 28, 2008

PREPARED BY:  
**VIA WIER & ASSOCIATES, INC.**  
 ENGINEERS SURVEYORS LAND PLANNERS  
 4300 BELTWAY PLACE SUITE 130 ARLINGTON, TEXAS 76018 METRO (817)467-7700  
 1380 U.S. HIGHWAY 287 N. SUITE 101 MANFRED, TEXAS 76063 METRO (817)477-6700  
 6849 ELM STREET FRISCO, TEXAS 75034 METRO (214)387-8000  
 www.WierAssociates.com

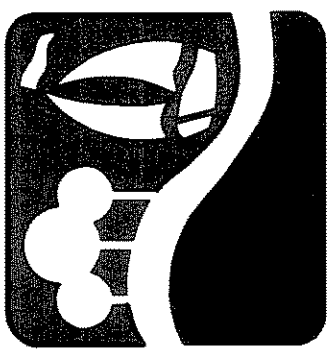

PHASE I S.H. 205 BYPASS  
 FROM S.H. 276 TO INTERSTATE 30  
 SWP3 - LAYOUT PLAN

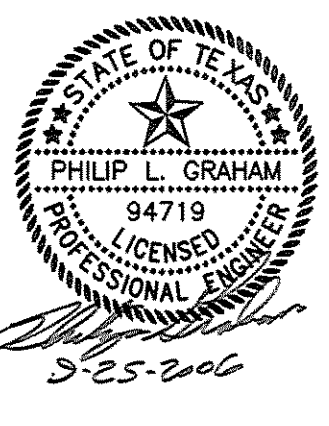

COPYRIGHT © WIER & ASSOCIATES, INC.  
 LAST SHEET EDIT DATE 09-07-2008  
 WA# 04141  
 SHEET NO. E101

ROCKWALL BYPASS, LTD.  
VOL. 2852, PG. 109  
D.R.R.C.T.

LOFLAND FARMS, LTD.  
VOL. 1392, PG. 271  
D.R.R.C.T.

THE CAMBRIDGE  
COMPANIES, INC. TRUSTEE  
VOL. 99, PG. 1022  
D.R.R.C.T.

BMP No. 6  
INSTALL 650 L.F. REINFORCED  
SILT FENCE AT TOE OF SLOPE

BMP No. 3  
INLET B-2: INSTALL BLOCK & GRAVEL  
DROP INLET PROTECTION & MAINTAIN  
UNTIL DISTURBED AREAS ARE REVEGETATED

BMP No. 2  
INSTALL 20 L.F. 12" HIGH  
ROCK BERM

BMP No. 8  
INLET A-5: INSTALL PHASE I &  
PHASE II INLET PROTECTION & MAINTAIN  
UNTIL PARKWAYS ARE REVEGETATED

BMP No. 1  
INSTALL 630 L.F. REINFORCED  
SILT FENCE AT TOE OF SLOPE



BMP No. 7  
INSTALL 50 L.F. ROCK CHECK DAMS  
AT APPROXIMATE 150' INTERVALS

BMP No. 5  
INSTALL 40 L.F. REINFORCED  
SILT FENCE

BMP No. 4  
INLET B-1: INSTALL BLOCK & GRAVEL  
DROP INLET PROTECTION & MAINTAIN  
UNTIL DISTURBED AREAS ARE REVEGETATED

LEGEND

- LIMITS OF OPERATOR DAY TO DAY OPERATIONAL CONTROL
- INLET TREATMENT
- REINFORCED SILT FENCE
- ROCK SILT DAMS / BERMS
- CONSTRUCTION ENTRANCE

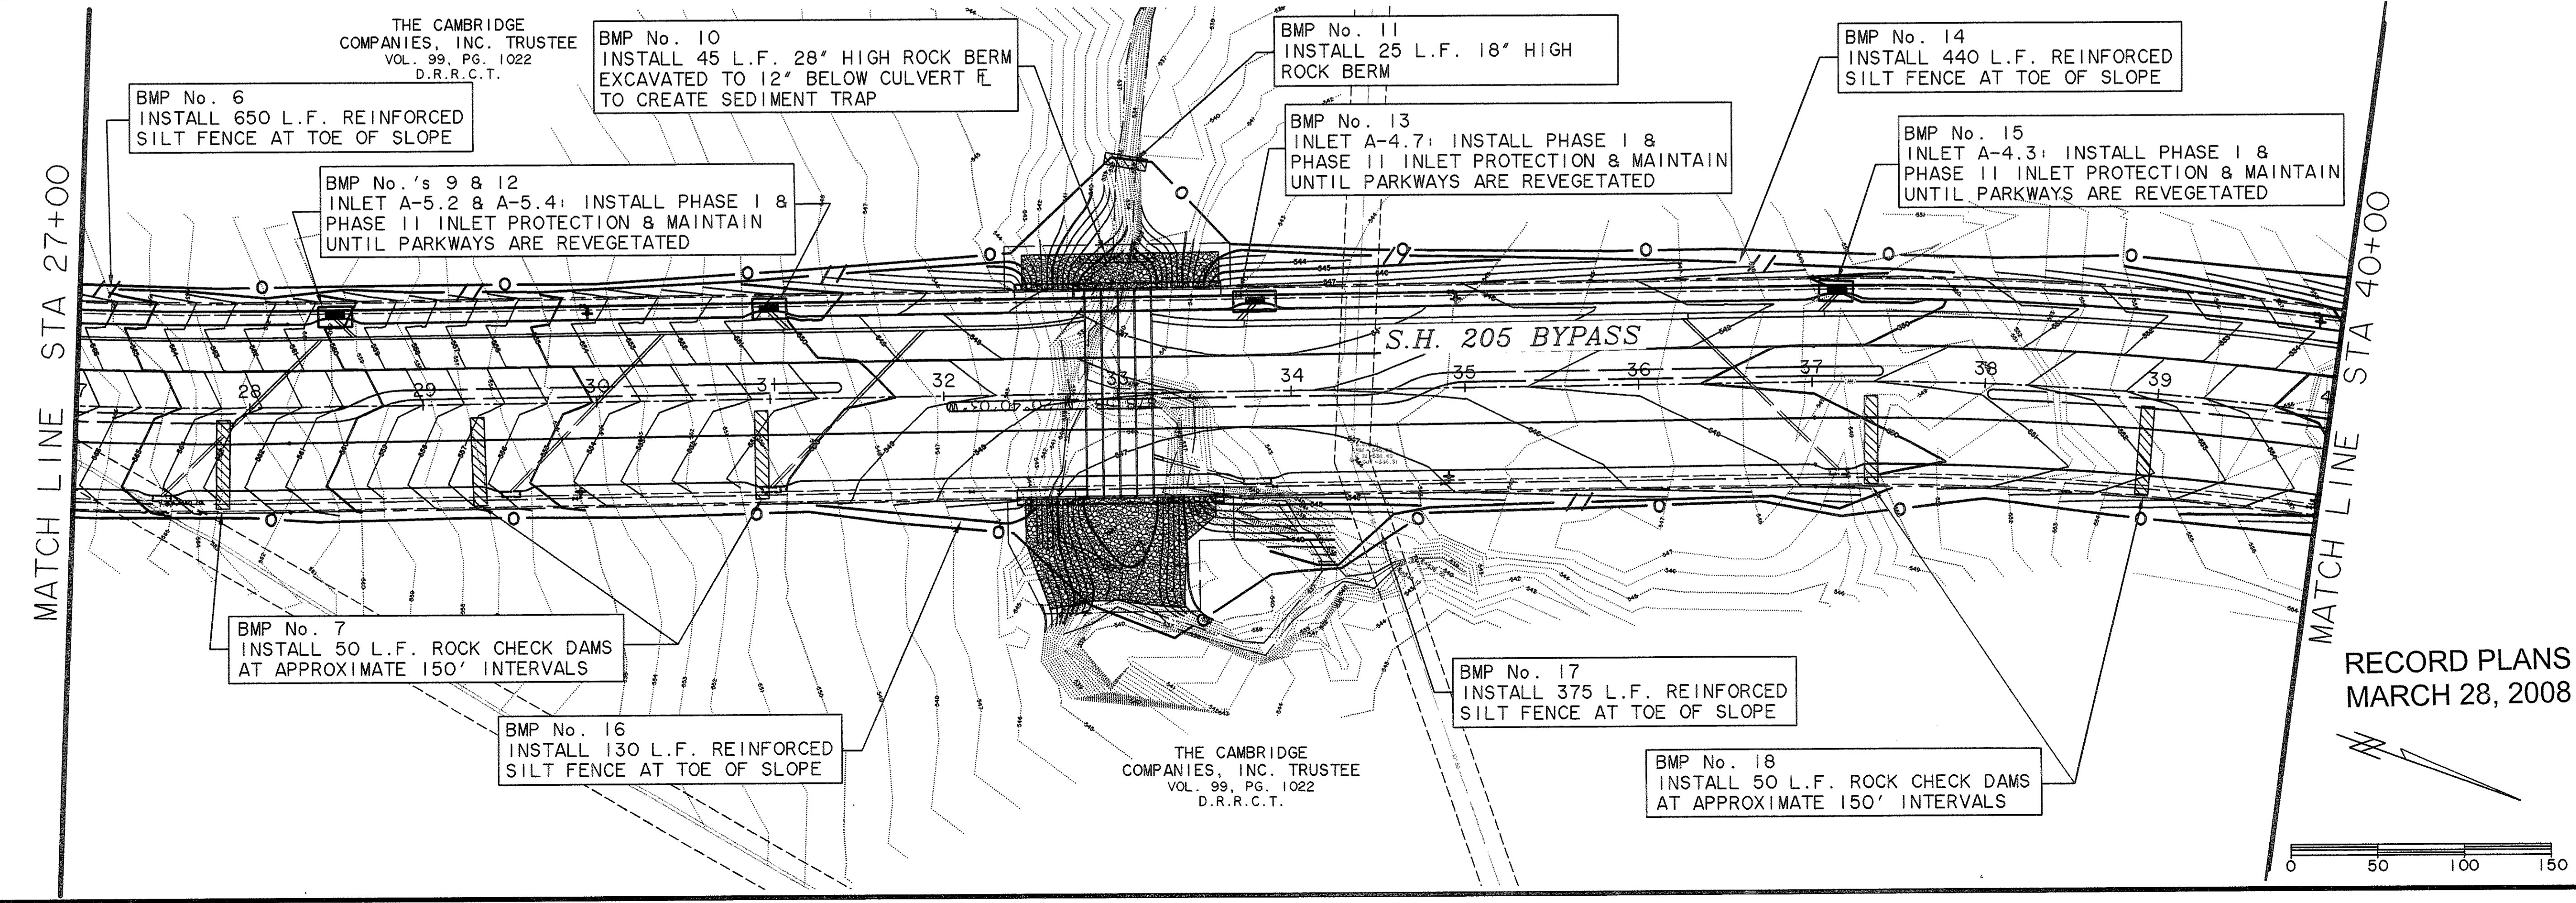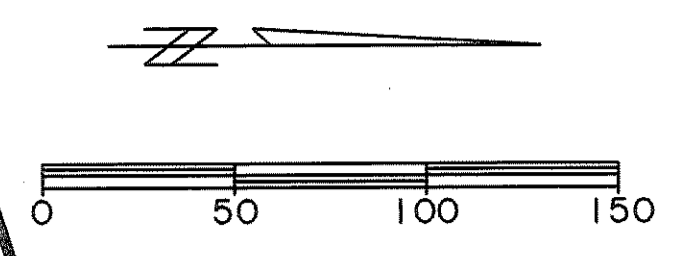

BMP No. 6  
INSTALL 650 L.F. REINFORCED  
SILT FENCE AT TOE OF SLOPE

BMP No.'s 9 & 12  
INLET A-5.2 & A-5.4: INSTALL PHASE I &  
PHASE II INLET PROTECTION & MAINTAIN  
UNTIL PARKWAYS ARE REVEGETATED

BMP No. 10  
INSTALL 45 L.F. 28" HIGH ROCK BERM  
EXCAVATED TO 12" BELOW CULVERT R_L  
TO CREATE SEDIMENT TRAP

BMP No. 11  
INSTALL 25 L.F. 18" HIGH  
ROCK BERM

BMP No. 14  
INSTALL 440 L.F. REINFORCED  
SILT FENCE AT TOE OF SLOPE

BMP No. 13  
INLET A-4.7: INSTALL PHASE I &  
PHASE II INLET PROTECTION & MAINTAIN  
UNTIL PARKWAYS ARE REVEGETATED

BMP No. 15  
INLET A-4.3: INSTALL PHASE I &  
PHASE II INLET PROTECTION & MAINTAIN  
UNTIL PARKWAYS ARE REVEGETATED

BMP No. 7  
INSTALL 50 L.F. ROCK CHECK DAMS  
AT APPROXIMATE 150' INTERVALS

BMP No. 16  
INSTALL 130 L.F. REINFORCED  
SILT FENCE AT TOE OF SLOPE

BMP No. 17  
INSTALL 375 L.F. REINFORCED  
SILT FENCE AT TOE OF SLOPE


BMP No. 18  
INSTALL 50 L.F. ROCK CHECK DAMS  
AT APPROXIMATE 150' INTERVALS

THE CAMBRIDGE  
COMPANIES, INC. TRUSTEE  
VOL. 99, PG. 1022  
D.R.R.C.T.


RECORD PLANS  
MARCH 28, 2008



PREPARED BY:  
**VIA WIER & ASSOCIATES, INC.**  
 ENGINEERS SURVEYORS LAND PLANNERS  
 4300 BELTWAY PLACE SUITE 130 ARLINGTON, TEXAS 76018 METRO (817)467-7700  
 1380 U.S. HIGHWAY 287 N. SUITE 101 MANFELD, TEXAS 78063 METRO (817)477-8700  
 6848 ELM STREET FROCO, TEXAS 75034 METRO (214)397-8000  
 www.via-wier.com

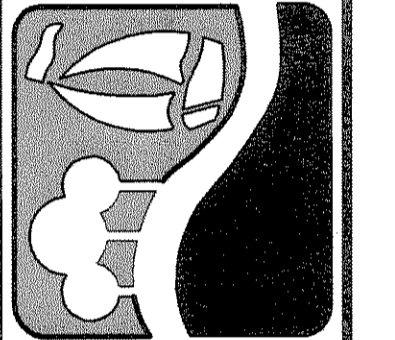

PHASE I S.H. 205 BYPASS  
 FROM S.H. 276 TO INTERSTATE 30  
 EROSION CONTROL  
 PLAN  
 BEGINNING TO STA 40+00

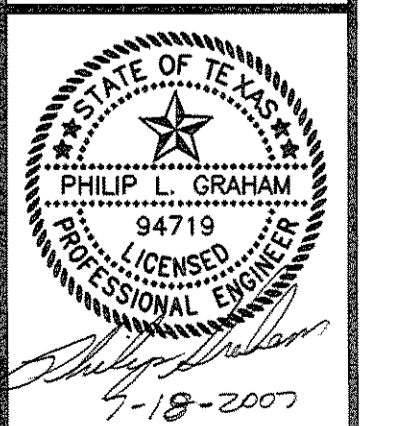

COPYRIGHT ©  
 WIER & ASSOCIATES, INC.  
 LAST SHEET EDIT  
 DATE 07-18-2007  
 WA# 04141

SHEET NO.  
 E102

TIME 20:22 FILE: I:\04141-SWP3-EROSION-I-Phase1.dwg

BMP No. 20  
INLET A-4.4: INSTALL BLOCK & GRAVEL  
DROP INLET PROTECTION & MAINTAIN  
UNTIL DISTURBED AREAS ARE REVEGETATED

THE CAMBRIDGE  
COMPANIES, INC. TRUSTEE  
VOL. 99, PG. 1022  
D.R.R.C.T.

THE CAMBRIDGE  
COMPANIES, INC. TRUSTEE  
VOL. 101, PG. 795  
D.R.R.C.T.

BMP No.'s 19, 21, & 22  
INLETS A-4.5, A-4.2, & A-4  
INSTALL PHASE I & II INLET  
PROTECTION & MAINTAIN UNTIL  
PARKWAYS ARE REVEGETATED

BMP No. 13  
INSTALL 110 L.F. REINFORCED  
SILT FENCE AT TOE OF SLOPE

BMP No. 24  
INSTALL 50 L.F. REINFORCED  
SILT FENCE AT TOE OF SLOPE

THE CAMBRIDGE  
COMPANIES, INC. TRUSTEE  
VOL. 99, PG. 1022  
D.R.R.C.T.

BMP No. 25  
INSTALL 50 L.F. REINFORCED  
SILT FENCE AT TOE OF SLOPE

BMP No. 18  
INSTALL 50 L.F. ROCK CHECK DAMS  
AT APPROXIMATE 150' INTERVALS

BMP No. 26  
INSTALL 510 L.F. REINFORCED  
SILT FENCE AT TOE OF SLOPE

THE CAMBRIDGE  
COMPANIES, INC. TRUSTEE  
VOL. 101, PG. 795  
D.R.R.C.T.

BMP No. 27  
INSTALL CONSTRUCTION ENTRANCE

BMP No. 29  
INSTALL 20 L.F. 12" HIGH  
ROCK BERM

THE CAMBRIDGE  
COMPANIES, INC. TRUSTEE  
VOL. 99, PG. 1022  
D.R.R.C.T.

BMP No. 32  
INLET C-2: INSTALL BLOCK & GRAVEL  
DROP INLET PROTECTION & MAINTAIN  
UNTIL DISTURBED AREAS ARE REVEGETATED

THE CAMBRIDGE  
COMPANIES, INC. TRUSTEE  
VOL. 99, PG. 1022  
D.R.R.C.T.

BLACKLAND  
WATER SUPPLY  
VOL. 17, PG. 420  
D.R.R.C.T.

PNEUMA VENTURES, LTD.  
VOL. 2924, PG. 314  
D.R.R.C.T.

BMP No. 33  
INSTALL CONSTRUCTION ENTRANCE

BMP No. 28  
INSTALL 200 L.F. REINFORCED  
SILT FENCE AT TOE OF SLOPE

ROCKWALL BYPASS, LTD.  
VOL. 2852, PG. 109  
D.R.R.C.T.

BMP No. 30  
INSTALL 240 L.F. REINFORCED  
SILT FENCE AT TOE OF SLOPE

LOFLAND FARMS, LTD.  
VOL. 1392, PG. 271  
D.R.R.C.T.


BMP No. 34  
INLET C-1: INSTALL BLOCK & GRAVEL  
DROP INLET PROTECTION & MAINTAIN  
UNTIL DISTURBED AREAS ARE REVEGETATED

**LEGEND**


- LIMITS OF OPERATOR DAY TO DAY OPERATIONAL CONTROL
- INLET TREATMENT
- REINFORCED SILT FENCE
- ROCK SILT DAMS / BERMS
- CONSTRUCTION ENTRANCE

RECORD PLANS  
MARCH 28, 2008

PREPARED BY:  
**WIA WIER & ASSOCIATES, INC.**  
ENGINEERS SURVEYORS LAND PLANNERS  
4300 BELLEVUE PLACE SUITE 130 ARLINGTON, TEXAS 76018 METRO (817)467-7700  
1380 U.S. HIGHWAY 287 N. SUITE 101 MANVEL, TEXAS 76663 METRO (817)477-8700  
6848 ELM STREET FROED, TEXAS 75004 METRO (214)387-8800  
www.WierAssociates.com

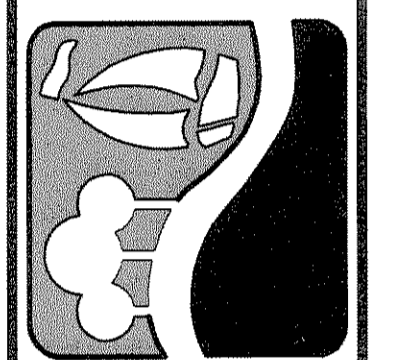


PHASE I S.H. 205 BYPASS  
FROM S.H. 276 TO INTERSTATE 30  
EROSION CONTROL  
PLAN  
STA 40+00 TO END & S.H. 276

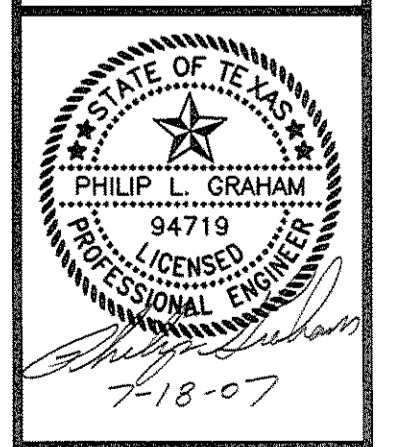


COPYRIGHT ©  
WIER & ASSOCIATES, INC.  
LAST SHEET EDIT  
DATE 07-18-2007  
WA# 04141  
**SHEET NO.**  
E103

FILE: 04141-SWP3-EROSION2-Phase1.dwg  
TIME: 21:51


1. SET POSTS AND EXCAVATE A 6" x 6" TRENCH UPSLOPE ALONG THE LINE OF POSTS. WHERE FENCE CANNOT BE TRENCHED (e.g. PAVEMENT), WEIGHT FABRIC WITH CRUSHED STONE ON THE UPHILL SIDE TO PREVENT FLOW FROM SEEPING UNDER FENCE.

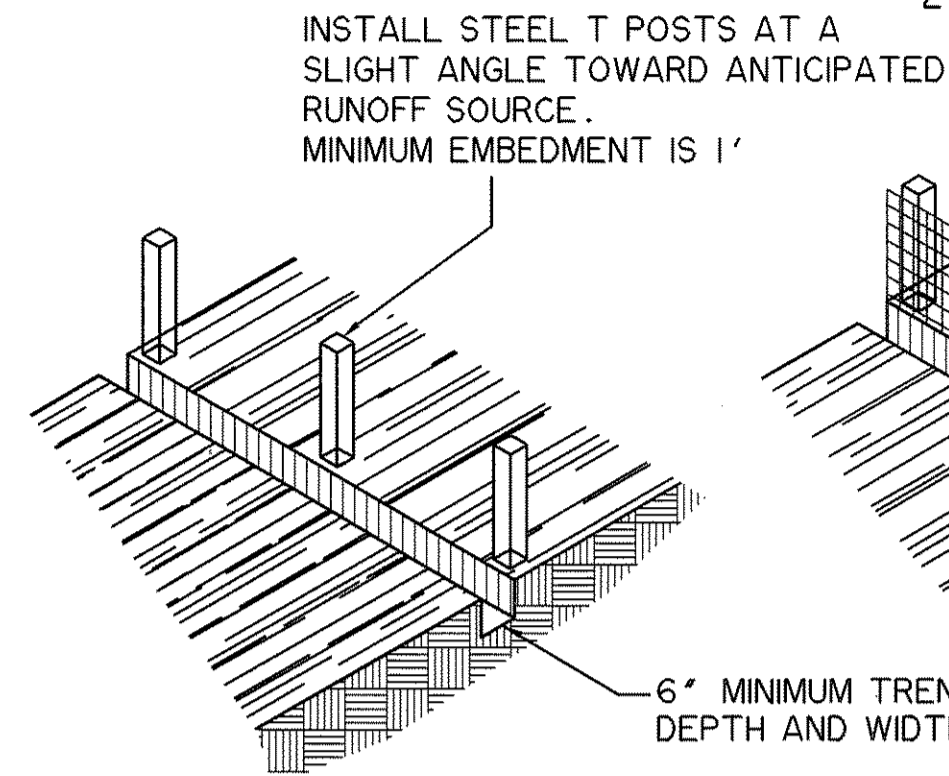




2. STAPLE OR FASTEN WIRE FENCING TO THE STEEL T POSTS.

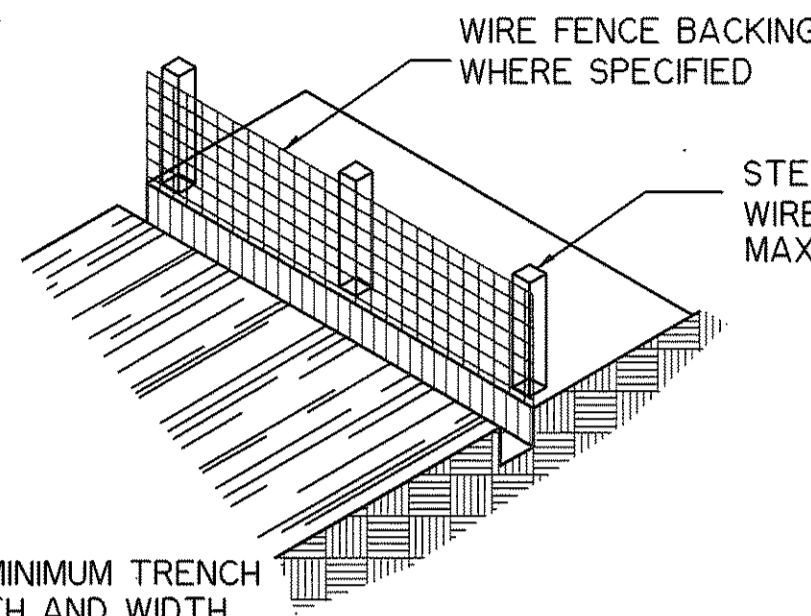


3. ATTACH THE FILTER FABRIC TO THE WIRE FENCE AND EXTEND IT INTO THE TRENCH. THERE SHALL BE A 6" DOUBLE OVERLAP, SECURELY FASTENED, WHERE ENDS OF FABRIC MEET.

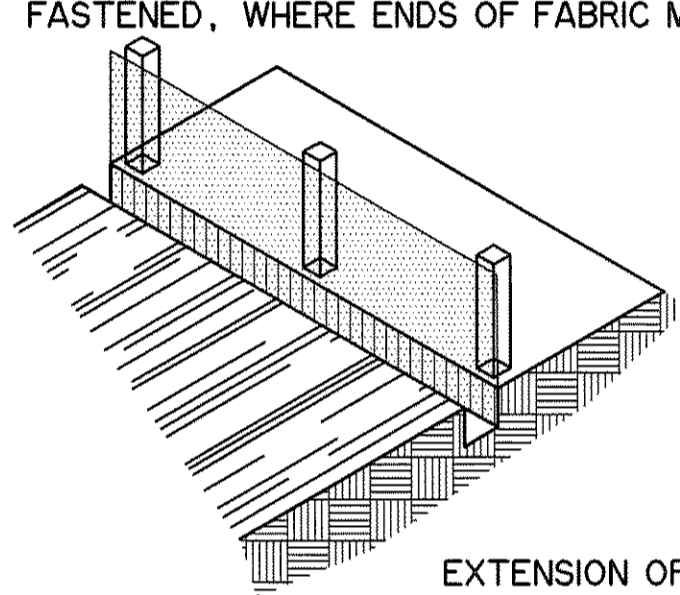

4. BACKFILL AND COMPACT THE EXCAVATED SOIL.

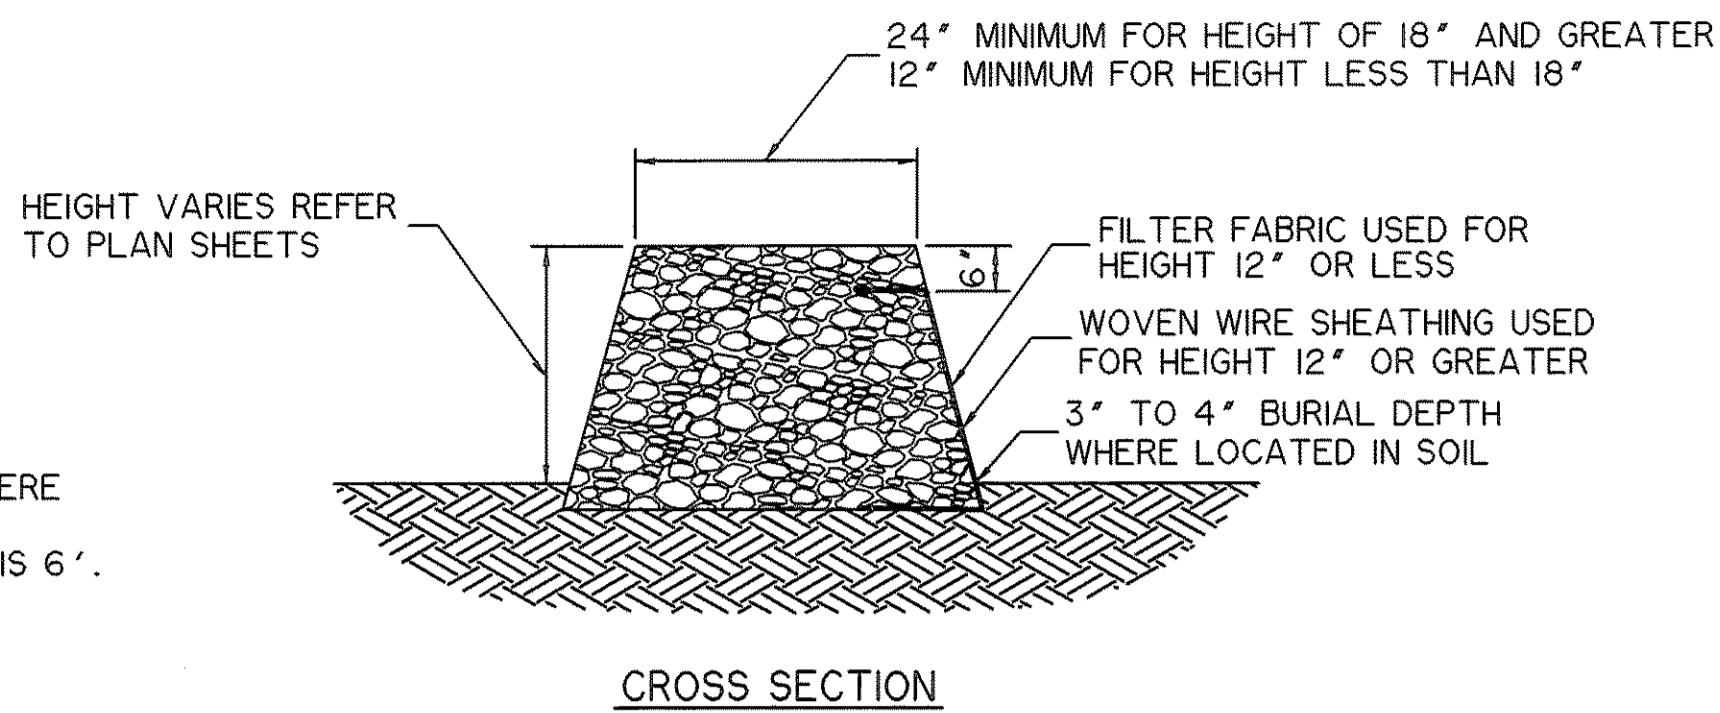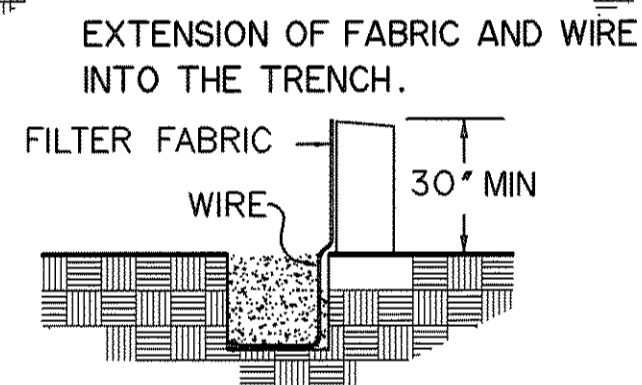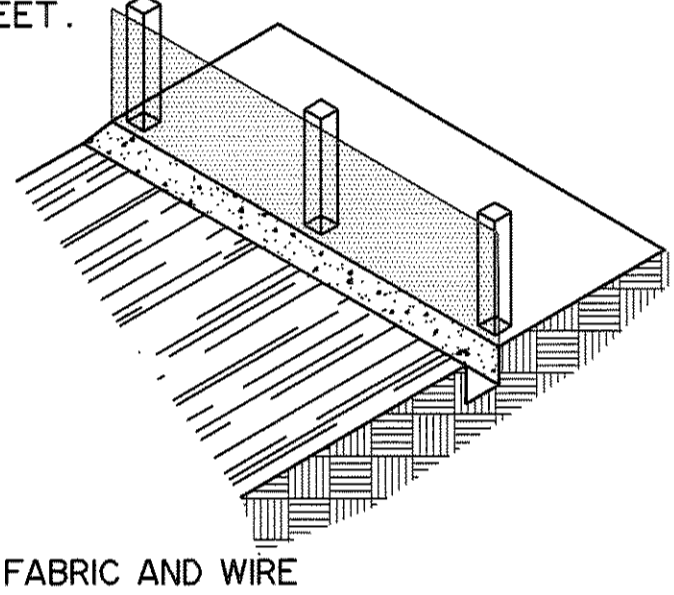

CROSS SECTION

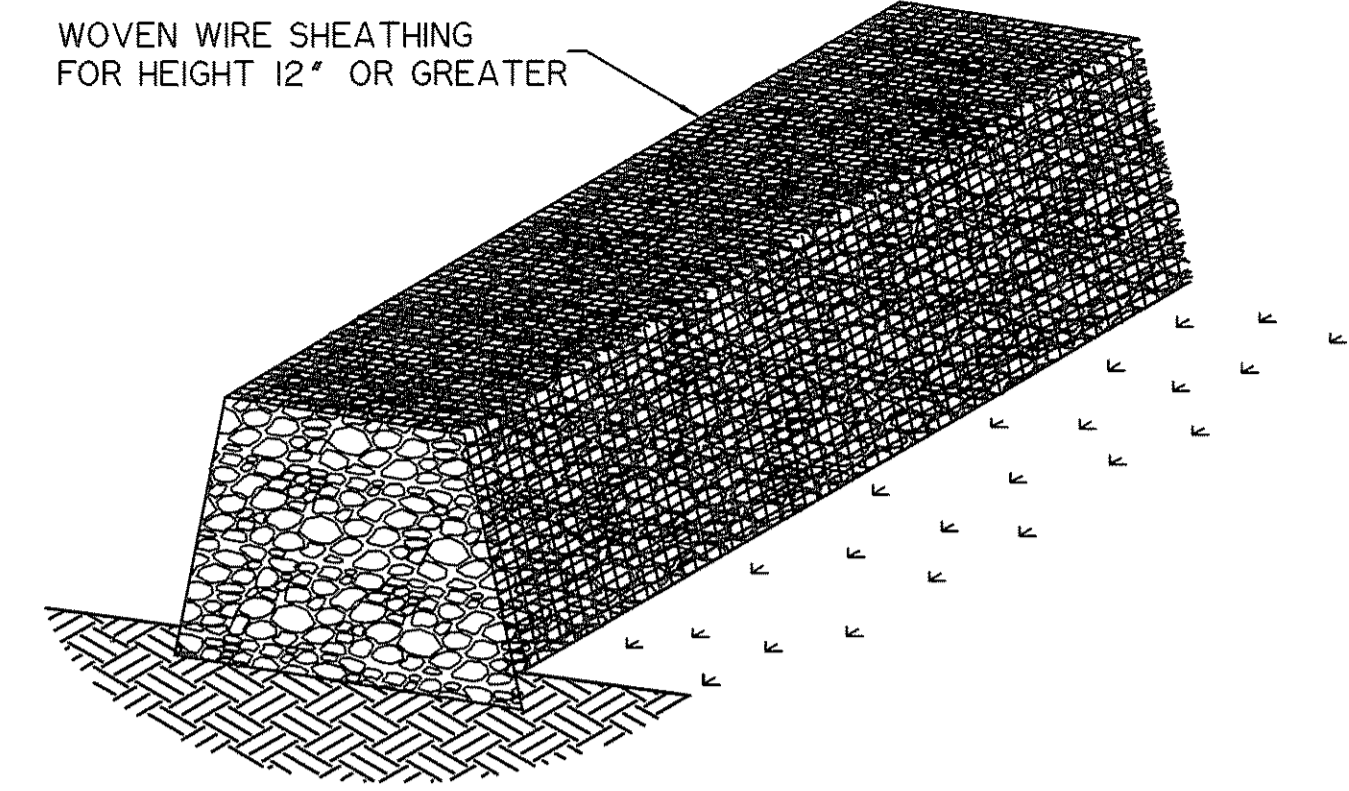


ISOMETRIC PLAN VIEW

GENERAL NOTES:


- USE ONLY OPEN GRADED ROCK 4-8 INCHES IN DIAMETER FOR STREAM FLOW CONDITION. USE OPEN GRADED ROCK 3-5 INCHES IN DIAMETER FOR OTHER CONDITIONS.
- THE ROCK BERM, IF GREATER THAN 12" IN HEIGHT, SHALL BE SECURED WITH A WOVEN WIRE SHEATHING HAVING A MAXIMUM OPENING OF 1 INCH AND A MINIMUM WIRE SIZE OF 20 GAUGE AND SHALL BE BURIED IN A TRENCH APPROXIMATELY 3-4 INCHES DEEP WHERE LOCATED IN SOIL.
- THE ROCK BERM SHALL BE INSPECTED WEEKLY OR AFTER EACH RAIN EVENT AND SHALL BE REPLACED WHEN THE STRUCTURE CEASES TO FUNCTION AS INTENDED DUE TO SILT ACCUMULATION AMONG THE ROCKS, WASHOUT, CONSTRUCTION TRAFFIC DAMAGE, ETC.
- WHEN SILT REACHES A DEPTH EQUAL TO ONE-THIRD OF THE HEIGHT OF THE BERM OR ONE FOOT, WHICHEVER IS LESS, THE SILT SHALL BE REMOVED AND DISPOSED OF PROPERLY.
- WHEN THE SITE IS COMPLETELY STABILIZED, THE BERM AND ACCUMULATED SILT SHALL BE REMOVED AND DISPOSED OF IN AN APPROVED MANNER.
- SEE SILT FENCE DETAIL GENERAL NOTE No. 2, THIS SHEET, FOR FILTER FABRIC MATERIAL SPECIFICATIONS.

ROCK BERM DETAIL


N.T.S.

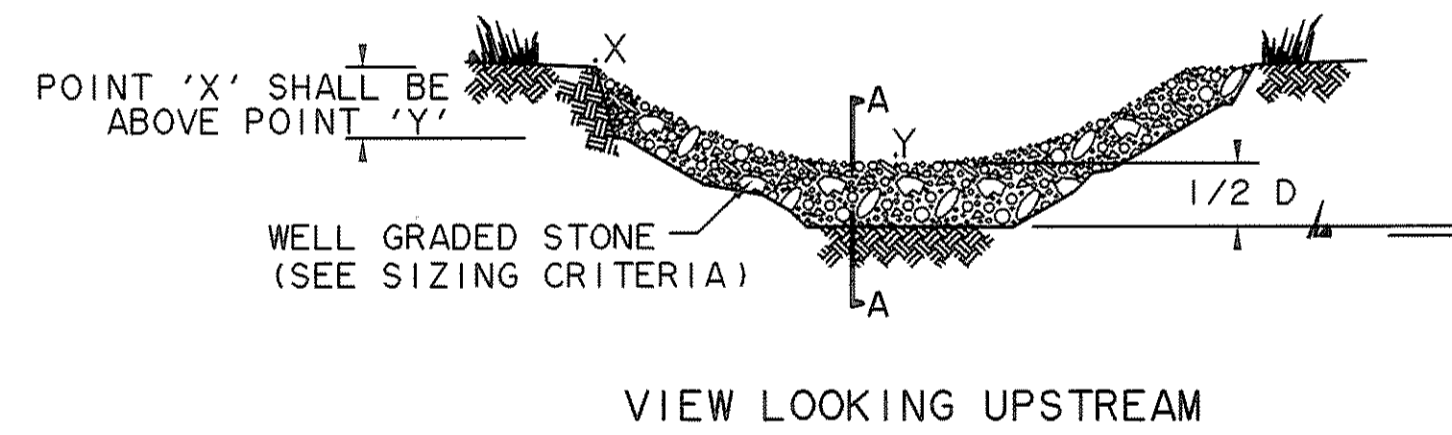

VIEW LOOKING UPSTREAM

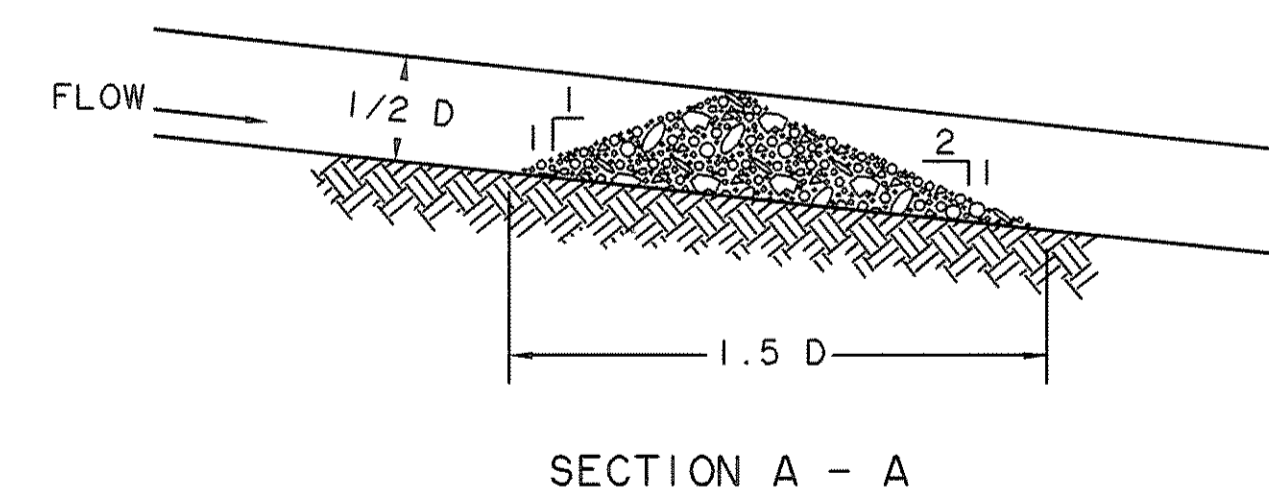

SECTION A - A

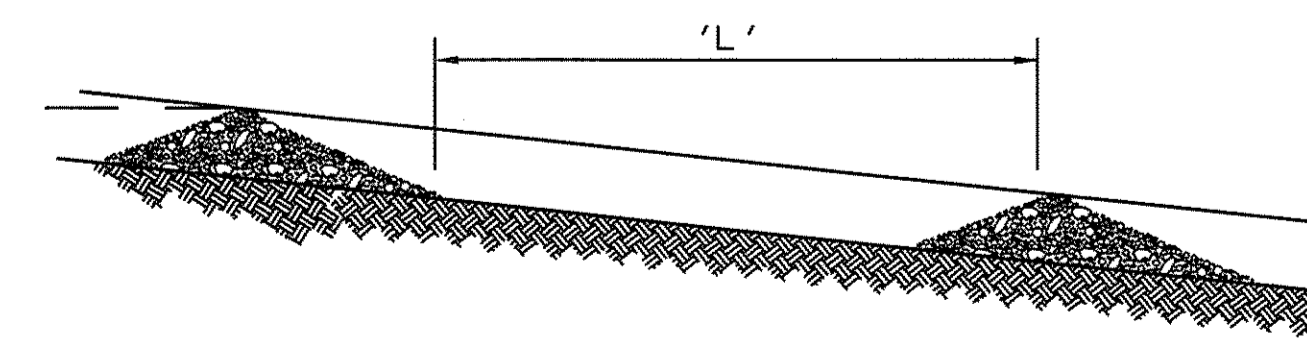

SPACING BETWEEN CHECK DAMS

ROCK CHECK DAM

N.T.S.

GENERAL NOTES:

- WIRE FENCE BACKING WHEN SPECIFIED ON PLANS SHALL BE CONSTRUCTED OF W1.4 X W1.4, 4" X 4", ZINC COATED (GALVANIZED) STEEL WOVEN WIRE FENCE FABRIC CONFORMING TO ASTM A116. STANDARD 2" X 2" CHAIN LINK FENCE FABRIC IS ACCEPTABLE AS WELL AS OTHER WELDED STEEL FABRICS CONSISTING OF EQUAL OR GREATER GAUGE WIRE AND EQUAL OR SMALLER SPACING AS THAT LISTED HEREIN.
- SILT FENCE FABRIC SHALL BE NYLON REINFORCED POLYPROPYLENE FABRIC WHICH HAS A BUILT IN CORD RUNNING THE ENTIRE LENGTH OF THE TOP EDGE OF THE FABRIC. THE FABRIC MUST MEET THE FOLLOWING MINIMUM CRITERIA:
- STEEL FENCE POSTS, WHEN REQUIRED, MAY BE ROLLED, FORMED, OR TUBULAR IN CROSS-SECTION. ALL POSTS NOT GALVANIZED SHALL BE PAINTED WITH AN APPROVED ANTI-CORROSIVE PAINT.
- INSPECTION SHALL BE MADE WEEKLY AND AFTER EACH RAINFALL. REPAIR OR REPLACEMENT SHALL BE MADE PROMPTLY AS NEEDED.
- SILT FENCE SHALL BE REMOVED WHEN SITE IS COMPLETELY STABILIZED SO AS NOT TO BLOCK OR IMPEDE STORM FLOW OR DRAINAGE.
- ACCUMULATED SILT SHALL BE REMOVED WHEN IT REACHES A DEPTH OF HALF THE HEIGHT OF THE FENCE. THE SILT SHALL BE DISPOSED OF IN SUCH A MANNER AS TO NOT CONTRIBUTE TO ADDITIONAL SILTATION.


TENSILE STRENGTH, ASTM D4632	90 Lbs. .
PUNCTURE RATING, ASTM D4833	60 Lbs. .
MULLEN BURST RATING, ASTM D3786	280 Psi. .
APPARENT OPENING SIZE, U.S. SIEVE No. 70.	


PRIMARY PURPOSE:  
SLOW AND FILTER RUNOFF TO RETAIN SEDIMENT

RATING =  $\frac{\text{SEDIMENT RETAINED}}{\text{TOTAL SEDIMENT LOADING}} = 0.75$

SILT FENCE DETAIL

N.T.S.

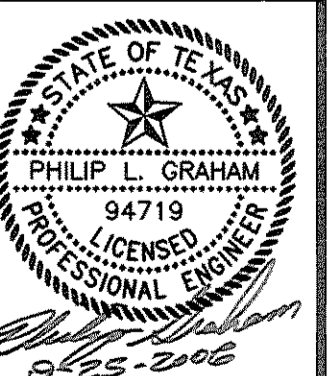

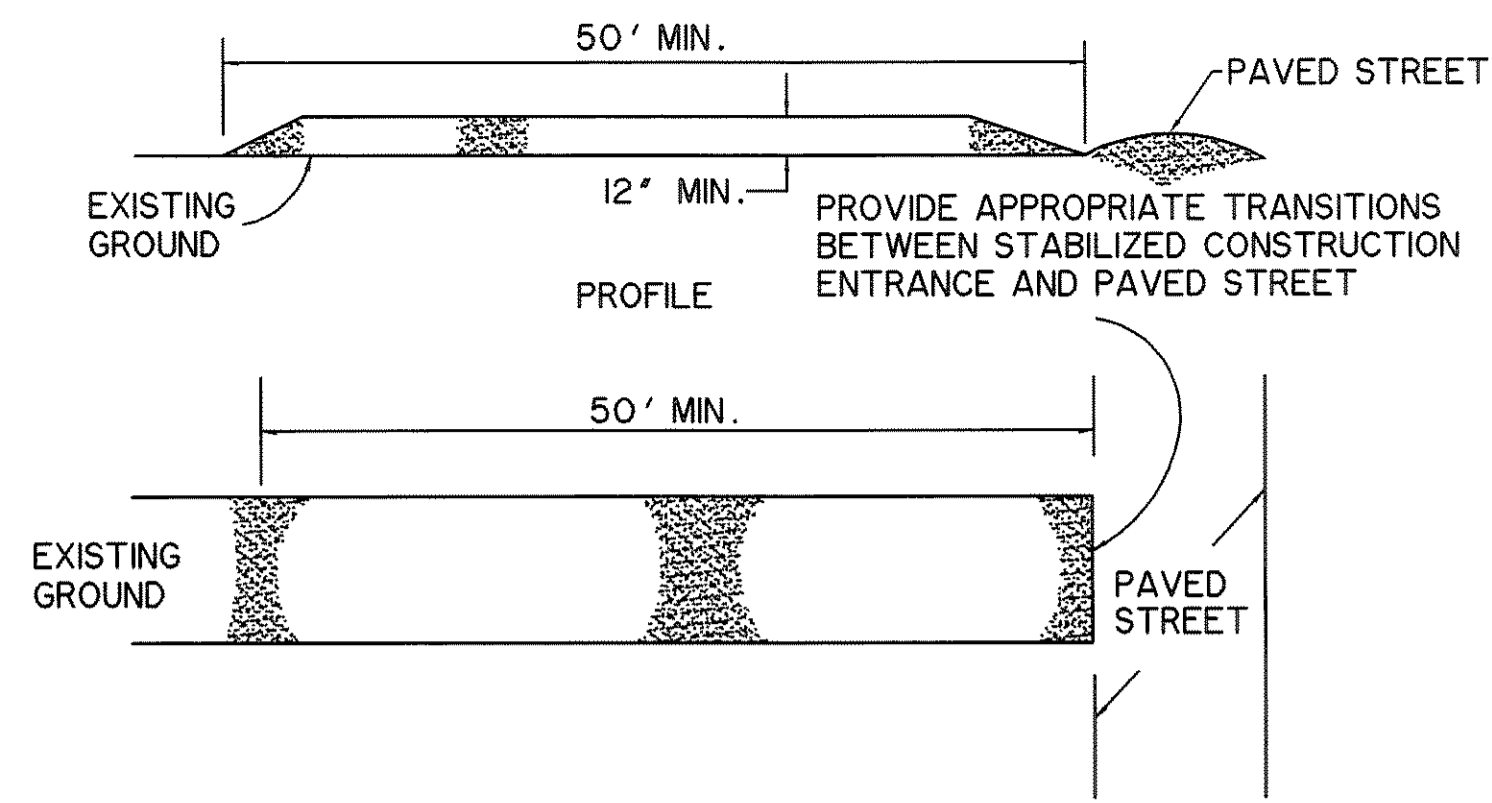

**GENERAL NOTES:**

1. STONE SIZE ASTM D448 (3' TO 5' DIAMETER) NO CRUSHED CONCRETE.
2. LENGTH - AS EFFECTIVE, BUT NOT LESS THAN 50 FEET, UNLESS APPROVED IN WRITING BY THE ENGINEER.
3. THICKNESS - NOT LESS THAN 12 INCHES.
4. WIDTH - NOT LESS THAN FULL WIDTH OF ALL POINTS OF INGRESS OR EGRESS.
5. WASHING - WHEN NECESSARY, WHEELS SHALL BE CLEANED TO REMOVE SEDIMENT PRIOR TO ENTRANCE ONTO A PAVED STREET. WHEN WASHING IS REQUIRED, IT SHALL BE DONE ON AN AREA STABILIZED WITH CRUSHED STONE WHICH DRAINS INTO AN APPROVED SEDIMENT TRAP OR SEDIMENT BASIN. ALL SEDIMENT SHALL BE PREVENTED FROM ENTERING ANY STORM DRAIN, DITCH, OR WATERCOURSE THROUGH USE OF SAND BAGS, OF SAND BAGS, GRAVEL, BOARDS OR OTHER APPROVED METHODS.
6. MAINTENANCE - THE ENTRANCE SHALL BE MAINTAINED IN A CONDITION WHICH WILL PREVENT TRACKING OR FLOWING OF SEDIMENT ONTO A PAVED STREET. THIS MAY REQUIRE PERIODIC TOP DRESSING WITH ADDITIONAL STONE AS CONDITIONS DEMAND, AND REPAIR AND/OR CLEANOUT OF ANY MEASURES USED TO TRAP SEDIMENT. ALL SEDIMENT SPILLED, DROPPED, WASHED OR TRACKED ONTO A PAVED STREET MUST BE REMOVED IMMEDIATELY.





**PRIMARY PURPOSE:**

REDUCES OFFSITE SEDIMENT TRACKING FROM TRUCKS AND CONSTRUCTION EQUIPMENT.


RATING IS NOT APPLICABLE

**STABILIZED CONSTRUCTION ENTRANCE**


N.T.S.

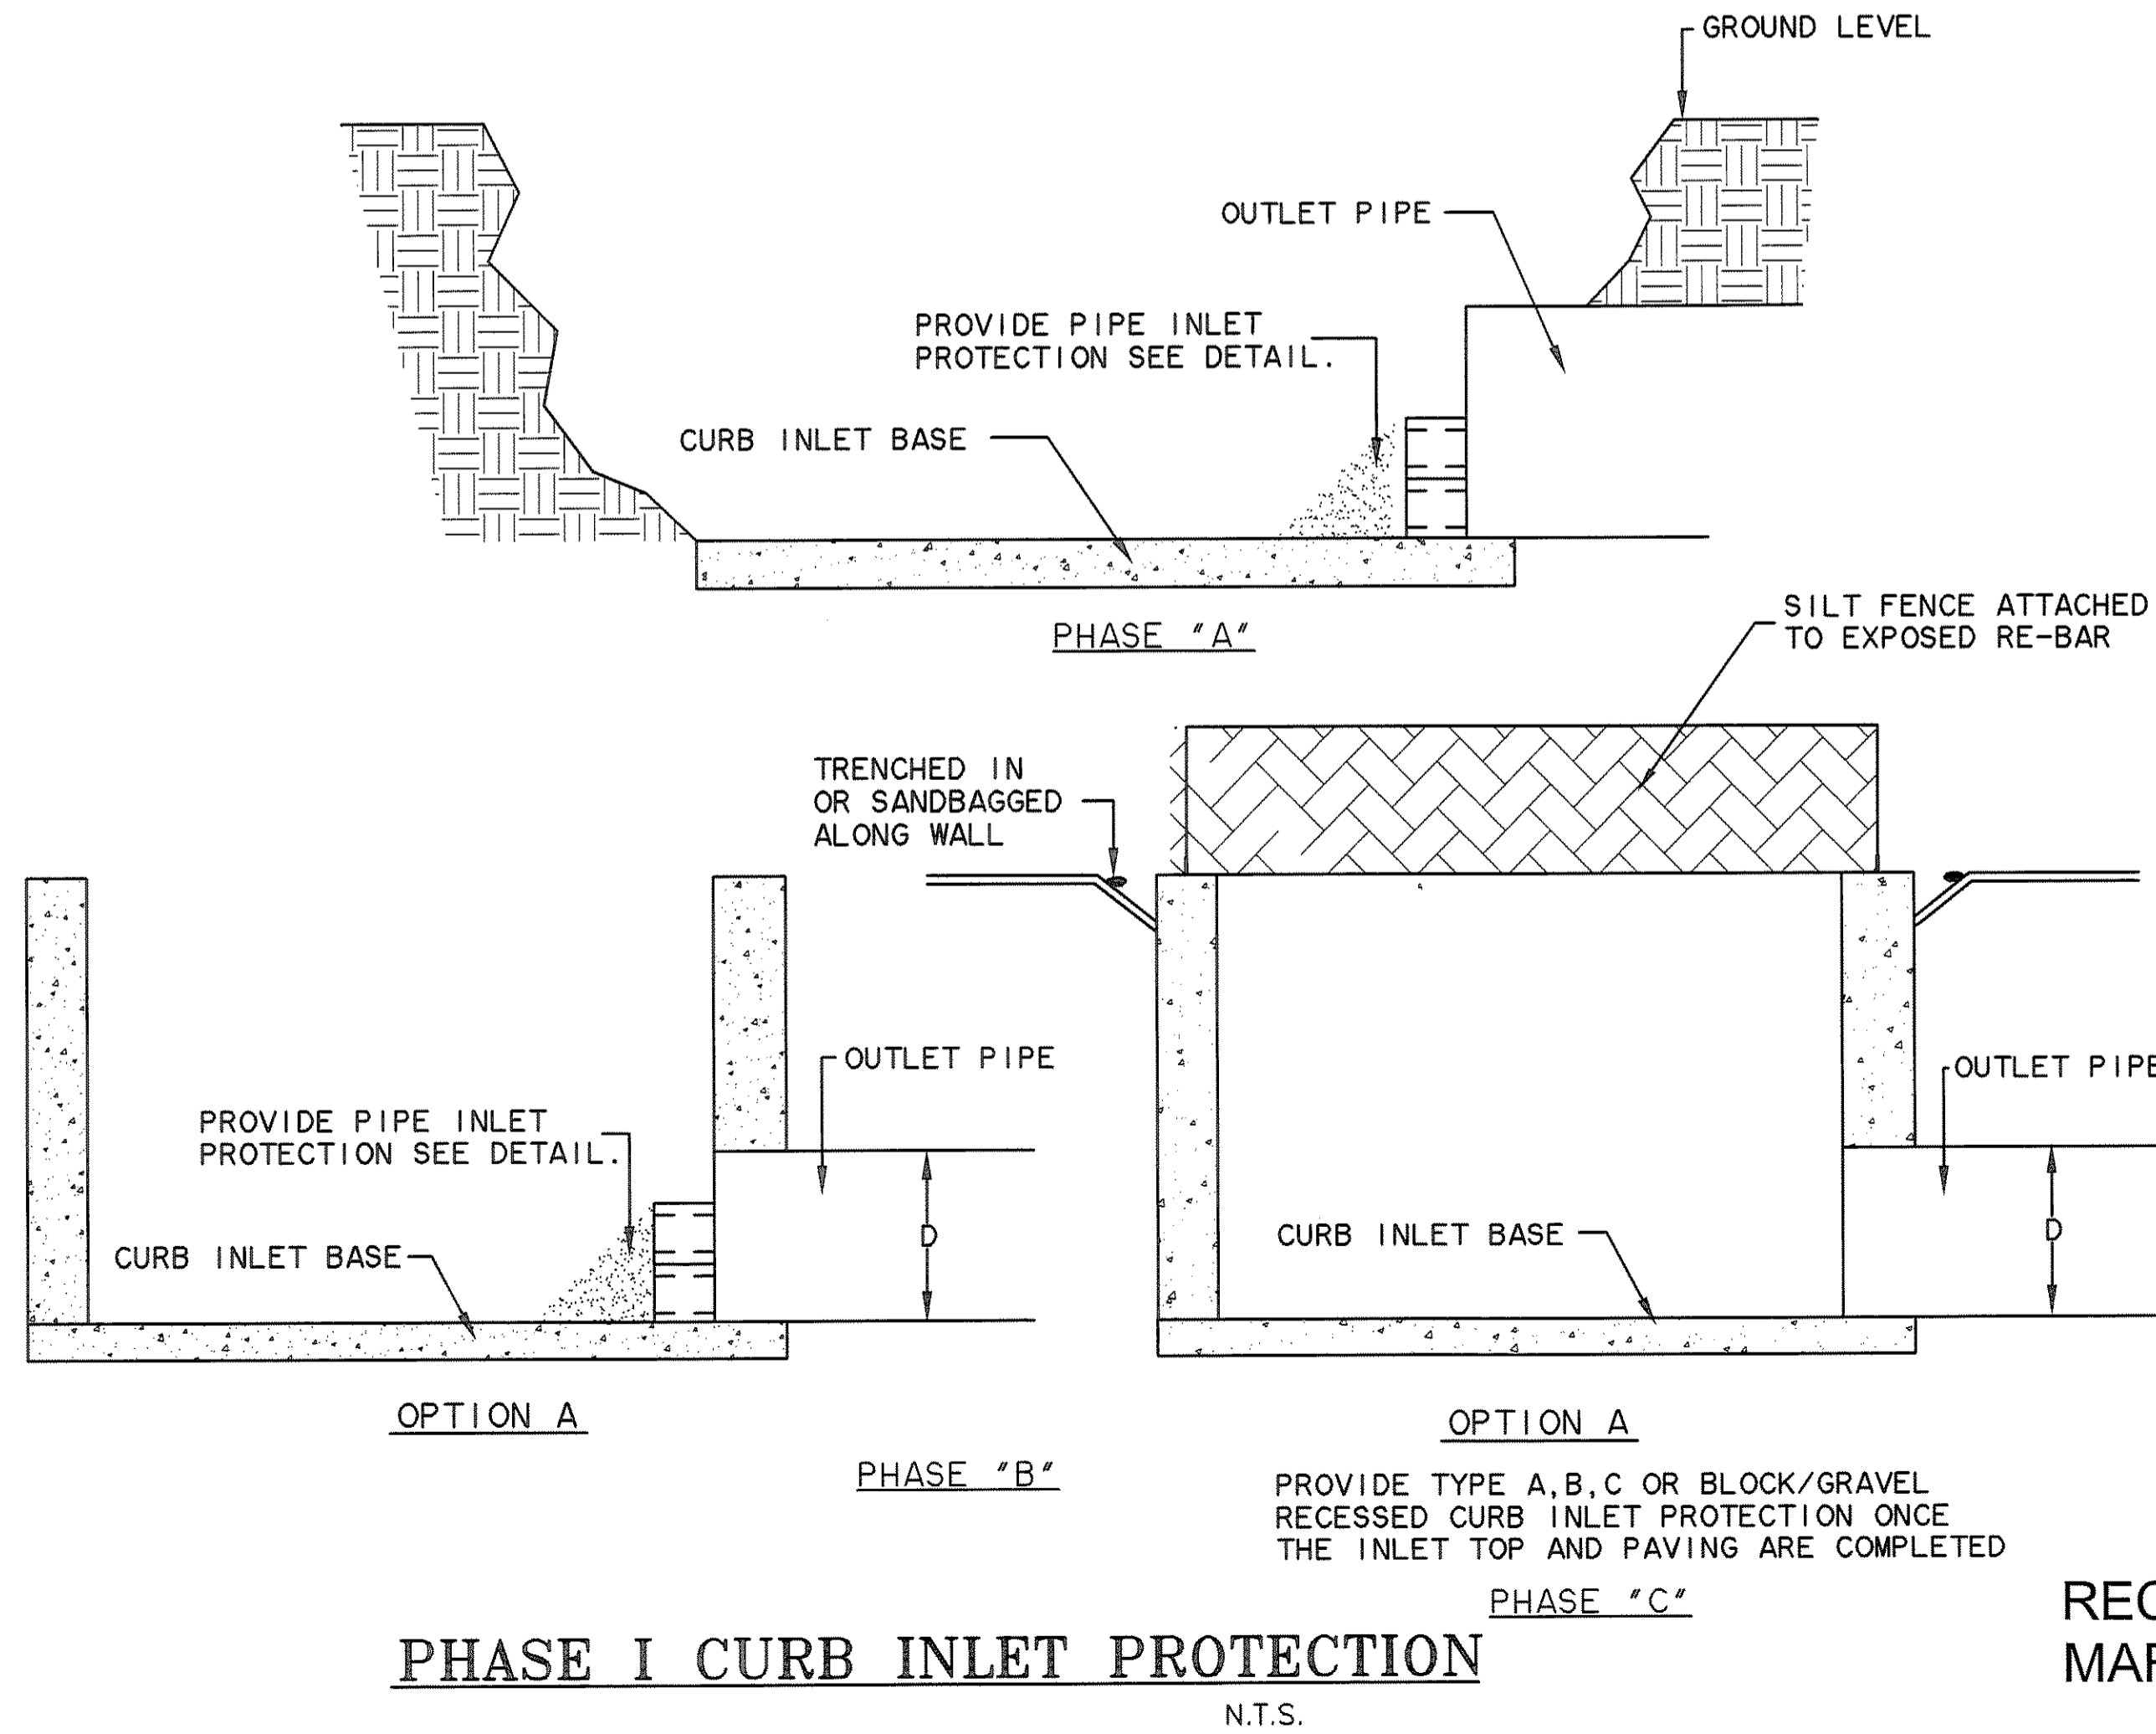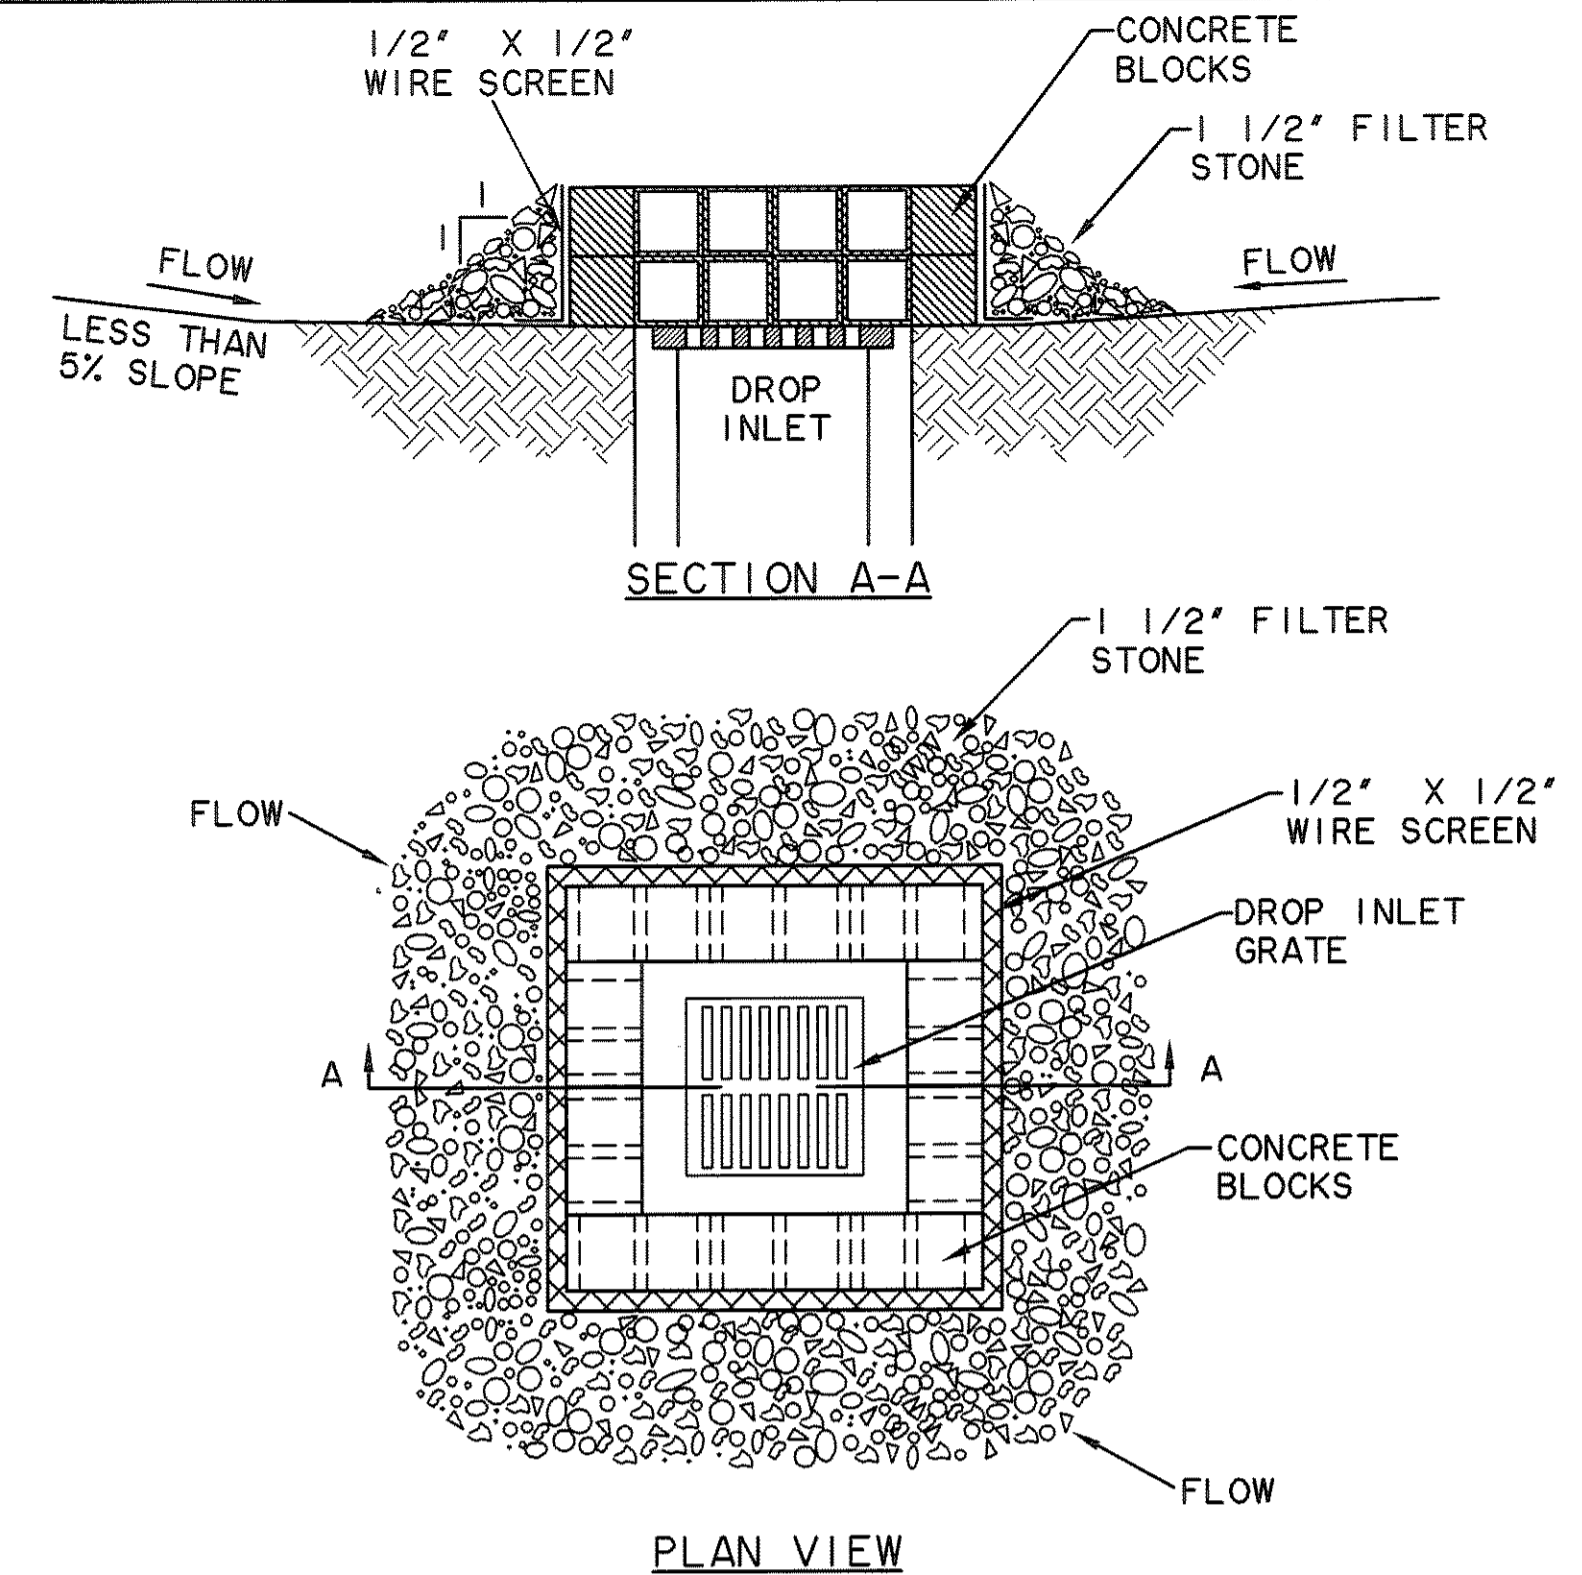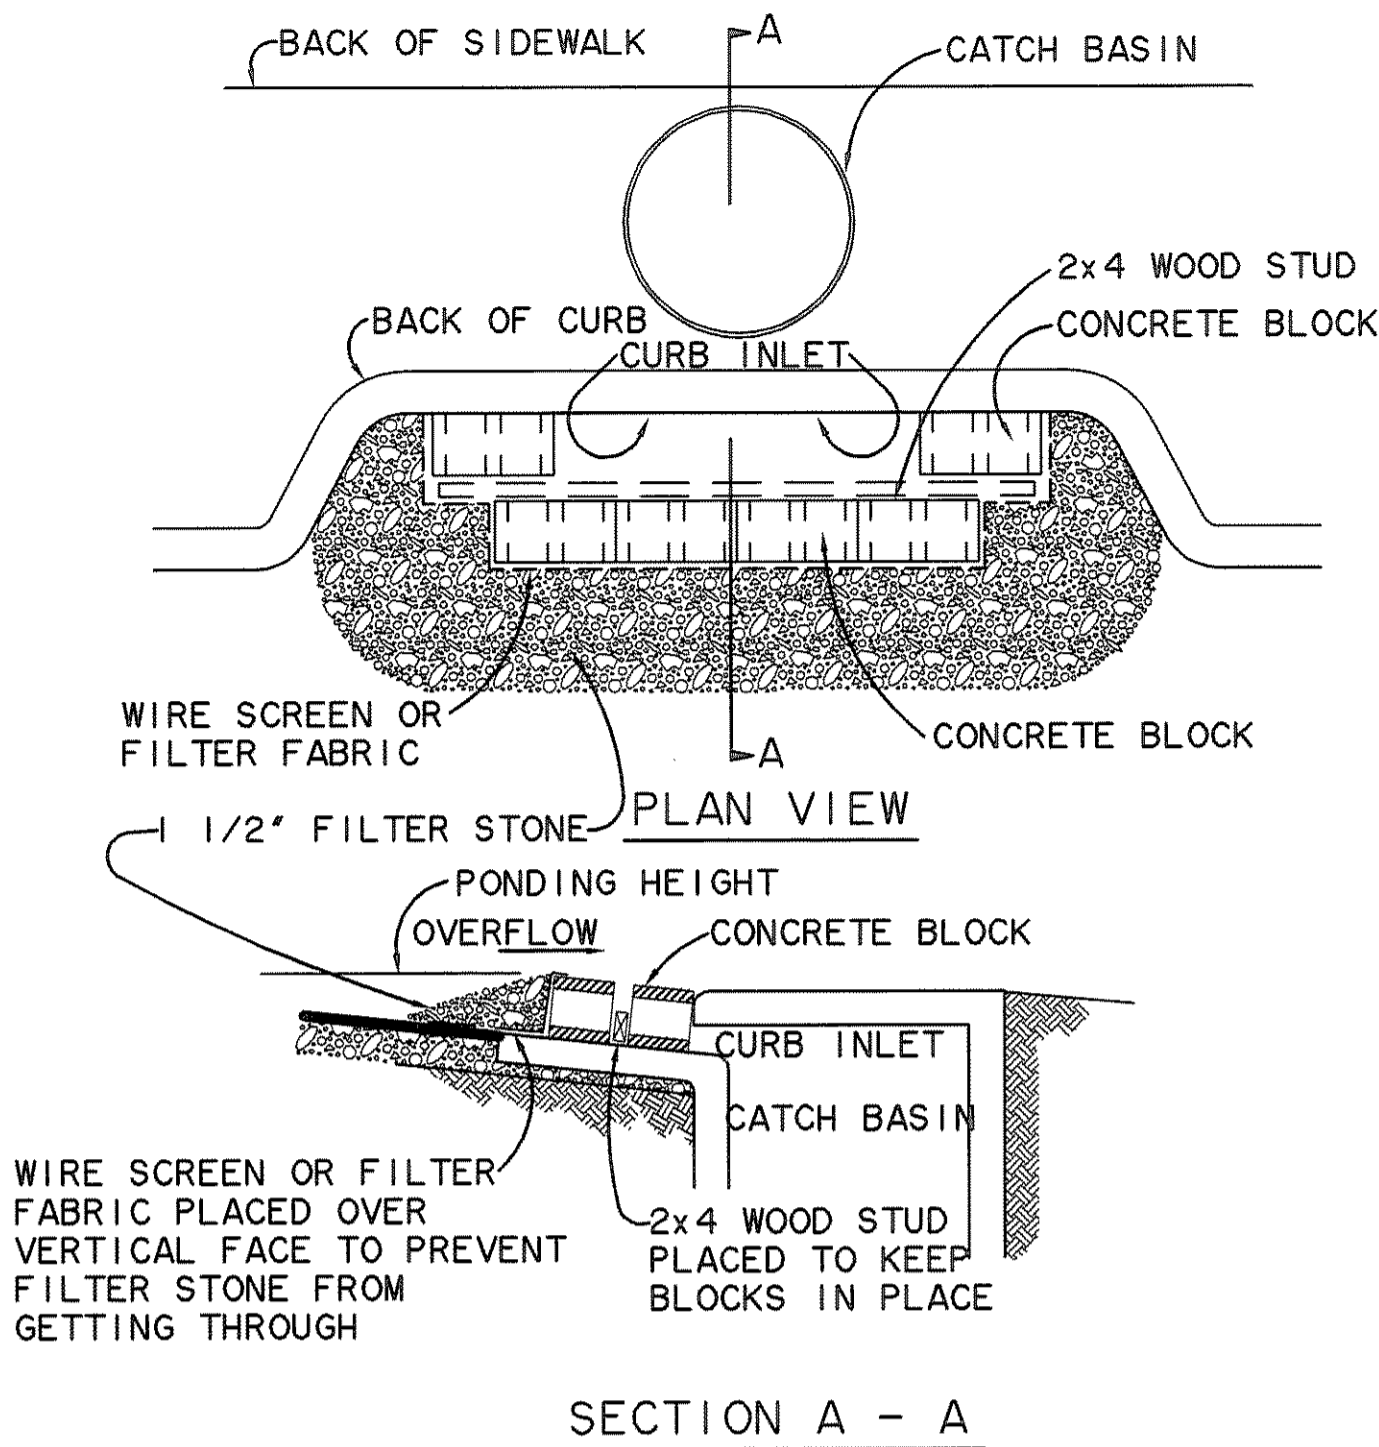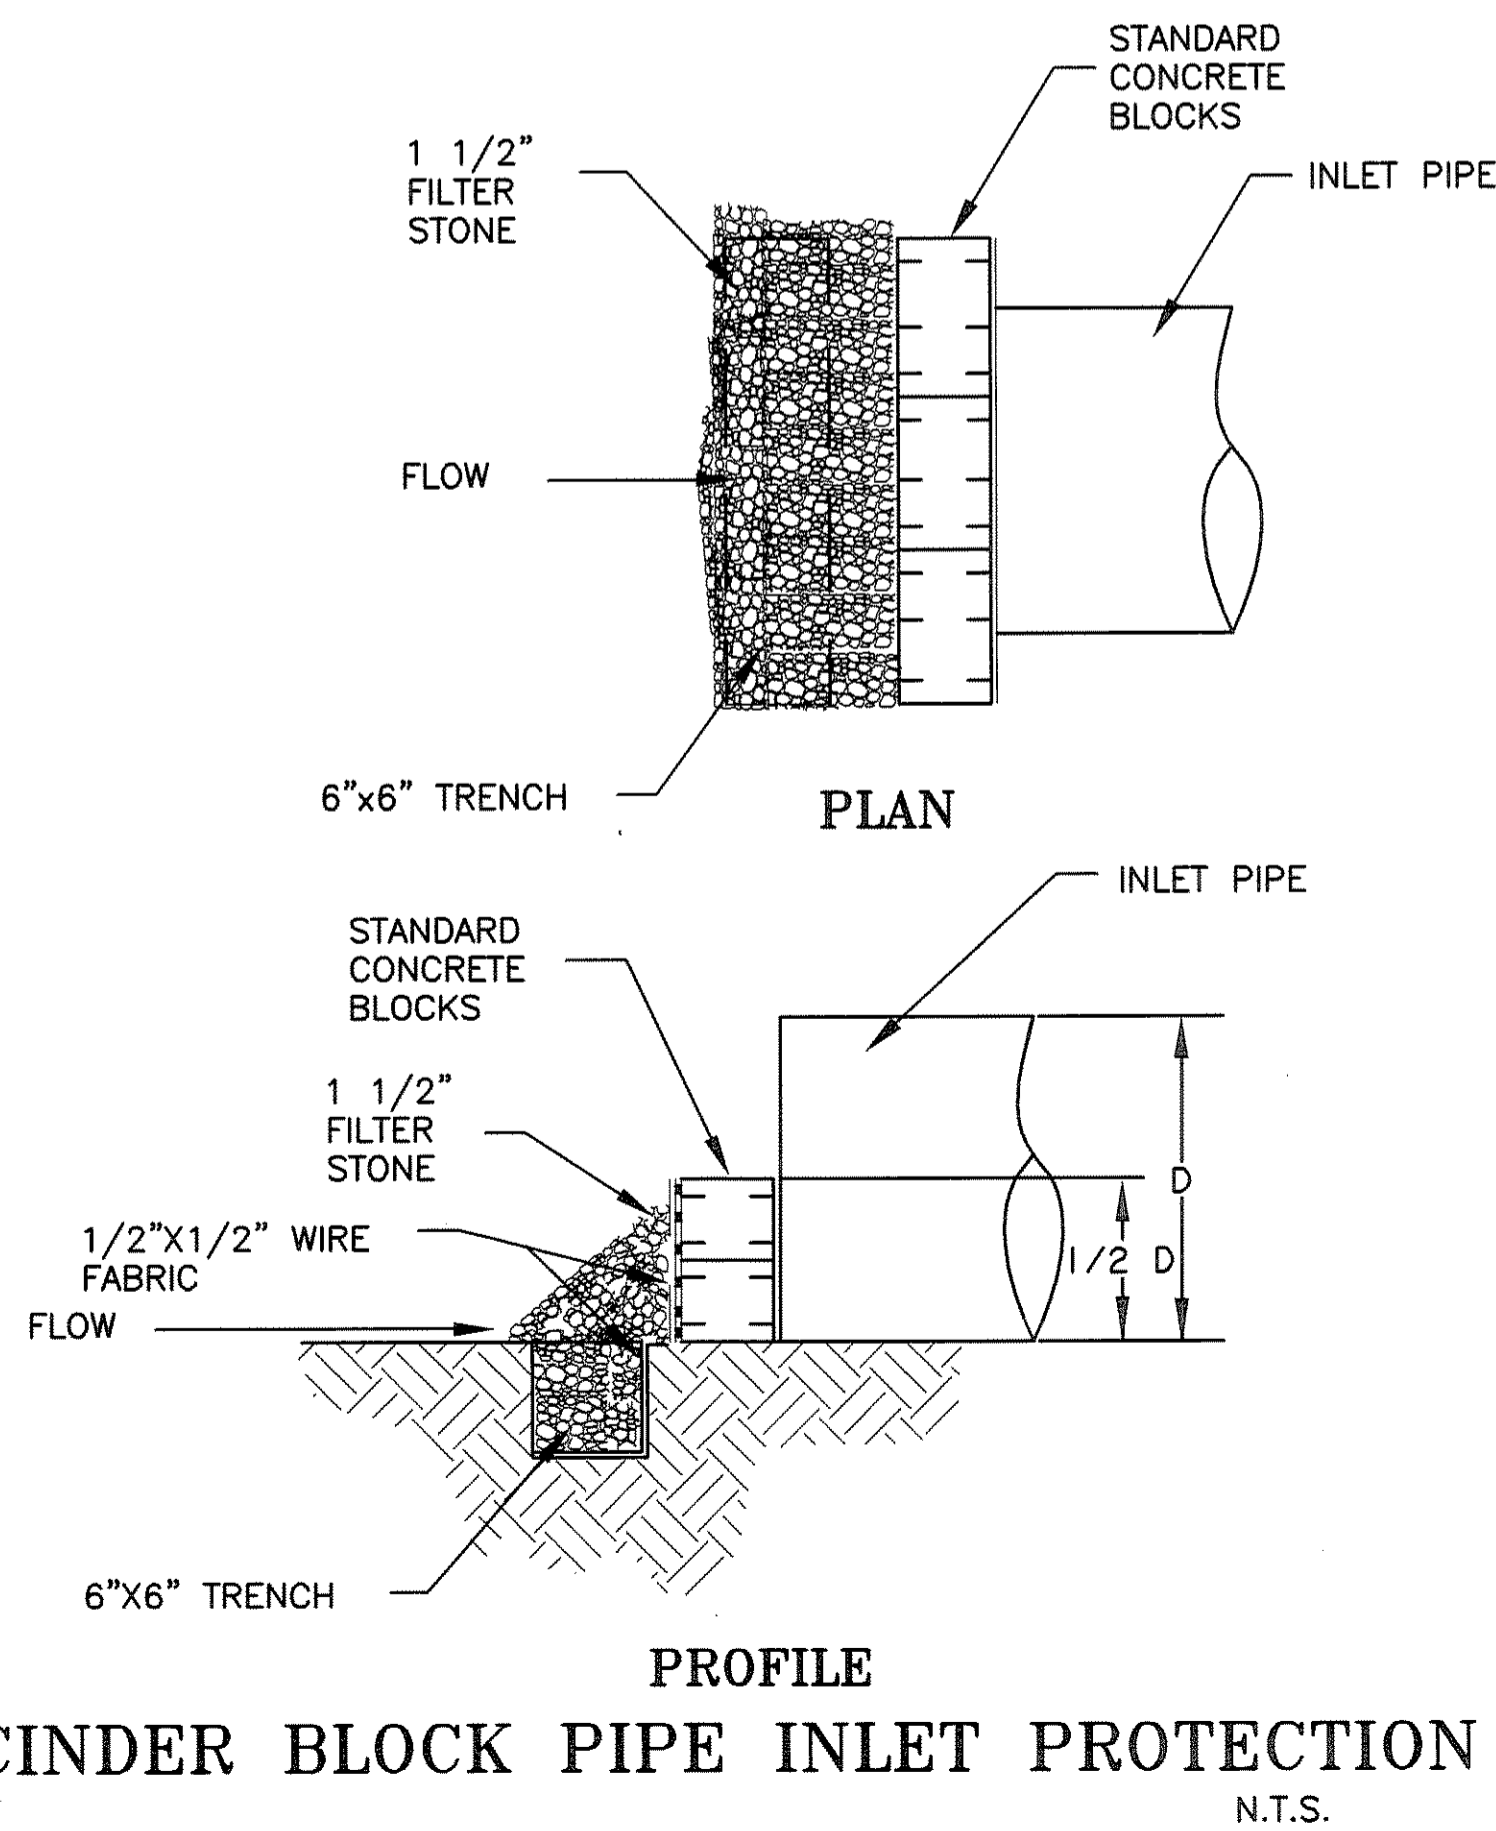

PREPARED BY:  
**WIER & ASSOCIATES, INC.**  
ENGINEERS SURVEYORS LAND PLANNERS  
4300 BELTWAY PLACE SUITE 130 ARLINGTON, TEXAS 76018 METRO (817)467-7700  
1380 U.S. HIGHWAY 287 N. SUITE 101 MARSHFIELD, TEXAS 76663 METRO (817)477-8700  
6649 ELM STREET FRODO, TEXAS 75004 METRO (214)307-8000  
www.WierAssociates.com

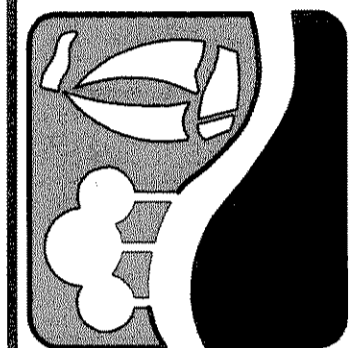

PHASE I S.H. 205 BYPASS  
FROM S.H. 276 TO INTERSTATE 30  
EROSION CONTROL  
DETAILS

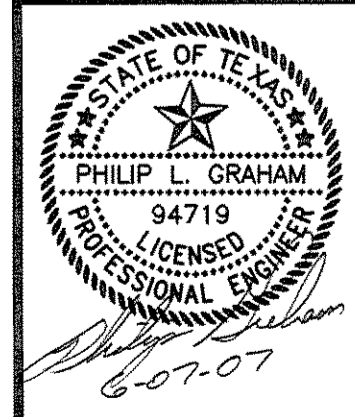


COPYRIGHT ©  
WIER & ASSOCIATES, INC.  
LAST SHEET EDIT  
DATE 06-07-2007  
WA# 04141  
SHEET NO.  
E202

RECORD PLANS  
MARCH 28, 2008

TIME: 8:50 FILE: I:\04141-ErosionDet2Phase1.dwg




TIME: 09:34 FILE: 04141-TrafficPhase1.dwg

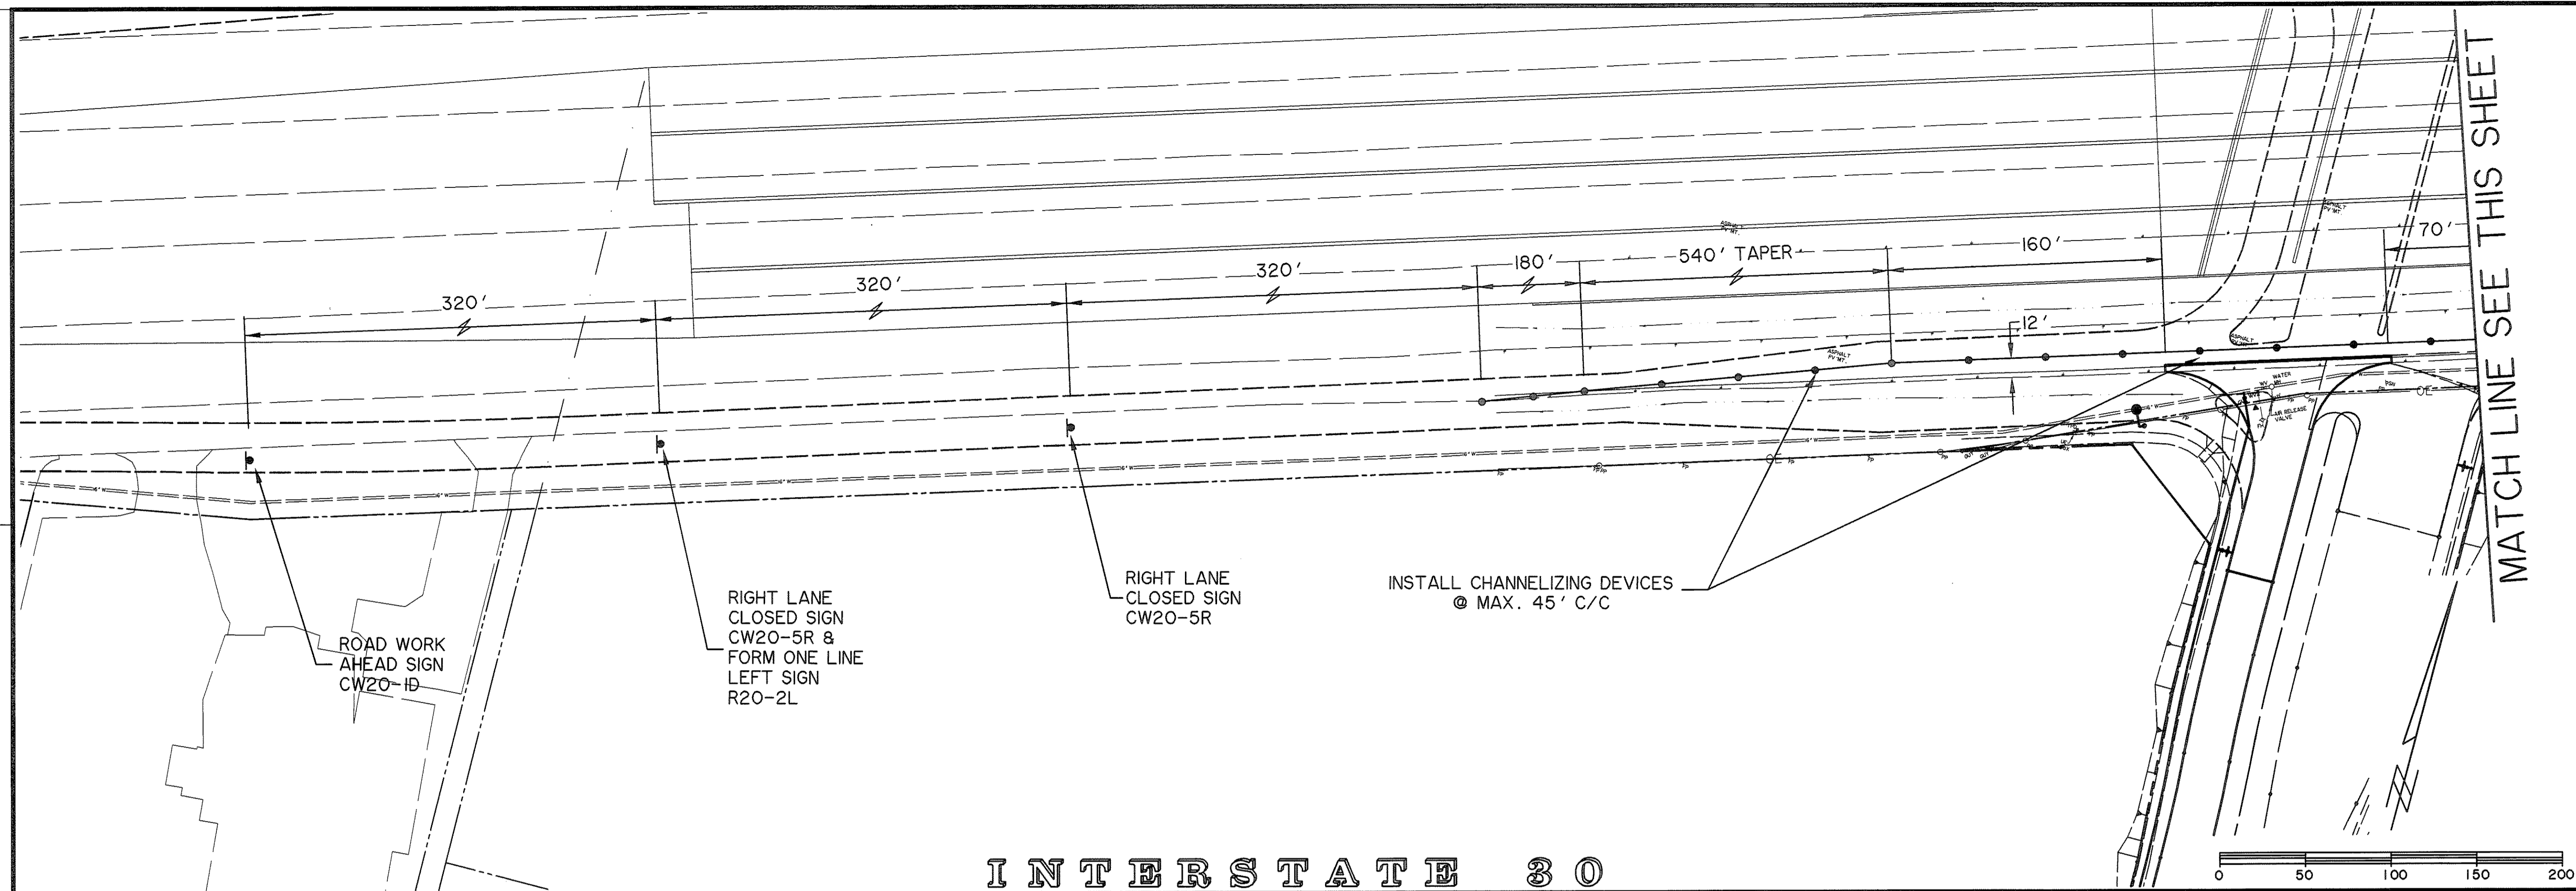

INTERSTATE 30

MATCH LINE SEE THIS SHEET

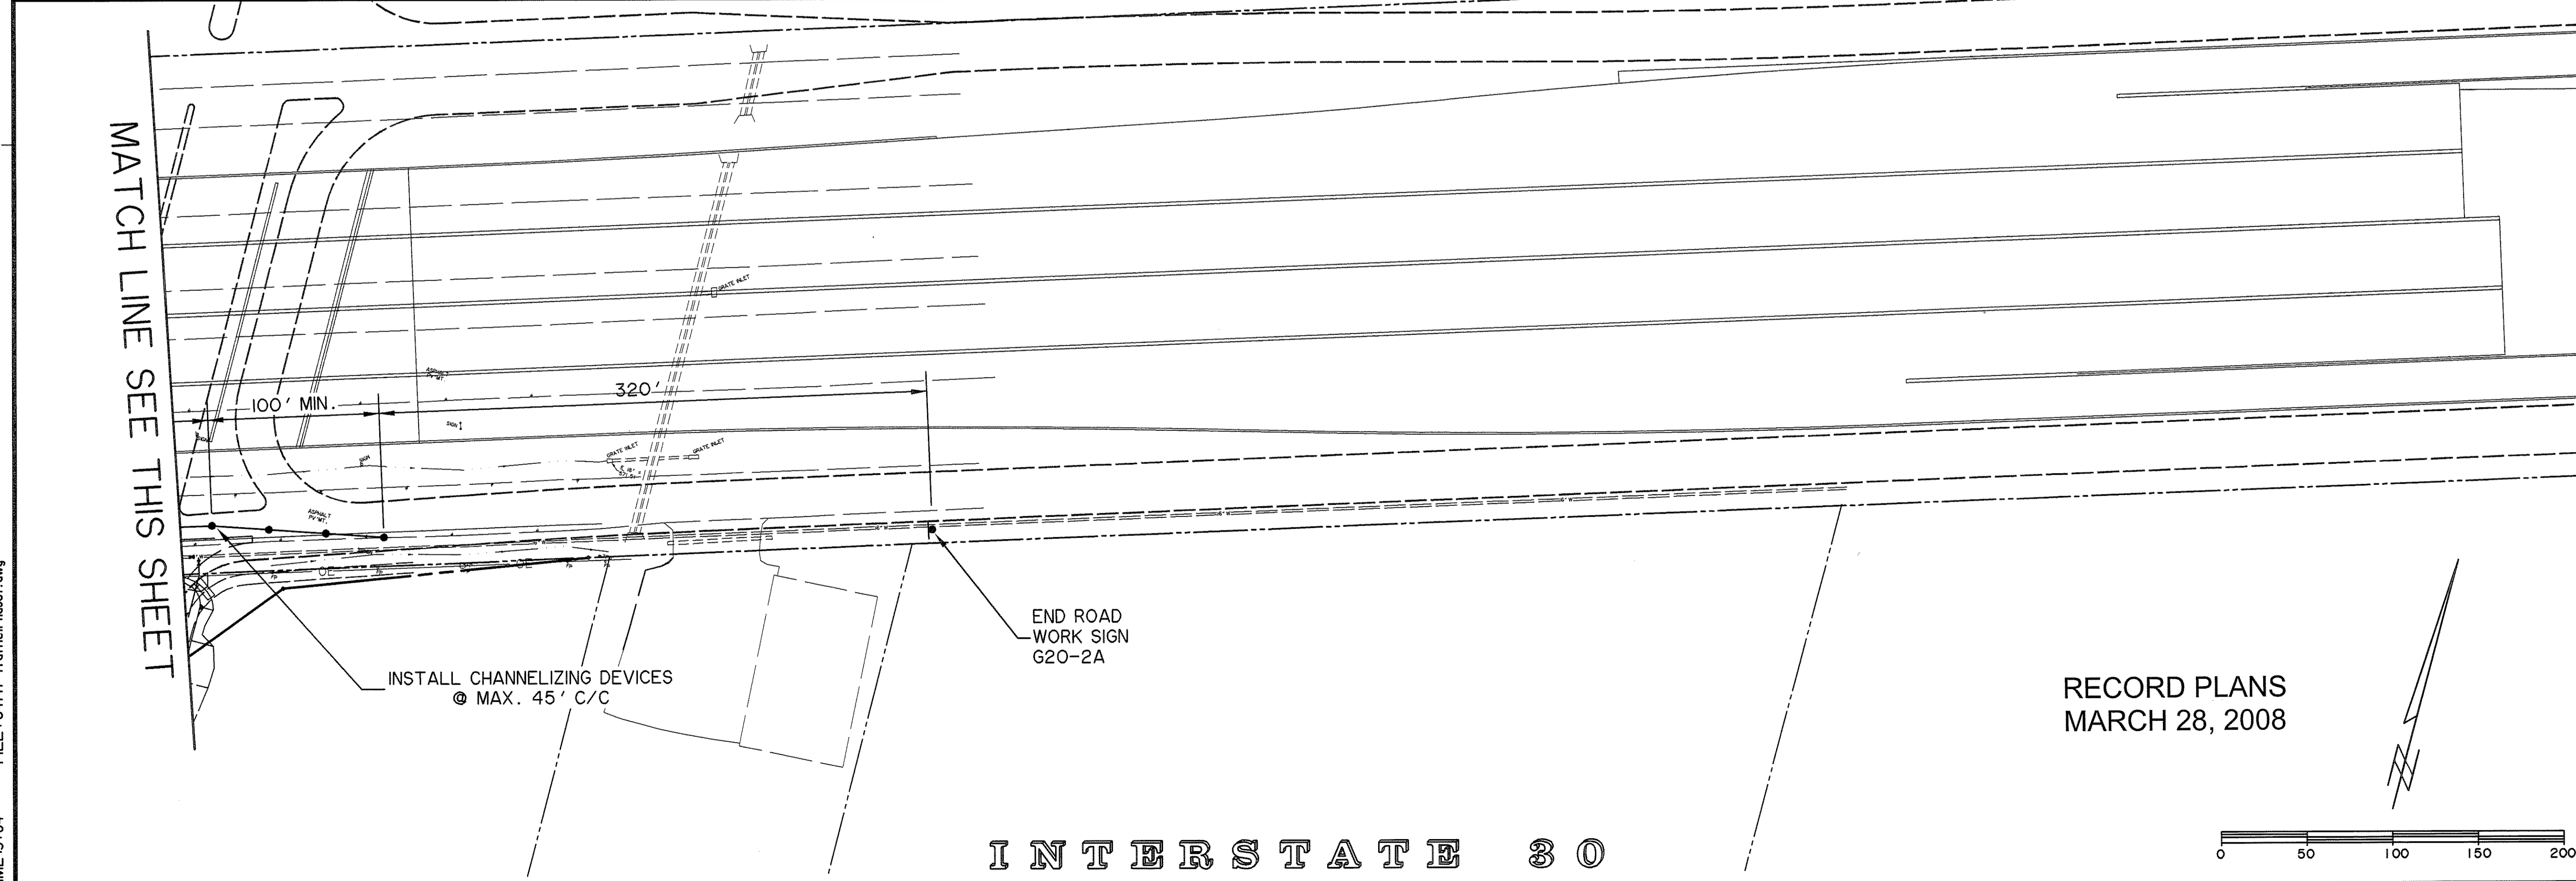

INTERSTATE 30


MATCH LINE SEE THIS SHEET

RECORD PLANS  
MARCH 28, 2008

PREPARED BY:  
**WIER & ASSOCIATES, INC.**  
 ENGINEERS SURVEYORS LAND PLANNERS  
 4300 BELWAY PLACE SUITE 130 ARLINGTON, TEXAS 76016 METRO (817)467-7700  
 1380 U.S. HIGHWAY 287 N. SUITE 101 MANSFIELD, TEXAS 76063 METRO (817)717-6700  
 6848 ELM STREET FRISCO, TEXAS 75034 METRO (214)397-8000  
 www.wierassociates.com





PHASE I SH. 205 BYPASS  
 FROM SH. 276 TO INTERSTATE 30  
 TRAFFIC CONTROL  
 PLAN

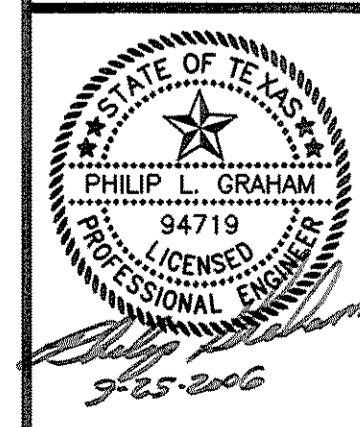


COPYRIGHT ©  
 WIER & ASSOCIATES, INC.  
 LAST SHEET EDIT  
 DATE 08-23-2006  
 WA# 04141  
 SHEET NO.  
 T101

TIME 19.1.35 FILE: 04141-Traffic2Phase1.dwg

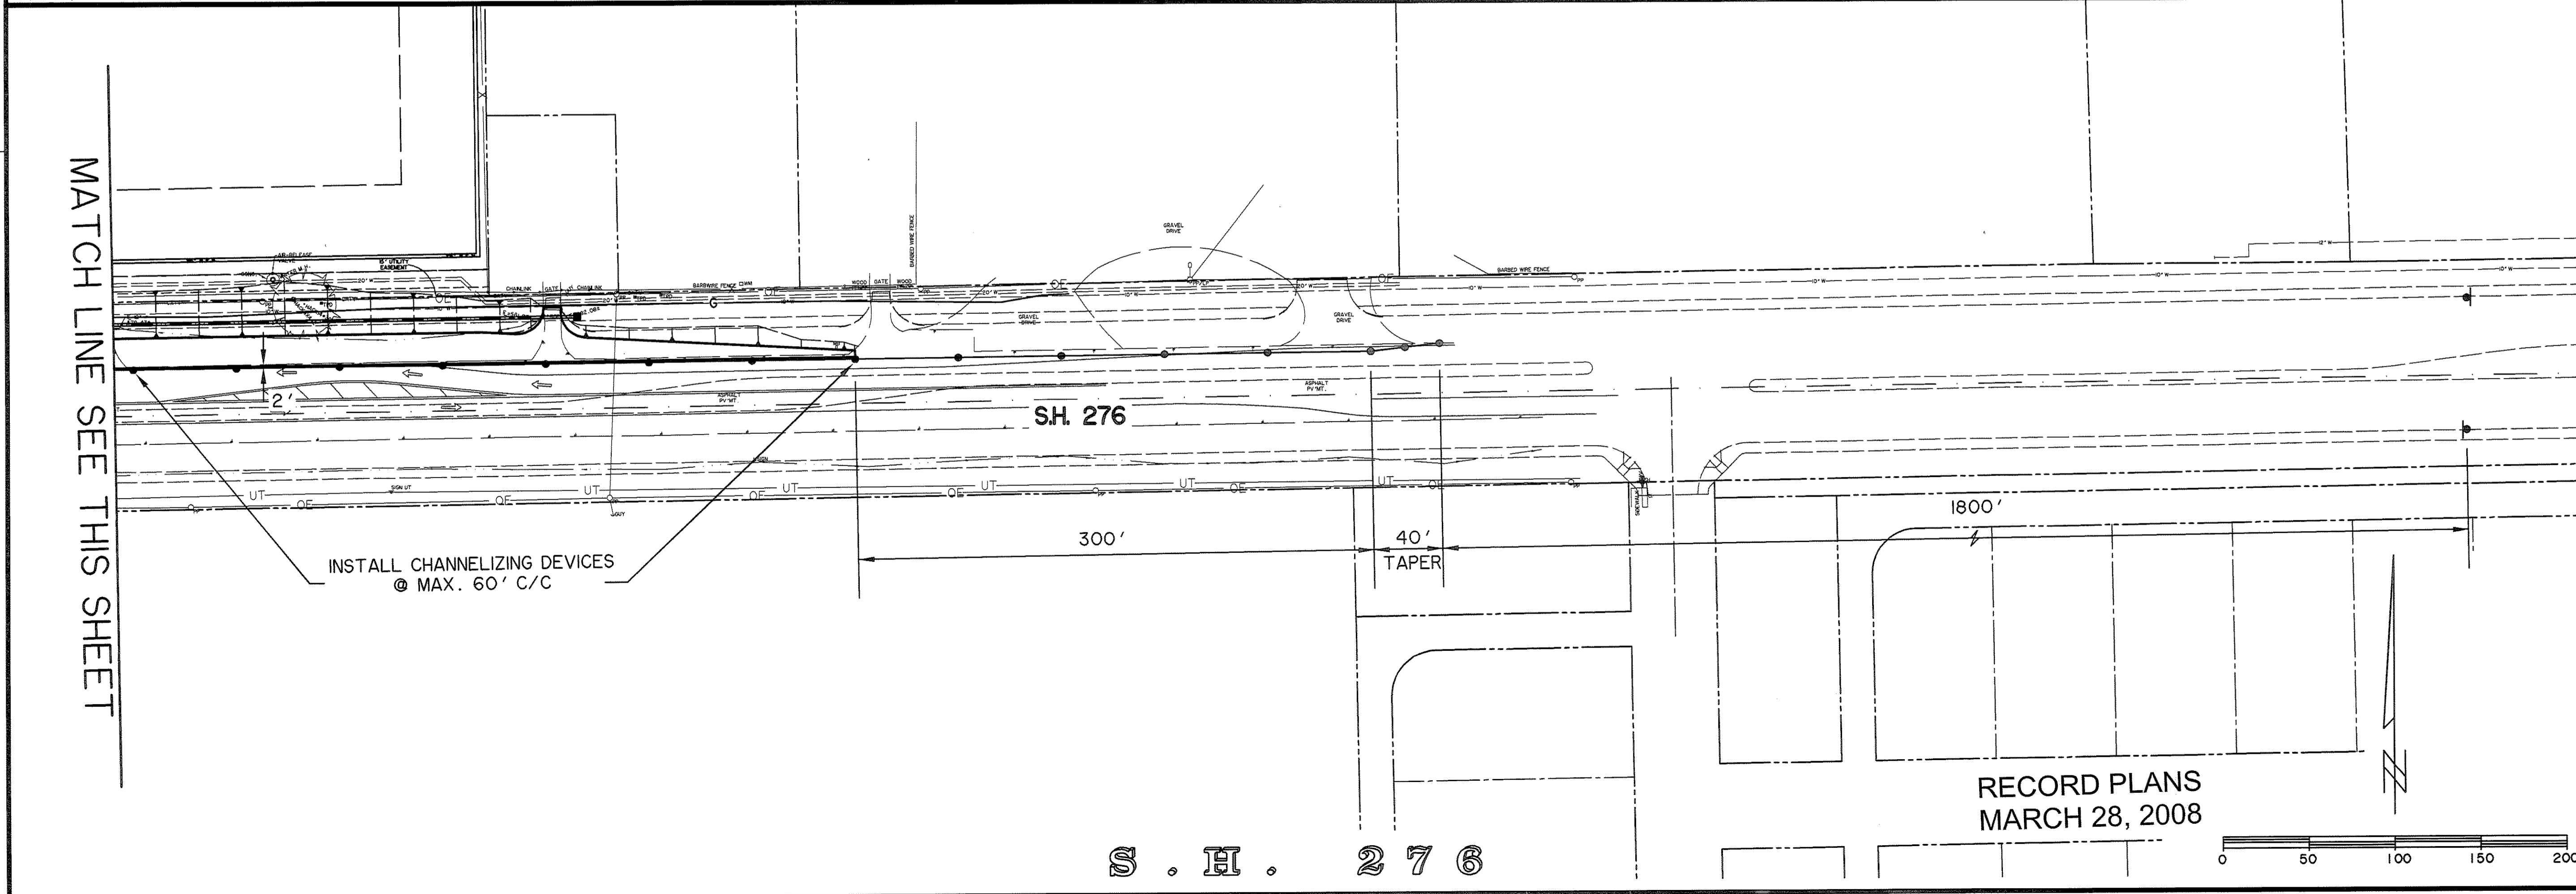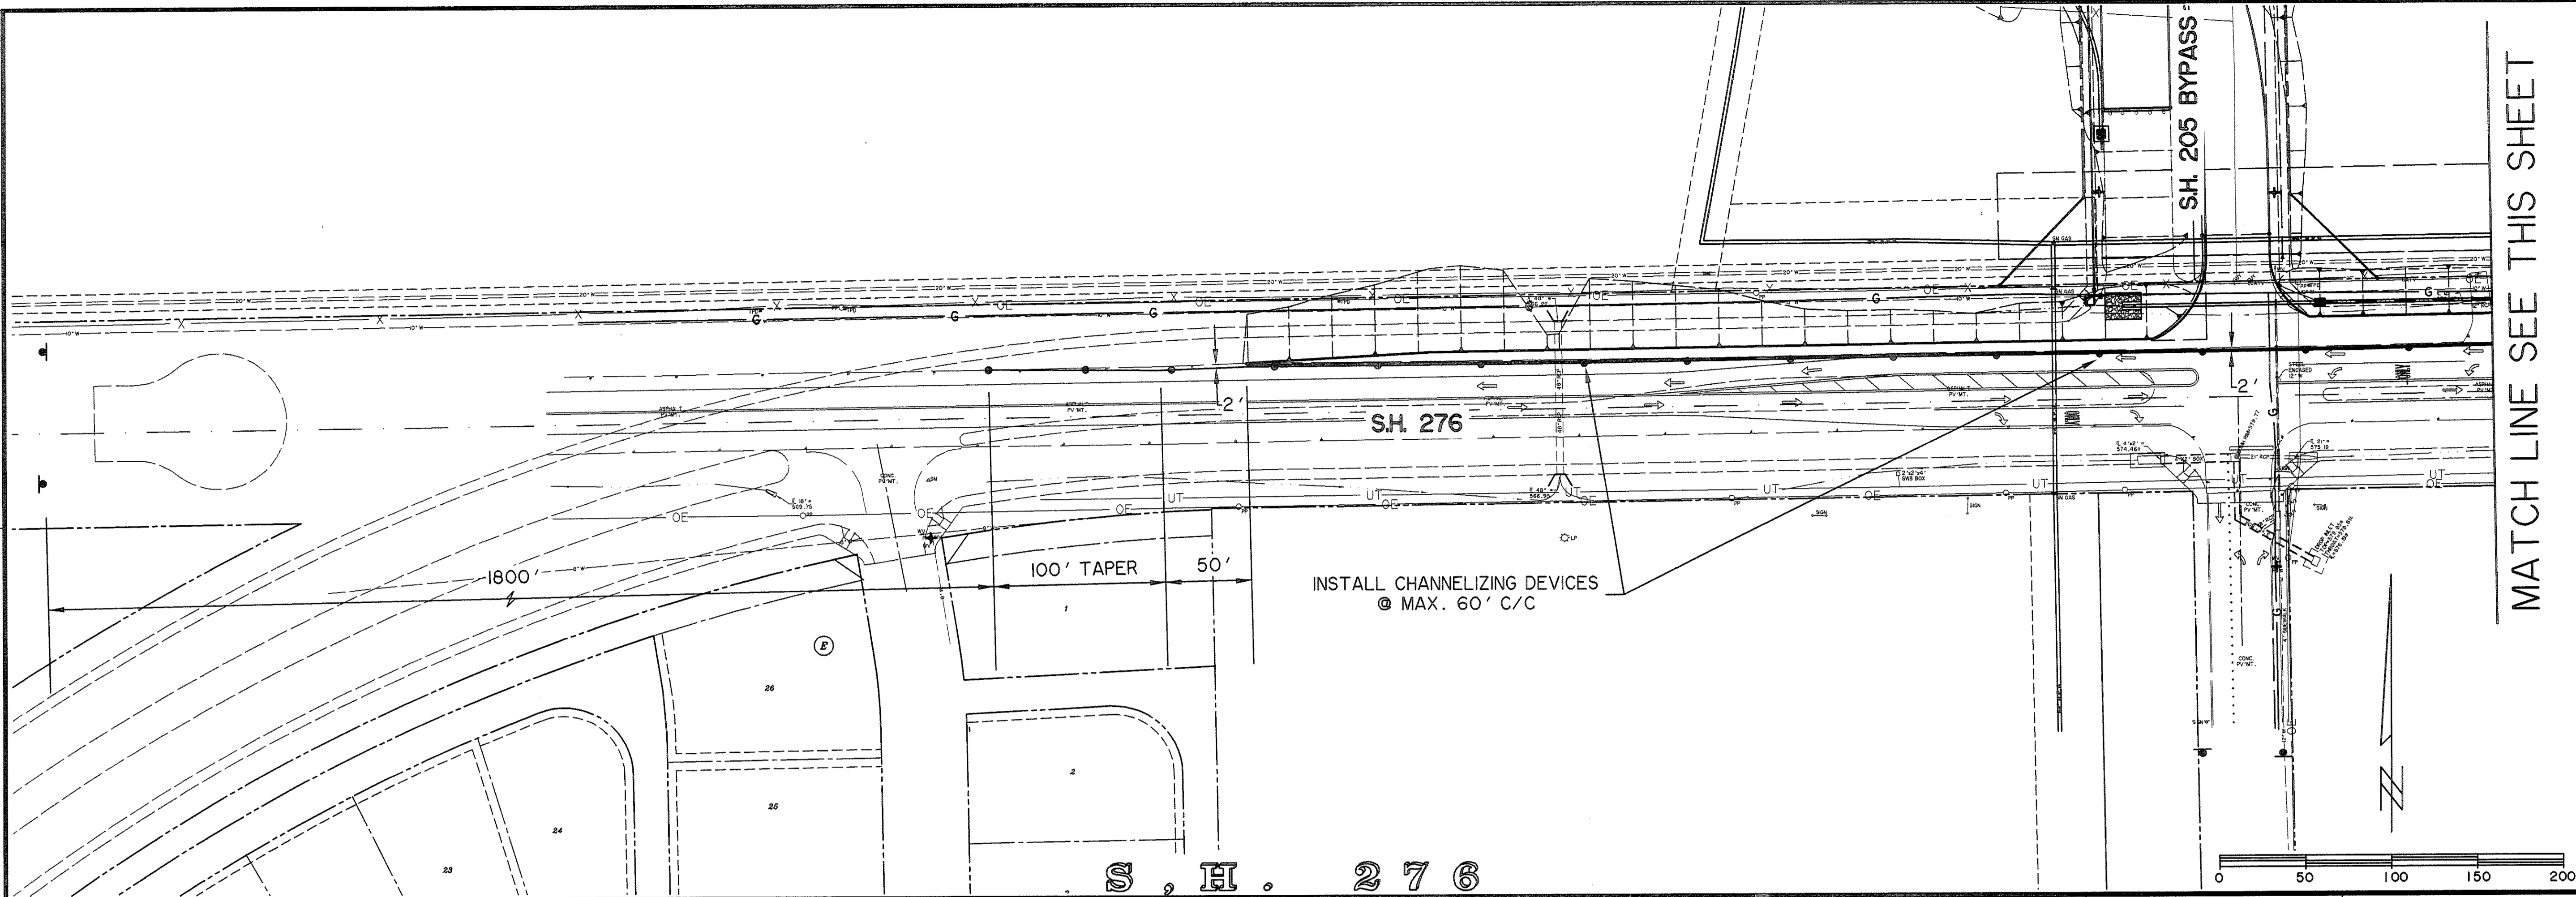


RECORD PLANS  
MARCH 28, 2008

PREPARED BY:  
**WIA WIER & ASSOCIATES, INC.**  
 ENGINEERS SURVEYORS LAND PLANNERS  
 4300 BELTWAY PLACE SUITE 130 ARLINGTON, TEXAS 76018 METRO (817)467-7700  
 1380 U.S. HIGHWAY 287 N. SUITE 101 WANSFELD, TEXAS 76063 METRO (817)477-9700  
 6849 ELM STREET FRESNO, TEXAS 75034 METRO (214)387-8000  
 www.wierassociates.com

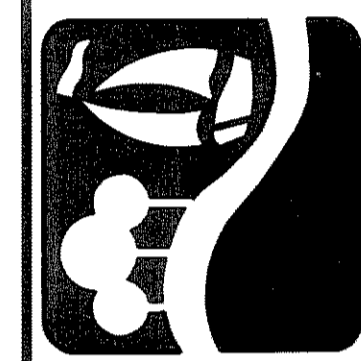


PHASE I SH. 205 BYPASS  
 FROM SH. 276 TO INTERSTATE 30  
 TRAFFIC CONTROL  
 PLAN

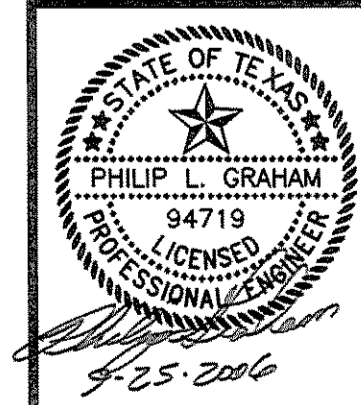

COPYRIGHT ©  
 WIER & ASSOCIATES, INC.  
 LAST SHEET EDIT  
 DATE 08-23-2006  
 WA# 04141  
 SHEET NO.  
 T102

DISCLAIMER  
 The use of this standard is governed by the "Texas Engineering Practice Act". No warranty of any kind is made by TxDOT for any purpose whatsoever. TxDOT assumes no responsibility for the conversion of this standard to other formats or for incorrect results or damages resulting from its use.

DN:	1	2	3	4	5	6	7	8	9	10	11	12	13	14	15	16
CK:	17	18	19	20	21	22	23	24	25	26	27	28	29	30	31	32
DW:	33	34	35	36	37	38	39	40	41	42	43	44	45	46	47	48
CK:	49	50	51	52	53	54	55	56	57	58	59	60	61	62	63	64

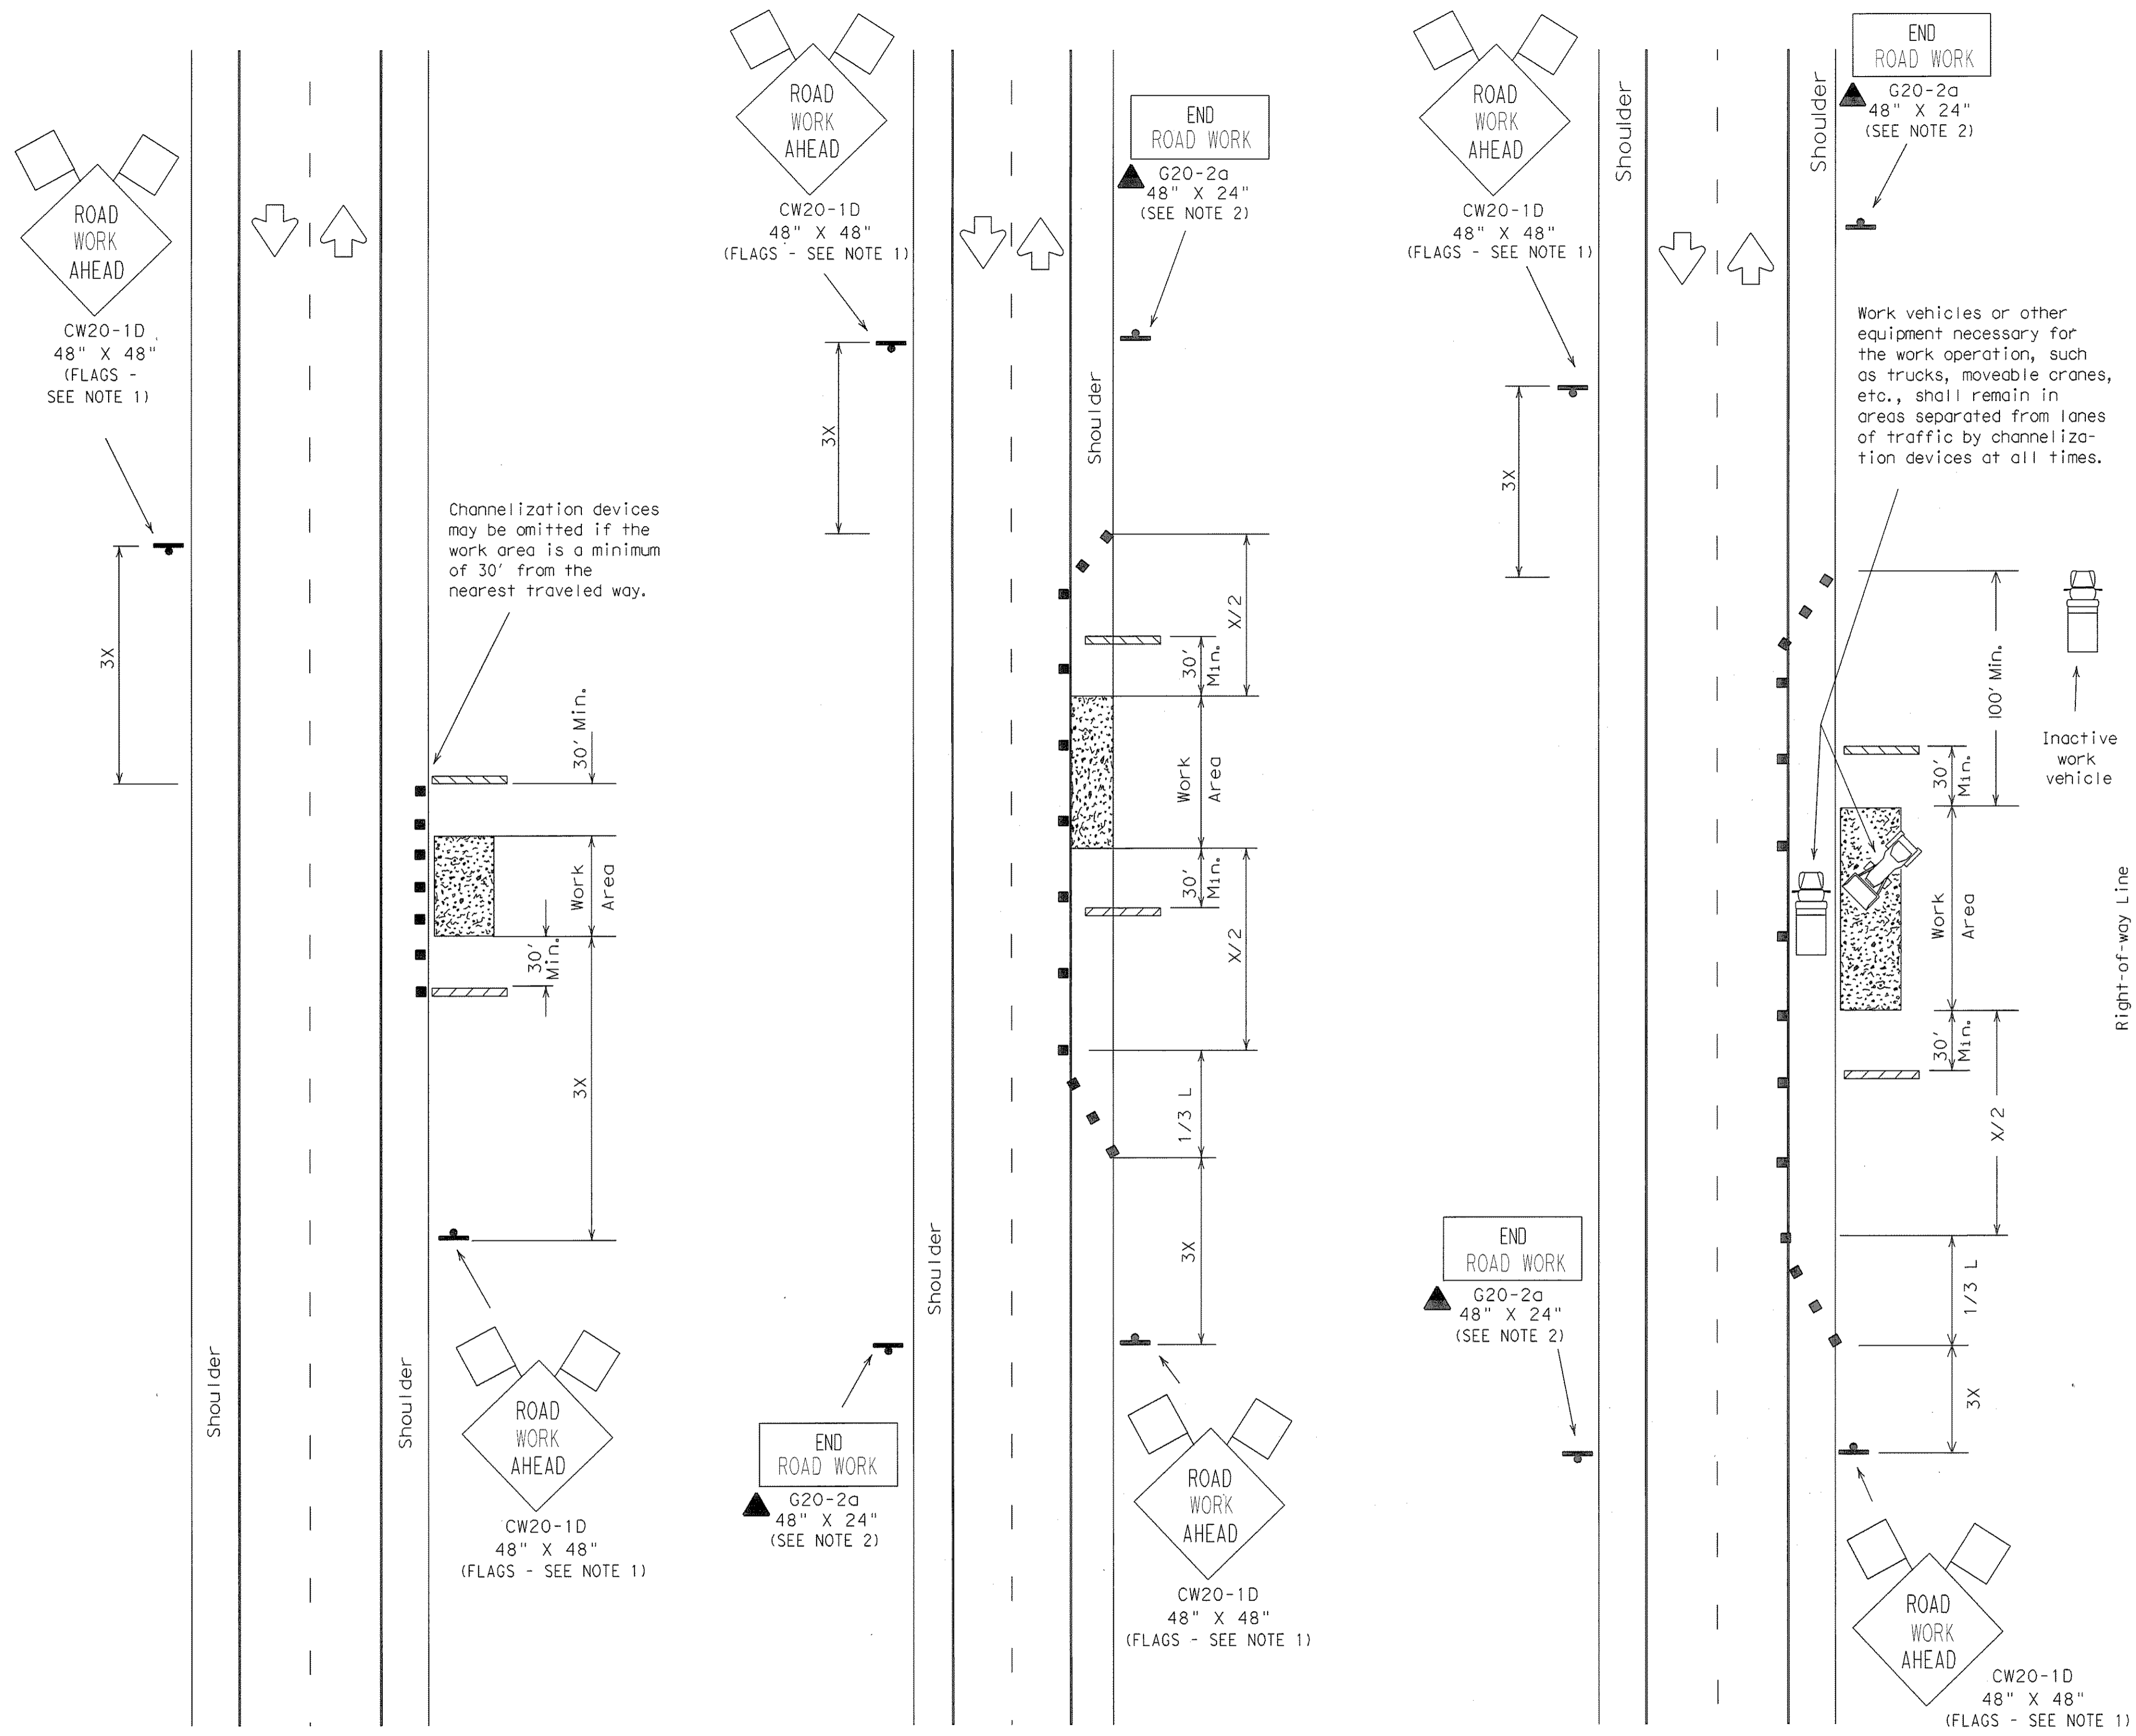

LEGEND

	Type III Barricade		Channelizing Devices		Flag
	Heavy Work Vehicle		Truck Mounted Attenuator		
	Trailer Mounted Flashing Arrow Panel		Portable Changeable Message Sign		
	Flagger		Sign Post		

Posted Speed X	Formula	Minimum Desirable Taper Lengths XX			Suggested Maximum Spacing of Device		Minimum Sign Spacing X Distance
		10' Offset	11' Offset	12' Offset	On a Taper	On a Tangent	
30	$L = \frac{WS^2}{60}$	150'	165'	180'	30'	60'-75'	120'
35		205'	225'	245'	35'	70'-90'	160'
40		265'	295'	320'	40'	80'-100'	240'
45	L=WS	450'	495'	540'	45'	90'-110'	320'
50		500'	550'	600'	50'	100'-125'	400'
55		550'	605'	660'	55'	110'-140'	500'
60		600'	660'	720'	60'	120'-150'	* 600'
65		650'	715'	780'	65'	130'-165'	* 700'
70	700'	770'	840'	70'	140'-175'	* 800'	

X Conventional Roads Only  
 XX Taper lengths have been rounded off.  
 L=Length of Taper (FT.) W=Width of Offset (FT.) S=Posted Speed (MPH)

TYPICAL USAGE:

MOBILE	SHORT DURATION	SHORT TERM STATIONARY	INTERMEDIATE TERM STATIONARY	LONG TERM STATIONARY
	✓	✓	✓	✓

- GENERAL NOTES:
- Unless otherwise stated in the plans, flags attached to signs are **REQUIRED**.
  - All traffic control devices illustrated are **REQUIRED**, except those denoted with the triangle symbol may be omitted when stated elsewhere in the plans.
  - Type III barricades are required on both sides of work area at all times. (See BC Standards for barricade details.)
  - Stockpiled material should be placed a minimum 30' from nearest traveled way.
  - On high speed facilities advance warning signs should be installed approximately 3X from the work area or from the beginning of a lane or shoulder taper. On low speed facilities the advance warning sign should be placed on the "X" minimum distance.

Only pre-qualified products shall be used. A list of compliant products and their sources may be obtained by writing or faxing:

Standards Engineer  
 Traffic Operations Division - TE  
 Texas Department of Transportation  
 125 East 11th Street  
 Austin, Texas 78701-2483  
 Phone (512) 416-3335  
 Fax (512) 416-3161  
 E-mail TRF-STANDARD@mailgw.dot.state.tx.us

**STANDARD PLANS**  
 TEXAS DEPARTMENT OF TRANSPORTATION  
 Traffic Operations Division

**TRAFFIC CONTROL PLAN**

TCP(2-1)-98

REVISIONS	DATE	BY	CHK	APP	NEG. NO.
2-94					
8-95					
1-97					
4-98					


TxDOT December 1985  
 STATE DISTRICT FEDERAL REGION FEDERAL AID PROJECT  
 COUNTY CONTROL SECTION JOB HIGHWAY

RECORD PLANS  
 MARCH 28, 2008

DISCLAIMER  
The use of this standard is governed by the "Texas Engineering Practice Act". No warranty of any kind is made by TxDOT for any purpose whatsoever. TxDOT assumes no responsibility for the conversion of this standard to other formats or for incorrect results or damages resulting from its use.


LEVELS DISPLAYED  
1 2 3 100  
DATE: ACC: FILE:

Warning Sign Sequence  
in Opposite Direction  
same as below.

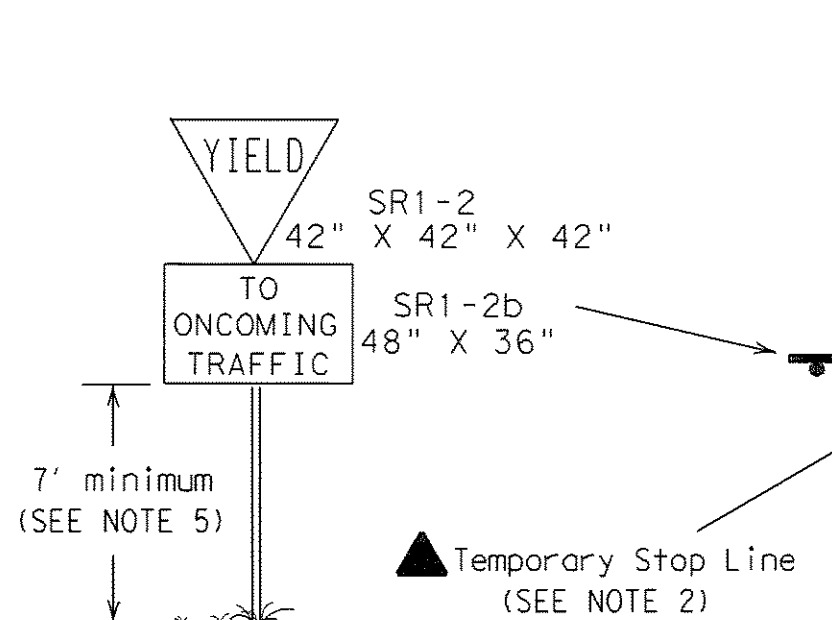






Type III barricade, channelizing devices, or shadow vehicle with orange flags or warning lights. When shadow vehicle is required, it shall be equipped with Truck Mounted Attenuator.

Temporary 24" Stop Line (SEE NOTE 2)

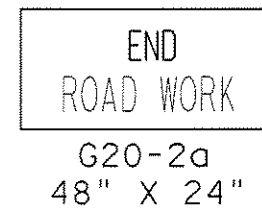

TCP (2-2a)  
2-Lane Roadway Without Paved Shoulders  
One Lane Closed  
Adequate Field of View


SR1-2b  
48" x 36"  
Legend & Boarder - Black  
Background - White  
Reflective

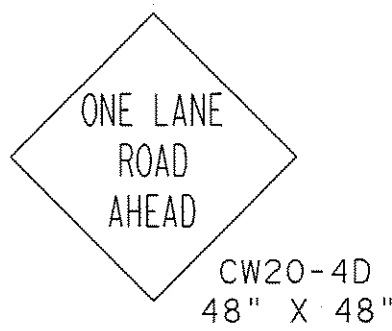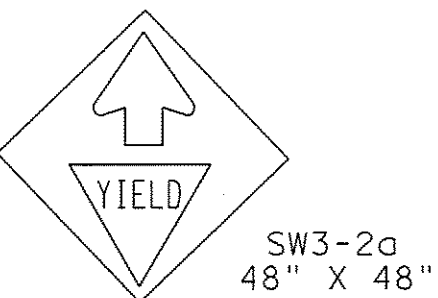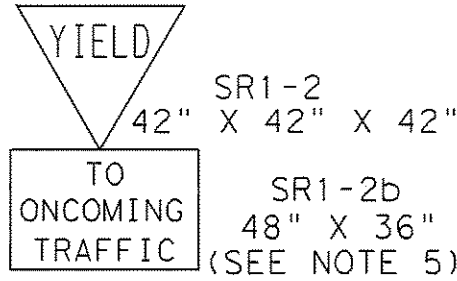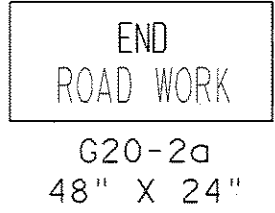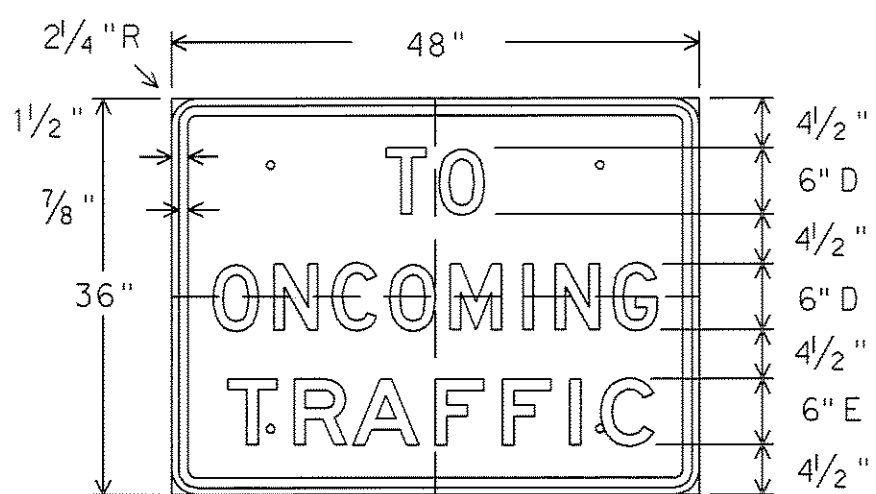

(FLAGS-SEE NOTE 1)



Type III barricade, channelizing devices, or shadow vehicle with orange flags or warning lights. When shadow vehicle is required, it shall be equipped with Truck Mounted Attenuator.

Temporary 24" Stop Line (SEE NOTE 2)


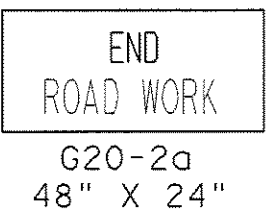


TCP (2-2b)  
2-Lane Roadway Without Paved Shoulders  
One Lane Closed  
Inadequate Field of View

The requirement for shadow vehicles will be listed in the project GENERAL NOTES, Item 502, Barricades, Signs and Traffic Handling.

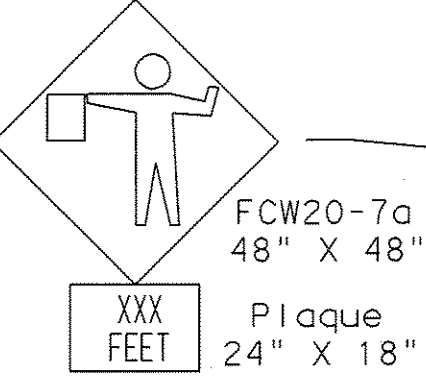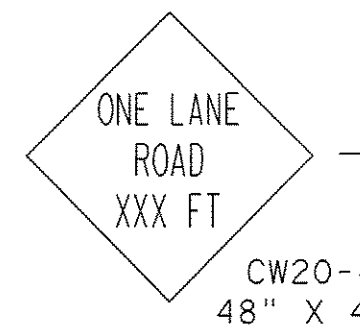

Temporary Stop Line (SEE NOTE 2)

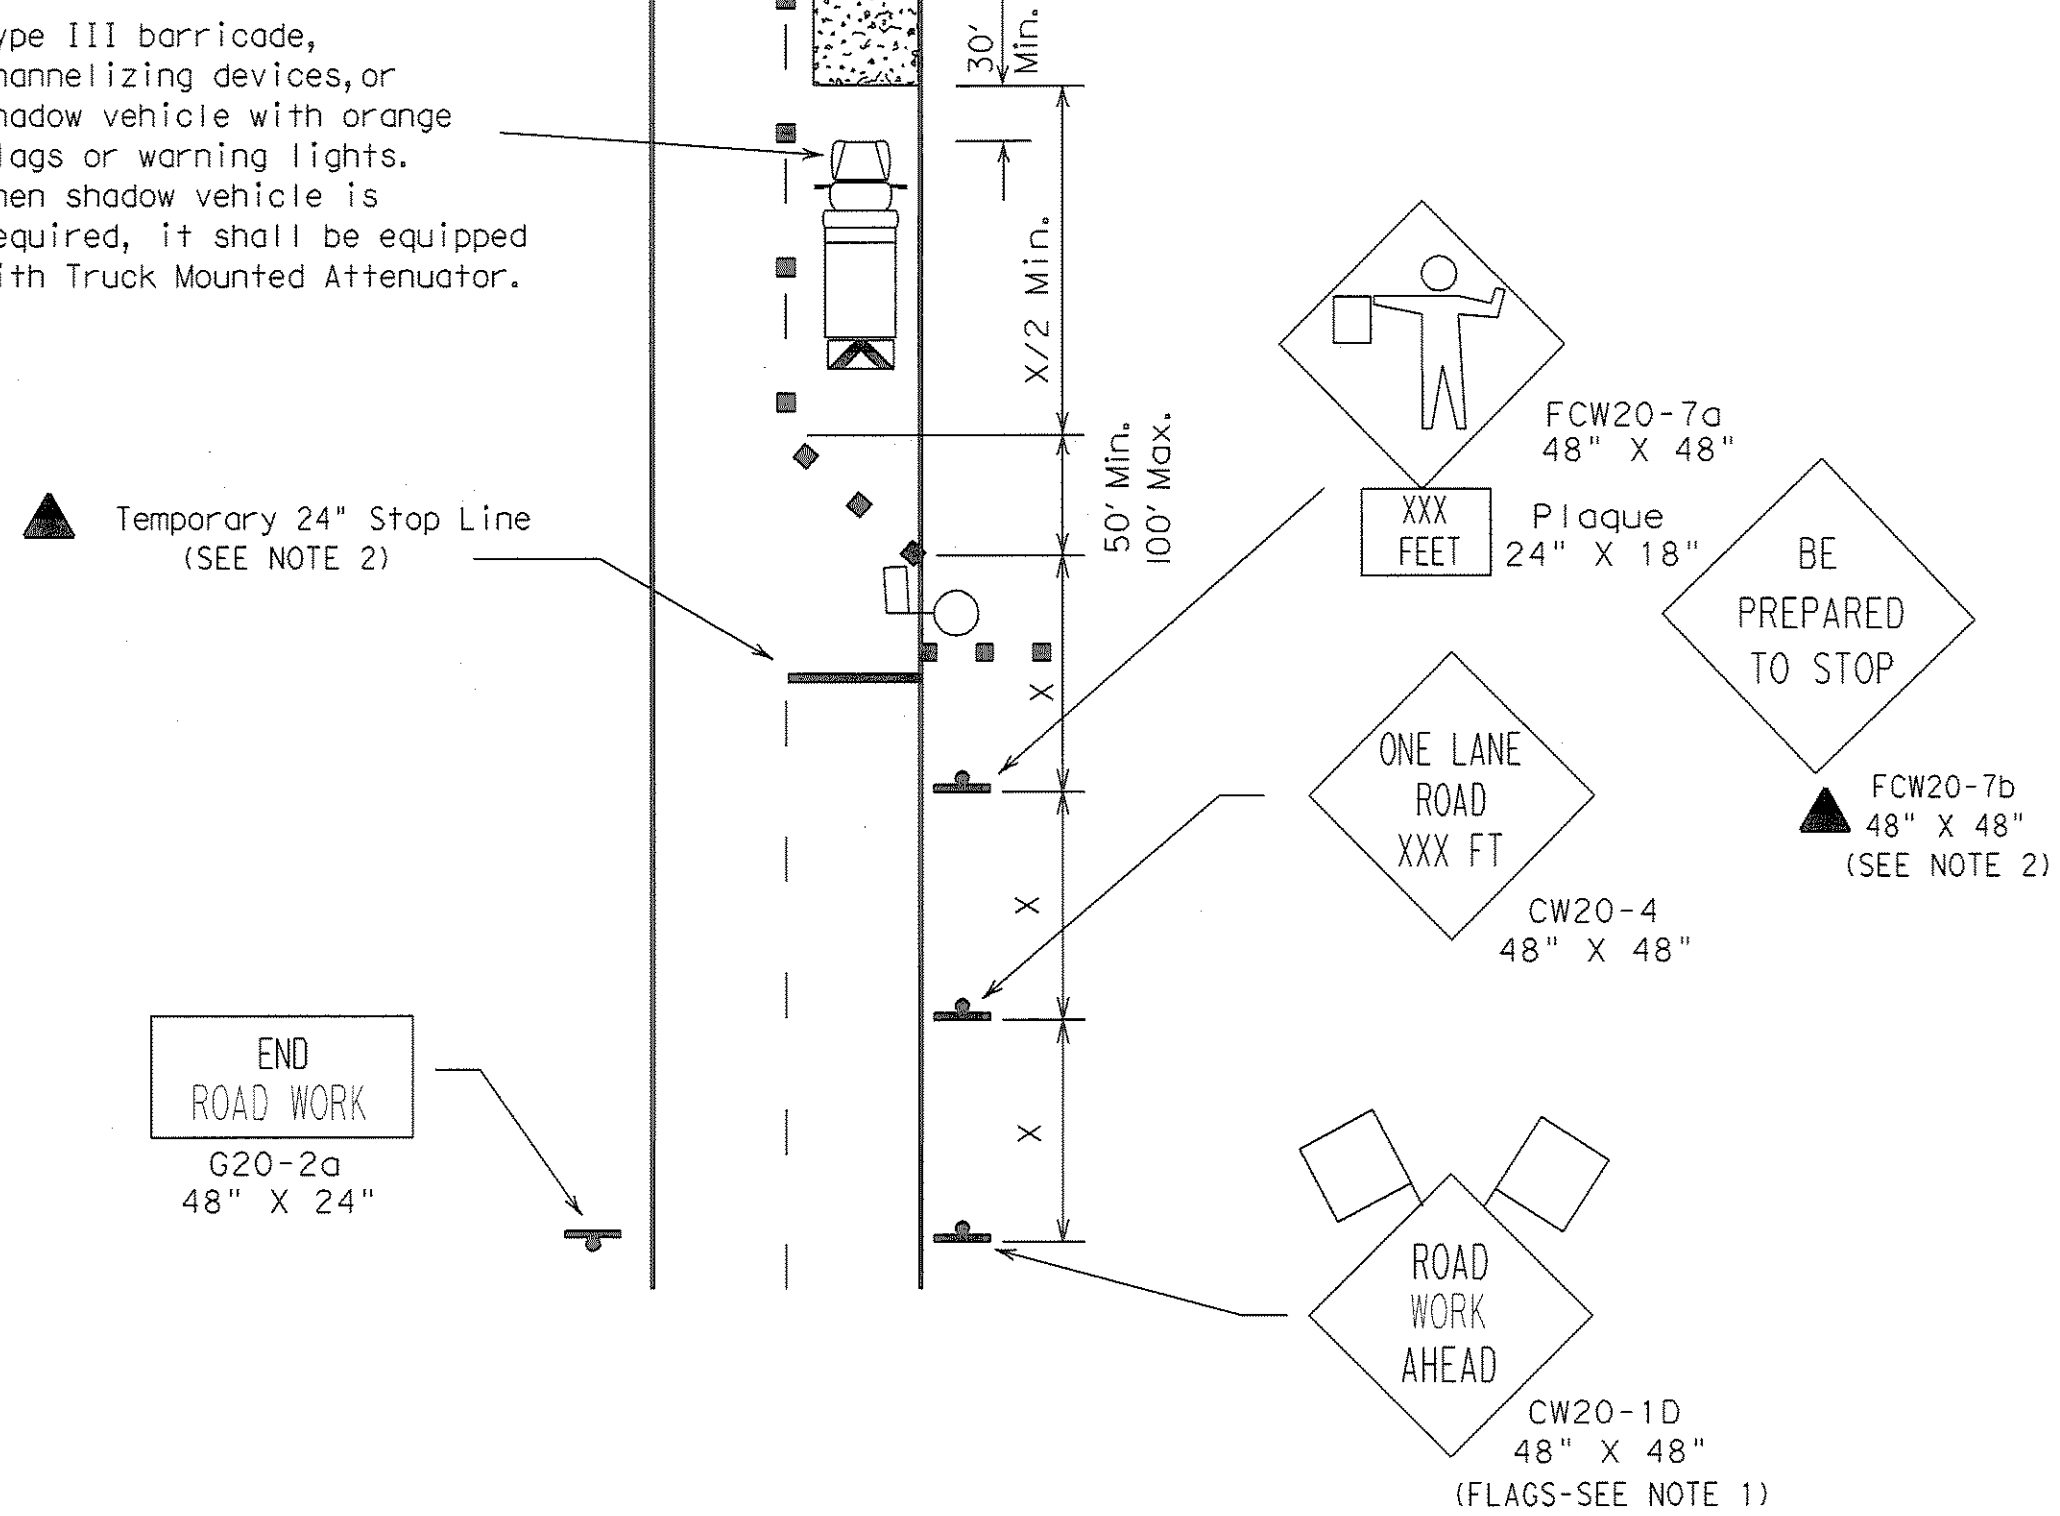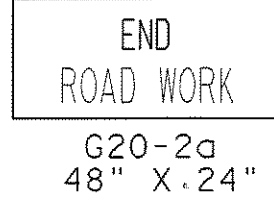

LEGEND

- Type III Barricade
- Channelizing Devices
- Flag
- Heavy Work Vehicle
- Truck Mounted Attenuator
- Trailer Mounted Flashing Arrow Panel
- Portable Changeable Message Sign
- Flagger
- Sign Post

Posted Speed X	Formula	Minimum Desirable Taper Lengths X X			Suggested Maximum Spacing of Device		Minimum Sign Spacing X Distance
		10' Offset	11' Offset	12' Offset	On a Taper	On a Tangent	
30	$L = \frac{WS^2}{60}$	150'	165'	180'	30'	60'-75'	120'
35		205'	225'	245'	35'	70'-90'	160'
40		265'	295'	320'	40'	80'-100'	240'
45	L=WS	450'	495'	540'	45'	90'-110'	320'
50		500'	550'	600'	50'	100'-125'	400'
55		550'	605'	660'	55'	110'-140'	500'
60		600'	660'	720'	60'	120'-150'	* 600'
65	650'	715'	780'	65'	130'-165'	* 700'	
70	700'	770'	840'	70'	140'-175'	* 800'	

X Conventional Roads Only  
XX Taper Lengths have been rounded off.  
L-Length of Taper (FT.) W-Width of Offset (FT.) S-Posted Speed (MPH)

TYPICAL USAGE:				
MOBILE	SHORT DURATION	SHORT TERM STATIONARY	INTERMEDIATE TERM STATIONARY	LONG TERM STATIONARY
	✓	✓	✓	

GENERAL NOTES:

- Flags attached to signs are REQUIRED.
- All traffic control devices illustrated are REQUIRED, except those denoted with the triangle symbol may be omitted when stated elsewhere in the plans.
- The BE PREPARED TO STOP sign may be installed after the ONE LANE ROAD XXX FT sign, but proper sign spacing shall be maintained.
- YIELD sign traffic control may be used on projects with approaches that have adequate sight distance. For projects in urban areas, work zones should be no longer than one half city block. In rural areas on roadways with less than 4000 ADT and work areas should be no longer than 400'.
- YIELD TO ONCOMING TRAFFIC sign shall be placed on a support at a 7' minimum mounting height.
- Flaggers should use two-way radios or other methods of communication to control traffic.
- Length of work area should be based on the ability of flaggers to communicate.
- For intermediate term situations, when it is not feasible to remove and restore pavement markings, the channelization must be made dominant by using a very close spacing. This is especially important in locations of conflicting information, such as where traffic is directed over a double yellow centerline. In such locations a maximum channelizing device spacing of 10 feet is recommended. The 10 foot channelizing device spacing recommendation is intended for the area of conflicting information and not the entire work zone.

RECORD PLANS  
MARCH 28, 2008

STANDARD PLANS  
TEXAS DEPARTMENT OF TRANSPORTATION  
Traffic Operations Division


TRAFFIC CONTROL PLAN

TCP (2-2) -03

REVISIONS		STATE DISTRICT	FEDERAL REGION	FEDERAL AID PROJECT	SHEET
8-95		6			T202
1-97					
4-98					
3-03					

DISCLAIMER  
 This standard is governed by the "Texas Engineering Practice Act". No warranty of any kind is made by TxDOT for any purpose whatsoever. TxDOT assumes no responsibility for the conversion of this standard to other formats or for incorrect results or damages resulting from its use.

DN:	CK:	DW:	CK:
DATE:	ACC:	FILE:	
LEVELS DISPLAYED			
1 2 3 4 5 6 7 8 9 10 11 12 13 14 15 16 17 18 19 20 21 22 23 24 25 26 27 28 29 30 31 32 33 34 35 36 37 38 39 40 41 42 43 44 45 46 47 48 49 50 51 52 53 54 55 56 57 58 59 60 61 62 63			

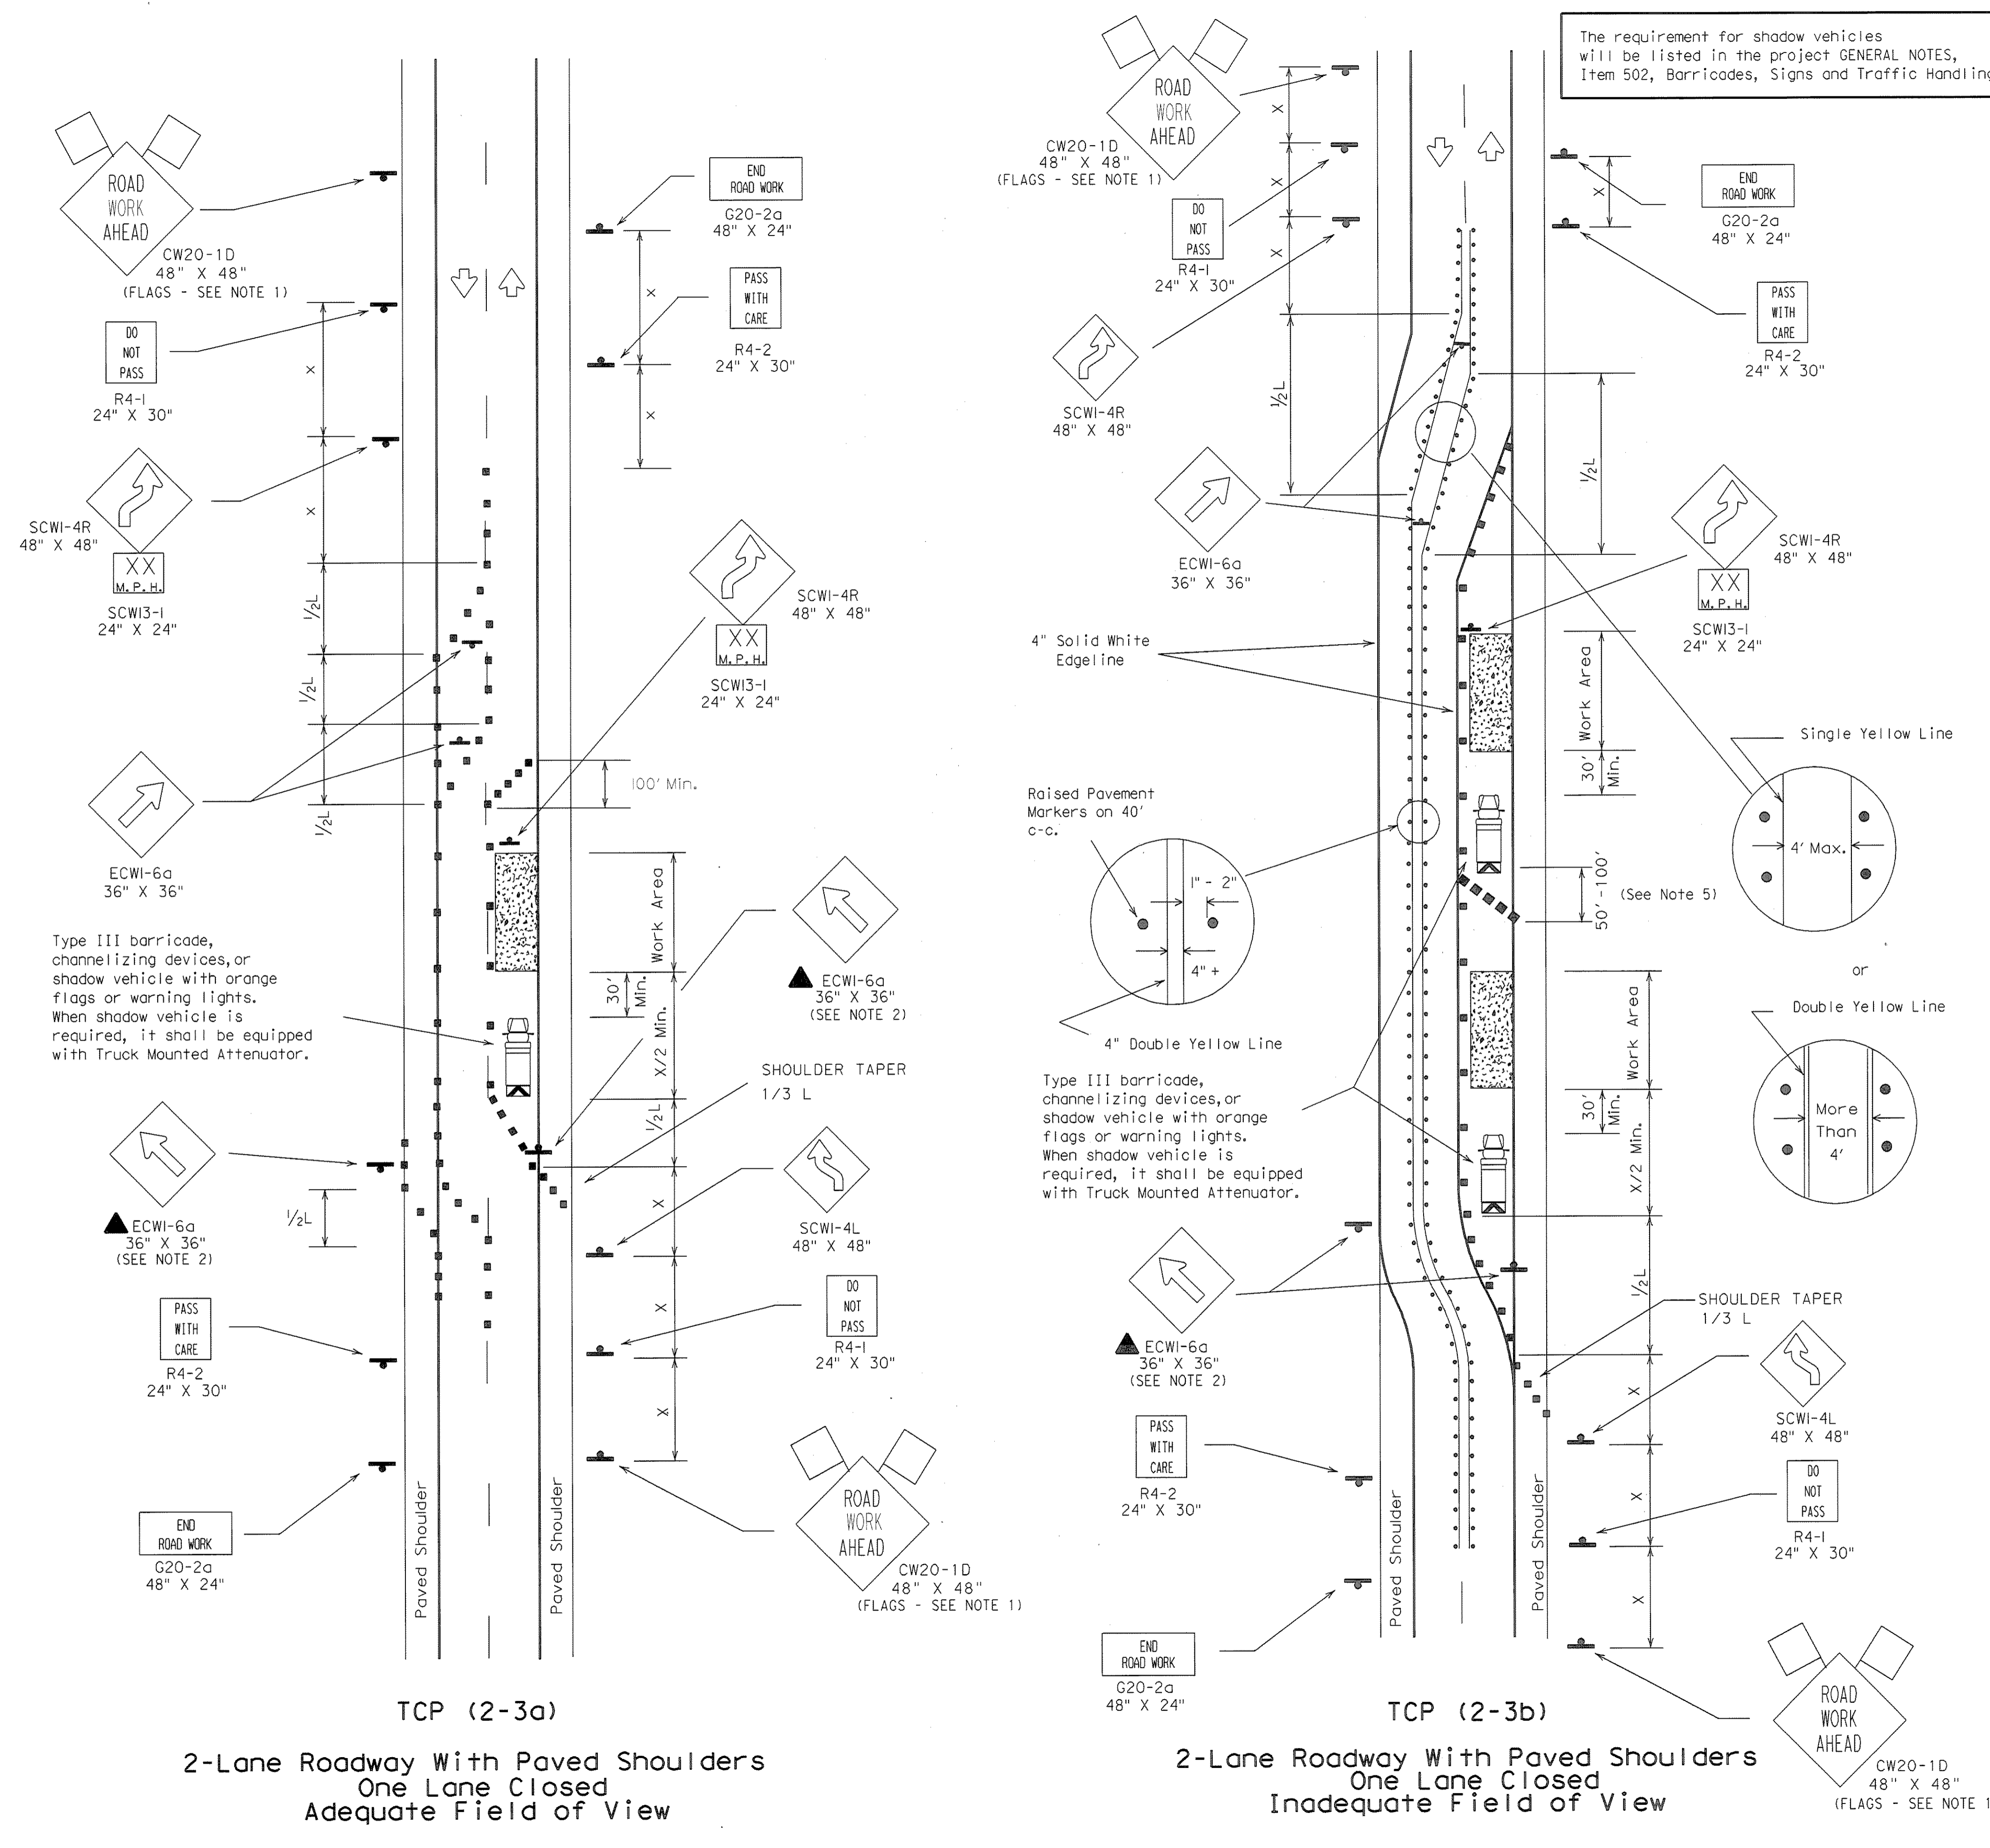

**LEGEND**

- Type III Barricade
- Channelizing Devices
- Flag
- Heavy Work Vehicle
- Truck Mounted Attenuator
- Trailer Mounted Flashing Arrow Panel
- Portable Changeable Message Sign
- Flagger
- Sign Post

• • • Raised Pavement Markers Type III-A-A (40' spacing)

Posted Speed $\times$	Formula	Minimum Desirable Taper Lengths $\times \times$			Suggested Maximum Spacing of Device		Minimum Sign Spacing $\times$ Distance
		10' Offset	11' Offset	12' Offset	On a Taper	On a Tangent	
30	$L = \frac{WS^2}{60}$	150'	165'	180'	30'	60' - 75'	120'
35		205'	225'	245'	35'	70' - 90'	160'
40		265'	295'	320'	40'	80' - 100'	240'
45	$L = WS$	450'	495'	540'	45'	90' - 110'	320'
50		500'	550'	600'	50'	100' - 125'	400'
55		550'	605'	660'	55'	110' - 140'	500'
60		600'	660'	720'	60'	120' - 150'	$\times$ 600'
65		650'	715'	780'	65'	130' - 165'	$\times$ 700'
70		700'	770'	840'	70'	140' - 175'	$\times$ 800'

$\times$  Conventional Roads Only  
 $\times \times$  Taper lengths have been rounded off.  
 L=Length of Taper (FT.) W=Width of Offset (FT.) S=Posted Speed (MPH)

**TYPICAL USAGE:**

	MOBILE	SHORT DURATION	SHORT TERM STATIONARY	INTERMEDIATE TERM STATIONARY	LONG TERM STATIONARY
			✓	✓	✓ (2-3b only)

- GENERAL NOTES:**
- Unless otherwise stated in the plans, flags attached to signs are **REQUIRED**.
  - All traffic control devices illustrated are **REQUIRED**, except those denoted with the triangle symbol may be omitted when stated elsewhere in the plans.
  - When work area will be in place more than one day but less than 2 weeks existing pavement markings may remain in place. Channelizing devices shall be used to separate traffic.
  - Flagger control should NOT be used unless roadway conditions or heavy traffic volume require additional emphasis to safely control traffic. Flagger should be positioned at end of traffic queue.
  - DO NOT PASS, PASS WITH CARE, and construction regulatory speed zone signs may be installed within ROAD WORK AHEAD signs. Proper spacing of signs shall be maintained.
  - When the work zone will be in place more than two weeks, conflicting pavement markings shall be removed, unless approved by the Engineer. New markings shall be placed and maintained to the satisfaction of the Engineer.
  - For intermediate term situations, when it is not feasible to remove and restore pavement markings, the channelization must be made dominant by using a very close spacing. This is especially important in locations of conflicting information, such as where traffic is directed over a double yellow centerline. In such locations a maximum channelizing device spacing of 10 feet is recommended. The 10 foot channelizing device spacing recommendation is intended for the area of conflicting information and not the entire work zone.

**RECORD PLANS**  
**MARCH 28, 2008**

**STANDARD PLANS**  
**TEXAS DEPARTMENT OF TRANSPORTATION**  
*Traffic Operations Division*


**TRAFFIC CONTROL PLAN**

**TCP (2-3) - 03**

REVISED	DATE	BY	REASON	FEDERAL AID PROJECT	SHEET
8-95					1203
1-97					
4-98					
3-03					

DISCLAIMER  
The use of this standard is governed by the "Texas Engineering Practice Act". No warranty of any kind is made by TxDOT for any purpose whatsoever. TxDOT assumes no responsibility for the conversion of this standard to other formats or for incorrect results or damages resulting from its use.

DN:	CK:	DW:	CK:
1	2	3	4
5	6	7	8
9	10	11	12
13	14	15	16
17	18	19	20
21	22	23	24
25	26	27	28
29	30	31	32
33	34	35	36
37	38	39	40
41	42	43	44
45	46	47	48
49	50	51	52
53	54	55	56
57	58	59	60
61	62	63	64
65	66	67	68
69	70	71	72
73	74	75	76
77	78	79	80
81	82	83	84
85	86	87	88
89	90	91	92
93	94	95	96
97	98	99	100

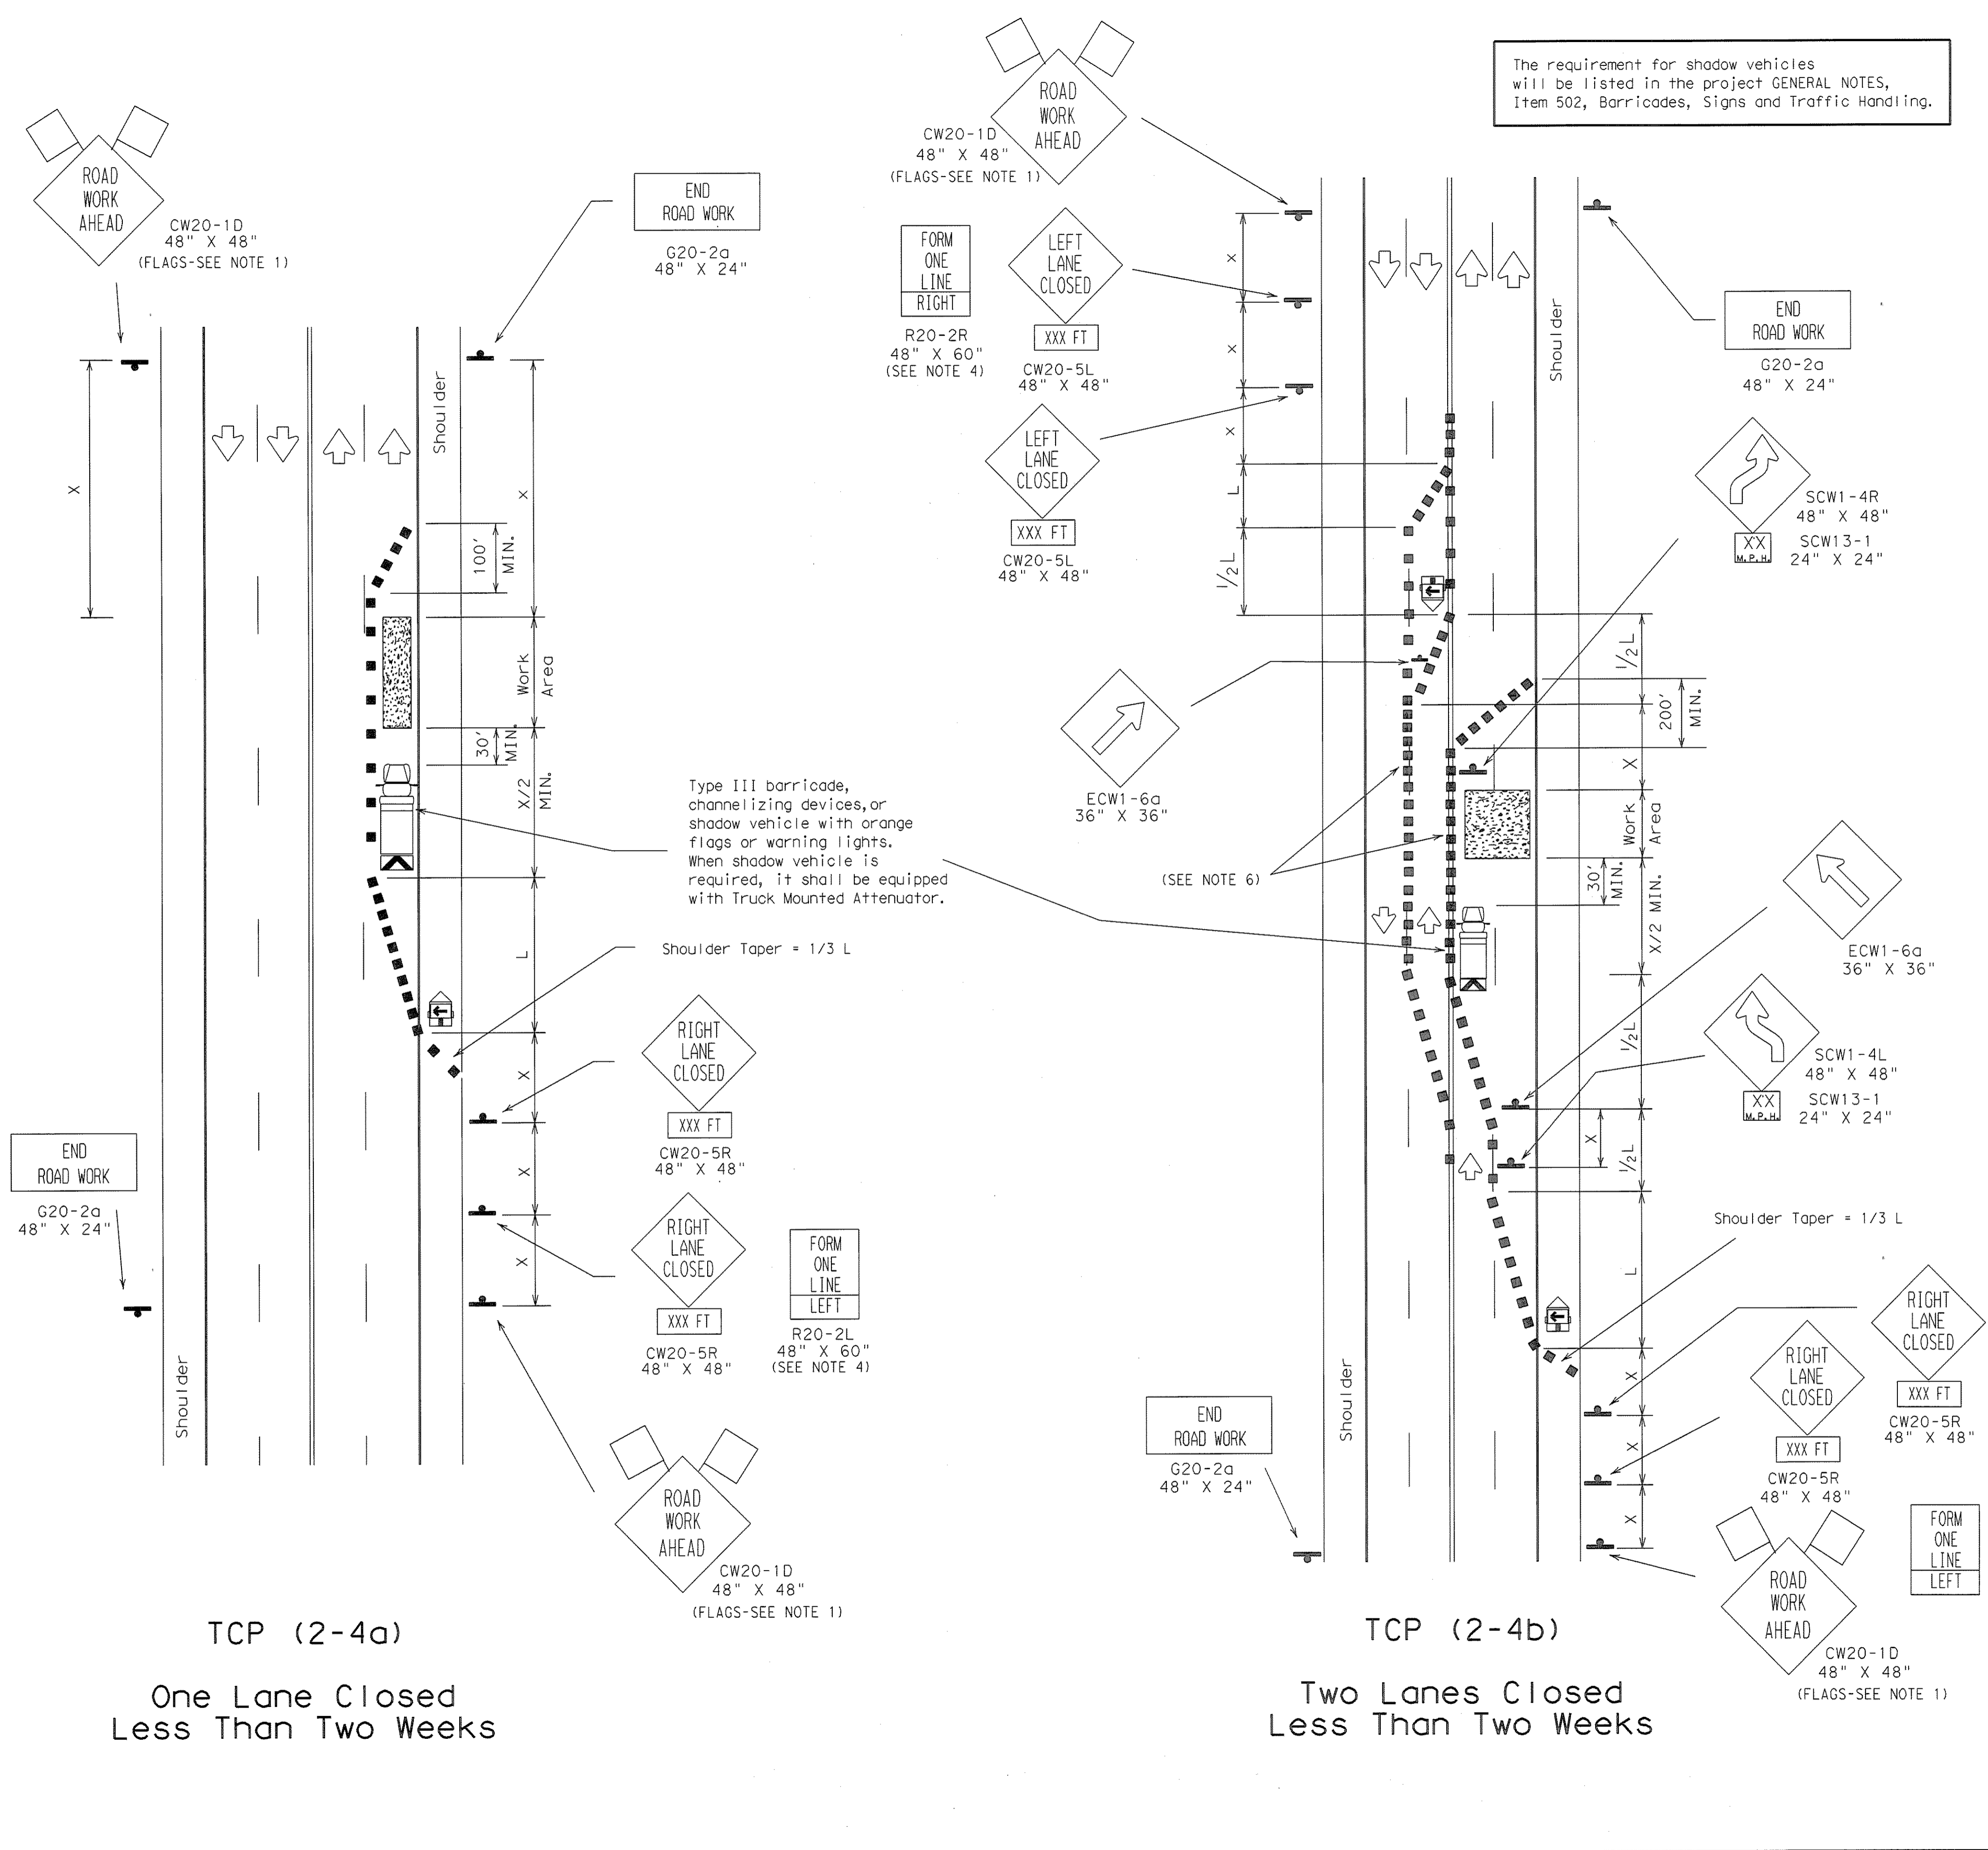

LEGEND

	Type III Barricade		Channelizing Devices		Flag
	Heavy Work Vehicle		Truck Mounted Attenuator		
	Trailer Mounted Flashing Arrow Panel		Portable Changeable Message Sign		
	Flagger		Sign Post		

Posted Speed	Formula	Minimum Desirable Taper Lengths			Suggested Maximum Spacing of Device		Minimum Sign Spacing X Distance
		10' Offset	11' Offset	12' Offset	On a Taper	On a Tangent	
30	L = WS ² / 60	150'	165'	180'	30'	60'-75'	120'
35		205'	225'	245'	35'	70'-90'	160'
40	L = WS	265'	295'	320'	40'	80'-100'	240'
45		450'	495'	540'	45'	90'-110'	320'
50	L = WS	500'	550'	600'	50'	100'-125'	400'
55		550'	605'	660'	55'	110'-140'	500'
60	L = WS	600'	660'	720'	60'	120'-150'	* 600'
65		650'	715'	780'	65'	130'-165'	* 700'
70	L = WS	700'	770'	840'	70'	140'-175'	* 800'
75		750'	825'	900'	75'	150'-190'	* 900'

* Conventional Roads Only  
 ** Taper lengths have been rounded off.  
 L=Length of Taper (FT.) W=Width of Offset (FT.) S=Posted Speed (MPH)

TYPICAL USAGE:

MOBILE	SHORT DURATION	SHORT TERM STATIONARY	INTERMEDIATE TERM STATIONARY	LONG TERM STATIONARY
		✓	✓	

- GENERAL NOTES:
- Unless otherwise stated in the plans, flags attached to signs are REQUIRED.
  - TCP (2-4b) shall be used only on projects that will be at a location for less than two weeks.
  - Existing pavement markings may remain in place for projects less than two weeks in duration.
  - The FORM ONE LINE LEFT (or RIGHT) sign may be used following the RIGHT (or LEFT) LANE CLOSED XXX FT sign. Spacing distance between signs should be the minimum distance indicated.
  - Downstream taper is optional. When used, it should be 100' minimum length per lane.
  - For intermediate term situations, when it is not feasible to remove and restore pavement markings, the channelization must be made dominant by using a very close spacing. This is especially important in locations of conflicting information, such as where traffic is directed over a double yellow centerline. In such locations a maximum channelizing device spacing of 10 feet is recommended. The 10 foot channelizing device spacing recommendation is intended for the area of conflicting information and not the entire work zone.

RECORD PLANS  
 MARCH 28, 2008

STANDARD PLANS  
 TEXAS DEPARTMENT OF TRANSPORTATION  
 Traffic Operations Division


TRAFFIC CONTROL PLAN

TCP (2-4) -03

© TxDOT	December 1985	DR - LR	OK - MT	DR - DN	OK - DM	REC NO. 1
REVISIONS	STATE DISTRICT	FEDERAL REGION	FEDERAL AID PROJECT			SHEET
8-95		6				1204
1-97			COUNTY	CONTROL SECTION	JOB	HIGHWAY
4-98						
3-03						

LEVELS DISPLAYED  
1 2 3 4 5 6 7 8 9 10 11 12 13 14 15 16 17 18 19 20 21 22 23 24 25 26 27 28 29 30 31 32  
DATE: 1/7/81 1/10/81 1/13/81 1/17/81 1/21/81 1/24/81 1/28/81 2/1/81 2/5/81 2/9/81 2/13/81 2/17/81 2/21/81 2/24/81 2/28/81 3/3/81 3/7/81 3/10/81 3/14/81 3/18/81 3/22/81 3/26/81 3/30/81 4/3/81 4/7/81 4/10/81 4/14/81 4/18/81 4/22/81 4/26/81 4/30/81 5/4/81 5/8/81 5/12/81 5/16/81 5/20/81 5/24/81 5/28/81 6/1/81 6/5/81 6/9/81 6/13/81 6/17/81 6/21/81 6/25/81 6/29/81 7/3/81 7/7/81 7/11/81 7/15/81 7/19/81 7/23/81 7/27/81 7/31/81 8/4/81 8/8/81 8/12/81 8/16/81 8/20/81 8/24/81 8/28/81 9/1/81 9/5/81 9/9/81 9/13/81 9/17/81 9/21/81 9/25/81 9/29/81 10/3/81 10/7/81 10/11/81 10/15/81 10/19/81 10/23/81 10/27/81 10/31/81 11/4/81 11/8/81 11/12/81 11/16/81 11/20/81 11/24/81 11/28/81 12/2/81 12/6/81 12/10/81 12/14/81 12/18/81 12/22/81 12/26/81 12/30/81  
DN: _____ CK: _____ DW: _____ CK: _____  
ACC: _____ FILE: _____

DISCLAIMER  
The use of this standard is governed by the "Texas Engineering Practice Act". No warranty of any kind is made by TxDOT for any purpose whatsoever. TxDOT assumes no responsibility for the conversion of this standard to other formats or for incorrect results or damages resulting from its use.

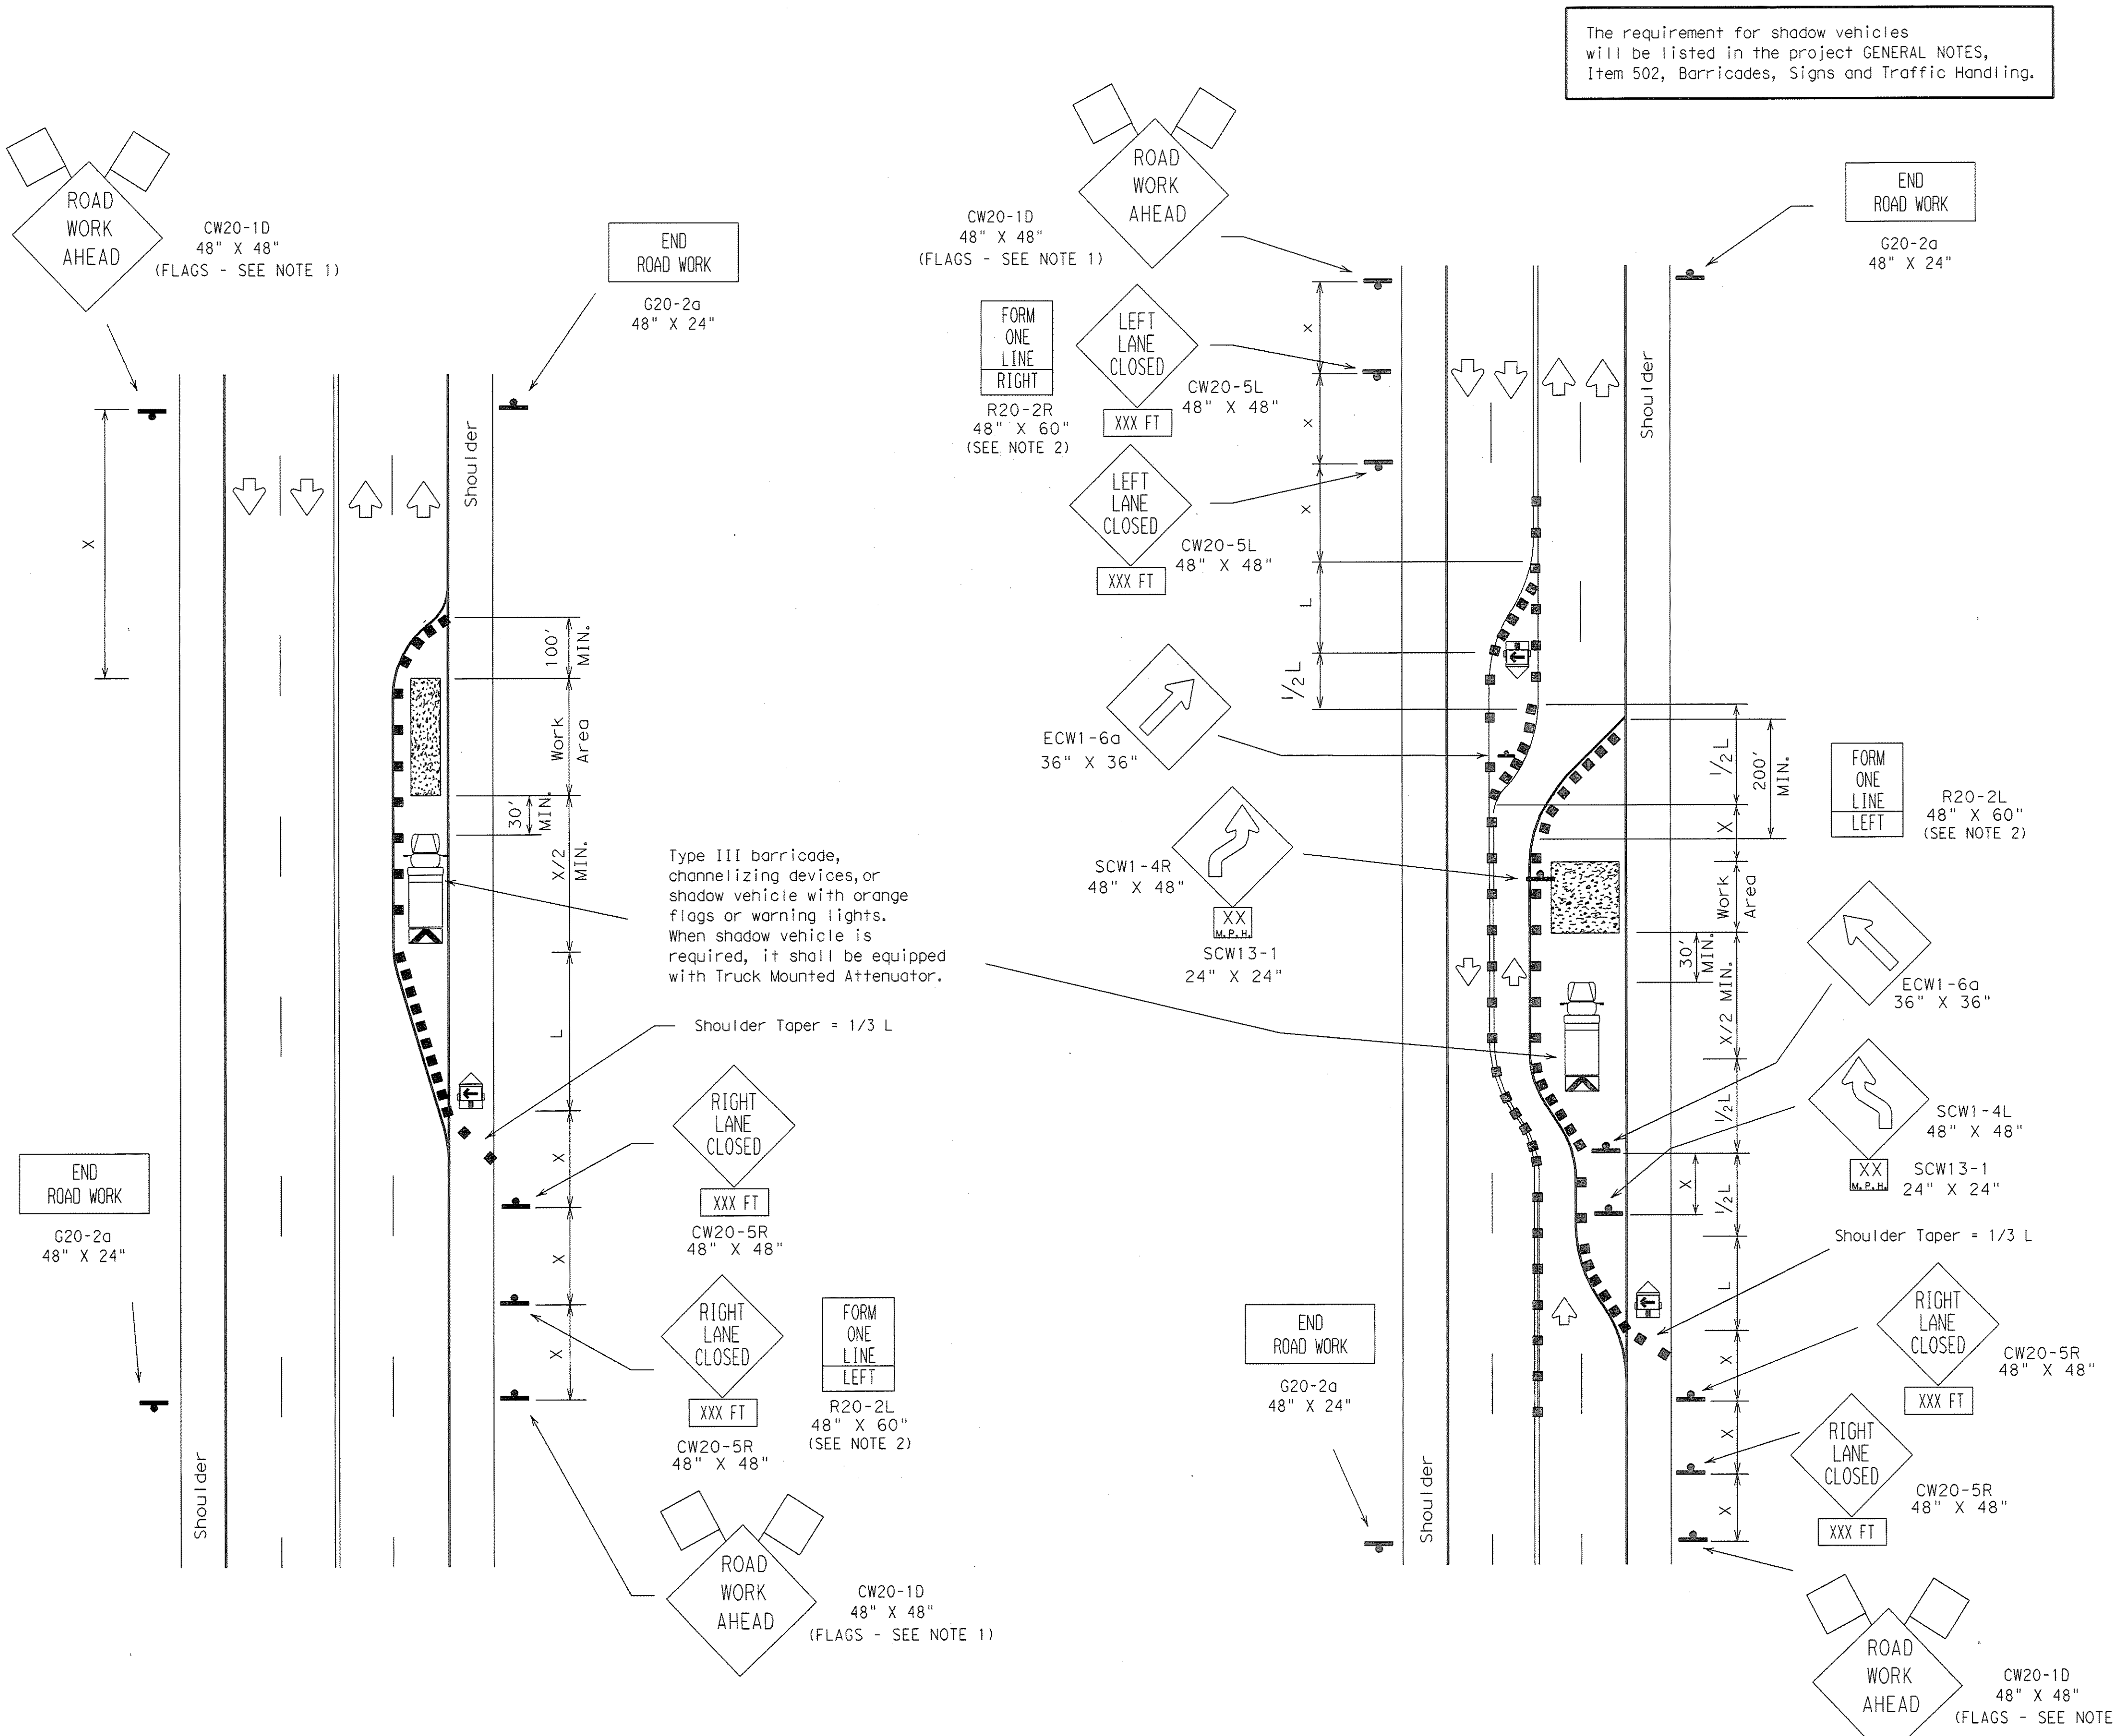

TCP (2-5a)  
One Lane Closed  
More Than Two Weeks

TCP (2-5b)  
Two Lanes Closed  
More Than Two Weeks

LEGEND

- Type III Barricade
- Channelizing Devices
- Flag
- Heavy Work Vehicle
- Truck Mounted Attenuator
- Trailer Mounted Flashing Arrow Panel
- Portable Changeable Message Sign
- Flagger
- Sign Post

Posted Speed	Formula	Minimum Desirable Taper Lengths (ft.)			Suggested Maximum Spacing of Device		Minimum Sign Spacing (ft.)
WS	$L = \frac{WS^2}{60}$	10'	11'	12'	On a Taper	On a Tangent	X
30			150'	165'	180'	30'	60' - 75'
35		205'	225'	245'	35'	70' - 90'	160'
40		265'	295'	320'	40'	80' - 100'	240'
45	L=WS	450'	495'	540'	45'	90' - 110'	320'
50		500'	550'	600'	50'	100' - 125'	400'
55		550'	605'	660'	55'	110' - 140'	500'
60		600'	660'	720'	60'	120' - 150'	* 600'
65		650'	715'	780'	65'	130' - 165'	* 700'
70		700'	770'	840'	70'	140' - 175'	* 800'

* Conventional Roads Only  
 ** Taper lengths have been rounded off.  
 L = Length of Taper (ft.) W = Width of Offset (ft.) S = Posted Speed (MPH)

TYPICAL USAGE:

MOBILE	SHORT DURATION	SHORT TERM STATIONARY	INTERMEDIATE TERM STATIONARY	LONG TERM STATIONARY
			✓	✓

GENERAL NOTES:

- Unless otherwise stated in the plans, flags attached to signs are **REQUIRED**.
- The FORM ONE LINE LEFT (or RIGHT) sign may be used following the RIGHT (or LEFT) LANE CLOSED XXX FT sign. Spacing distance between signs should be the minimum distance indicated.
- When the work zone will be in place more than two weeks, conflicting pavement markings shall be removed. New markings shall be installed and maintained to the satisfaction of the Engineer.
- Downstream taper is optional. When used, it should be 100' minimum length per lane.
- For intermediate term situations, when it is not feasible to remove and restore pavement markings, the channelization must be made dominant by using a very close spacing. This is especially important in locations of conflicting information, such as where traffic is directed over a double yellow centerline. In such locations a maximum channelizing device spacing of 10 feet is recommended. The 10 foot channelizing device spacing recommendation is intended for the area of conflicting information and not the entire work zone.

RECORD PLANS  
MARCH 28, 2008

STANDARD PLANS  
TEXAS DEPARTMENT OF TRANSPORTATION  
Traffic Operations Division

TRAFFIC CONTROL PLAN


TCP (2-5) - 03

REVISED	STATE	FEDERAL PROJECT	FEDERAL AID PROJECT	SHEET
8-95	6			1205
1-97				HIGHWAY
4-98	COUNTY	CONTROL	SECTION	JOB
3-03				


© TxDOT December 1985 DN - LR CK - DN CK - MT NEG NO. :

DISCLAIMER  
 The use of this standard is governed by the "Texas Engineering Practice Act". No warranty of any kind is made by TxDOT for any purpose whatsoever. TxDOT assumes no responsibility for the conversion of this standard to other formats or for incorrect results or damages resulting from its use.

LEVELS DISPLAYED	DATE:
1 2 3 4 5 6 7 8 9 10 11 12 13 14 15 16	DN: 1/11/08
	CK: 1/11/08
	DW: 1/11/08
	CC: 1/11/08
	FILE: 1/11/08

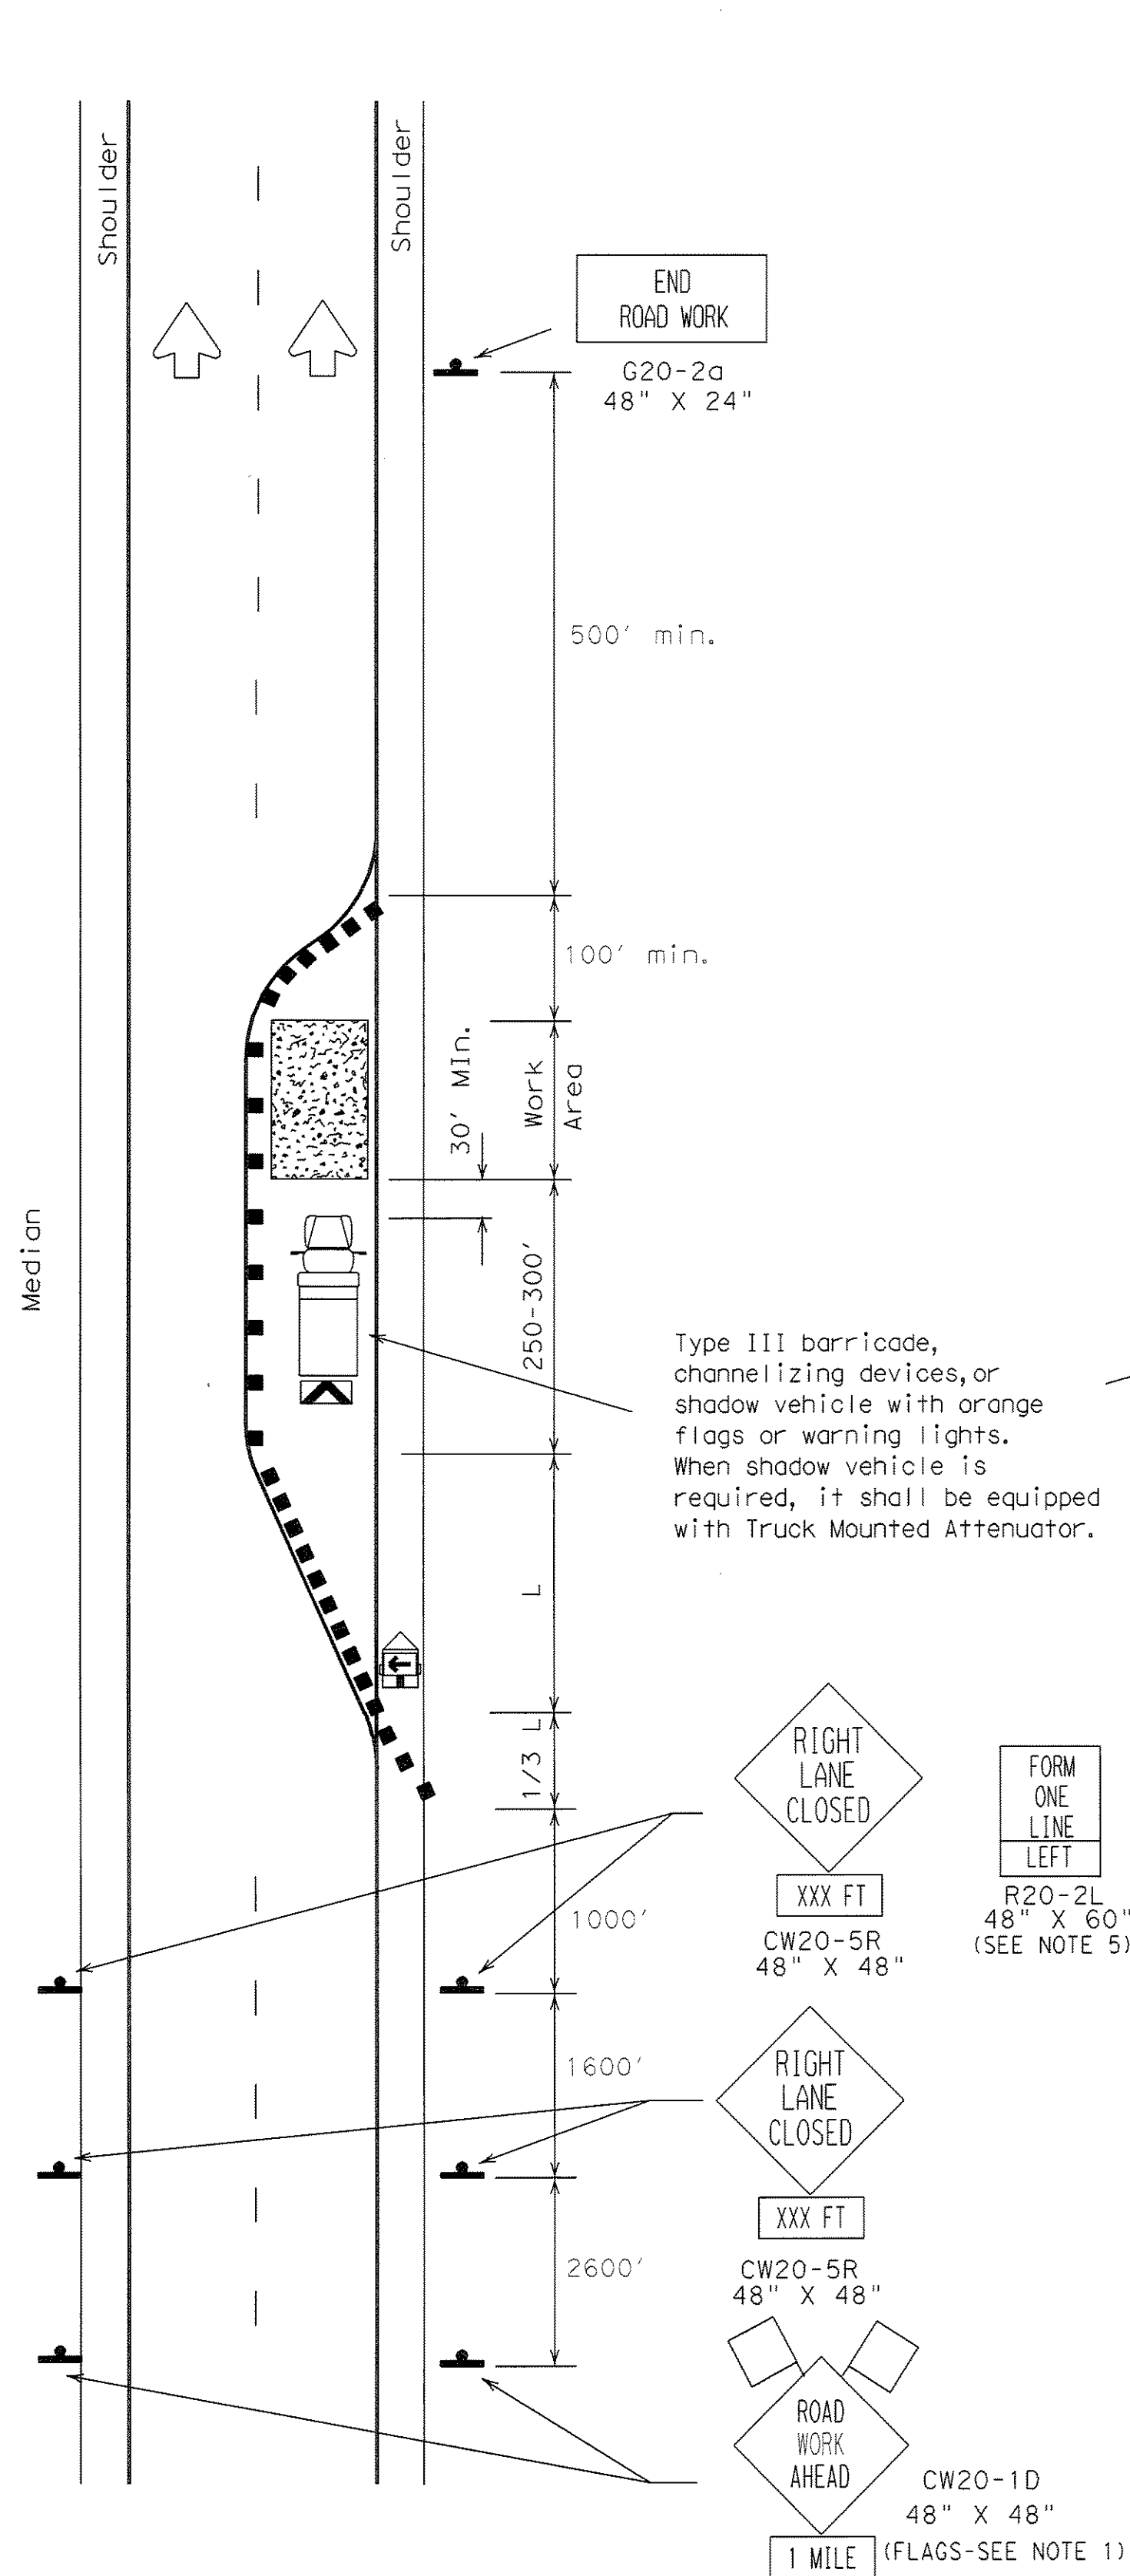

TCP (2-6a)  
 One Lane Closure

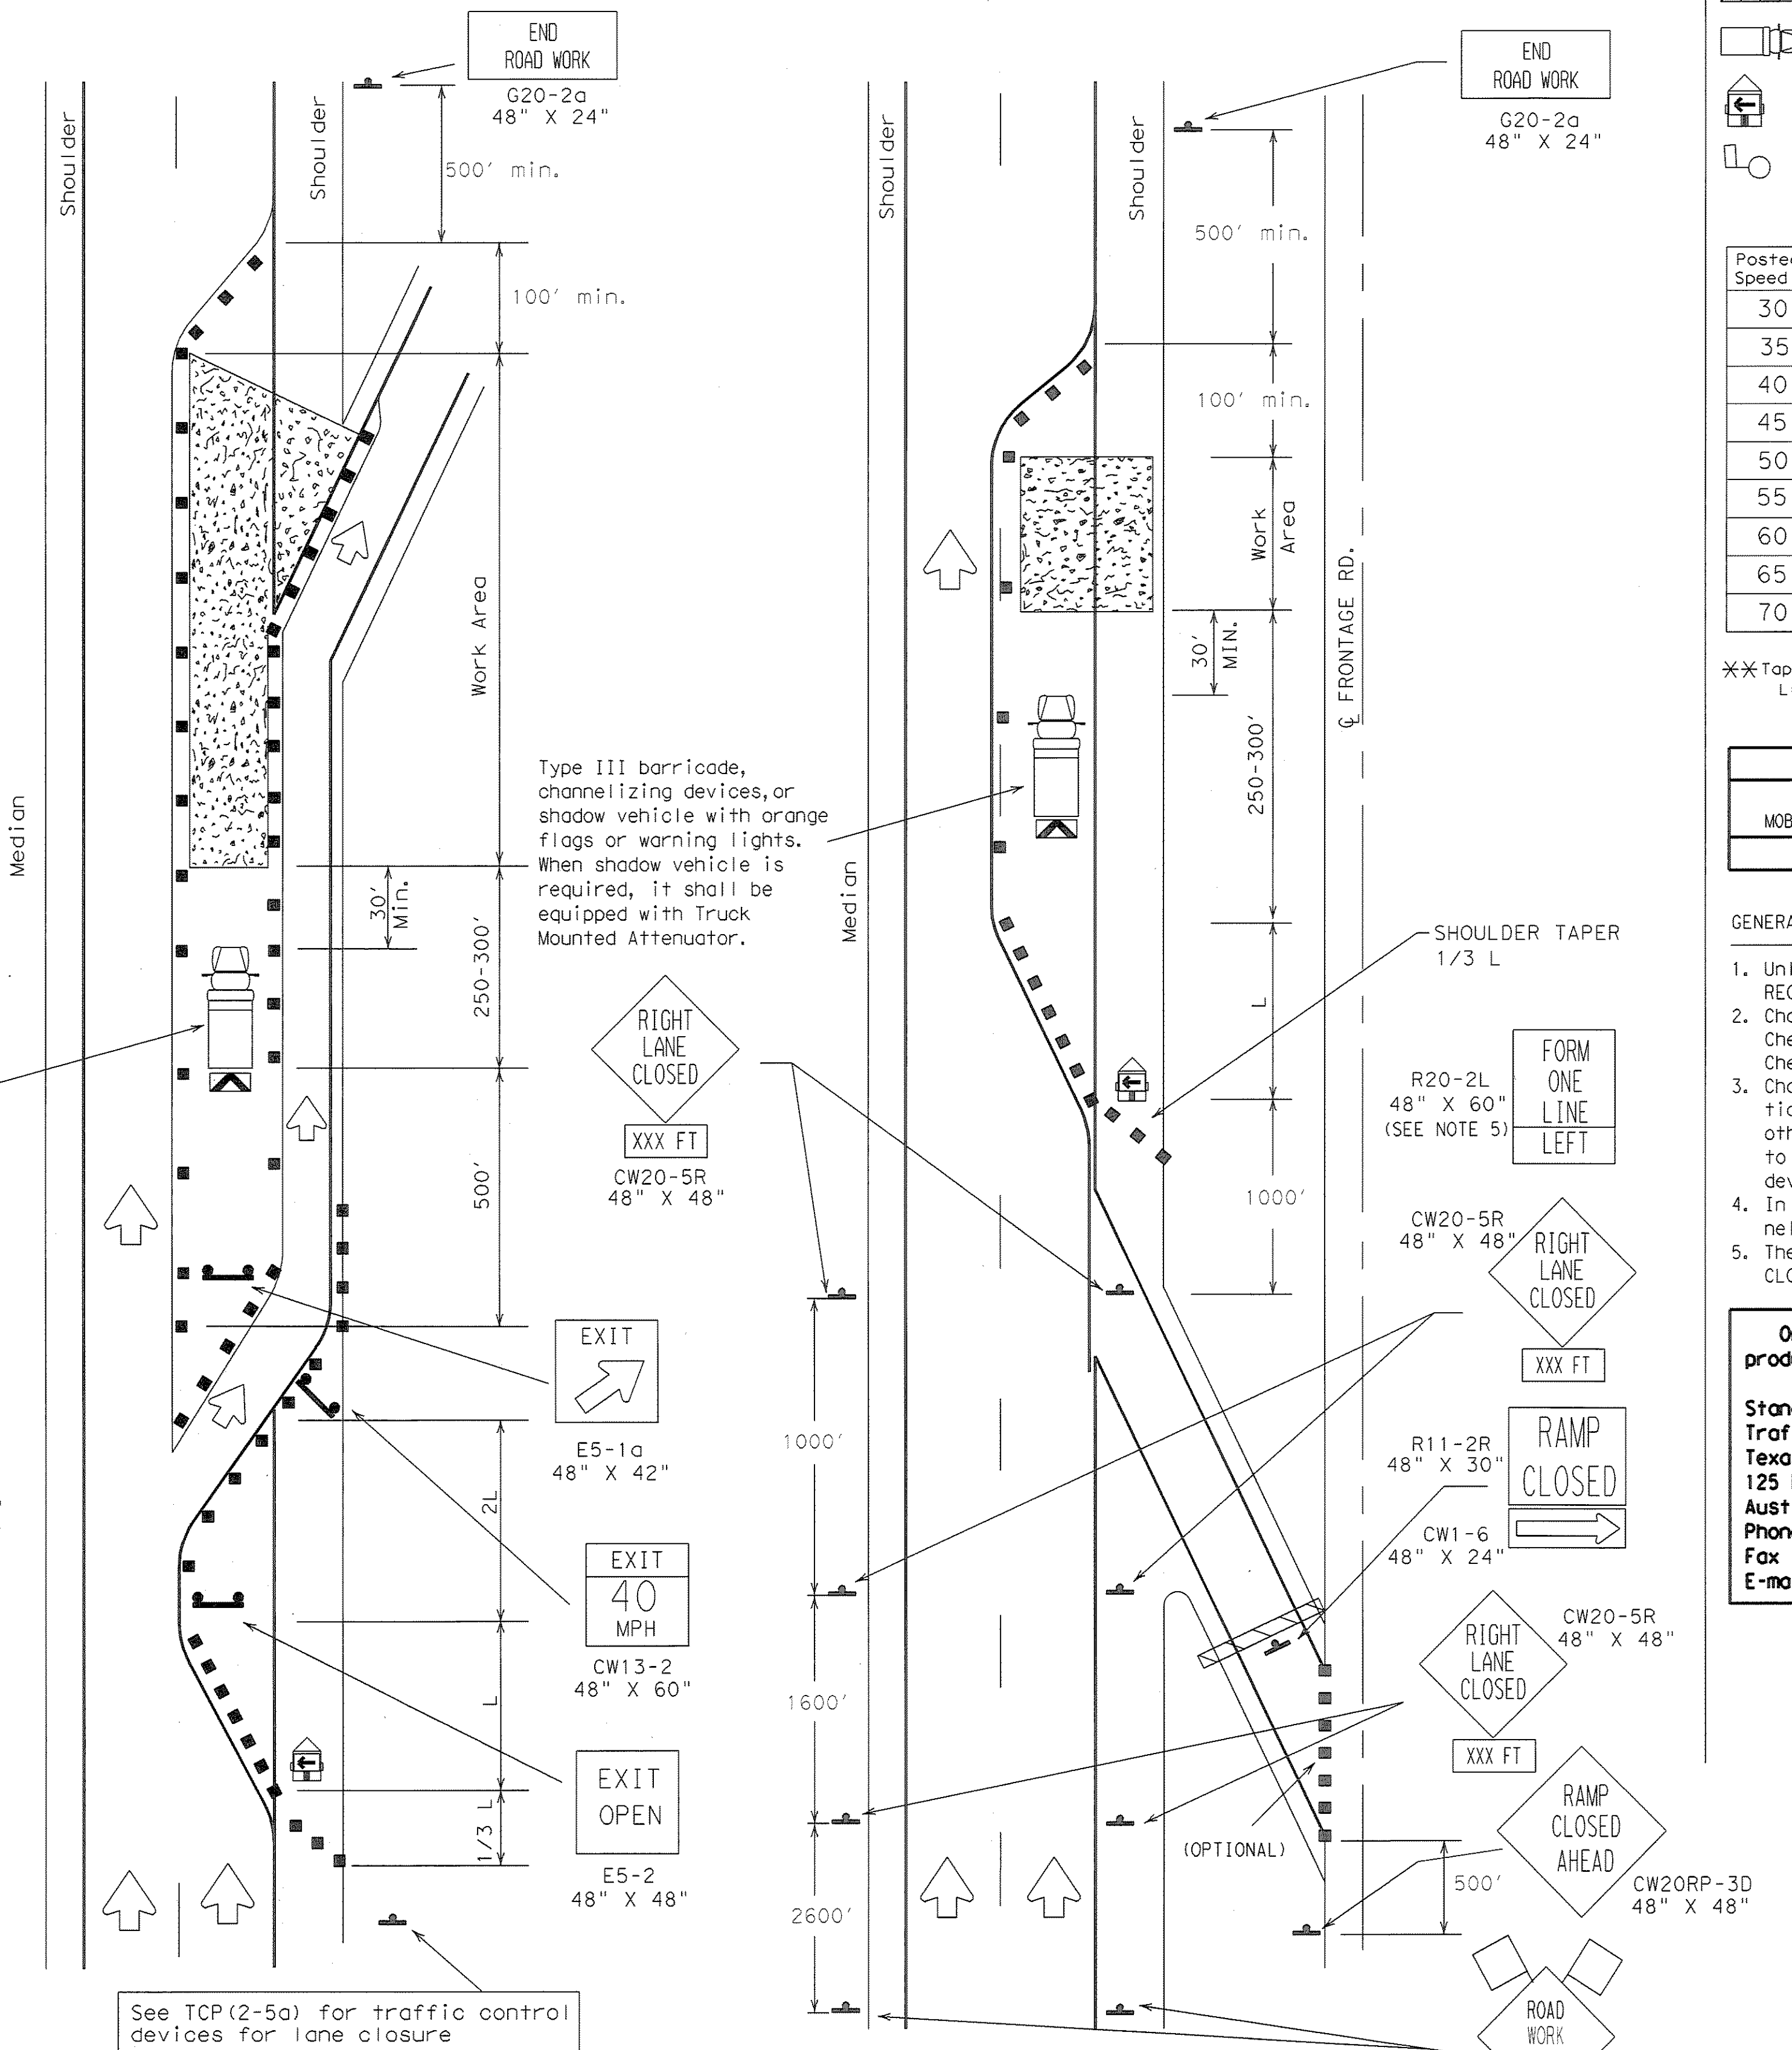

RECORD PLANS  
 MARCH 28, 2008

TCP (2-6b)  
 Lane Closure Near Exit Ramps

TCP (2-6c)  
 Lane Closure Near Entrance Ramps

LEGEND

- Type III Barricade
- Channelizing Devices
- Flag
- Heavy Work Vehicle
- Truck Mounted Attenuator
- Trailer Mounted Flashing Arrow Panel
- Portable Changeable Message Sign
- Flagger
- Sign Post

Posted Speed	Formula	Minimum Desirable Taper Lengths **			Suggested Maximum Spacing of Device	
		10' Offset	11' Offset	12' Offset	On a Taper	On a Tangent
30	L = WS ² / 60	150'	165'	180'	30'	60' - 75'
35		205'	225'	245'	35'	70' - 90'
40		265'	295'	320'	40'	80' - 100'
45	L = WS	450'	495'	540'	45'	90' - 110'
50		500'	550'	600'	50'	100' - 125'
55		550'	605'	660'	55'	110' - 140'
60		600'	660'	720'	60'	120' - 150'
65		650'	715'	780'	65'	130' - 165'
70		700'	770'	840'	70'	140' - 175'

**Taper lengths have been rounded off.  
 L=Length of Taper (FT.) W=Width of Offset (FT.) S=Posted Speed (MPH)

TYPICAL USAGE:				
MOBILE	SHORT DURATION	SHORT TERM STATIONARY	INTERMEDIATE TERM STATIONARY	LONG TERM STATIONARY
			✓	✓

GENERAL NOTES:

- Unless otherwise stated in the plans, flags attached to signs are REQUIRED.
- Channelizing devices used to close lanes may be supplemented with the Chevron Alignment Sign placed on every other channelizing device. Chevrons may be attached to plastic drums as per BC Standards.
- Channelizing devices used along the work area or along tangent sections may be supplemented with vertical panels (VP) placed on every other channelizing device. If night time conditions make it difficult to see at least two VP's, the VP's may be placed on each channelizing device.
- In areas with safety lighting or continuous illumination the channelizing devices can be supplemented with delineators.
- The FORM ONE LINE LEFT sign may be used following the RIGHT LANE CLOSED sign.

Only pre-qualified products shall be used. A list of compliant products and their sources may be obtained by writing or faxing:

Standards Engineer  
 Traffic Operations Division - TE  
 Texas Department of Transportation  
 125 East 11th Street  
 Austin, Texas 78701-2483  
 Phone (512) 416-3335  
 Fax (512) 416-3161  
 E-mail TRF-STANDARD@mailgw.dot.state.tx.us

The requirement for shadow vehicles will be listed in the project GENERAL NOTES, Item 502, Barricades, Signs and Traffic Handling.

**STANDARD PLANS**  
 TEXAS DEPARTMENT OF TRANSPORTATION  
 Traffic Operations Division

## TRAFFIC CONTROL PLAN

### TCP (2-6) - 98


© TxDOT December 1985		DN - LR	CK - MT	DW - DN	CK - DM	REG NO. 1
REVISIONS	STATE DISTRICT	FEDERAL SECTION	FEDERAL AID PROJECT			SHEET
2-94	6					1206
8-95			COUNTY	CONTROL	SECTION	JOB
1-97						HIGHWAY
4-98						



DISCLAIMER  
 The use of this standard is governed by the "Texas Engineering Practice Act". No warranty of any kind is made by TxDOT for any purpose whatsoever. TxDOT assumes no responsibility for the conversion of this standard to other formats or for incorrect results or damages resulting from its use.


DN:	1	2	3	4	5	6	7	8	9	10	11	12	13	14	15
CK:	1	2	3	4	5	6	7	8	9	10	11	12	13	14	15
DW:	1	2	3	4	5	6	7	8	9	10	11	12	13	14	15
CK:	1	2	3	4	5	6	7	8	9	10	11	12	13	14	15

Traffic Control Devices shown for one direction.

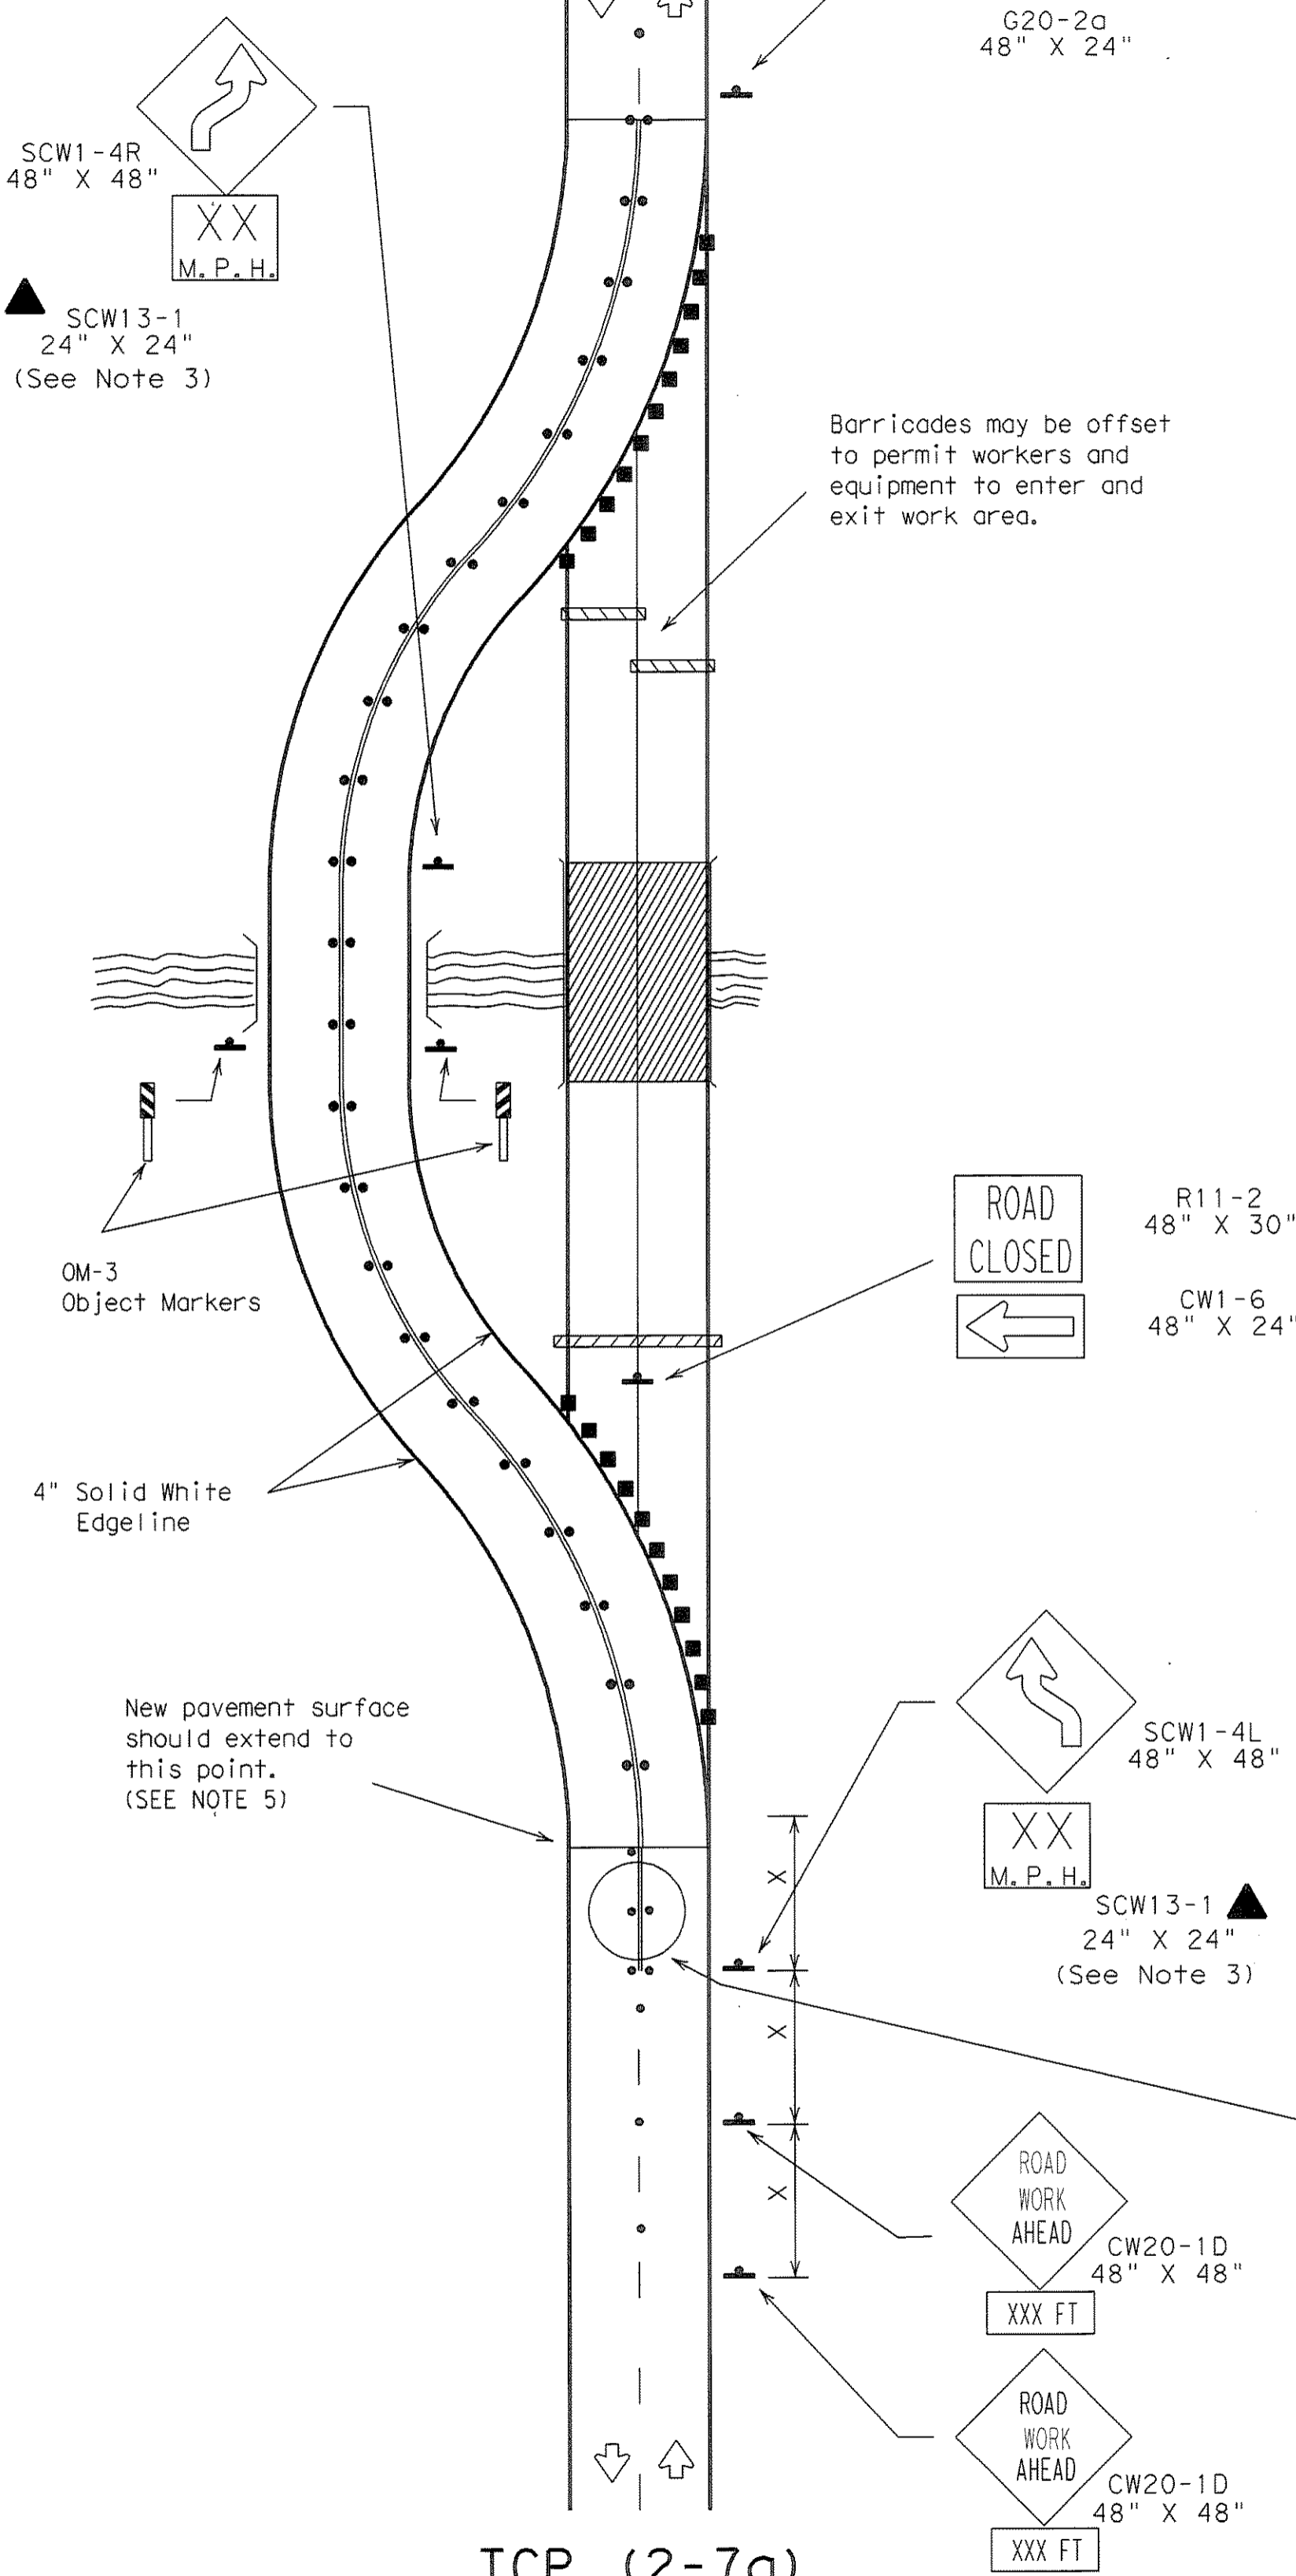

TCP (2-7a)  
 Roadway Diversion

Traffic Control Devices shown for one direction.

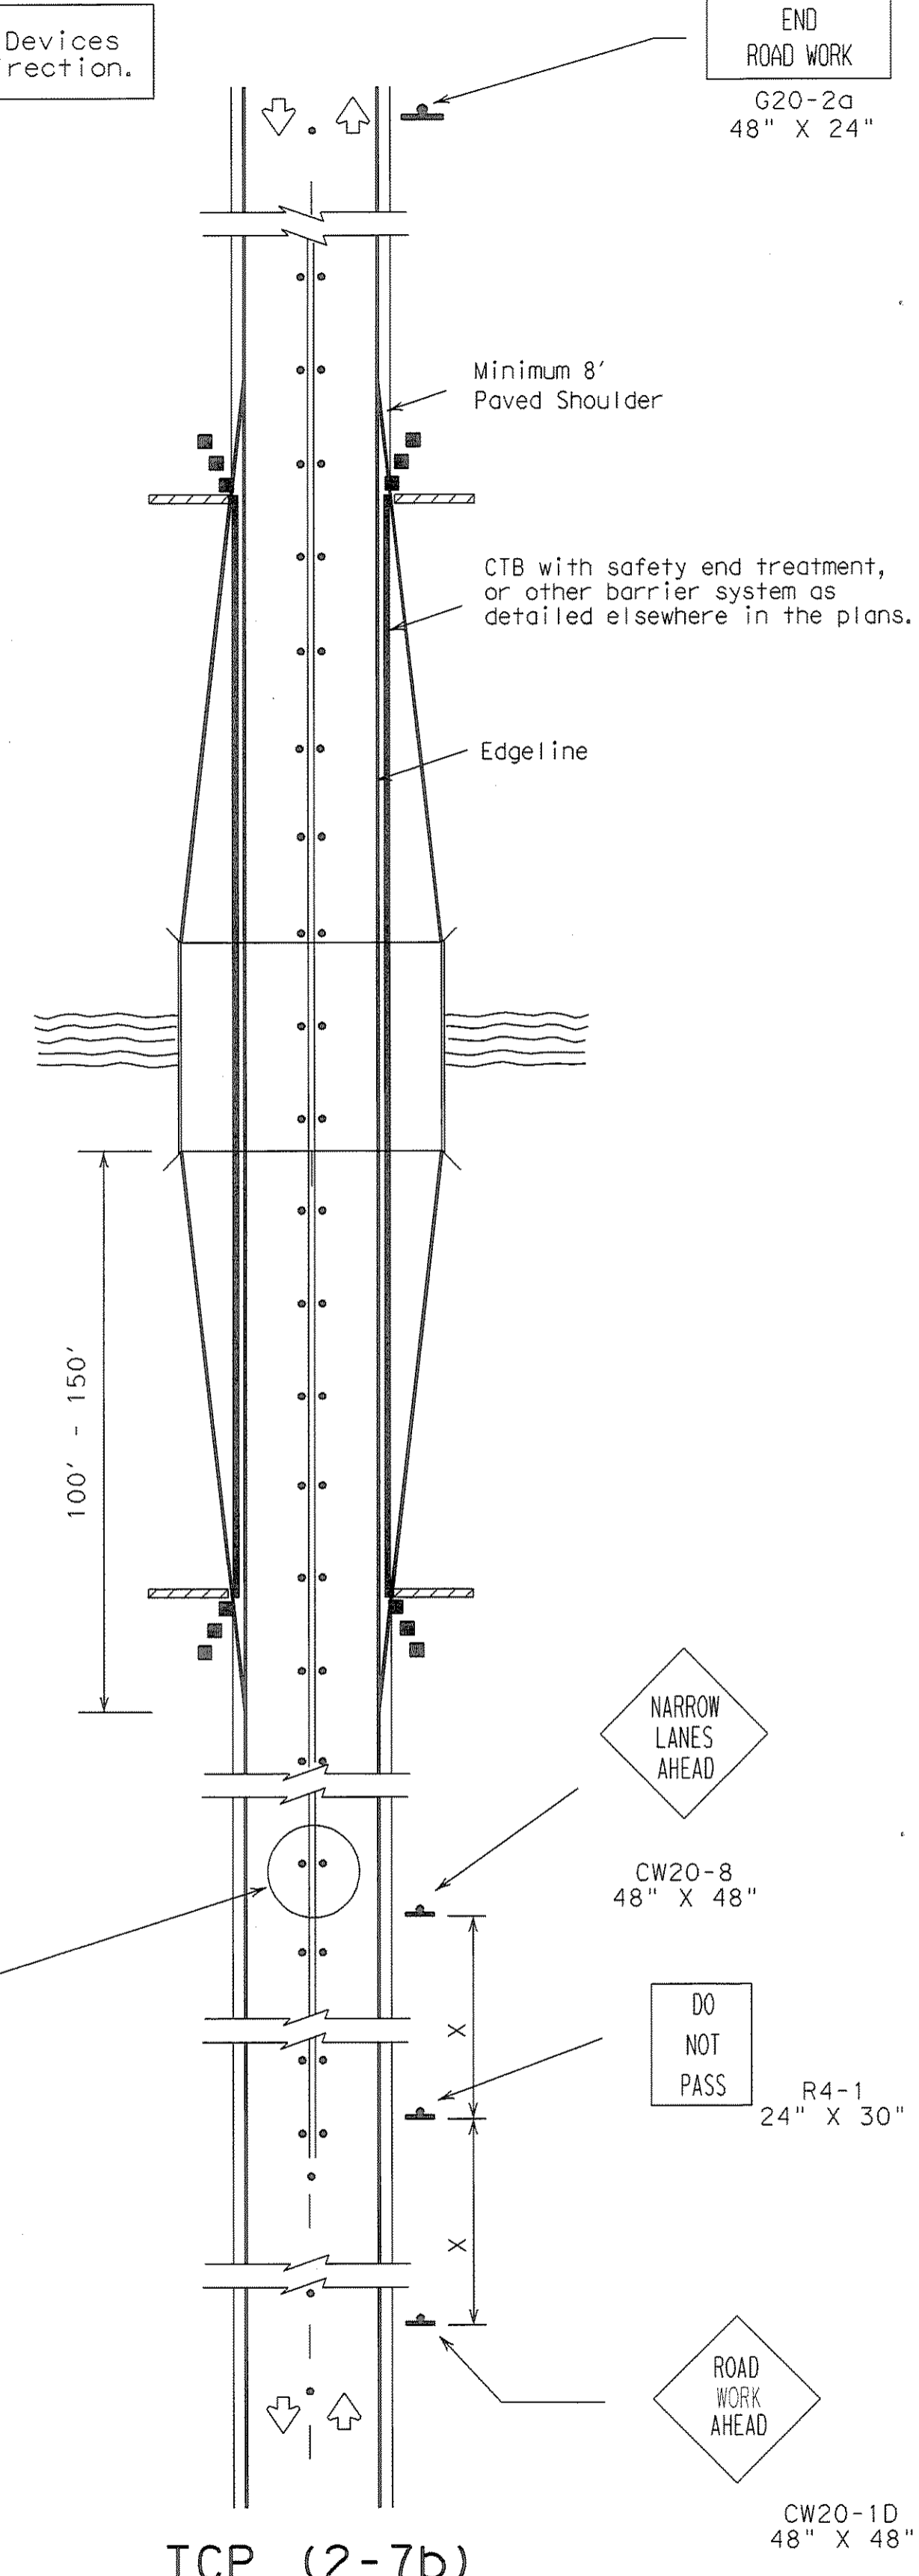

TCP (2-7b)  
 Bridge Widening

LEGEND

	Type III Barricade		Channelizing Devices		Flag
	Heavy Work Vehicle		Truck Mounted Attenuator		
	Trailer Mounted Flashing Arrow Panel		Portable Changeable Message Sign		
	Flagger		Sign Post		

• • • Raised Pavement Markers Type III-A-A (40' spacing)

Posted Speed X	Formula	Minimum Desirable Taper Lengths **			Suggested Maximum Spacing of Device		Minimum Sign Spacing X Distance
		10' Offset	11' Offset	12' Offset	On a Taper	On a Tangent	
30	$L = \frac{WS^2}{60}$	150'	165'	180'	30'	60' - 75'	120'
35		205'	225'	245'	35'	70' - 90'	160'
40		265'	295'	320'	40'	80' - 100'	240'
45	L=WS	450'	495'	540'	45'	90' - 110'	320'
50		500'	550'	600'	50'	100' - 125'	400'
55		550'	605'	660'	55'	110' - 140'	500'
60		600'	660'	720'	60'	120' - 150'	* 600'
65		650'	715'	780'	65'	130' - 165'	* 700'
70		700'	770'	840'	70'	140' - 175'	* 800'

* Conventional Roads Only  
 ** Taper lengths have been rounded off.  
 L=Length of Taper (FT.) W=Width of Offset (FT.) S=Posted Speed (MPH)

TYPICAL USAGE:

	SHORT DURATION	SHORT TERM STATIONARY	INTERMEDIATE TERM STATIONARY	LONG TERM STATIONARY
MOBILE			✓	✓

- GENERAL NOTES:
- Unless otherwise stated in the plans, flags attached to signs are REQUIRED.
  - Raised pavement markers shall be placed 40' c-c on centerline throughout project.
  - All traffic control devices illustrated are REQUIRED, except those with the triangle symbol may be omitted when stated elsewhere in the plans.
  - Roadway diversion design requirement should be based on posted speed limit or prevailing speed.
  - New pavement surface should be extended across existing roadway edge to a point where existing pavement markings left in place during project do not conflict with construction area pavement markings.

RECORD PLANS  
 MARCH 28, 2008


STANDARD PLANS  
 TEXAS DEPARTMENT OF TRANSPORTATION  
 Traffic Operations Division

TRAFFIC CONTROL PLAN  
 TCP (2-7) -03


REVISIONS	STATE DISTRICT	FEDERAL REGION	FEDERAL AID PROJECT	SHEET
8-95				120
1-97	6			
4-98	COUNTY	CONTROL	SECTION	JOB
3-03				167

DISCLAIMER  
 This standard is governed by the "Texas Engineering Practice Act". No warranty of any kind is made by TxDOT for any purpose whatsoever. TxDOT assumes no responsibility for the conversion of this standard to other formats or for incorrect results or damages resulting from its use.

DN:	1	2	3	4	5	6	7	8	9	10	11	12	13	14	15	16
CK:																
DW:																
CK:																

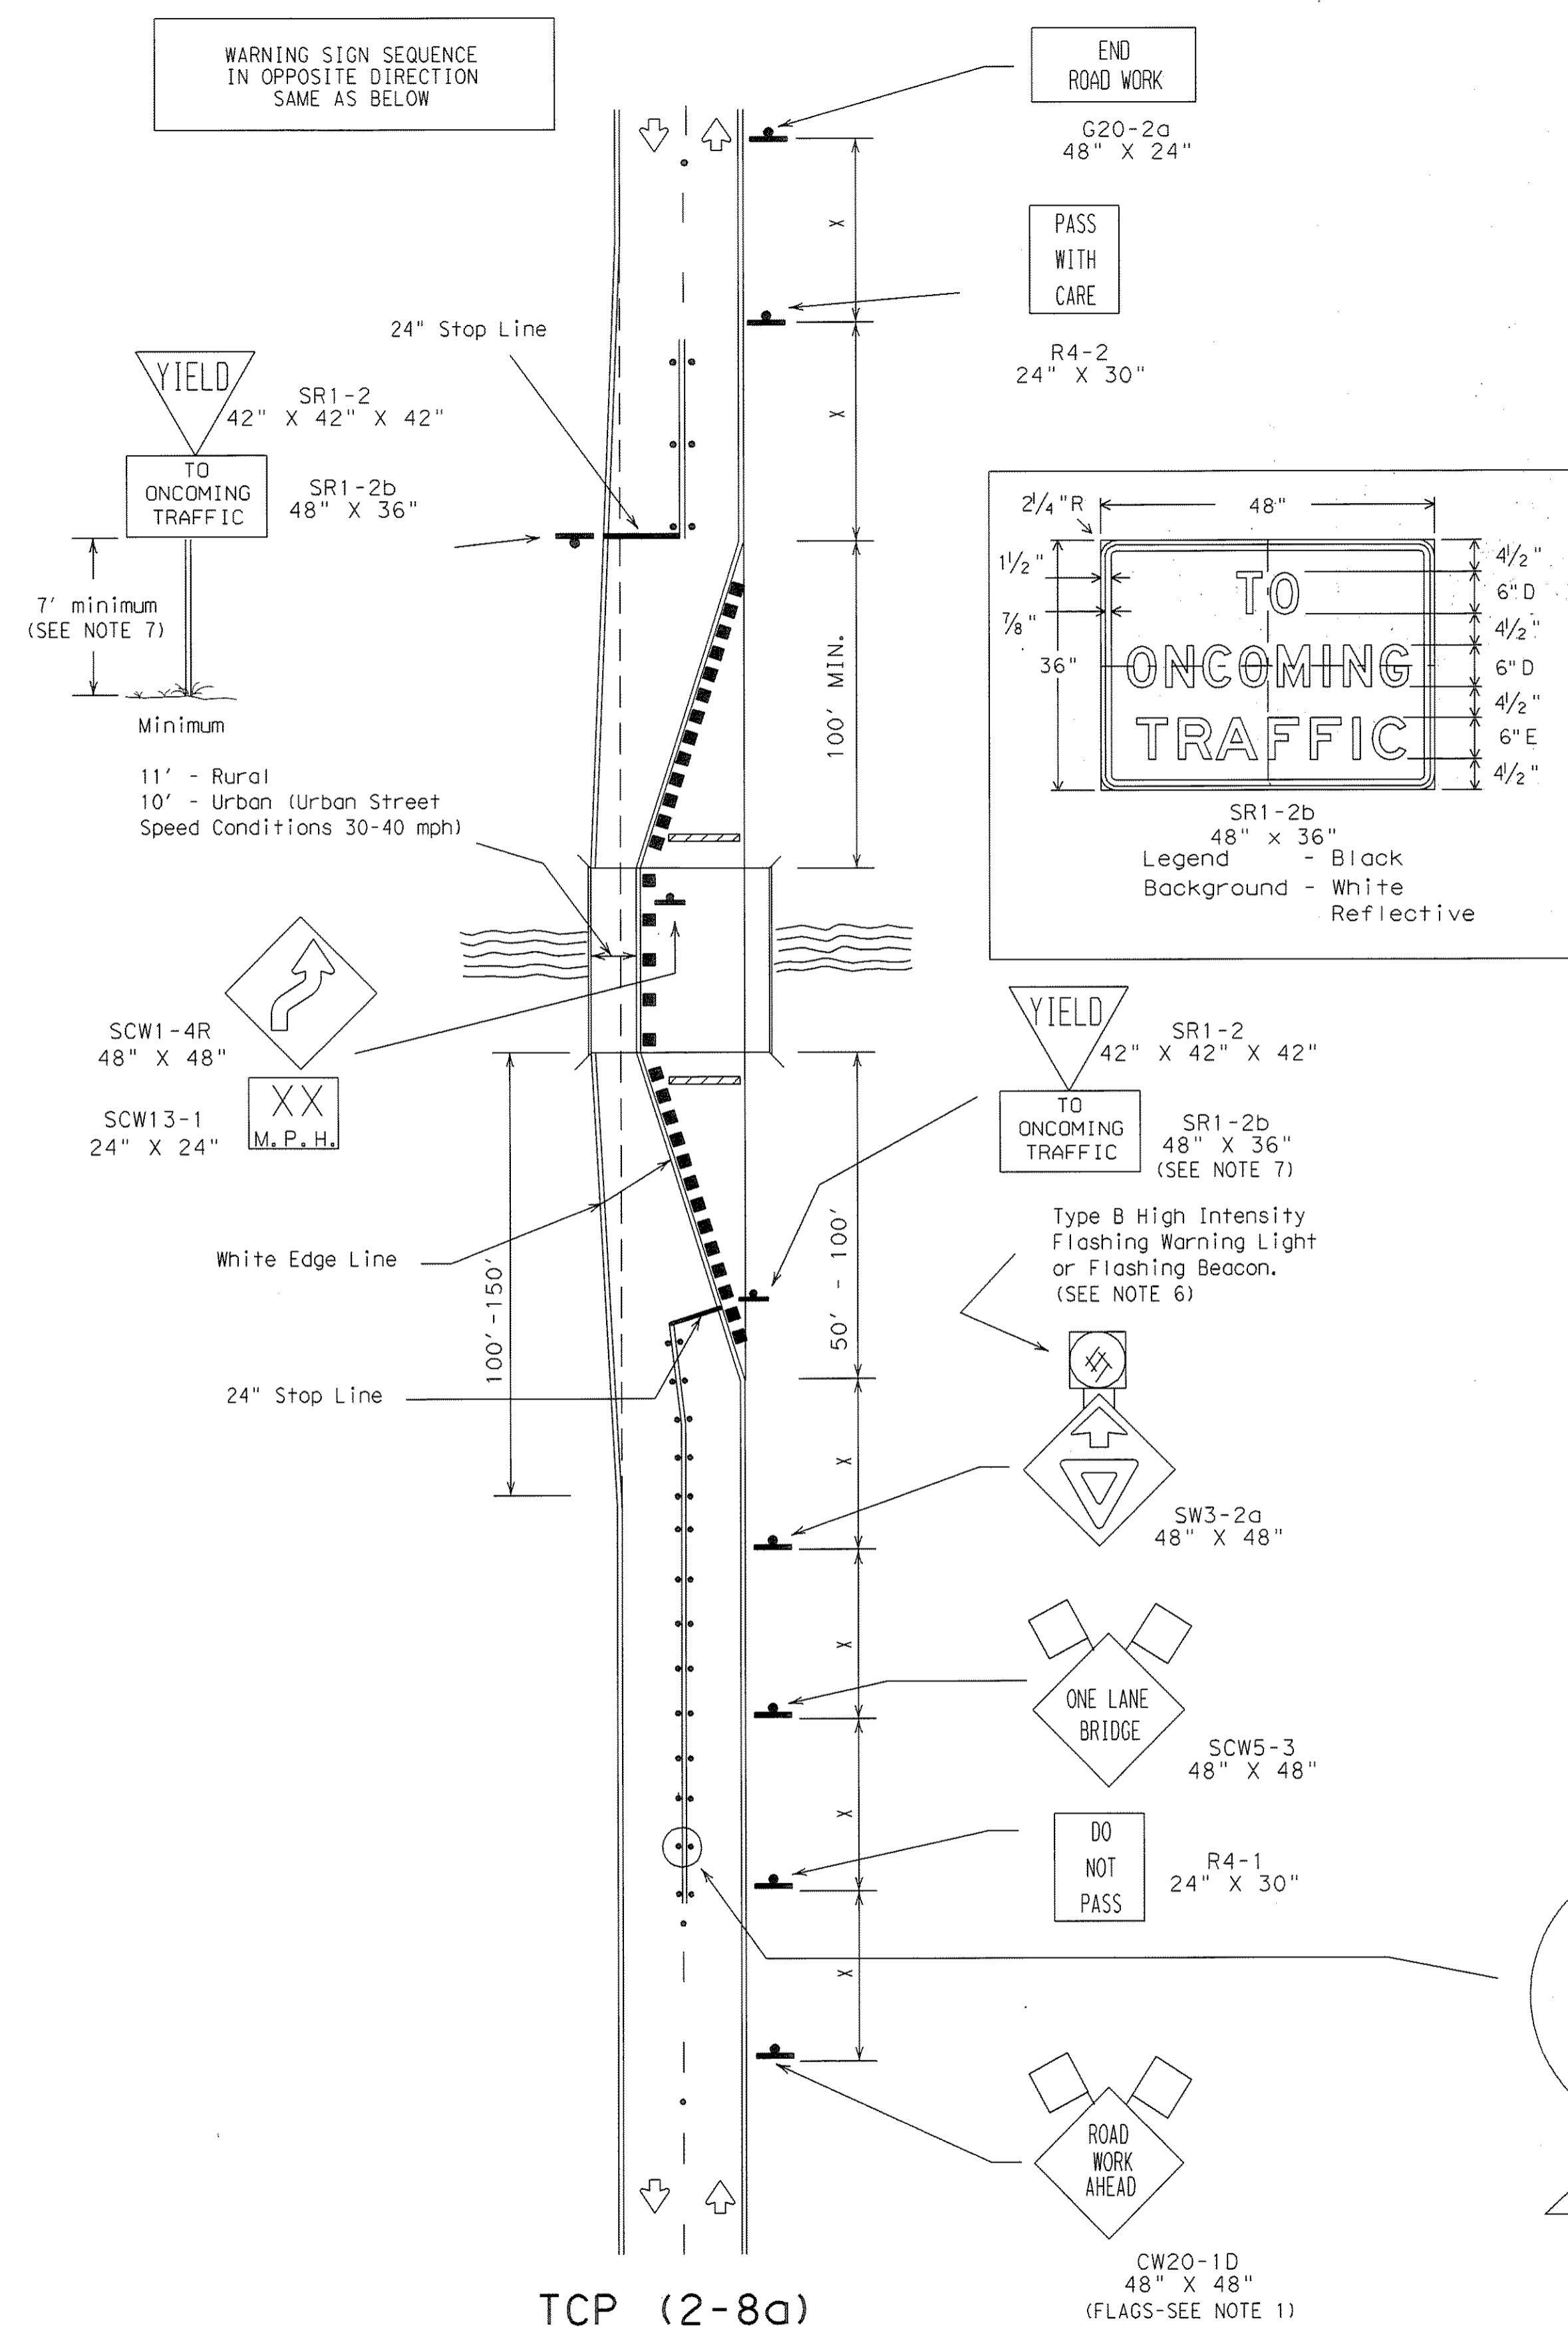

TCP (2-8a)  
 Two-Way Traffic Control  
 With Yield Signs

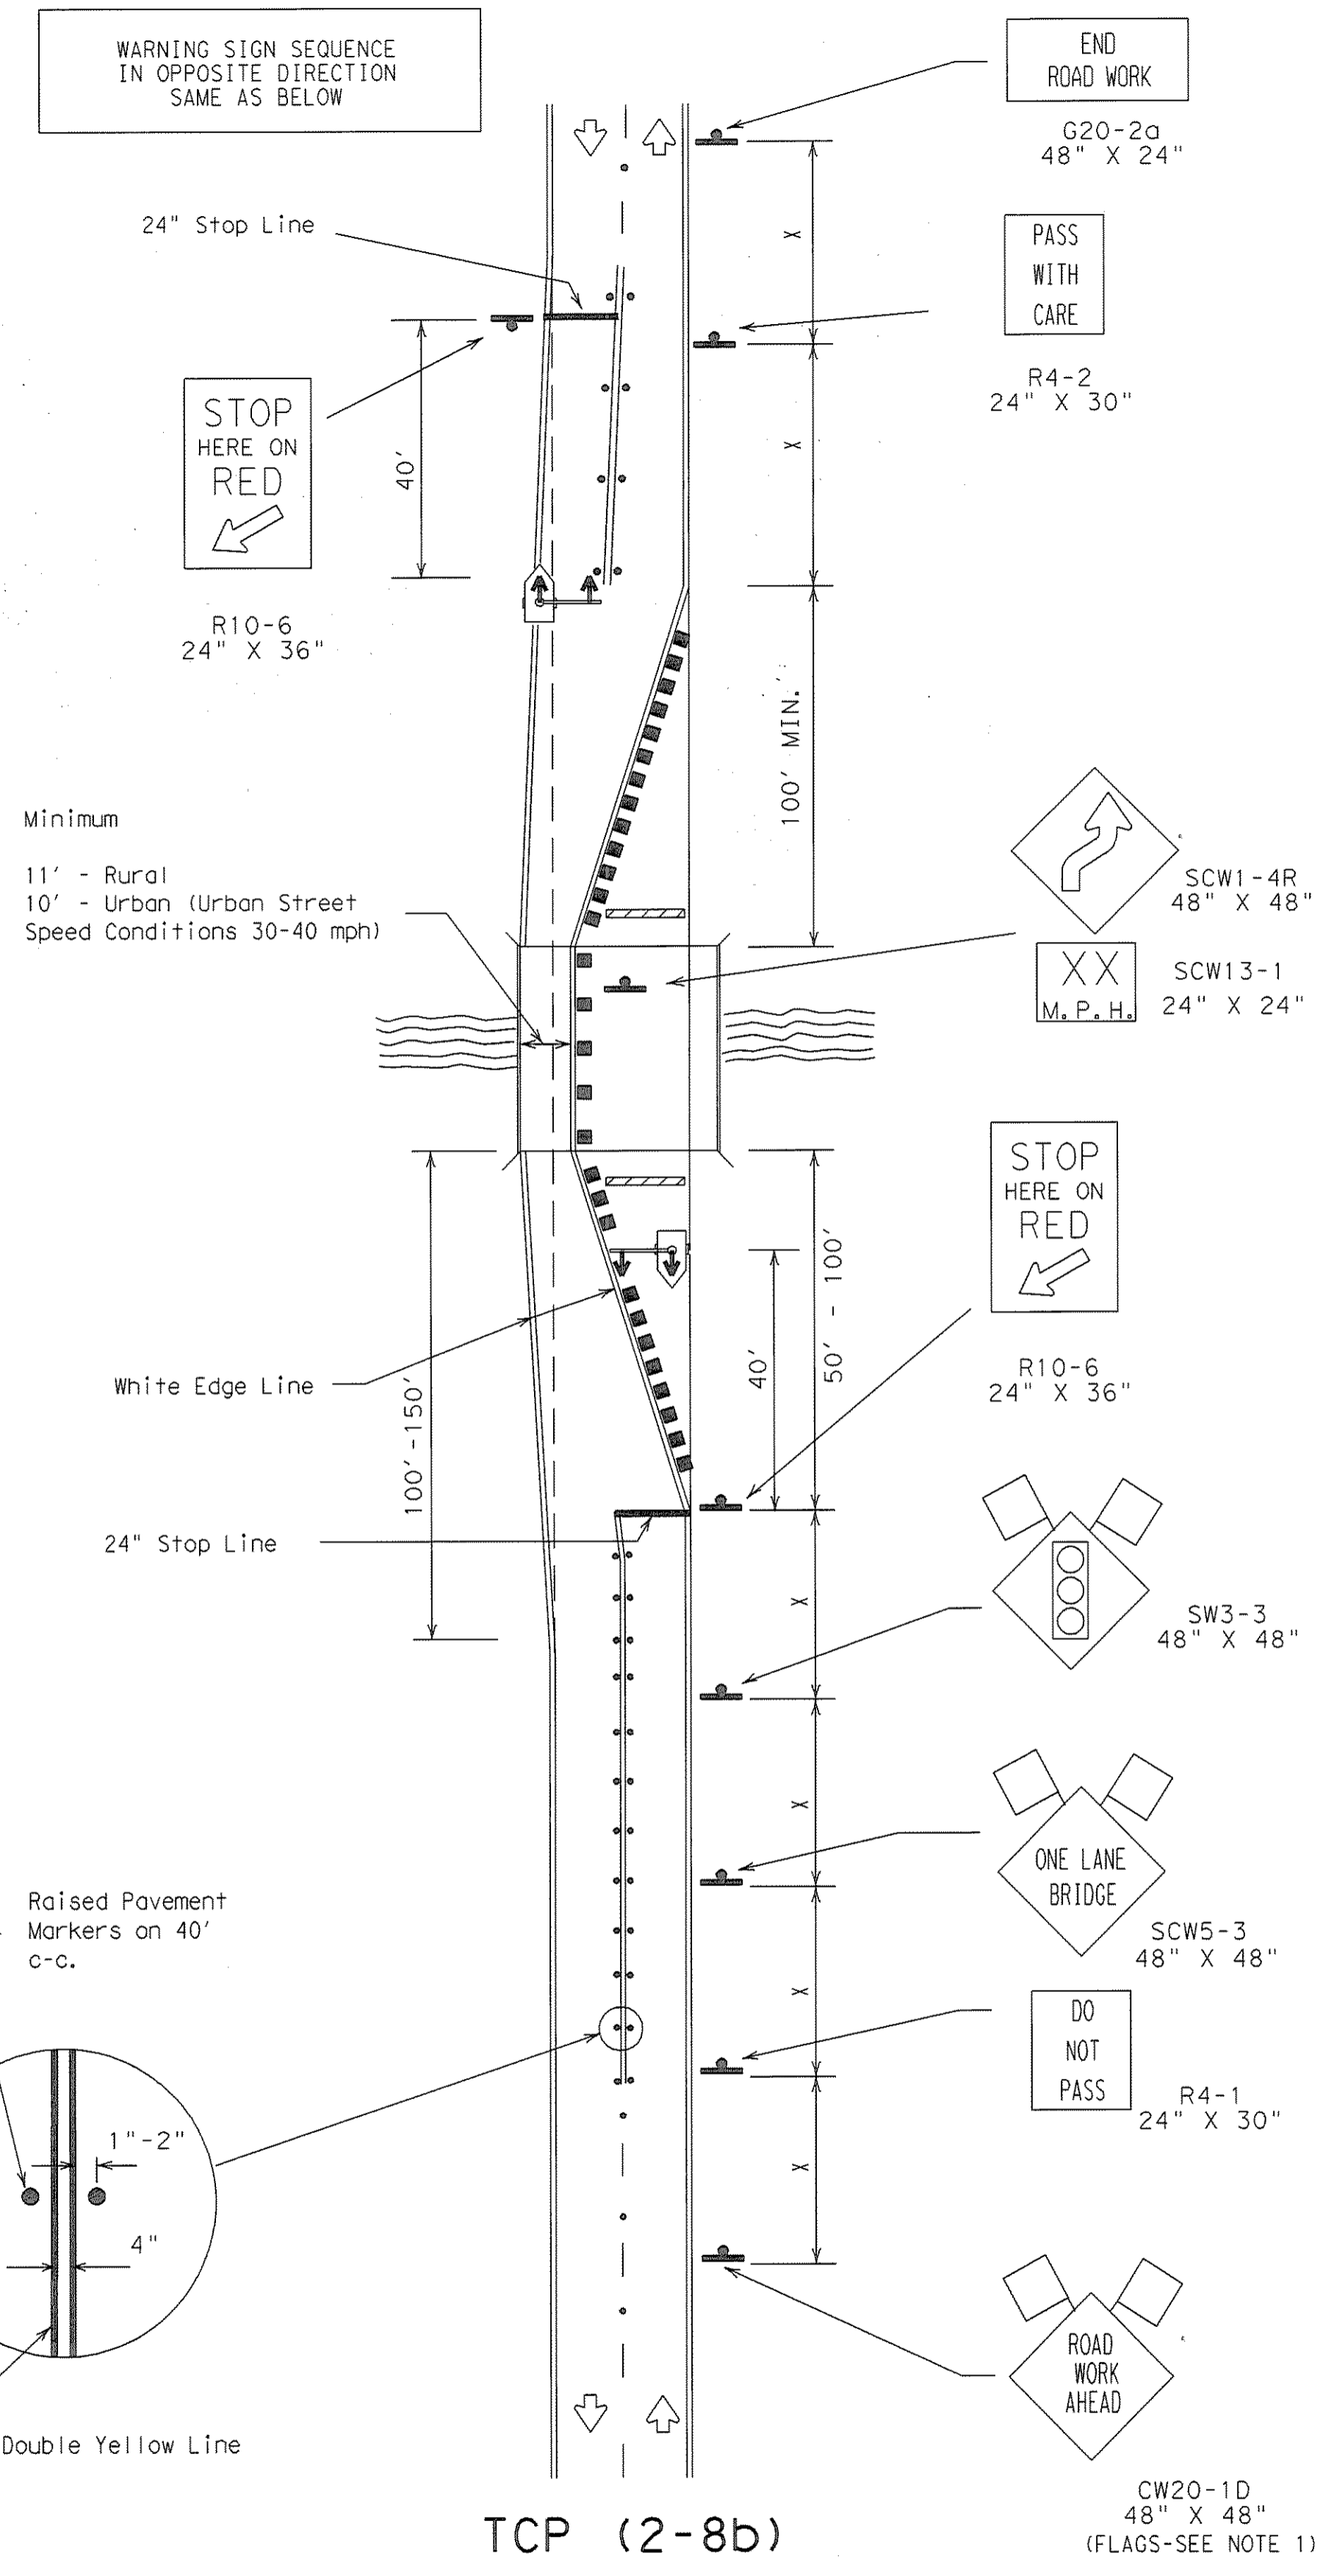

TCP (2-8b)  
 Two-Way Traffic Control  
 With Traffic Signal

LEGEND

	Type III Barricade		Channelizing Devices		Flag
	Flagger		Sign Post		Temporary or Portable Traffic Signals

• • • Raised Pavement Markers Type III-A-A (40' spacing)

Posted Speed X	Formula	Minimum Desirable Taper Lengths **			Suggested Maximum Spacing of Device		Minimum Sign Spacing X Distance
		10' Offset	11' Offset	12' Offset	On a Taper	On a Tangent	
30	L = WS / 60	150'	165'	180'	30'	60' - 75'	120'
35		205'	225'	245'	35'	70' - 90'	160'
40		265'	295'	320'	40'	80' - 100'	240'
45	L = WS	450'	495'	540'	45'	90' - 110'	320'
50		500'	550'	600'	50'	100' - 125'	400'
55		550'	605'	660'	55'	110' - 140'	500'
60		600'	660'	720'	60'	120' - 150'	* 600'
65		650'	715'	780'	65'	130' - 165'	* 700'
70	700'	770'	840'	70'	140' - 175'	* 800'	

* Conventional Roads Only  
 ** Taper lengths have been rounded off.  
 L=Length of Taper (FT.) W=Width of Offset (FT.) S=Posted Speed (MPH)

TYPICAL USAGE:

MOBILE	SHORT DURATION	SHORT TERM STATIONARY	INTERMEDIATE TERM STATIONARY	LONG TERM STATIONARY

- GENERAL NOTES:
- Unless otherwise stated in the plans, flags attached to signs are REQUIRED.
  - Advance Warning signing shown for one direction.
  - Raised reflective pavement markers shall be placed 40' c-c on centerline between ROAD WORK AHEAD signs and stop lines.
  - For intermediate term situations, when it is not feasible to remove and restore pavement markings, the channelization must be made dominant by using a very close spacing. This is especially important in locations of conflicting information, such as where traffic is directed over a double yellow centerline. In such locations a maximum channelizing device spacing of 10 feet is recommended. The 10 foot channelizing device spacing recommendation is intended for the area of conflicting information and not the entire work zone.
- TCP (2-8a)
- Traffic control by YIELD AHEAD symbol signs for one lane two-way traffic control operations should be limited to structures less than 400' long and roadways with less than 4000 ADT. Portable traffic signals should be used on other roadways.
  - If power is available, a flashing beacon should be attached to the YIELD AHEAD symbol sign for emphasis.
  - YIELD and TO ONCOMING TRAFFIC signs and other regulatory signs shall be installed at 7' minimum mounting height.
- TCP (2-8b)
- A list of approved Portable Traffic Signals can be found on compliant products list.

RECORD PLANS  
 MARCH 28, 2008

STANDARD PLANS  
 TEXAS DEPARTMENT OF TRANSPORTATION  
 Traffic Operations Division

TRAFFIC CONTROL PLAN


TCP (2-8) - 03

REVISED	DATE	BY	REASON
1-97	8-95		
4-98	1-97		
3-03	4-98		


1208

DISCLAIMER  
The use of this standard is governed by the "Texas Engineering Practice Act". No warranty of any kind is made by TxDOT for any purpose whatsoever. TxDOT assumes no responsibility for the conversion of this standard to other formats or for incorrect results or damages resulting from its use.

LEVELS DISPLAYED: 1 2 3 4 5 6 7 8 9 10 11 12 13 14 15 16  
 DN: 17 18 19 20 21 22 23 24 25 26 27 28 29 30 31 32  
 CK: 33 34 35 36 37 38 39 40 41 42 43 44 45 46 47 48  
 ACC: 49 50 51 52 53 54 55 56 57 58 59 60 61 62 63  
 DATE: 64 65 66 67 68 69 70 71 72 73 74 75 76 77 78 79 80  
 FILE: 81 82 83 84 85 86 87 88 89 90 91 92 93 94 95 96 97 98 99 100

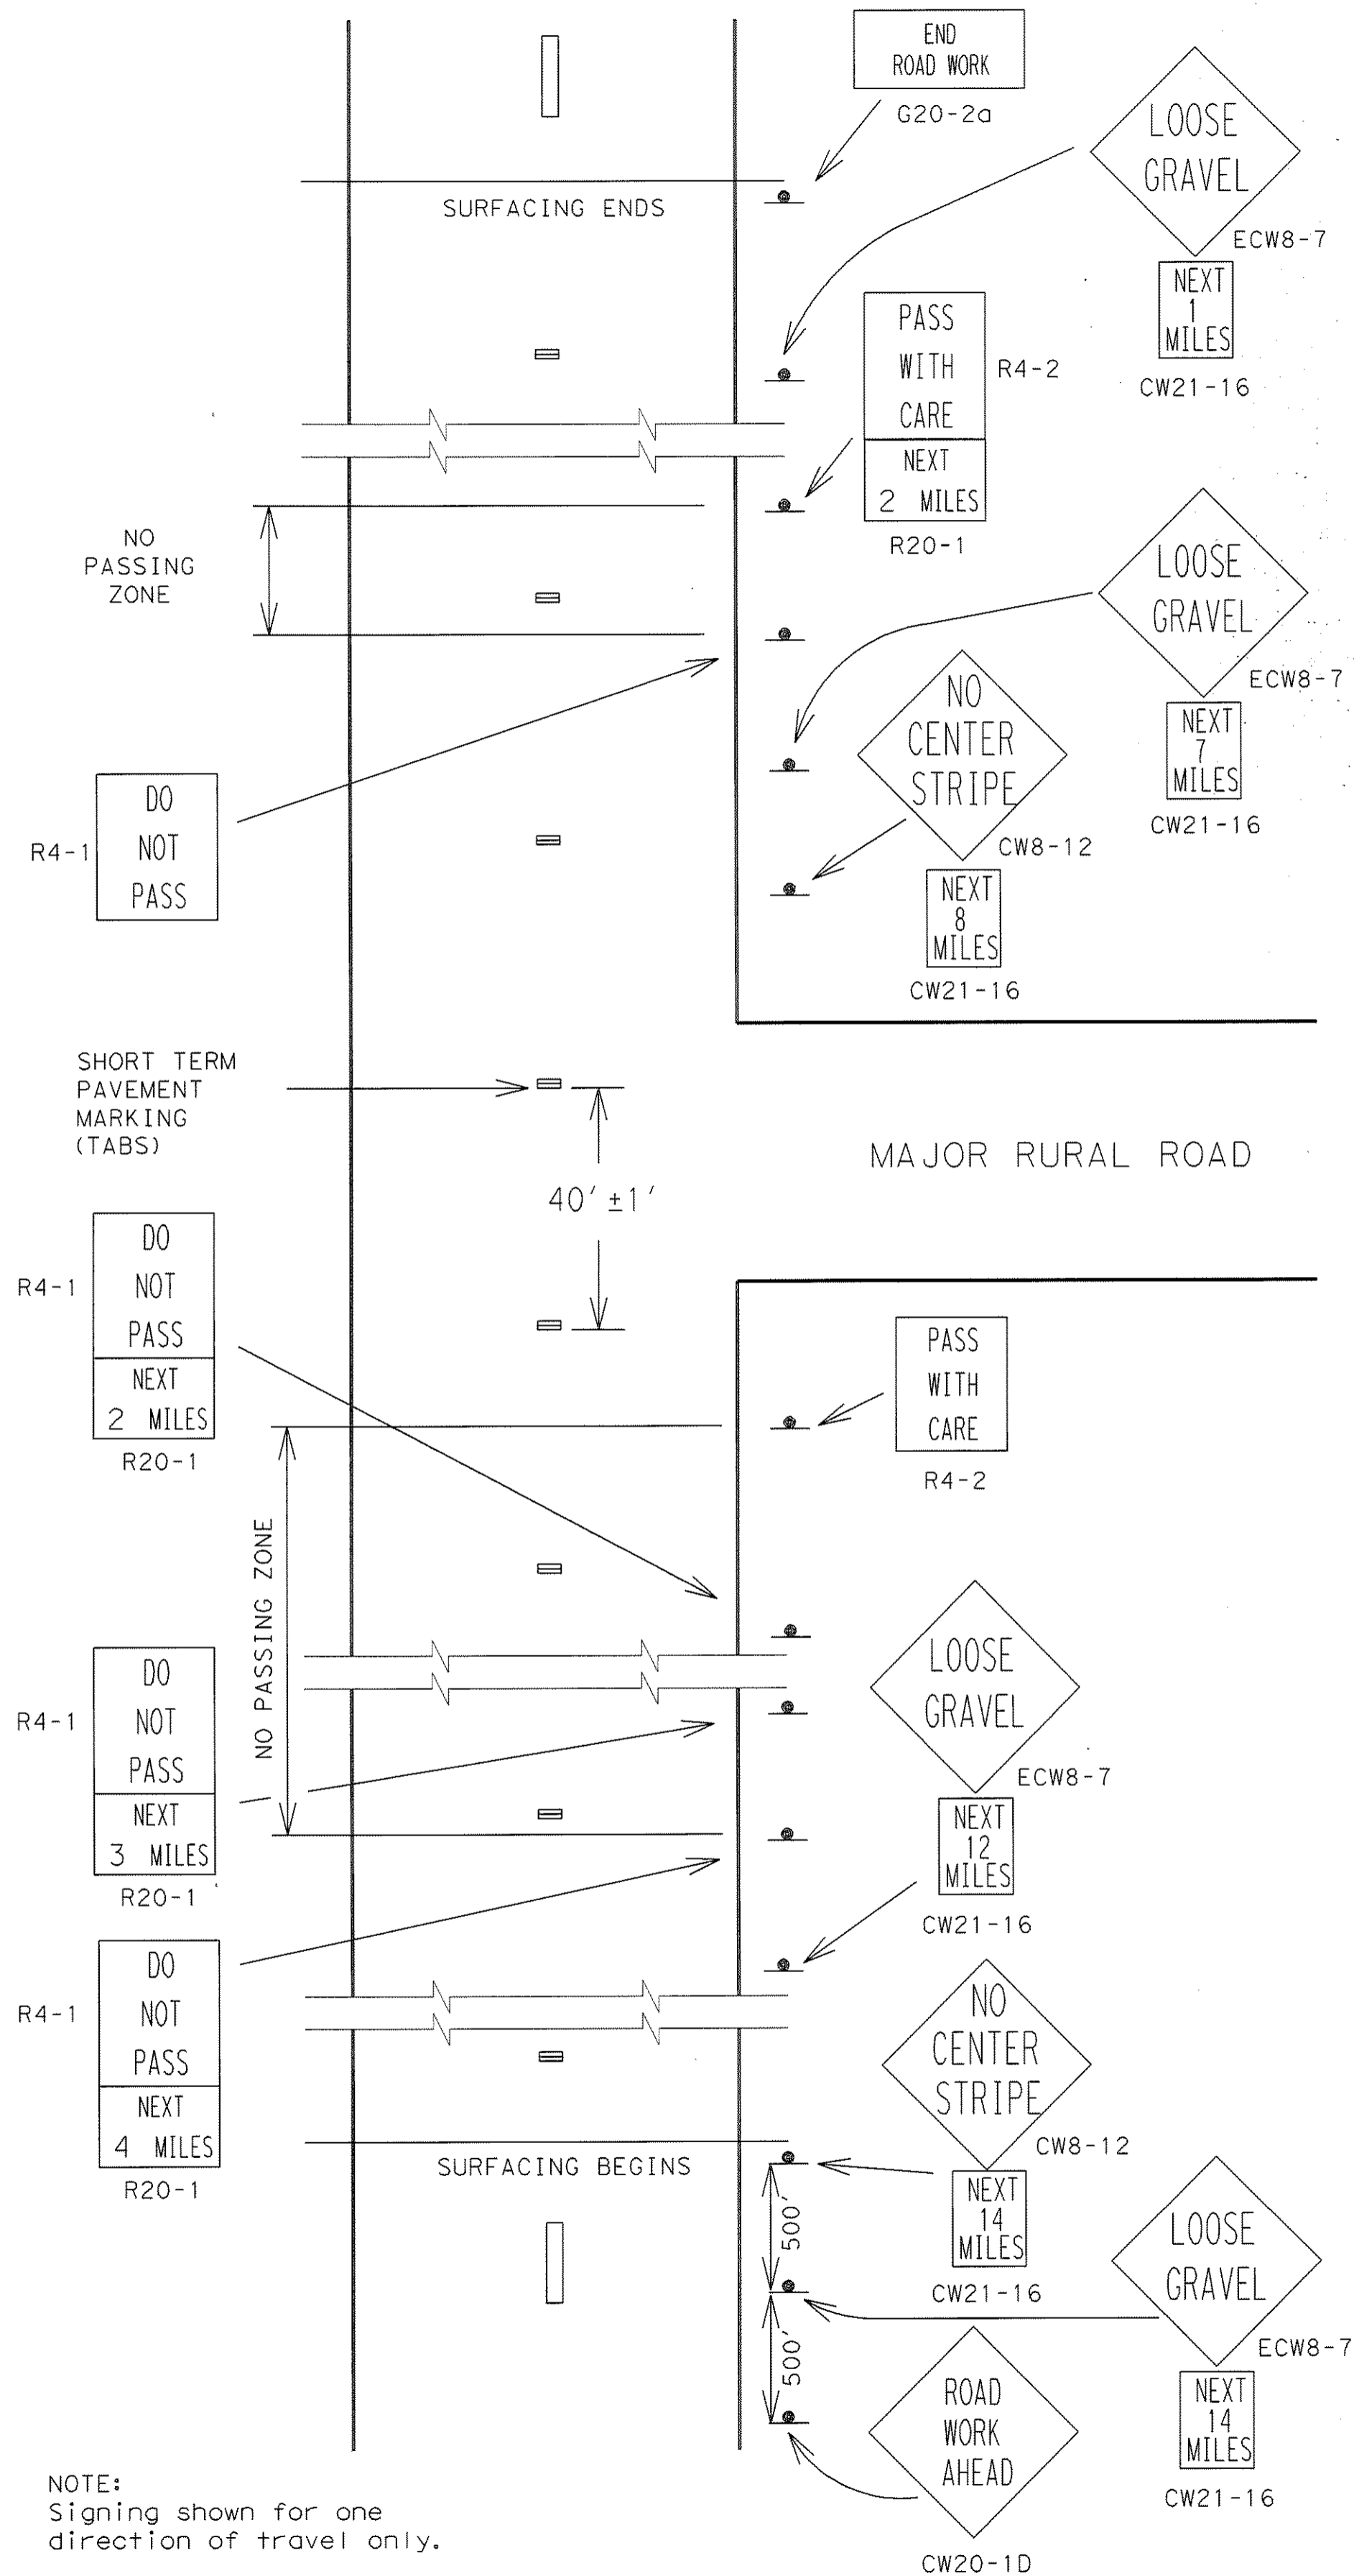


NOTE:  
Signing shown for one direction of travel only.

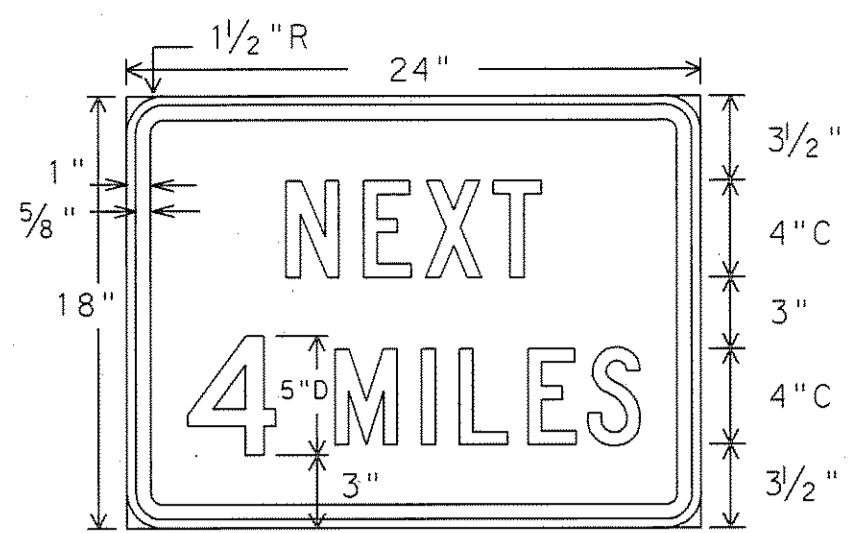

R20-1  
24"x18"

Legend - Black  
Border - Black  
Background - White Refl.


FOR USE WITH REGULATORY SIGNS ONLY

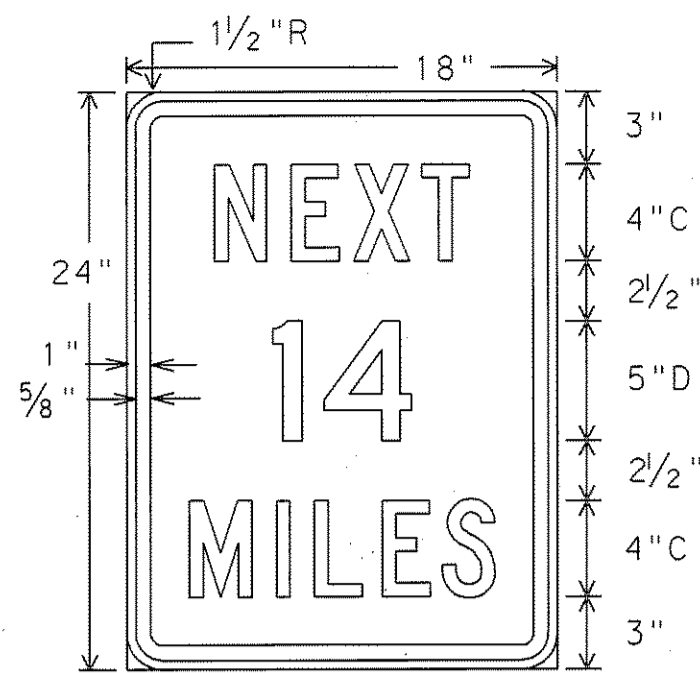

CW21-16  
18"x24"


Legend - Black  
Border - Black  
Background - Orange Refl.

FOR USE WITH CONSTRUCTION WARNING SIGNS ONLY

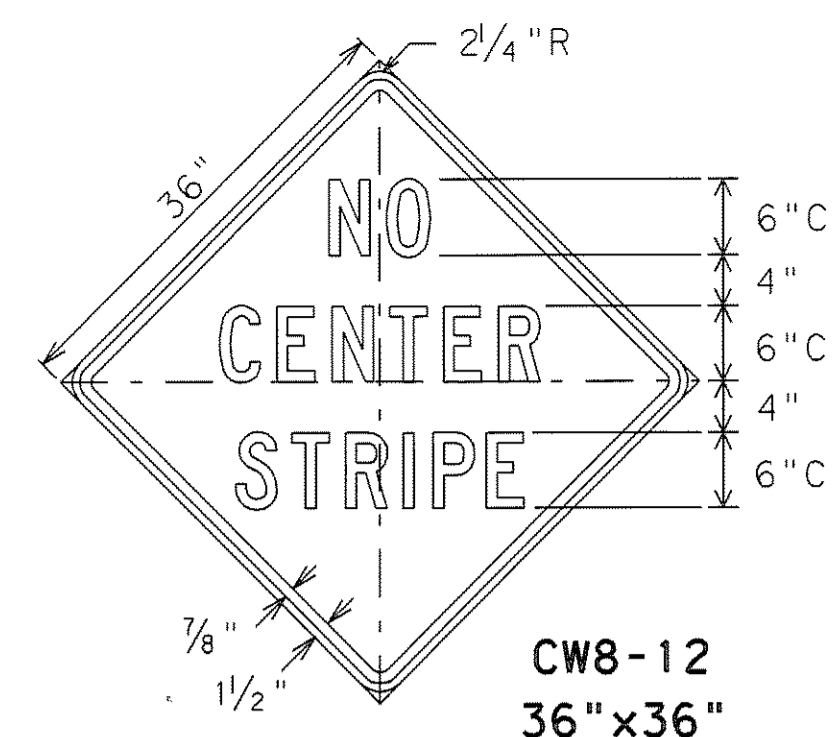


CW8-12  
36"x36"

Legend - Black  
Border - Black  
Background - Orange Refl.

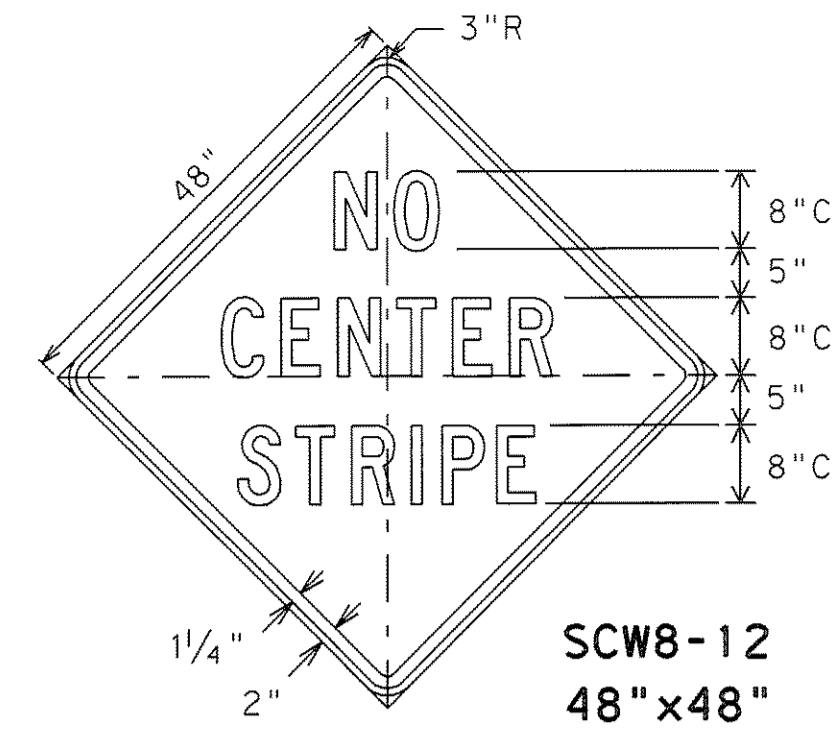

SCW8-12  
48"x48"

Legend - Black  
Border - Black  
Background - Orange Refl.

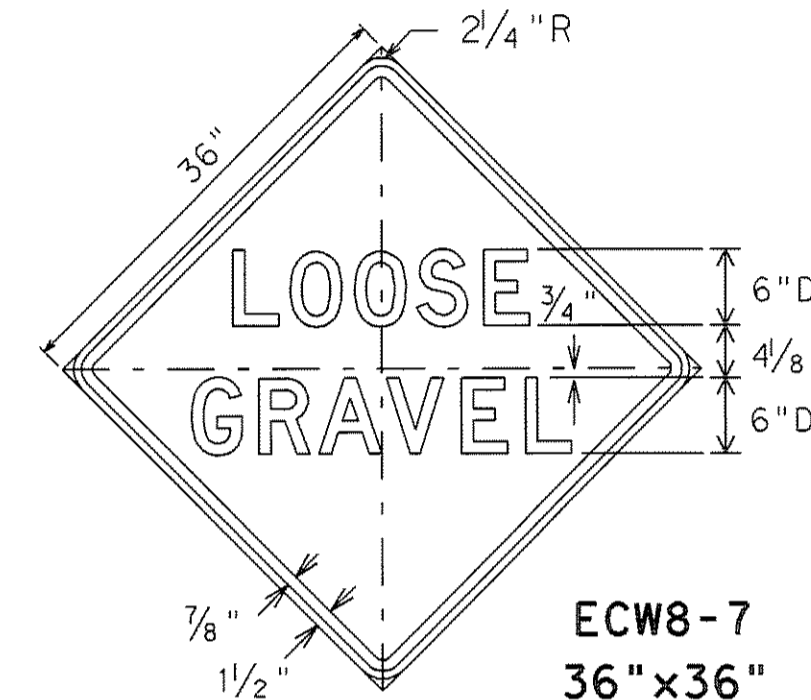


ECW8-7  
36"x36"

Legend - Black  
Border - Black  
Background - Orange Refl.

TEMPORARY FLEXIBLE-REFLECTIVE ROADWAY MARKER TABS

for surfacing projects only

Standard pavement markings to be placed within 14 calendar days after temporary flexible-reflective roadway marker tabs

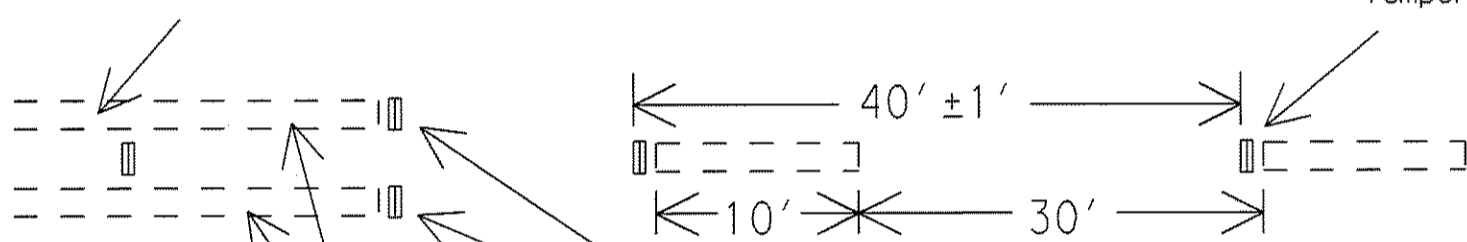

Paint & Beads

Type Y-2 temporary flexible-reflective roadway marker tabs



Temporary flexible-reflective roadway marker tabs placed to indicate beginning and end of no passing zones, are optional

GENERAL NOTES

The traffic control devices detailed on this sheet will be furnished and erected as directed by the Engineer on sections of roadway where the surfacing operation has covered or obliterated existing pavement markings. These traffic control devices are to be used to supplement those required by BC Standards.

"DO NOT PASS" SIGN (R4-1) and NO-PASSING ZONES

Prior to the beginning of construction, all currently striped no-passing zones should be signed with the DO NOT PASS sign (R4-1) and PASS WITH CARE sign (R4-2) placed at the beginning and end of each zone for each direction of travel except as otherwise provided herein. Signs marking these individual no-passing zones need not be covered prior to construction if the signs supplement the existing pavement markings.

At the discretion of the Engineer, in areas of numerous no-passing zones, several zones may be combined and signed as a single zone. If passing is to be prohibited over one or more lengthy sections, a DO NOT PASS sign and a NEXT XX MILES sign (R20-1) may be used at the beginning of such zones. The DO NOT PASS and NEXT XX MILES signs should be repeated every mile to the end of the no-passing zone. In areas where there is considerable distance between no-passing zones, the end of a no-passing zone may be signed with a PASS WITH CARE and NEXT XX MILES sign.

Depending on traffic volumes and length of sections, it may be desirable to prohibit passing throughout the project to prevent damage to windshields and lights. The DO NOT PASS and NEXT XX MILES sign should be used and repeated as often as necessary for this purpose. Where several existing zones are to be combined into one individual no-passing zone, the sign at the beginning of the zone should be covered until the surfacing operation has passed this location so as not to have the DO NOT PASS sign conflict with existing pavement markings. Also, unless one days operation completes the entire length of such combined zones, care must be taken to place DO NOT PASS and PASS WITH CARE signs in order to sign the beginning and end of the no-passing zones in the area where the surfacing operation has stopped for the day.

R4-1 and R4-2 signs should be mounted on fixed supports as detailed on BC Standards. These signs are to remain in place until standard pavement markings are placed.

"NO CENTER STRIPE" SIGN (CW21-15)

At the time construction activity obliterates the existing centerline (low volume roads may not have an existing centerline), a NO CENTER STRIPE sign (CW8-12) should be erected at each end of the work area and just beyond major rural intersections and other location deemed necessary by the Engineer. Where possible, the signs erected at each end of the work area should be located in such a manner that drivers can read the sign and immediately see the change to no centerline. The NO CENTER STRIPE sign should be supplemented with the NEXT XX MILES sign (CW21-16) mounted below it.

The NO CENTER STRIPE sign should be erected as detailed on BC Standards. These signs are to remain in place until standard pavement markings are placed.

"LOOSE GRAVEL" SIGN (ECW8-7)

When construction begins, a LOOSE GRAVEL sign (ECW8-7) should be erected at each end of the work area and repeated at intervals of approximately two (2) miles in rural areas and closer in urban areas. The LOOSE GRAVEL sign should be supplemented with the NEXT XX MILES sign (CW21-16) mounted below it.

The LOOSE GRAVEL sign should be erected as detailed on BC Standards. They should remain in place until the loose gravel condition no longer exists.

PAVEMENT MARKINGS

Short term pavement markings for surfacing projects shall use Temporary Flexible-reflective Roadway Marker Tabs. Tabs are to be installed to provide true alignment for striping crews or as directed by the Engineer. Tabs will be placed at the spacing indicated. Tabs should be applied to the pavement no more than two (2) days before the surfacing is applied. After the surfacing is rolled and swept the cover over the reflective strip shall be removed. Tabs shall NOT be used to simulate edge lines.

Only pre-qualified products shall be used. A list of compliant products and their sources may be obtained by writing or faxing:  
 Standards Engineer  
 Traffic Operations Division - TE  
 Texas Department of Transportation  
 125 East 11th Street  
 Austin, Texas 78701-2483  
 Phone (512) 416-3335  
 Fax (512) 416-3161  
 E-mail TRF-STANDARD@mailgw.dot.state.tx.us

RECORD PLANS  
MARCH 28, 2008

TYPICAL USAGE:				
MOBILE	SHORT DURATION	SHORT TERM STATIONARY	INTERMEDIATE TERM STATIONARY	LONG TERM STATIONARY
	✓	✓	✓	✓

STANDARD PLANS  
TEXAS DEPARTMENT OF TRANSPORTATION  
Traffic Operations Division

TRAFFIC CONTROL DETAILS  
for  
SURFACING OPERATIONS  
TCP (7-1)-98

REVISONS	STATE DISTRICT	FEDERAL REGION	FEDERAL #10 PROJECT	DATE
4-92	E			T209
1-97				
4-98	COUNTY	CONTROL	SECTION	JOB
				HIGHWAY

DISCLA I M E R  
 The use of this standard is governed by the "Texas Engineering Practice Act". No warranty of any kind is made by TxDOT for any purpose whatsoever. TxDOT assumes no responsibility for the conversion of this standard to other formats or for incorrect results or damages resulting from its use.

LEVELS DISPLAYED  
 1 2 3 4 5 6 7 8 9 10 11 12 13 14 15 16  
 ACC:  
 17 18 19 20 21 22 23 24 25 26 27 28 29 30 31 32  
 33 34 35 36 37 38 39 40 41 42 43 44 45 46 47 48  
 49 50 51 52 53 54 55 56 57 58 59 60 61 62 63

Barricade and Construction (BC) Standard Sheets General Notes:  $\Delta$

1. The Barricade and Construction Standard Sheets (BC sheets) are intended to show typical examples for placement of traffic control devices, construction pavement markings, and typical construction signs. The information contained in these sheets meet or exceed the requirements shown in the "Texas Manual on Uniform Traffic Control Devices" (TMUTCD).
2. The development and design of the Traffic Control Plan (TCP) is the responsibility of the Engineer.
3. The Contractor may propose changes to the TCP that are signed and sealed by a licensed professional engineer for approval. The Engineer may develop, sign and seal Contractor proposed changes.
4. The Contractor is responsible for installing and maintaining the traffic control devices as shown in the plans. The Contractor may not move or change the approximate location of any device without the approval of the Engineer.
5. Geometric design of lane shifts and detours should, when possible, meet the applicable design criteria contained in manuals such as the American Association of State Highway and Transportation Officials (AASHTO) "Policy on the Geometric Design of Highways and Streets" or the TxDOT "Roadway Design Manual".
6. When projects abut, the Engineer(s) may omit the END ROAD WORK, TRAFFIC FINES DOUBLE, and other advance warning signs if the signing would be redundant and the work areas appear continuous to the motorists. If the adjacent project is completed first, the Contractor will erect the necessary warning signs as shown on these sheets, the TCP sheets or as directed by the Engineer. The BEGIN ROAD WORK NEXT X MILES sign will be revised to show appropriate work zone distance.
7. The Engineer may require duplicate construction warning signs on the median side of divided highways where median width will permit and traffic volumes justify the signing.
8. All signs shall be constructed in accordance with the details found in the "Standard Highway Sign Designs for Texas," latest edition. Sign details not shown in this manual shall be shown in the plans or the Engineer shall provide a detail to the Contractor before the sign is manufactured.
9. The traffic control devices shown in the illustrations of the BC sheets are examples. As necessary, the Engineer will determine the most appropriate traffic control devices to be used.
10. As shown on BC(2), the OBSERVE WARNING SIGNS STATE LAW, BEGIN ROAD WORK NEXT X MILES, CONTRACTOR and END ROAD WORK signs shall be erected at or near the CSJ limits and the WORK ZONE TRAFFIC FINES DOUBLE sign with plaque shall be erected in advance of the CSJ limits.
11. Except for devices required by Note 10, traffic control devices should be in place only while work is actually in progress or a definite need exists.
12. The Engineer has the final decision on the location of all traffic control devices.

Only pre-qualified products shall be used. A copy of the "Compliant Work Zone Traffic Control Devices List" (CWZTCD) describes pre-qualified products and their sources and may be obtained by contacting:


Standards Engineer  
 Traffic Operations Division - TE  
 Texas Department of Transportation  
 125 East 11th Street  
 Austin, Texas 78701-2483  
 Phone (512) 416-3120  
 Fax (512) 416-3299

Instructions to locate the "CWZTCD" on TxDOT website are:

Start at website - [www.dot.state.tx.us](http://www.dot.state.tx.us)  
 Click on "About TxDOT",  
 Click on "Organizational Chart",  
 Click on Traffic Operations Box,  
 Click on "Compliant Work Zone Traffic Control Devices",  
 Click on "View PDF".  
 This site is printable.

RECORD PLANS  
 MARCH 28, 2008

4/03 Revision  
 $\Delta$  Revised General Notes


**STANDARD PLANS**  
**TEXAS DEPARTMENT OF TRANSPORTATION**  
*Traffic Operations Division*


**BARRICADE AND CONSTRUCTION**  
**GENERAL NOTES**  
**AND REQUIREMENTS**

1 of 12 BC(1)-03


© TxDOT 11-4-02		DN - BAS	CS - GRB	DM - FDN	CK - CAL
REVISIONS	STATE DISTRICT	FEDERAL REGION	PROJECT NUMBER		SHEET
4-03	6	6			T210
COUNTY		CONTROL	SECTION	JOB	HIGHWAY

DISCLAIMER  
The use of this standard is governed by the "Texas Engineering Practice Act". No warranty of any kind is made by TxDOT for any purpose whatsoever. TxDOT assumes no responsibility for the conversion of this standard to other formats or for incorrect results or damages resulting from its use.


LEVELS DISPLAYED  
1 2 3 4 5 6 7 8 9 10 11 12 13 14 15 16  
ACC: 17 18 19 20 21 22 23 24 25 26 27 28 29 30 31 32  
33 34 35 36 37 38 39 40 41 42 43 44 45 46 47 48  
49 50 51 52 53 54 55 56 57 58 59 60 61 62 63

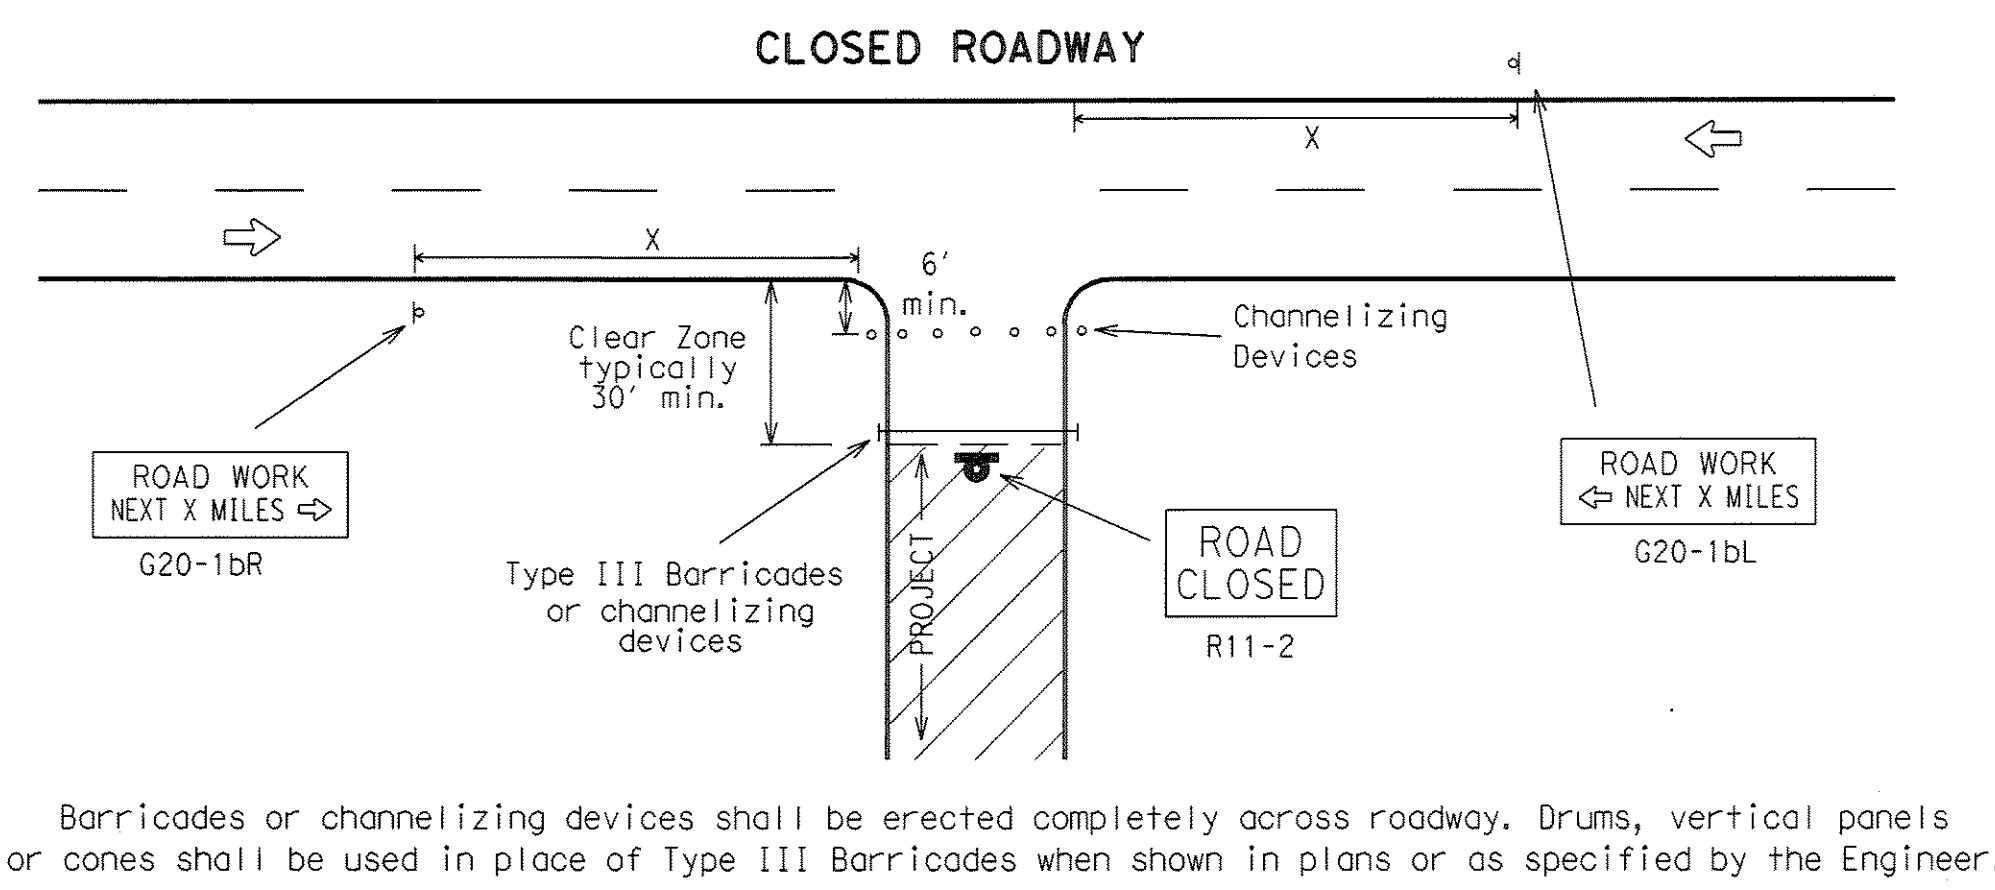

**TYPICAL LOCATION OF CROSSROAD SIGNS**

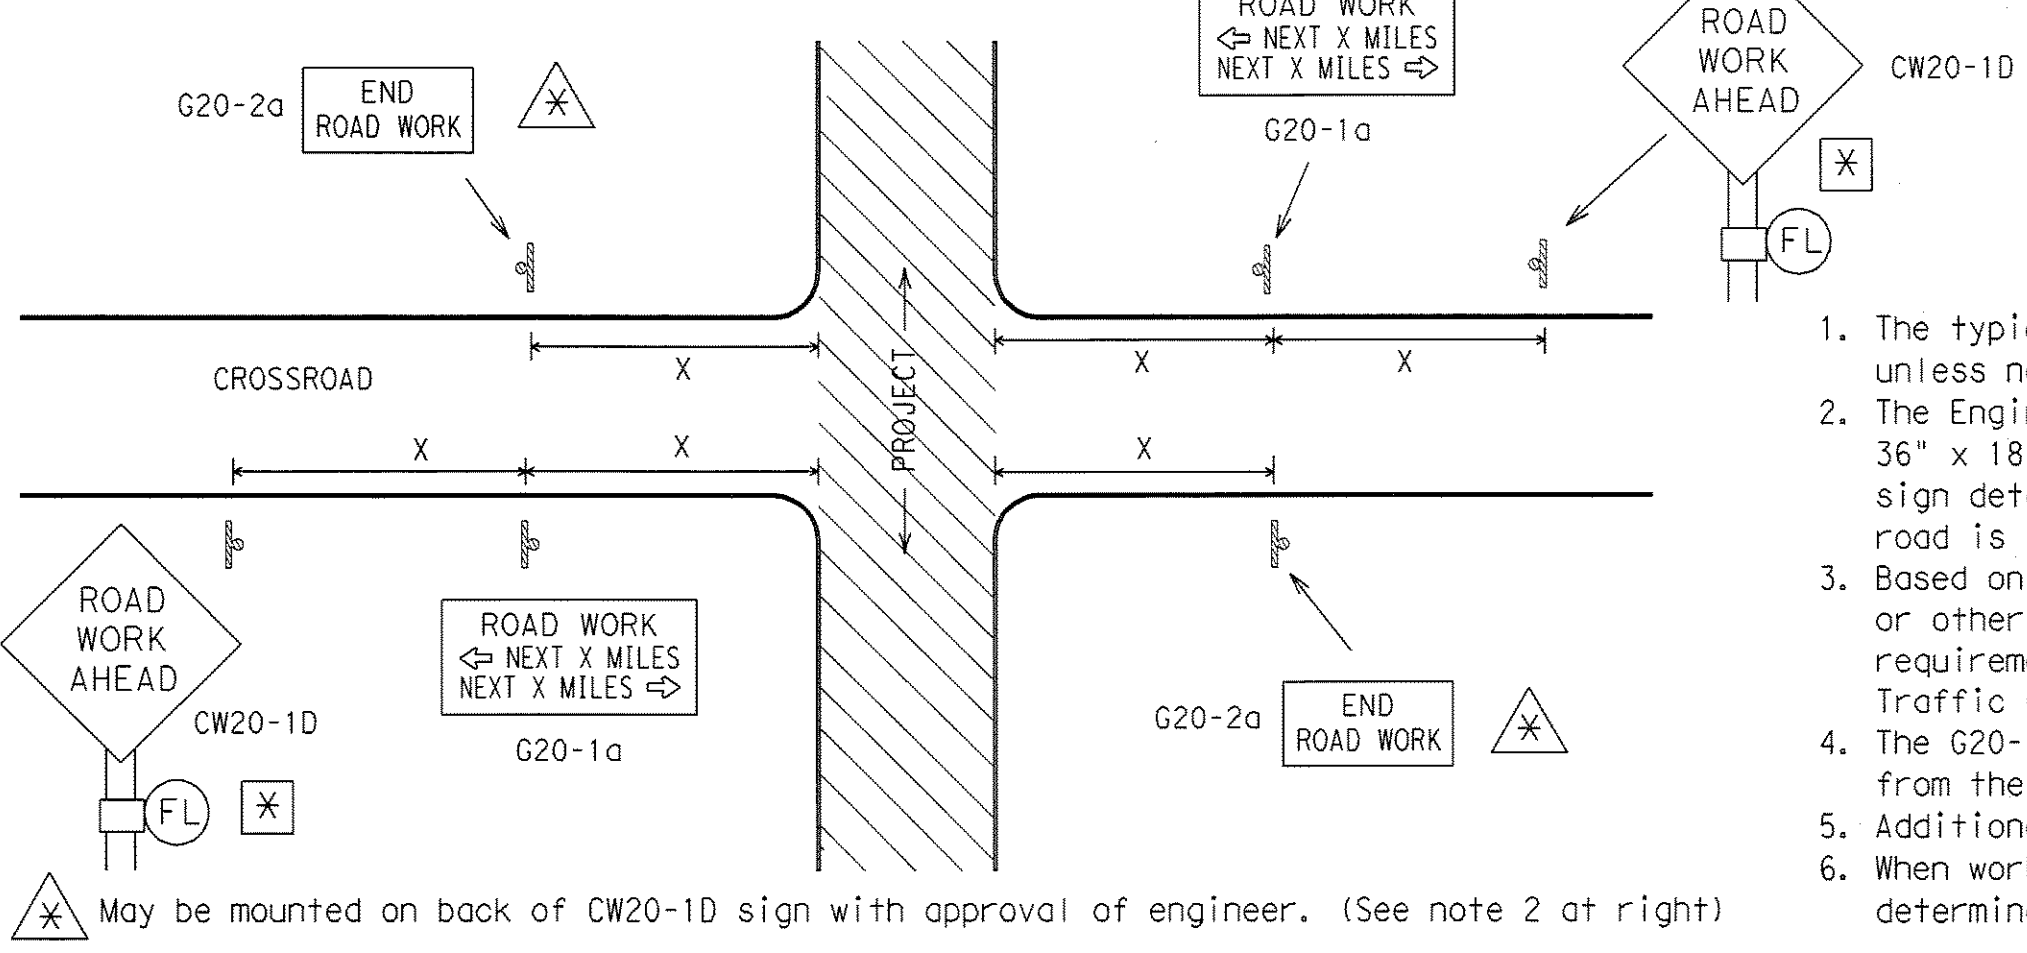

1. The typical minimum signing on a crossroad approach should be a CW20-1D ROAD WORK AHEAD sign and a G20-2a END ROAD WORK sign, unless noted otherwise in plans.
2. The Engineer may use the reduced size 36" x 36" ROAD WORK AHEAD (MCW20-1D) sign mounted back to back with the reduced size 36" x 18" END ROAD WORK (SG20-2a) sign on low volume crossroads. See the "Standard Highway Sign Designs for Texas" manual for sign details. The Engineer may omit the advance warning signs on low volume crossroads. The Engineer will determine whether a road is low volume. This information shall be shown in the plans.
3. Based on existing field conditions, the Engineer/Inspector may require additional signs such as FLAGGER AHEAD, LOOSE GRAVEL, or other appropriate signs. When additional signs are required, these signs will be considered part of the minimum requirements. The Engineer/Inspector will determine the proper location and spacing of any sign not shown on the BC sheets, Traffic Control Plan sheets or the Work Zone Standard Sheets.
4. The G20-1a sign shall be required on major crossroads to advise motorists of the length of construction in either direction from the intersection. The Engineer will determine whether a roadway is considered high volume.
5. Additional traffic control devices may be shown elsewhere in the plans for higher volume crossroads.
6. When work occurs in the intersection area, appropriate traffic control devices, as shown elsewhere in the plans or as determined by the Engineer/Inspector, shall be in place.


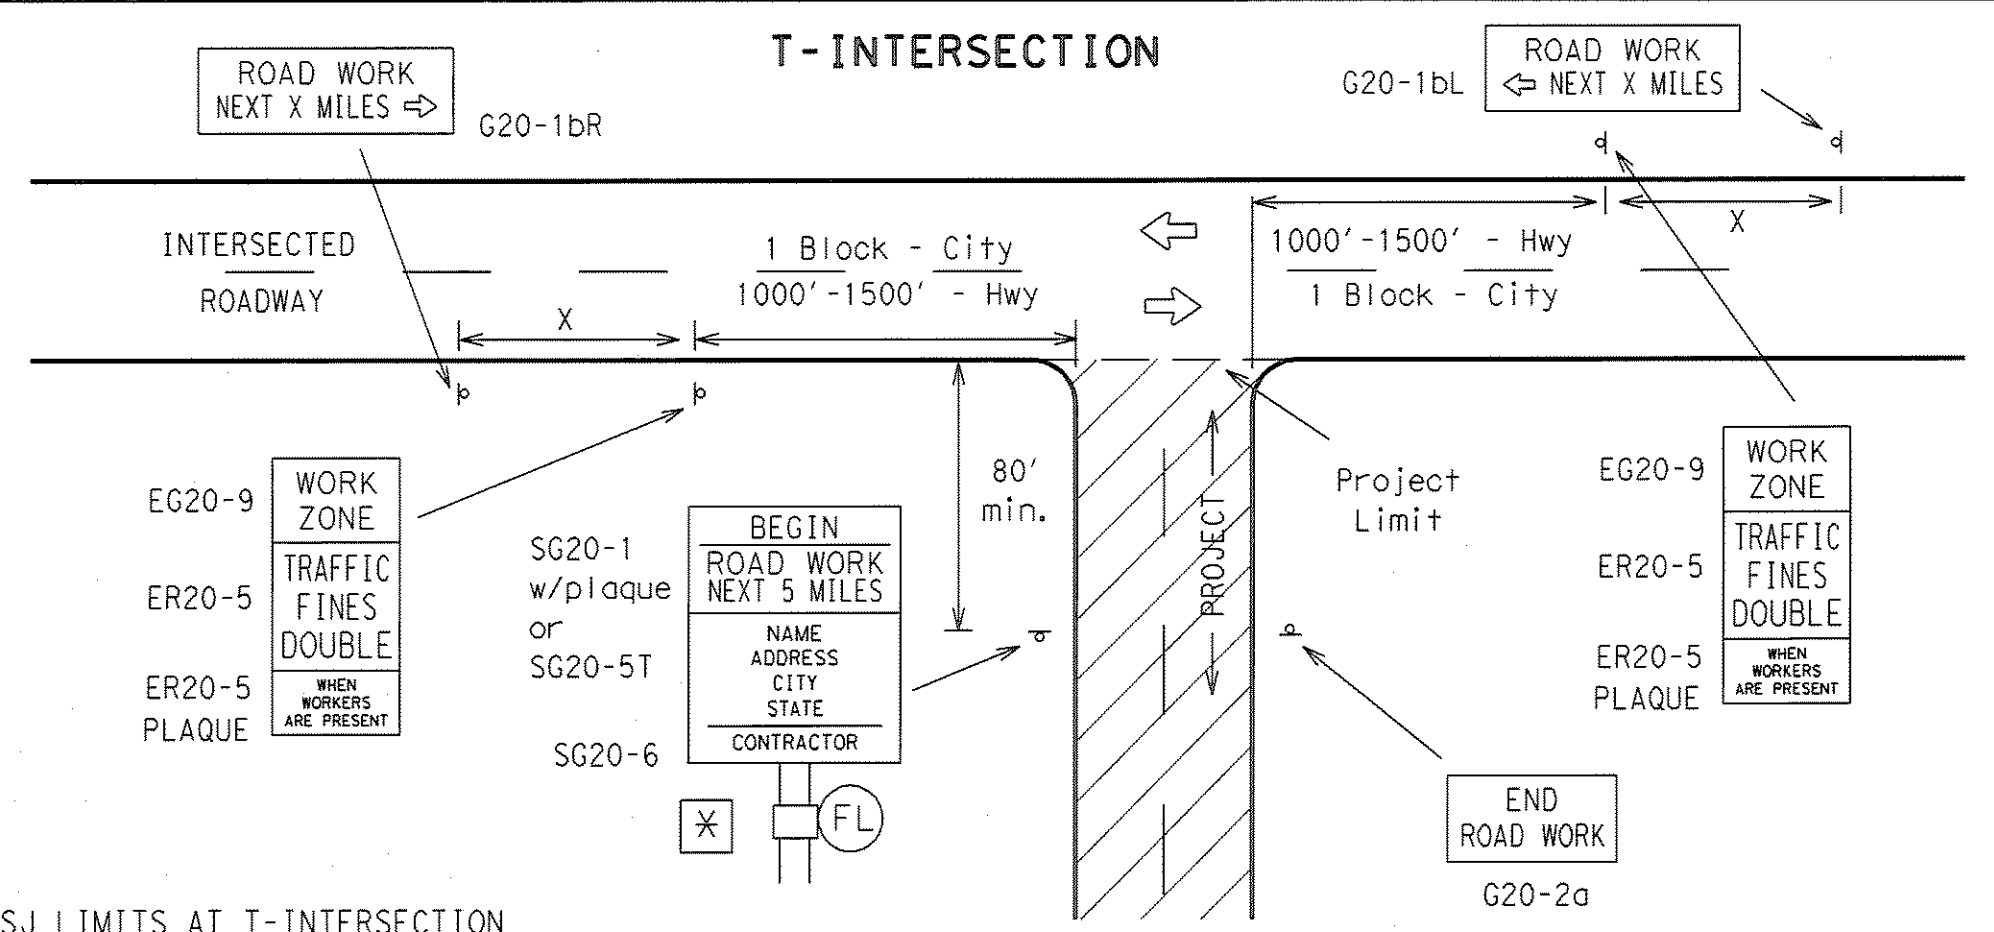


- CSJ LIMITS AT T-INTERSECTION**
1. A ROAD WORK NEXT X MILES (G20-1bR(L)) sign should be erected on the intersected highway as shown above.
  2. The Engineer will determine the types and location of any additional traffic control devices, such as a flagger and accompanying signs, or other signs, that should be used when work is being performed at or near an intersection.
  3. The Engineer/Inspector shall ensure that construction work zone signs are installed with adequate spacing between the signs so the legibility of existing permanent and other work zone signs is not obstructed.

**TYPICAL CONSTRUCTION WARNING SIGN SIZE AND SPACING**^{1,5,6}

Posted Speed	Sign Spacing "X"	Long-term Or Intermediate-term Stationary Approach Warning Signs CW20 and CW21 Series		Short-term Stationary Or Short Duration Approach Warning Signs CW21 Series		Other Warning Signs
		Standard inches	Minimum ⁴ inches	Standard inches ⁷	Minimum ⁴ inches ⁷	
30	120	48 x 48	36 x 36	30 x 30 or 36 x 36	24 x 24 or 30 x 30	30 x 30 or 36 x 36
35	160	Use Standard Size	Use Standard Size	Use Standard Size	Use Standard Size	Use Standard Size
40	240					
45	320					
50	400					
55	500 ²	Use Standard Size	Use Standard Size	Use Standard Size	Use Standard Size	Use Standard Size
60	600 ²					
65	700 ²					
70	800 ²	Use Standard Size	Use Standard Size	Use Standard Size	Use Standard Size	Use Standard Size
75	900 ²					
*	*	Use Standard Size		Use Standard Size		Use Standard Size

- * For typical sign spacings on expressways and freeways, see Part VI of the "Texas Manual on Uniform Traffic Control Devices" (TMUTCD) typical application diagrams or TCP Standard Sheets.
- Δ Minimum distance from work area to first Advance Warning sign and/or distance between each additional sign.
- General Notes:
1. Special or larger size signs may be used as necessary.
  2. Distance between signs should be increased as required to have 1500 feet advance warning.
  3. Distance between signs should be increased as required to have 1/2 mile or more advance warning.
  4. For use only on secondary roads or city streets where speeds are low.
  5. Only diamond shaped warning sign sizes are indicated.
  6. See sign size listing in "TMUTCD", Appendix A or the "Standard Highway Sign Design" manual for complete list of available sign design sizes.
  7. Where two sizes are listed, see sign size listing in "TMUTCD", Appendix A or the "Standard Highway Sign Design" manual for proper size.

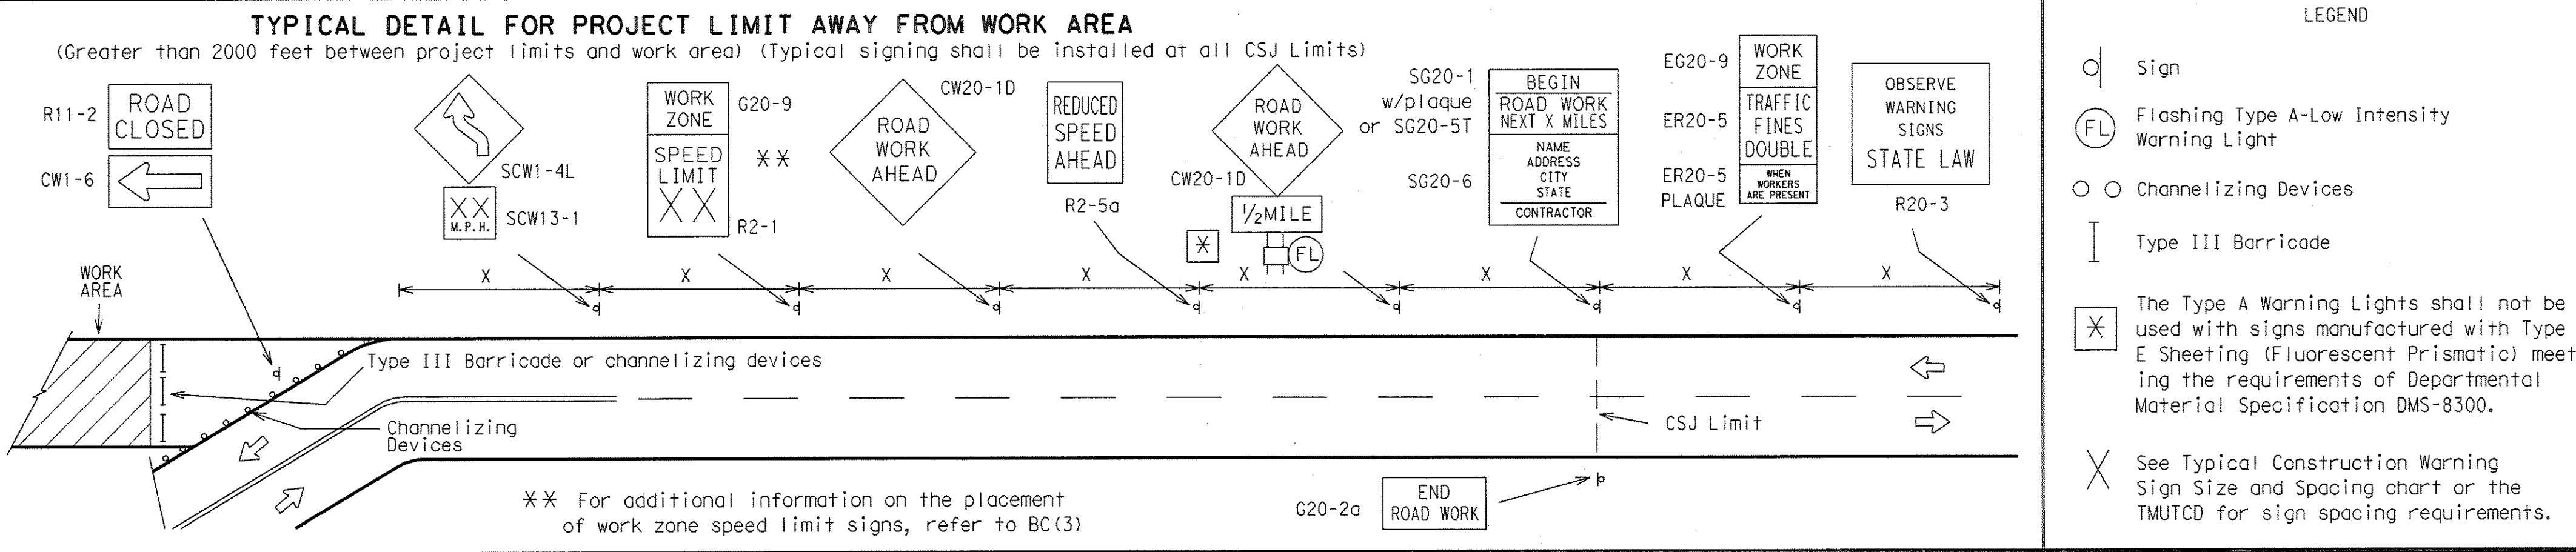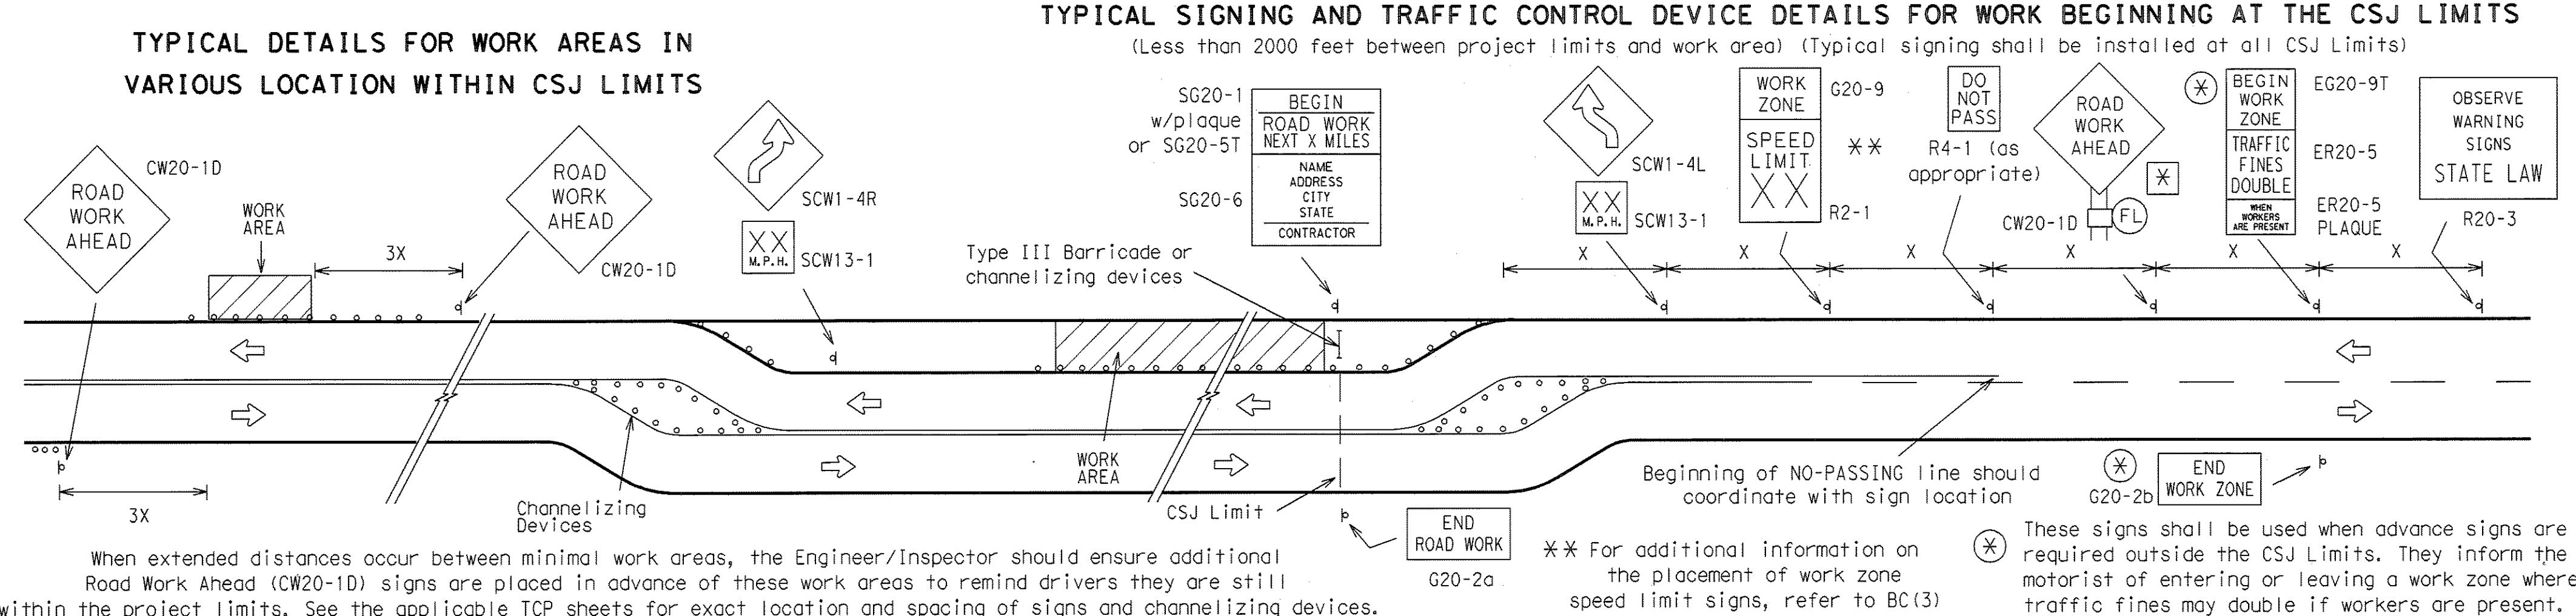

- LEGEND**
- Sign
  - ⓕ Flashing Type A-Low Intensity Warning Light
  - Channelizing Devices
  - ▮ Type III Barricade
  - ✱ The Type A Warning Lights shall not be used with signs manufactured with Type E Sheeting (Fluorescent Prismatic) meeting the requirements of Departmental Material Specification DMS-8300.
  - ✕ See Typical Construction Warning Sign Size and Spacing chart or the TMUTCD for sign spacing requirements.

**Only pre-qualified products shall be used. A copy of the "Compliant Work Zone Traffic Control Devices List" (CWZTCD) describes pre-qualified products and their sources and may be obtained by contacting:**

**Standards Engineer**  
Traffic Operations Division - TE  
Texas Department of Transportation  
125 East 11th Street  
Austin, Texas 78701-2483  
Phone (512) 416-3120  
Fax (512) 416-3299

**RECORD PLANS**  
**MARCH 28, 2008**

**Instructions to locate the "CWZTCD" on TxDOT website are:**

Start at website - [www.dot.state.tx.us](http://www.dot.state.tx.us)  
Click on "About TxDOT",  
Click on "Organizational Chart",  
Click on "Traffic Operations Box",  
Click on "Compliant Work Zone Traffic Control Devices",  
Click on "View PDF".  
This site is printable.

**STANDARD PLANS**  
**TEXAS DEPARTMENT OF TRANSPORTATION**  
Traffic Operations Division

**BARRICADE AND CONSTRUCTION PROJECT LIMIT STANDARD**

**2 of 12** **BC(2)-03**

© TxDOT 11-4-02


REVISIONS	STATE DISTRICT	FEDERAL REGION	FEDERAL AID PROJECT	SHEET
	6			T211
	COUNTY	CONTROL	SECTION	JOB
				HIGHWAY

102

# TYPICAL APPLICATION OF WORK ZONE SPEED LIMIT SIGNS

Work zone speed limits shall be regulatory, established in accordance with the "Procedures for Establishing Speed Zones," and approved by the Texas Transportation Commission.

Reduced speeds should only be posted in the vicinity of work activity and not throughout the entire project.

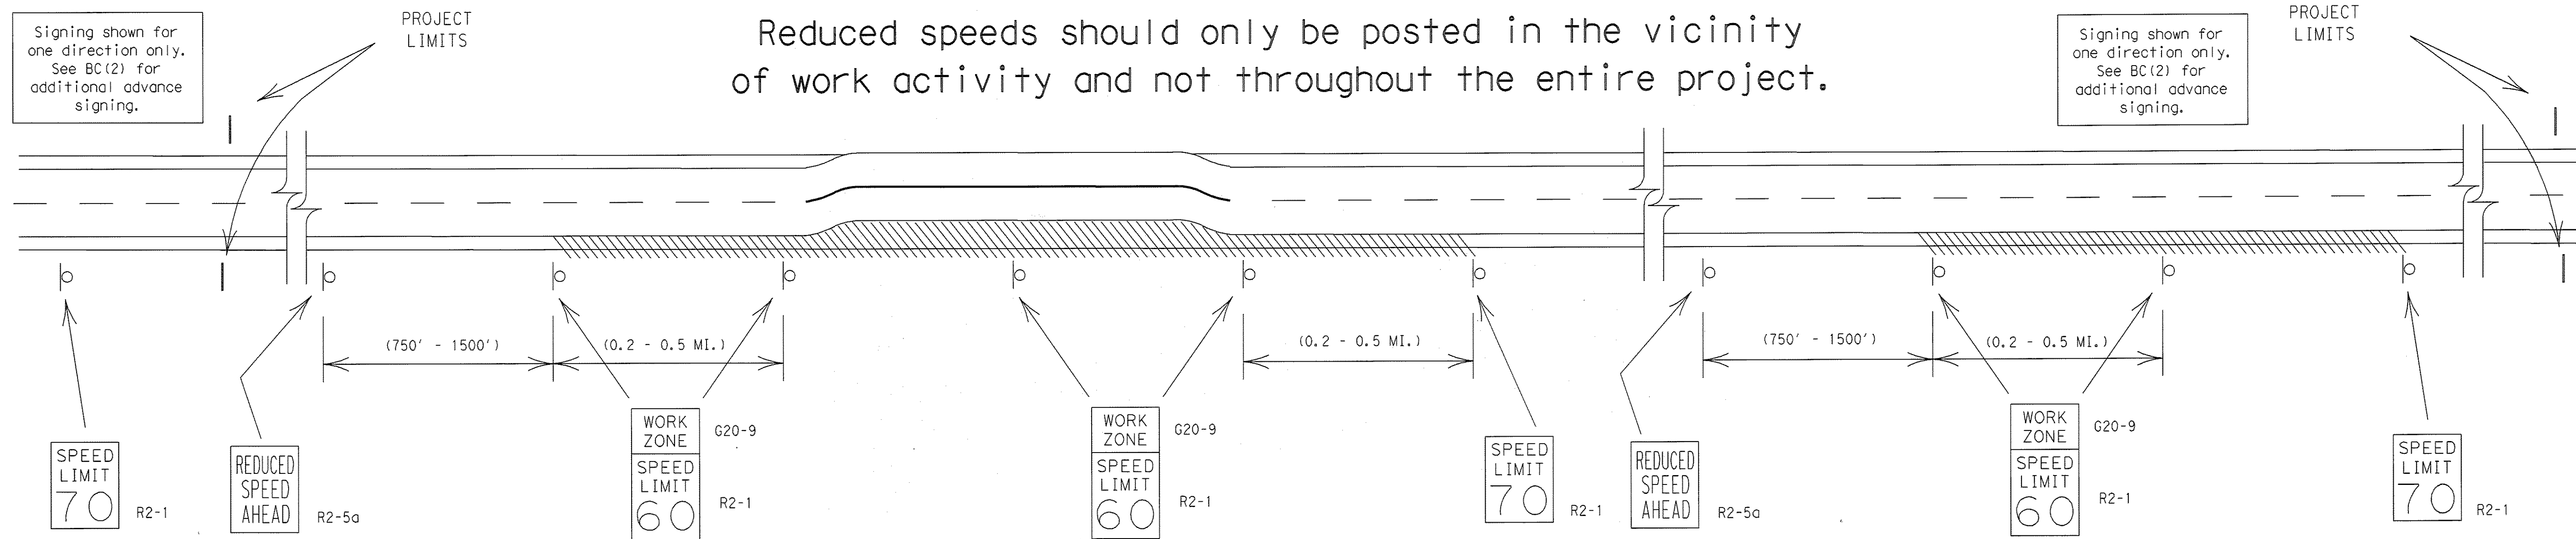

## GUIDANCE FOR USE:

### LONG/INTERMEDIATE TERM WORK ZONE SPEED LIMITS

This type of work zone speed limit should be included on the design of the traffic control plans when restricted geometrics with a lower design speed are present in the work zone and modification of the geometrics to a higher design speed is not feasible.

LONG/INTERMEDIATE TERM WORK ZONE SPEED LIMIT signs should be posted and visible to the motorists at all times. Work activity in the area of reduced speed zone should be greater than 12 consecutive hours per day. Work activity may also be defined as a change in the roadway that requires a reduced speed for motorists to safely negotiate the work area, including:

- rough road or damaged pavement surface
- substantial alteration of roadway geometrics (diversions)
- construction detours
- grade
- width
- other conditions readily apparent to the driver

As long as any of these conditions exist, the work zone speed limit signs should remain in place.

### SHORT TERM WORK ZONE SPEED LIMITS

This type of work zone speed limit should be included on the design of the traffic control plans when workers or equipment are not behind concrete barrier, work activity is within 15 feet of pavement edge or actually on the pavement.

SHORT TERM WORK ZONE SPEED LIMIT signs should be posted and visible to the motorists only when work activity is present. Work activity in the area of reduced speed should be less than 12 consecutive hours. When work activity is not present, signs should be covered with an approved sign cover or removed from work area.

## GENERAL NOTES:

- Regulatory work zone speed limits should be used only for sections of construction projects where speed control is of major importance. Regulatory work zone speed signs (R2-1) should be removed during periods when they are not needed to minimize interference with traffic.
- Regulatory work zone speed limit signs shall be placed on supports at a 7 foot mounting height.
- Speed zone signs are illustrated for one direction of travel and are normally posted for each direction of travel.
- Frequency of speed limit signs should be:
 

40 mph and greater	0.2 to 2 miles
35 mph and less	0.2 to 1 mile
- Regulatory speed limit signs shall have black legend and border on a white reflective background.
- Fabrication, erection and maintenance of REDUCED SPEED AHEAD sign, WORK ZONE plaque and SPEED LIMIT signs shall not be paid for directly, but shall be considered subsidiary to Item 502.
- Turning signs from view, laying signs over or down will not be allowed, unless otherwise noted.
- Techniques that may help reduce traffic speeds. (In order of effectiveness.)
  - Flagger stationed next to sign.
  - Law enforcement.
  - Portable changeable message sign (PCMS).
  - Low-power radar transmitter.
- Refer to "Work Zone Speed Limit Work Sheets 1 and 2" to determine when a construction speed zone should be required.

DISCLAIMER: This standard is governed by the "Texas Engineering Practice Act". No warranty of any kind is made by TxDOT for any purpose whatsoever. TxDOT assumes no responsibility for the conversion of this standard to other formats or for incorrect results or damages resulting from its use.


ACC:

LEVELS DISPLAYED:  
 1 2 3 4 5 6 7 8 9 10 11 12 13 14 15 16  
 17 18 19 20 21 22 23 24 25 26 27 28 29 30 31 32  
 33 34 35 36 37 38 39 40 41 42 43 44 45 46 47 48  
 49 50 51 52 53 54 55 56 57 58 59 60 61 62 63

RECORD PLANS  
 MARCH 28, 2008

STANDARD PLANS Texas Department of Transportation Traffic Operations Division	
<b>BARRICADE AND CONSTRUCTION WORK ZONE SPEED LIMIT STANDARD</b>	
3 of 12	BC(3)-03
© TxDOT 11-4-02	
REVISED	DATE
6	11-4-02
STATE DISTRICT	FEDERAL PROJECT
6	
COUNTY	CONTROL SECTION JOB
SHEET <b>T212</b>	


TYPICAL MINIMUM CLEARANCES FOR LONG TERM AND INTERMEDIATE TERM SIGNS

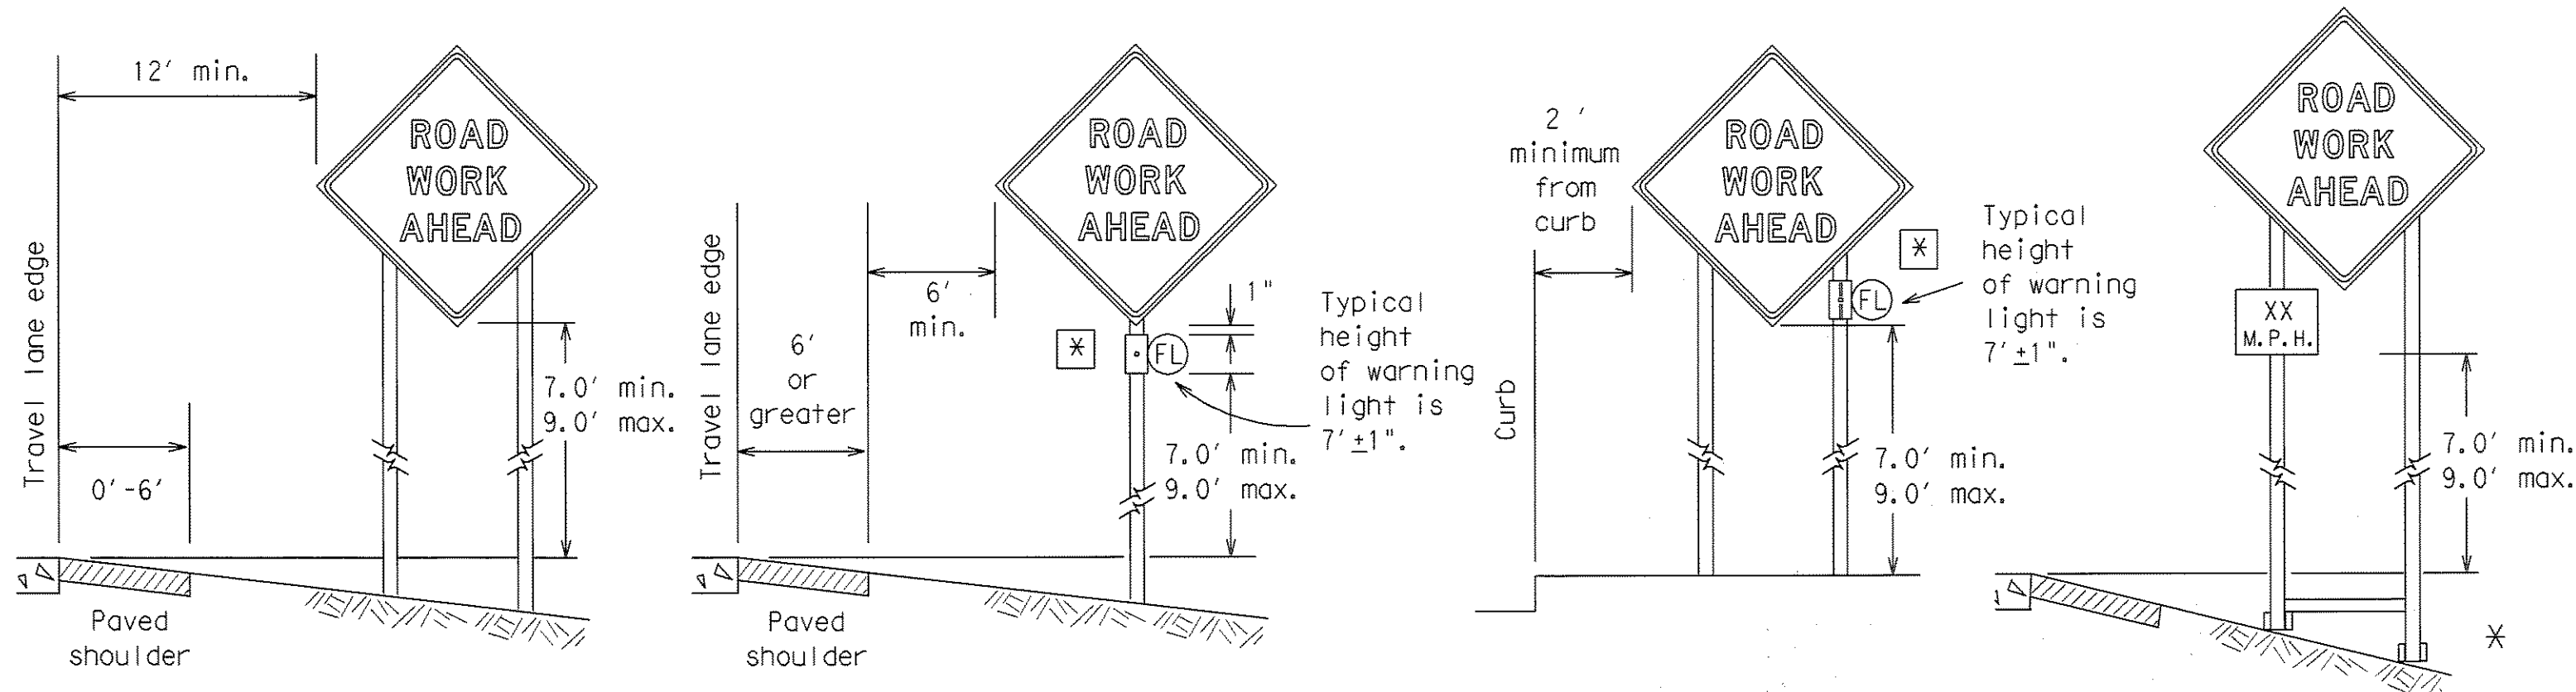

It is the intent of these plans to provide positive guidance to motorists throughout the project limits by the use of signs, pavement markings, delineation and/or channelizing devices. All traffic control devices shall conform with the "Texas Manual on Uniform Traffic Control Devices for Streets and Highways" (TMUTCD) and the "Compliant Work Zone Traffic Control Devices List" list (CWZTCD).

* When placing skid supports on unlevel ground, the leg post lengths must be adjusted so the sign appears straight and plumb. Objects shall NOT be placed under skids as a means of leveling.

ATTACHMENT FOR WOODEN SIGN SUPPORTS

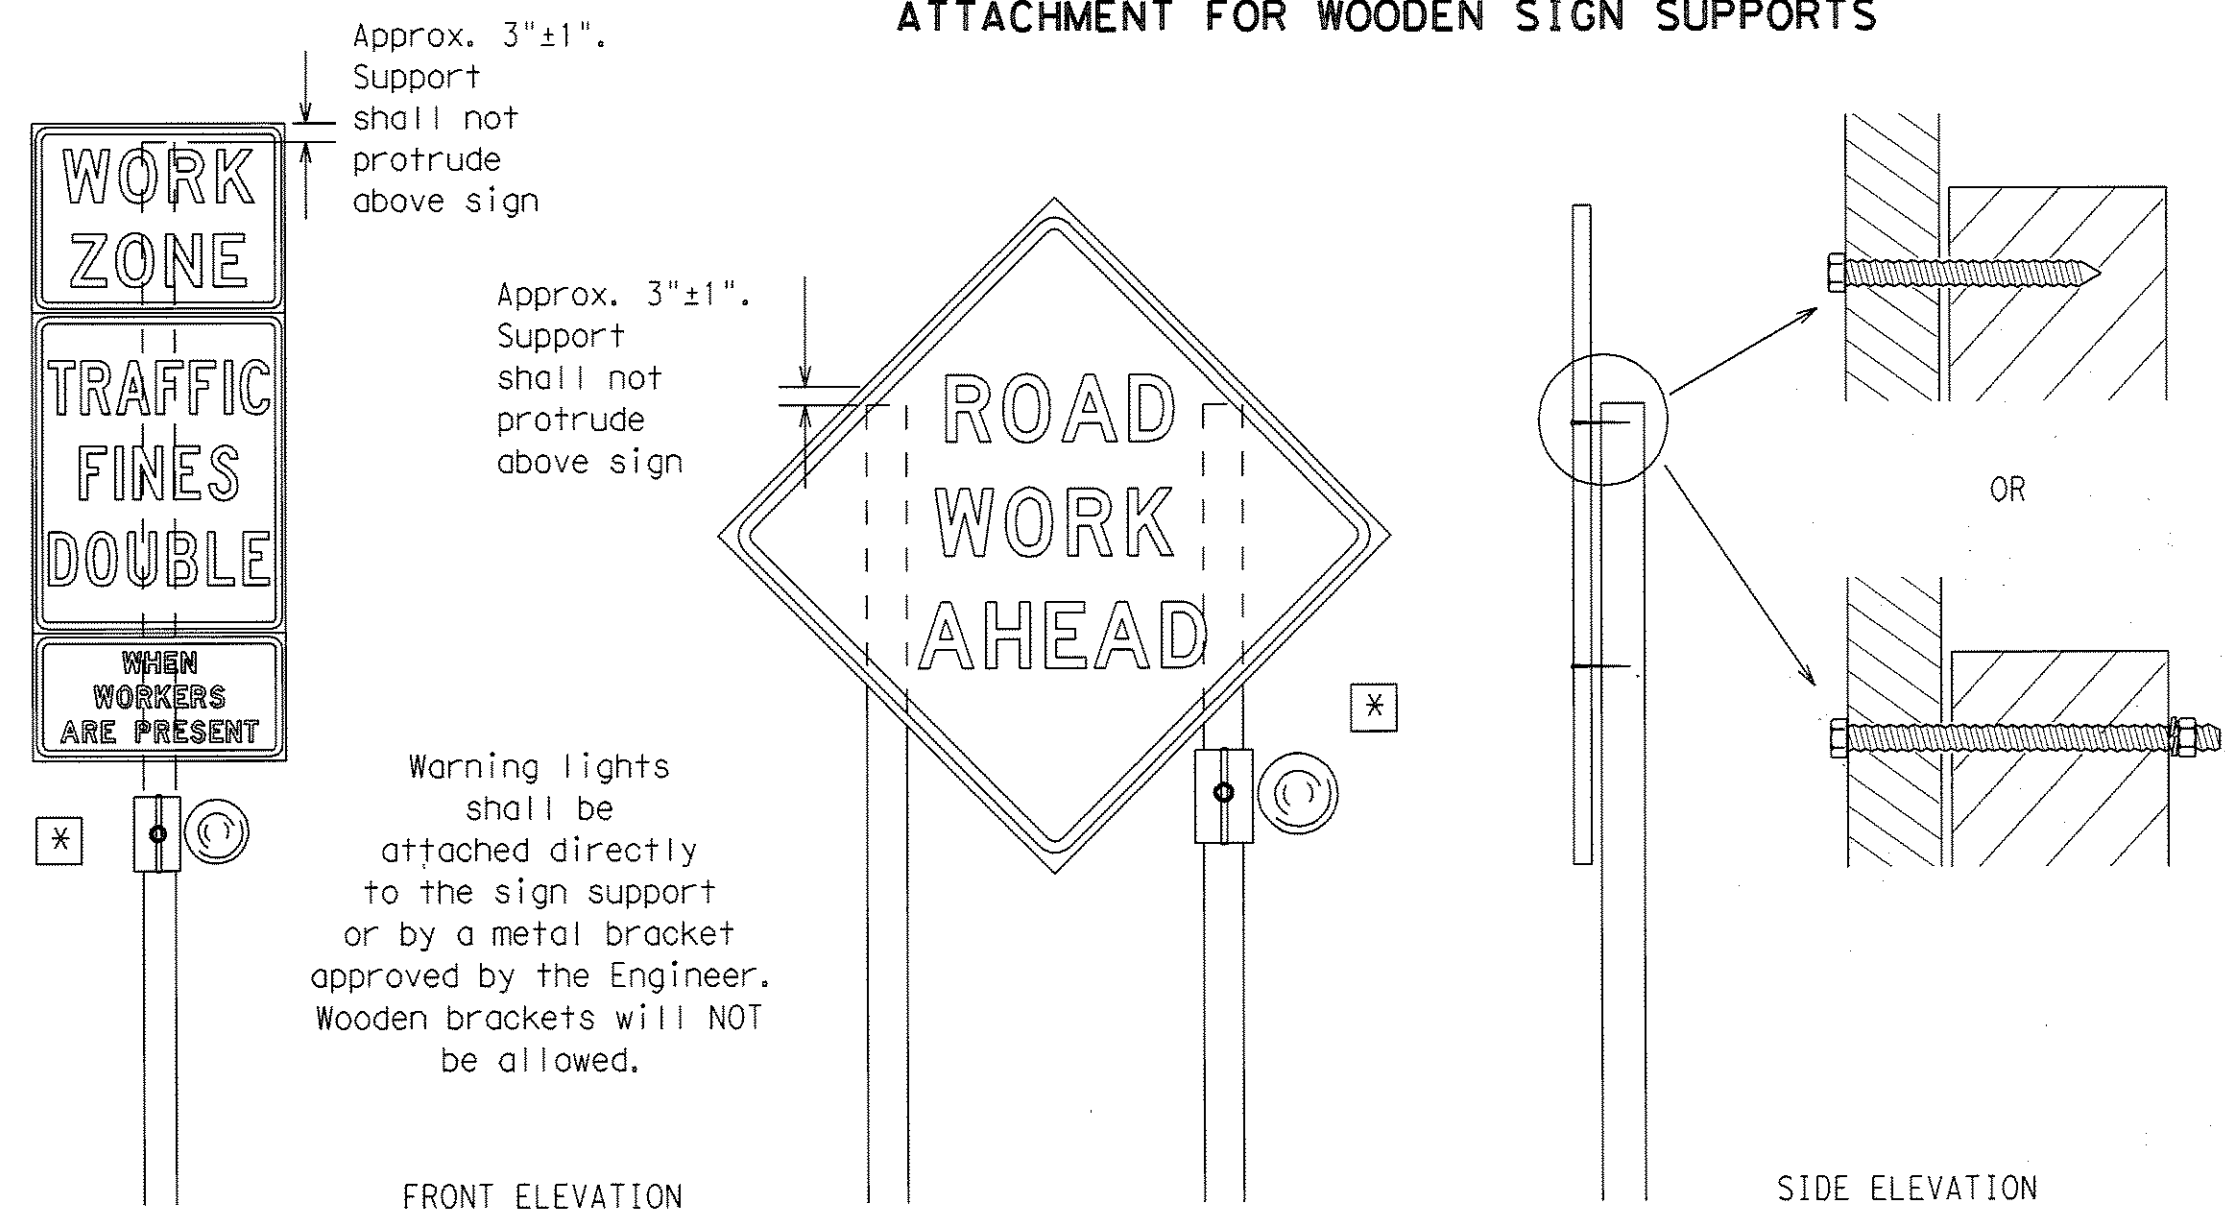

Attachment to wooden supports will be by bolts and nuts or screws. Use TxDOT's or manufacturer's recommended procedures for attaching sign substrates to other types of sign supports

Nails will NOT be allowed.

Each sign shall be attached directly to the sign support. Multiple signs shall not be joined or spliced by any means. Supports shall not be extended or repaired by splicing or other means.

GENERAL NOTES FOR WORK ZONE SIGNS

- Contractor shall install and maintain signs in a straight and plumb condition and/or as directed by the Engineer.
  - Wooden sign posts shall be painted white.
  - Barricades shall NOT be used as sign supports.
  - Nails shall NOT be used to attach signs to any support.
  - All signs shall be installed in accordance with the plans or as directed by the Engineer. Signs shall be used to regulate, warn, and guide the traveling public safely through the work zone.
  - The Contractor may furnish either the sign design shown in the plans or in the "Standard Highway Sign Designs for Texas" (SHSD). The Engineer/Inspector may require the Contractor to furnish other work zone signs that are shown in the TMUTCD but may have been omitted from the plans. Any variation in the plans shall be documented by written agreement between the Engineer and the Contractor's Responsible Person. All changes must be documented in writing before being implemented. This can include documenting the changes in the Inspector's TxDOT diary and having both the Inspector and Contractor initial and date the agreed upon changes. The additional signs requested by the Engineer/Inspector shall not be subsidiary.
  - The Contractor shall furnish sign supports listed in the "Compliant Work Zone Traffic Control Device List" (CWZTCD). The Contractor shall install the sign support in accordance with the manufacturer's recommendations. If there is a question regarding installation procedures, the Contractor shall furnish the Engineer a copy of the manufacturer's installation recommendations so that the Engineer can verify the correct procedures are being followed.
  - The contractor is responsible for sign installations and replacing signs with damaged or cracked substrates and/or damaged or marred reflective sheeting as directed by the Engineer/Inspector.
  - Identification markings may be shown only on the back of the sign substrate. The maximum height of letters and/or company logos used for identification shall be 1".
  - The Contractor shall replace damaged wood posts. New or damaged wood sign posts shall not be spliced.
- Duration of Work (as defined by the "Texas Manual on Uniform Traffic Control Devices" Part VI)**
- The types of sign supports, the size of signs, and the type of sign substrates can vary based on the type of work being performed. The Engineer is responsible for selecting the appropriate size sign for the type of work being performed. The Contractor is responsible for ensuring that the sign support and substrate meets crashworthiness and length of work requirements.
  - Long-term stationary - work that occupies a location more than 3 days.
  - Intermediate-term stationary - work that occupies a location from overnight to 3 days.
  - Short-term stationary - daytime work that occupies a location from 1 to 12 hours.
  - Short, duration - work that occupies a location up to 1 hour.
  - Mobile - work that moves intermittently or continuously. Does not stop for more than 15 minutes at a time.

SIGN MOUNTING HEIGHT

- The bottom of Long-term/Intermediate-term signs shall be at least 7 feet, but not more than 9 feet, above the paved surface.
- The bottom of Short-term/Short Duration signs shall be a minimum of 1 foot above the pavement surface but no more than 2 feet above the ground.
- Long-term/Intermediate-term Signs may be used in lieu of Short-term/Short Duration signing.
- Short-term/Short Duration signs shall be used only during daylight and shall be removed at the end of the workday.
- Regulatory signs shall be mounted at least 7 feet, but not more than 9.0 feet, above the paved surface regardless of work duration.

SIZE OF SIGNS

- The Engineer may allow the use of smaller size construction warning signs on secondary roads or city streets where speeds are low if the sign size is listed as an option on the "Typical Construction Warning Sign Size and Spacing" chart shown on BC(2).
- The Contractor shall furnish the sign sizes shown in plans, the BC Sheets, the TCP sheets or as directed by the Engineer.

SIGN SUBSTRATES

- The Contractor shall ensure that the sign substrate is allowed for the type of sign support that is being used. The CWZTCD lists each substrate that can be used on the different types and models of sign supports.
- "Mesh" type materials are NOT an approved sign substrate.
- All wooden individual sign panels fabricated from 2 or more pieces shall have one or more plywood cleat, 1/2" thick by 6" wide, fastened to the back of the sign and extending fully across the sign. The cleat shall be attached to the back of the sign using wood screws that do not penetrate the face of the sign panel. The screws shall be placed on both sides of the splice and spaced at 6" centers. The Engineer may approve other methods of splicing the sign faces.

REFLECTIVE SHEETING

- Reflectorized signs shall be constructed of sheeting meeting the color and retro-reflectivity requirements of DMS-8300 or DMS-8310. The DMS specifications can be accessed from the following web address:  
[http://manuals.dot.state.tx.us:80/dynaweb/colmates/@Generic__CollectionView;cs=default;ts=default](http://manuals.dot.state.tx.us:80/dynaweb/colmates/@Generic__CollectionView;cs=default;ts=default)
- White sheeting, meeting the requirements of DMS-8300 Type C (High Specific Intensity), shall be used for signs with white background and channelizing devices.
- Orange sheeting, meeting the requirements of DMS-8300 Type E (Fluorescent Prismatic), shall be used for signs with orange backgrounds.

SIGN LETTERS

- All sign letters and numbers shall be clear, and open rounded type uppercase alphabet letters as approved by the Federal Highway Administration (FHWA) and as published in the "Standard Highway Sign Design for Texas" manual. Signs, letters and numbers shall be of first class workmanship in accordance with Department Standards and Specifications.

REMOVING OR COVERING

- When sign messages may be confusing or do not apply, the signs shall be removed or completely covered.
- Long-term stationary or intermediate stationary signs installed on square metal tubing may be turned away from traffic 90 degrees when the sign message is not applicable. This type of sign support meets the crashworthiness standards regardless of the direction of impact. This technique may not be used for signs installed in the median of divided highways or near any intersections where the sign may be seen from approaching traffic.
- Signs installed on skids shall not be turned at 90 degree angles to the roadway. These signs should be removed or completely covered when not required.
- When signs are covered, the material used shall be opaque, such as heavy mil black plastic.
- Burlap shall NOT be used to cover signs.
- Duct tape or other adhesive material NOT be affixed to a sign face. These materials can damage the retroreflectivity of sign sheeting.
- Signs shall be removed upon completion of the work.

SIGN SUPPORT WEIGHTS

- Where sign supports require the use of weights to keep from turning over, the use of sandbags with dry, cohesionless sand is recommended.
- The sandbags will be tied shut to keep the sand from spilling and to maintain a constant weight.
- Rock, concrete, iron, steel or other solid objects will not be permitted for use as sign support weights.
- Sandbags should weigh a minimum of 35 lbs and a maximum of 50 lbs.
- Sandbags shall be made of a durable material that tears upon vehicular impact.
- Rubber (such as tire inner tubes) shall NOT be used for sandbags.
- Rubber ballasts (such as those used with cones or edgeline channelizers) shall NOT be used as sign support weights.
- Sandbags shall only be placed along or laid over the base supports of the traffic control device and shall not be suspended above ground level or hung with rope, wire, chains or other fasteners. Sandbags shall be placed along the length of the skids to weigh down the sign support.
- Sandbags shall NOT be placed under the skid and shall not be used to level sign supports placed on slopes.

Only pre-qualified products shall be used. A copy of the "Compliant Work Zone Traffic Control Devices List" (CWZTCD) describes pre-qualified products and their sources and may be obtained by contacting:

**Standards Engineer**  
Traffic Operations Division - TE  
Texas Department of Transportation  
125 East 11th Street  
Austin, Texas 78701-2483  
Phone (512) 416-3120  
Fax (512) 416-3299

Instructions to locate the "CWZTCD" on TxDOT website are:

Start at **website - [www.dot.state.tx.us](http://www.dot.state.tx.us)**  
Click on "About TxDOT",  
Click on "Organizational Chart",  
Click on "Traffic Operations Box",  
Click on "Compliant Work Zone Traffic Control Devices",  
Click on "View PDF".  
This site is printable.

CONTRACTOR REQUIREMENTS FOR MAINTAINING PERMANENT SIGNS WITHIN THE PROJECT LIMITS

- Permanent signs are used to give notice of traffic laws or regulations, call attention to conditions that are potentially hazardous to traffic operations, show route designations, destinations, directions, distances, services, points of interest, and other geographical, recreational, or cultural information. Drivers proceeding through a work zone need the same, if not better route guidance as normally installed on a roadway without construction.
- When permanent regulatory or warning signs conflict with work zone conditions, remove or cover the permanent signs until the permanent sign message matches the roadway condition.
- When existing permanent signs are moved and relocated due to construction purposes, they shall be visible to motorists at all times.
- If existing signs are to be relocated on their original supports, they shall be installed on crashworthy bases as shown on the SMD Standard sheets. The signs shall meet the required mounting heights shown on the BC Sheets or the SMD Standards. This work should be paid for under the appropriate pay item for relocating existing signs.
- If permanent signs are to be removed and relocated using temporary supports, the Contractor shall use crashworthy supports as shown on the BC sheets or the CWZTCD. The signs shall meet the required mounting heights shown on the BC Sheets or the SMD Standards during construction. This work should be paid for under the appropriate pay item for relocating existing signs.
- Any sign or traffic control device that is struck or damaged by the Contractor or his/her construction equipment shall be replaced as soon as possible by the Contractor to ensure proper guidance for the motorists. This will be subsidiary to Item 502.

(FL) Flashing Type A - Low Intensity Warning Light

(X) The Type A Warning lights shall not be used with Type E Sheeting (Fluorescent Prismatic) meeting the requirements of DMS-8300.

RECORD PLANS  
MARCH 28, 2008

STANDARD PLANS  
Texas Department of Transportation  
Traffic Operations Division

BARRICADE AND CONSTRUCTION  
TEMPORARY SIGN NOTES  
STANDARD

4 of 12 BC(4)-03


REVISIONS	STATE DISTRICT	FEDERAL REGION	FEDERAL AID PROJECT	SHEET
	6			T213
	COUNTY	CONTROL SECTION	JOB	HIGHWAY

ACC: 1 1 2 3 4 5 6 7 8 9 10 11 12 13 14 15 16 17 18 19 20 21 22 23 24 25 26 27 28 29 30 31 32 33 34 35 36 37 38 39 40 41 42 43 44 45 46 47 48 49 50 51 52 53 54 55 56 57 58 59 60 61 62 63


DISCLAIMER  
This standard is governed by the "Texas Engineering Practice Act". No warranty of any kind is made by TxDOT for any purpose whatsoever. TxDOT assumes no responsibility for incorrect results or damages resulting from its use.

## EXAMPLES OF SKID MOUNTED SIGN SUPPORTS


### LONG/INTERMEDIATE TERM STATIONARY - PORTABLE SKID MOUNTED SIGN SUPPORTS □

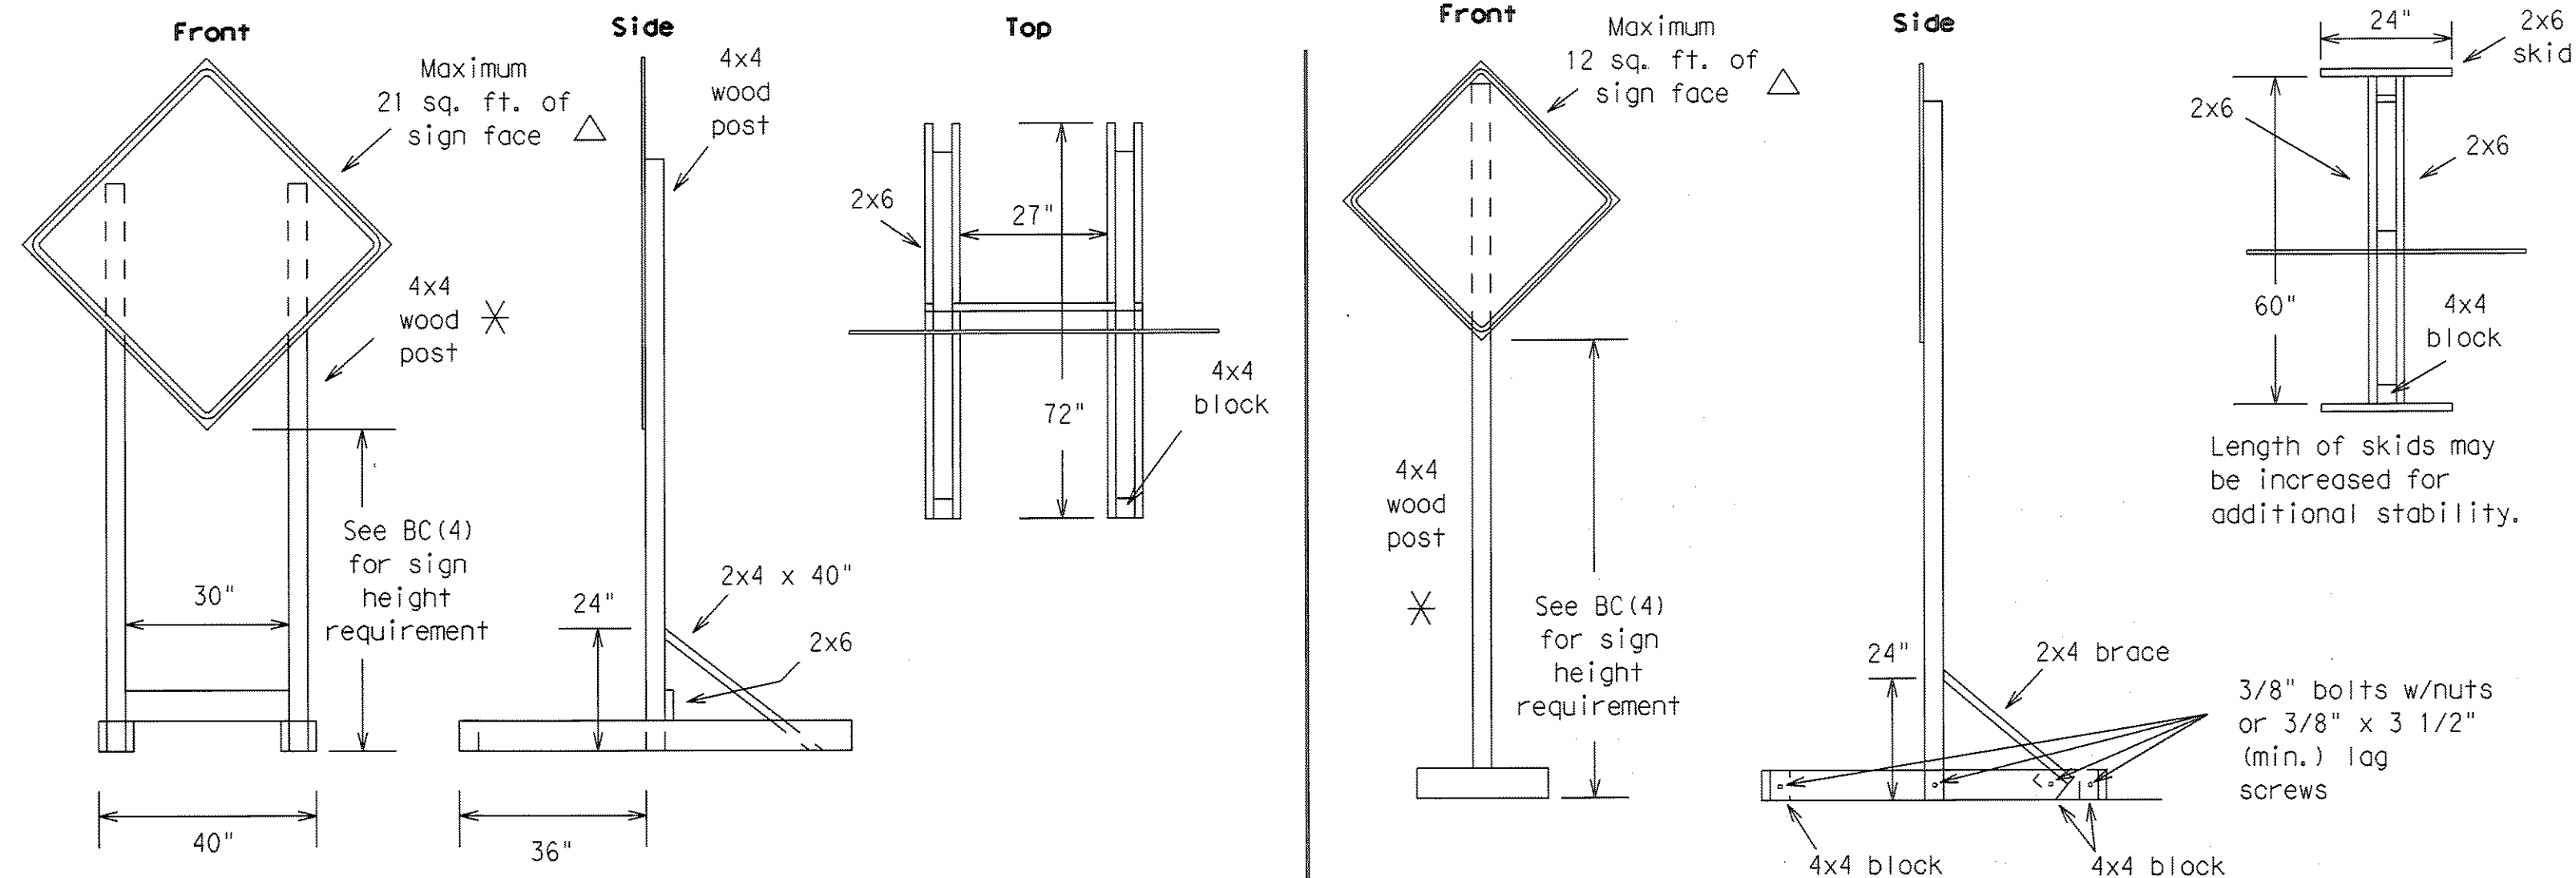

### SHORT TERM STATIONARY/SHORT DURATION - PORTABLE SIGN SUPPORTS □

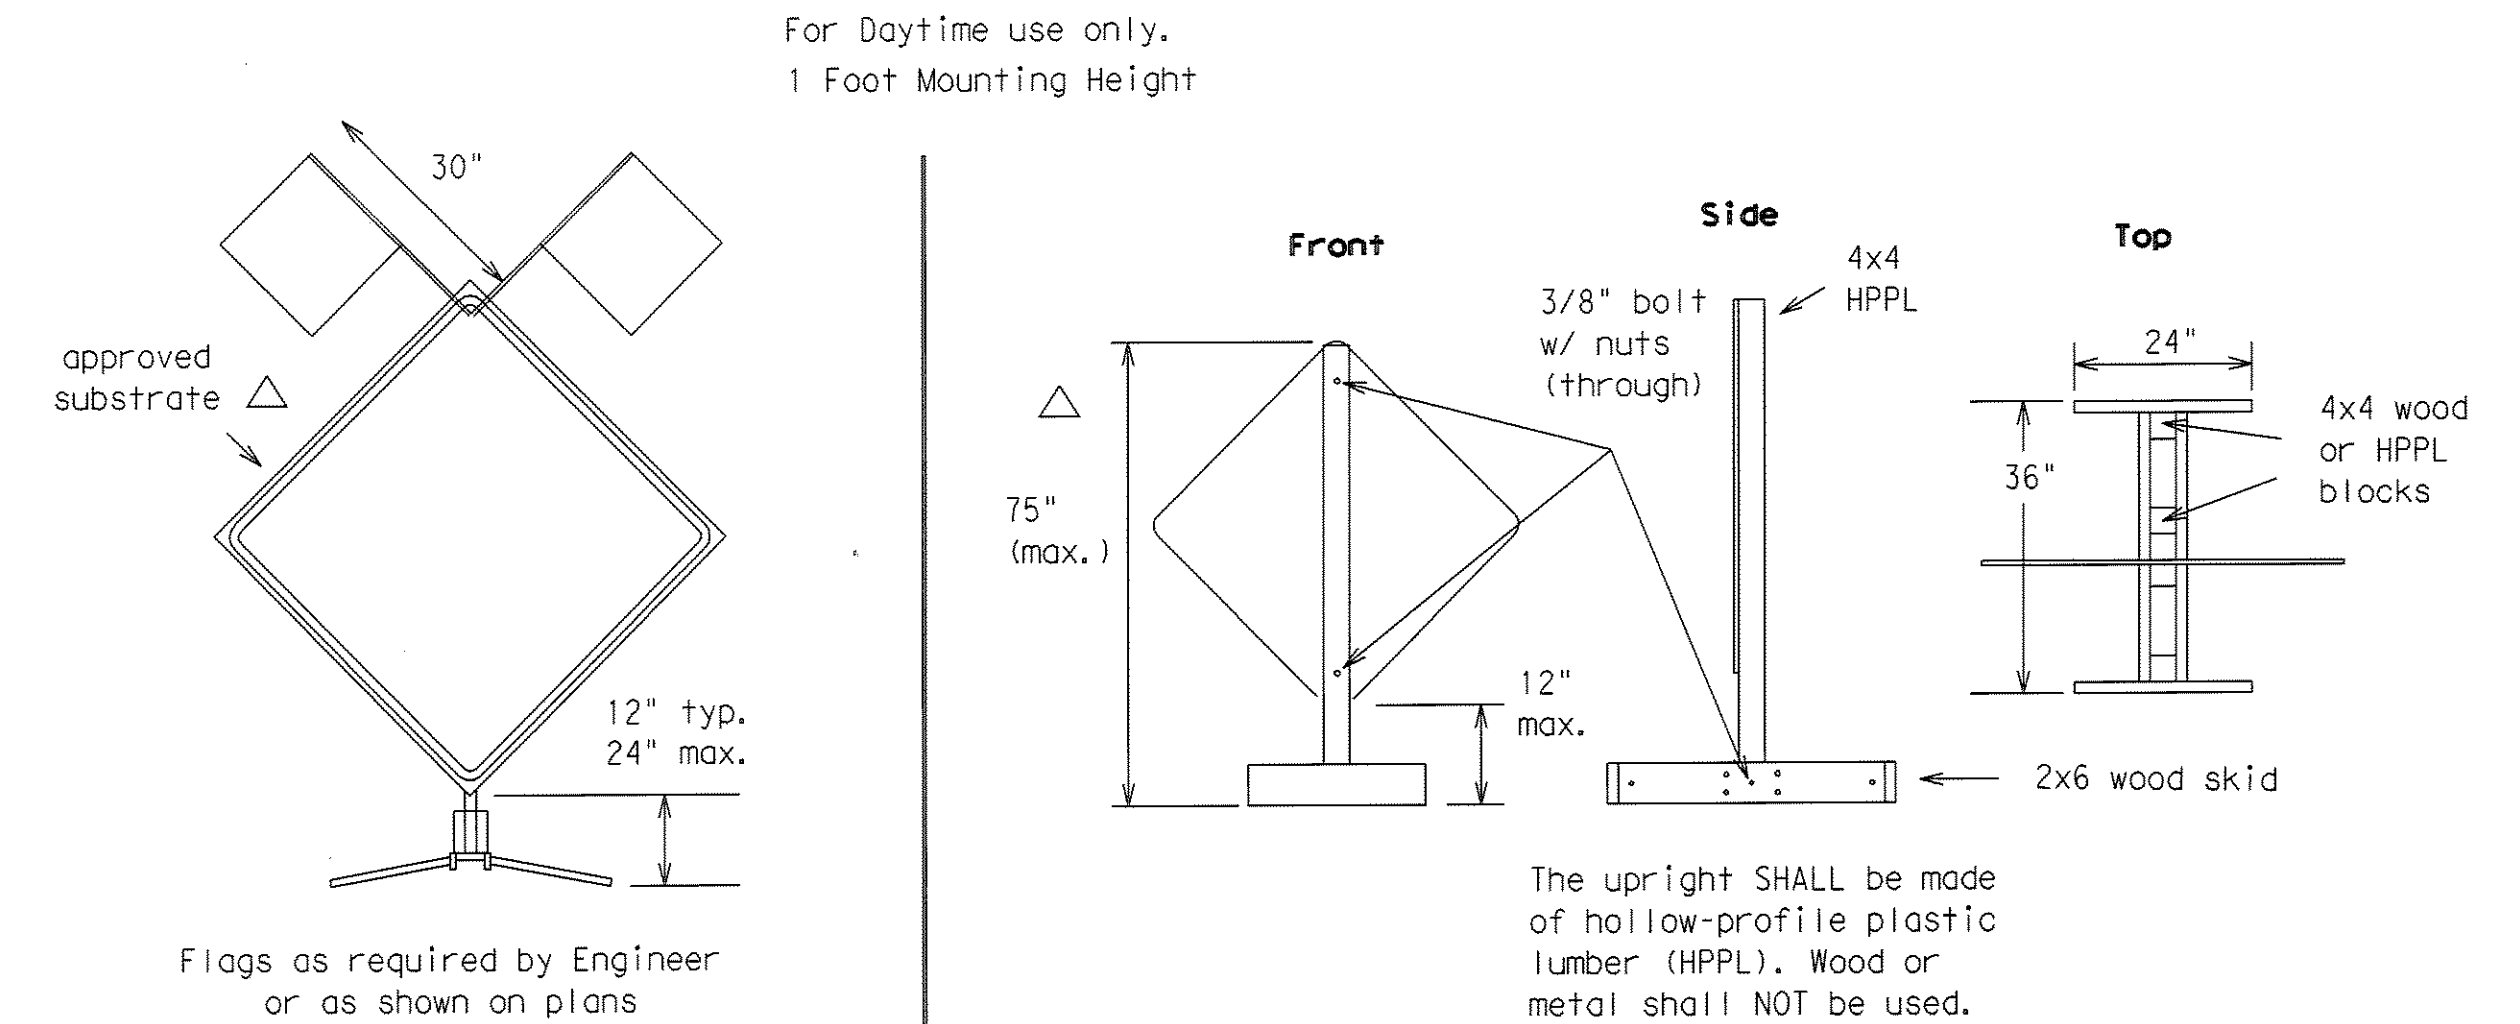


## EXAMPLES OF GROUND MOUNTED SIGN SUPPORTS

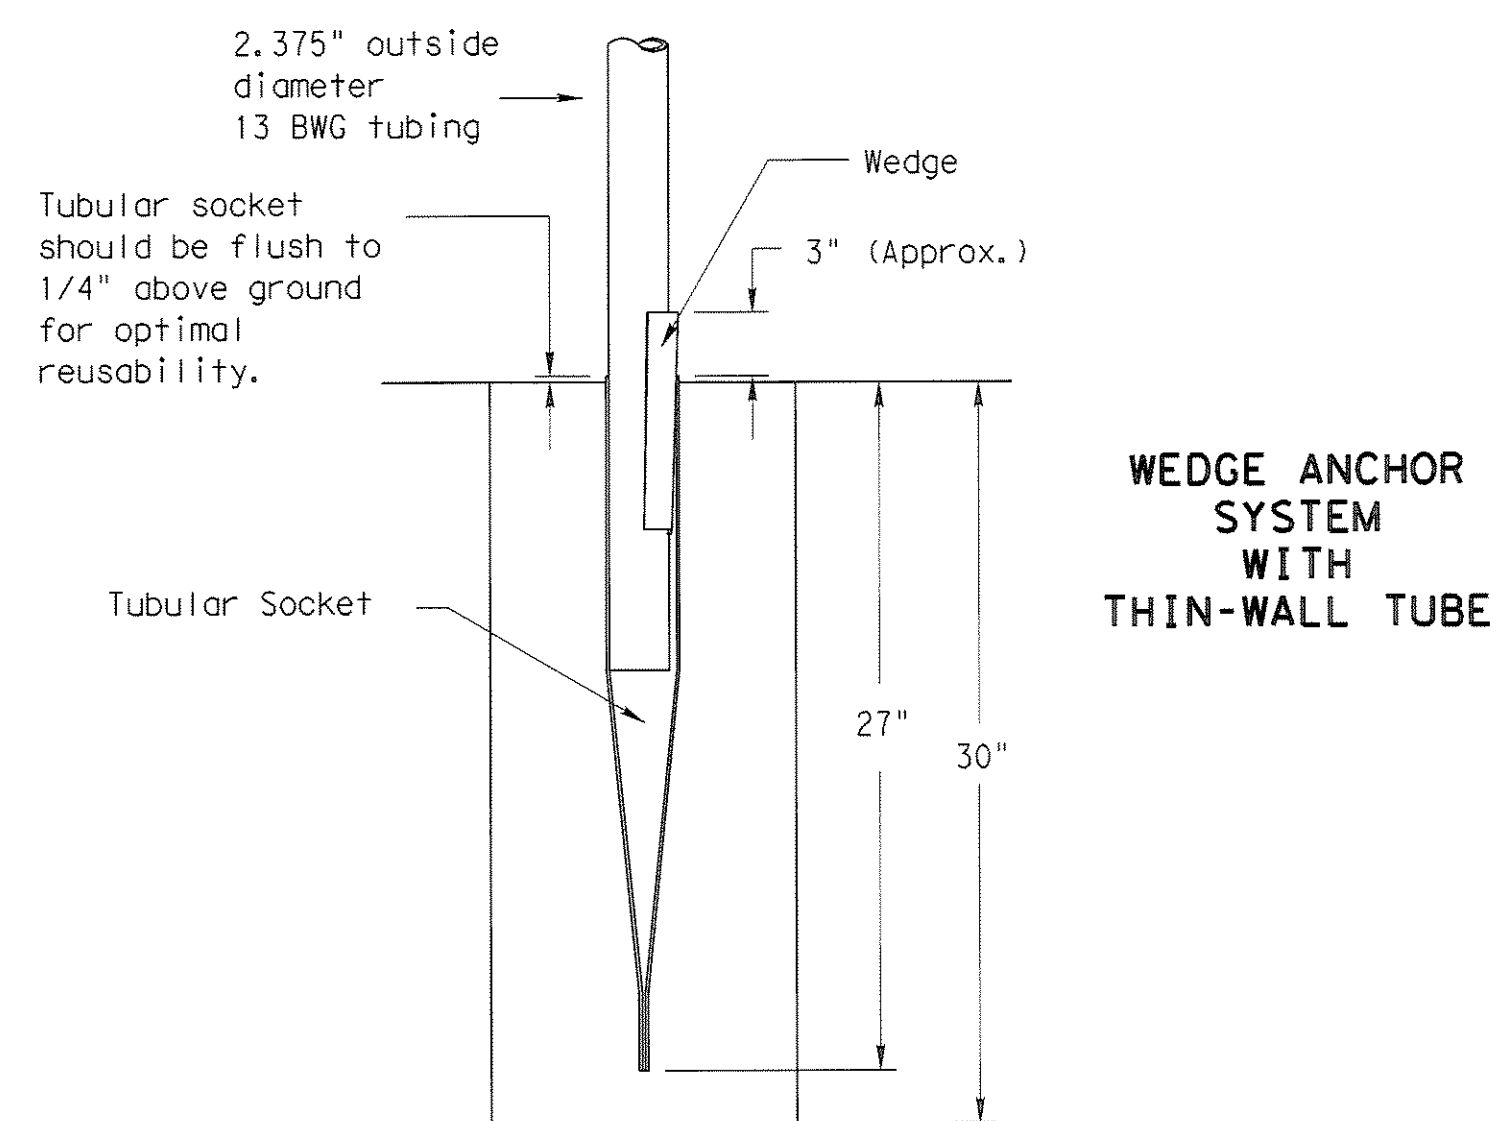


**WEDGE ANCHOR SYSTEM WITH THIN-WALL TUBE**

**WING CHANNEL**  
Lap-splice/base bolted anchor

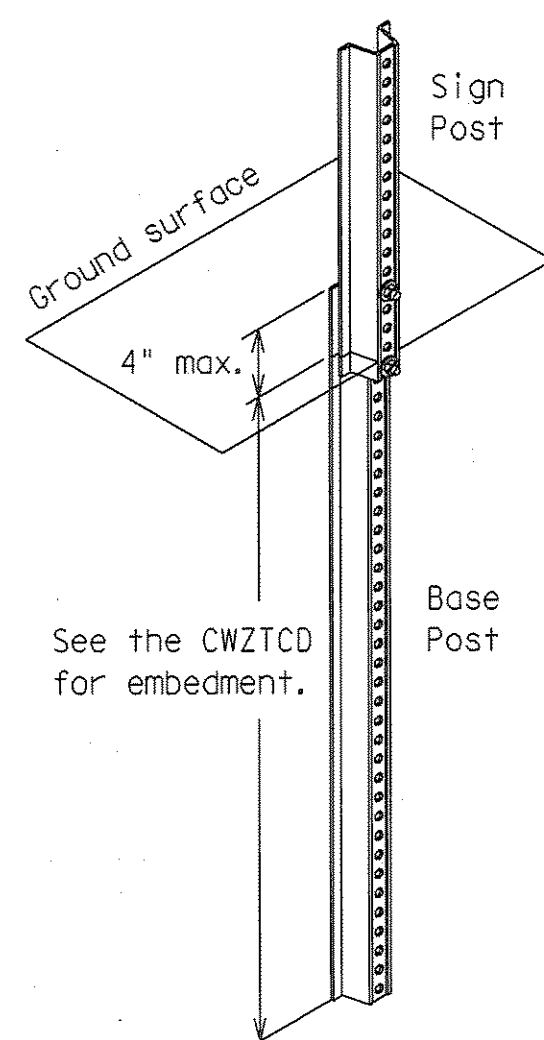


**PERFORATED SQUARE METAL TUBING**  
With Anchor

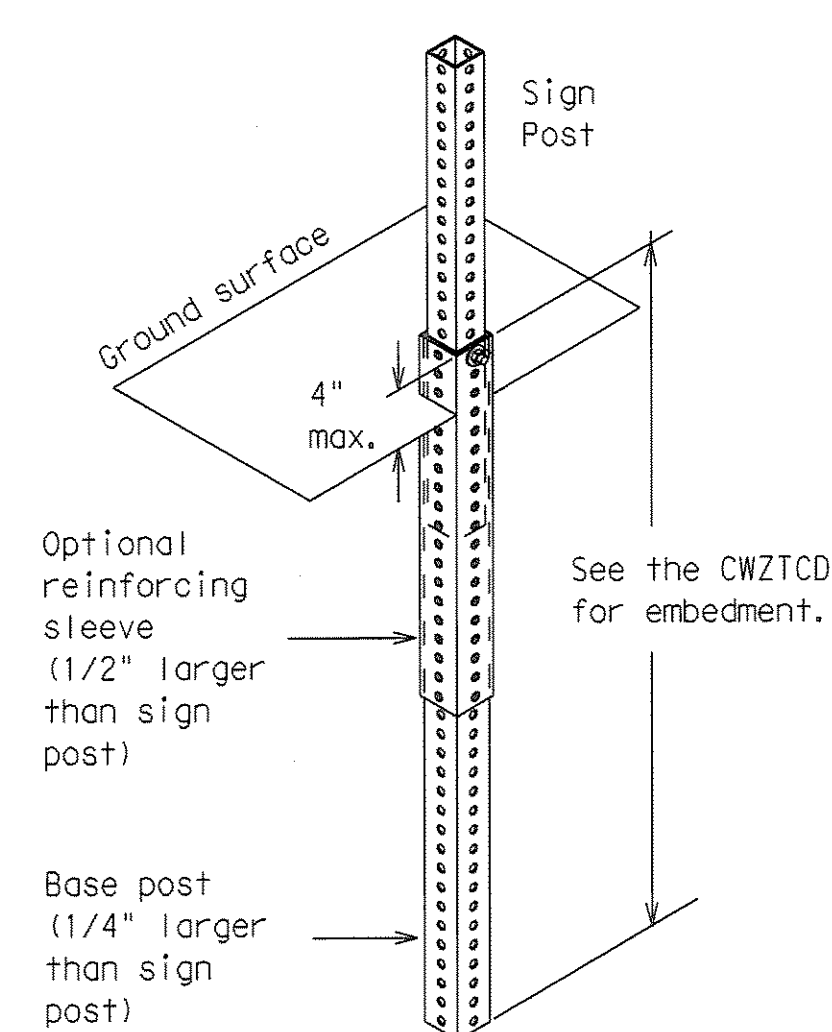

Refer to the CWZTCD and the manufacturer's installation procedure for each type sign support.  
The maximum sign square footage shall adhere to the manufacturer's recommendation. Two post installations can be used for larger signs.

**WOOD POST SYSTEM FOR GROUND MOUNTED SIGN SUPPORTS**

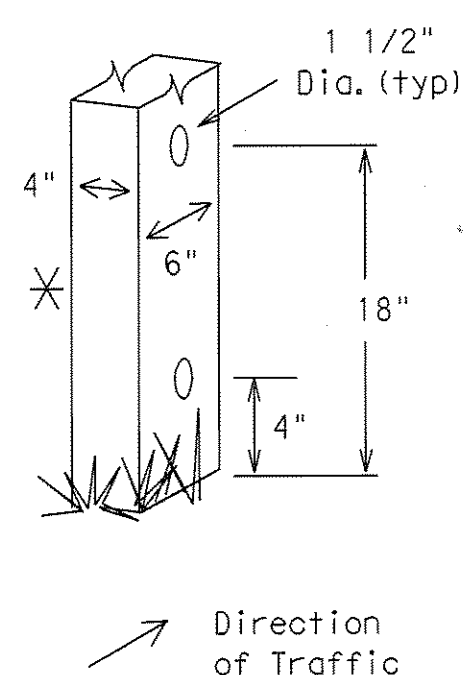

Nominal Post Size	No. of Posts	Maximum Sq. feet of Sign Face	Minimum Soil Embedment	Drilled Hole(s) Required
4 x 4	1	12	36"	NO
4 x 4	2	21	36"	NO
4 x 6	1	21	36"	YES
4 x 6	2	36	36"	YES

No more than 2 sign posts shall be mounted within a 7 ft. circle.

When project is completed, all sign supports and foundations shall be removed from the project site. This will be considered subsidiary to Item 502.

□ See BC(4) for definition of "Work Duration."

✕ Sign posts MUST be one piece. Splicing will NOT be allowed. Posts shall be painted white.

△ See the CWZTCD for the type of sign substrate that can be used for each approved sign support.

Only pre-qualified products shall be used. A copy of the "Compliant Work Zone Traffic Control Devices List" (CWZTCD) describes pre-qualified products and their sources and may be obtained by contacting:

**Standards Engineer**  
Traffic Operations Division - TE  
Texas Department of Transportation  
125 East 11th Street  
Austin, Texas 78701-2483  
Phone (512) 416-3120  
Fax (512) 416-3299

Instructions to locate the "CWZTCD" on TxDOT website are:

Start at website - [www.dot.state.tx.us](http://www.dot.state.tx.us)  
Click on "About TxDOT",  
Click on "Organizational Chart",  
Click on Traffic Operations Box,  
Click on "Compliant Work Zone Traffic Control Devices",  
Click on "View PDF".  
This site is printable.

**RECORD PLANS**  
**MARCH 28, 2008**

**STANDARD PLANS**  
**Texas Department of Transportation**  
*Traffic Operations Division*

**BARRICADE AND CONSTRUCTION**  
**TYPICAL SIGN SUPPORT**  
**STANDARD**

**5 of 12** **BC(5) -03**

© TxDOT 11-4-02	DIR - JWT	CHK - GRB	DR - FON	CHK - CAL
REVISIONS	STATE DISTRICT	FEDERAL REGION	FEDERAL AID PROJECT	SHEET
	6			<b>T214</b>
	COUNTY	CONTROL	SECTION	JOB
				HIGHWAY

DISCLAIMER  
The use of this standard is governed by the "Texas Engineering Practice Act". No warranty of any kind is made by TxDOT for any purpose whatsoever. TxDOT assumes no responsibility for the conversion of this standard to other formats or for incorrect results or damages resulting from its use.

LEVELS DISPLAYED  
ACC:



## PORTABLE CHANGEABLE MESSAGE SIGNS


- The Engineer/Inspector shall approve all messages used on portable changeable message signs (PCMS).
- PCMS placed on the shoulder or within the R-0-W, but are not behind a concrete traffic barrier shall have a minimum of four plastic drums placed perpendicular to traffic, on the upstream side of the PCMS.
- Messages on PCMS should contain no more than 8 words (four to eight characters per word), not including simple words such as "TO," "FOR," "AT," etc.
- Messages should consist of a single phase, or two phases that alternate. Three-phase messages are not allowed.
- Each phase of the message should convey a single thought.
- Use the word "EXIT" to refer to an exit ramp on a freeway; i.e., "EXIT CLOSED." Do not use the term "RAMP."
- Always use the route or interstate designation (IH, US, SH, FM) along with the number when referring to a roadway.
- Specify the actual days of the week; e.g., TUES THROUGH FRI or TUES-FRI in the coming week that work activity will occur.
- The message term "WEEKEND" should be used only if the work is to start on Saturday morning and end by Sunday evening at midnight. Actual days and hours of work should be displayed on the PCMS if work is to begin on Friday evening and/or continue into Monday morning.
- The Engineer/Inspector may select one of two options which are available for displaying a two-phase message on a PCMS. Each phase may be displayed for either four seconds each or for two seconds each.
- Do not "flash" messages or words included in a message. The message should be steady burn or continuous while displayed.
- Do not present redundant information on a two-phase message; i.e., keeping two lines of the message the same and changing the third line.
- Do not use the words "Danger" or "Caution" in message.
- Do not display the message "LANES SHIFT LEFT" or "LANES SHIFT RIGHT" on a PCMS. Drivers do not understand the message.
- Do not display messages that scroll horizontally or vertically across the face of the sign.
- The following table lists abbreviated words and two-word phrases that are acceptable for use on a PCMS. Both words in a phrase must be displayed together. Words or phrases not on this list should not be abbreviated.

Word or Phrase	Abbreviation	Word or Phrase	Abbreviation
Access Road	ACCES RD	Miles	MI
Air Quality	AIR QLTY	Miles Per Hour	MPH
Avenue	AVE	Time Minutes	Time MIN
Best Route	BEST RTE	Monday	MON
Boulevard	BLVD	Normal	NORM
Bridge	BRDG	North	N
Cannot	CANT	Parking	PKING
Center	CNTR	Parking Lot	PRK LOT
Construction Ahead	CONST AHEAD	Road	RD
Detour Route	DETOUR RTE	Right Lane	RGT LN
East	E	Saturday	SAT
Emergency	EMER	Service Road	SERV RD
Emergency Vehicle	EMER VEH	Shoulder	SHLDR
Entrance, Enter	ENT	Slippery	SLIP
Express Lanes	EXP LANE	South	S
Expressway	EXPWY	Speed	SPD
Distance Feet	Distance FT	Street	ST
Fog Ahead	FOG AHD	Sunday	SUN
Freeway	FRWY, FWY	Telephone	PHONE
Freeway Blocked	FWY BLKD	Thursday	THURS
Friday	FRI	To Downtown	TO DWNTN
Hazardous Driving	HAZ DRIVING	Traffic	TRAF
Highway	HWY	Travelers	TRVLRS
Hours	HR	Tuesday	TUES
Information	INFO	Turnpike	Name TRNPK
Left	LFT	Upper Level	UPPR LVL
Left Lane	LFT LN	Warning	WARN
Lane Closed	LN CLSD	Wednesday	WED
Lower Level	LOWR LVL	Weight Limit	WT LIMIT
Maintenance	MAINT	Wet Pavement	WET PVMT
Roadway designation #	IH-number, US-number, SH-number, FM-number	West	W


WHEN NOT IN USE, REMOVE THE PCMS FROM THE RIGHT-OF-WAY OR PLACE THE PCMS BEHIND CONCRETE TRAFFIC BARRIER.

## TYPICAL FLASHING ARROW PANEL

- The Flashing Arrow Panel should be used for all lane closures on multi-lane roadways, or slow moving maintenance or construction activities on the travel lanes.
- Flashing Arrow Panels should not be used on two-lane, two-way roadways, detours, diversions or work on shoulders unless the "CAUTION" display (see detail below) is used.
- The Engineer/Inspector shall choose all appropriate signs, barricades and/or other traffic control devices that should be used in conjunction with the Flashing Arrow Panel.
- The Flashing Arrow Panel should be able to display the following symbols:

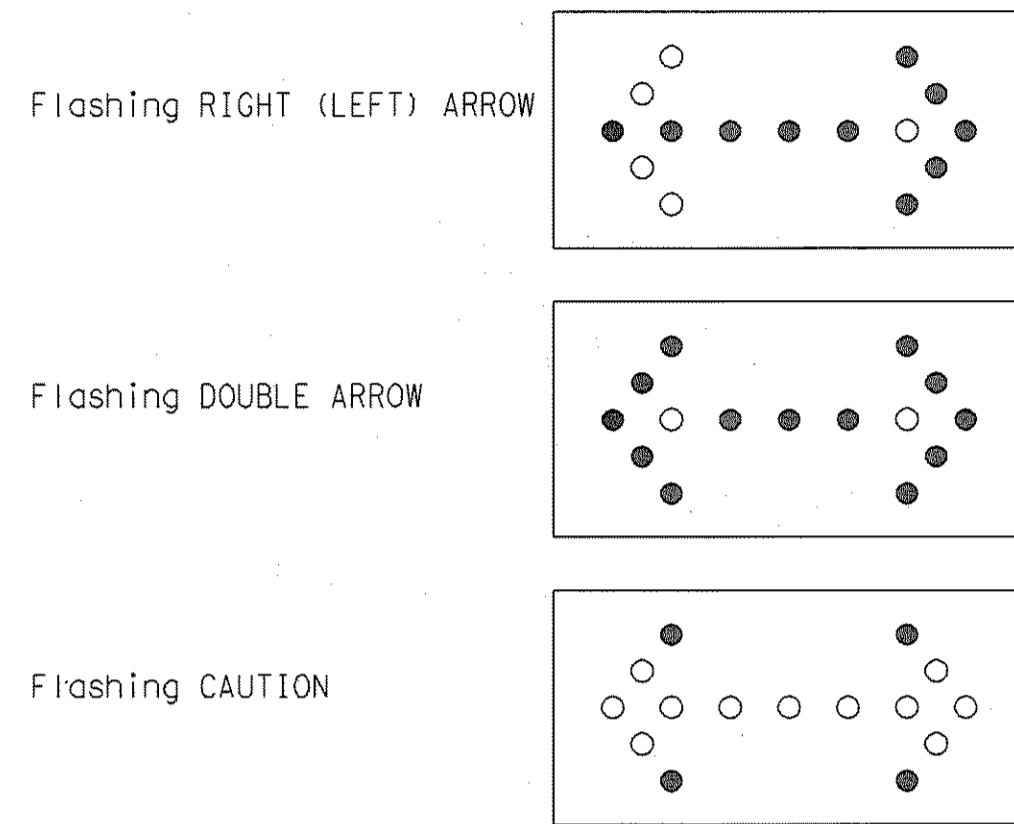

- The "CAUTION" display consists of four corner lamps flashing simultaneously.
- The straight line caution display is NOT ALLOWED.
- The Flashing Arrow Panel shall be capable of minimum 50 percent dimming from rated lamp voltage. The flashing rate of the lamps shall not be less than 25 nor more than 40 flashes per minute.
- Minimum lamp "on time" shall be approximately 50 percent for the flashing arrow and equal intervals of 25 percent for each sequential phase of the flashing chevron.
- The sequential arrow display is NOT ALLOWED.
- The flashing arrow display is the TxDOT standard; however, the sequential Chevron display may be used during daylight operations.

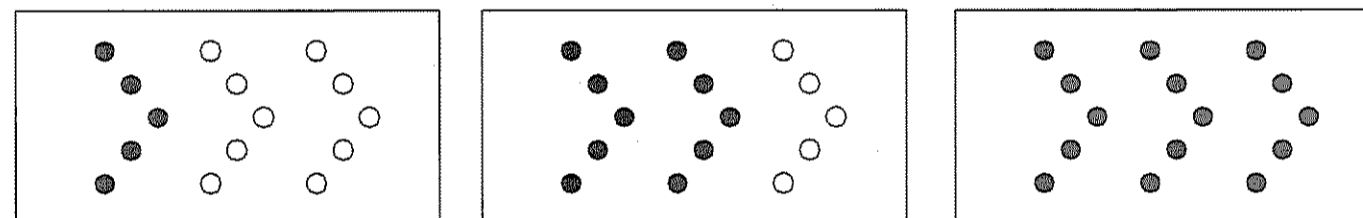

- The Flashing Arrow Panel shall be mounted on a vehicle, trailer or other suitable support.
- A Flashing Arrow Panel SHOULD NOT BE USED to laterally shift all lanes of traffic on a multi-lane roadway at once.

REQUIREMENTS			
TYPE	MINIMUM SIZE	MINIMUM NUMBER OF PANEL LAMPS	MINIMUM VISIBILITY DISTANCE
B	30 x 60	13	3/4 mile
C	48 x 96	15	1 mile

**ATTENTION:** Flashing Arrow Panels shall be equipped with automatic dimming devices.

WHEN NOT IN USE, REMOVE THE ARROW PANEL FROM THE RIGHT-OF-WAY OR PLACE THE ARROW PANEL BEHIND CONCRETE TRAFFIC BARRIER.


### TRUCK-MOUNTED ATTENUATORS

- Truck-mounted attenuators (TMA) used on TxDOT facilities must meet the requirements outlined in the National Cooperative Highway Research Report No. 350 (NCHRP 350).
- Refer to the CWZTCD for the requirements of Level 2 or Level 3 TMAs.
- Refer to the dates shown in the CWZTCD to ensure that the TMA meets the age requirements and the crashworthiness criteria established by the Federal Highway Administration (FHWA) for TMAs.
- Refer to the CWZTCD for a list of approved TMAs.
- TMAs are required on freeways unless otherwise noted in the plans.
- A TMA should be used anytime that it can be positioned approximately 100 feet or less in advance of the area of crew exposure without adversely affecting the work performance.
- The only reason a TMA should not be required is when a work area is spread down the roadway and the work crew is an extended distance from the TMA.

## TYPE C DELINEATORS FOR CONCRETE TRAFFIC BARRIER AND ATTENUATORS


- Type C Delineators shall be prequalified, and conform to the color and reflectivity requirements of DMS-8600. A list of prequalified Type C Delineators can be found at the following Web site: [ftp://ftp.dot.state.tx.us/pub/txdot-info/gsd/pdf/dms8600preq.pdf](http://ftp.dot.state.tx.us/pub/txdot-info/gsd/pdf/dms8600preq.pdf).
- Color of delineators shall be as specified in the "Texas Manual on Uniform Traffic Control Devices" (TMUTCD). The cost of the Type C Delineators shall be considered subsidiary to Item 502.

### CONCRETE TRAFFIC BARRIER (CTB)

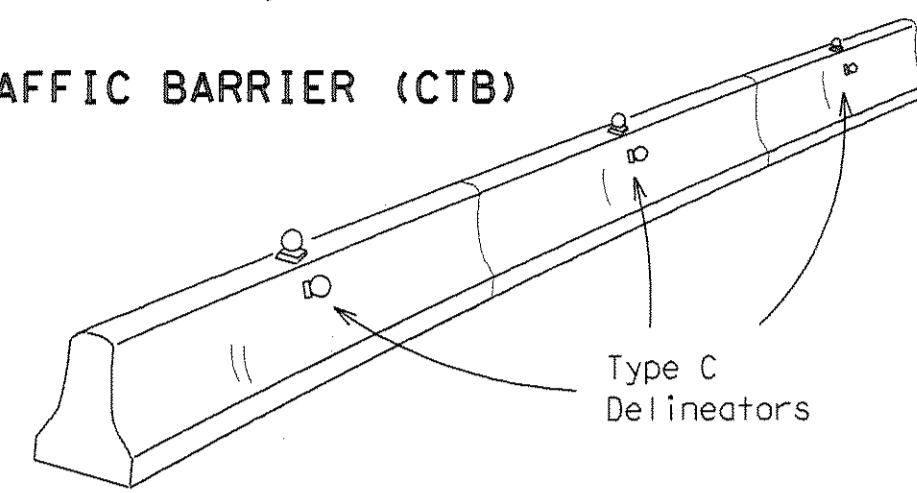


- Two (2) Type C Delineators should be mounted on each section of CTB in approximately the midsection of the CTB. The Type C Delineator on the side of the CTB shall be installed directly below the Type C Delineator mounted on top of the CTB.
- Maximum spacing of Type C Delineators is 40 feet.
- Pavement markers or temporary flexible-reflective roadway marker tabs shall NOT be used as CTB delineation.
- Attach Type C Delineators on CTB as per manufacturer's recommendations.
- Missing or damaged Type C Delineators shall be replaced as directed by the Engineer.

### LOW PROFILE CONCRETE BARRIER (LPCB)

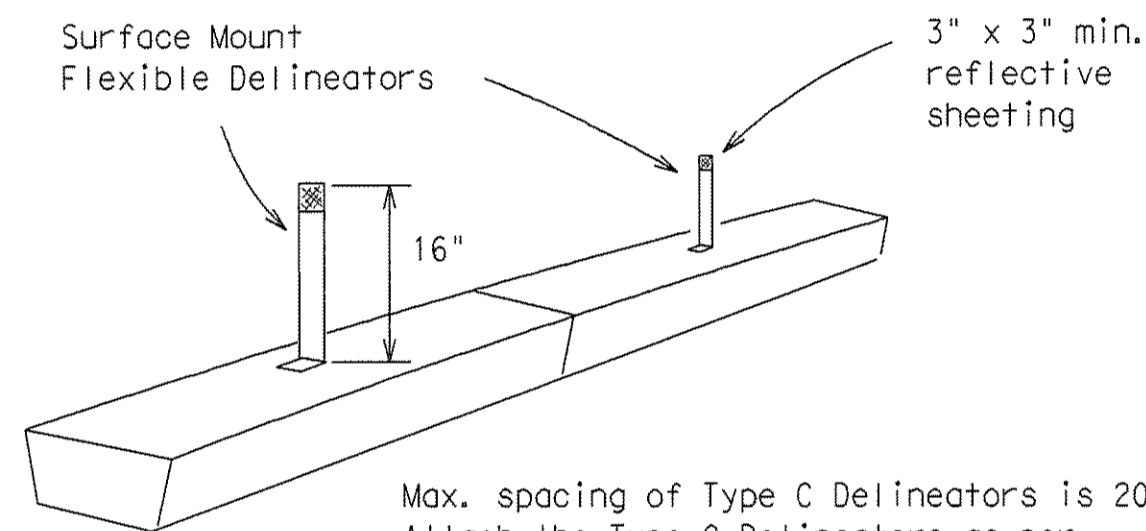

Max. spacing of Type C Delineators is 20 feet. Attach the Type C Delineators as per manufacturer's recommendations.

### DELINEATION OF END TREATMENTS

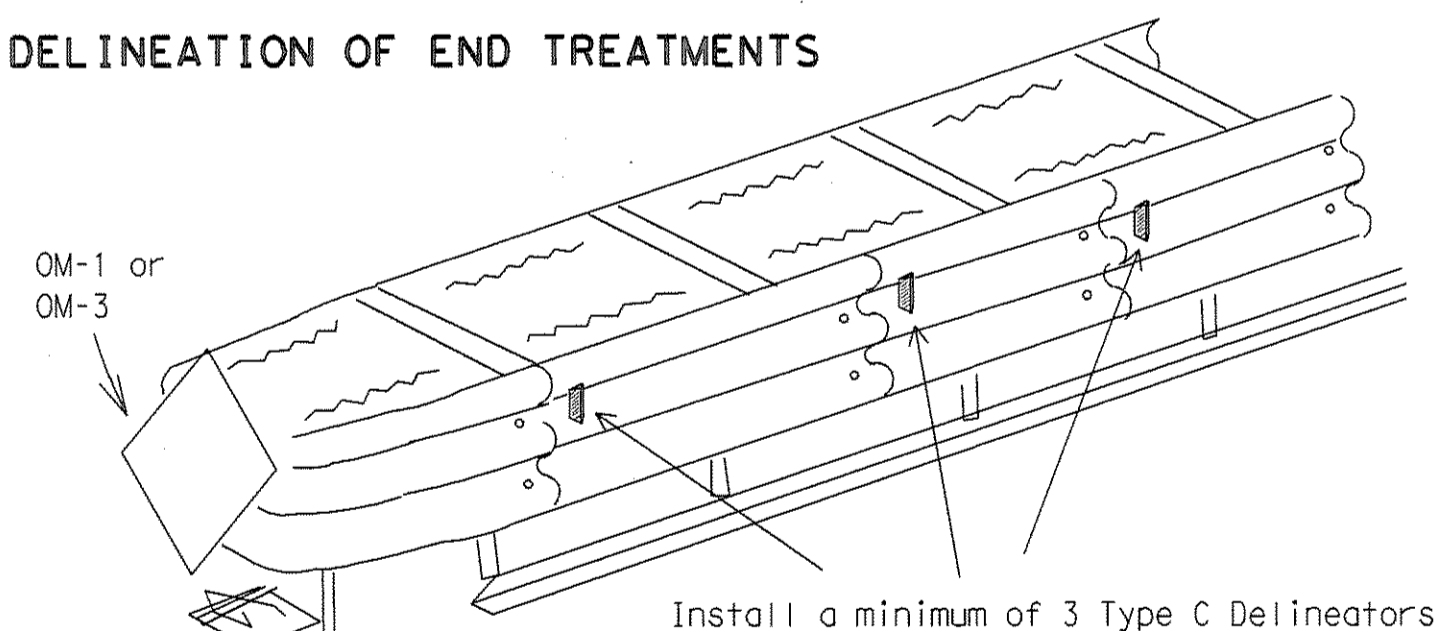

DELINEATION	APPROACHING TRAFFIC	
	BOTH SIDES	ONE SIDE
OM-1		OM-3 or Vertical Panel

Attach the Type C Delineators as per manufacturer's recommendations.

## WARNING LIGHTS

- Warning lights shall meet the requirements of the TMUTCD.
- Warning lights shall NOT be installed on barricades.
- Type A-Low Intensity Flashing Warning Lights are commonly used with signs. They are intended to warn of an approaching potentially hazardous area. Their use shall be as indicated on this sheet and/or other sheets of the plans by the designation "FL". The Type A Warning Lights shall not be used with signs manufactured with Type E Sheeting (Fluorescent Prismatic) meeting the requirements of Departmental Material Specification DMS-8300.
- Type-C Steady Burn Lights are intended to be used in a series for delineation to supplement other traffic control devices. Their use shall be as indicated on this sheet and/or other sheets of the plans by the designation "SB".
- The Engineer/Inspector or the plans shall specify the location and type of warning lights to be installed on the traffic control devices.
- When required by the Engineer, the Contractor shall furnish a copy of the warning lights certification. The warning light manufacturer will certify the warning lights meet the requirements of the latest ITE Purchase Specifications for Flashing and Steady-Burn Warning Lights.

## END TREATMENTS FOR CTB'S USED IN WORK ZONES

End treatments used on CTB's in work zones shall meet crashworthy standards as defined in the National Cooperative Highway Research Report 350. Refer to the CWZTCD List for approved end treatments and manufacturers.

**Only pre-qualified products shall be used. A copy of the "Compliant Work Zone Traffic Control Devices List" (CWZTCD) describes pre-qualified products and their sources and may be obtained by contacting:**

Standards Engineer  
Traffic Operations Division - TE  
Texas Department of Transportation  
125 East 11th Street  
Austin, Texas 78701-2483  
Phone (512) 416-3120  
Fax (512) 416-3299

Instructions to locate the "CWZTCD" on TxDOT website are:

Start at website - [www.dot.state.tx.us](http://www.dot.state.tx.us)  
Click on "About TxDOT",  
Click on "Organizational Chart",  
Click on "Traffic Operations Box",  
Click on "Compliant Work Zone Traffic Control Devices",  
Click on "View PDF".  
This site is printable.

STANDARD PLANS  
Texas Department of Transportation  
Traffic Operations Division

BARRICADE AND CONSTRUCTION  
ARROW & MESSAGE SIGNS,  
REFLECTORS & WARNING LIGHT  
STANDARD

6 of 12 BC(6) -03

© TxDOT 11-4-02	DIST - BAS	EX - GRB	DIST - FDN	EX - CAL
REVISIONS	STATE DISTRICT	FEDERAL PROJECT	FEDERAL AID PROJECT	SHEET
6	COUNTY	CONTROL	SECTION	JOB
				T215
				HIGHWAY


RECORD PLANS  
MARCH 28, 2008

DISCLAIMER  
The use of this standard is governed by the "Texas Engineering Practice Act". No warranty of any kind is made by TxDOT for any purpose whatsoever. TxDOT assumes no responsibility for the conversion of this standard to other formats or for incorrect results or damages resulting from its use.

LEVELS DISPLAYED  
ACC:  
1 2 3 4 5 6 7 8 9 10 11 12 13 14 15 16 17 18 19 20 21 22 23 24 25 26 27 28 29 30 31 32 33 34 35 36 37 38 39 40 41 42 43 44 45 46 47 48 49 50 51 52 53 54 55 56 57 58 59 60 61 62 63

DISCLAIMER  
The use of this standard is governed by the "Texas Engineering Practice Act". No warranty of any kind is made by TxDOT for any purpose whatsoever. TxDOT assumes no responsibility for the conversion of this standard to other formats or for incorrect results or damages resulting from its use.

LEVELS DISPLAYED  
ACC: 1 2 3 4 15 16 17 18 19 20 21 22 23 24 25 26 27 28 29 30 31 32 33 34 35 36 37 38 39 40 41 42 43 44 45 46 47 48 49 50 51 52 53 54 55 56 57 58 59 60 61 62 63 64

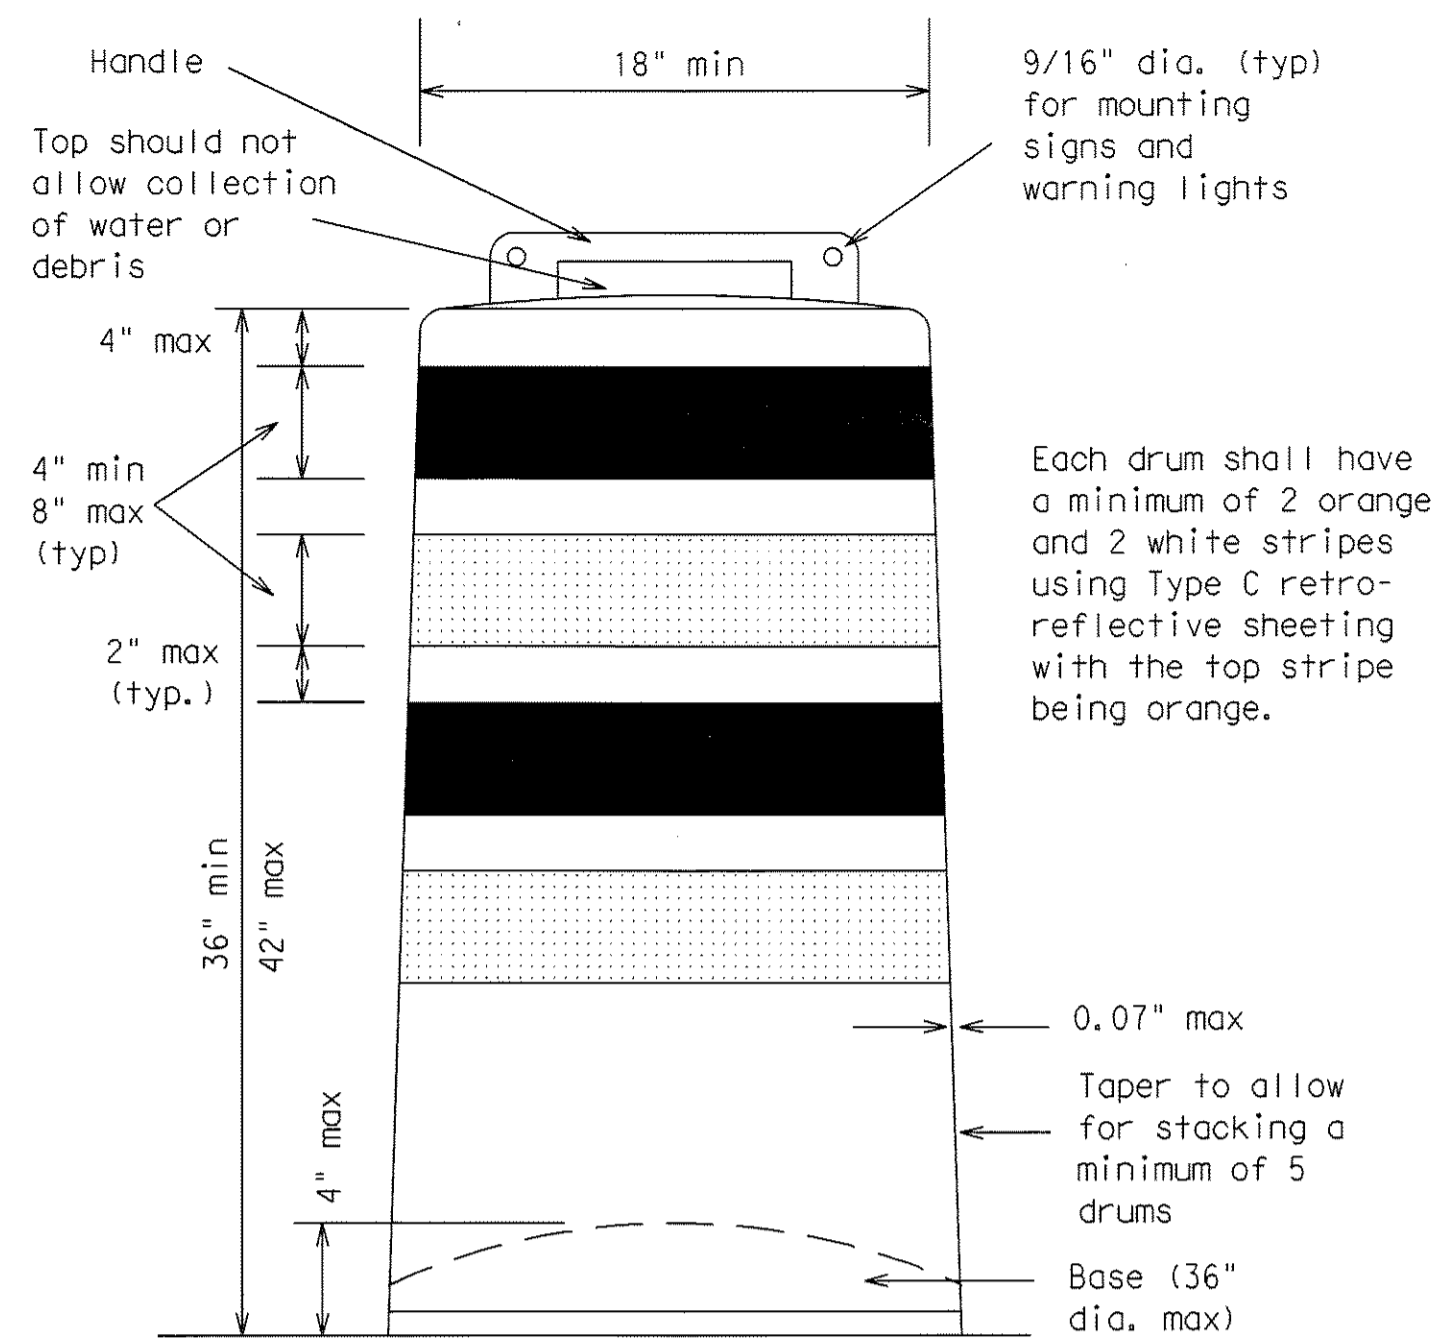

**GENERAL NOTES**

- Drums and all related items shall comply with the requirements of the current version of the "Texas Manual on Uniform Traffic Control Devices" (TMUTCD) and the "Compliant Work Zone Traffic Control Devices List" (CWZTCD).
- Drums, bases, and related materials shall exhibit good workmanship and shall be free from objectionable marks or defects that would adversely affect their appearance or serviceability.
- The Contractor shall have a maximum of 24 hours to replace any plastic drums or other traffic control devices identified for replacement by the Engineer/Inspector. The replacement device must be an approved device.

Prequalified plastic drums shall meet the following requirements:

**GENERAL DESIGN REQUIREMENTS**

- Plastic drums shall be a two-piece design; the "body" of the drum shall be the top portion and the "base" shall be the bottom.
- The body and base shall lock together in such a manner that the body separates from the base when impacted by a vehicle traveling at a speed of 20 MPH or greater but prevents accidental separation due to normal handling and/or air turbulence created by passing vehicles.
- Plastic drums shall be constructed of lightweight flexible, and deformable materials. The Contractor shall NOT use metal drums or single piece plastic drums as channelization devices or sign supports.
- Drums shall present a profile that is a minimum of 18 inches in width at the 36 inch height when viewed from any direction. The height of drum unit (body installed on base) shall be a minimum of 36 inches and a maximum of 42 inches.
- The top of the drum shall have a built-in handle for easy pickup and shall be designed to drain water and not collect debris. The handle shall have a minimum of two widely spaced 9/16 inch diameter holes to allow attachment of a warning light, delineator reflector unit or non-plywood sign.
- The exterior of the drum body shall have a minimum of four alternating orange and white retroreflective circumferential stripes not less than 4 inches nor greater than 8 inches in width. Any non-reflectORIZED space between any two adjacent stripes shall not exceed 2 inches in width.
- Bases shall have a maximum width of 36 inches, a maximum height of 4 inches, and a minimum of two footholds of sufficient size to allow base to be held down while separating the drum body from the base.
- Plastic drums shall be constructed of ultra-violet stabilized, orange, high-density polyethylene (HDPE) or other approved material.
- Drum body shall have a minimum unballasted weight of 7.7 lbs. and maximum unballasted weight of 11 lbs. The wall of the drum

body shall be a minimum of 0.07 inch in thickness. Weight of any drum supplied shall not vary more than 0.5 lb. from that of the prequalified sample.


- Drum and base shall be marked with manufacturer's name and model number.

**RETROREFLECTIVE SHEETING**

- The stripes used on drums shall be constructed of sheeting meeting the color and retroreflectivity requirements of Departmental Materials Specification DMS-8300, "Flat Surface Reflective Sheeting." High Specific Intensity (Type C) retro-reflective sheeting shall be supplied unless otherwise specified in the plans.
- The sheeting shall be suitable for use on and shall adhere to the drum surface such that, upon vehicular impact, the sheeting shall remain adhered in-place and exhibit no delaminating, checking, cracking, or loss of retroreflectivity other than that loss due to abrasion of the sheeting surface.

**BALLAST**

- Unballasted bases shall be large enough to hold up to 50 lbs. of sand. This base, when filled with the ballast material, should weigh between 35 lbs (minimum) and 50 lbs (maximum). The ballast may be sand in one to three sandbags separate from the base, sand in a sand-filled plastic base, or other ballasting devices as approved by the Engineer. Stacking of sandbags will be allowed, however height of sandbags above pavement surface may not exceed 12 inches.
- Bases with built-in ballast shall weigh between 40 lbs. and 50 lbs. Built-in ballast can be constructed of an integral crumb rubber base or a solid rubber base.
- The ballast shall not be heavy objects, water, or any material that would become hazardous to motorists, pedestrians, or workers when the drum is struck by a vehicle.
- When used in regions susceptible to freezing, drums shall have drainage holes in the bottoms so that water will not collect and freeze becoming a hazard when struck by a vehicle.
- Ballast shall not be placed on top of drums.
- Adhesives may be used to secure base of drums to pavement.

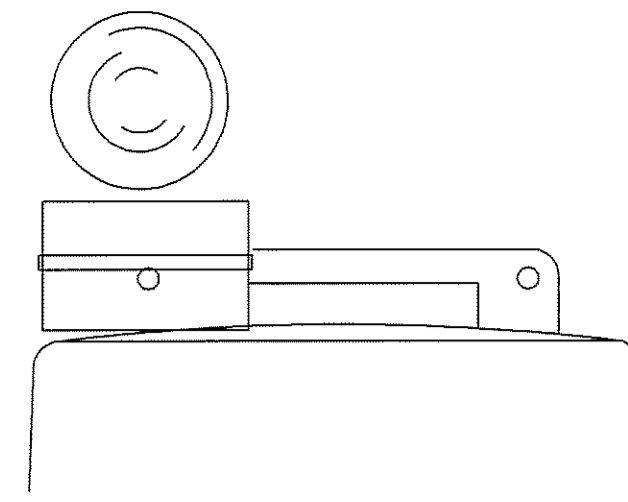


Type C Warning Light or approved substitute mounted adjacent to the travel way.

**WARNING LIGHTS AND DELINEATORS MOUNTED ON PLASTIC DRUMS**

- Type A flashing warning lights are intended to warn drivers that they are approaching or are in a potentially hazardous area.
- Type A flashing warning lights are not intended for delineation and shall not be used in a series.
- Type C steady-burn warning lights are intended to be used in a series to delineate the edge of the travel lane on detours, on lane changes, on lane closures, and on other similar conditions.
- Type A and Type C warning lights shall be installed at locations as detailed on other sheets in the plans.
- Warning lights shall not be installed on a drum that has a sign, chevron or vertical panel.
- Type A Class 1, Type A Class 2, or Type B Reflector Units (D & OM Standard) may be attached to drums to delineate the intended vehicular path. The color of the reflector unit shall correspond to the pavement marking it is supplementing or for which it is substituting (left edgeline-yellow or right edgeline-white). The reflective unit shall be attached to the handle of the drum using the mounting hole nearest the travel lane and shall be aligned perpendicular to approaching traffic.
- Delineators may be used as directed by the Engineer. Delineators may not be used as a substitute for warning lights.


**WARNING REFLECTORS MOUNTED ON PLASTIC DRUMS AS A SUBSTITUTE FOR TYPE C WARNING LIGHTS**

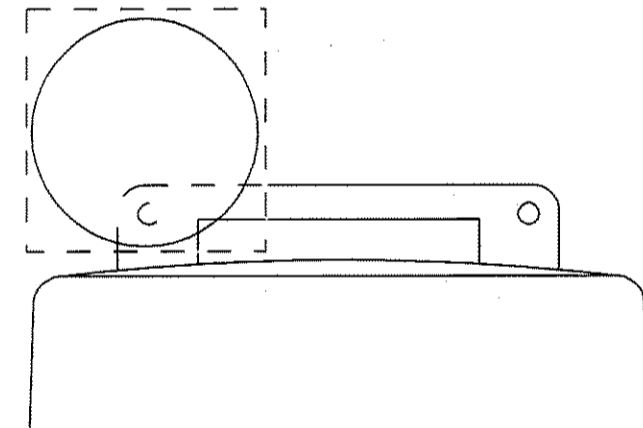

Warning reflector may be round or square. Must have a reflective surface area of at least 30 square inches

- A warning reflector or approved substitute may be mounted on a plastic drum as a substitute for a Type C, steady burn warning light at the discretion of the Contractor unless otherwise noted in the plans.
- The warning reflector shall be manufactured using a sign substrate approved for use with plastic drums listed on the CWZTCD.
- The warning reflector shall have a minimum retroreflective surface area (one-side) of 30 square inches.
- Round reflectors shall be fully reflectORIZED, including the area where attached to the drum.
- Square substrates must have a minimum of 30 square inches of reflectORIZED sheeting. They do not have to be reflectORIZED where it attaches to the drum.
- The side of the warning reflector facing approaching traffic shall have sheeting meeting the color and retroreflectivity requirements for DMS 8300-Type D (Non-fluorescent Prismatic).
- When used near two-way traffic, both sides of the warning reflector shall be reflectORIZED.
- The warning reflector should be mounted on the side of the handle nearest approaching traffic.

**TYPICAL DETAIL OF LANE CLOSURE USING PLASTIC DRUMS AS CHANNELIZING DEVICES**

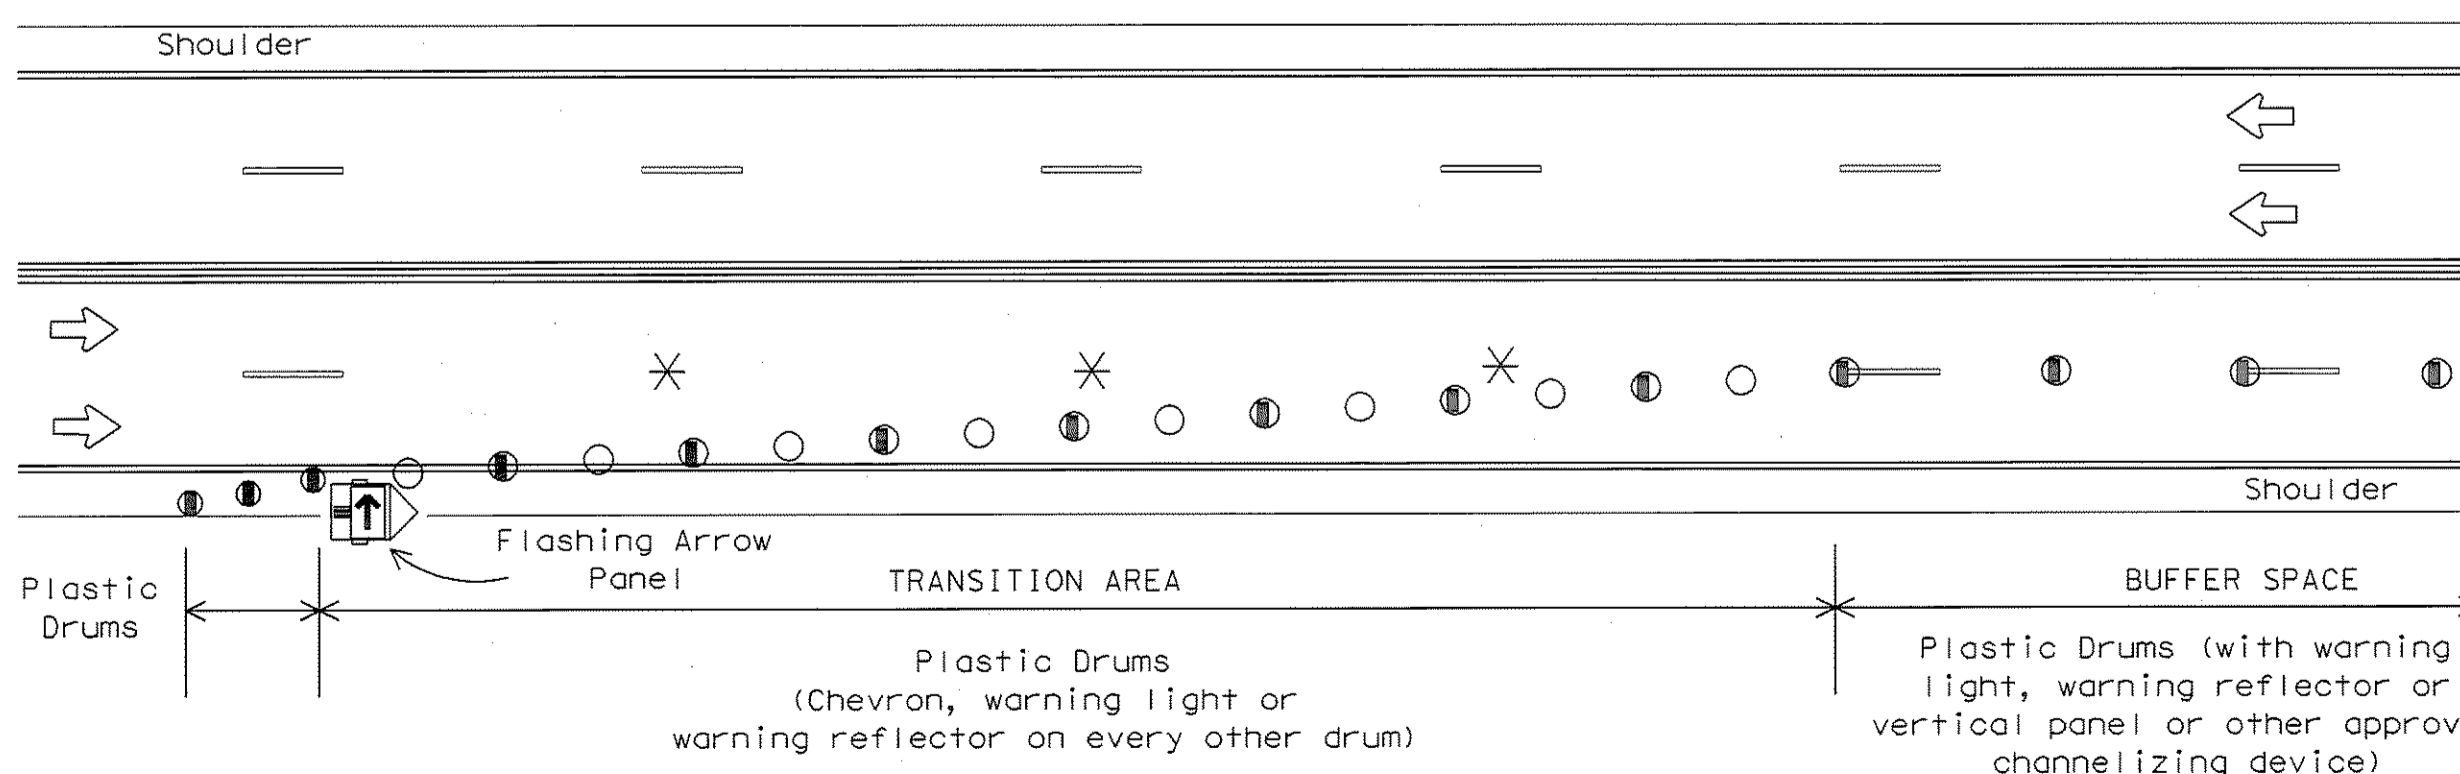


Provide adequate sight distance when placing lane closures. Do not place lane closures in vertical or horizontal curves. See BC(8) for table showing the spacing of channelizing devices in the taper and tangent section.

* NOTE: Lane lines shall be removed when the lane closure occupies a location for longer than 2 weeks.


**LEGEND**

- Flashing Arrow Panel
- Plastic Drum
- Plastic Drum w/ approved channelizing device

RECORD PLANS  
MARCH 28, 2008

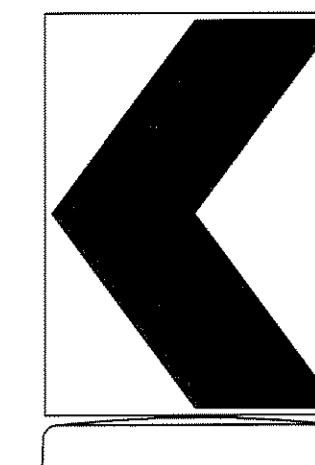

18" x 24" Sign (Maximum Sign Dimension) Chevron CW1-8, Driveway sign D70a, Keep Right R4 series or other signs as approved by Engineer

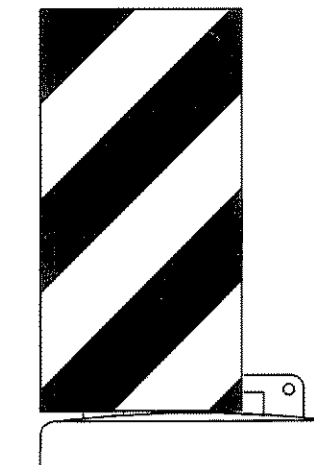

12" x 24" Vertical Panel mount with diagonals sloping down towards travel way

Plywood, Aluminum or Metal sign substrates shall NOT be used on plastic drums

**SIGNS, CHEVRONS, AND VERTICAL PANELS MOUNTED ON PLASTIC DRUMS**

- Signs used on plastic drums shall be manufactured using substrates listed on the CWZTCD.
- Chevrons and other work zone signs with an orange background shall be manufactured with Type E (Fluorescent Prismatic) sheeting meeting the color and retroreflectivity requirements of DMS-8300, "Flat Surface Reflective Sheeting," unless otherwise specified in the plans.
- Vertical Panels shall be manufactured with orange and white sheeting meeting the requirements of DMS-8300 Type C (High Specific Intensity). Diagonal stripes on Vertical Panels shall slope down toward the intended traveled lane.
- Other sign messages (text or symbolic) may be used as approved by the Engineer. Sign dimensions shall not exceed 18 inches in width or 24 inches in height.
- Signs shall be installed using a 1/2 inch bolt (nominal) and nut, two washers, and one locking washer for each connection.
- Mounting bolts and nuts shall be fully engaged and adequately torqued. Bolts should not extend more than 1/2 inch beyond nuts.

Only pre-qualified products shall be used. A copy of the "Compliant Work Zone Traffic Control Devices List" (CWZTCD) describes pre-qualified products and their sources and may be obtained by contacting:

Standards Engineer  
Traffic Operations Division - TE  
Texas Department of Transportation  
125 East 11th Street  
Austin, Texas 78701-2483  
Phone (512) 416-3120  
Fax (512) 416-3299

Instructions to locate the "CWZTCD" on TxDOT website are:

Start at website - [www.dot.state.tx.us](http://www.dot.state.tx.us)  
Click on "About TxDOT",  
Click on "Organizational Chart",  
Click on "Traffic Operations Box",  
Click on "Compliant Work Zone Traffic Control Devices",  
Click on "View PDF".  
This site is printable.

4/03 Revision

Revised note

STANDARD PLANS  
Texas Department of Transportation  
Traffic Operations Division



**BARRICADE AND CONSTRUCTION  
PLASTIC DRUM  
STANDARD**

7 of 12 BC(7)-03


TxDOT 11-4-02		DW - BAS	CK - GRB	DW - FDN	CK - CAL
REVISIONS	STATE DISTRICT	FEDERAL SECTION	FEDERAL AID PROJECT		SHEET
4-03	6				T216
	COUNTY	CONTROL	SECTION	JOB	HIGHWAY

# CHANNELIZING DEVICES

## VERTICAL PANELS

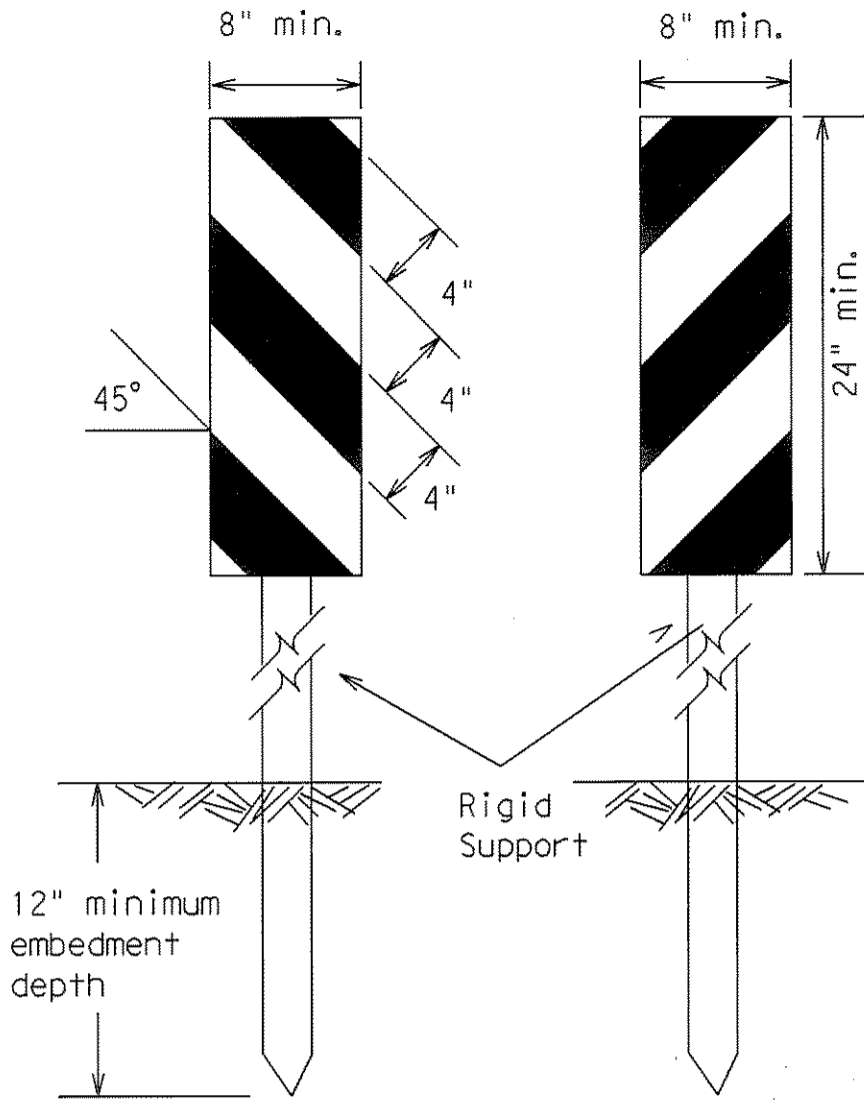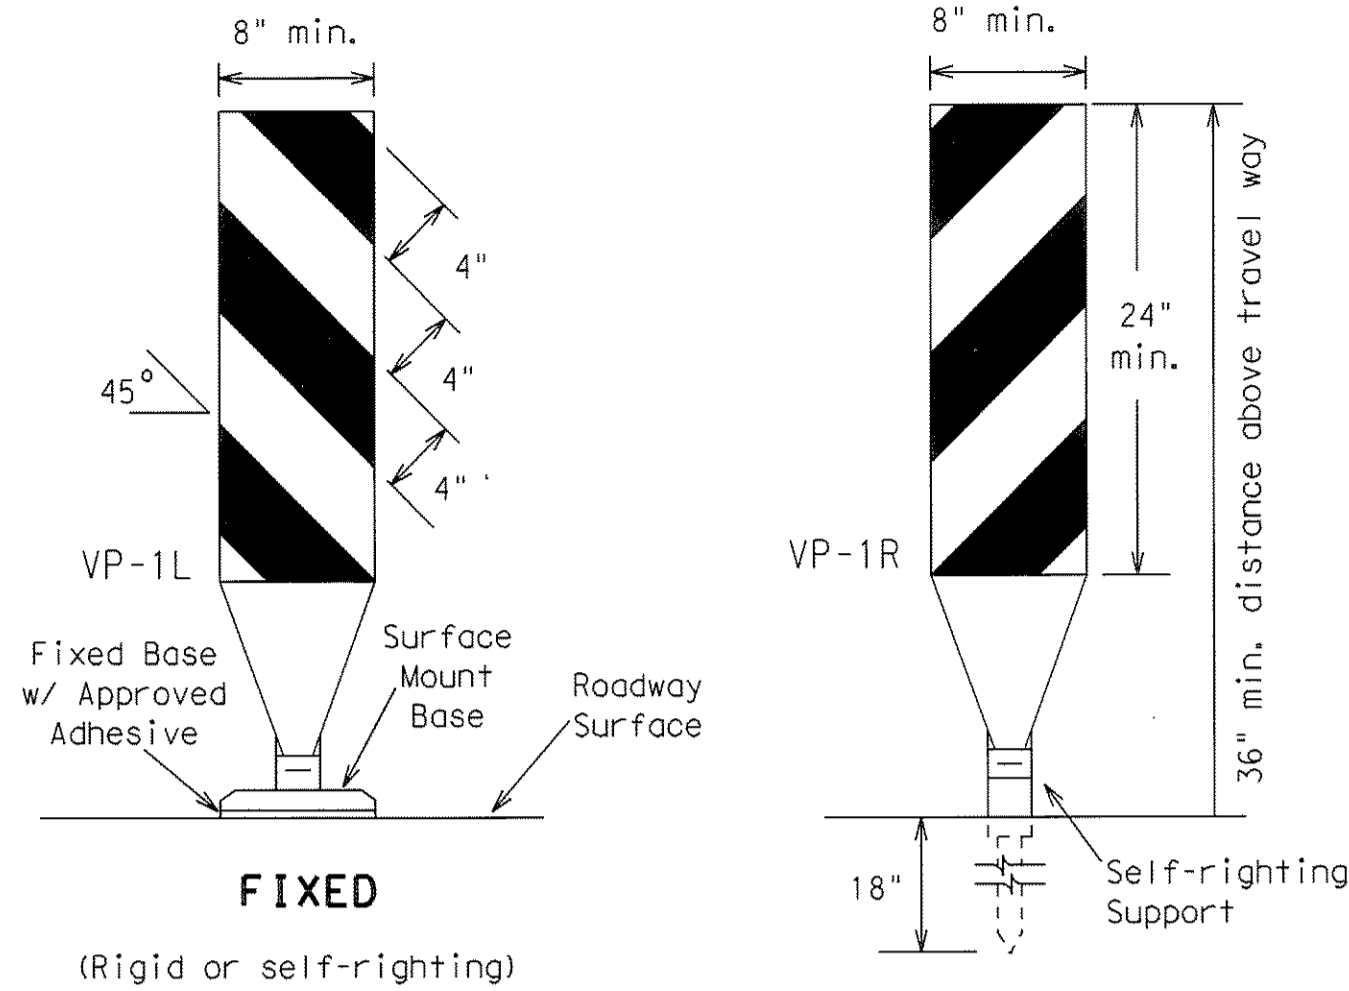


## DRIVEABLE

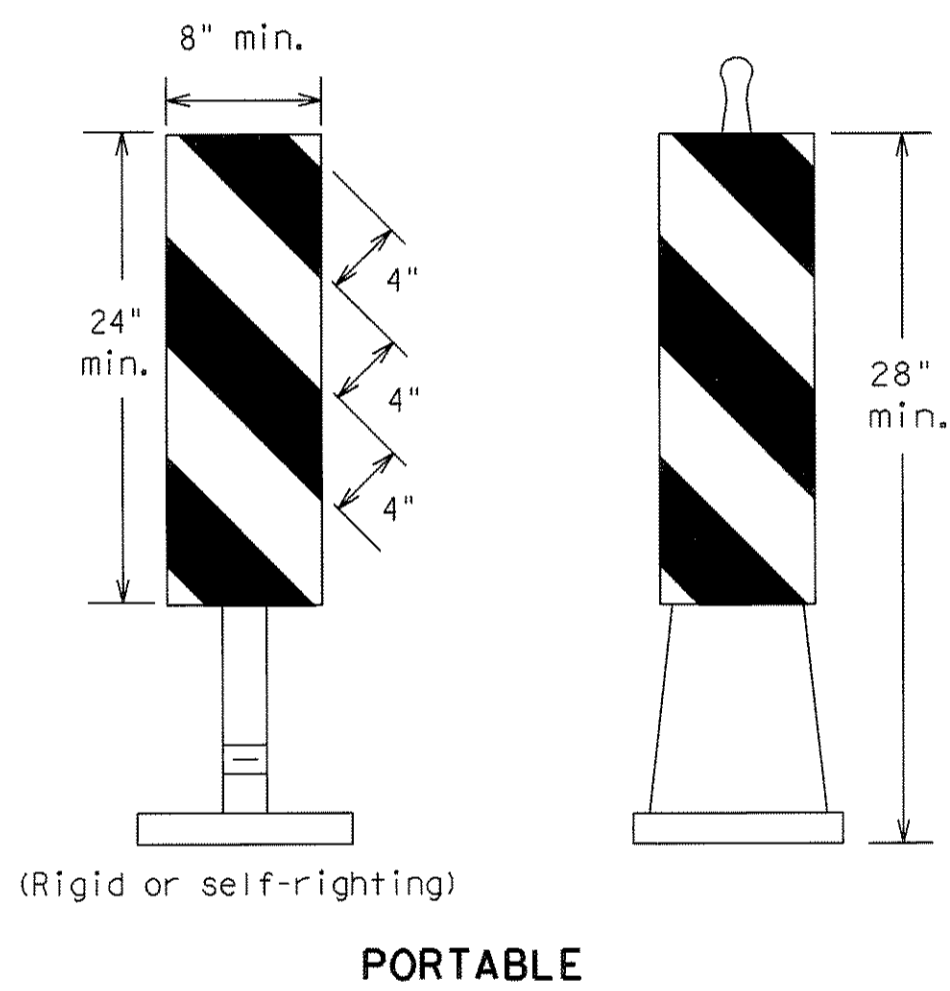

- Vertical Panels (VP's) are normally used to channelize traffic or divide opposing lanes of traffic.
- VP's may be used in daytime or nighttime situations. They may be used at the edge of shoulder drop-offs and other areas such as lane transitions where positive daytime and nighttime delineation is required. The Engineer/Inspector shall refer to the Roadway Design Manual Appendix B "Treatment of Pavement Drop-offs in Work Zones" for additional guidelines on the use of VP's for drop-offs.
- VP's should be mounted back to back if used at the edge of cuts adjacent to two-way two lane roadways. Stripes are to be reflective orange and reflective white and should always slope downward toward the travel lane.
- VP's used on expressways, freeways, and on high speed roadways shall have a minimum of 2 square feet of retroreflective area facing traffic.
- Self-righting supports are available with portable base. See "Compliant Work Zone Traffic Control Devices List" (CWZTCD).
- Sheeting for the VP's shall be retroreflective Type C (High Specific Intensity) conforming to Departmental Material Specification DMS-8300, unless noted otherwise.

## CHEVRONS

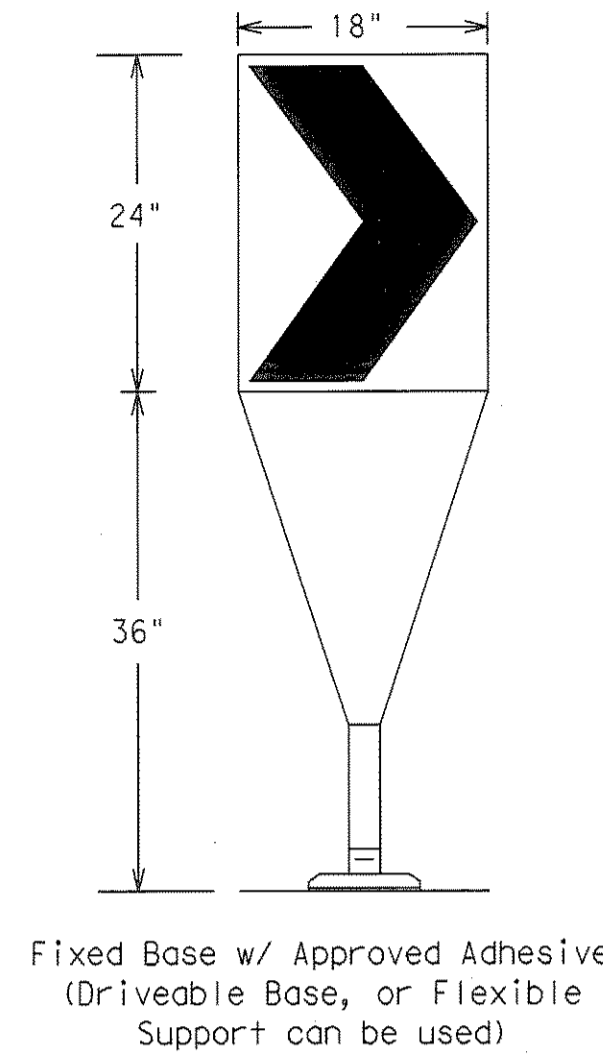

- The chevron shall be a vertical rectangle with a minimum size of 12 by 18 inches.
- Chevrons are intended to give notice of a sharp change of alignment with the direction of travel and provide additional emphasis and guidance for vehicle operators with regard to changes in horizontal alignment of the roadway.
- Chevrons, when used, shall be erected on the outside of a sharp curve or turn, or on the far side of an intersection. They shall be in line with and at right angles to approaching traffic. Spacing should be such that the motorist always has three in view, until the change in alignment eliminates its need.
- To be effective, the chevron should be visible for at least 500 feet.
- Chevrons shall be orange with a black non-reflective legend. Sheeting for the chevron shall be retroreflective Type E (Fluorescent Prismatic) conforming to Departmental Material Specification DMS-8300, unless noted otherwise. The legend shall be black vinyl non-reflective decal sheeting meeting the requirements of DMS-8320.

Posted Speed	Formula	Minimum Desirable Taper Lengths **			Suggested Maximum Spacing of Channelizing Devices	
		10' Offset	11' Offset	12' Offset	On a Taper	On a Tangent
30	$L = \frac{WS^2}{60}$	150'	165'	180'	30'	60' - 75'
35		205'	225'	245'	35'	70' - 90'
40		265'	295'	320'	40'	80' - 100'
45	L=WS	450'	495'	540'	45'	90' - 110'
50		500'	550'	600'	50'	100' - 125'
55		550'	605'	660'	55'	110' - 140'
60		600'	660'	720'	60'	120' - 150'
65		650'	715'	780'	65'	130' - 165'
70		700'	770'	840'	70'	140' - 175'
75		750'	825'	900'	75'	150' - 185'

**Taper lengths have been rounded off.  
L=Length of Taper (FT.) W=Width of Offset (FT.) S=Posted Speed (MPH)

## GENERAL NOTES:

- Work Zone channelizing devices illustrated on this sheet may be installed in close proximity to traffic and are suitable for use on high or low speed roadways. The Engineer/Inspector shall ensure that spacing and placement is uniform and in accordance with the "Texas Manual on Uniform Traffic Control Devices" (TMUTCD).
- Channelizing devices shown on this sheet may have a driveable, fixed or portable base. The requirement for self-righting channelizing devices must be specified in the General Notes or other plan sheets.
- Channelizing devices on self-righting supports should be used in work zone areas where channelizing devices are frequently impacted by errant vehicles or vehicle related wind gusts making alignment of the channelizing devices difficult to maintain. Locations of these devices shall be detailed elsewhere in the plans. These devices shall conform to the TMUTCD and the "Compliant Work Zone Traffic Control Devices List" (CWZTCD).
- The contractor shall maintain devices in a clean condition and replace damaged, non-reflective, faded, or broken devices and bases as required by the Engineer/Inspector. The Contractor shall be required to maintain proper device spacing and alignment.
- Portable bases shall be fabricated from virgin and/or recycled rubber. The portable bases shall weigh approximately 35 lbs.
- Pavement surfaces shall be prepared in a manner that ensures proper bonding between the adhesives, the fixed mount bases and the pavement surface. Adhesives shall be prepared and applied according to the manufacturer's recommendations.
- The installation and removal of channelizing devices shall not cause detrimental effects to the final pavement surfaces, including pavement surface discoloration or surface integrity. Driveable bases shall not be permitted on final pavement surfaces. The Engineer/Inspector shall approve all application and removal procedures of fixed bases.
- Examples on this sheet are the most commonly used channelizing devices in work zones. For other devices, refer to the CWZTCD.

Only pre-qualified products shall be used. A copy of the "Compliant Work Zone Traffic Control Devices List" (CWZTCD) describes pre-qualified products and their sources and may be obtained by contacting:


**Standards Engineer**  
Traffic Operations Division - TE  
Texas Department of Transportation  
125 East 11th Street  
Austin, Texas 78701-2483  
Phone (512) 416-3120  
Fax (512) 416-3299

Instructions to locate the "CWZTCD" on TxDOT website are:

Start at website - [www.dot.state.tx.us](http://www.dot.state.tx.us)  
Click on "About TxDOT",  
Click on "Organizational Chart",  
Click on Traffic Operations Box,  
Click on "Compliant Work Zone Traffic Control Devices",  
Click on "View PDF".  
This site is printable.


LEVELS DISPLAYED  
1 2 3 4 5 16 17 18 19 101 112 121 31 41 51 6  
ACC: 1 7 8 9 20 21 22 23 24 25 26 27 28 29 30 31 32  
33 34 35 36 37 38 39 40 41 42 43 44 45 46 47 48  
49 50 51 52 53 54 55 56 57 58 59 60 61 62 63

## OPPOSING TRAFFIC LANE DIVIDERS (OTLD)

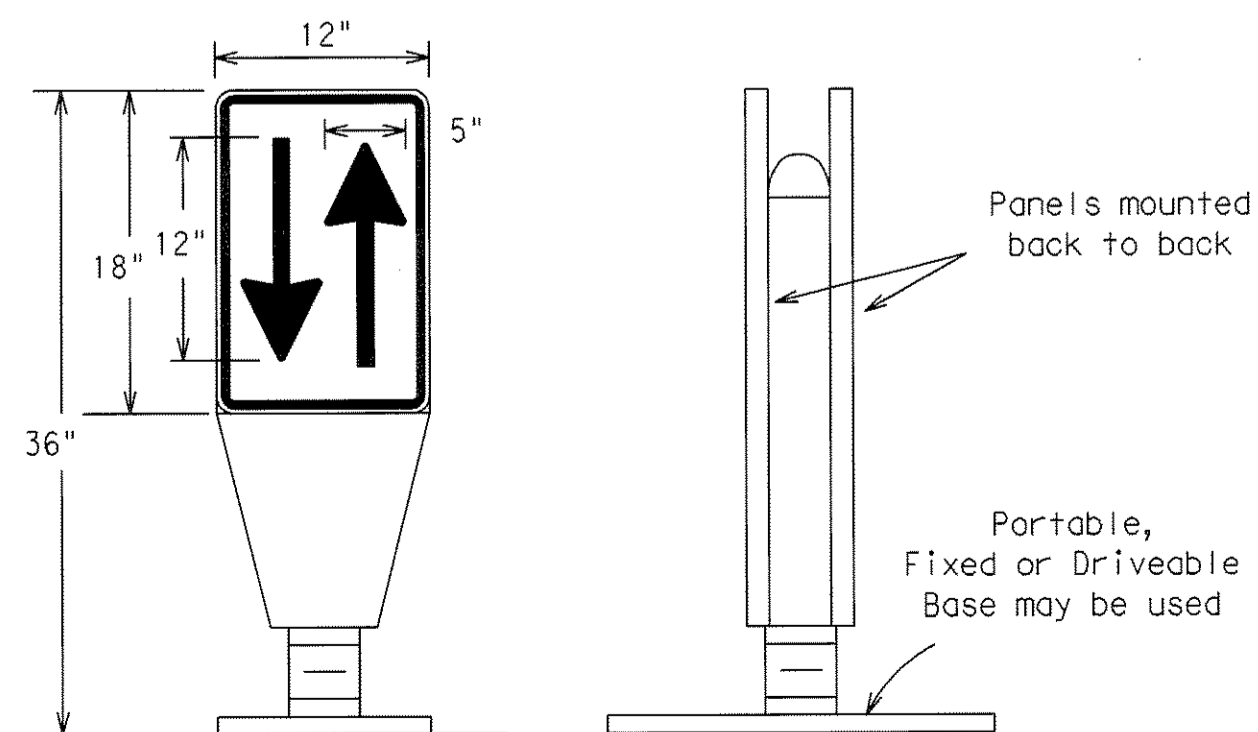

- Opposing Traffic Lane Dividers (OTLD) are delineation devices designed to convert a normal one-way roadway section to two-way operation. OTLD's are used on temporary centerlines. The upward and downward arrows on the sign's face indicate the direction of traffic on either side of the divider. The base is secured to the pavement with an adhesive or rubber weight to minimize movement caused by a vehicle impact or wind gust. The OTLD is placed on a flexible self-righting support that returns to an upright position when impacted by a vehicle.
- The OTLD may be used in combination with simple tubular markers or vertical panels (vp's).
- Spacing between the OTLD shall not exceed 500 feet. Tubular markers or vp's placed between the OTLD's should not exceed 100 foot spacing.
- The OTLD shall be orange with a black non-reflective legend. Sheeting for the OTLD shall be retroreflective Type E (Fluorescent Prismatic) conforming to Departmental Material Specification DMS-8300, unless noted otherwise. The legend shall be black vinyl non-reflective decal sheeting meeting the requirements of DMS-8320.

RECORD PLANS  
MARCH 28, 2008

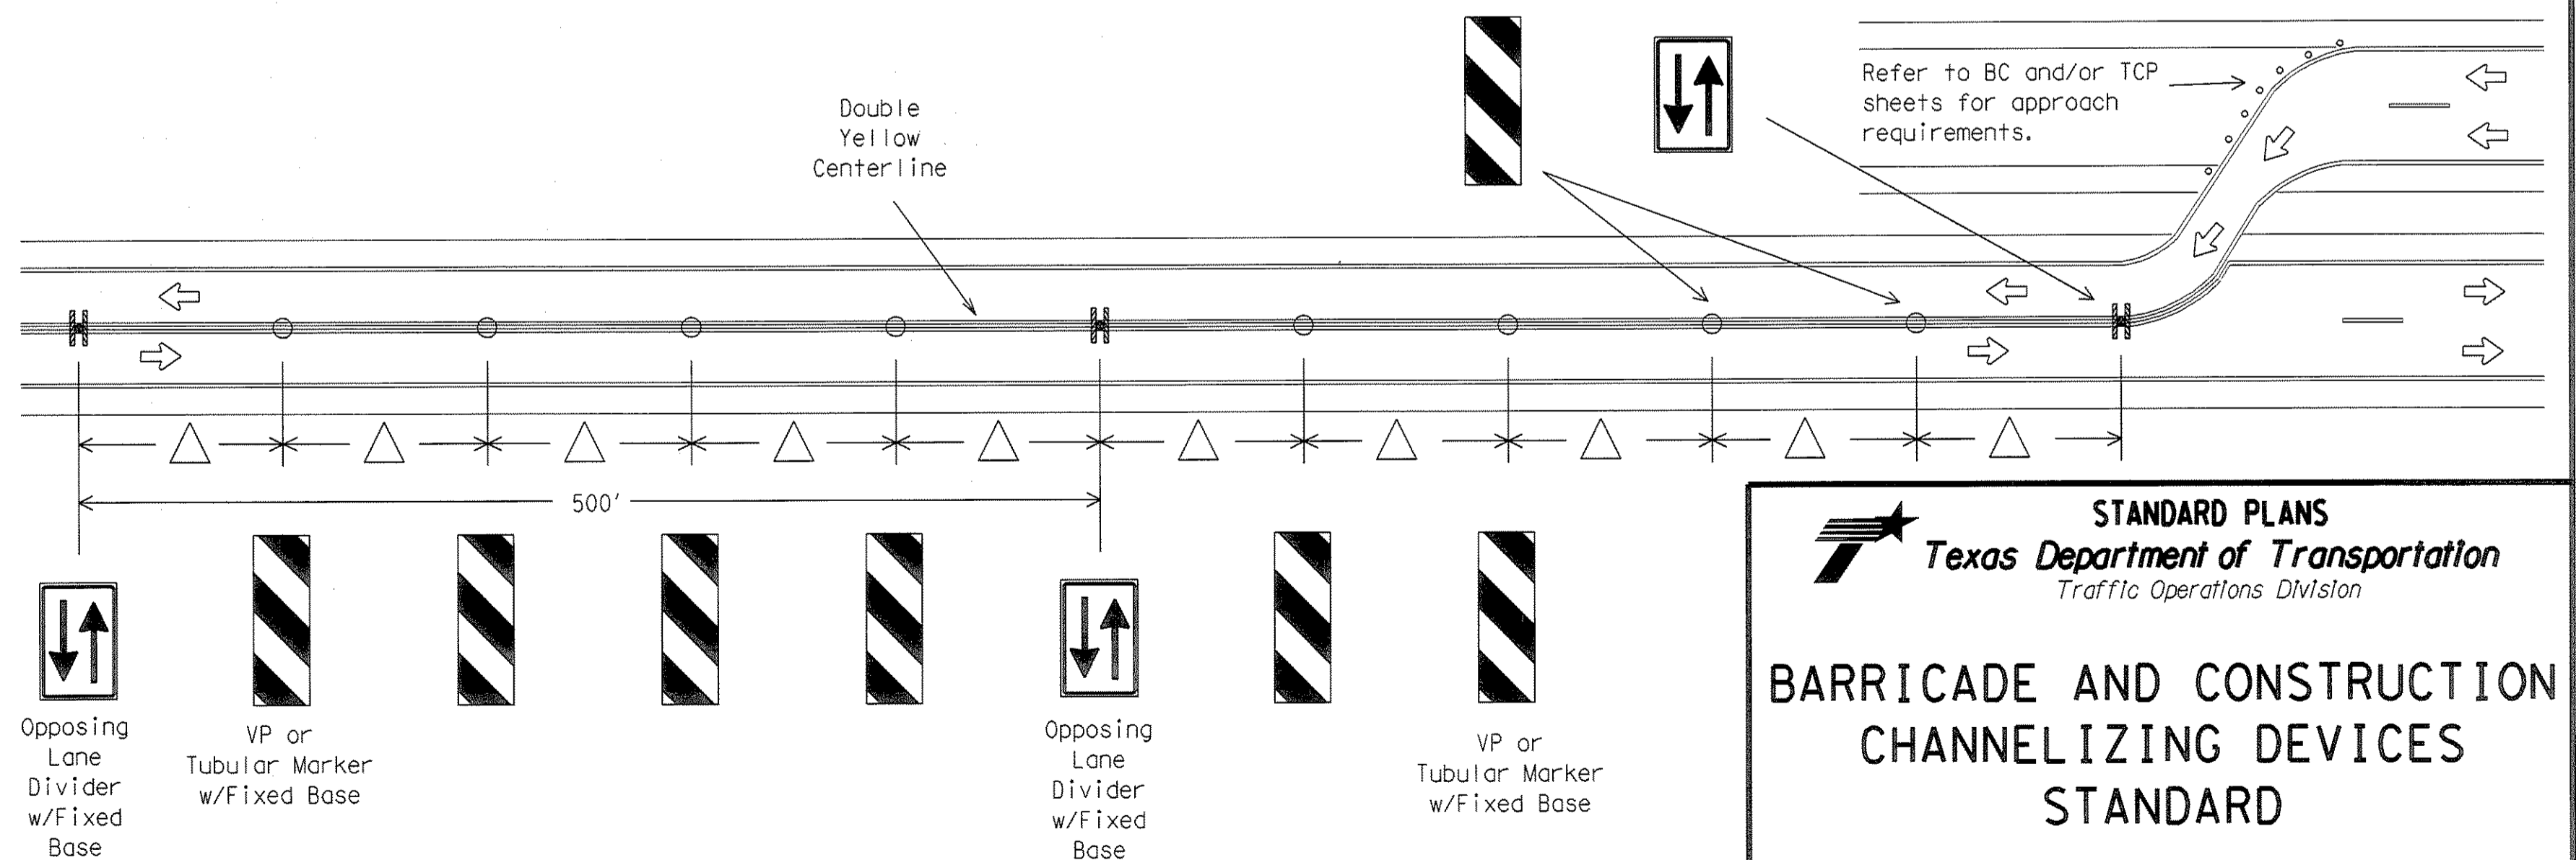

△ Spacing between the VP's or tubular markers shall not exceed 100 feet. On roadways with speeds less than 45 MPH, spacing between the tubular markers or VP's shall be as shown on the channelizing spacing table shown on this page. If the table shows spacing greater than 100 feet based on the roadway speed, then use a maximum of 100 feet spacing between the tubular markers or VP's. Every fifth channelizing device shall be an OTLD. Spacing between the OTLD shall not exceed 500 feet. When using this type of traffic control set-up, the OTLD, VP's or tubular markers shall have the fixed base with approved adhesive per the manufacturer's recommendations.

**STANDARD PLANS**  
Texas Department of Transportation  
Traffic Operations Division

### BARRICADE AND CONSTRUCTION CHANNELIZING DEVICES STANDARD

8 of 12 BC(8)-03

TxDOT 11-4-02

REVISED	STATE DISTRICT	FEDERAL REGION	FEDERAL AID PROJECT	SHEET
	6			T217
	COUNTY	CONTROL	SECTION	JOB
				HIGHWAY

108

DISCLAIMER  
 The use of this standard is governed by the "Texas Engineering Practice Act". No warranty of any kind is made by TxDOT for any purpose whatsoever. TxDOT assumes no responsibility for the conversion of this standard to other formats or for incorrect results or damages resulting from its use.


ACC:  
 LEVELS DISPLAYED  
 1 2 3 4 5 6 7 8 9 10 11 12 13 14 15 16  
 17 18 19 20 21 22 23 24 25 26 27 28 29 30 31 32  
 33 34 35 36 37 38 39 40 41 42 43 44 45 46 47 48  
 49 50 51 52 53 54 55 56 57 58 59 60 61 62 63

**TYPE III BARRICADES**


1. Refer to the Compliant Work Zone Traffic Control Devices List (CWZTCD) for details of the Type III Barricades and a list of all materials used in the construction of Type III Barricades.
2. Type III Barricades shall be used at each end of construction projects closed to all traffic.
3. Barricades extending across a roadway should have stripes that slope downward in the direction toward which traffic must turn in detouring. When both right and left turns are provided, the chevron striping may slope downward in both directions from the center of the barricade.
4. Striping of rails, for the right side of the roadway, should slope downward to the left. For the left side of the roadway, striping should slope downward to the right.
5. Identification markings may be shown only on the back of the barricade rails. The maximum height of letters and/or company logos used for identification shall be 1".
6. Barricades shall not be placed parallel to traffic unless an adequate clear zone is provided.
7. Warning lights shall NOT be installed on barricades.
8. Where barricades require the use of weights to keep from turning over, the use of sandbags with dry, cohesionless sand is recommended. The sandbags will be tied shut to keep the sand from spilling and to maintain a constant weight. Rock, concrete, iron, steel or other solid objects will NOT be permitted. Sandbags should weigh a minimum of 35 lbs and a maximum of 50 lbs. Sandbags shall be made of a durable material that tears upon vehicular impact. Rubber (such as tire inner tubes) shall not be used for sandbags. Sandbags shall only be placed along or upon the base supports of the device and shall not be suspended above ground level or hung with rope, wire, chains or other fasteners.

**Barricades shall NOT  
 be used as a sign support.**


**TYPICAL STRIPING DETAIL FOR BARRICADE RAIL**

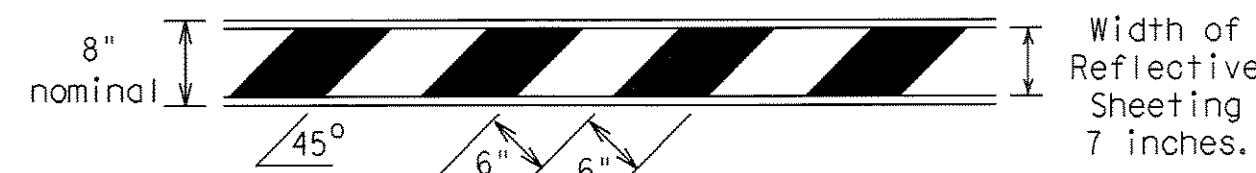

**TYPICAL PANEL DETAIL FOR SKID OR POST TYPE BARRICADES**

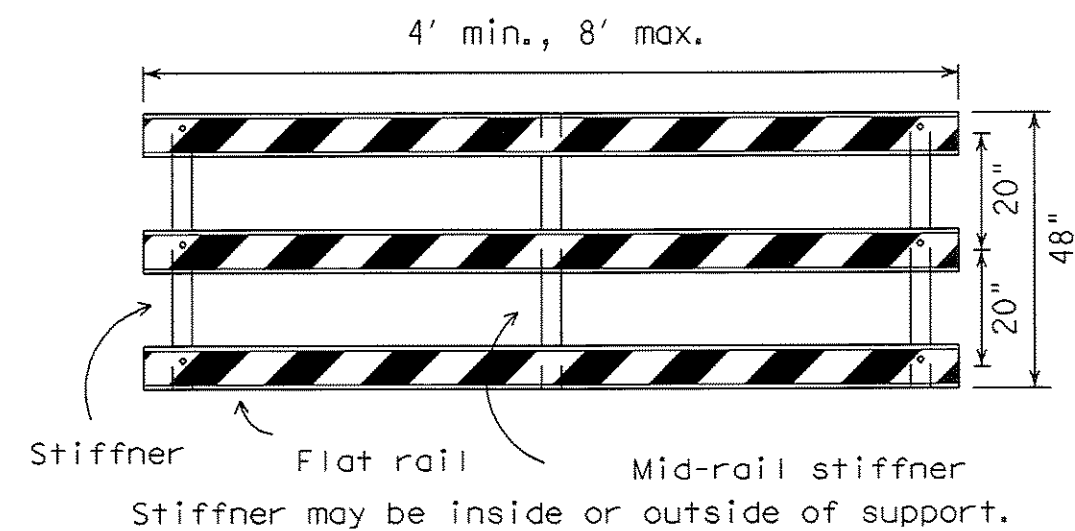


**EDGE LINE CHANNELIZER**

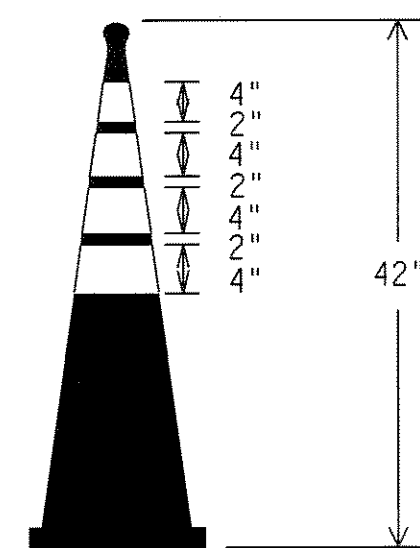

1. This device is intended only for use in place of a vertical panel to channelize traffic by indicating the edge of the travel lane.
2. This device shall not be used to separate lanes of traffic (opposing or otherwise) or warn of objects.
3. This device is based on a 42 inch, two-piece cone with an alternate striping pattern: four 4 inch retroreflective bands, with an approximate 2 inch gap between bands. The color of the band should correspond to the color of the edgeline (yellow for left edgeline, white for right edgeline) for which the device is substituted or for which it supplements. The reflectorized bands shall be retroreflective Type C (High Specific Intensity) conforming to Departmental Material Specification DMS-8300, unless otherwise noted.
4. The base must weigh a minimum of 30 lbs.


**TYPE III BARRICADE (POST AND SKID) TYPICAL APPLICATION**

Each roadway of a divided highway shall be barricaded in the same manner.

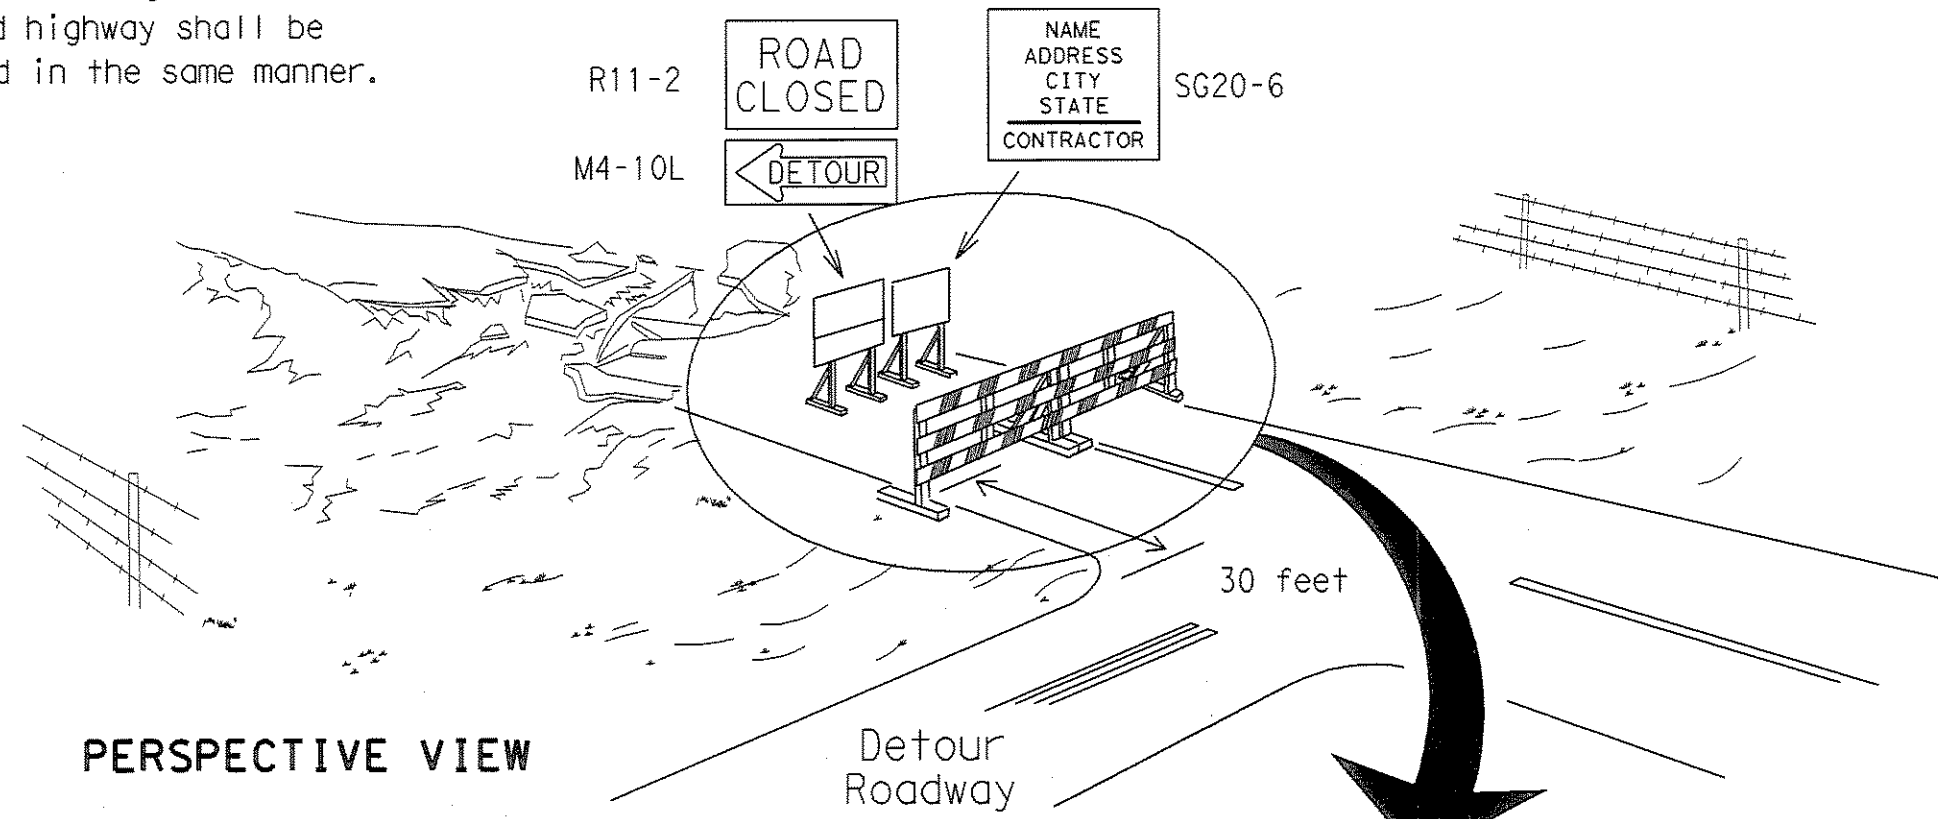

PERSPECTIVE VIEW


The three rails on Type III barricades shall be reflectorized orange and reflective white stripes on one side facing one-way traffic and both sides for two-way traffic. Barricade striping should slant downward in the direction of detour.

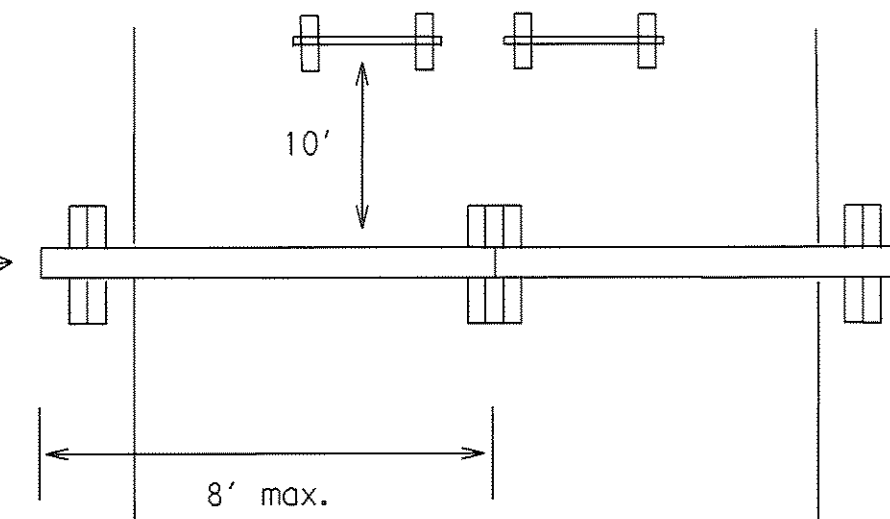


PLAN VIEW

1. Signs should be mounted on independent supports at a 7 foot mounting height in center of roadway. The signs should be a minimum of 10 feet behind Type III Barricades.
2. Advance signing shall be as specified elsewhere in the plans.

**CULVERT WIDENING OR OTHER ISOLATED WORK WITHIN THE PROJECT LIMITS**

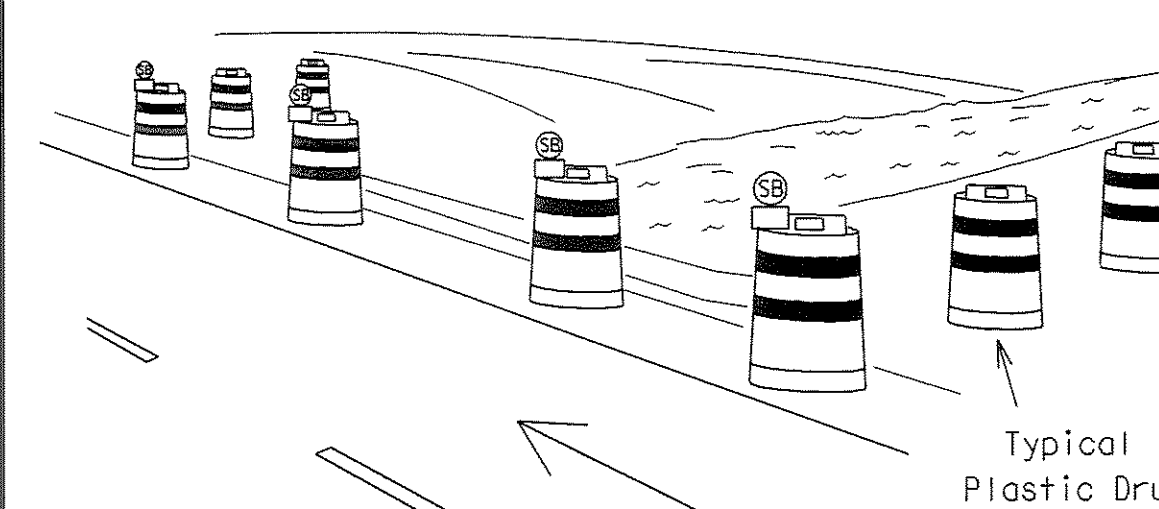

PERSPECTIVE VIEW

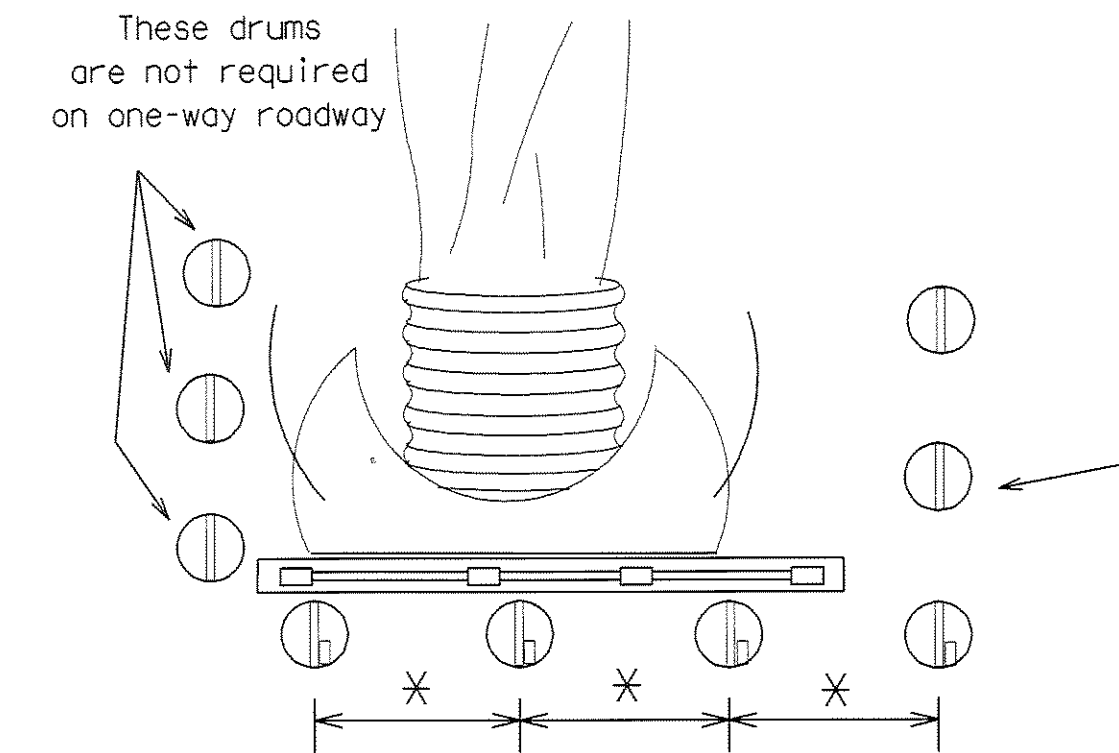

Legend

- Plastic drum
- ⊙ Plastic drum with steady burn light

PLAN VIEW

1. Where positive redirection capability is provided, drums may be omitted.
2. Plastic construction fencing may be used with drums for safety as required in the plans.
3. Vertical Panels on flexible support may be substituted for drums when the shoulder width is less than 4 feet.
4. When the shoulder width is greater than 12 feet, steady-burn lights may be omitted if drums are used.
5. Drums must extend the length of the culvert widening.


Increase number of plastic drums on the side of approaching traffic if the crown width makes it necessary. (minimum of 2 and maximum of 4 drums)

* Maximum spacing between drums shall be 10 feet. A minimum of two drums shall be used across the work area.

**RECORD PLANS  
 MARCH 28, 2008**

**28" Cones shall have a minimum weight of 9 1/2 lbs.  
 42" 2-piece cones shall have a minimum weight of 30 lbs.**

**CONES**

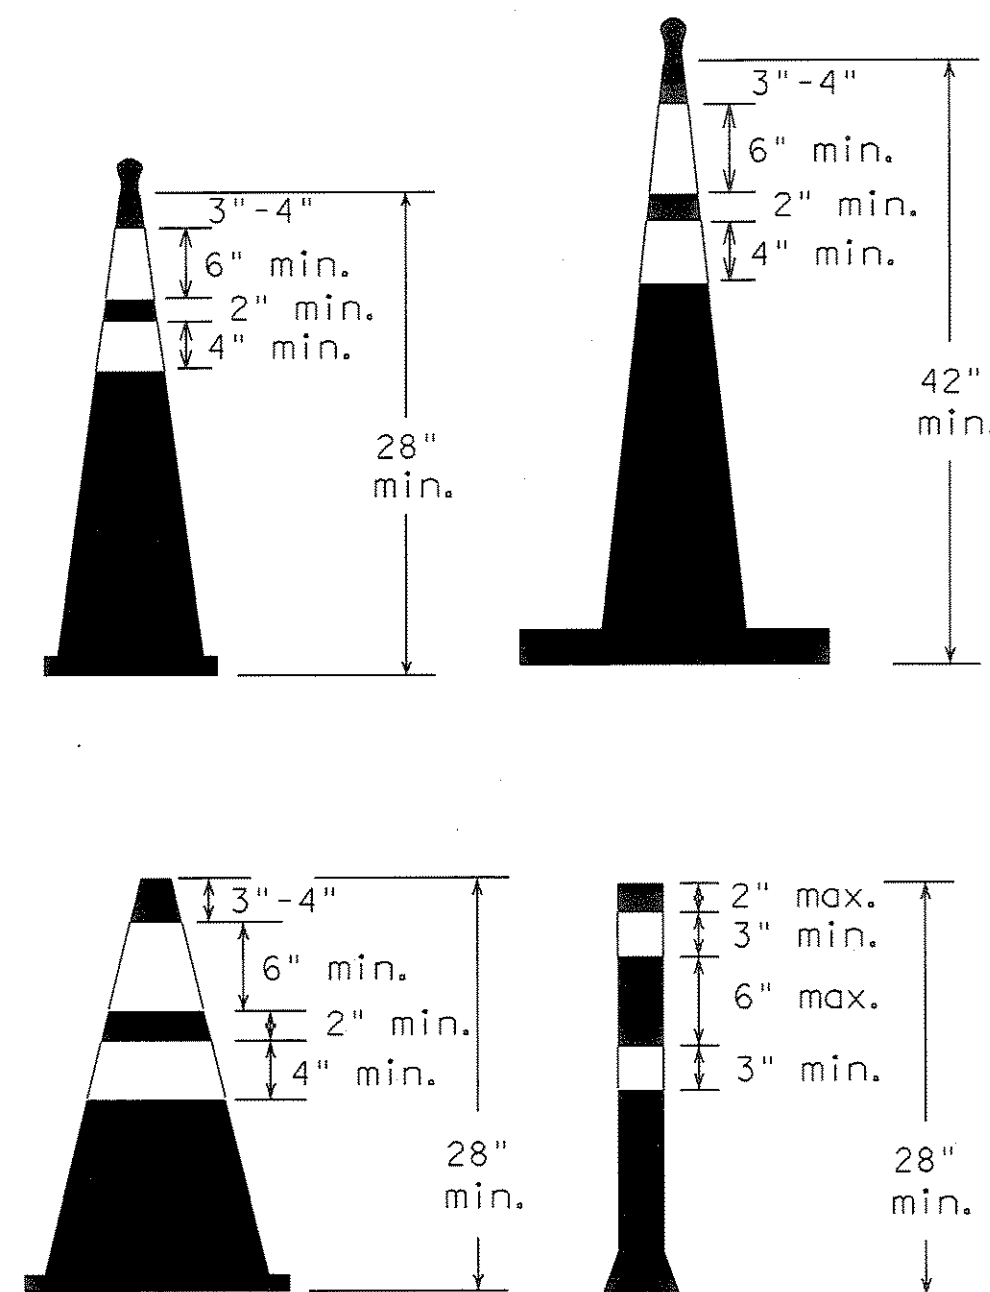

1. Traffic cones and tubular markers shall be a minimum of 28 inches in height when used either on freeways or at nighttime.
2. Cones or tubular markers shall be predominantly orange, fluorescent red-orange, or fluorescent yellow-orange. They should be kept clean and bright for maximum visibility.
3. Cones used only for daytime operations do not require the reflectorized bands.
4. Cones used for nighttime operations shall be reflectorized. Reflectorized material shall have a smooth, sealed outer surface that displays the same approximate color during the day and night. The reflectorized bands shall be retroreflective Type C (High Specific Intensity) conforming to Departmental Material Specification DMS-8300, unless otherwise noted.
5. When used at night, appropriate personnel shall ensure that cones and tubular markers remain in their proper location and in an upright position.
6. Reflectorization of cones shall consist of a minimum 6 inch band placed at least 3 inches but not more than 4 inches from the top, supplemented by a minimum 4 inch band spaced a minimum of 2 inches below the 6 inch band.
7. Reflectorization of tubular markers shall be a minimum of two 3 inch bands placed a maximum of 2 inches from the top with a maximum of 6 inches between bands. The reflectorized bands shall be retroreflective Type C (High Specific Intensity) conforming to Departmental Material Specification DMS-8300, unless otherwise noted.
8. One-piece cones or tubular markers are generally suitable for temporary usage (up to 8 hours) with other channelization devices such as vertical panels, drums or two-piece cones for long term usage. Care should be taken to ensure they remain in their proper location and in an upright position.
9. Cones or tubular markers used on each project shall be of the same size and shape.
10. The handle may be designed as a hook or other shape, fabricated from non-rigid materials similar to the cone material, and may extend up to a maximum of 8 inches above the top of cone. Length of the handle shall not be considered with regard to the overall height of the cone.

Only pre-qualified products shall be used. A copy of the "Compliant Work Zone Traffic Control Devices List" (CWZTCD) describes pre-qualified products and their sources and may be obtained by contacting:

Standards Engineer  
 Traffic Operations Division - TE  
 Texas Department of Transportation  
 125 East 11th Street  
 Austin, Texas 78701-2483  
 Phone (512) 416-3120  
 Fax (512) 416-3299

Instructions to locate the "CWZTCD" on TxDOT website are:

Start at website - [www.dot.state.tx.us](http://www.dot.state.tx.us)  
 Click on "About TxDOT",  
 Click on "Organizational Chart",  
 Click on Traffic Operations Box,  
 Click on "Compliant Work Zone Traffic Control Devices",  
 Click on "View PDF".  
 This site is printable.

**STANDARD PLANS**  
 Texas Department of Transportation  
 Traffic Operations Division

**BARRICADE AND CONSTRUCTION  
 TYPE III BARRICADE  
 & CONES STANDARD**

9 of 12 BC(9)-03

TxDOT 11-4-02		DIV - BAS	EX - GRB	DIV - FDN	EX - CAL
STATE DISTRICT	FEDERAL PROJECT	FEDERAL AID PROJECT		SHEET	
6				T218	
COUNTY	CONTROL	SECTION	JOB	HIGHWAY	

LEVELS DISPLAYED  
 1 2 3 4 5 6 7 8 9 10 11 12 13 14 15 16 17 18 19 20 21 22 23 24 25 26 27 28 29 30 31 32  
 ACC: 33 34 35 36 37 38 39 40 41 42 43 44 45 46 47 48 49 50 51 52 53 54 55 56 57 58 59 60 61 62 63

DISCLAIMER  
 The use of this standard is governed by the "Texas Engineering Practice Act". No warranty of any kind is made by TxDOT for any purpose whatsoever. TxDOT assumes no responsibility for the conversion of this standard to other formats or for incorrect results or damages resulting from its use.

## WORK ZONE PAVEMENT MARKINGS

### GENERAL

- The Contractor shall be responsible for maintaining work zone and existing pavement markings, in accordance with the standard specifications and special provisions, on all roadways open to traffic within the CSJ limits unless otherwise stated in the plans.
- Color, patterns and dimensions shall be in conformance with the "Texas Manual on Uniform Traffic Control Devices" (TMUTCD).
- Additional supplemental pavement marking details may be found in the plans or specifications.
- Pavement markings shall be installed in accordance with the TMUTCD and as shown on the plans.
- When short term markings are required on the plans, short term markings shall conform with the TMUTCD, the plans and details as shown on the Standard Plan Sheet WZ(STPM).
- When standard pavement markings are not in place and the roadway is opened to traffic, DO NOT PASS signs shall be erected to mark the beginning of the sections where passing is prohibited and the sections where passing is permitted.
- All work zone pavement markings shall be installed in accordance with Item 662, "Work Zone Pavement Markings."

### RAISED PAVEMENT MARKERS

- Raised pavement markers are to be placed according to the patterns on BC(11).
- All raised pavement markers used for work zone markings shall meet the requirements of Item 672, "RAISED PAVEMENT MARKERS" and Departmental Material Specification DMS-4200 or DMS-4300.
- A list of prequalified reflective raised pavement markers can be found at the following web site:  
ftp://ftp.dot.state.tx.us/pub/txdot-info/gsd/pdf/dms4200preq.pdf
- A list of prequalified non-reflective traffic buttons can be found at the following web site:  
ftp://ftp.dot.state.tx.us/pub/txdot-info/gsd/pdf/4300preq.pdf

### PREFABRICATED PAVEMENT MARKINGS

- Removable prefabricated pavement markings shall meet the requirements of DMS-8241. A list of prequalified products can be found at the following web site:  
ftp://ftp.dot.state.tx.us/pub/txdot-info/gsd/pdf/pavemark.pdf
- Non-removable prefabricated pavement markings (foil back) shall meet the requirements of DMS-8240 or the TXDOT Purchase Specification No. 550-74-89. A list of prequalified products and a copy of the TXDOT Purchase Specifications can be found at web sites:  
ftp://ftp.dot.state.tx.us/pub/txdot-info/gsd/pdf/pavement.pdf  
ftp://ftp.dot.state.tx.us/pub/txdot-info/gsd/pdf/tss/tss377.pdf


### MAINTAINING WORK ZONE PAVEMENT MARKINGS

- The Contractor will be responsible for maintaining work zone pavement markings within the work limits.
- Work zone pavement markings shall be inspected in accordance with the frequency and reporting requirements of work zone traffic control device inspections as required by Form 599.
- The markings should provide a visible reference for a minimum distance of 300 feet during normal daylight hours and 150 feet when illuminated by automobile low-beam headlights at night, unless sight distance is restricted by roadway geometrics.
- Markings failing to meet this criteria shall be replaced as required by the Engineer at the expense of the Contractor.

### REMOVAL OF PAVEMENT MARKINGS

- Pavement markings that are no longer applicable, could create confusion or direct a motorist toward or into the closed portion of the roadway, shall be removed or obliterated before the roadway is opened to traffic.
- The above shall not apply to detours in place for less than two weeks, where flaggers and/or sufficient channelizing devices are used in lieu of markings to outline the detour route.
- Pavement markings shall be removed to the fullest extent possible, so as not to leave a discernible marking, by any method that does not materially damage the surface or texture of the pavement.
- The removal of pavement markings may require resurfacing or seal coating portions of the roadway.
- Subject to the approval of the Engineer, any method that proves to be successful on a particular type pavement may be used.
- Blast cleaning may be used but will not be required unless specifically shown in the plans.
- Over-painting of the markings SHALL NOT BE permitted.
- Removal of raised pavement markers shall be as directed by the Engineer.
- Removal of existing pavement markings and markers will be paid for directly in accordance with Item 677, "ELIMINATING EXISTING PAVEMENT MARKINGS AND MARKERS," unless otherwise stated in the plans.

## Temporary Flexible-Reflective Roadway Marker Tabs

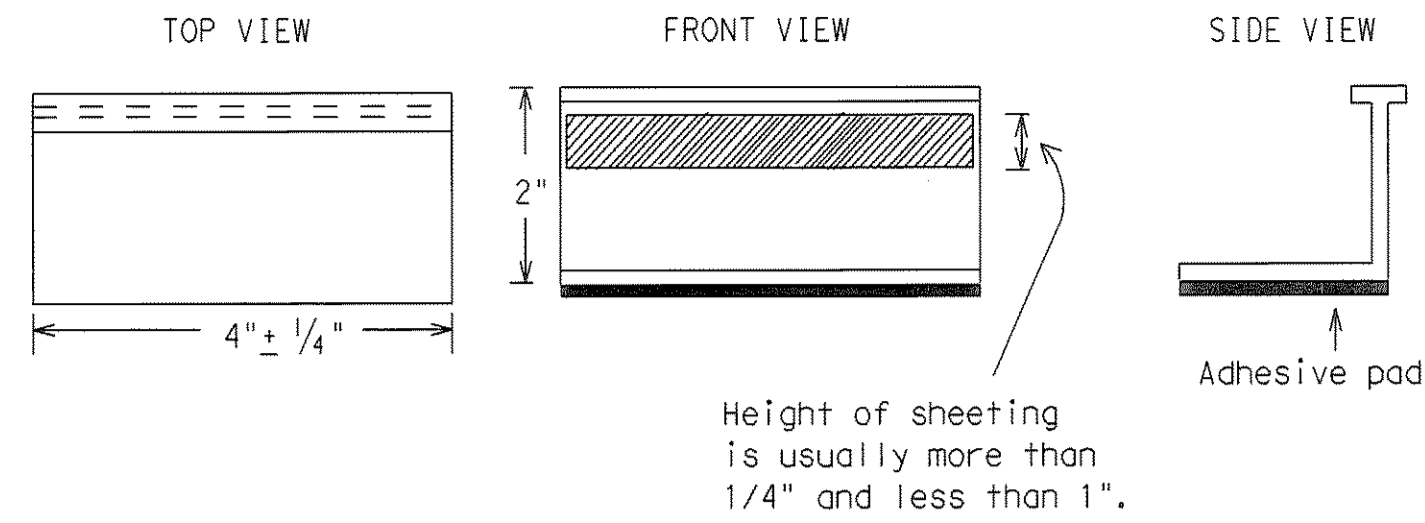

**STAPLES OR NAILS SHALL NOT BE USED TO SECURE  
 TEMPORARY FLEXIBLE-REFLECTIVE ROADWAY MARKER  
 TABS TO THE PAVEMENT SURFACE**

- Temporary flexible-reflective roadway marker tabs used as guidemarks shall meet the requirements of DMS-8242.
- Tabs detailed on this sheet are to be inspected and accepted by the Engineer or designated representative. Sampling and testing is not normally required, however at the option of the Engineer, either "A" or "B" below may be imposed to assure quality before placement on the roadway.
  - Select five (5) or more tabs at random from each lot or shipment and submit to the Construction Division, Materials and Pavement Section to determine specification compliance.
  - Select five (5) tabs and perform the following test. Affix five (5) tabs at 24 inch intervals on an asphaltic pavement in a straight line. Using a medium size passenger vehicle or pickup, run over the markers with the front and rear tires at a speed of 35 to 40 miles per hour, four (4) times in each direction. No more than one (1) out of the five (5) reflective surfaces shall be lost or displaced as a result of this test.
- Small design variances may be noted between tab manufacturers.

## Raised Pavement Markers used as Guidemarks

- Raised pavement markers used as guidemarks shall be from the approved product list, and meet the requirements of DMS-4200.
- All temporary construction raised pavement markers provided on a project shall be of the same manufacturer.
- Adhesive for guidemarks shall be bituminous material hot applied or butyl rubber pad for all surfaces, or thermoplastic for concrete surfaces.

Guidemarks shall be designated as:

- YELLOW - (two amber reflective surfaces with yellow body).
- WHITE - (one silver reflective surface with white body).

### DEPARTMENTAL MATERIAL SPECIFICATIONS

PAVEMENT MARKERS (REFLECTORIZED)	DMS-4200
TRAFFIC BUTTONS	DMS-4300
EPOXY AND ADHESIVES	DMS-6100
BITUMINOUS ADHESIVE FOR PAVEMENT MARKERS	DMS-6130
PREFABRICATED PAVEMENT MARKINGS-PERMANENT	DMS-8240
PREFABRICATED PAVEMENT MARKINGS-REMOVABLE	DMS-8241
TEMPORARY FLEXIBLE-REFLECTIVE ROADWAY MARKER TABS	DMS-8242

**Only pre-qualified products shall be used. A copy of the  
 "Compliant Work Zone Traffic Control Devices List" (CWZTCD)  
 describes pre-qualified products and their sources and may be  
 obtained by contacting:**

**Standards Engineer  
 Traffic Operations Division - TE  
 Texas Department of Transportation  
 125 East 11th Street  
 Austin, Texas 78701-2483  
 Phone (512) 416-3120  
 Fax (512) 416-3299**

**Instructions to locate the "CWZTCD" on TxDOT website are:**

**Start at website - [www.dot.state.tx.us](http://www.dot.state.tx.us)  
 Click on "About TxDOT",  
 Click on "Organizational Chart",  
 Click on Traffic Operations Box,  
 Click on "Compliant Work Zone Traffic Control Devices",  
 Click on "View PDF".  
 This site is printable.**

**RECORD PLANS  
 MARCH 28, 2008**

**STANDARD PLANS**  
 Texas Department of Transportation  
 Traffic Operations Division

**BARRICADE AND CONSTRUCTION  
 PAVEMENT MARKINGS  
 STANDARD**

**10 of 12 BC(10)-03**


© TxDOT February 1998		Dist - LR	Chg - DTN	Dist - FDN	Chg - CAL
REVISIONS	STATE DISTRICT	FEDERAL REGION	FEDERAL AID PROJECT		SHEET
1-97		6			<b>T219</b>
2-98			COUNTY	CONTROL SECTION JOB	
1-02					
11-02					

DISCLAIMER  
 This standard is governed by the "Texas Engineering Practice Act". No warranty of any kind is made by TxDOT for any purpose whatsoever. TxDOT assumes no responsibility for the conversion of this standard to other formats or for incorrect results or damages resulting from its use.

LEVELS DISPLAYED  
 1 2 3 4 5 6 7 8 9 10 11 12 13 14 15 16  
 ACC:  
 17 18 19 20 21 22 23 24 25 26 27 28 29 30 31 32  
 33 34 35 36 37 38 39 40 41 42 43 44 45 46 47 48  
 49 50 51 52 53 54 55 56 57 58 59 60 61 62 63


## PAVEMENT MARKING PATTERNS

### CENTER LINE & NO-PASSING ZONE BARRIER LINES FOR TWO-LANE, TWO-WAY HIGHWAYS

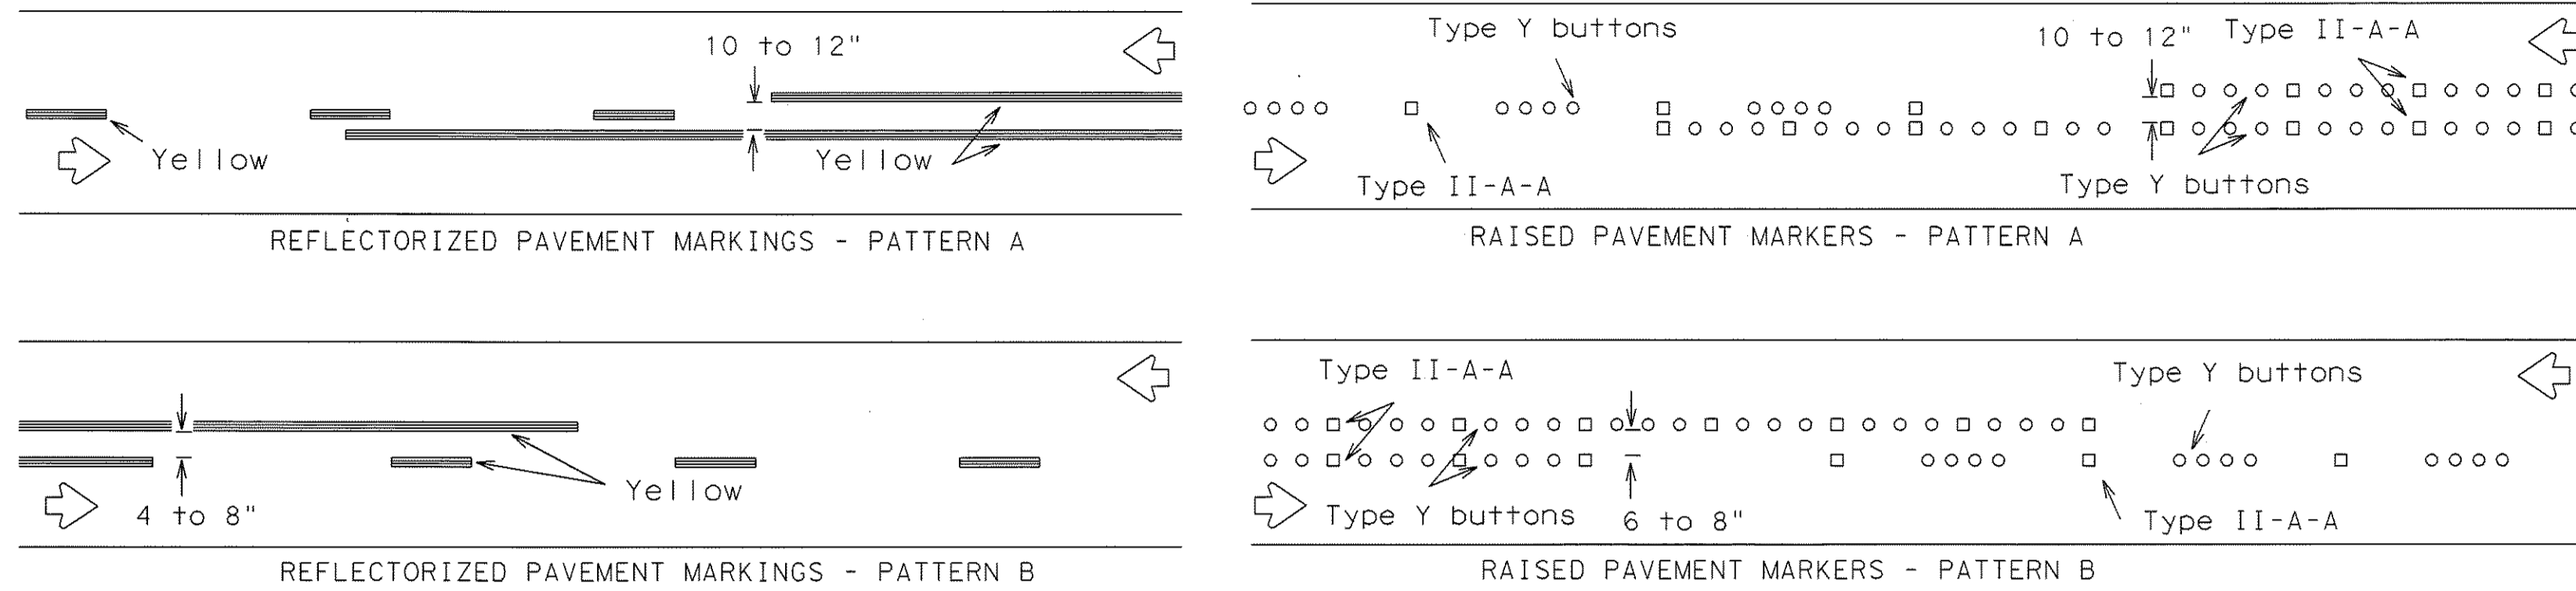


Pattern A is the TxDOT Standard, however Pattern B may be used if approved by the Engineer. Prefabricated markings may be substituted for reflectorized pavement markings.

### EDGE & LANE LINES FOR DIVIDED HIGHWAY

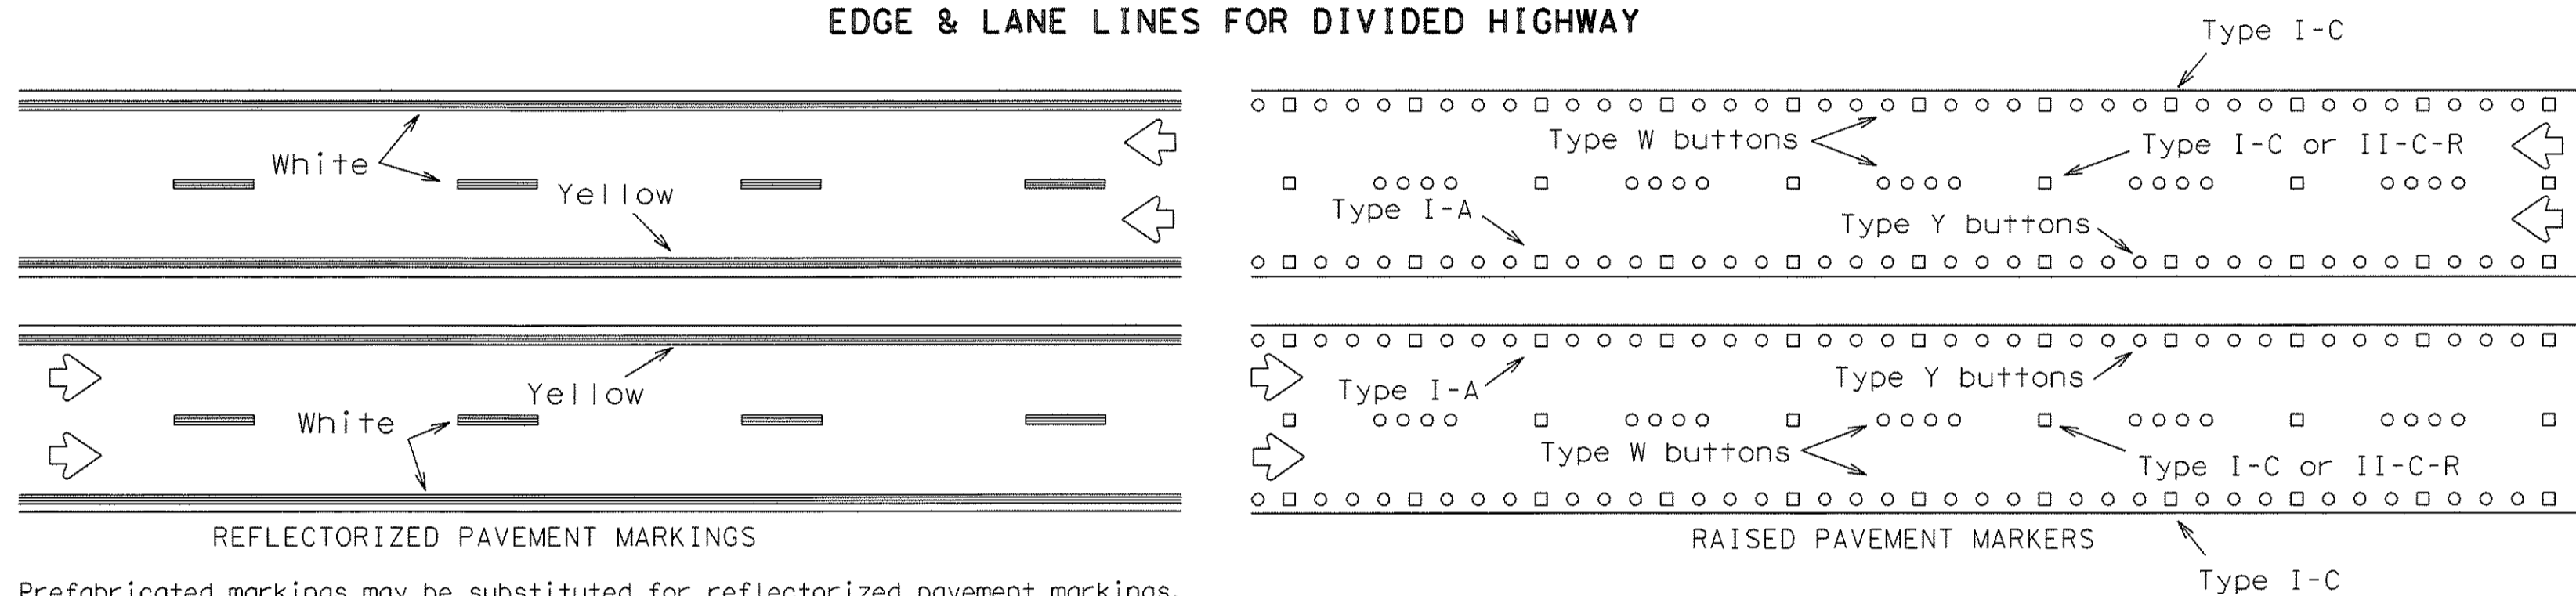


Prefabricated markings may be substituted for reflectorized pavement markings.

### LANE & CENTER LINES FOR MULTILANE UNDIVIDED HIGHWAYS

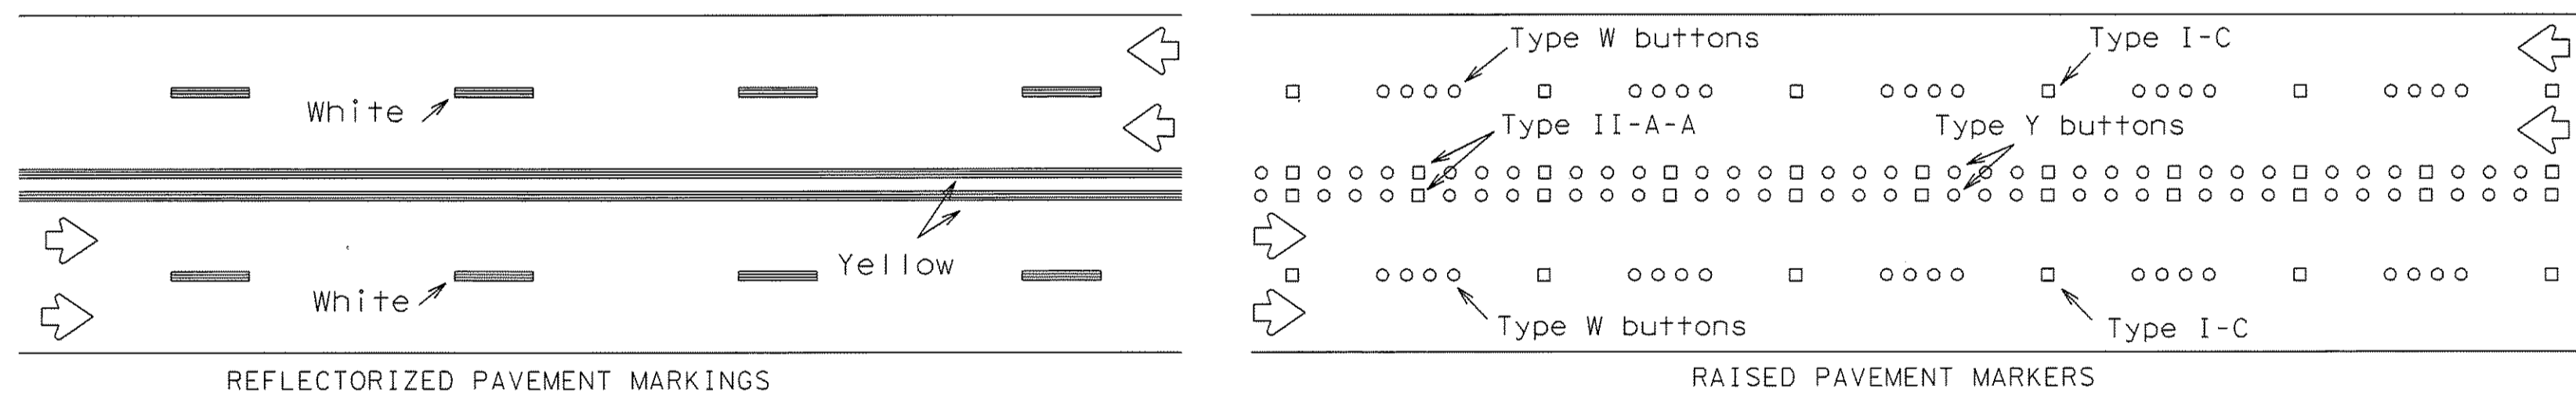

Prefabricated markings may be substituted for reflectorized pavement markings.


### TWO-WAY LEFT TURN LANE

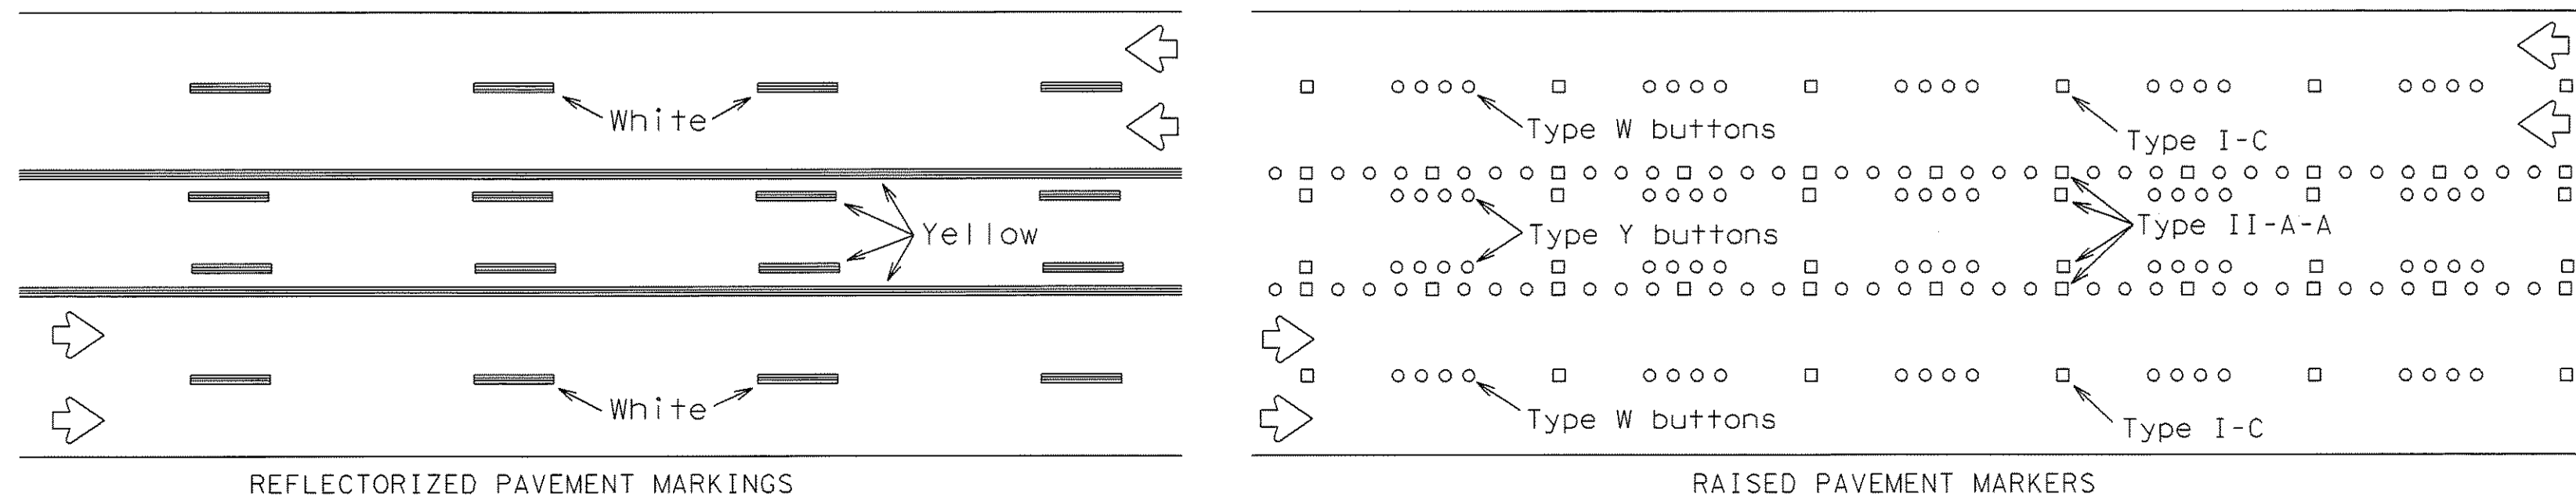

Prefabricated markings may be substituted for reflectorized pavement markings.

RECORD PLANS  
MARCH 28, 2008

## STANDARD WORK ZONE PAVEMENT MARKINGS DETAILS

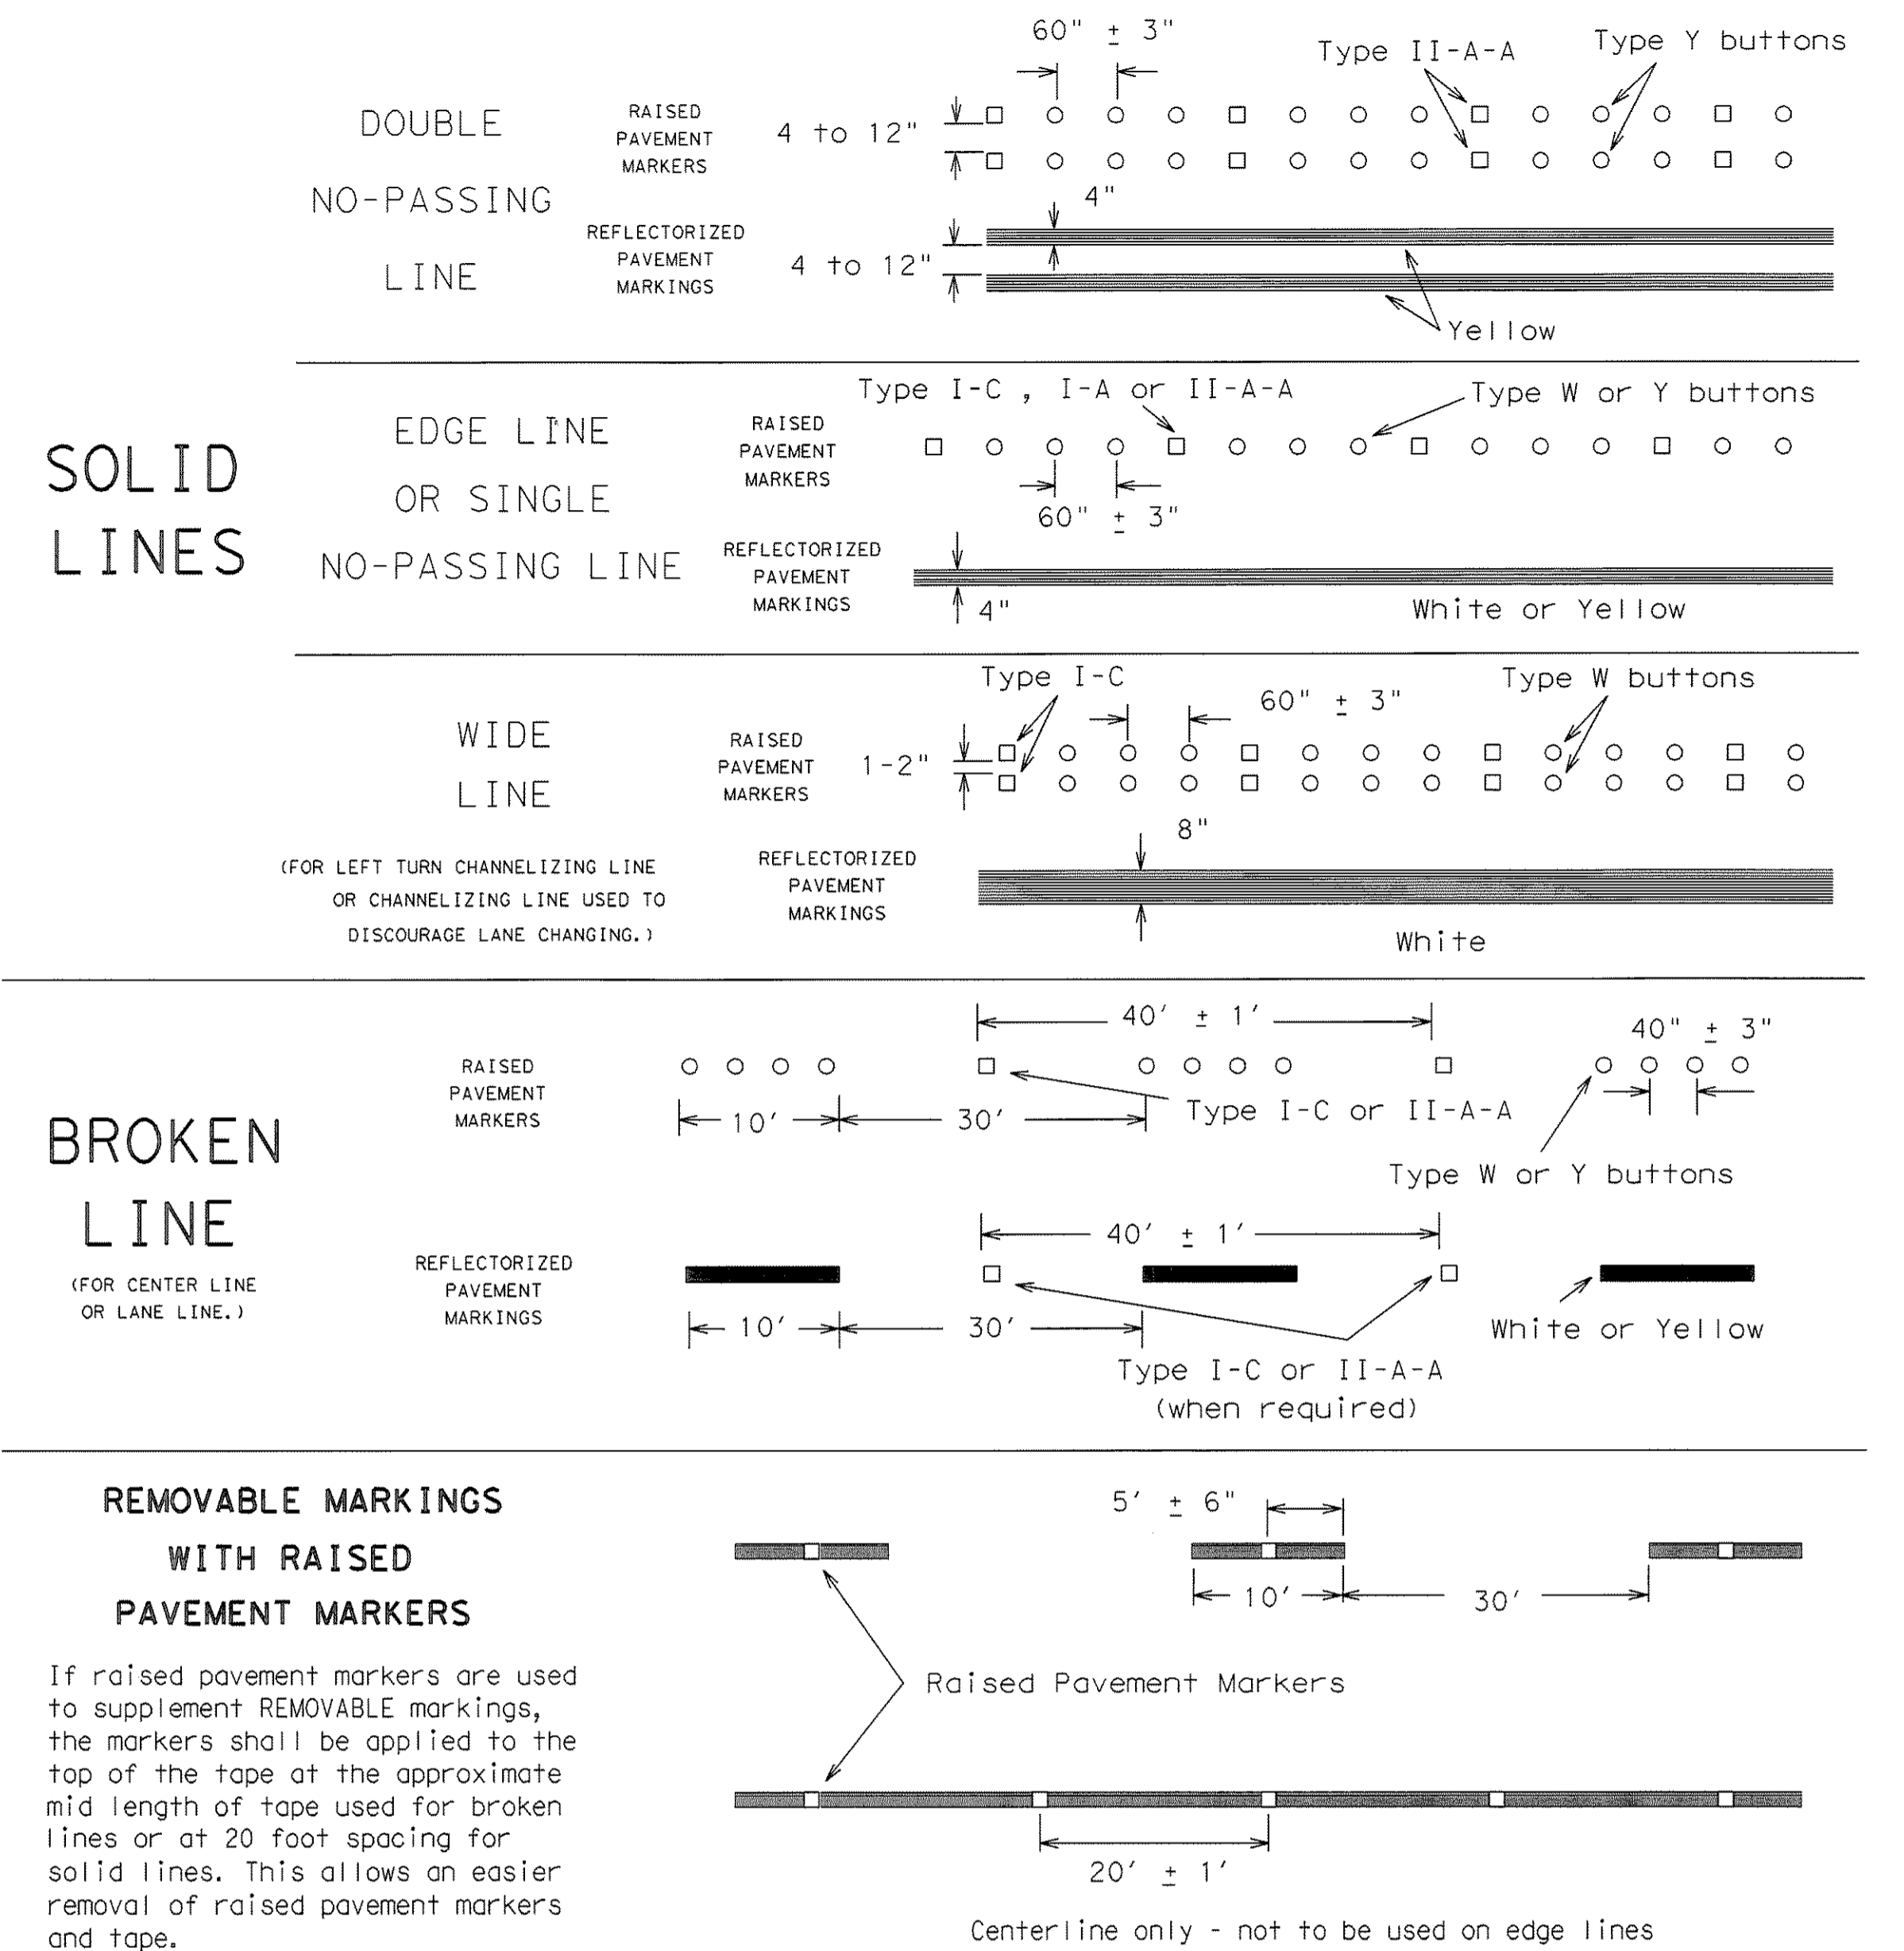

Only pre-qualified products shall be used. A copy of the "Compliant Work Zone Traffic Control Devices List" (CWZTCD) describes pre-qualified products and their sources and may be obtained by contacting:

Standards Engineer  
 Traffic Operations Division - TE  
 Texas Department of Transportation  
 125 East 11th Street  
 Austin, Texas 78701-2483  
 Phone (512) 416-3120  
 Fax (512) 416-3299

Instructions to locate the "CWZTCD" on TxDOT website are:

Start at website - [www.dot.state.tx.us](http://www.dot.state.tx.us)  
 Click on "About TxDOT",  
 Click on "Organizational Chart",  
 Click on Traffic Operations Box,  
 Click on "Compliant Work Zone Traffic Control Devices",  
 Click on "View PDF".  
 This site is printable.

Raised pavement markers used as standard pavement markings shall be from the approved products list and meet the requirements of Item "RAISED PAVEMENT MARKERS."

STANDARD PLANS  
 Texas Department of Transportation  
 Traffic Operations Division

## BARRICADE AND CONSTRUCTION PAVEMENT MARKING PATTERNS STANDARD

11 of 12 BC(11)-03

REVISED	DATE	BY	REASON
2-94			
1-97			
2-98			
11-02			


FEDERAL AID PROJECT

COUNTY CONTROL SECTION JOB HIGHWAY


SHEET T220

DISCLAIMER


This standard is governed by the "Texas Engineering Practice Act". No warranty of any kind is made by TxDOT for any purpose whatsoever. TxDOT assumes no responsibility for the conversion of this standard to other formats or for incorrect results or damages resulting from its use.

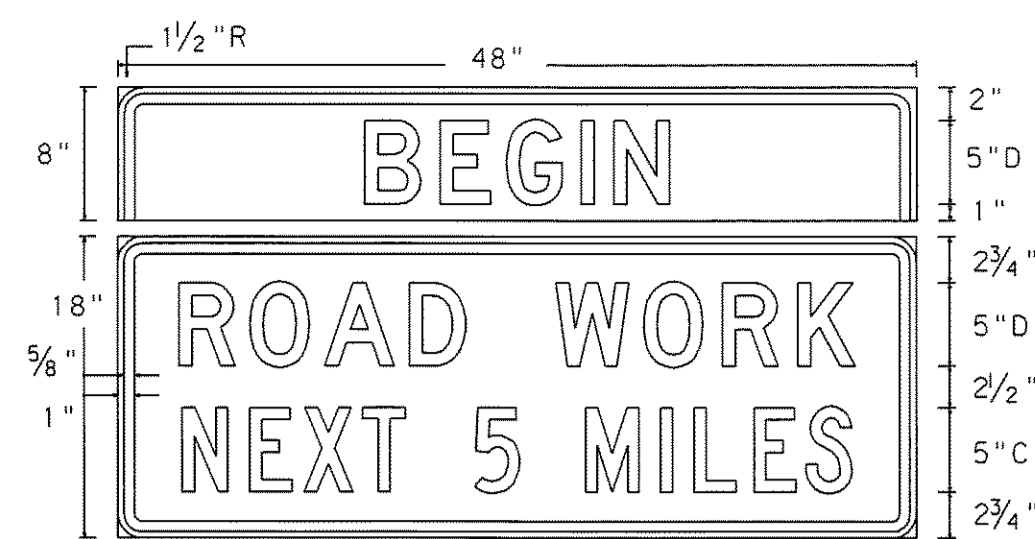

**SG20-1 w/plaque**  
48" X 26"  
Letters - Black  
Numbers - Black  
Border - Black  
Background - Orange Refl.

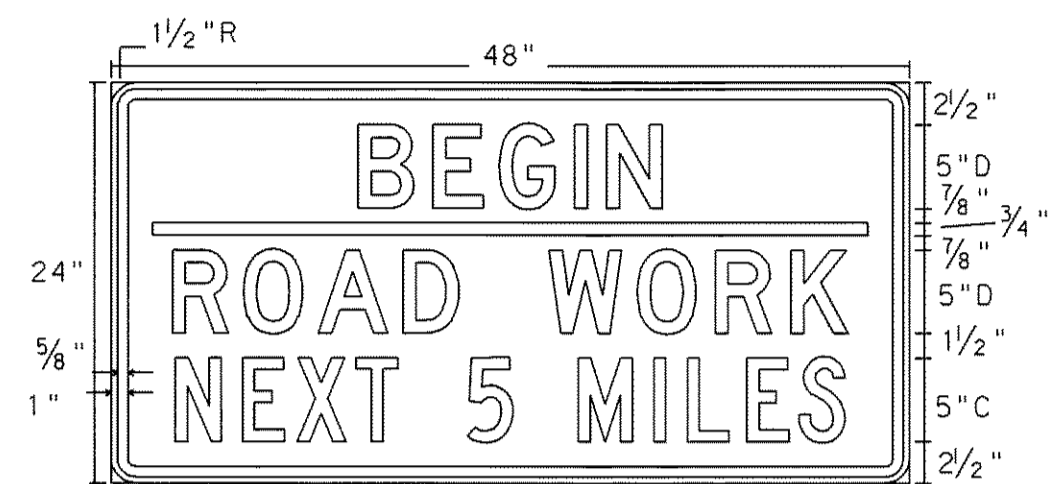


**SG20-5T**  
48" X 24"  
Letters - Black  
Numbers - Black  
Border - Black  
Background - Orange Refl.

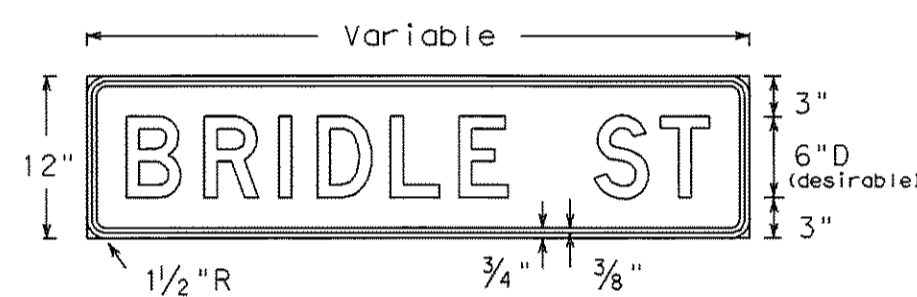


**M4-9N**  
Variable X 12"  
Letters - Black  
Border - Black  
Background - Orange Refl.


The M4-9R, L or S sign is to be used to detour local streets or roads that are not a State or Federal numbered highway; however, it should not be used in lieu of the M4-10 sign at the beginning of the detour or to detour State or Federal numbered routes. Also, when the M4-9R, L or S sign is used, a sign (M4-9N) with the name of the street being detoured may be mounted above it.

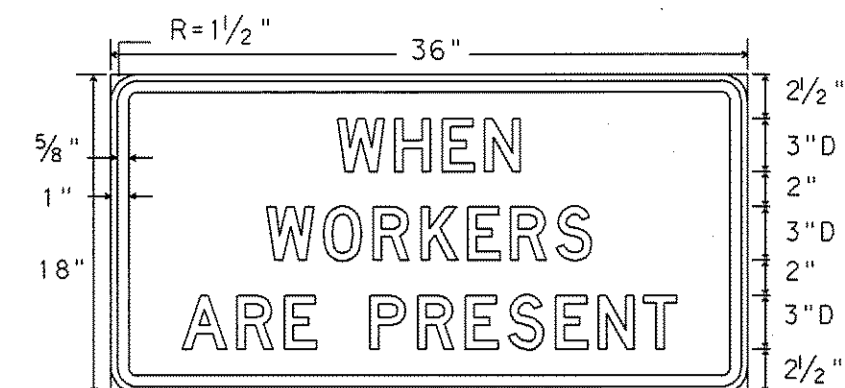

**ER20-5 Plaque**  
36" X 18"  
Letters - Black  
Border - Black  
Background - White Refl.

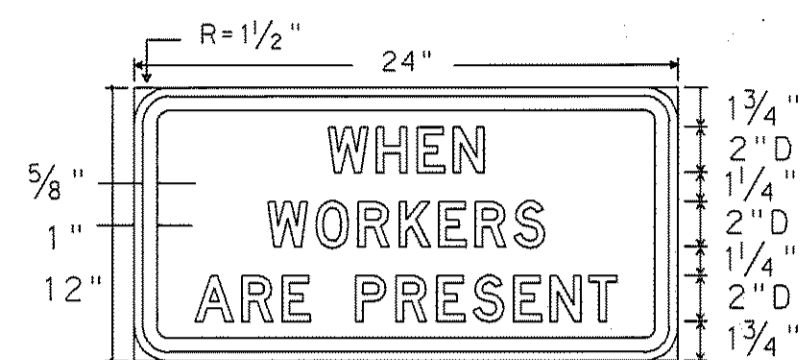


**R20-5 Plaque**  
24" X 12"  
Letters - Black  
Border - Black  
Background - White Refl.

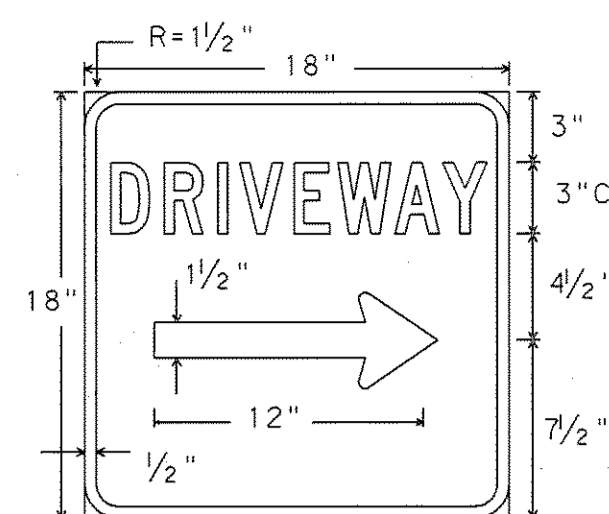


**D-70a**  
18" X 18"



Letters - White Refl.  
Symbol - White Refl.  
Border - White Refl.  
Background - Blue Refl.

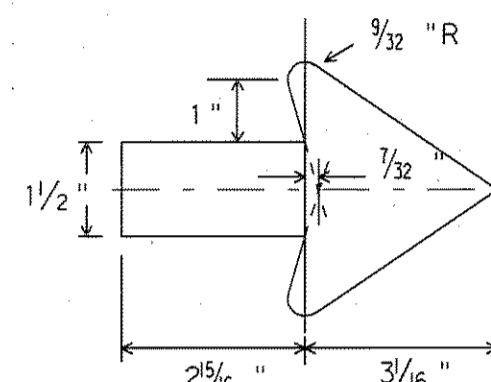


B-1 Arrow Detail

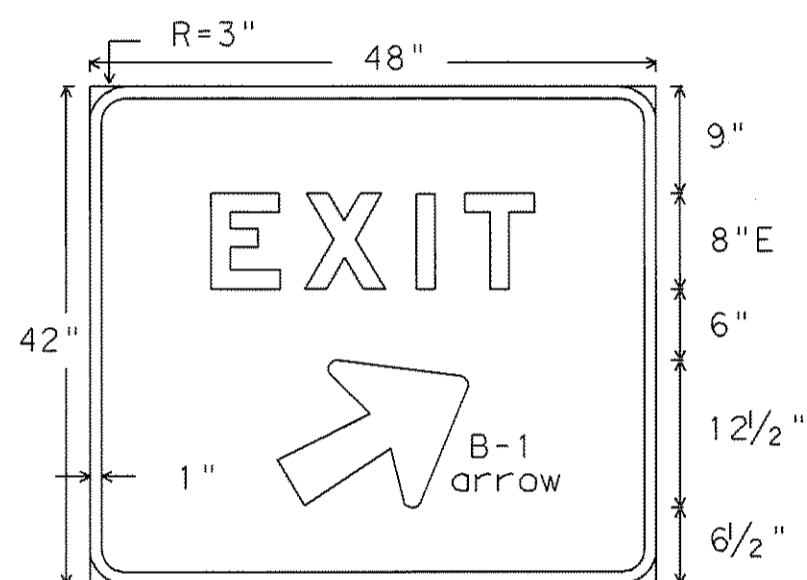


**E5-1a**  
48" X 42"  
Letters - White Refl.  
Arrow - White Refl.  
Border - White Refl.  
Background - Green Refl.

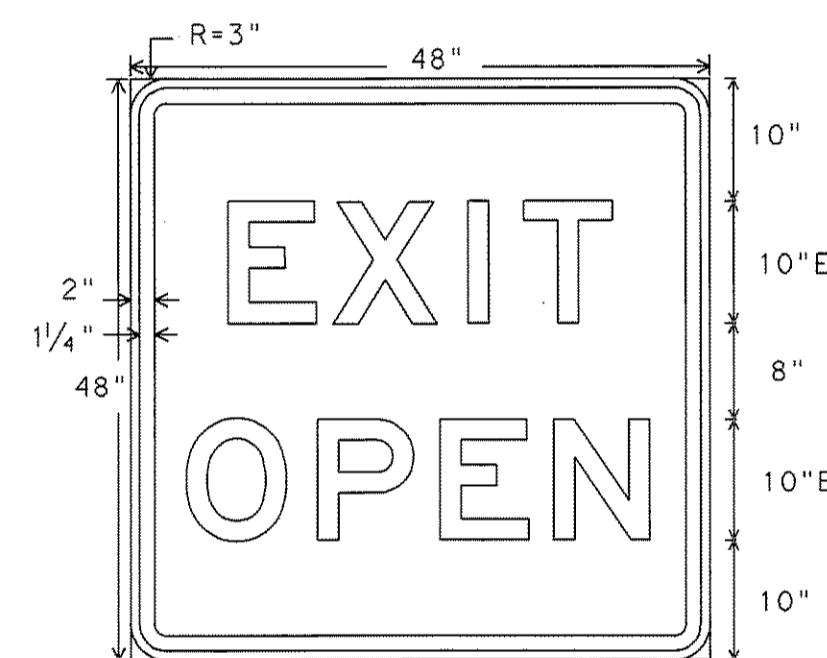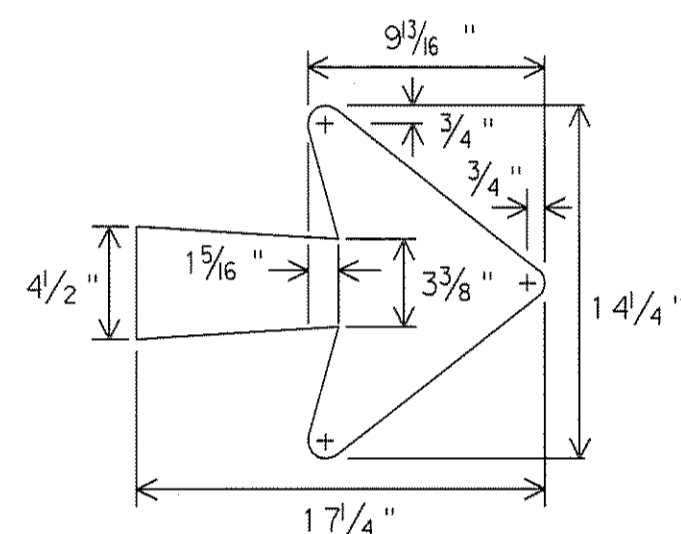

**E5-2**  
48" X 48"  
Letters - Black  
Border - Black  
Background - Orange Refl.

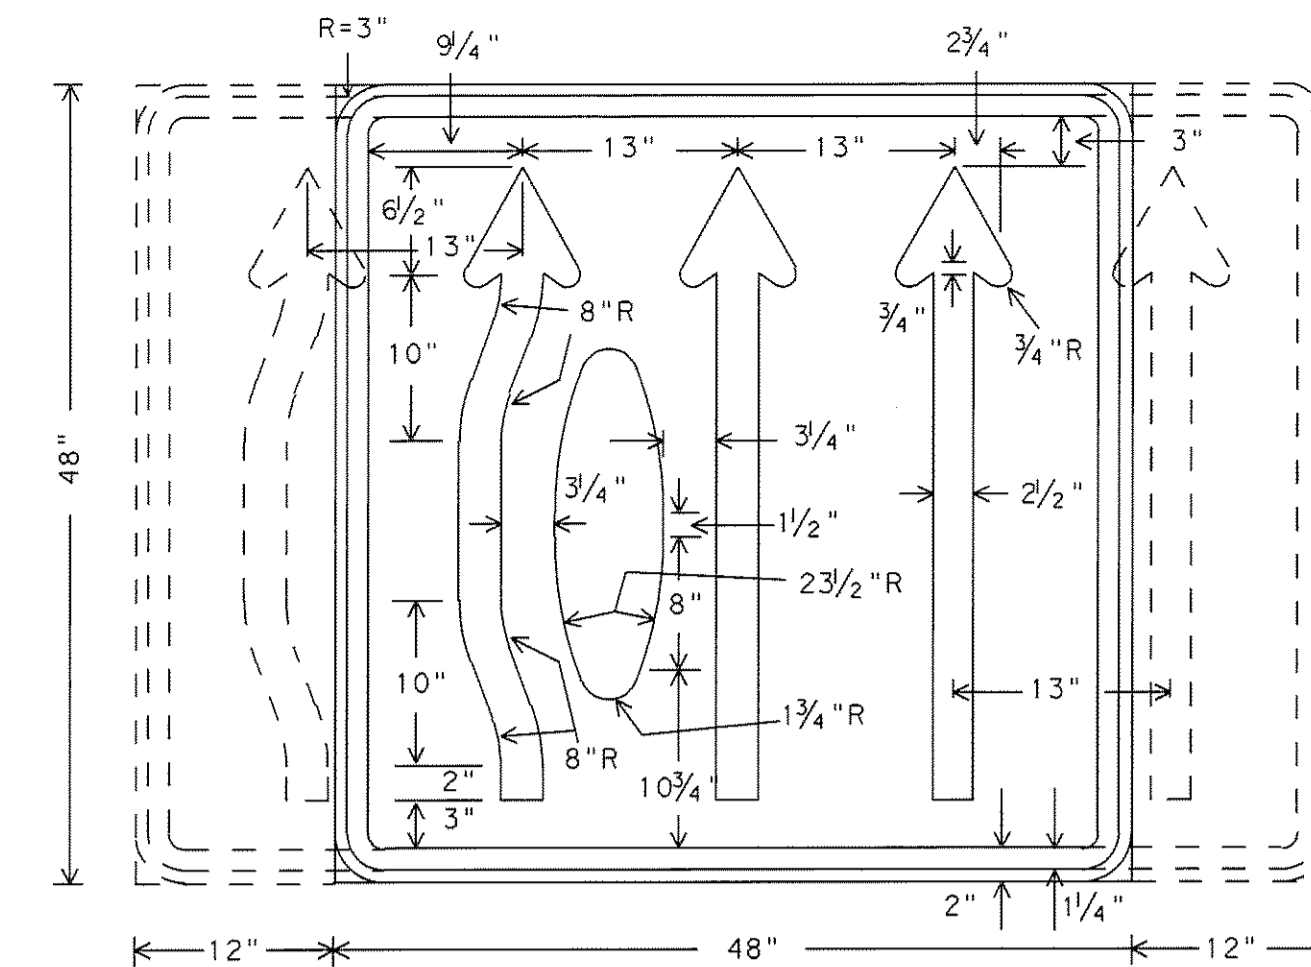

**CW24-2**  
Var. X 48"  
A mirror image may be used to show proper lane alignment.

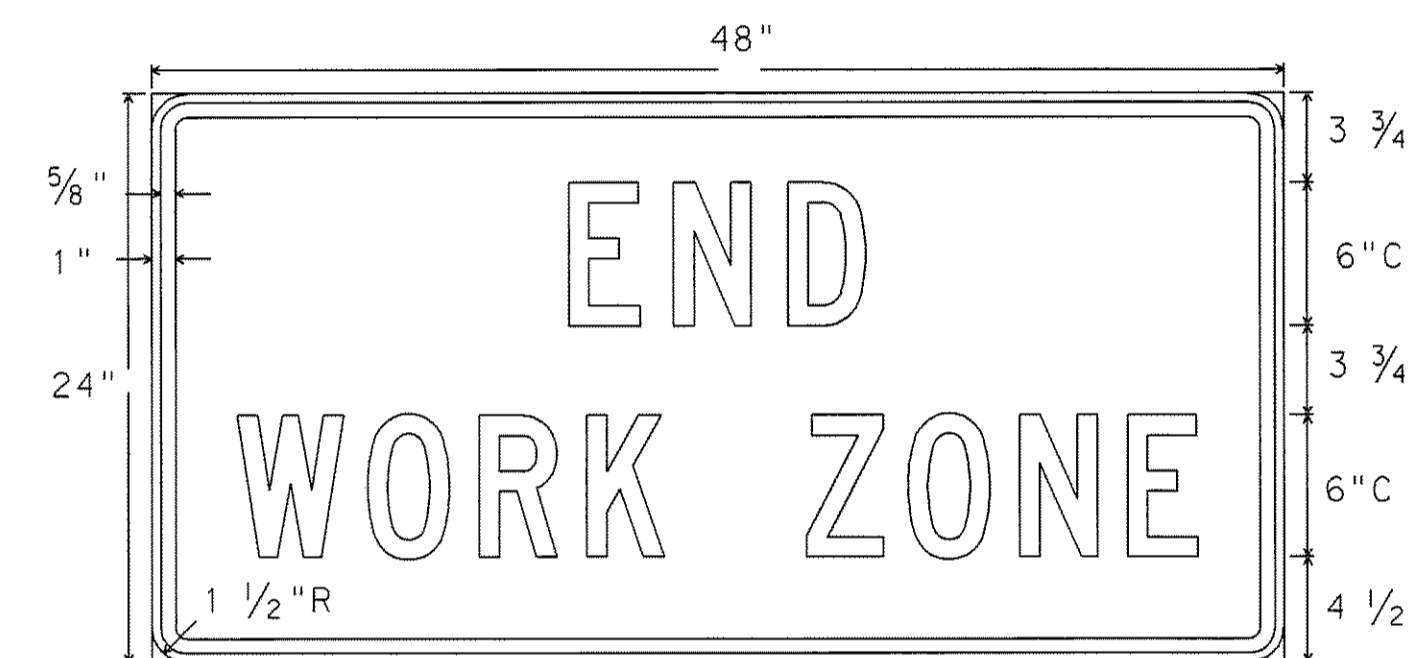

**G20-2b**  
48" X 24"  
Letters - Black  
Border - Black  
Background - Orange Refl.

DEPARTMENT MATERIAL SPECIFICATIONS	
PLYWOOD SIGN BLANKS	DMS-7100
ALUMINUM SIGN BLANKS	DMS-7110
FLAT SURFACE REFLECTIVE SHEETING	DMS-8300
VINYL NON-REFLECTIVE DECAL SHEETING	DMS-8320


REFLECTIVE SHEETING OR OTHER MATERIAL		
COLOR	USAGE	
BLUE	BACKGROUND	TYPE C (HIGH SPECIFIC INTENSITY)
RED	BACKGROUND	TYPE C (HIGH SPECIFIC INTENSITY)
GREEN	BACKGROUND	TYPE C (HIGH SPECIFIC INTENSITY)
ORANGE	BACKGROUND	TYPE E (FLUORESCENT PRISMATIC)
WHITE	BACKGROUND	TYPE C (HIGH SPECIFIC INTENSITY)
YELLOW	BACKGROUND	TYPE C (HIGH SPECIFIC INTENSITY)
BLACK	LEGEND & BORDERS	VINYL NON-REFLECTIVE DECAL SHEETING
WHITE	LEGEND & BORDERS	TYPE C (HIGH SPECIFIC INTENSITY)

Only pre-qualified products shall be used. A copy of the "Compliant Work Zone Traffic Control Devices List" (CWZTCD) describes pre-qualified products and their sources and may be obtained by contacting:


Standards Engineer  
Traffic Operations Division - TE  
Texas Department of Transportation  
125 East 11th Street  
Austin, Texas 78701-2483  
Phone (512) 416-3120  
Fax (512) 416-3299

Instructions to locate the "CWZTCD" on TxDOT website are:

Start at website - [www.dot.state.tx.us](http://www.dot.state.tx.us)  
Click on "About TxDOT",  
Click on "Organizational Chart",  
Click on Traffic Operations Box,  
Click on "Compliant Work Zone Traffic Control Devices",  
Click on "View PDF".  
This site is printable.

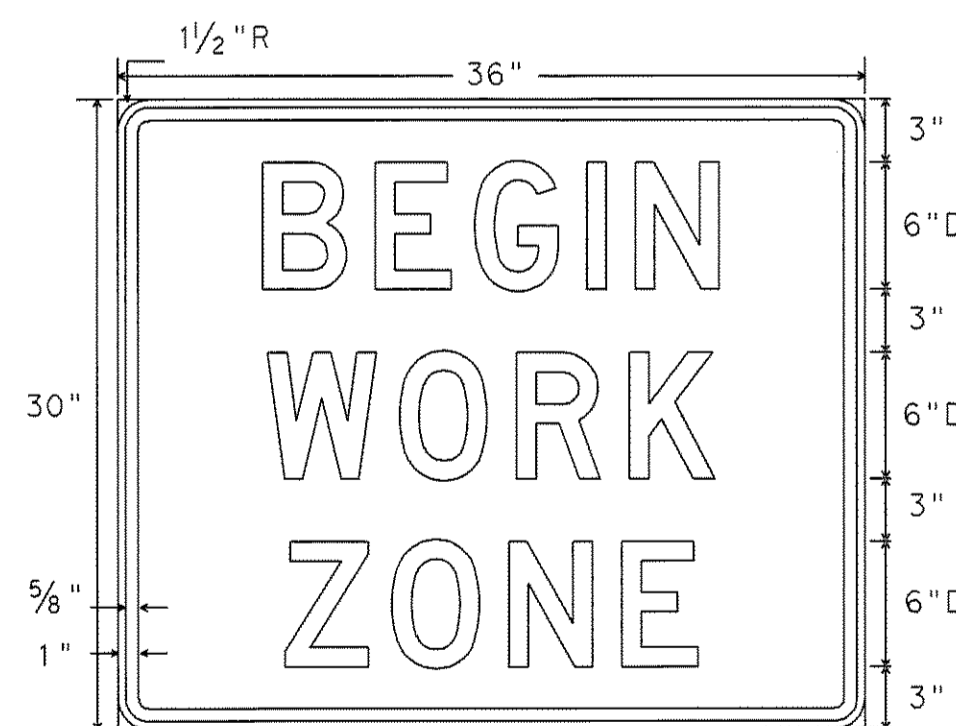

**EG20-9T**  
36" X 30"  
Letters - Black  
Border - Black  
Background - Orange Refl.

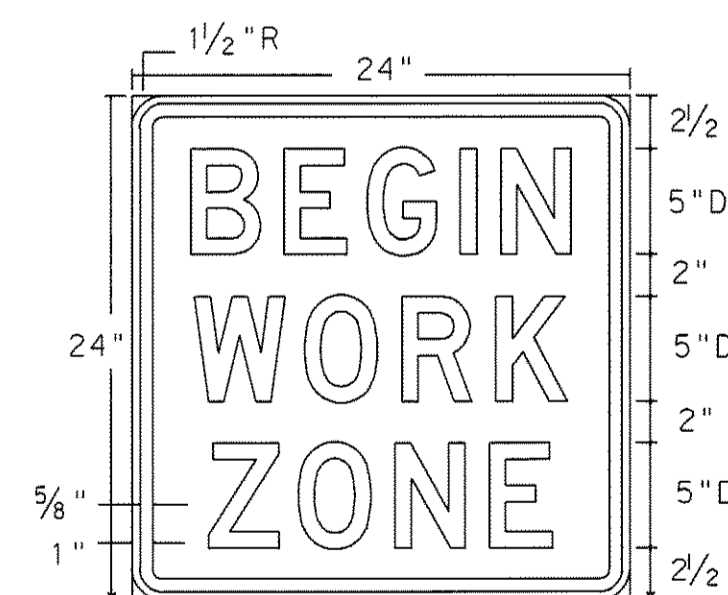

**G20-9T**  
24" X 24"  
Letters - Black  
Border - Black  
Background - Orange Refl.

RECORD PLANS  
MARCH 28, 2008

**STANDARD PLANS**  
Texas Department of Transportation  
Traffic Operations Division

**BARRICADE AND CONSTRUCTION REGULATORY & GUIDE SIGNS STANDARDS**

12 of 12 BC(12)-03

© TxDOT February 1998 DR- GRB CR- BAS DR- FDN CR- CAL

REVISIONS	STATE DISTRICT	FEDERAL REGION	FEDERAL AID PROJECT	SHEET
10-99	6			T221
11-02	COUNTY	CONTROL	SECTION	JOB
				HIGHWAY

LEVELS DISPLAYED:  
1 2 3 4 5 6 7 8 9 10 11 12 13 14 15 16  
17 18 19 20 21 22 23 24 25 26 27 28 29 30 31 32  
33 34 35 36 37 38 39 40 41 42 43 44 45 46 47 48  
49 50 51 52 53 54 55 56 57 58 59 60 61 62 63