

THE CAMBRIDGE COMPANIES, INC. TRUSTEE
VOL. 99, PG. 1022
D.R.R.C.T.

THE CAMBRIDGE COMPANIES, INC. TRUSTEE
VOL. 101, PG. 795
D.R.R.C.T.

ST. STA 48+85
OFF 5.00' LT.
CONSTRUCT STREET LIGHT
BASE PER ONCOR STANDARDS

ST. STA 41+20
OFF 0.00
CONSTRUCT STREET LIGHT
BASE PER ONCOR STANDARDS

ST. STA 44+20
OFF 5.00' RT.
CONSTRUCT STREET LIGHT
BASE PER ONCOR STANDARDS

ST. STA 46+50
OFF 1.00' LT.
CONSTRUCT STREET LIGHT
BASE PER ONCOR STANDARDS

THE CAMBRIDGE COMPANIES, INC. TRUSTEE
VOL. 99, PG. 1022
D.R.R.C.T.


THE CAMBRIDGE COMPANIES, INC. TRUSTEE
VOL. 101, PG. 795
D.R.R.C.T.

S . H . 2 0 5 B Y P A S S




⊕ INDICATES STREET LIGHT BASE

PREPARED BY:
WIA WIER & ASSOCIATES, INC.
ENGINEERS SURVEYORS LAND PLANNERS
4300 BELWAY PLACE SUITE 130 ARLINGTON, TEXAS 76018 METRO (817)467-7700
1300 U.S. HIGHWAY 287 N. SUITE 101 WAXFIELD, TEXAS 76063 METRO (817)477-8700
8949 ELM STREET FRISCO, TEXAS 75034 METRO (214)387-8000
www.wierassociates.com

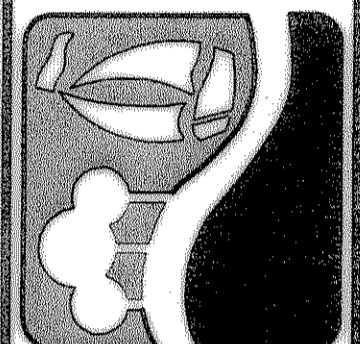

PHASE II S.H. 205 BYPASS
FROM S.H. 276 TO INTERSTATE 30
ILLUMINATION
PLAN
STA 38+50 TO 1-30

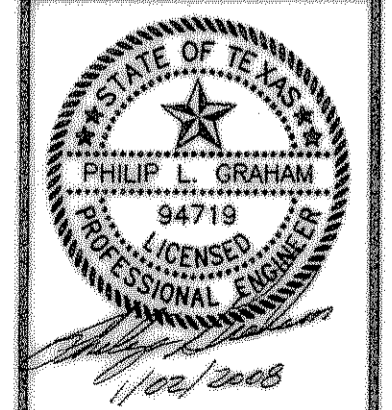

RECORD PLANS
AUGUST 29, 2008

COPYRIGHT ©
WIER & ASSOCIATES, INC.
LAST SHEET EDIT
DATE 01-02-2008
WA# 04141
SHEET NO.
1102

FILE: illum2-Phase2-04141.dwg
TIME: 7:27