
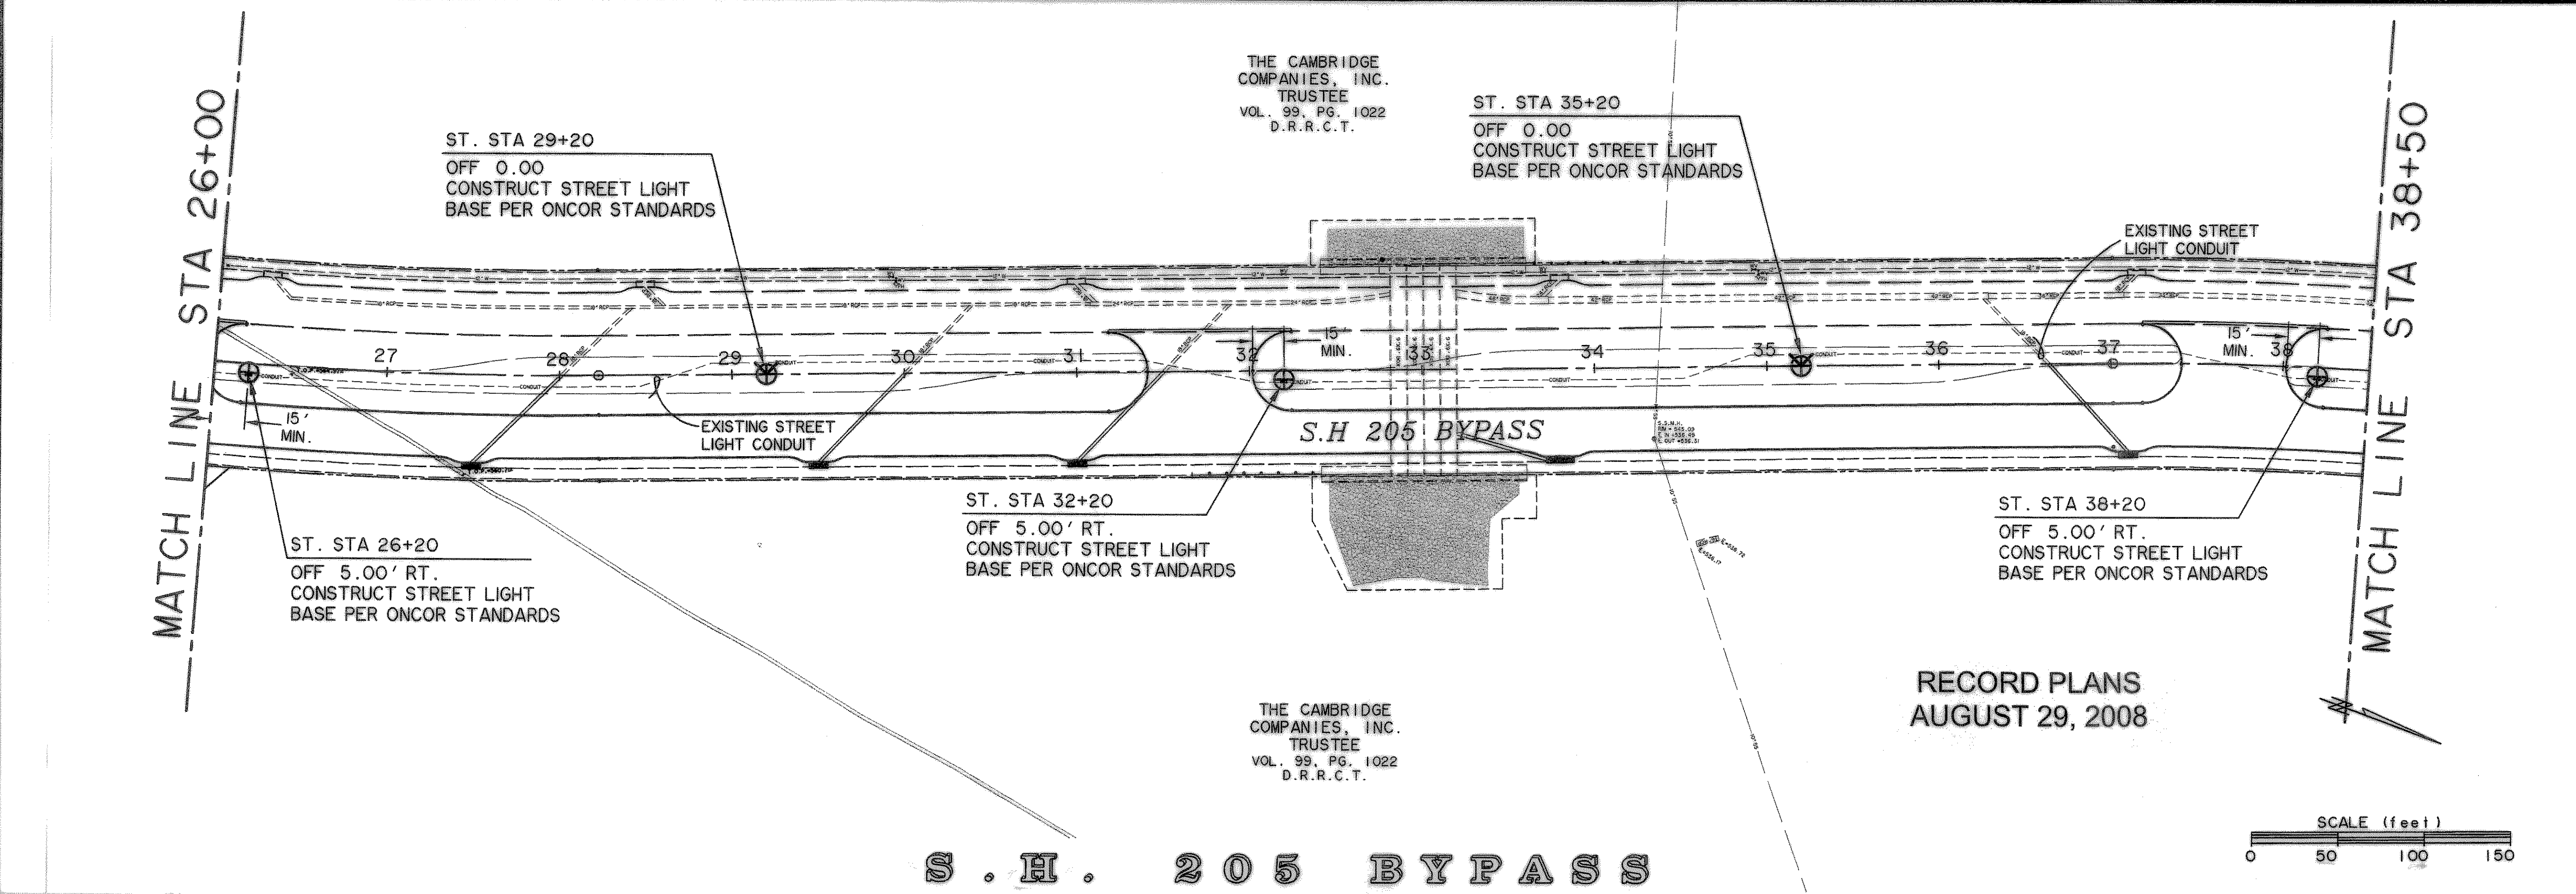


TIME 7:21 FILE: Illum-Phase2-04141.dwg

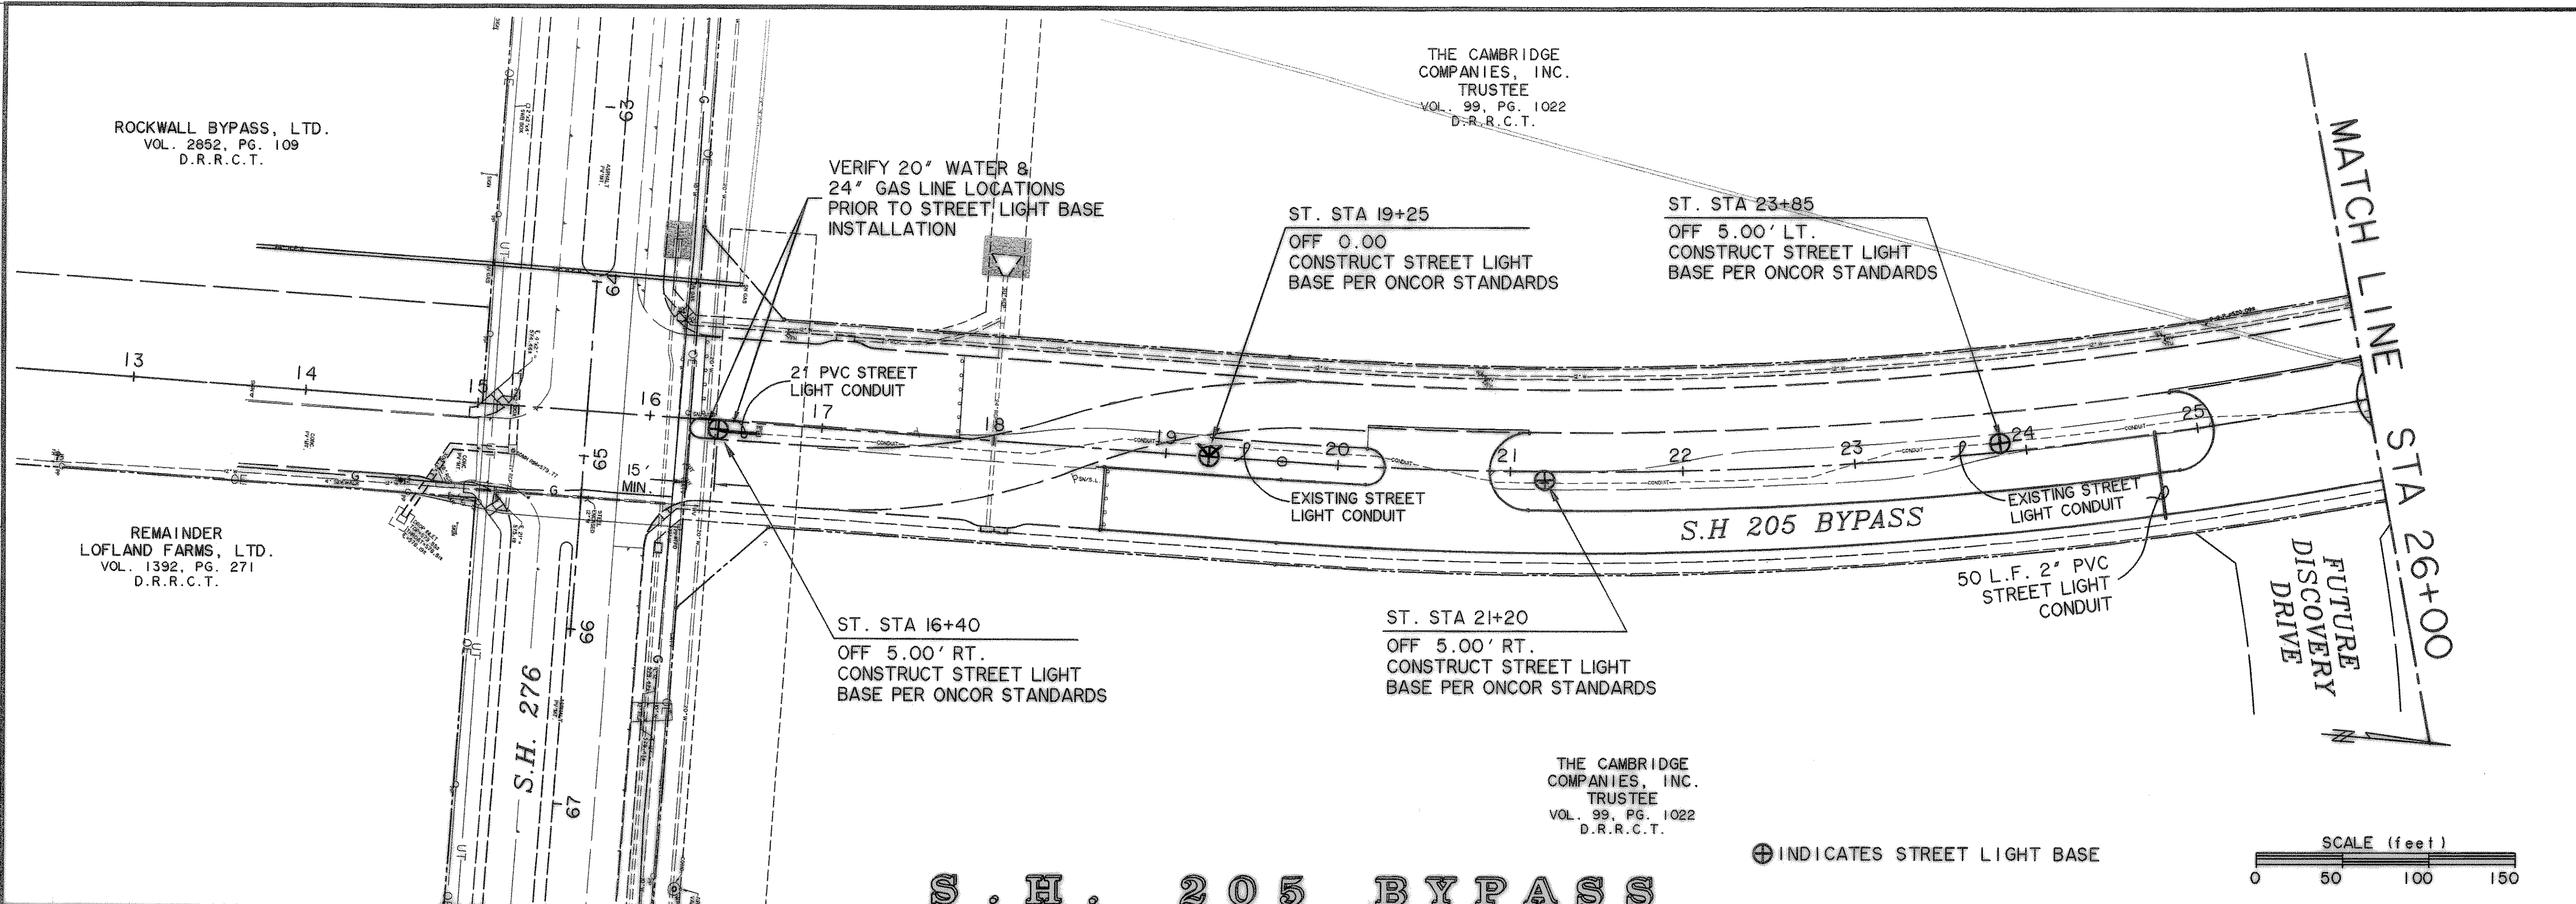

RECORD PLANS
AUGUST 29, 2008


THE CAMBRIDGE COMPANIES, INC.
TRUSTEE
VOL. 99, PG. 1022
D.R.R.C.T.

THE CAMBRIDGE COMPANIES, INC.
TRUSTEE
VOL. 99, PG. 1022
D.R.R.C.T.


THE CAMBRIDGE COMPANIES, INC.
TRUSTEE
VOL. 99, PG. 1022
D.R.R.C.T.

THE CAMBRIDGE COMPANIES, INC.
TRUSTEE
VOL. 99, PG. 1022
D.R.R.C.T.

PREPARED BY:
WIA WIER & ASSOCIATES, INC.
ENGINEERS SURVEYORS LAND PLANNERS
4300 BELTWAY PLACE SUITE 130 ARLINGTON, TEXAS 76018 METRO (817)467-7700
1300 U.S. HIGHWAY 207 N. SUITE 101 WAXFORD, TEXAS 76063 METRO (817)477-6700
6849 ELM STREET FRISCO, TEXAS 75034 METRO (214)397-8000
www.wierassociates.com

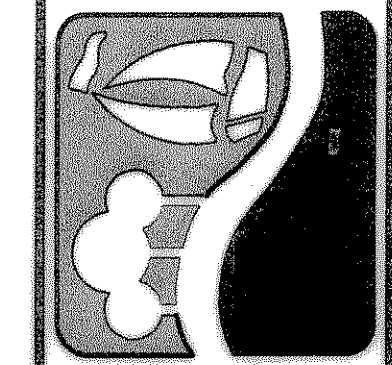

PHASE II S.H. 205 BYPASS
FROM S.H. 276 TO INTERSTATE 30
ILLUMINATION
PLAN
STA 13+50± TO 38+50

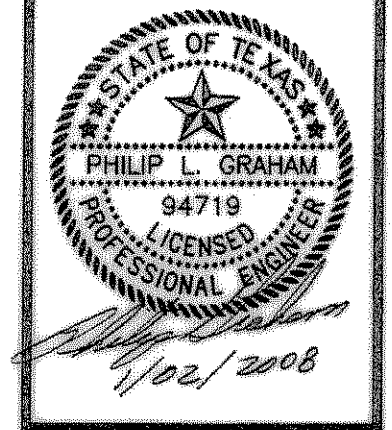

COPYRIGHT ©
WIER & ASSOCIATES, INC.
LAST SHEET EDIT
DATE 01-02-2008
WA# 04141
SHEET NO.
1101