

STABILIZATION PRACTICES

Table with 4 columns: Stabilization Practices, Location On-Site, Implementation Date, Temporary or Permanent.

STABILIZATION PRACTICES MAY INCLUDE, BUT ARE NOT LIMITED TO: ESTABLISHING TEMPORARY OR PERMANENT VEGETATION, MULCHING, GEOTEXTILES, SOD STABILIZATION, VEGETATIVE BUFFER STRIPS, AND PROTECTING EXISTING TREES AND VEGETATION.

STRUCTURAL CONTROL PRACTICES

WILL THE PROJECT DISTURB 10 ACRES OR MORE AT ONE TIME? YES NO

PROJECT IS A LINEAR PROJECT IN WHICH ALL MAJOR DISCHARGE LOCATIONS HAVE LESS THAN 10 ACRES OF DISTURBED AREA DRAINING TO THEM. THE TOTAL PROJECT DISTURBS 12.4 ACRES.

PERMANENT STORM WATER CONTROLS

THE FOLLOWING MEASURES WILL BE CONSTRUCTED TO CONTROL POST-CONSTRUCTION RUNOFF:

Table with 3 columns: Control Measure, Location on Project Site, Control Runoff from What Areas.

VELOCITY DISSIPATION DEVICES

THE FOLLOWING VELOCITY DISSIPATION DEVICES WILL BE PLACED AT DISCHARGE LOCATIONS AND ALONG THE LENGTH OF ANY OUTFALL CHANNEL:

Table with 3 columns: Velocity Dissipation Device, Outfall Discharging To, At Outfall or Channel.

CONSTRUCTION AND WASTE MATERIALS STORED ON-SITE

The following construction and waste materials will be stored on-site:

Table with 4 columns: Materials Stored On-Site, Average Amount Stored, Location On-Site, Controls Used to Prevent Pollutants.

POTENTIAL SOURCES OF POLLUTION

Table with 3 columns: Potential Sources of Pollution, Location On-Site, Controls Used to Prevent Pollutants.

DATES OF MAJOR GRADING AND CONSTRUCTION ACTIVITIES

If you do not list activities below, either attach documentation or state where records for the activities can be accessed:

Documents Attached? Where can documentation be found? Contact Person: Phone Number:

Dates when major grading activities will occur and locations on-site:

Table with 3 columns: Activity, Location, Dates Activity is Scheduled to Occur.

Dates when construction activity will temporarily or permanently cease:

Table with 4 columns: Location on-site, Date activity is to be stopped, Temporary or Permanent?, Stabilization Initiation Date.

RECORD PLANS AUGUST 29, 2008

ELIGIBLE NON-STORM WATER DISCHARGES


Table with 4 columns: Eligible Non-storm Water Discharge, Used? (Y/N), Pollution Prevention Measure(s), Implementation Date.

GOOD HOUSEKEEPING PRACTICES


Good Housekeeping practices implemented to limit the off-site transport of litter, construction debris, and construction materials.

Table with 2 columns: Good Housekeeping Activity, Location(s) On-Site. Includes sections for Litter Controls, Construction Debris Controls, and Construction Materials Controls.

WIA WIER & ASSOCIATES, INC. ENGINEERS SURVEYORS LAND PLANNERS

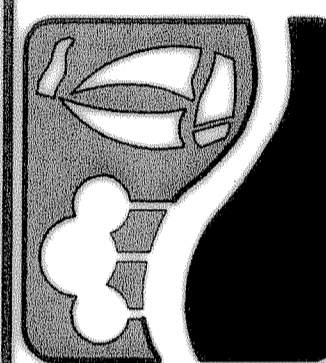

PHASE II S.H. 205 BYPASS FROM S.H. 276 TO INTERSTATE 30 SWP3 - STORM WATER POLLUTION PREVENTION NOTES

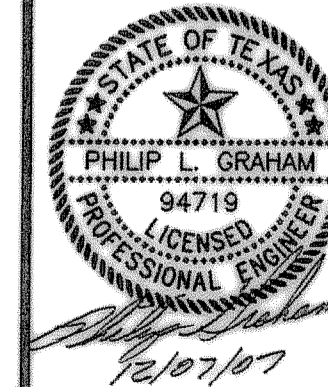

COPYRIGHT © WIER & ASSOCIATES, INC. LAST SHEET EDIT DATE 08-15-2007 WA# 04141 SHEET NO. E004