

TIME 9/16 FILE: SWP3-EROSION2-Phase2-04141.dwg

MATCH LINE
STA 40+00

THE CAMBRIDGE
COMPANIES, INC. TRUSTEE
VOL. 99, PG. 1022
D.R.R.C.T.

BMP No. 17
INSTALL 325 L.F. REINFORCED
SILT FENCE AT TOE OF SLOPE

BMP No. 18
INSTALL 55 L.F. REINFORCED
SILT FENCE AT TOE OF SLOPE

BMP No. 19
INSTALL 55 L.F. REINFORCED
SILT FENCE AT TOE OF SLOPE

THE CAMBRIDGE
COMPANIES, INC. TRUSTEE
VOL. 99, PG. 1022
D.R.R.C.T.

THE CAMBRIDGE
COMPANIES, INC. TRUSTEE
VOL. 101, PG. 795
D.R.R.C.T.

BMP No. 22
INSTALL 470 L.F. REINFORCED
SILT FENCE AT TOE OF SLOPE

BMP No. 5
PHASE I & II INSTALL
EDGE OF PAVEMENT
SEDIMENT TRAP

BMP No. 20
INLET A-4.3: INSTALL PHASE I
PHASE II INLET PROTECTION & MAINTAIN
UNTIL PARKWAYS ARE REVEGETATED


THE CAMBRIDGE
COMPANIES, INC. TRUSTEE
VOL. 101, PG. 795
D.R.R.C.T.

BMP No. 21
INSTALL 515 L.F. REINFORCED
SILT FENCE AT TOE OF SLOPE

BMP No. 1
INSTALL CONSTRUCTION ENTRANCE


S.H. 205 BYPASS

INTERSTATE
HIGHWAY No. 30

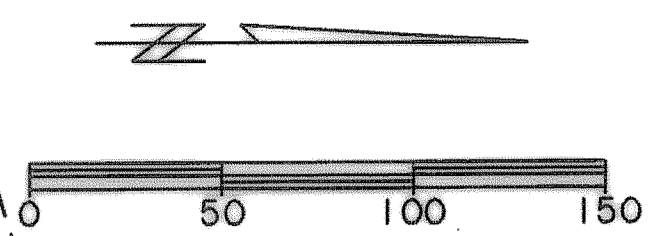


LEGEND	
	LIMITS OF OPERATOR DAY TO DAY OPERATIONAL CONTROL
	INLET TREATMENT
	REINFORCED SILT FENCE
	CONSTRUCTION ENTRANCE
	EDGE OF PAVEMENT SEDIMENT TRAP

PREPARED BY:
WIA WIER & ASSOCIATES, INC.
ENGINEERS SURVEYORS LAND PLANNERS
4300 BELTWAY PLACE SUITE 130 ARLINGTON, TEXAS 76018 METRO (817)467-7700
1380 U.S. HIGHWAY 287 N. SUITE 101 WAXSWELL, TEXAS 76063 METRO (817)477-0700
6849 ELM STREET FRISCO, TEXAS 75034 METRO (214)387-8000
www.wierassociates.com

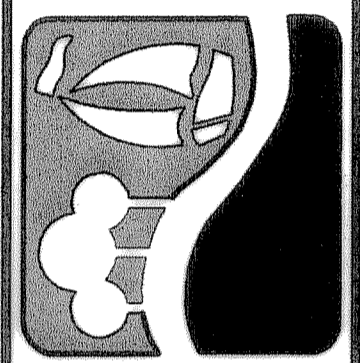

PHASE II S.H. 205 BYPASS
FROM S.H. 276 TO INTERSTATE 30
EROSION CONTROL
PLAN
STA 40+00 TO END & S.H. 276

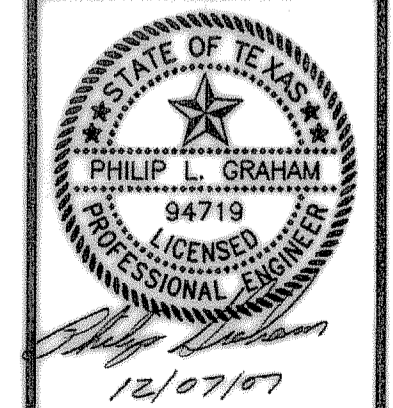

RECORD PLANS
AUGUST 29, 2008

COPYRIGHT ©
WIER & ASSOCIATES, INC.
LAST SHEET EDIT
DATE 12-07-2007
WA# 04141
SHEET NO.
E103