


△	2/20/08	REVISED QUANTITIES FOR SHEETS P104 & P105	PLG
NO.	DATE	DESCRIPTION	BY

SHEET QUANTITIES - PAVING, PAVEMENT MARKING, ILLUMINATION, EROSION & TRAFFIC CONTROL QUANTITIES																
ITEM No.	DESCRIPTION	SHEET UNITS	TOTAL QUANTITY	P101	P102	P103	△ P104	△ P105	P106	P107	M101	M102	H01	I102	E102	E103
100	Mobilization	LS	1													
101	Unclassified Excavation	CY	2,042	338	332	298	181	294	360	239						
102	Controlled Density Roadway Embankment	CY	2,786	244	353	460	826	431	454	18						
103	Imported Borrow	CY	1,200													
104	Right-of-way Preparation	STA	32.0	5.0	5.0	5.0	5.0	5.0	5.0	2.0						
105	Sawcut & Remove Existing Concrete Curb	LF	541	93	128	106		107	107							
106	Remove Existing Barricade	LF	37	37												
107	8" Lime Stabilized Subgrade (42 lbs/SY)	SY	13,530	2,000	2,130	1,990	1,610	1,965	2,565	1,270						
108	Hydrated Lime	TON	284.2	42.0	44.7	41.8	33.8	41.3	53.9	26.7						
109	10" 5,000 p.s.i. reinforced Concrete Street Pavement (7 sack min. - Class "G")	SY	11,300	1,805	1,905	1,780	1,402	1,738	2,330	340						
110	6" Type "D" Asphalt Concrete Pavement	SY	861							861						
111	6" Rolled Asphalt Curb	LF	167							167						
112	Concrete Street Header	LF	73							61						
113	Pavestone Median Cap	SY	302	51	63	63		62	63							
114	Bermuda Grass Sod Parkways and Median	SY	16,319	1,940	2,666	2,756	2,759	3,164	2,477	557						
115	Hydromulch Seed Slopes	SY	1,805	5	11	119	900	220	346	204						
116	Place 4" Topsoil on Medians, Parkways & Slopes (Imported)	SY	18,124	1,945	2,677	2,875	3,659	3,384	2,823	761						
117	Metal Beam Guard Fence & MGBF Transition	LF	50			50										
118	Single Guard Rail Terminal (SGT-03A)(25 L.F.)	EA	1			1										
119	Adjust Existing Sanitary Sewer Manhole to Finished Grade	EA	1				1									
120	3" Sch. 40 PVC Irrigation Sleeve	LF	538	87	152	87		125	87							
121	Remove Existing Pavement Markings	LS	1													
122	4" Type I-A White Reflectorized Ceramic Pavement Markers	EA	377								73	304				
123	4" Type I-A Yellow Reflectorized Ceramic Pavement Markers	EA	136								136					
124	4" Type I-A White Reflectorized Ceramic Pavement Markers	EA	200								91	109				
125	4" Type I-A Yellow Reflectorized Ceramic Pavement Markers	EA	30								30					
126	4" Non-reflectorized White Ceramic Pavement Markers	EA	686								360	326				
127	4" Non-reflectorized Yellow Ceramic Pavement Markers	EA	30								30					
128	24" Type I Thermoplastic Stop Bar	EA	1									1				
129	Type I Thermoplastic Right Turn Arrow	EA	4									4				
130	Type I Thermoplastic "ONLY" Word	EA	4									4				
131	Stop Sign R1-1	EA	1									1				
132	Remove & relocate Stop Sign R1-1	EA	1									1				
133	Remove & relocate Speed Limit Sign R2-1	EA	1								1					
134	Lane Ends Merge Left Sign W9-2L	EA	1								1					
135	2" Sch. 40 PVC Street Light Conduit	LF	190										100	90		
136	24" Dia. Concrete Street Light Base per ONCOR Standards	EA	13										9	4		
137	Prepare & Maintain SWP3 Plan	LS	1													
138	Curb Inlet Protection (All Phases)	EA	7											6	1	
139	Reinforced Silt Fence	LF	4,095											2,675	1,420	
140	Stabilized Construction Entrance	EA	2											1	1	
141	S.H. 205 Bypass Temporary Traffic Control	LS	1													
142	I.H. 30 Connection Temporary Traffic Control	LS	1													


SHEET QUANTITIES - DRAINAGE					
ITEM No.	DESCRIPTION	SHEET UNITS	TOTAL QUANTITY	D104	D105
201	18" R.C.P. Storm Drain Pipe Class III	LF	351	133	218
202	21" R.C.P. Storm Drain Pipe Class III	LF	49	49	
203	10' Recessed Curb Inlet	EA	5	2	3
204	15' Recessed Curb Inlet	EA	1	1	
205	Trench Safety	LF	322	182	140
206	Connect to Existing RCP	EA	6	3	3

RECORD PLANS  
AUGUST 29, 2008

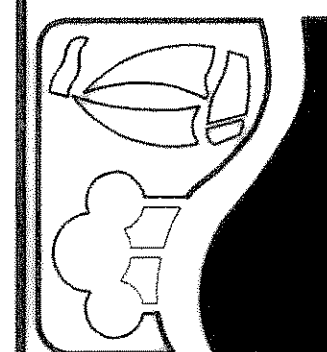

PREPARED BY:  
**WIER & ASSOCIATES, INC.**  
ENGINEERS SURVEYORS LAND PLANNERS  
4300 BELWAY PLACE SUITE 130 ARLINGTON, TEXAS 76010 METRO (817)467-7700  
1380 U.S. HIGHWAY 287 N. SUITE 101 MANSFIELD, TEXAS 76063 METRO (817)477-0700  
6848 ELM STREET FRISCO, TEXAS 75034 METRO (214)387-8000  
www.wierassociates.com

PHASE II S.H. 205 BYPASS  
FROM S.H. 276 TO INTERSTATE 30  
SHEET QUANTITIES

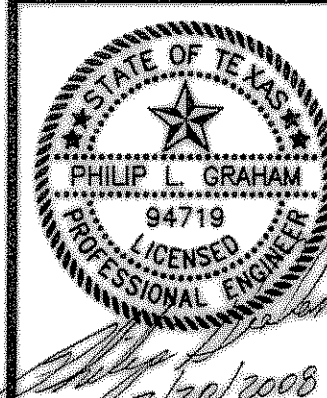

COPYRIGHT ©  
WIER & ASSOCIATES, INC.  
LAST SHEET EDIT  
DATE 02-20-2008  
WAR 04141

SHEET NO.  
S002