

ROCKWALL BYPASS, LTD.
VOL. 2852, PG. 109
D.R.R.C.T.

REMAINDER
LOFLAND FARMS, LTD.
VOL. 1392, PG. 271
D.R.R.C.T.

THE CAMBRIDGE
COMPANIES, INC.
TRUSTEE
VOL. 99, PG. 1022
D.R.R.C.T.

REMOVE EXISTING BUTTONS
ALONG ROLLED ASPHALT
CURB

INSTALL SOLID WHITE
STRIPING PER DETAIL
SHEET M201

LANE ENDS
MERGE LEFT
SIGN W9-2L

INSTALL SOLID YELLOW
STRIPING PER DETAIL
SHEET M201

INSTALL BROKEN WHITE
LINE PER DETAIL SHEET M201

13 14

16

17

18

20

21

22

23

24

25

S.H. 205 BYPASS

RETAIN 100 L.F.
EXIST. YELLOW
PAVEMENT MARKINGS

RELOCATE EXIST.
SPEED LIMIT
SIGN R2-1

INSTALL YELLOW LANE DROP STRIPING
PER DETAIL SHEET M201

INSTALL BROKEN WHITE
LINE PER DETAIL SHEET M201

THE CAMBRIDGE
COMPANIES, INC.
TRUSTEE
VOL. 99, PG. 1022
D.R.R.C.T.

SCALE (feet)



S . H . 2 0 5 B Y P A S S

NOTES:
1. REMOVE EXISTING YELLOW
PAVEMENT MARKINGS.
2. DIMENSIONS ARE FROM
FACE OF CURB.

THE CAMBRIDGE
COMPANIES, INC.
TRUSTEE
VOL. 99, PG. 1022
D.R.R.C.T.

INSTALL BROKEN WHITE
LINE PER DETAIL SHEET M201

MATCH LINE STA 26+00

27

28

29

30

31

32

33

34

35

36

37

38

S.H. 205 BYPASS

MATCH LINE STA 38+50

THE CAMBRIDGE
COMPANIES, INC.
TRUSTEE
VOL. 99, PG. 1022
D.R.R.C.T.


RECORD PLANS
AUGUST 29, 2008

SCALE (feet)




S . H . 2 0 5 B Y P A S S

PREPARED BY:
WIA WIER & ASSOCIATES, INC.
ENGINEERS SURVEYORS LAND PLANNERS
4300 BELWAY PLACE, SUITE 130, ARLINGTON, TEXAS 76018, METRO (817)467-7700
1300 U.S. HIGHWAY 287 N., SUITE 101, WANSFELD, TEXAS 76063, METRO (817)477-5700
6649 ELM STREET, FRISCO, TEXAS 75034, METRO (214)387-8000
www.WierAssociates.com

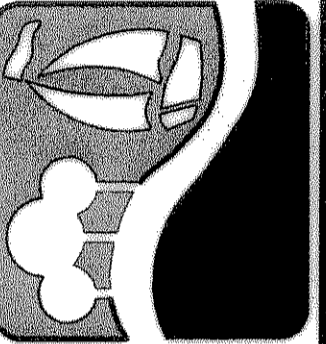

PHASE II S.H. 205 BYPASS
FROM S.H. 276 TO INTERSTATE 30
STRIPING
PLAN
STA 13+50+ TO 38+50

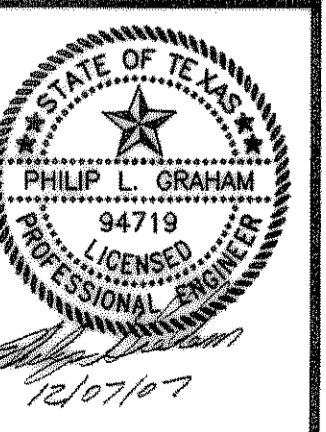

COPYRIGHT ©
WIER & ASSOCIATES, INC.
LAST SHEET EDIT
DATE: 12-07-2007
WA# 04141
SHEET NO.
M101

TIME: 01:45 FILE: STRIPES-Phase2-04141.dwg