

EXISTING TOPOGRAPHIC LEGEND

	ASPHALT PAVEMENT
BOL/GP ○	BOLLARD/GUARD POST
B/C	DIMENSION TO BACK OF CURB
T/C = XXX.XX	TOP OF CURB ELEVATION
CATV □	CABLE TV BOX
CM	CONTROL MONUMENT
CONC.	CONCRETE
EAP	EDGE OF ASPHALT PAVEMENT
EB □	ELEC BOX (GROUND)
EM □	ELEC METER
FH ⊕	FIRE HYDRANT
FO ⊕	FIBER OPTIC CABLE
GM △	GAS METER
GMH ⊙	GAS MANHOLE
GTS ▽	GAS TEST STATION
GUY ∩	GUY WIRE
HDWL .	CONCRETE HEADWALL
ICV □	IRRIGATION CONTROL VALVE
IRF	IRON ROD FOUND
IRS	IRON ROD SET
LP ⊙	LIGHT POLE
PP ○	POWER POLE
PP/LP ⊙	POWER POLE W/LIGHT
SDMH ⊕	STORM DRAIN MANHOLE
SHD ○	SPRINKLER HEAD
SN ⊕	SIGN
SSMH ⊙	SANITARY SEWER MANHOLE
SSCO ○	SANITARY SEWER CLEANOUT
TELE	TELEPHONE
TPD ⊕	TELEPHONE PEDESTAL
TSG □	TELEPHONE SWITCH GEAR
TSB □	TRAFFIC SIGNAL BOX
TSP ○	TRAFFIC SIGNAL POLE
TSC	TRAFFIC SIGNAL CONTROLLER
⊗	TRANSFORMER PAD
WM □	WATER METER
WV ⊗	WATER VALVE
— OE —	OVERHEAD ELECTRIC LINE
— UE —	UNDERGROUND ELECTRIC LINE
— W —	WATER LINE
— SS —	SANITARY SEWER LINE
— FO —	FIBER OPTIC LINE
— UT —	UNDERGROUND TELEPHONE
— OT —	OVERHEAD TELEPHONE
— G —	UNDERGROUND GAS
===24" RCP===	EXISTING RCP
===24" CMP===	EXISTING CMP
===24" CPP===	EXISTING CPP
→	EXISTING FLOWLINE
— X —	BARBED WIRE FENCE
— O —	CHAIN LINK FENCE
— // —	WOOD FENCE
— □ —	WROUGHT IRON FENCE
— o —	GUARD RAIL / BARRICADE
— ( ) —	EXISTING TREE LINE
— ( ) —	EXISTING TREE

PAVING PLAN LEGEND

	10' 5,000 P.S.I. REINFORCED CONCRETE STREET PAVEMENT
	4' TYPE "D" HMAc TRANSITION PAVEMENT
	6' TYPE "D" HMAc TRANSITION PAVEMENT
	4' 3,000 P.S.I. REINFORCED CONCRETE SIDEWALK
	PAVESTONE MEDIAN CAP
	PROPOSED EDGE OF PAVEMENT
	FUTURE EDGE OF PAVEMENT
L2	LINE IDENTIFIED IN LINE TABLE
C2	CURVE IDENTIFIED IN CURVE TABLE
B/B	BACK OF CURB TO BACK OF CURB
— O —	PROPOSED CHAIN LINK FENCE
— X —	PROPOSED BARBED WIRE FENCE
— // —	PROPOSED WOOD / STOCKADE FENCE
— o —	PROPOSED BARRICADE / GUARD RAIL
	PROPOSED RETAINING WALL
	HANDICAP PARKING SYMBOL
	INDICATES CUT OR FILL SLOPE
	PROPOSED SIGN & POST
	INDICATES PROPOSED RECESSED CURB INLET
	INDICATES PROPOSED STANDARD CURB INLET

DRAINAGE PLAN LEGEND

	DRAINAGE AREA DESIGNATION
	DRAINAGE AREA (ACRES)
	WATERSHED LIMITS
	DRAINAGE AREA DIVIDE
	DRAINAGE AREA SUB-DIVIDE
	ZONING BOUNDARY
	FLOW DIRECTION ARROW
L2	LINE IDENTIFIED IN LINE TABLE
C2	CURVE IDENTIFIED IN CURVE TABLE
	INDICATES PROPOSED RECESSED CURB INLET
	INDICATES PROPOSED STANDARD CURB INLET
	INDICATES PROPOSED DROP INLET
	INDICATES PROPOSED JUNCTION BOX
	PROPOSED STORM DRAIN
	FUTURE STORM DRAIN
	PROPOSED SWALE

EROSION CONTROL LEGEND

	LIMITS OF OPERATOR DAY TO DAY OPERATIONAL CONTROL
	PROPOSED SWALE
	INDICATES STABILIZED CONSTRUCTION ENTRANCE
	INDICATES UN-REINFORCED SILT FENCE
	INDICATES REINFORCED SILT FENCE
	INDICATES ROCK BERM
	INDICATES SACK GABIONS
	INDICATES DROP INLET PROTECTION
	INDICATES PROPOSED INLET TREATMENT
	CURLEX EROSION CONTROL BLANKET
	INDICATES SEDIMENT TRAP OUTLET CONTROL DEVICE
	EDGE OF PAVEMENT SEDIMENT TRAP
— 640 —	EXISTING CONTOUR LINE
— 640 —	PROPOSED CONTOUR LINE

WATER & SANITARY SEWER PLAN LEGEND

	PROPOSED 16" OR LARGER WATER MAIN
	PROPOSED 12" OR SMALLER WATER MAIN
	FUTURE 16" OR LARGER WATER MAIN
	FUTURE 12" OR SMALLER WATER MAIN
	PROPOSED GATE VALVE
	PROPOSED REDUCER
	PROPOSED WATER METER
	PROPOSED FIRE HYDRANT
	PROPOSED AIR RELEASE VALVE OR BLOW-OFF VALVE
	PROPOSED 16" OR LARGER SANITARY SEWER
	PROPOSED 12" OR SMALLER SANITARY SEWER
	FUTURE 16" OR LARGER SANITARY SEWER
	FUTURE 12" OR SMALLER SANITARY SEWER
	PROPOSED SANITARY SEWER MANHOLE
	PROPOSED SANITARY SEWER CLEANOUT


STREET LIGHT & CONDUITS LEGEND

	PROPOSED STREET LIGHT BASE
	PROPOSED 2" PVC STREET LIGHT CONDUIT


RECORD PLANS  
AUGUST 29, 2008

NO.	DATE	DESCRIPTION	BY

PREPARED BY:  
**WIER & ASSOCIATES, INC.**  
ENGINEERS SURVEYORS LAND PLANNERS  
4300 BELTWAY PLACE SUITE 130 ARLINGTON, TEXAS 76018 METRO (817)467-7700  
1300 U.S. HIGHWAY 287 N. SUITE 107 WINSFIELD, TEXAS 76663 METRO (817)477-8700  
6809 ELM STREET FINSCO, TEXAS 75004 METRO (214)387-8000  
www.wierassociates.com

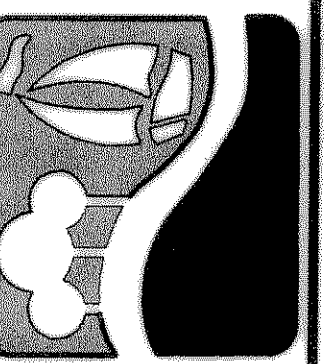

PHASE II  
S.H. 205 BYPASS  
TOPOGRAPHIC LEGEND

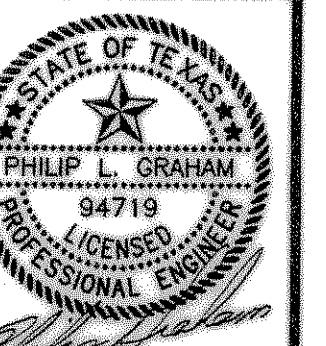

COPYRIGHT ©  
WIER & ASSOCIATES, INC.  
LAST SHEET EDIT  
DATE 12-06-2007  
WA# 04141  
SHEET NO.  
001