



DISCLAIMER
The use of this standard is governed by the "Texas Engineering Practice Act". No warranty of any kind is made by TxDOT for any purpose whatsoever. TxDOT assumes no responsibility for the conversion of this standard to other formats or for incorrect results or damages resulting from its use.

| | | |
|---|------|-------|
| DN: | CK: | CK: |
| DATE: | ACC: | FILE: |
| LEVELS DISPLAYED | | |
| 1 2 3 100 | | |

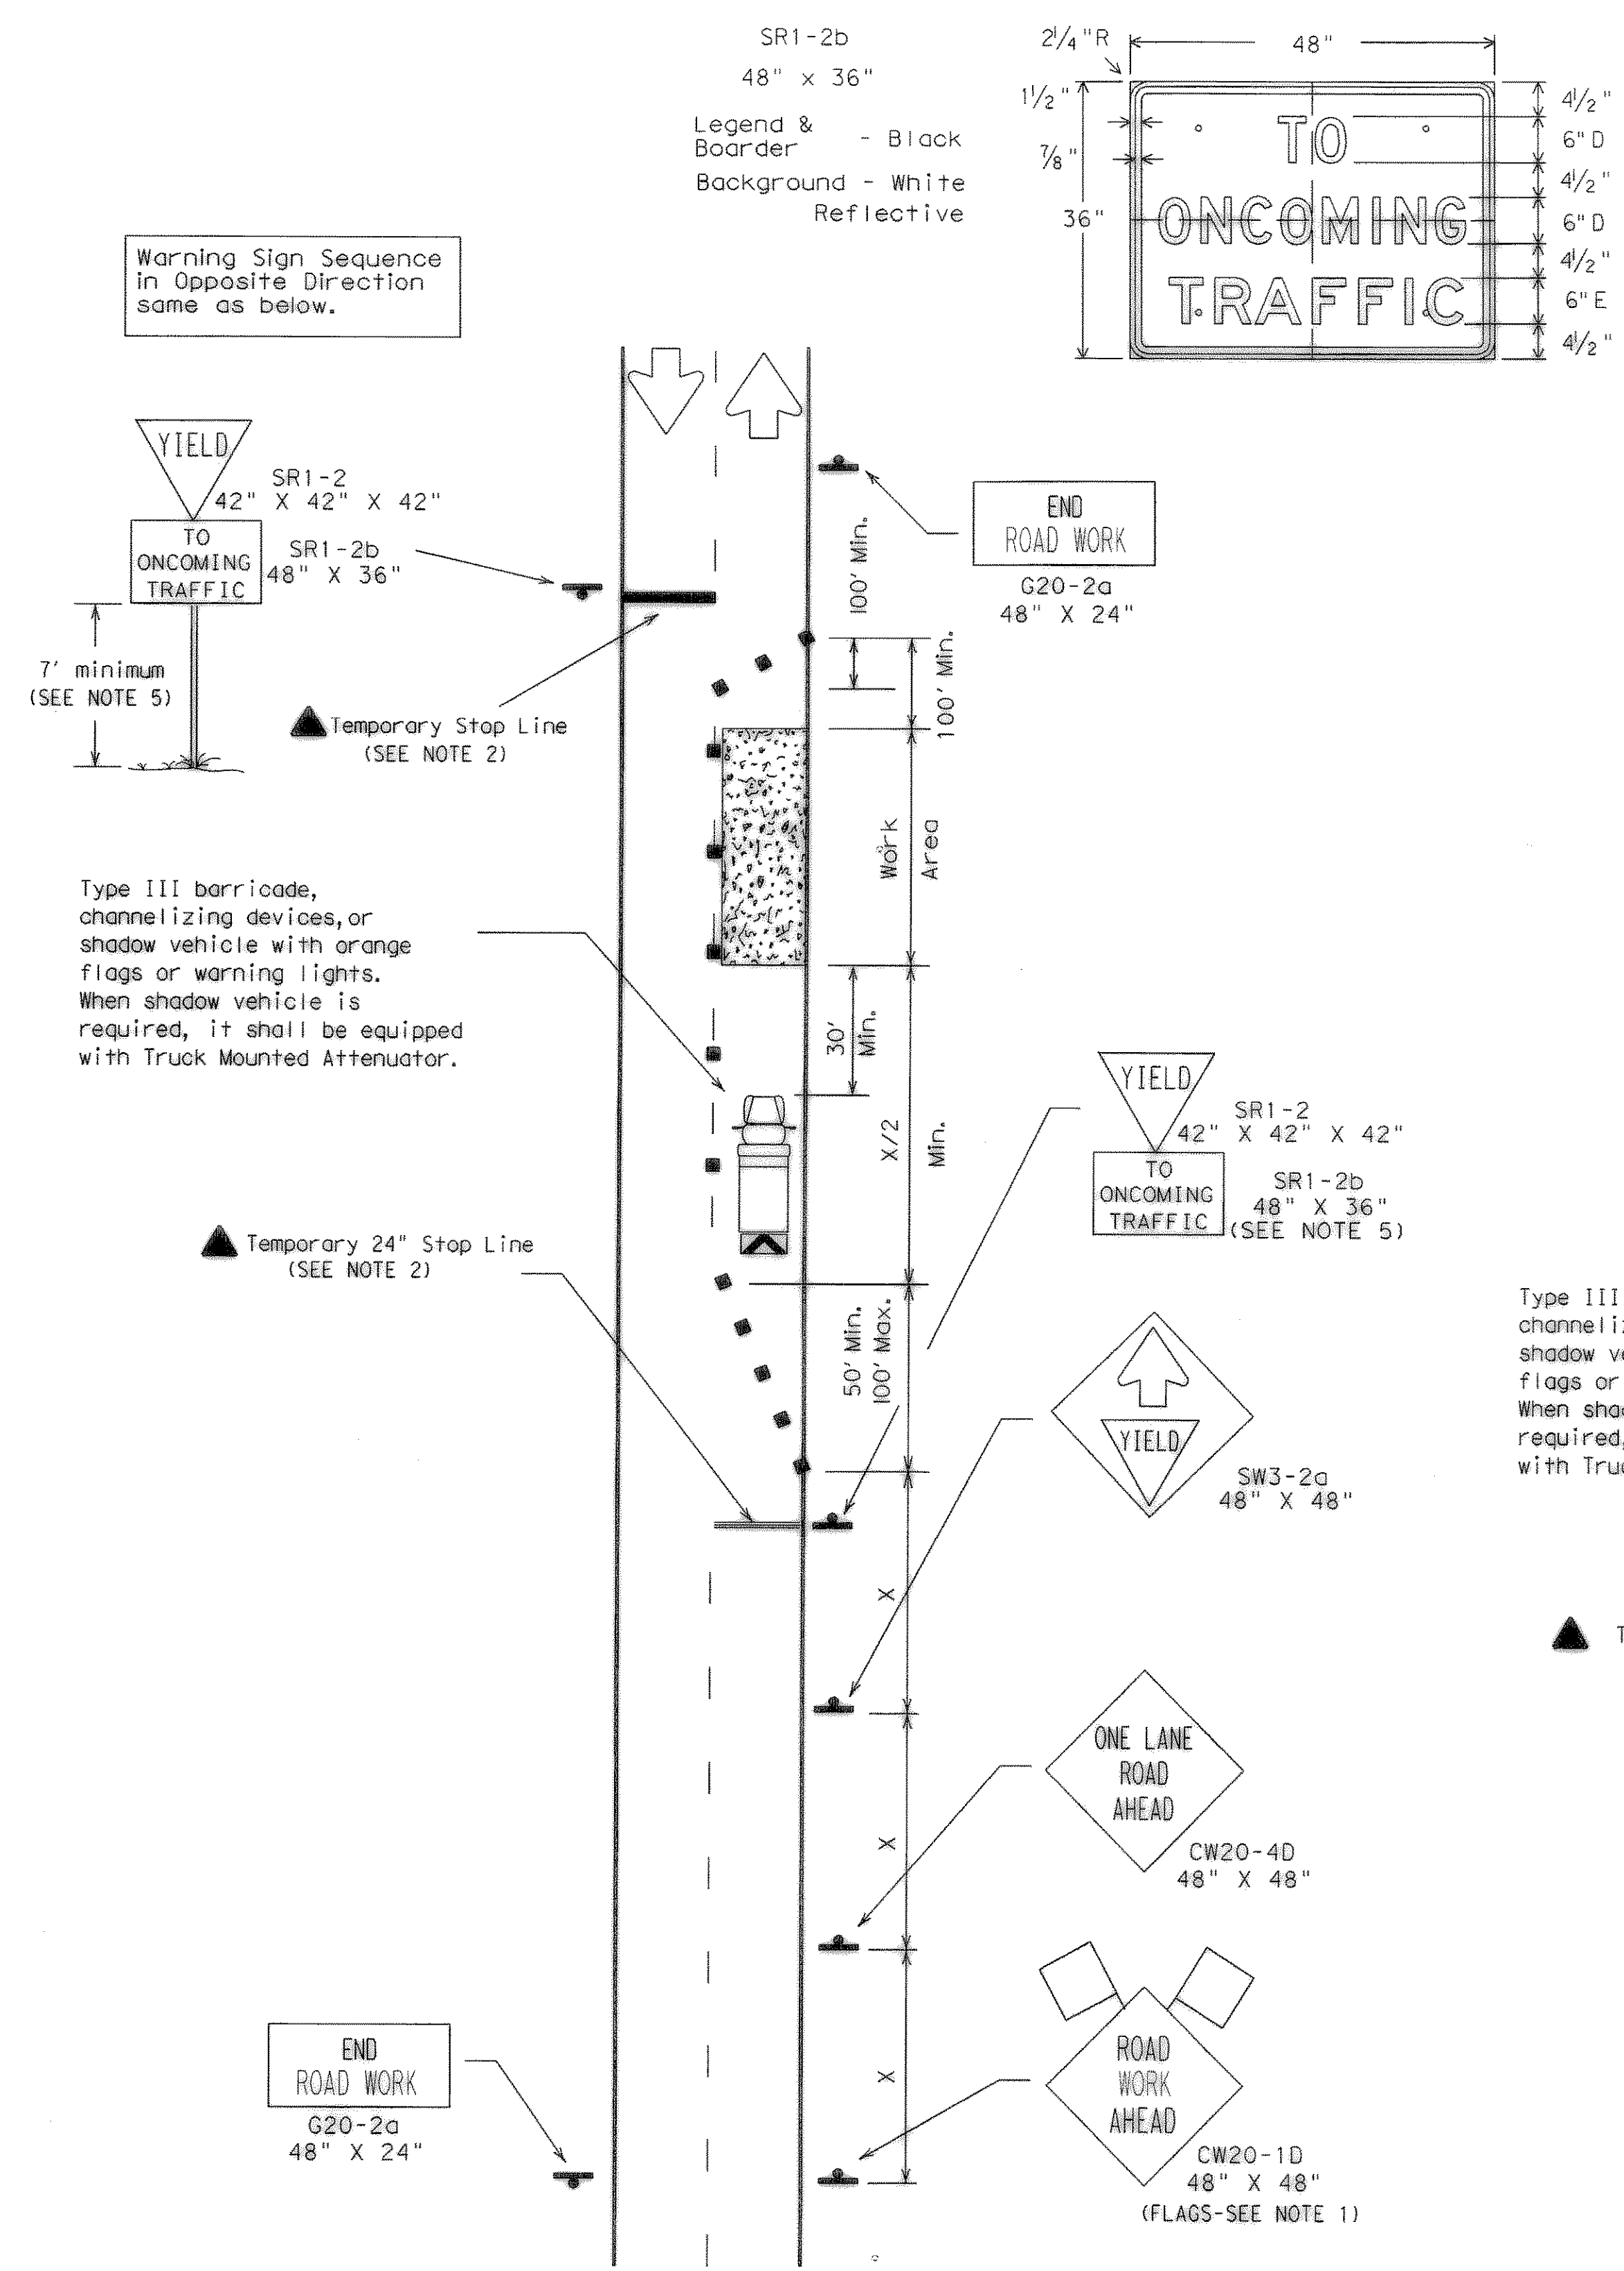

TCP (2-2a)
2-Lane Roadway Without Paved Shoulders
One Lane Closed
Adequate Field of View

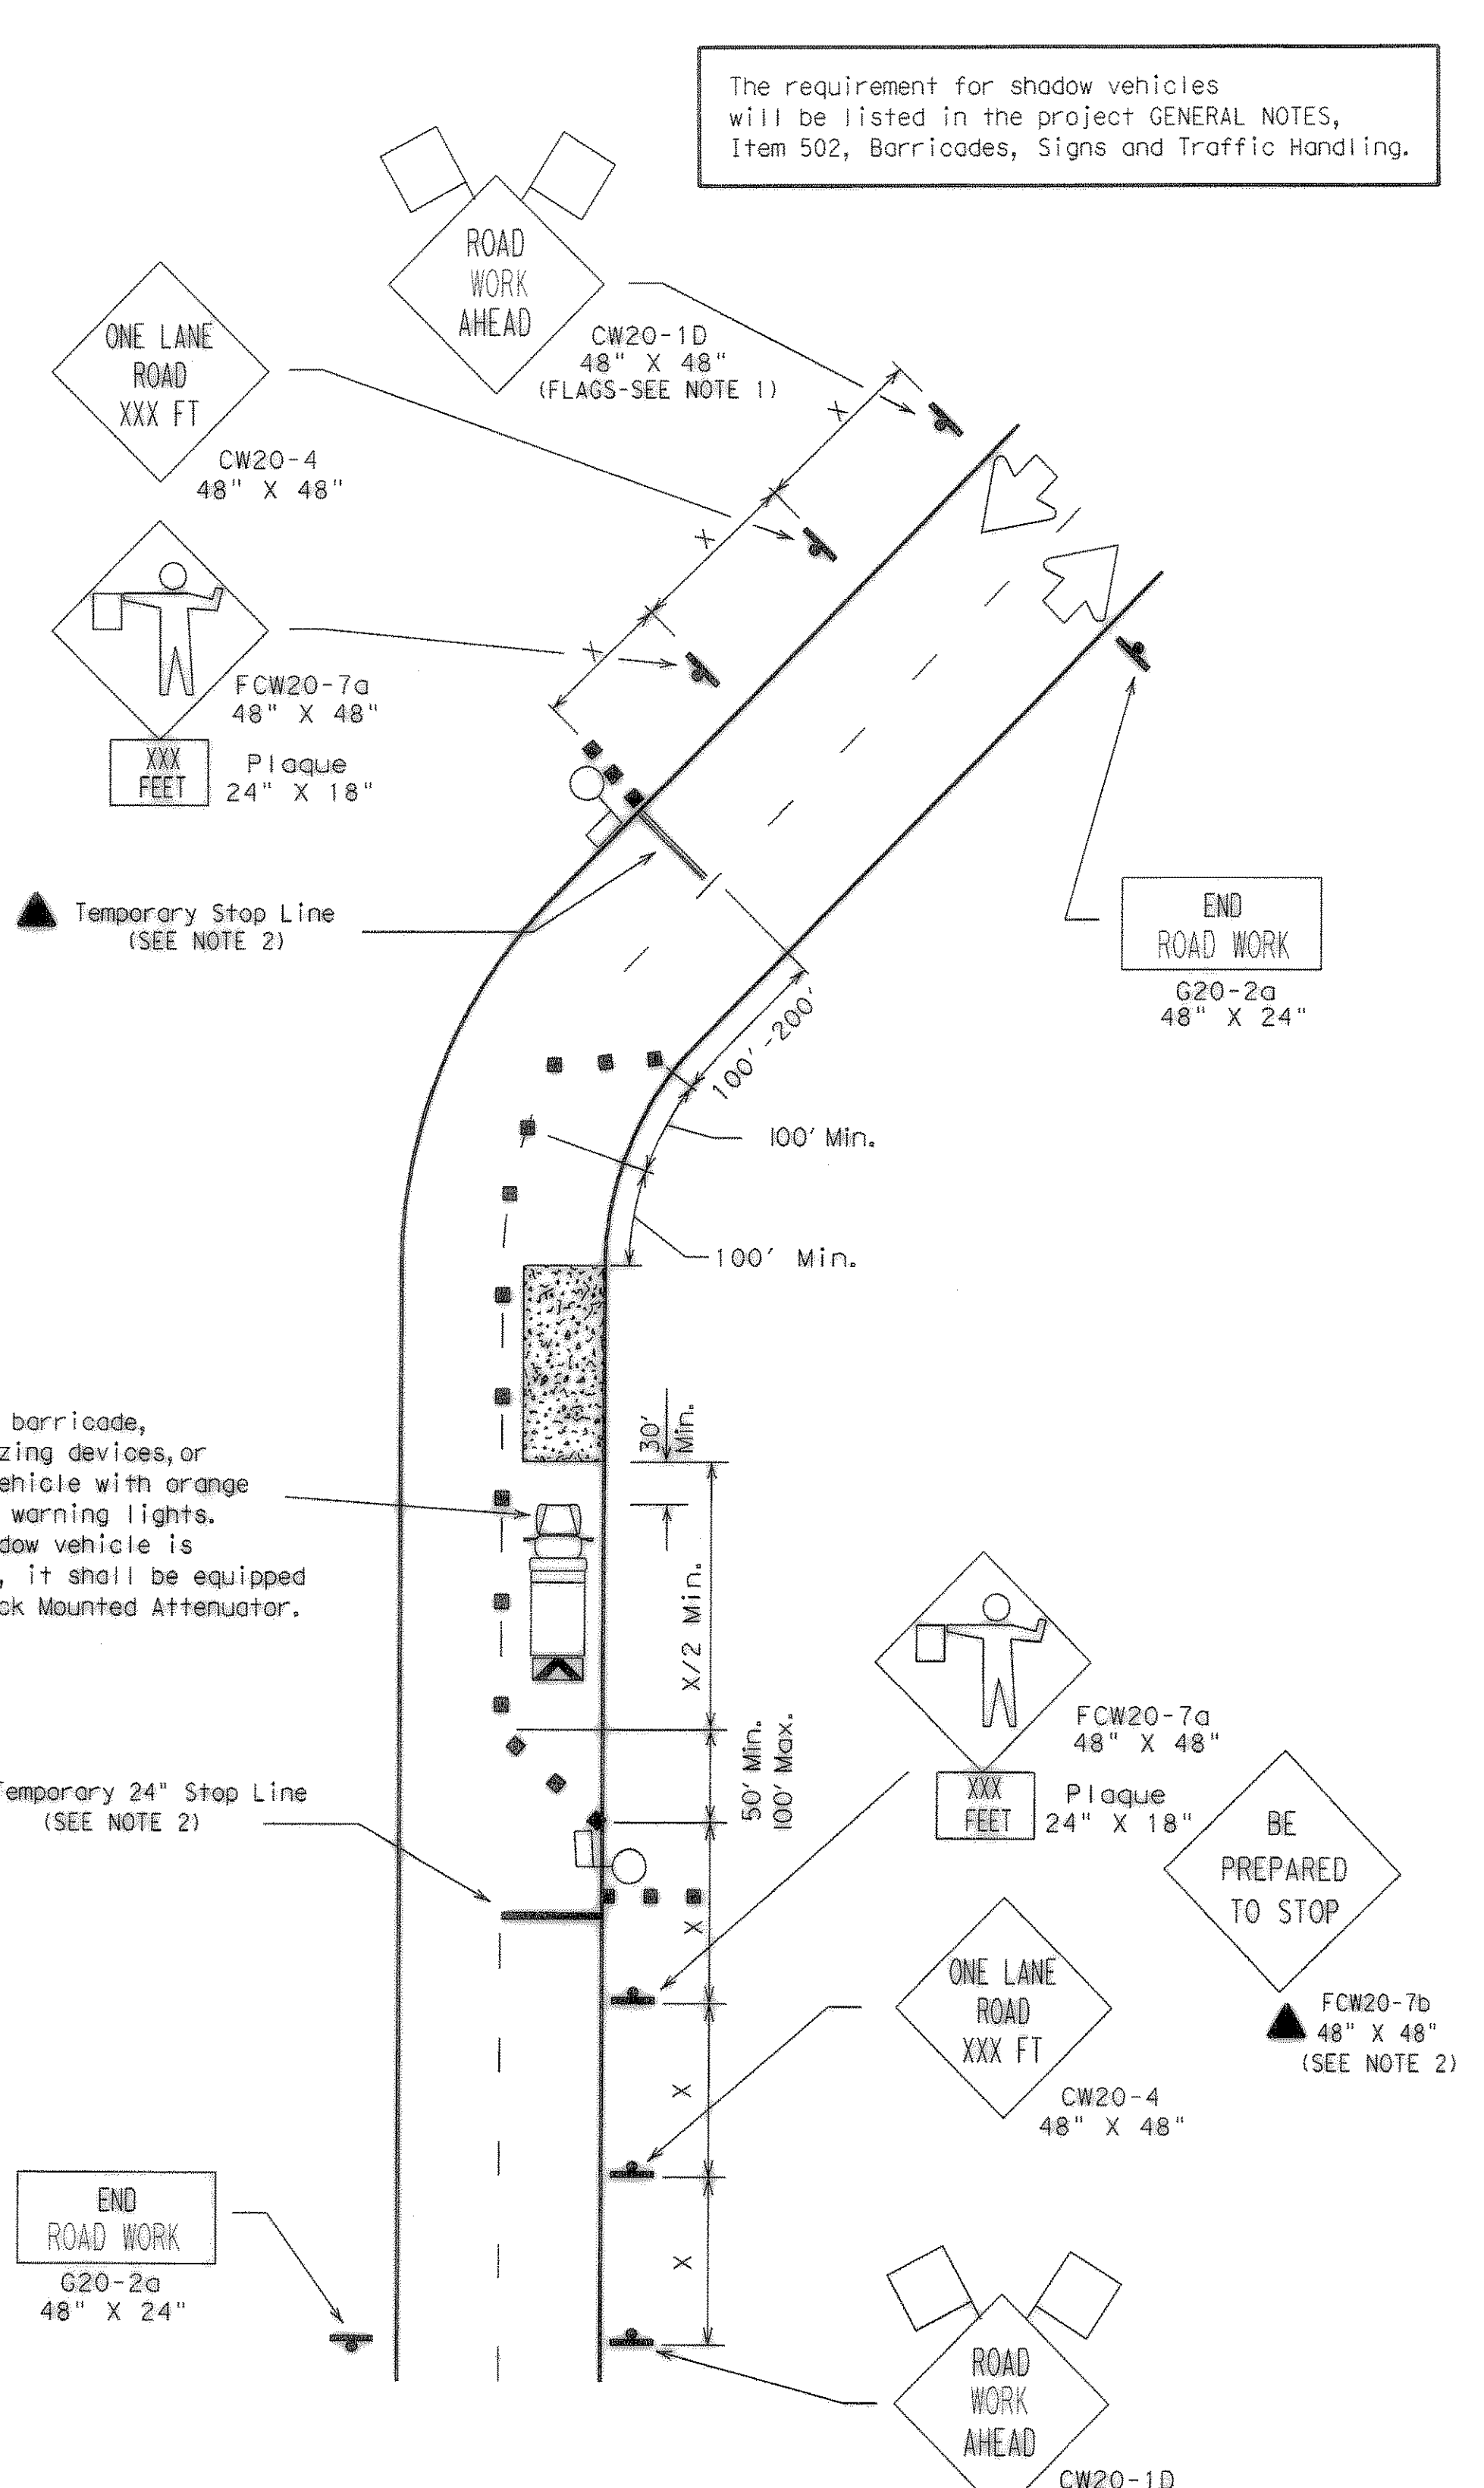

TCP (2-2b)
2-Lane Roadway Without Paved Shoulders
One Lane Closed
Inadequate Field of View

LEGEND

| | | | | | |
|--|--------------------------------------|--|----------------------------------|--|------|
| | Type III Barricade | | Channelizing Devices | | Flag |
| | Heavy Work Vehicle | | Truck Mounted Attenuator | | |
| | Trailer Mounted Flashing Arrow Panel | | Portable Changeable Message Sign | | |
| | Flagger | | Sign Post | | |

| Posted Speed X | Formula | Minimum Desirable Taper Lengths X X | | | Suggested Maximum Spacing of Device | | Minimum Sign Spacing X Distance |
|----------------|--------------------------|-------------------------------------|------------|------------|-------------------------------------|--------------|---------------------------------|
| | | 10' Offset | 11' Offset | 12' Offset | On a Taper | On a Tangent | |
| 30 | L = WS ² / 60 | 150' | 165' | 180' | 30' | 60' - 75' | 120' |
| 35 | | 205' | 225' | 245' | 35' | 70' - 90' | 160' |
| 40 | | 265' | 295' | 320' | 40' | 80' - 100' | 240' |
| 45 | L = WS | 450' | 495' | 540' | 45' | 90' - 110' | 320' |
| 50 | | 500' | 550' | 600' | 50' | 100' - 125' | 400' |
| 55 | | 550' | 605' | 660' | 55' | 110' - 140' | 500' |
| 60 | | 600' | 660' | 720' | 60' | 120' - 150' | * 600' |
| 65 | | 650' | 715' | 780' | 65' | 130' - 165' | * 700' |
| 70 | 700' | 770' | 840' | 70' | 140' - 175' | * 800' | |

* Conventional Roads Only
** Taper lengths have been rounded off.
L = Length of Taper (FT.) W = Width of Offset (FT.) S = Posted Speed (MPH)

TYPICAL USAGE:

| MOBILE | SHORT DURATION | SHORT TERM STATIONARY | INTERMEDIATE TERM STATIONARY | LONG TERM STATIONARY |
|--------|----------------|-----------------------|------------------------------|----------------------|
| | ✓ | ✓ | ✓ | |

- GENERAL NOTES:
- Flags attached to signs are **REQUIRED**.
 - All traffic control devices illustrated are **REQUIRED**, except those denoted with the triangle symbol may be omitted when stated elsewhere in the plans.
 - The BE PREPARED TO STOP sign may be installed after the ONE LANE ROAD XXX FT sign, but proper sign spacing shall be maintained.
 - YIELD sign traffic control may be used on projects with approaches that have adequate sight distance. For projects in urban areas, work zones should be no longer than one half city block. In rural areas on roadways with less than 4000 ADT and work areas should be no longer than 400'.
 - YIELD TO ONCOMING TRAFFIC sign shall be placed on a support at a 7' minimum mounting height.
 - Flaggers should use two-way radios or other methods of communication to control traffic.
 - Length of work area should be based on the ability of flaggers to communicate.
 - For intermediate term situations, when it is not feasible to remove and restore pavement markings, the channelization must be made dominant by using a very close spacing. This is especially important in locations of conflicting information, such as where traffic is directed over a double yellow centerline. In such locations a maximum channelizing device spacing of 10 feet is recommended. The 10 foot channelizing device spacing recommendation is intended for the area of conflicting information and not the entire work zone.

RECORD PLANS
AUGUST 29, 2008

STANDARD PLANS
TEXAS DEPARTMENT OF TRANSPORTATION
Traffic Operations Division

TRAFFIC CONTROL PLAN

TCP (2-2) - 03

| | | | | | |
|-----------------------|---------|----------------|---------------------|---------|-----------|
| © TxDOT December 1985 | DN - LR | DN - MT | DN - DN | DN - MT | REG. NO.: |
| REVISIONS | STATE | FEDERAL REGION | FEDERAL AID PROJECT | | SHEET |
| 8-95 | | G | | | T202 |
| 1-97 | | | | | |
| 4-98 | COUNTY | CONTROL | SECTION | JOB | HIGHWAY |
| 3-03 | | | | | |