

City of Rockwall, Texas

CONSTRUCTION PLANS

FOR

205 BYPASS

SECTION I

FROM QUAIL RUN ROAD TO FM-552

FOR THE CONSTRUCTION OF MISCELLANEOUS WORK

CONSISTING OF : GRADING, DRAINAGE FACILITIES, CONCRETE PAVEMENT, ASPHALT CONCRETE PAVEMENT, SIGNING AND PAVEMENT MARKINGS.

DESIGN SPEEDS:

205-BYPASS	=	45 mph
QUAIL RUN RD.	=	30 mph
HAYS RD.	=	30 mph
F.M 552	=	55 mph

MAYOR
Bill Cecil

MAYOR PRO-TEM
Stephen Straughan

CITY COUNCIL


Matt Scott
David Sweet
Glen Farris
Cliff Sevier
Margo Nielsen

CITY MANAGER
Julie Couch

CITY ENGINEER
Chuck Todd

NOTE:
SPECIFICATIONS ADOPTED BY THE TEXAS DEPARTMENT OF TRANSPORTATION, JUNE 1, 2004 AND THE CONTRACT PROVISIONS LISTED AND DATED AS FOLLOWS SHALL GOVERN ON THIS PROJECT: REQUIRED CONTRACT PROVISIONS FOR ALL FEDERAL-AID CONSTRUCTION CONTRACTS, (FORM FHWA 1273, DECEMBER 1993.)

2007

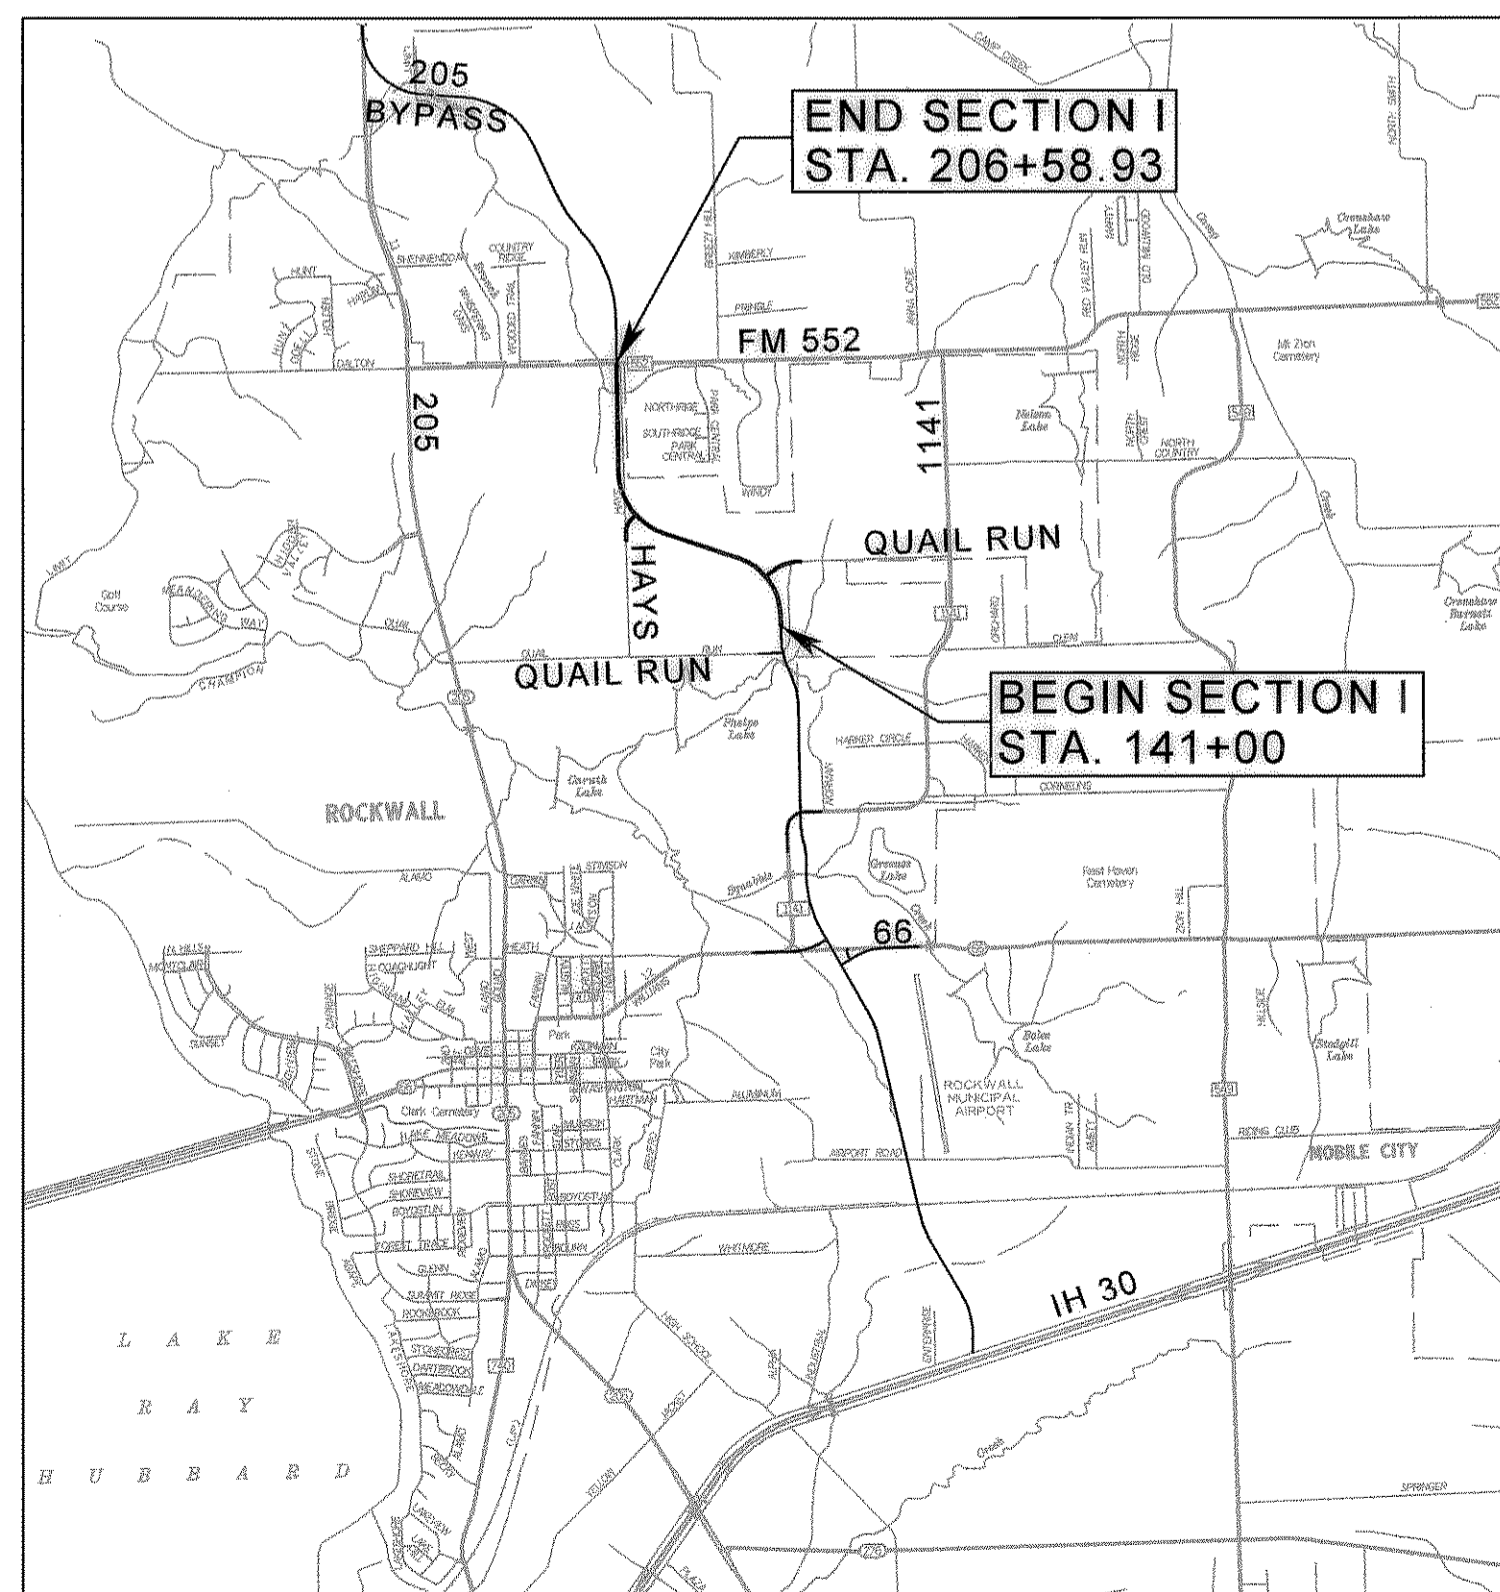

PROJECT LENGTH = 6,597.86 LF

VICINITY MAP
SCALE: N.T.S.

RECORD DRAWING
 This drawing is a compilation of the original sealed engineering drawing and modifications by addenda, change orders and information furnished by the contractor. Information shown that was provided by the contractor and others not associated with the design engineer cannot be verified for accuracy or completeness. Original sealed drawing is on file at the office of AECOM USA Group, Inc., TBPE REG. NO. F-3082

ORIGINAL DRAWING SEALED & SIGNED BY
 Matthew L. Abbe, P.E.
 TX NO. 92715

ORIGINAL DRAWING SEALED & SIGNED BY
 Robert C. Reach, P.E.
 TX NO. 48587



TCB INC.
17300 DALLAS PARKWAY, SUITE 1010
DALLAS, TEXAS 75248
WWW.TCB.AECOM.COM