



ITEM SPEC NO.	DESCRIPTION	UNIT	QUANTITY
100	PREP ROW (STORM DRAIN STRUCTURE REMOVAL)	LF	0
* 105	REMOVING STAB. BASE AND ASPHALT PVMT	SY	616
* 104	REMOVING CONCRETE (CONCRETE PVMT)	SY	0
100	PREP ROW (FENCE REMOVAL)	LF	656
* 106	OBLITERATING ABANDONED ROAD	STA	3.3

NOTE: * THESE ITEMS ARE SUBSIDIARY TO ITEM 100. ALL QUANTITIES SHOWN ARE FOR CONTRACTORS INFORMATION ONLY.

- LEGEND**
- EXIST. TREE TO REMAIN
 - EXIST. FENCE TO REMAIN
 - EXIST. TREE TO BE REMOVED
 - EXIST. FENCE TO BE REMOVED
 - EXIST. BRUSH & SMALL DIAMETER TREES TO BE REMOVED

- NOTES:**
- CONTRACTOR SHALL PAY FOR REMOVALS IN ACCORDANCE WITH PREPARING ROW, ITEM NO. 100.
 - QUANTITIES SHOWN ARE FOR CONTRACTOR'S INFORMATION ONLY.
 - FOR UTILITY ADJUSTMENTS, SEE THE UTILITY LAYOUT SHEETS.

REFER TO 205 BYPASS DEMOLITION PLAN (SHT. 5 OF 9) FOR CONTINUATION

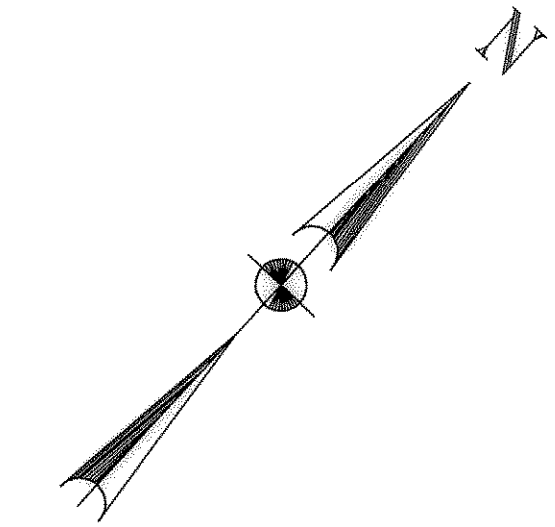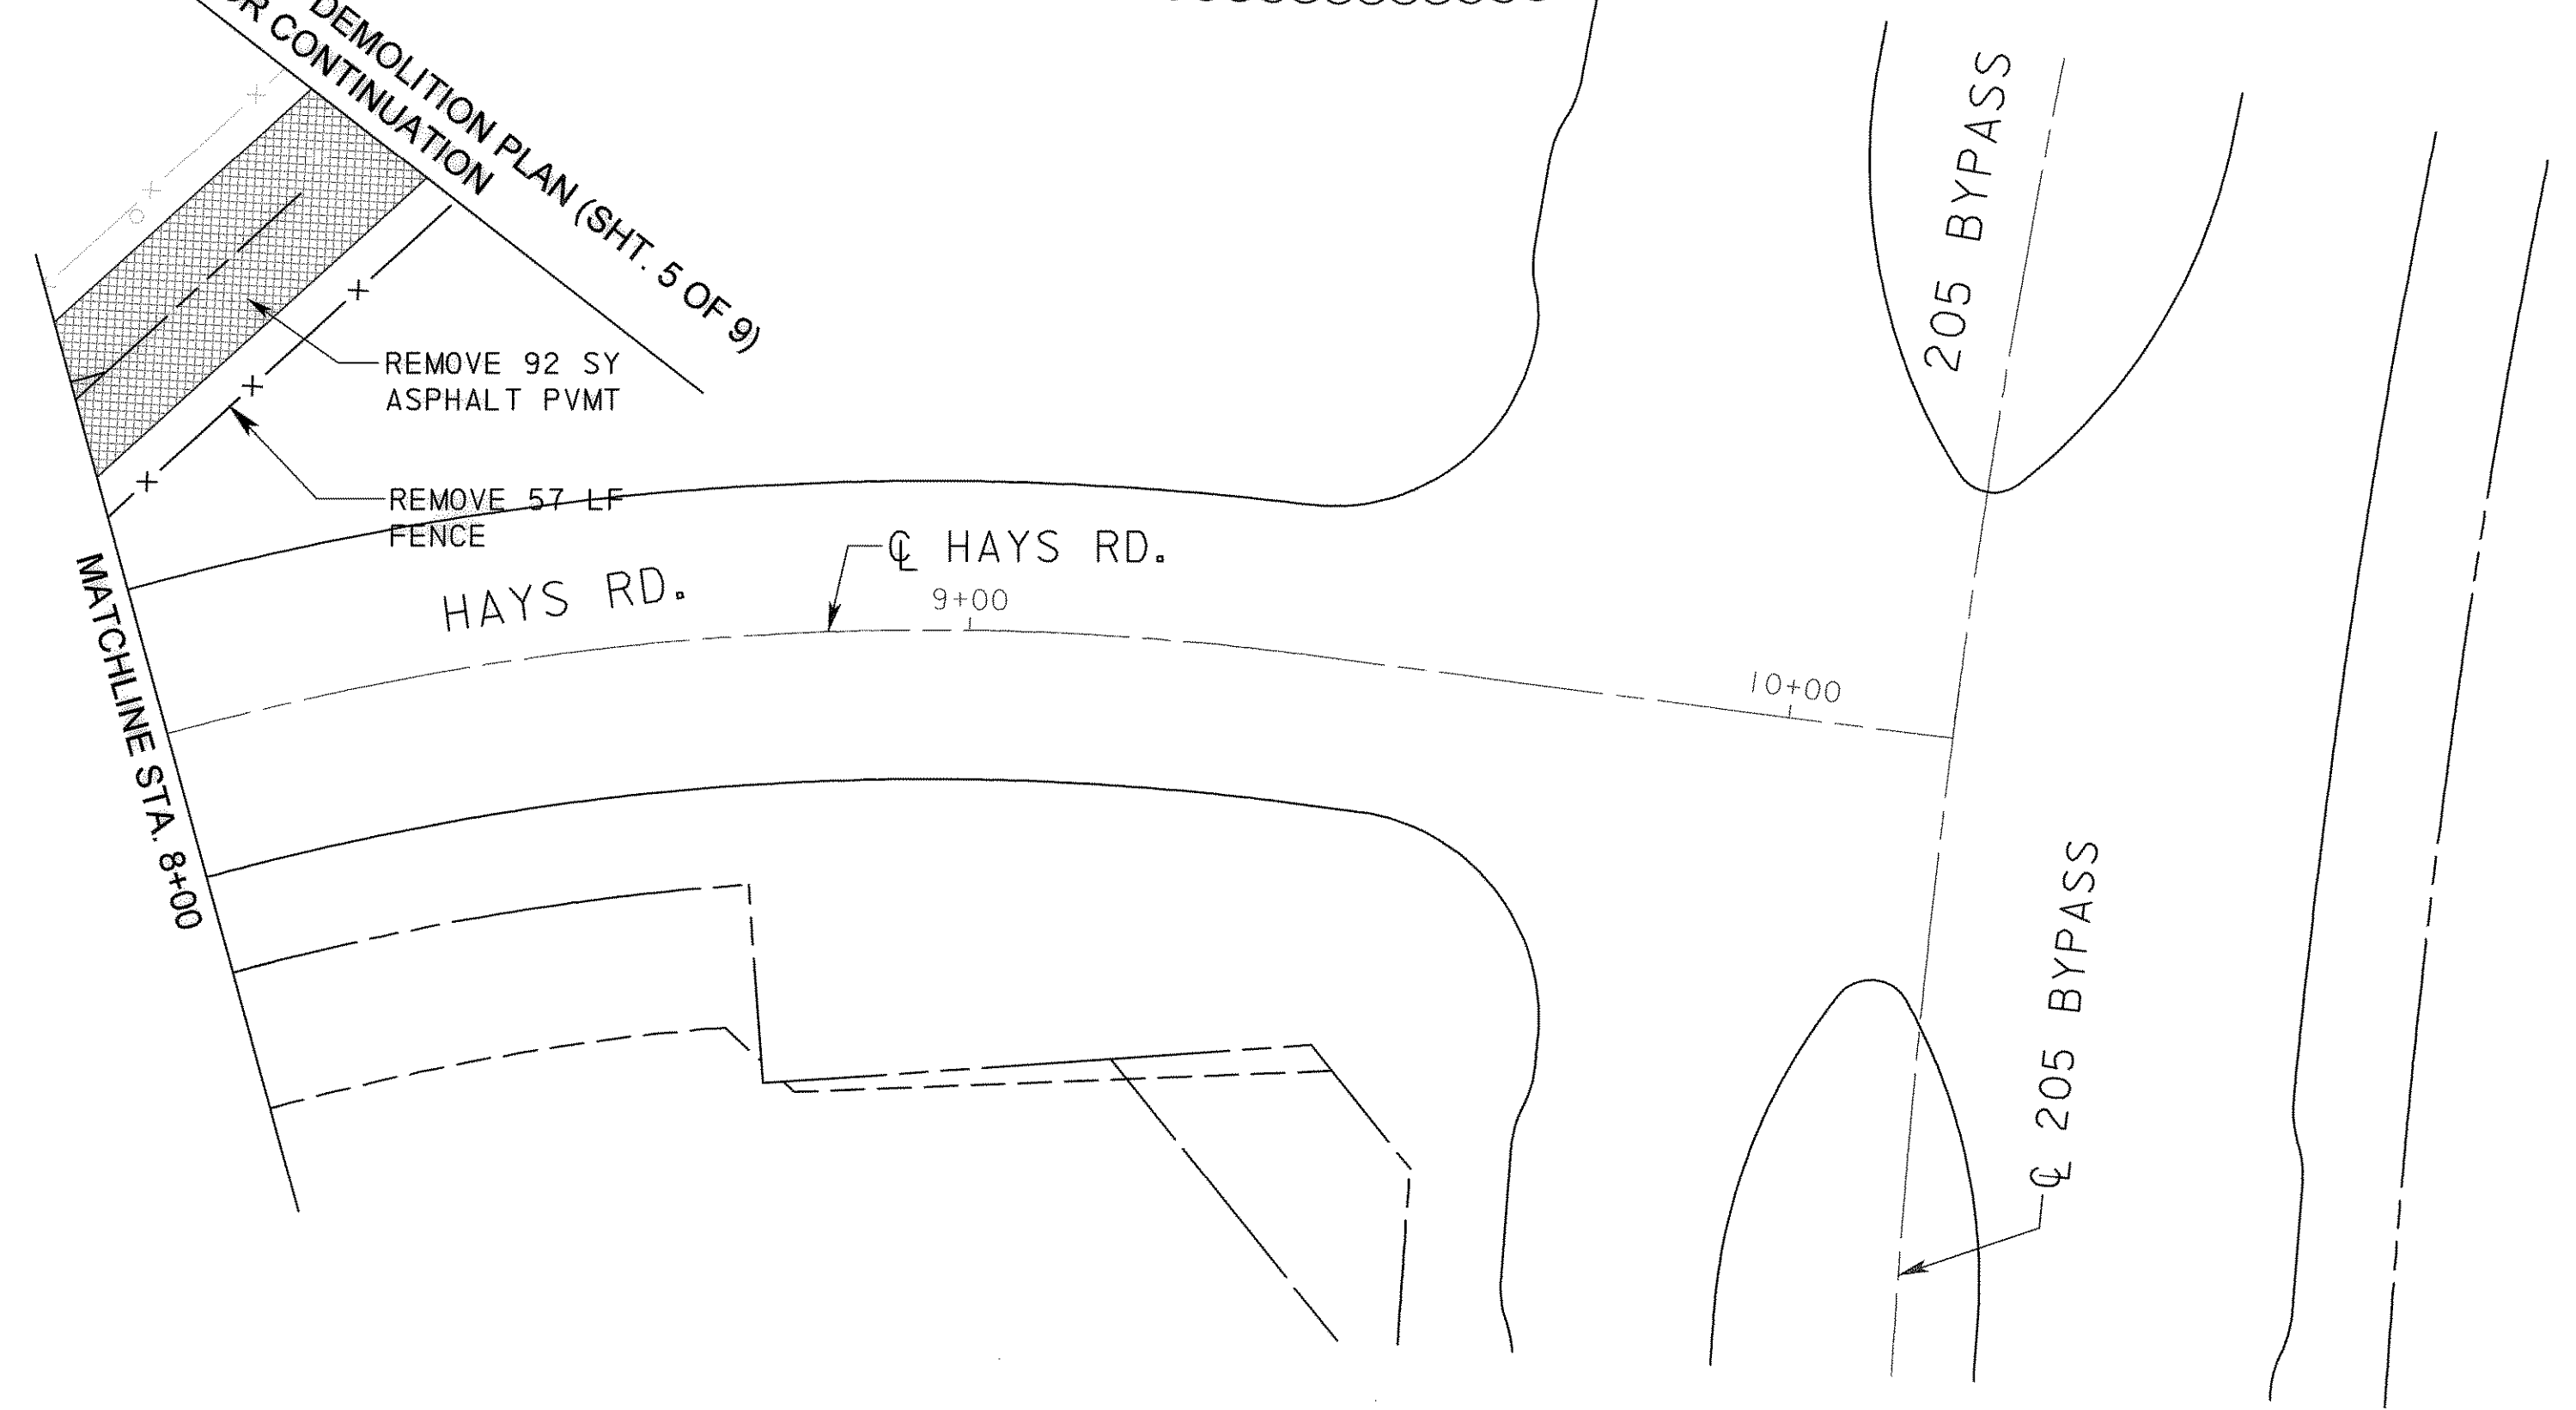

RECORD DRAWING
 This drawing is a compilation of the original sealed engineering drawing and modifications by addenda, change orders and information furnished by the contractor. Information shown that was provided by the contractor and others not associated with the design engineer cannot be verified for accuracy or completeness. Original sealed drawing is on file at the office of AECOM USA Group, Inc., TBPE REG. NO. F-3082

ORIGINAL DRAWING SEALED & SIGNED BY
 Matthew L. Abbe, P.E.
 TX NO. 92715

ADDENDUM NO. 3 - DELETED NOTE		TCB	8/7/07
NO.	REVISION	BY	DATE
205 BYPASS SECTION 1 DEMOLITION PLAN HAYS RD.			
TCB AECOM		<small>TCB INC. WWW.TCB.AECOM.COM 17300 DALLAS PARKWAY, SUITE 1010 DALLAS, TEXAS 75248</small>	
Unit	PW-DAL-FW	Scale: Horiz AS SHOWN Vert: AS SHOWN	Date 11/11/2009
Designed	SKW/MLA	Checked TCB	Project No. 60004153
Drawn	TCB	Approved TCB	Sheet 38 of 217

P:\14228\60004153-205Bypass\CADD\Sheets\Sheet1.dwg 10.7.09\0303Dem-HaysRd.dgn
 11/11/2009