



ITEM SPEC NO.	DESCRIPTION	UNIT	QUANTITY
100	PREP ROW (STORM DRAIN STRUCTURE REMOVAL)	LF	0
* 105	REMOVING STAB. BASE AND ASPHALT PVMT	SY	0
* 104	REMOVING CONCRETE (CONCRETE PVMT)	SY	0
100	PREP ROW (FENCE REMOVAL)	LF	196

NOTE: * THESE ITEMS ARE SUBSIDIARY TO ITEM 100.
ALL QUANTITIES SHOWN ARE FOR CONTRACTORS INFORMATION ONLY.

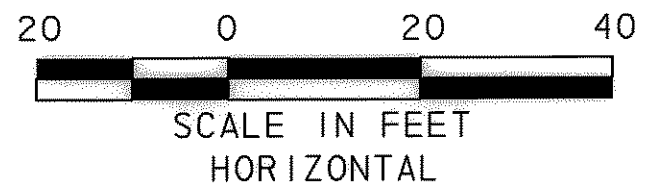

- LEGEND**
- EXIST. TREE TO REMAIN
 - EXIST. FENCE TO REMAIN
 - EXIST. TREE TO BE REMOVED
 - EXIST. FENCE TO BE REMOVED
 - EXIST. BRUSH & SMALL DIAMETER TREES TO BE REMOVED

- NOTES:**
- CONTRACTOR SHALL PAY FOR REMOVALS IN ACCORDANCE WITH PREPARING ROW, ITEM NO. 100.
 - QUANTITIES SHOWN ARE FOR CONTRACTOR'S INFORMATION ONLY.
 - FOR UTILITY ADJUSTMENTS, SEE THE UTILITY LAYOUT SHEETS.

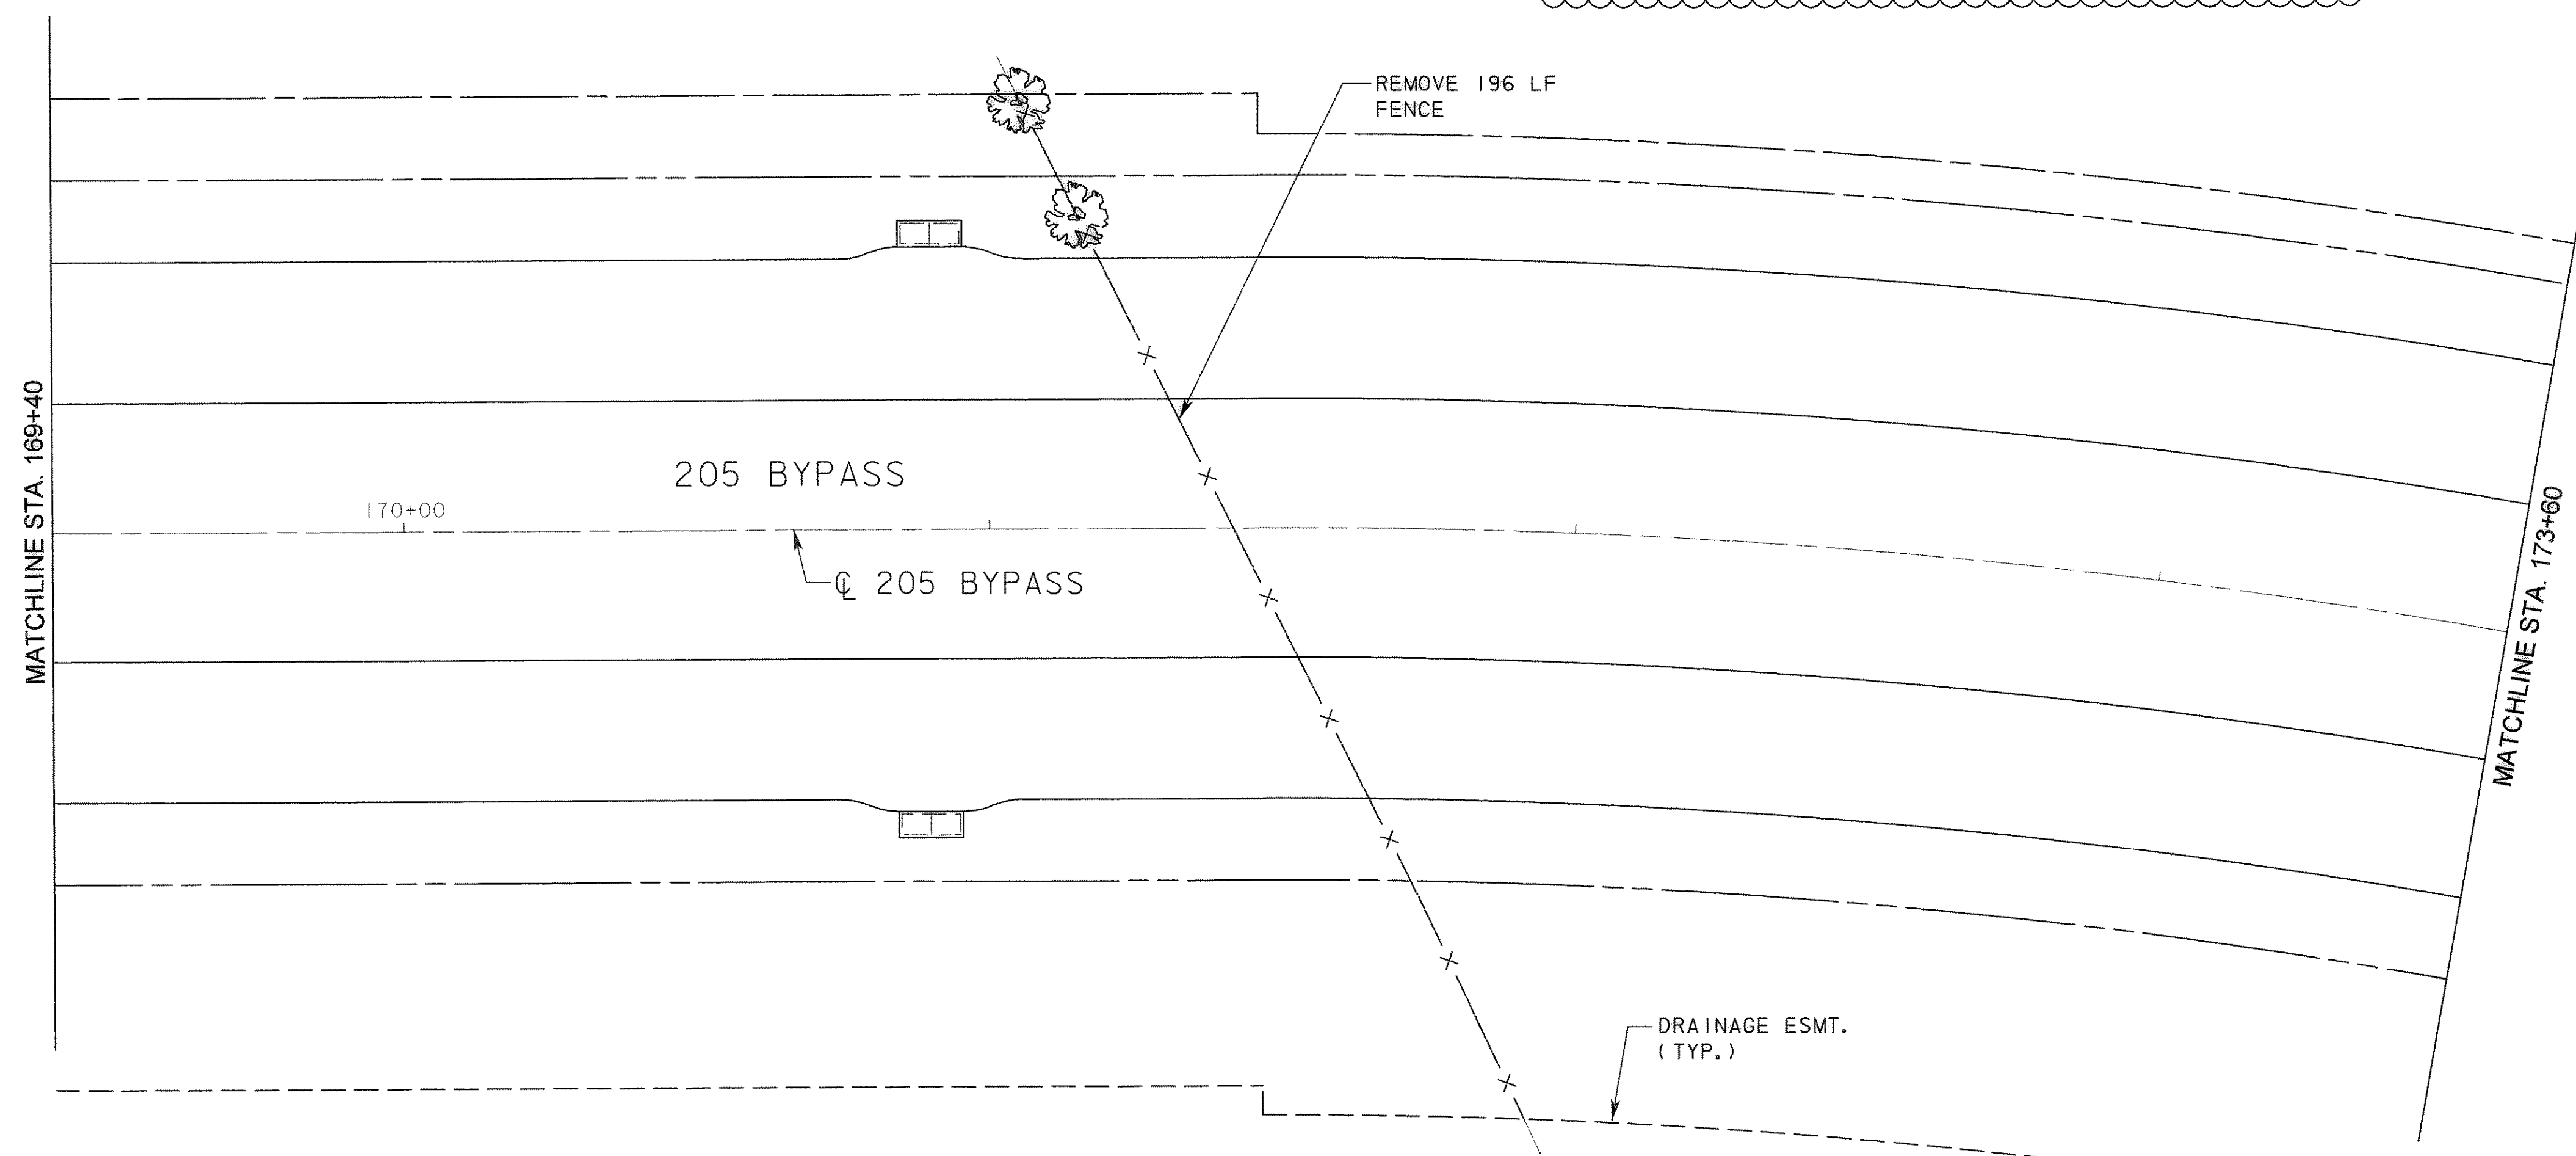

RECORD DRAWING
This drawing is a compilation of the original sealed engineering drawing and modifications by addenda, change orders and information furnished by the contractor. Information shown that was provided by the contractor and others not associated with the design engineer cannot be verified for accuracy or completeness. Original sealed drawing is on file at the office of AECOM USA Group, Inc., TBPE REG. NO. F-3082

ORIGINAL DRAWING SEALED & SIGNED BY
Matthew L. Abbe, P.E.
TX NO. 92715

ADDENDUM NO. 3 - DELETED NOTE	TCB	8/7/07
NO.	REVISION	BY DATE



205 BYPASS SECTION 1

DEMOLITION PLAN STA. 165+20 TO STA. 173+60

4 OF 9

TCB INC. WWW.TCB.AECOM.COM
17300 DALLAS PARKWAY, SUITE 1010
DALLAS, TEXAS 75248

Unit: PW-DAL-FW	Scale: Horiz AS SHOWN	Date: 11/11/2009
Designed: SKW/MLA	Checked: TCB	Project No. 60004153
Drawn: TCB	Approved: TCB	Sheet 31 of 217

P:\4228\00004153-205Bypass\CADD\Sheets\Section1\140-00-Top\FMS2\Record Drawing 10_7_09\031Demop-04.dgn
11/11/2009