
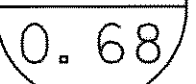





LEGEND

-  INLET DESIGNATION
-  AREA (AC)
-  INLET DRAINAGE BOUNDARY
-  SURFACE FLOW DIRECTION

NOTES:


1. TYPE H INLET AND THE STORM DRAIN SYSTEM WAS SIZED TO COLLECT EXISTING CONDITION DISCHARGES. ACCORDING TO CURRENT ROCKWALL DESIGN CRITERIA, ULTIMATE CONDITION DISCHARGES ARE TO BE DETAINED PRIOR TO ENTERING SYSTEM.
2. INLET B3 WAS SIZED BASED ON EXISTING WATERSHED CONDITIONS.
3. SEE HYDRAULIC DATA SHEETS FOR DRAINAGE CALCULATIONS.

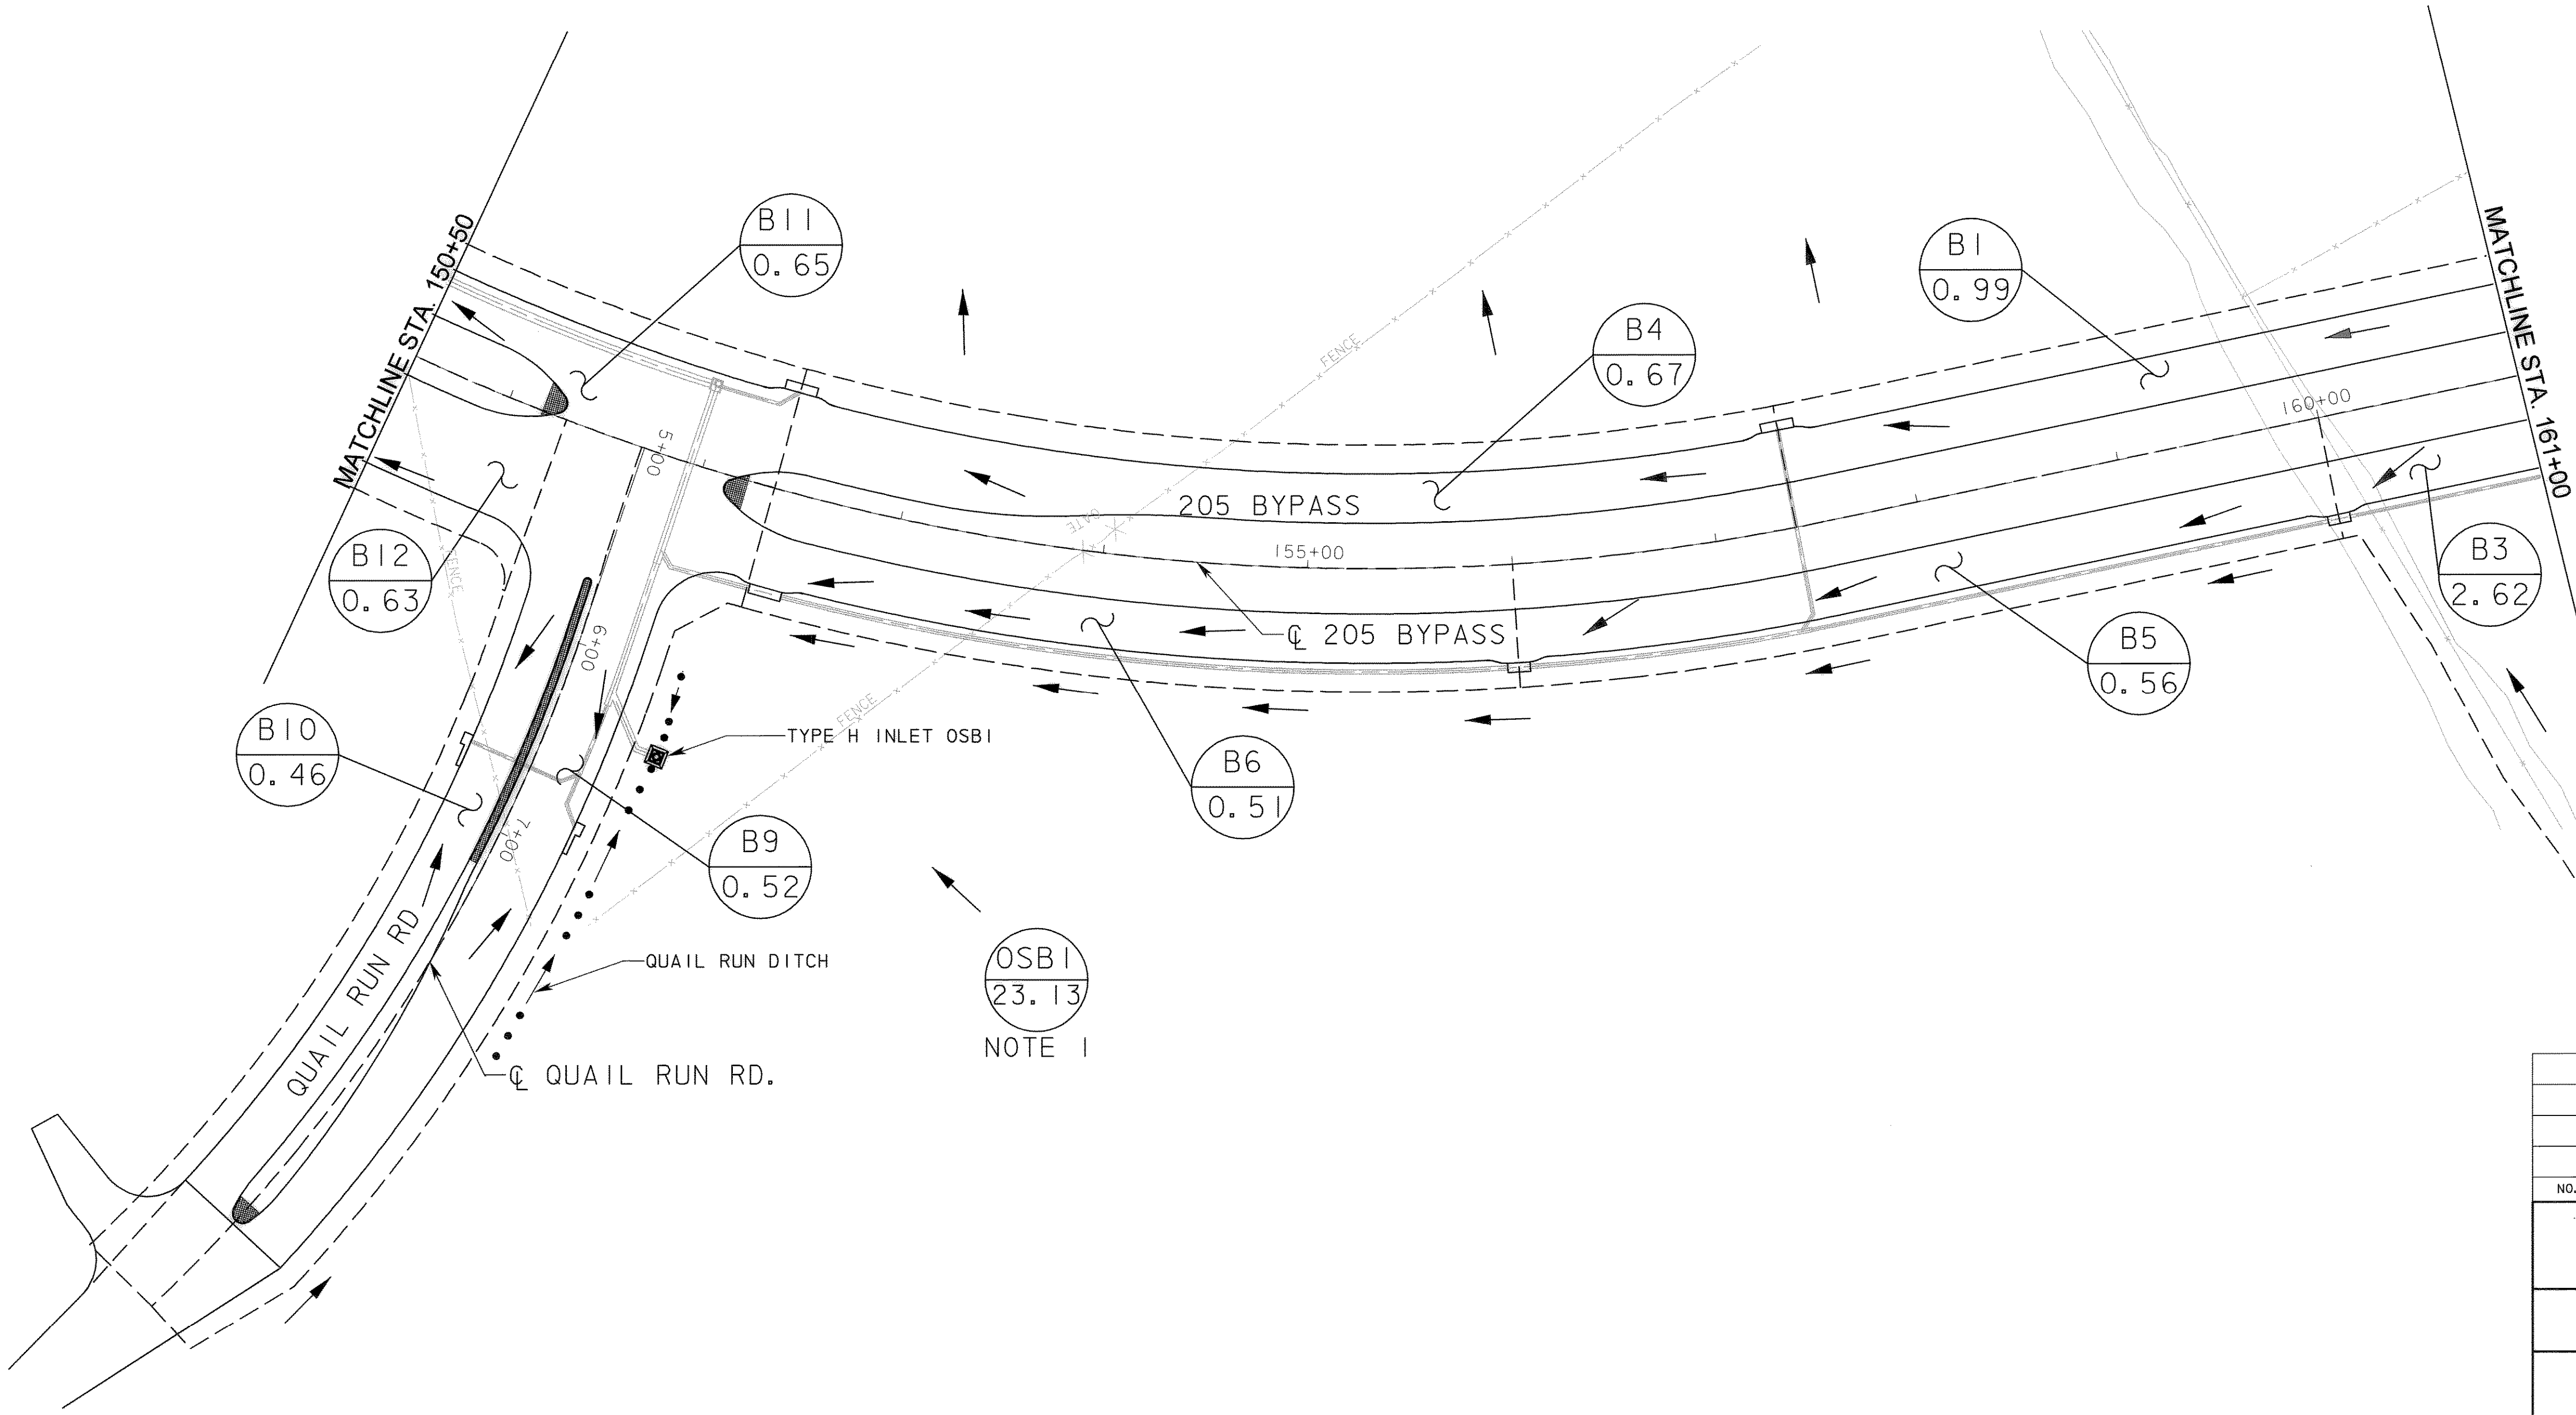

RECORD DRAWING
 This drawing is a compilation of the original sealed engineering drawing and modifications by addenda, change orders and information furnished by the contractor. Information shown that was provided by the contractor and others not associated with the design engineer cannot be verified for accuracy or completeness. Original sealed drawing is on file at the office of AECOM USA Group, Inc., TBPE REG. NO. F-3082

ORIGINAL DRAWING SEALED & SIGNED BY
 Matthew L. Abbe, P.E.
 TX NO. 92715

OSB1
 23.13
 NOTE 1

NO.	REVISION	BY	DATE
 City of Rockwall, Texas			
205 BYPASS SECTION 1			
DRAINAGE SYSTEM MAP STA. 150+50 TO STA. 161+00			
2 OF 7			
TCB AECOM			
<small>TCB INC. 17300 DALLAS PARKWAY, SUITE 1010 DALLAS, TEXAS 75248</small>			
Unit	PW-DAL-FW	Scale: Horz: AS SHOWN Vert: AS SHOWN	Date 11/11/2009
Designed	SRR/SDB	Checked TCB	Project No. 60004153
Drawn	FG	Approved TCB	Sheet 71 of 217

P:\4328\60004153-205Bypass\CADD\Sheets\Section1\140+00-To-FM652\Record Drawing 10_7_09\071DraIn_syst-02.dgn
 11/11/2009