
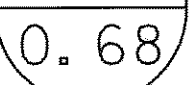





LEGEND

-  INLET DESIGNATION
-  AREA (AC)
-  INLET DRAINAGE BOUNDARY
-  SURFACE FLOW DIRECTION

NOTES:

1. FLOW FROM RSA2 WILL BE COLLECTED IN EXISTING HAYS ROAD DITCH, CONVEYED THROUGH HAYS DRIVEWAY CULVERT, AND CONTINUED ALONG 205 BYPASS TO STREAM 6 CULVERT. STORM DRAIN SYSTEM NOT SIZED TO HANDLE FLOW FROM RSA2.
2. SEE HYDRAULIC DATA SHEETS FOR DRAINAGE CALCULATIONS.
3. SEE CULVERT LAYOUT FOR CULVERT INFORMATION AND DRAINAGE DATA.

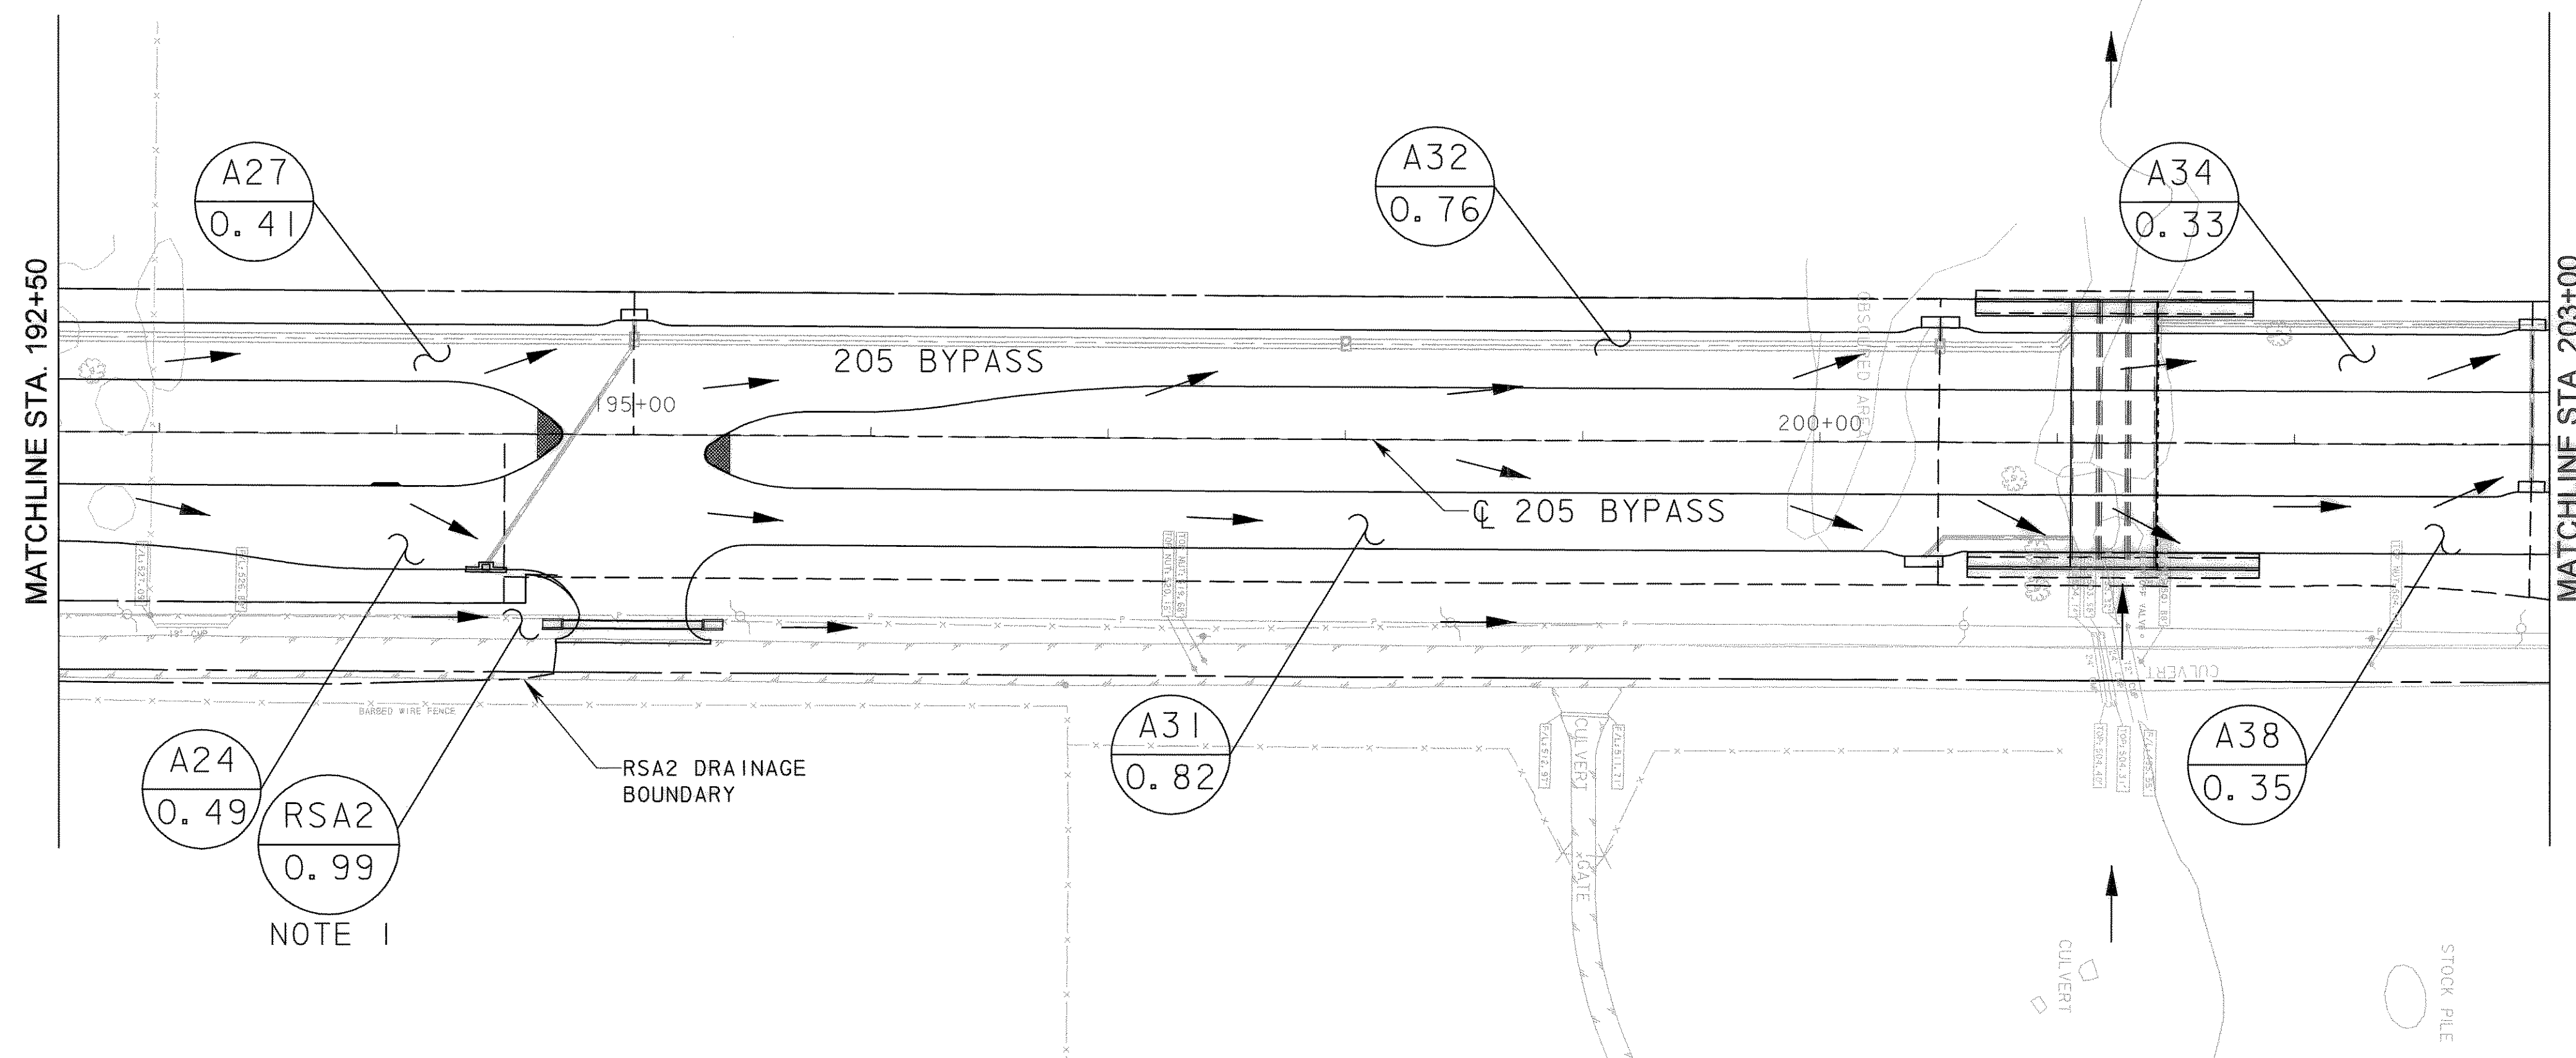

RECORD DRAWING

This drawing is a compilation of the original sealed engineering drawing and modifications by addenda, change orders and information furnished by the contractor. Information shown that was provided by the contractor and others not associated with the design engineer cannot be verified for accuracy or completeness. Original sealed drawing is on file at the office of AECOM USA Group, Inc., TBPE REG. NO. F-3082

ORIGINAL DRAWING
SEALED & SIGNED BY
Matthew L. Abbe, P.E.
TX NO. 92715

NO.	REVISION	BY	DATE



205 BYPASS
SECTION 1

DRAINAGE SYSTEM MAP
STA. 192+50 TO STA. 203+00

6 OF 7

TCB | AECOM
TCB INC. WWW.TCB.AECOM.COM
17300 DALLAS PARKWAY, SUITE 1010
DALLAS, TEXAS 75248

Unit	PW-DAL-FW	Scale:	Horz: AS SHOWN Vert: AS SHOWN	Date	11/11/2009
Designed	SRR/SDB	Checked	TCB	Project No.	60004153
Drawn	FG	Approved	TCB	Sheet	75 of 217