


P:\4328\60004153-205Bypass\CADD\Sheets\Section1 - 140-00-To-FM552\Record Drawing 10_7_09\0760Rain_syst-07.dgn
11/11/2009


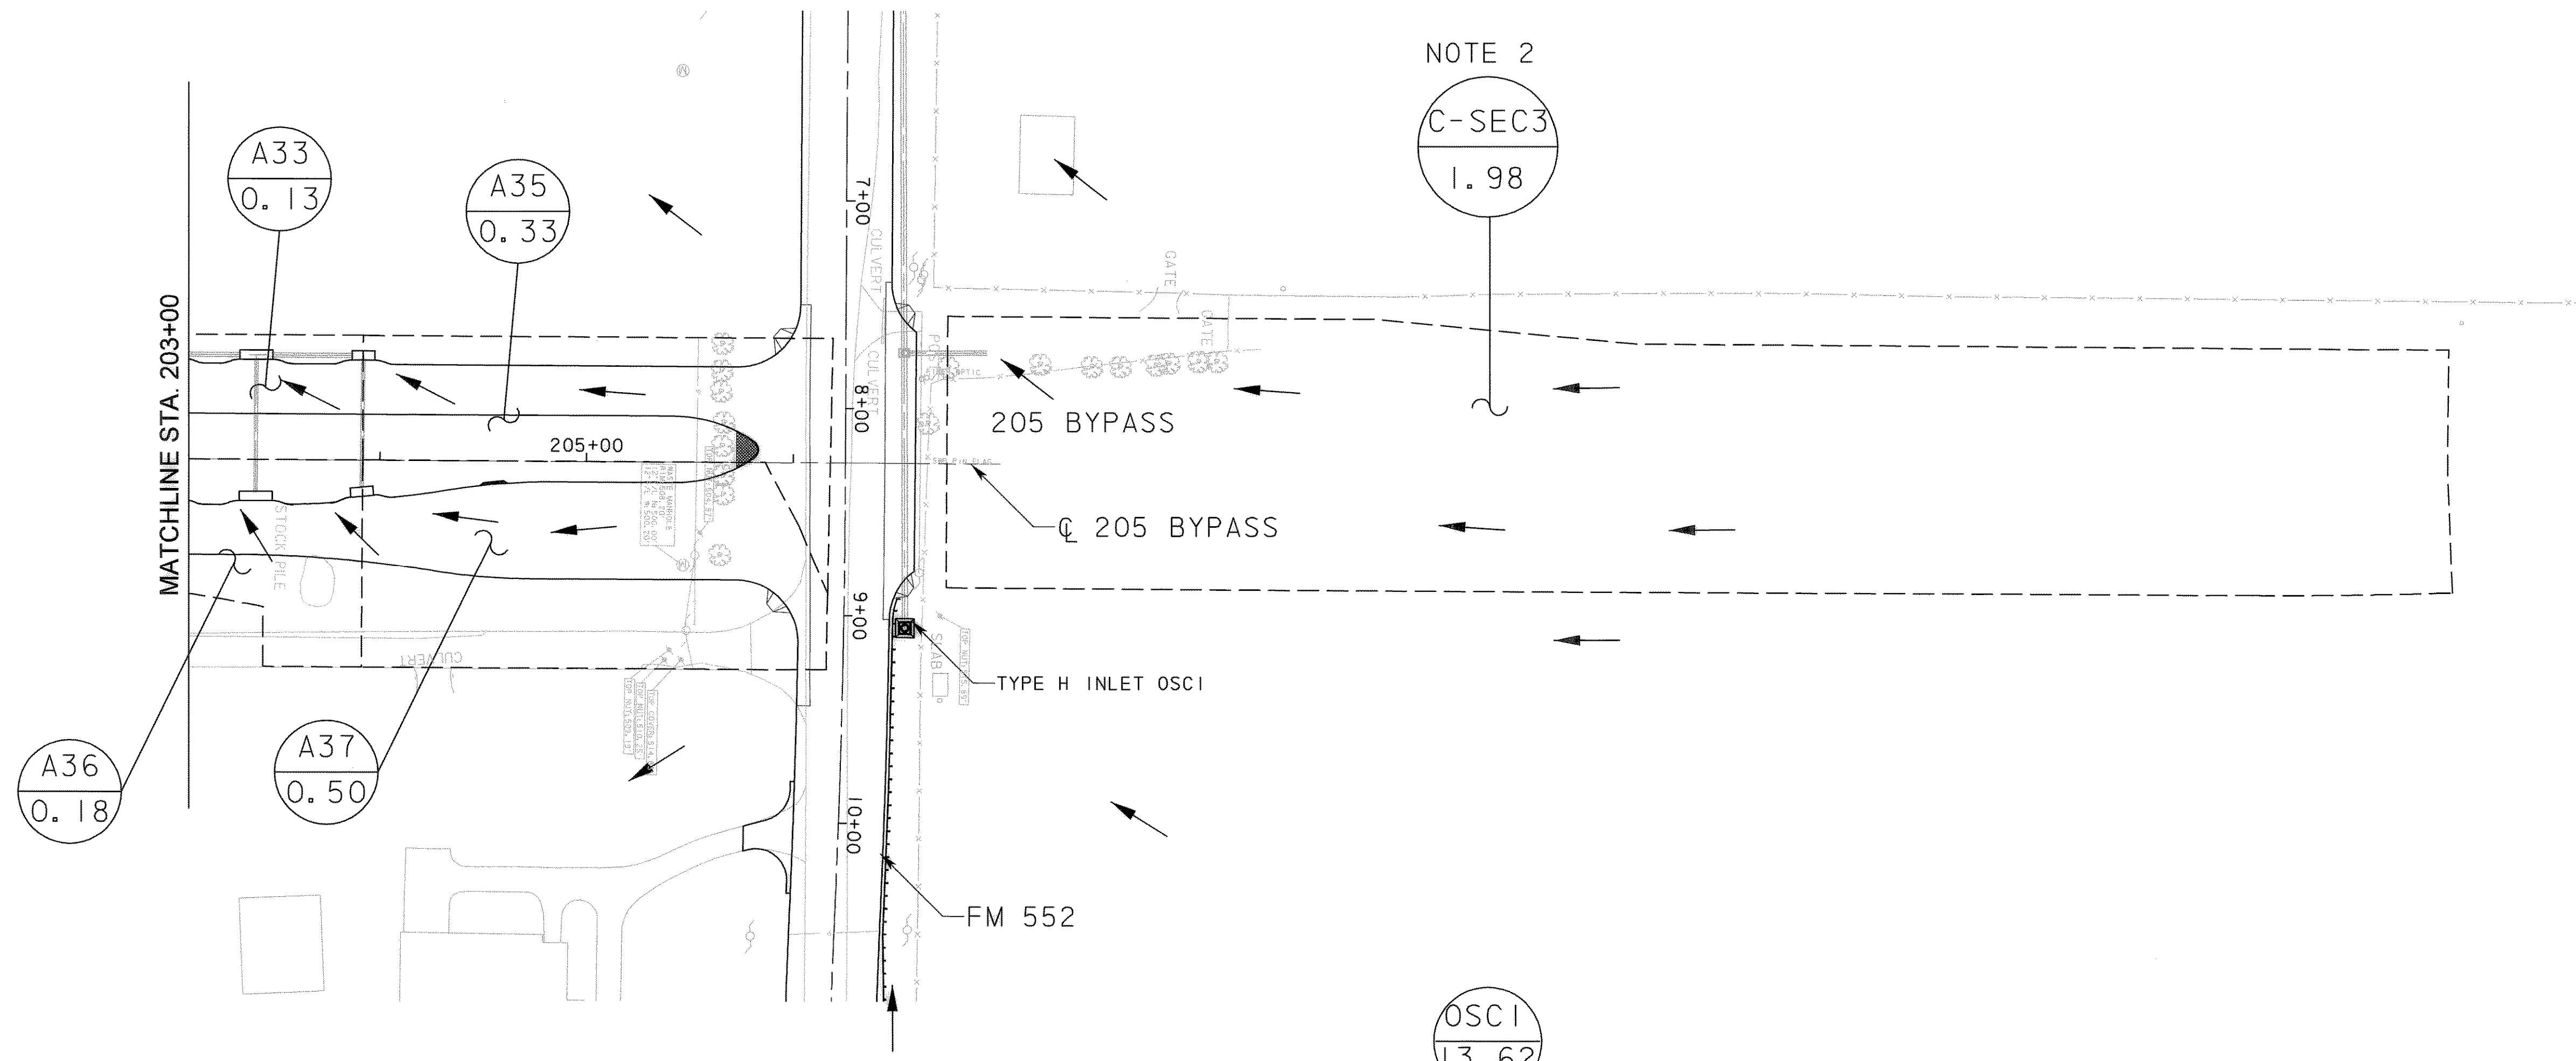


NOTE 2


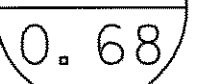
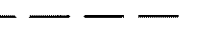

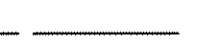
C-SEC3
1.98

OSC1
13.62

NOTE 1

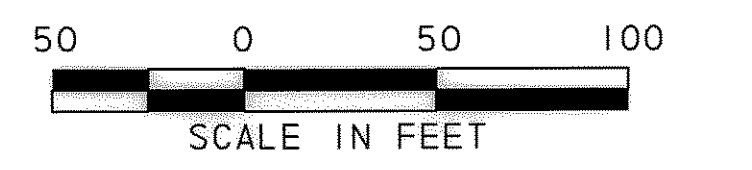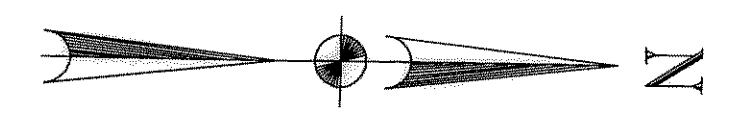

LEGEND

-  INLET DESIGNATION
-  AREA (AC)
-  INLET DRAINAGE BOUNDARY
-  SURFACE FLOW DIRECTION
-  PROPOSED ROW


NOTES:

1. TYPE H INLET AND THE STORM DRAIN SYSTEM WAS SIZED TO COLLECT EXISTING CONDITION DISCHARGES. ACCORDING TO CURRENT ROCKWALL DESIGN CRITERIA, ULTIMATE CONDITION DISCHARGES ARE TO BE DETAINED PRIOR TO ENTERING SYSTEM.
2. C-SEC3 REPRESENTS THE AREA FROM 205 BYPASS SECTION 3 THAT WILL TIE INTO MAHOLE J-SEC3 CONSTRUCTED IN SECTION 1.
3. SEE HYDRAULIC DATA SHEETS FOR DRAINAGE CALCULATIONS.

RECORD DRAWING
This drawing is a compilation of the original sealed engineering drawing and modifications by addenda, change orders and information furnished by the contractor. Information shown that was provided by the contractor and others not associated with the design engineer cannot be verified for accuracy or completeness. Original sealed drawing is on file at the office of AECOM USA Group, Inc., TBPE REG. NO. F-3082

ORIGINAL DRAWING
SEALED & SIGNED BY
Matthew L. Abbe, P.E.
TX NO. 92715

NO.	REVISION	BY	DATE

 **City of Rockwall, Texas**

**205 BYPASS
SECTION 1**

**DRAINAGE SYSTEM MAP
STA. 203+00 TO STA. 213+50**

TCB | AECOM
TCB INC. WWW.TCB.AECOM.COM
17300 DALLAS PARKWAY, SUITE 1010
DALLAS, TEXAS 75248

Unit: PW-DAL-FW	Scale: Horiz AS SHOWN Vert: AS SHOWN	Date: 11/11/2009
Designed: SRR/SDB	Checked: TCB	Project No. 60004153
Drawn: FG	Approved: TCB	Sheet 76 of 217