
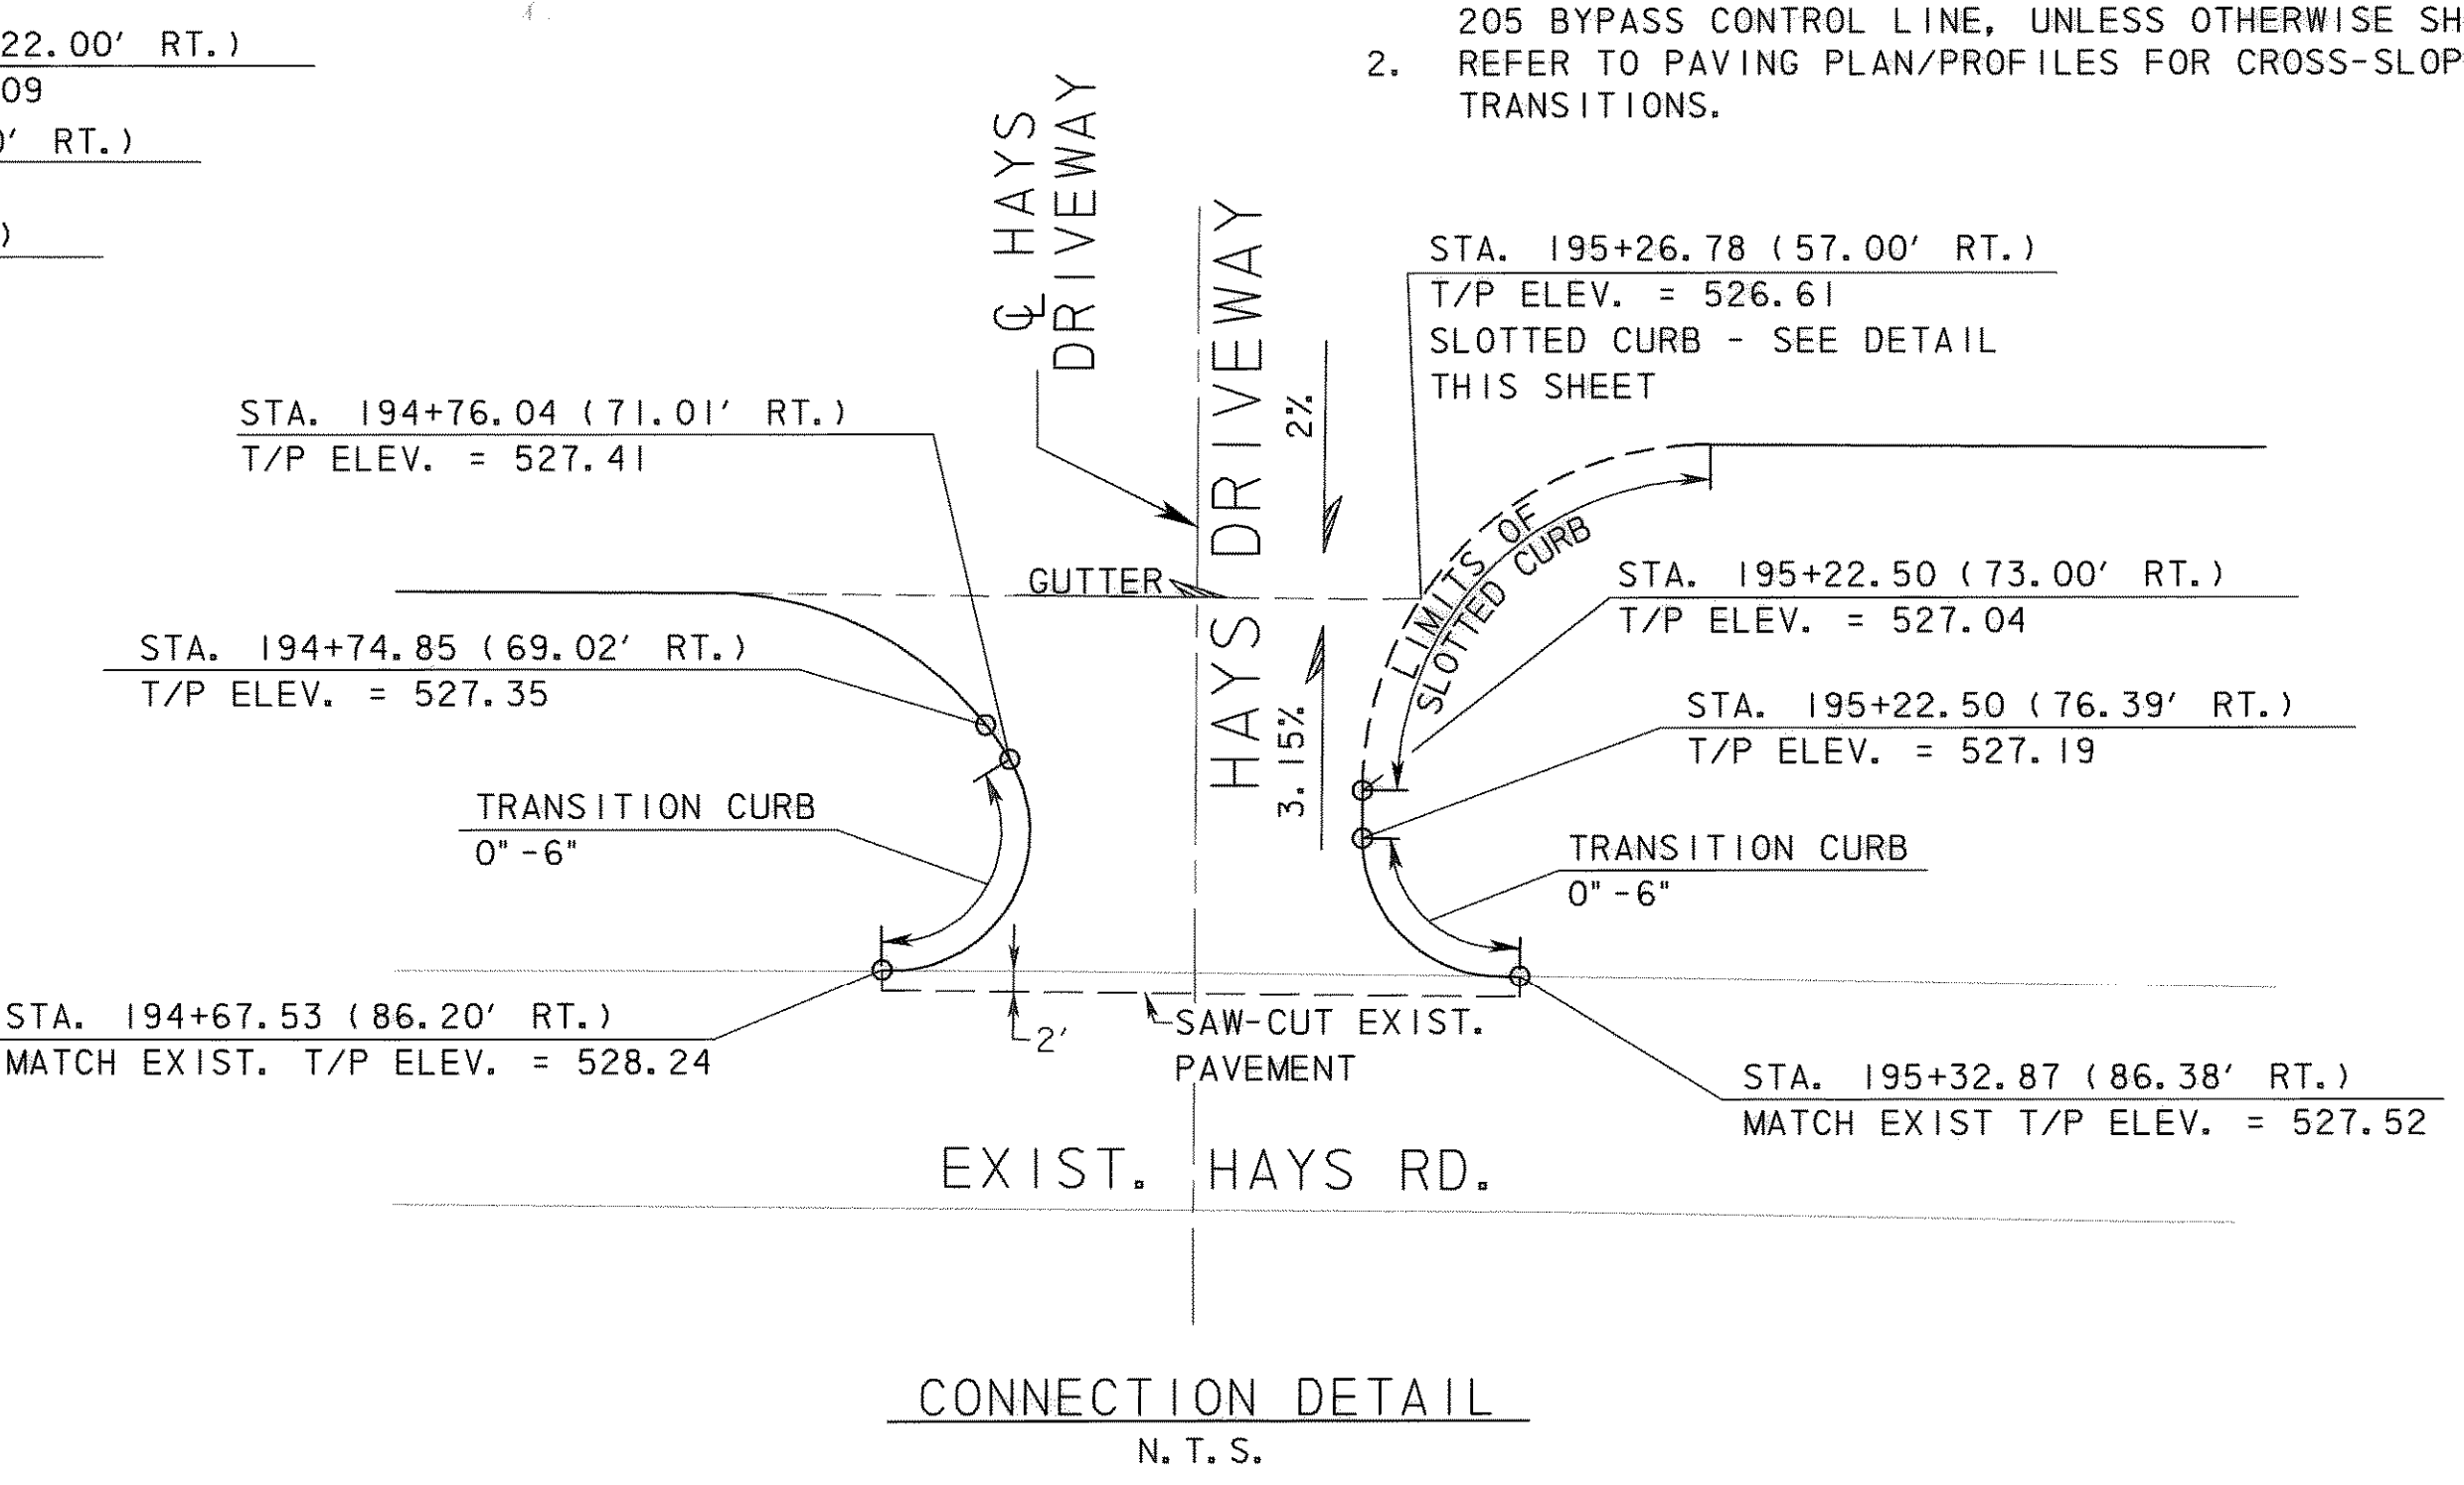


P:\4328\60004153-205Bypass\CADD\Sheets\Sheet\10-1-14\10-00-To-FM52\Record Drawing 10_1_09\0611\intersectLay-Hays Drive-02.dgn 11/11/2009

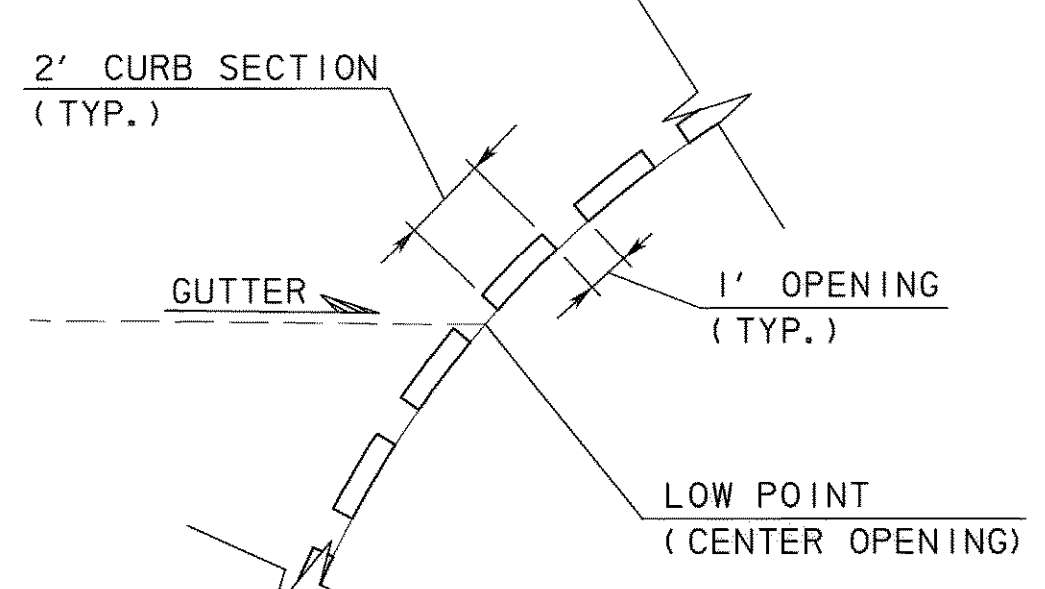

- NOTES:
1. STATION/OFFSETS SHOWN ARE REFERENCED FROM 205 BYPASS CONTROL LINE, UNLESS OTHERWISE SHOWN.
 2. REFER TO PAVING PLAN/PROFILES FOR CROSS-SLOPE TRANSITIONS.

RECORD DRAWING
 This drawing is a compilation of the original sealed engineering drawing and modifications by addenda, change orders and information furnished by the contractor. Information shown that was provided by the contractor and others not associated with the design engineer cannot be verified for accuracy or completeness. Original sealed drawing is on file at the office of AECOM USA Group, Inc., TBPE REG. NO. F-3082

ORIGINAL DRAWING SEALED & SIGNED BY
 Matthew L. Abbe, P.E.
 TX NO. 92715

NO.	REVISION	BY	DATE

City of Rockwall, Texas

205 BYPASS SECTION 1

HAYS DRIVEWAY INTERSECTION LAYOUT

2 OF 2

TCB | AECOM

TCB INC. WWW.TCB.AECOM.COM
 17300 DALLAS PARKWAY, SUITE 1010
 DALLAS, TEXAS 75248

Unit: PW-DAL-FW	Scale: Horiz AS SHOWN	Date: 11/11/2009
Designed: SKW/MLA	Checked: TCB	Project No: 60004153
Drawn: TCB	Approved: TCB	Sheet: 61 of 217