

NOTES:


1. ALL CONDUIT FOR ILLUMINATION ASSEMBLIES SHALL BE PLACED 3-FT FROM 205 BYPASS CENTERLINE.
2. CONDUIT INSTALLATION WILL BE PHASED IN FOLLOWING SUBGRADE OPERATIONS AND FOLLOWING UTILITY CONSTRUCTION, BUT PRIOR TO ROADWAY PAVEMENT CONSTRUCTION. IF CONSTRUCTION ACTIVITIES REQUIRE CONDUIT PLACEMENT AFTER STREET PAVEMENT CONSTRUCTION, THEN CONDUIT WILL NEED TO BE BORED FOR PLACEMENT. OPEN CUT METHOD OF CONDUIT PLACEMENT WILL NOT BE PERMITTED ON NEW PAVEMENT.
3. CONDUIT LENGTHS SHOWN REPRESENT ENTIRE RUN (GROUND BOX-TO-GROUND BOX).
4. IRRIGATION SLEEVES SHOULD BE INSTALLED 1-FT AWAY FROM BOXES SHOWN ON PLANS, AND NOT CONNECT TO BOXES.

LEGEND

■ EB	PROPOSED ELEC. GROUND BOX
—	PROPOSED 2' CONDUIT
- - - -	PROPOSED 4' IRRIGATION SLEEVE
■ VB	PROPOSED IRRIG. VALVE BOX
○ PB	PROPOSED ILLUMINATION POLE BASE FOUNDATION FOR 30' POLE.

RECORD DRAWING
 This drawing is a compilation of the original sealed engineering drawing and modifications by addenda, change orders and information furnished by the contractor. Information shown that was provided by the contractor and others not associated with the design engineer cannot be verified for accuracy or completeness. Original sealed drawing is on file at the office of AECOM USA Group, Inc., TBPE REG. NO. F-3082.

ORIGINAL DRAWING SEALED & SIGNED BY
 T.H. Gaertner, P.E.
 TX NO. 37124

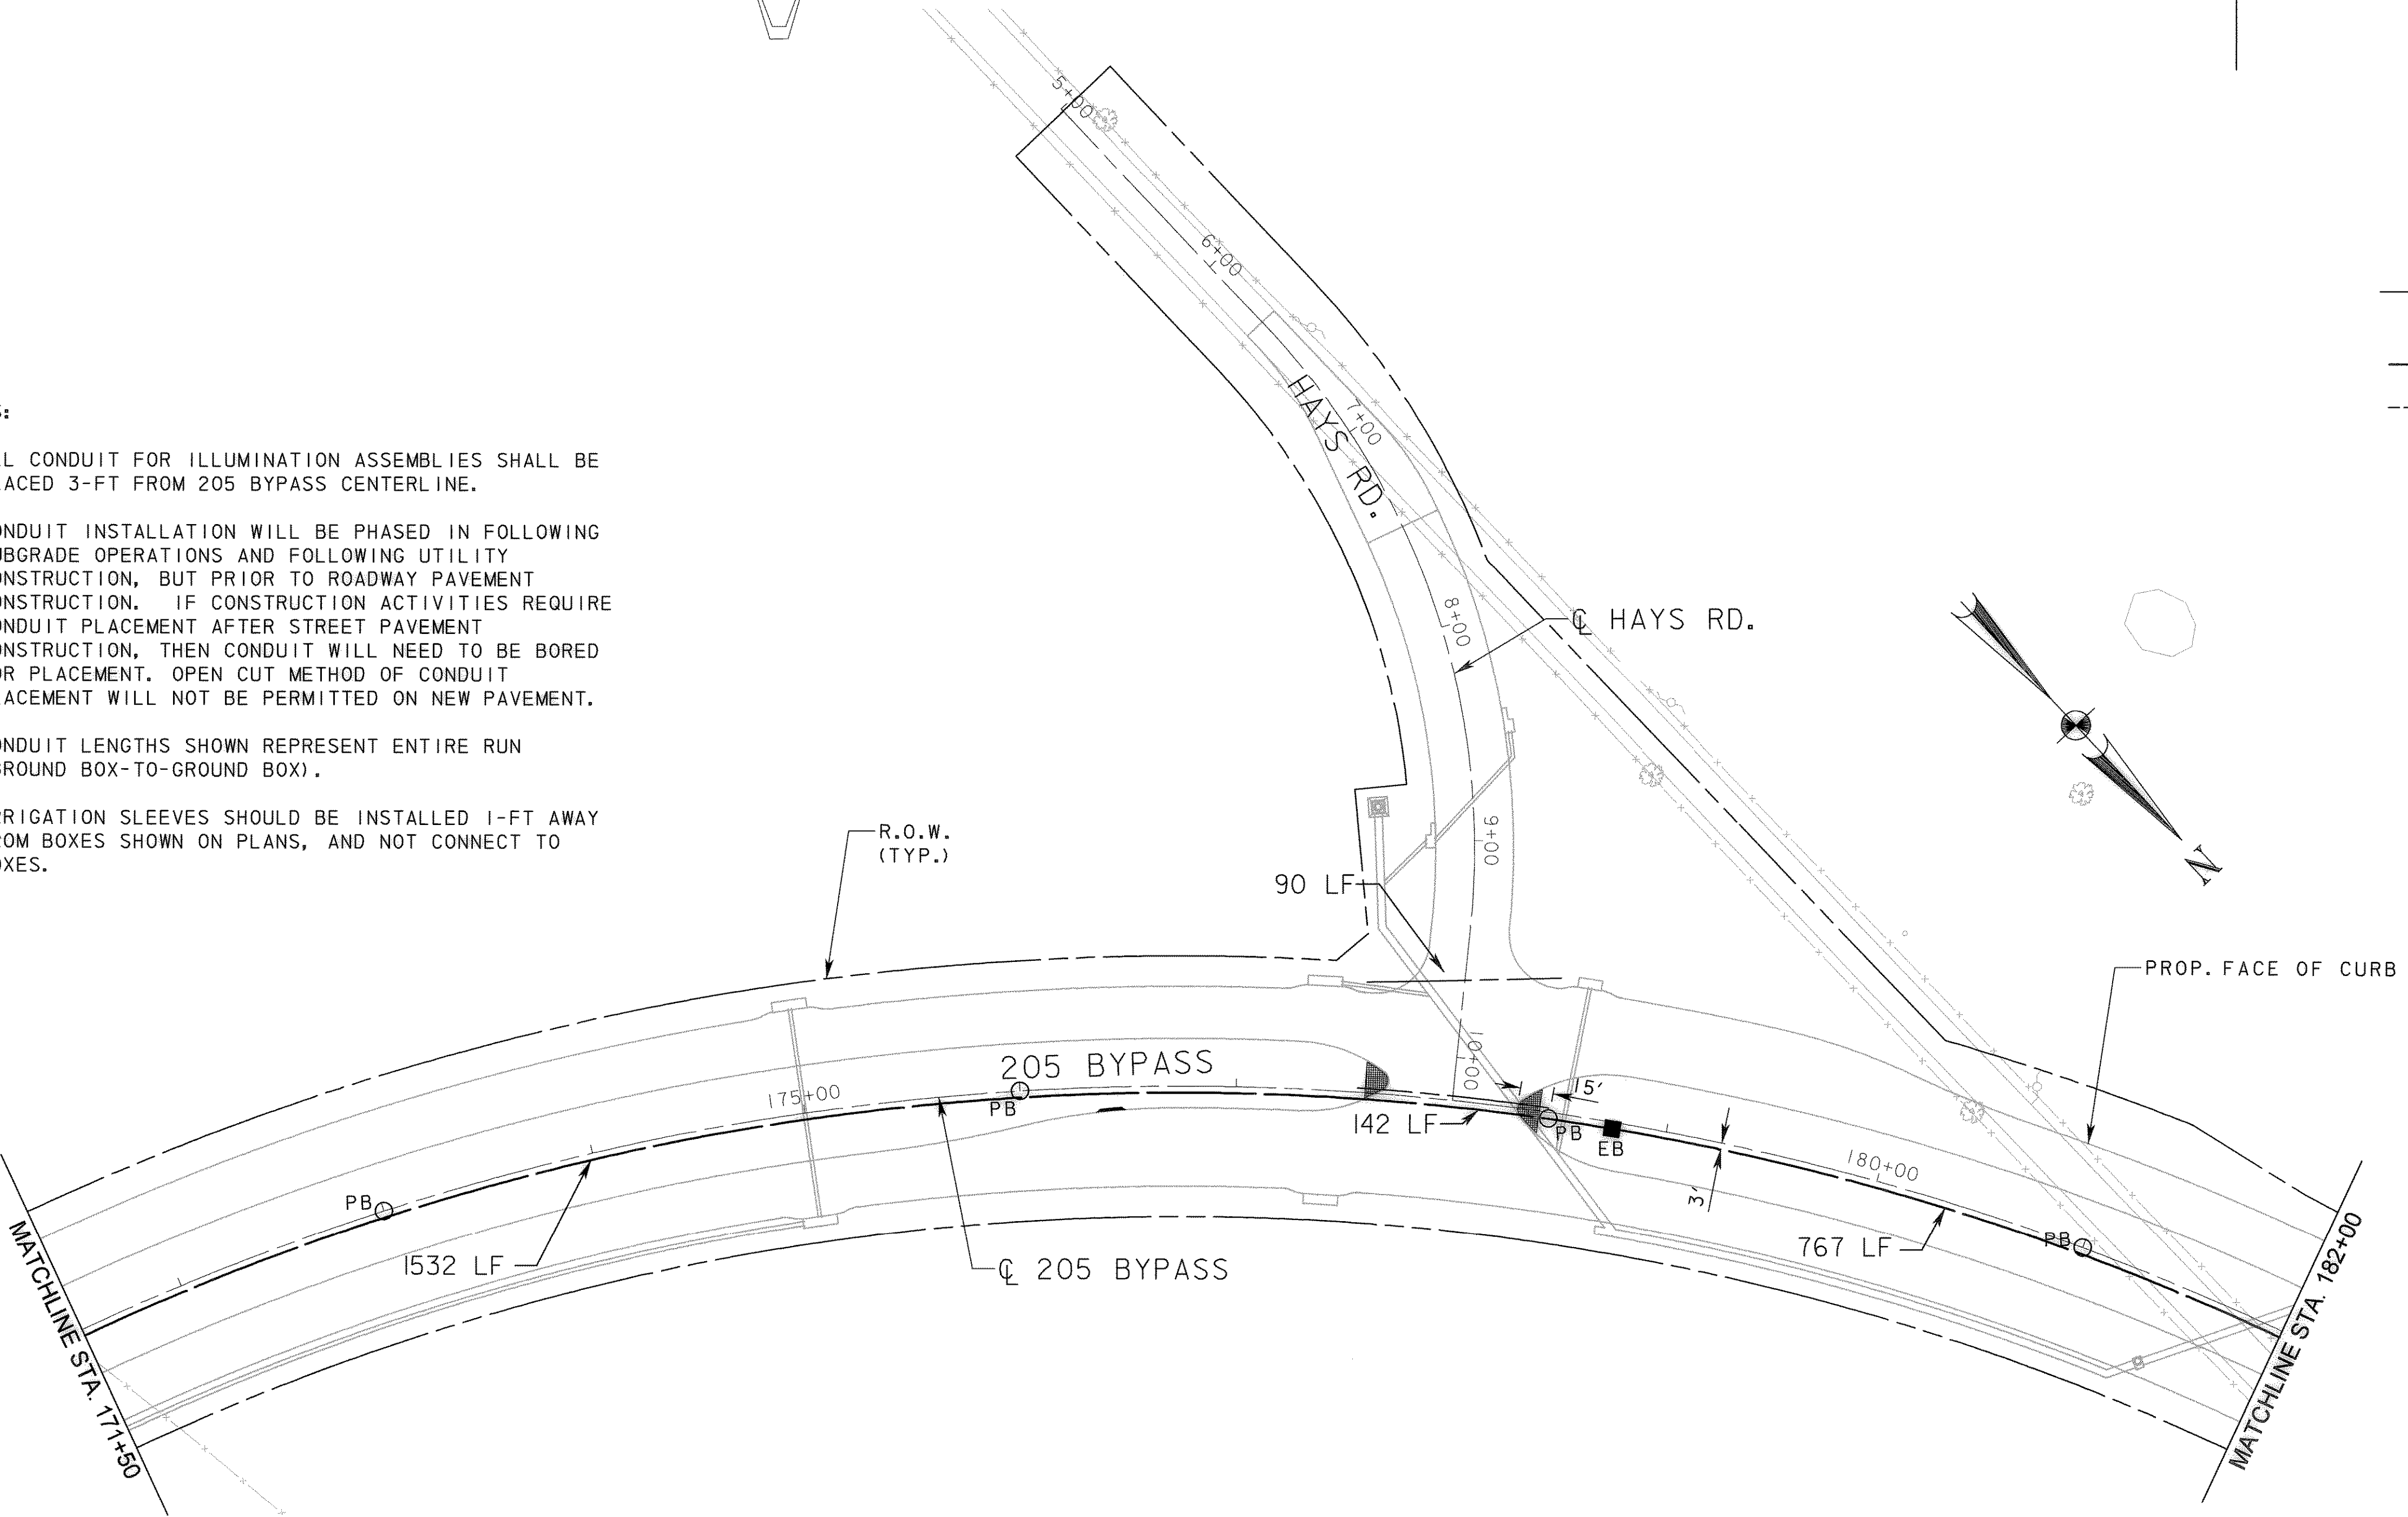

NO.	REVISION	BY	DATE
I	ADDED ILLUMINATION POLE BASES	THG	6/16/08

City of Rockwall, Texas

205 BYPASS SECTION 1

ILLUMINATION & IRRIGATION PLAN

2 OF 3

TCB AECOM
 TCB INC. WWW.TCB.AECOM.COM
 17300 DALLAS PARKWAY, SUITE 1010
 DALLAS, TEXAS 75248

Unit	PW-DAL-FW	Scale: Horz: AS SHOWN	Date	11/11/2009
Designed	THG	Checked	TCB	Project No. 60004153
Drawn	FG	Approved	TCB	Sheet 110 of 217

P:\4328\60004153-205Bypass\CADD\Sheets\Section1-140-00-To-FM55\Record Drawing 10.7.08\110111umirrig-02.dgn
 11/11/2009