


NOTES:

1. FLOWLINE ELEVATIONS AND GRADES ARE CALCULATED FROM APPROPRIATE CENTER TO CENTER OF PROPOSED DRAINAGE STRUCTURES. PIPE LENGTHS ON PLANS ARE ACTUAL LENGTHS USED IN QUANTITY TAKEOFFS.
2. ALL UTILITIES SHOWN ARE APPROXIMATE AND SHOULD BE FIELD VERIFIED AS TO THE LOCATION AND DEPTH PRIOR TO CONSTRUCTION.
3. ALL STORM DRAIN PIPE IS CLASS III UNLESS OTHERWISE NOTED.
4. REFER TO TABLE FOR MANHOLE DIMENSIONS.
5. THE CONTROL POINT FOR RECESSED CURB INLETS IS AT THE CENTER OF THE OUTSIDE FACE OF THE INLET.
6. FOR RECESSED CURB INLETS, VARIABLE DIMENSION "W," AS SHOWN ON THE NCTCOG STANDARDS, SHALL BE 3.5-FT.
7. CONTRACTOR TO INSTALL CEMENT TREATED BACKFILL TO THE SPRINGLINE OF THE DRAINAGE PIPE FOR SLOPES GREATER THAN 10%.
8. FOR TYPE C INLETS, THE GUTTER DEPRESSION WIDTH SHALL BE 2-FT AND THE GUTTER DEPRESSION DEPTH SHALL BE 0.25 FT.

**RECORD DRAWING**  
This drawing is a compilation of the original sealed engineering drawing and modifications by addenda, change orders and information furnished by the contractor. Information shown that was provided by the contractor and others not associated with the design engineer cannot be verified for accuracy or completeness. Original sealed drawing is on file at the office of AECOM USA Group, Inc. TBPE REG. NO. F-3082

**ORIGINAL DRAWING  
SEALED & SIGNED BY**  
Matthew L. Abbe, P.E.  
TX NO. 92715

NO.	DESCRIPTION	THG	DATE
1	INLET A24		01/10/08
	REVISION	BY	DATE

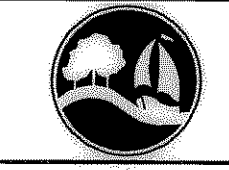

City of Rockwall, Texas

205 BYPASS  
SECTION 1

LATERAL PROFILES  
LINE A

2 OF 4

TCB AECOM  
TCB INC.  
WWW.TCB.AECOM.COM  
17300 DALLAS PARKWAY, SUITE 1010  
DALLAS, TEXAS 75248

Unit	Scale	Horz. AS SHOWN	Vert. AS SHOWN	Date
PW-DAL-FW		AS SHOWN	AS SHOWN	11/11/2009
Designed	SRR/SDB	Checked	TCB	Project No. 60004153
Drawn	FG	Approved	TCB	Sheet 100 of 217

P:\4328\60004153-205Bypass\CA00\Sheets\Sect1\01-140+00-To-FM552\Record Draw\Fig 10-7-09\FM552\form\lateral-02.dgn 11/11/2009

