
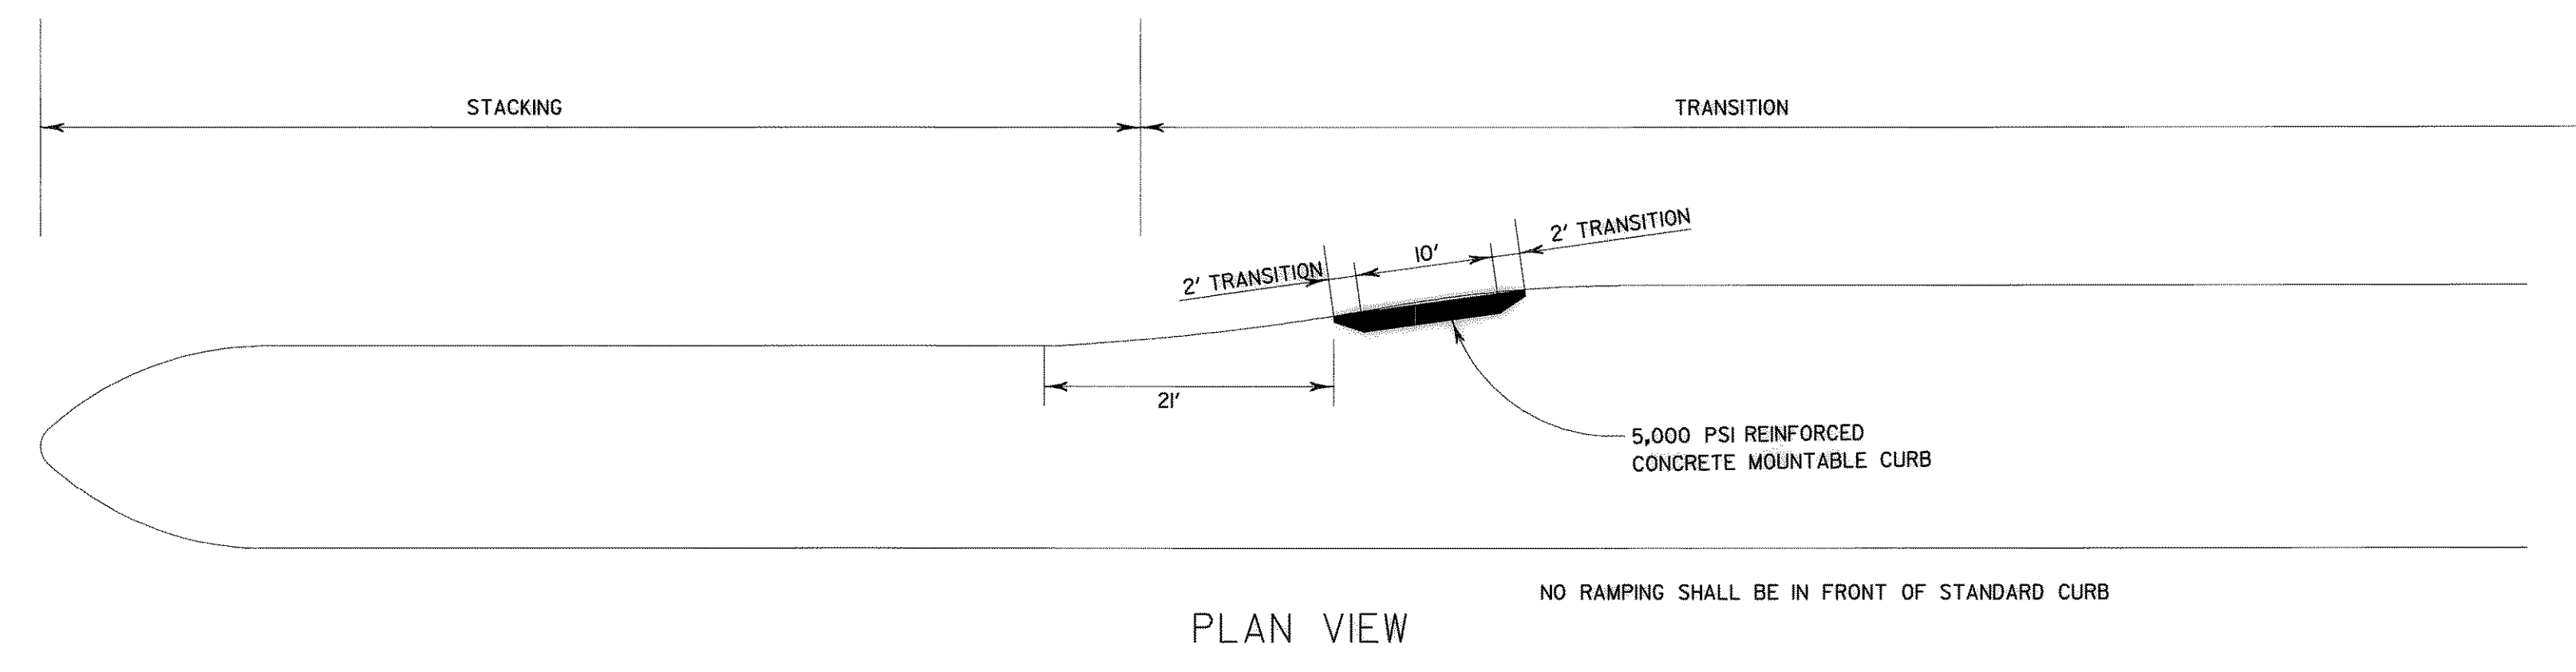


STREET MARKING DETAIL
N.T.S

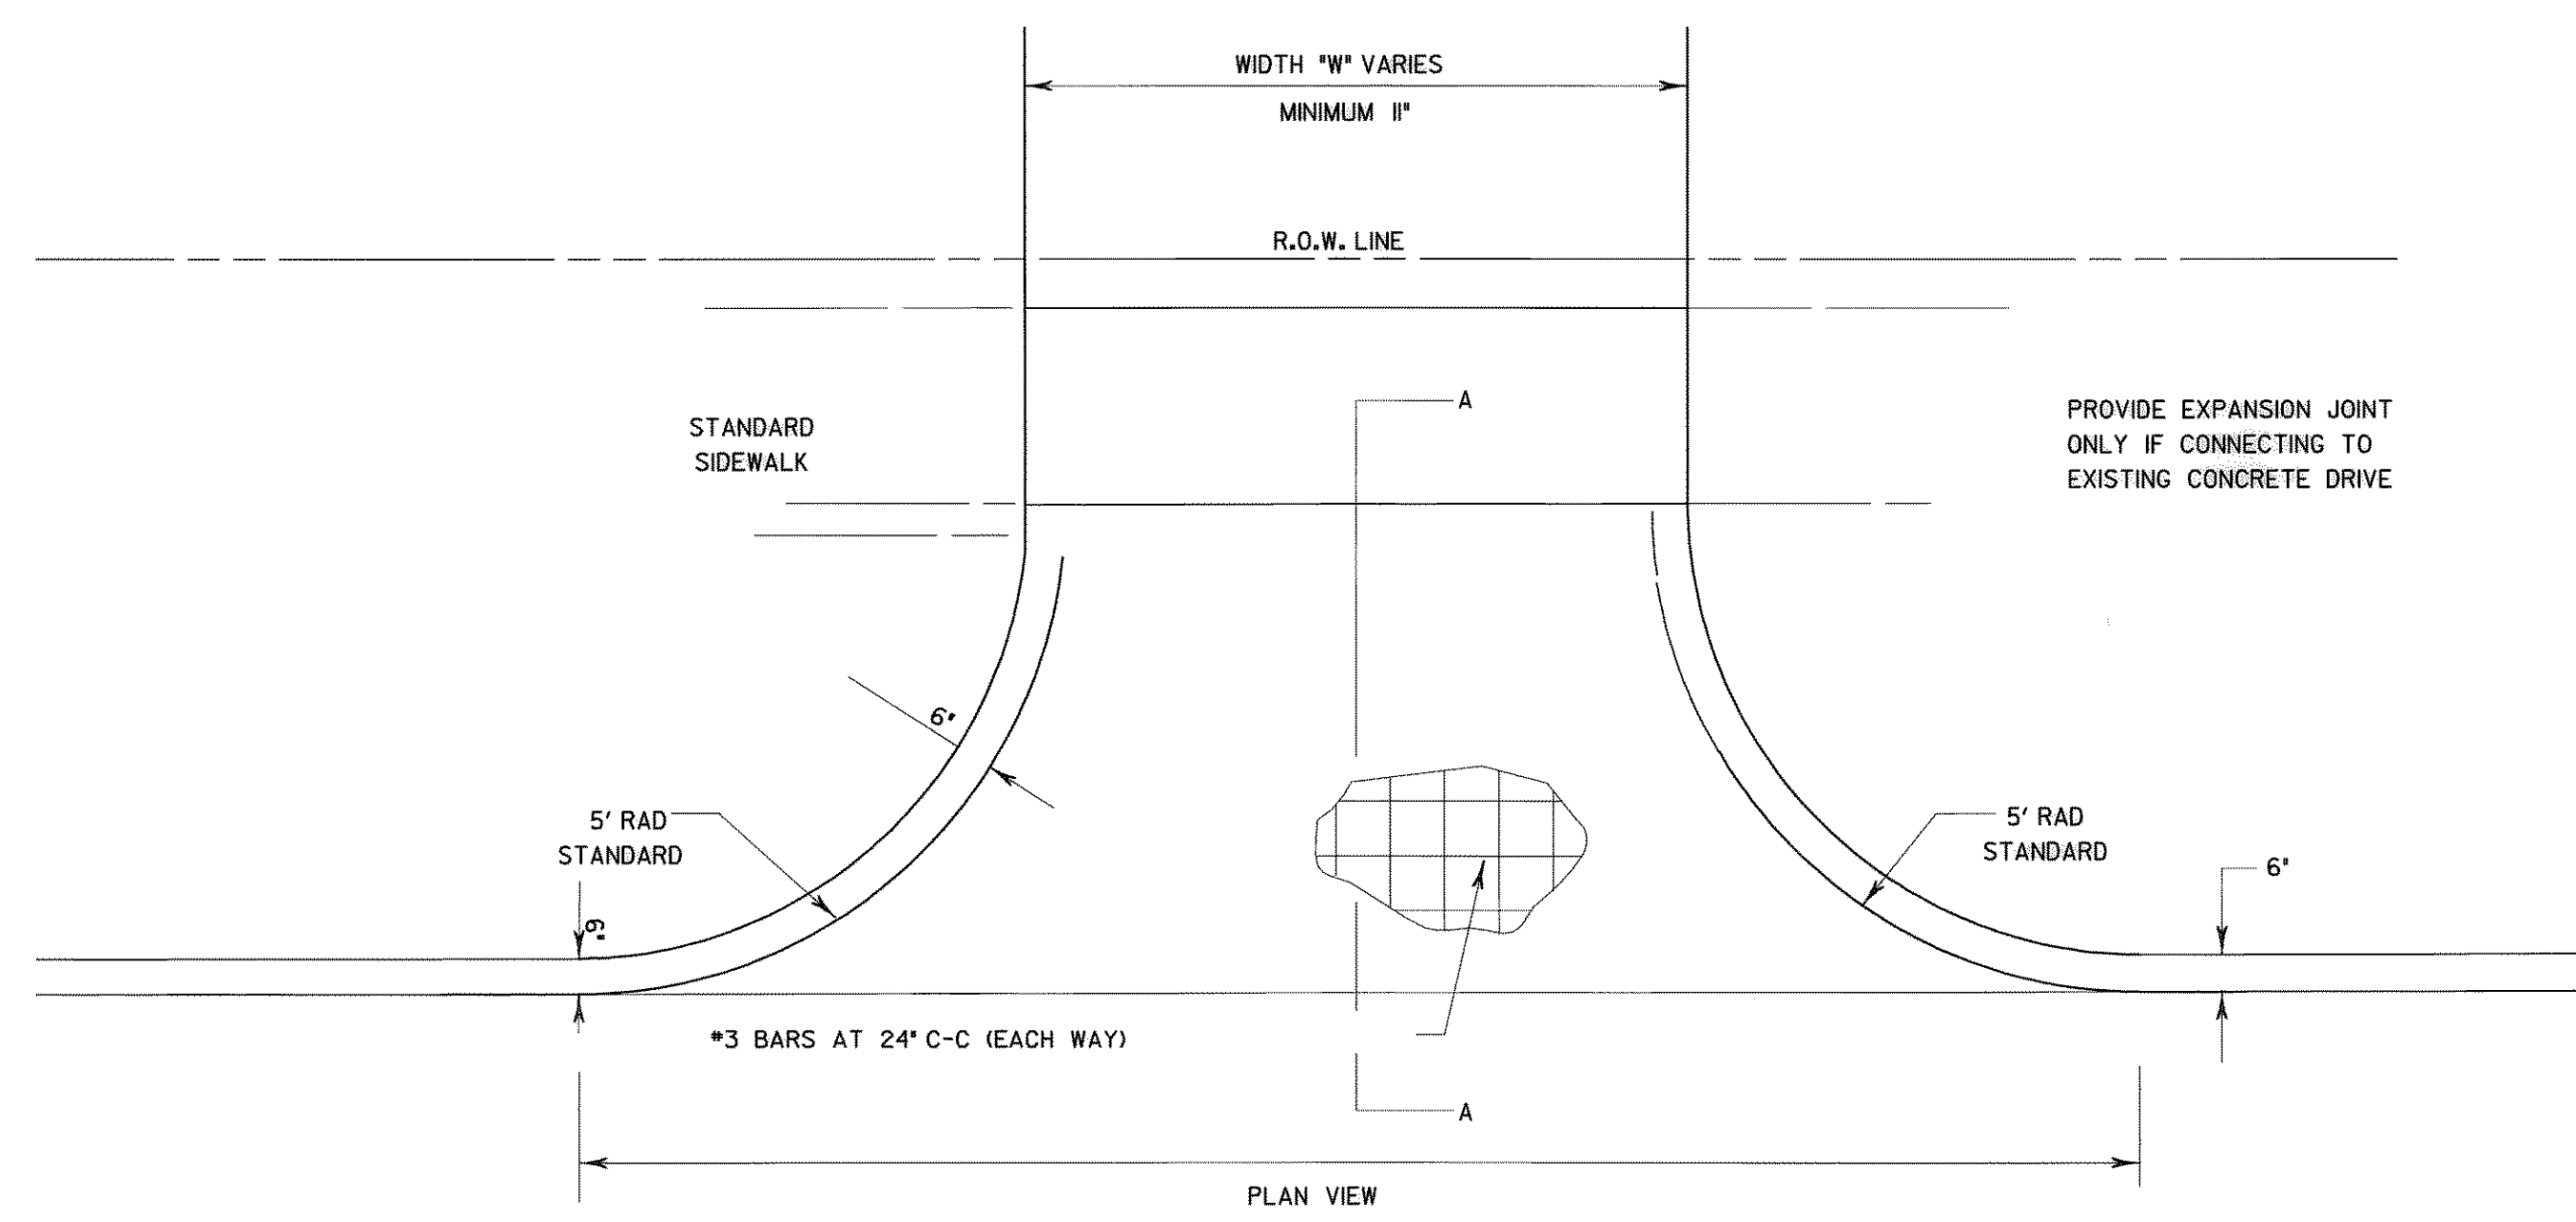

LANDSCAPE MAINTENANCE RAMP
N.T.S

RECORD DRAWING
This drawing is a compilation of the original sealed engineering drawing and modifications by addenda, change orders and information furnished by the contractor. Information shown that was provided by the contractor and others not associated with the design engineer cannot be verified for accuracy or completeness. Original sealed drawing is on file at the office of AECOM USA Group, Inc., TBPE REG. NO. F-3082

ORIGINAL DRAWING SEALED & SIGNED BY
Matthew L. Abbe, P.E.
TX NO. 92715

NO.	REVISION	BY	DATE
205 BYPASS SECTION 1			
MISCELLANEOUS ROADWAY DETAILS			
2 OF 2			
TCB AECOM		<small>TCB INC. WWW.TCB.AECOM.COM 17300 DALLAS PARKWAY, SUITE 1010 DALLAS, TEXAS 75248</small>	
Unit	PW-DAL-FW	Scale: Horiz: AS SHOWN Vert: AS SHOWN	Date: 11/11/2009
Designed	SKW/MLA	Checked: TCB	Project No. 60004153
Drawn	TCB	Approved: TCB	Sheet 151 of 217

P:\4328\60004153-205Bypass\CADD\Sheets\Sheet\01-140-00-To-FM552\Record\Draw\ng 10_7_09\151MISC-Roadway\Detail11502.dgn
 11/11/2009