

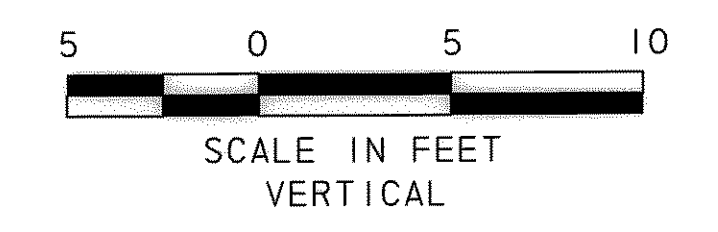
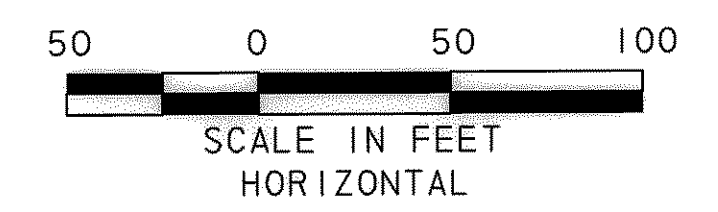


NOTE:  
SEE INTERSECTION LAYOUTS FOR  
ADDITIONAL INFORMATION.

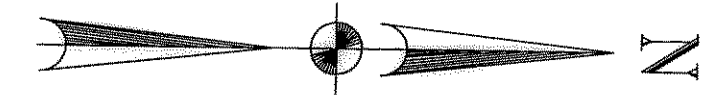

- LEGEND
- CONCRETE PAVEMENT
  - HMAC PAVEMENT
  - CURB INLET
  - RECESSED CURB INLET

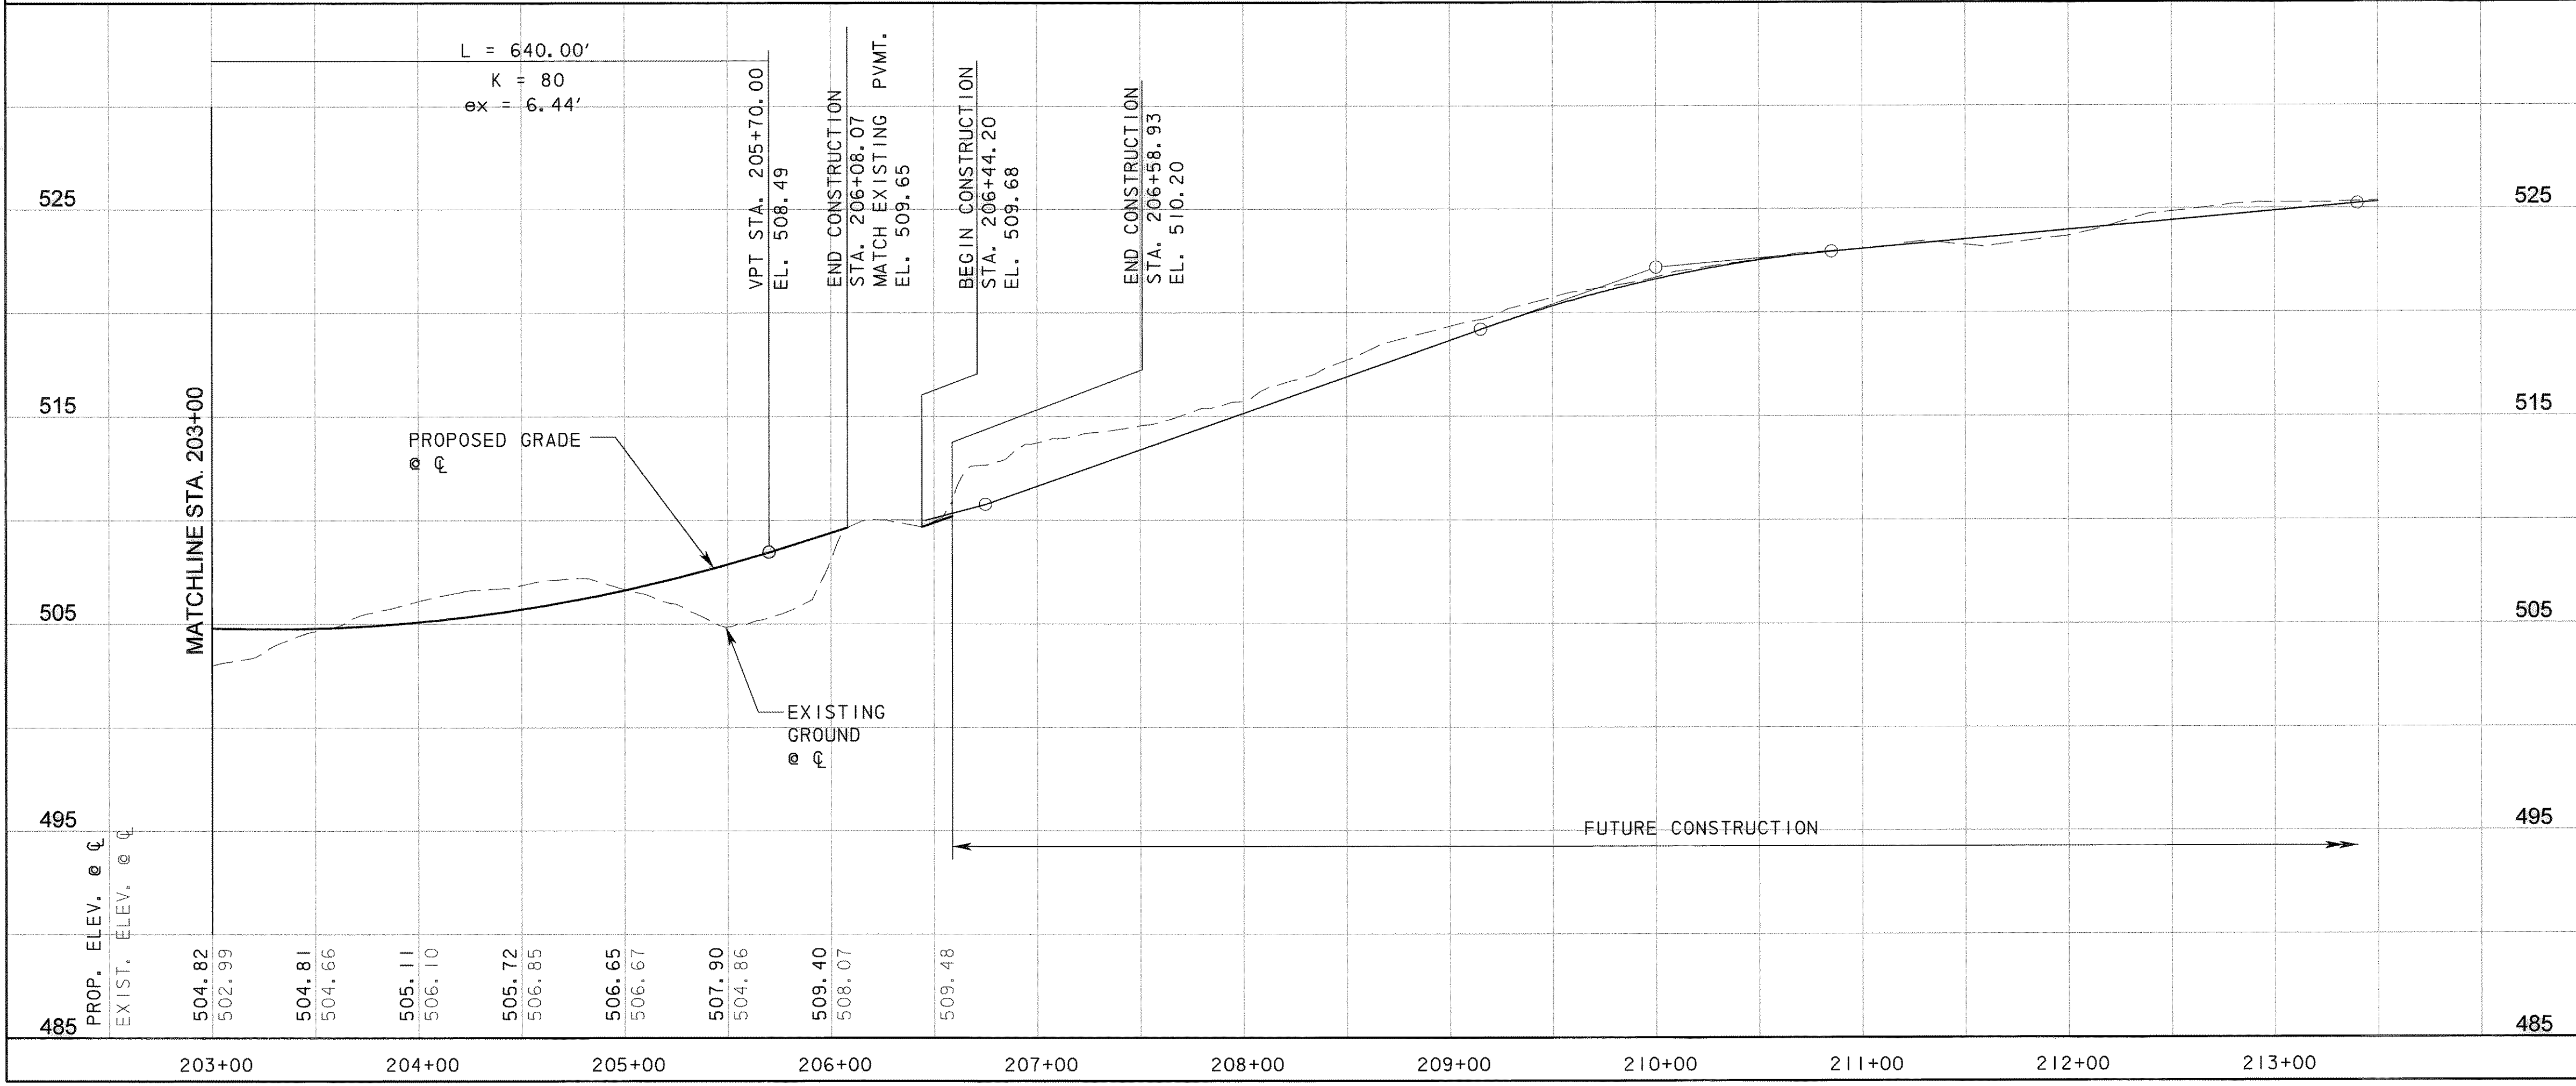

**RECORD DRAWING**

This drawing is a compilation of the original sealed engineering drawing and modifications by addenda, change orders and information furnished by the contractor. Information shown that was provided by the contractor and others not associated with the design engineer cannot be verified for accuracy or completeness. Original sealed drawing is on file at the office of AECOM USA Group, Inc., TBPE REG. NO. F-3082

ORIGINAL DRAWING  
SEALED & SIGNED BY  
Matthew L. Abbe, P.E.  
TX NO. 92715

NO.	REVISION	BY	DATE

**City of Rockwall, Texas**

**205 BYPASS  
SECTION 1**

**PLAN & PROFILE  
STA. 203+00 TO STA. 213+50** 7 OF 7

TCB | AECOM

Unit: PW-DAL-FW    Scale: Horiz: AS SHOWN    Date: 11/11/2009  
 Vert: AS SHOWN  
 Designed: SKW/MLA    Checked: TCB    Project No.: 60004153  
 Drawn: TCB    Approved: TCB    Sheet: 51 of 217

P:\4328\60004153-205Bypass\CADD\Sheets\Section1-140+00-To-FM552\Record Drawing ID\_7\_09\_05\IPav\IngP-205BP07.dgn  
11/21/2009