

LEGEND

- PROPOSED ROW
- ==== PROPOSED STORM DRAIN
- ⌒ INLET


NOTES:
 1. COORDINATE WITH PHASE 6 CONTRACTOR TO ENSURE THAT THE STUB OUT IS INSTALLED BEFORE PHASE 6 STORM DRAIN CONSTRUCTION BEGINS.

RECORD DRAWING


This drawing is a compilation of the original sealed engineering drawing and modifications by addenda, change orders and information furnished by the contractor. Information shown that was provided by the contractor and others not associated with the design engineer cannot be verified for accuracy or completeness. Original sealed drawing is on file at the office of AECOM USA Group, Inc., TBPE REG. NO. F-3082

ORIGINAL DRAWING SEALED & SIGNED BY

Matthew L. Abbe, P.E.
 TX NO. 92715

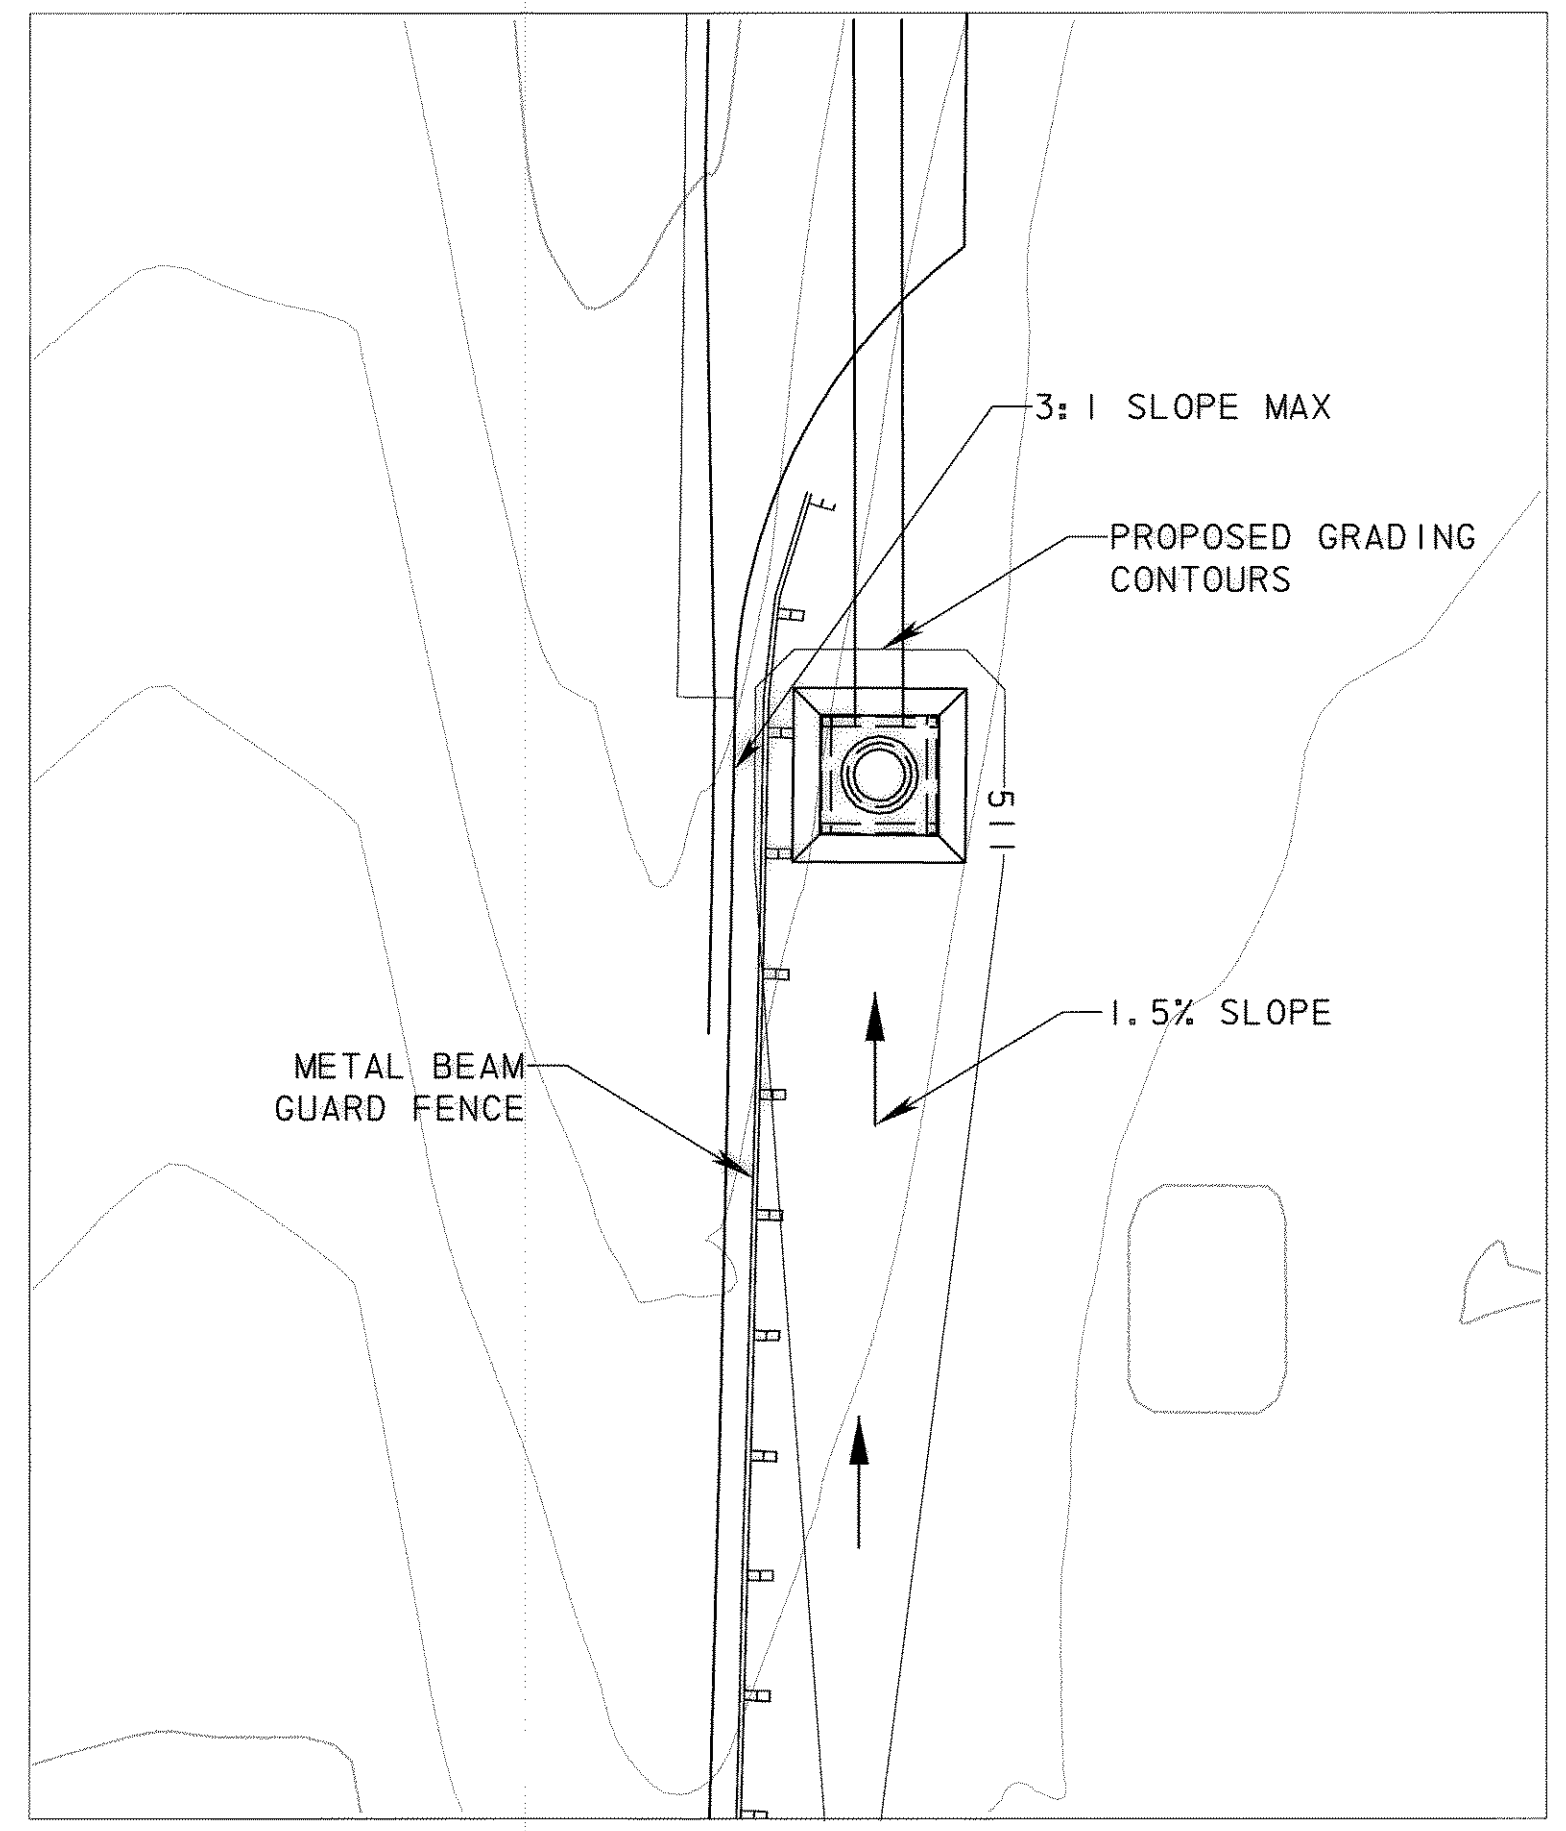

OSCI GRADING DETAIL

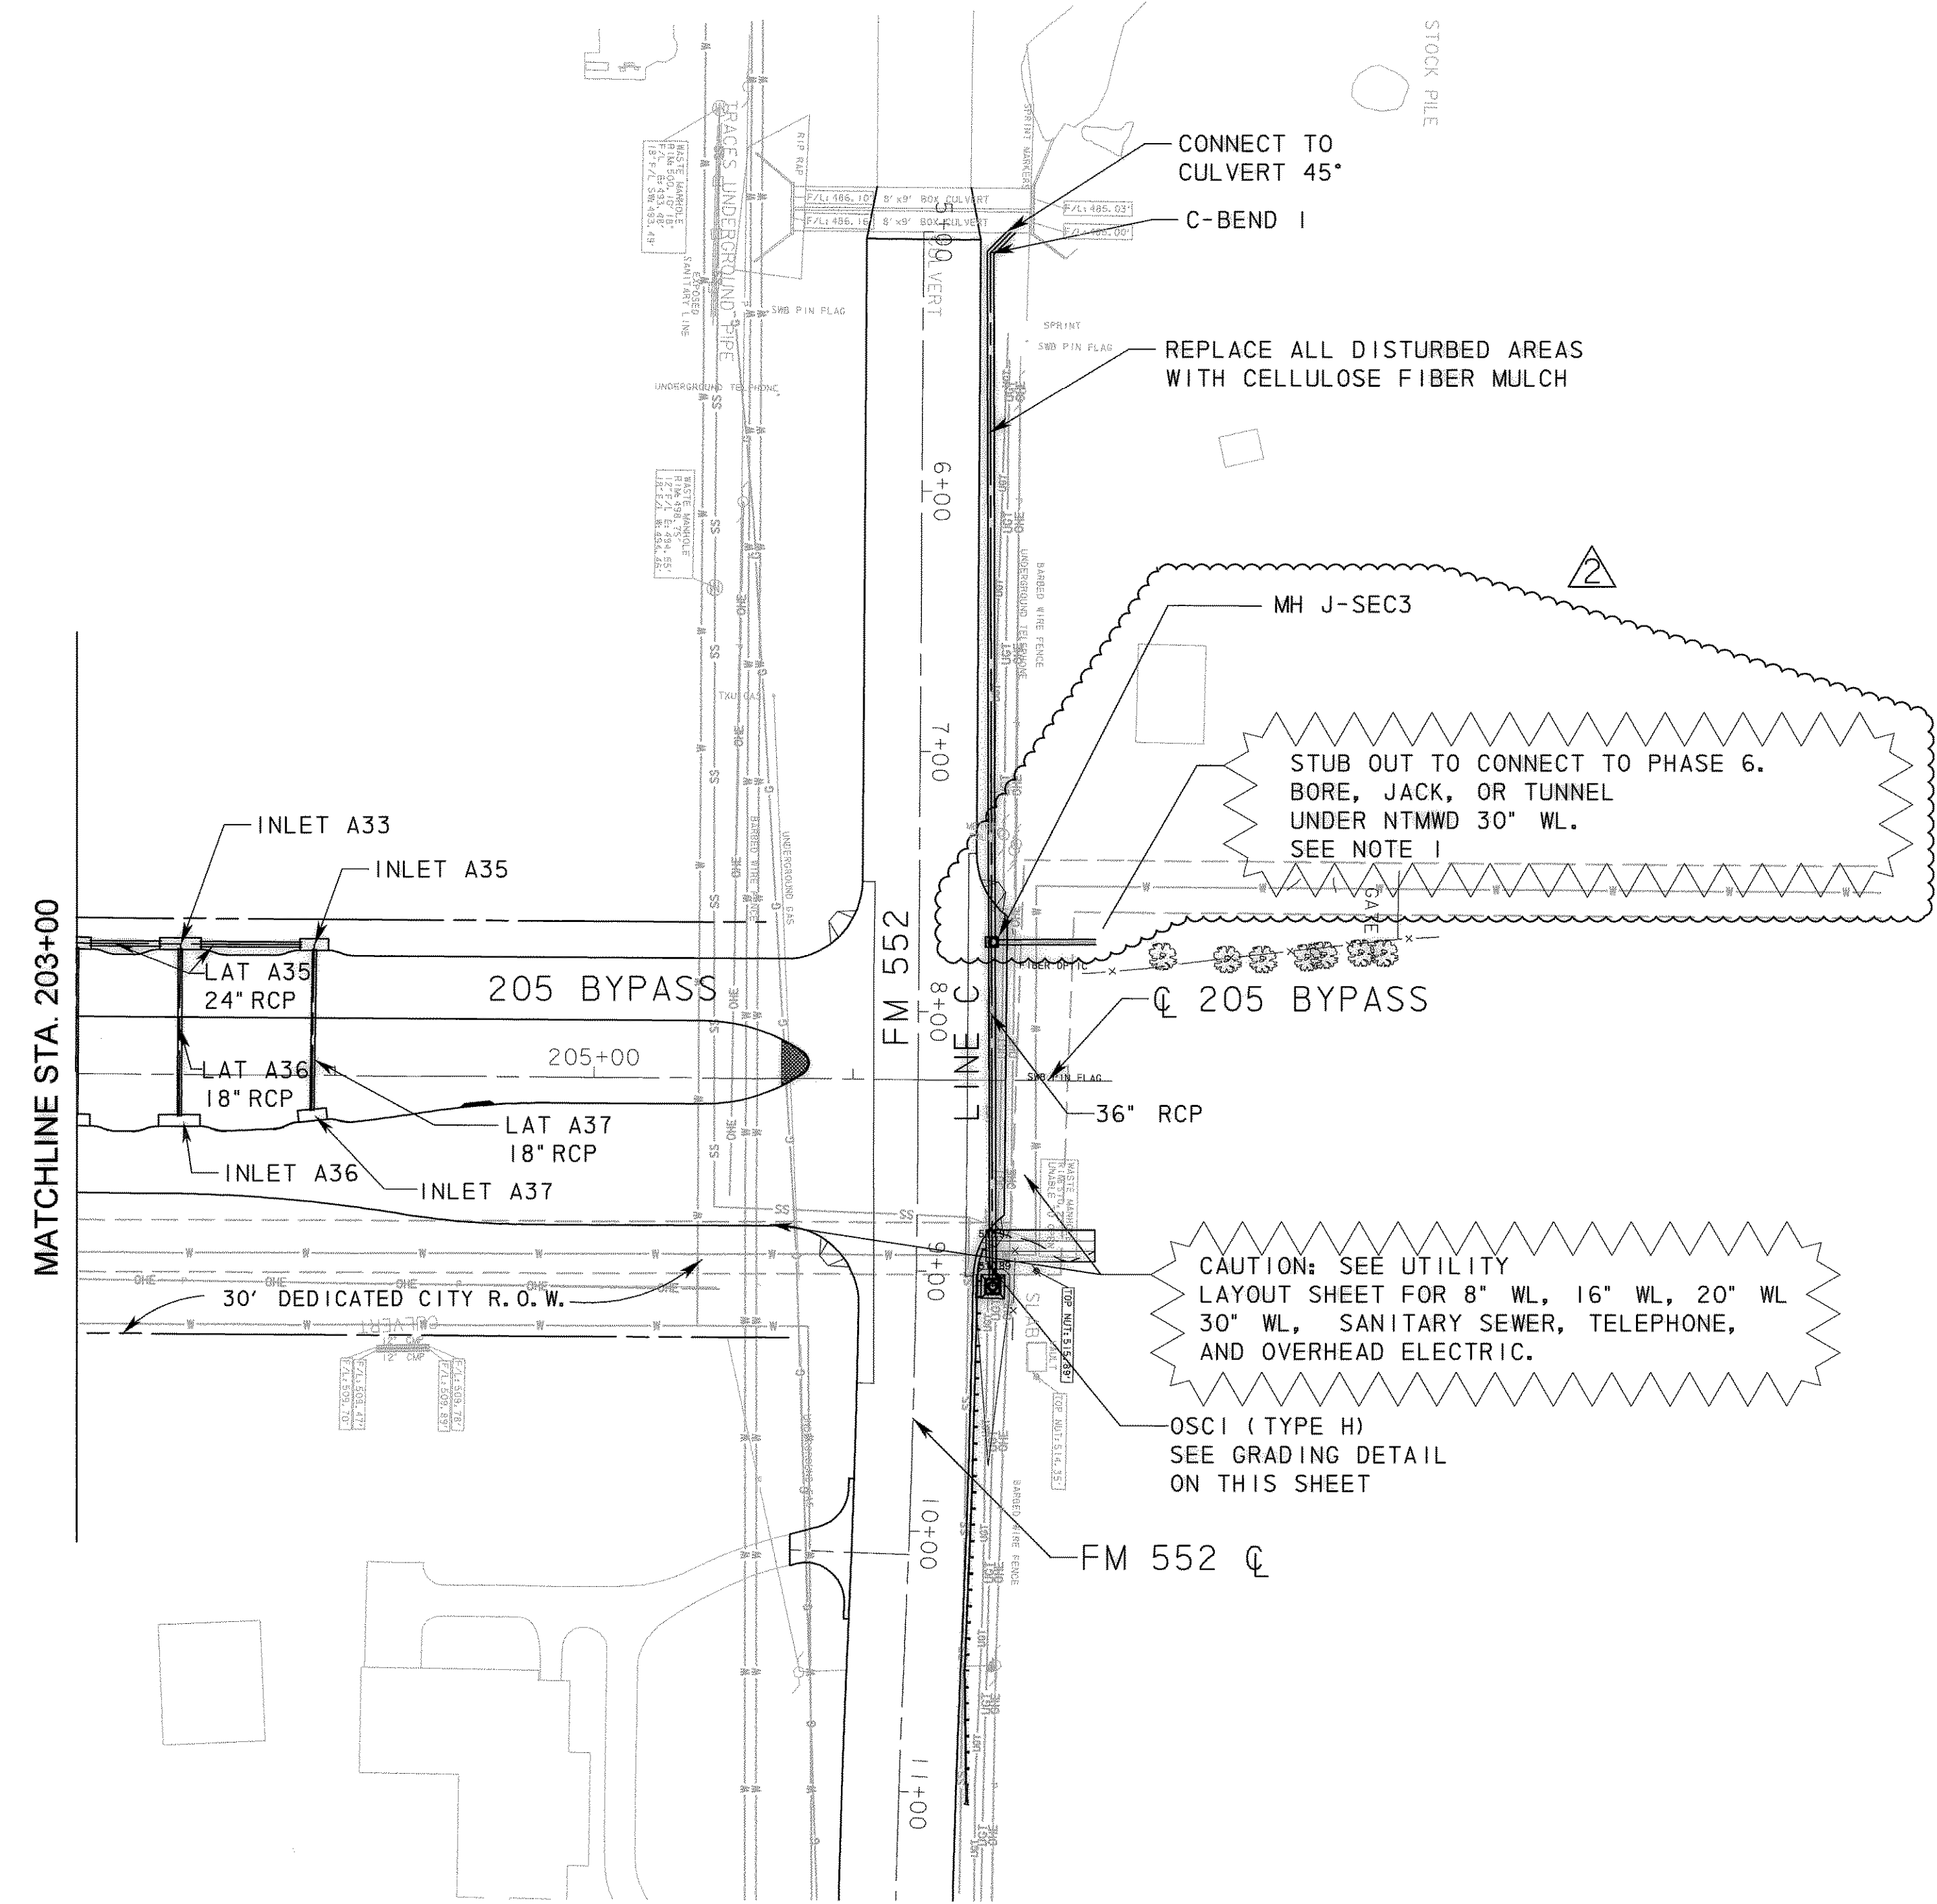

CAUTION: SEE UTILITY LAYOUT SHEET FOR 8" WL, 16" WL, 20" WL 30" WL, SANITARY SEWER, TELEPHONE, AND OVERHEAD ELECTRIC.

OSCI (TYPE H) SEE GRADING DETAIL ON THIS SHEET

STUB OUT TO CONNECT TO PHASE 6. BORE, JACK, OR TUNNEL UNDER NTMWD 30" WL. SEE NOTE 1

REPLACE ALL DISTURBED AREAS WITH CELLULOSE FIBER MULCH

CONNECT TO CULVERT 45" C-BEND 1

MATCHLINE STA. 203+00

P:\4328\60004153-205Bypass\CADD\Sheets\Section1-140-00-Top-FM552\Record Drawing 10_7_09\0555\form\p.dwg 11/11/2009

2	STUB OUT ADDITION	THG	11/12/07
1	REVISED FM 552 LAYOUT	THG	9/19/07
NO.	REVISION	BY	DATE

City of Rockwall, Texas

205 BYPASS SECTION 1

STORM PLAN STA. 203+00 TO STA. 213+50

7 OF 7

TCB AECOM TCB INC. WWW.TCB.AECOM.COM 17300 DALLAS PARKWAY, SUITE 1010 DALLAS, TEXAS 75248

Unit	PW-DAL-FW	Scale	AS SHOWN	Date	11/11/2009
Designed	SRR/SDB	Checked	TCB	Project No.	60004153
Drawn	FG	Approved	TCB	Sheet	95 of 217