


SCALE : 1" = 10'

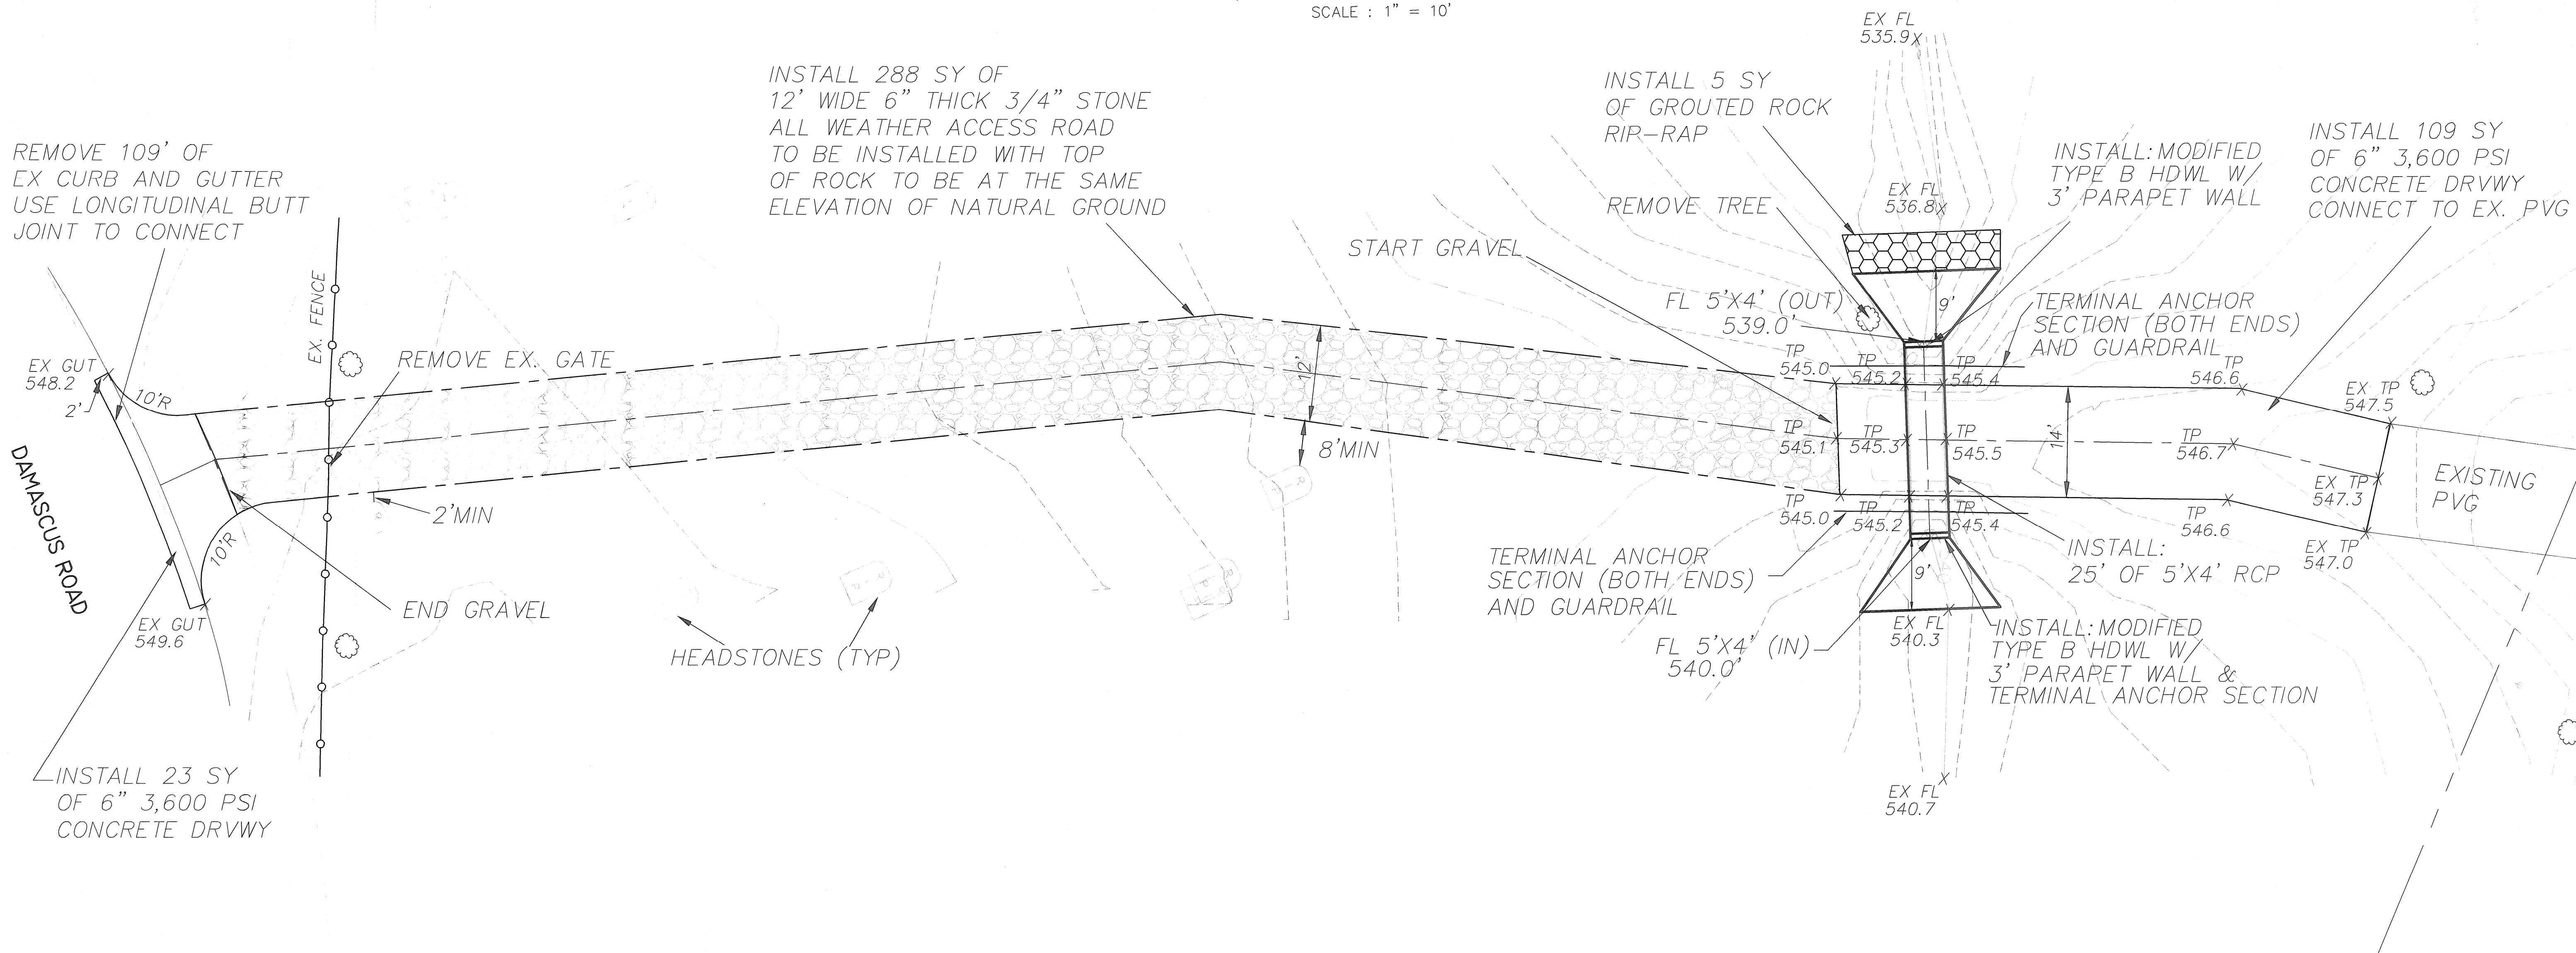

NOTES

1. CONTRACTOR TO USE CITY OF ROCKWALL STANDARDS OF DESIGN AND NCTCOG 3RD EDITION STANDARD SPECIFICATIONS
2. CONTRACTOR TO INSTALL DAMASCUS ENTRANCE AND GRAVEL DRIVEWAY FIRST TO ALLOW FOR CEMETERY ACCESS.
3. CONTRACTOR TO VERIFY ALL EXISTING UTILITIES PRIOR TO CONSTRUCTION
4. NO CONSTRUCTION CHANGES ARE ALLOWED WITHOUT PERMISSION FROM THE DESIGN ENGINEER AND THE CITY OF ROCKWALL.
5. GRAVEL DRIVEWAY SHALL BE STONE FLEX BASE IN ACCORDANCE WITH NCTCOG ITEM 2.1.3(B).
6. ALL FILL TO BE COMPACTED TO 95% USING A SHEEP'S FOOT ROLLER.
7. PLACE GROUDED ROCK RIP RAP AT THE DOWNSTREAM END OF APRON
8. CONNECT TO ALL EXISTING CONCRETE WITH A LONGITUDINAL BUTT JOINT
9. ALL CONSTRUCTION TO STOP DURING FUNERALS (MIN 4 HOURS).

RECORD DRAWING
OCTOBER 16, 2012

SH 205 CEMETERY	
PROPOSED IMPROVEMENTS	
ROCKWALL, TEXAS	
CITY OF ROCKWALL "THE NEW HORIZON"	

REVISION NO.	REMARKS	DATE

DESIGNED: A.J.W.	THE SEAL APPEARING ON THIS DOCUMENT WAS AUTHORIZED BY AMY J. WILLIAMS TEXAS P.E. NO. 99406 ON	
DRAWN: ACAD		
SH 205 CEMETERY		
DATE: 12/2011	SHEET NO.	

10-16-12