


CITY OF ROCKWALL, TEXAS

CONSTRUCTION PLANS FOR

STATE HIGHWAY NO. 205 SANITARY SEWER

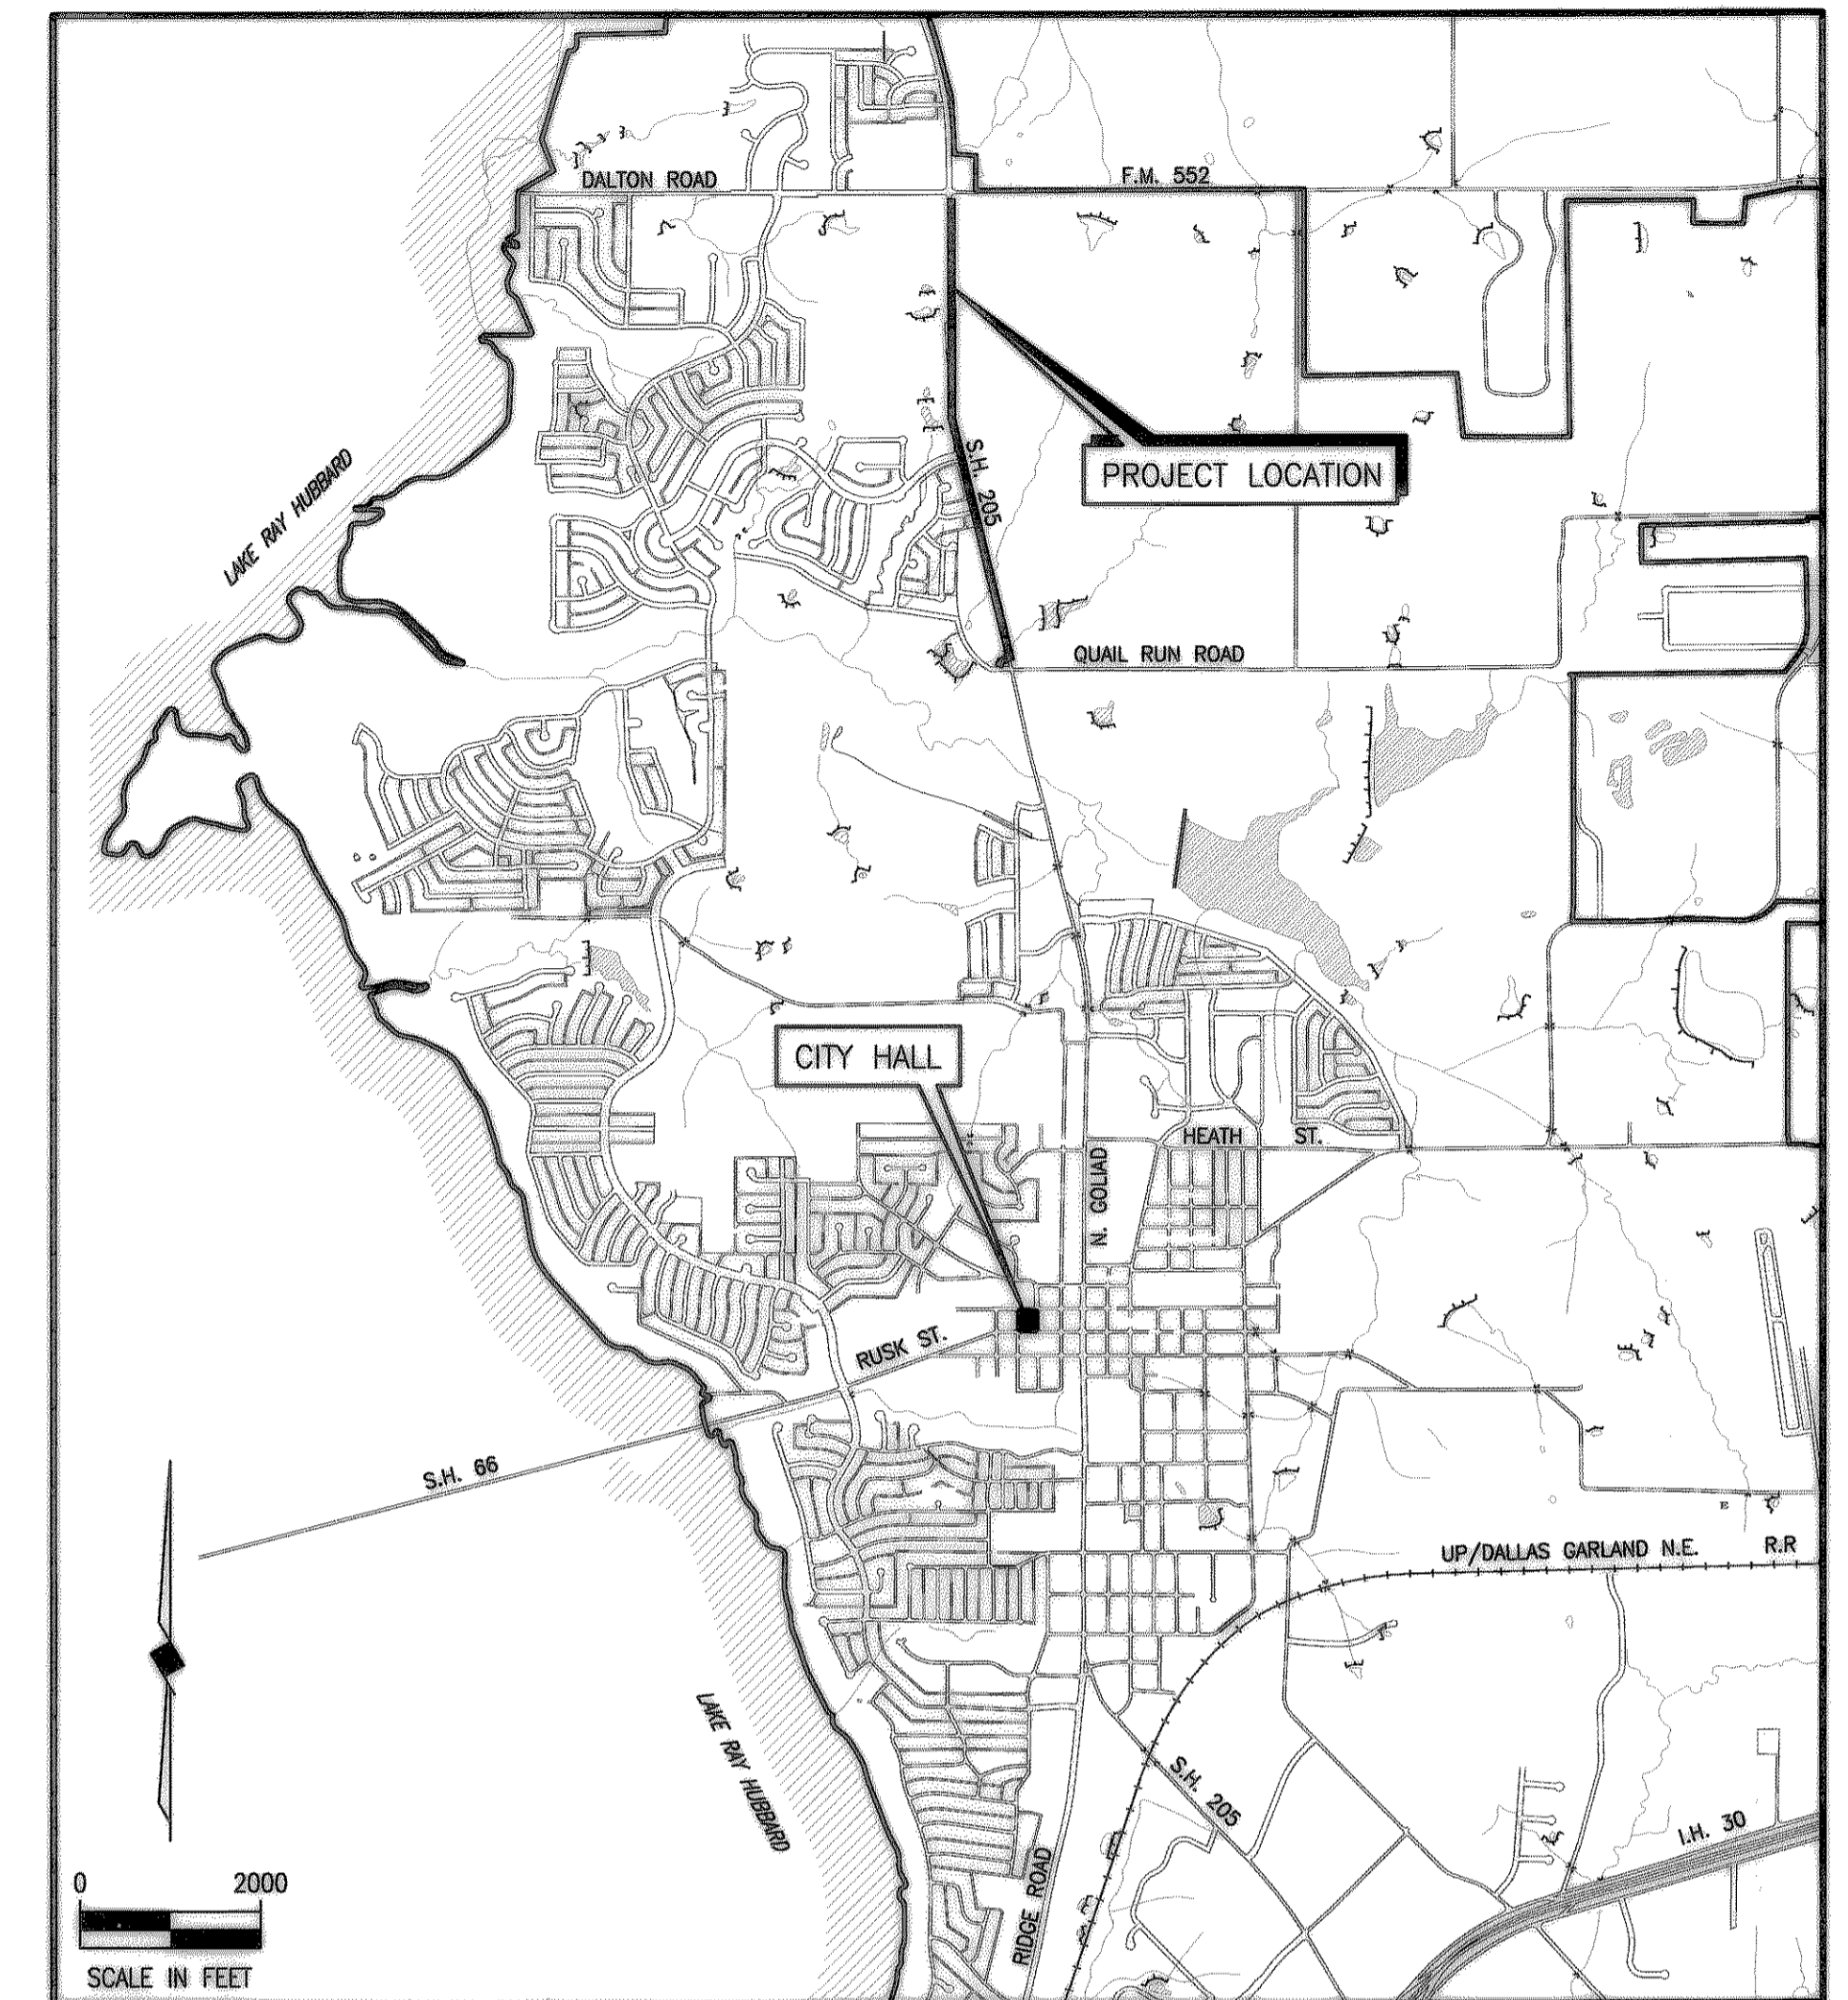

LOCATION MAP

SHEET INDEX

<u>SHEET NO.</u>	<u>SHEET DESCRIPTION</u>
—	COVER SHEET AND LOCATION MAP
1	STATE HIGHWAY 205 GRAVITY SEWER PLAN—PROFILE STA. 0+13.77 TO STA. 5+00
2	STATE HIGHWAY 205 GRAVITY SEWER PLAN—PROFILE STA. 5+00 TO STA. 10+00
3	STATE HIGHWAY 205 GRAVITY SEWER PLAN—PROFILE STA. 10+00 TO STA. 15+00
4	STATE HIGHWAY 205 GRAVITY SEWER PLAN—PROFILE STA. 15+00 TO STA. 20+00
5	STATE HIGHWAY 205 GRAVITY SEWER PLAN—PROFILE STA. 20+00 TO STA. 25+00
6	STATE HIGHWAY 205 GRAVITY SEWER PLAN—PROFILE STA. 25+00 TO STA. 30+00
7	STATE HIGHWAY 205 GRAVITY SEWER PLAN—PROFILE STA. 30+00 TO STA. 35+00
8	STATE HIGHWAY 205 GRAVITY SEWER PLAN—PROFILE STA. 35+00 TO STA. 40+00
9	STATE HIGHWAY 205 GRAVITY SEWER PLAN—PROFILE STA. 40+00 TO STA. 45+00
10	STATE HIGHWAY 205 GRAVITY SEWER PLAN—PROFILE STA. 45+00 TO STA. 50+00
11	STATE HIGHWAY 205 GRAVITY SEWER PLAN—PROFILE STA. 50+00 TO STA. 55+62.89
12	MISCELLANEOUS DETAILS

COUNCIL MEMBERS

KEN JONES, MAYOR
 BILL CECIL, MAYOR PRO-TEM
 BOB COTTI
 JOHN KING
 TERRY RAULSTON
 BILLY MORRIS
 RON COLESON

CITY MANAGER


JULIE COUCH

ASSISTANT CITY MANAGER

RICHARD CROWLEY

CITY ENGINEER

CHUCK TODD, P.E.

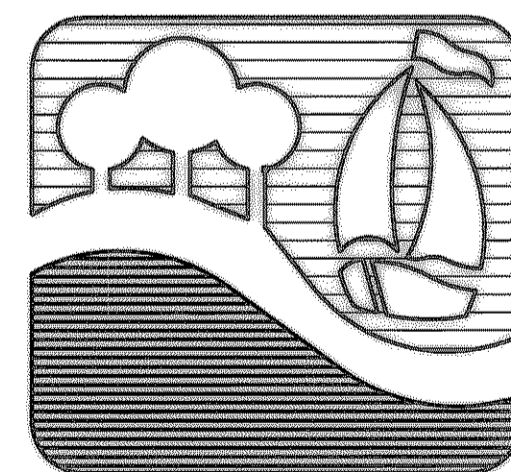


BIRKHOFF, HENDRICKS & CONWAY, L.L.P.
 CONSULTING ENGINEERS
 Dallas, Texas

THESE DOCUMENTS ARE FOR
 BIDDING, CONSTRUCTION,
 AND PERMIT PURPOSES.

DATE: 5/10/02

MAY, 2002

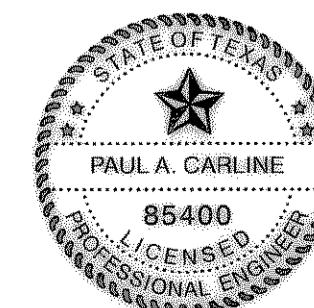

REVISED TO CONFORM
 TO CONSTRUCTION RECORDS
 BY P.A.C. DATE 03/25/2002