


S. KING SURVEY
ABSTRACT NO. 131

RANDOM OAKS AT THE SHORES ADDITION

RIDGE ROAD

MATCH LINE STA. 20+00
N 12712.9449, E 11577.6957

MATCH LINE STA. 25+00
N 13209.2526, E 11518.2265

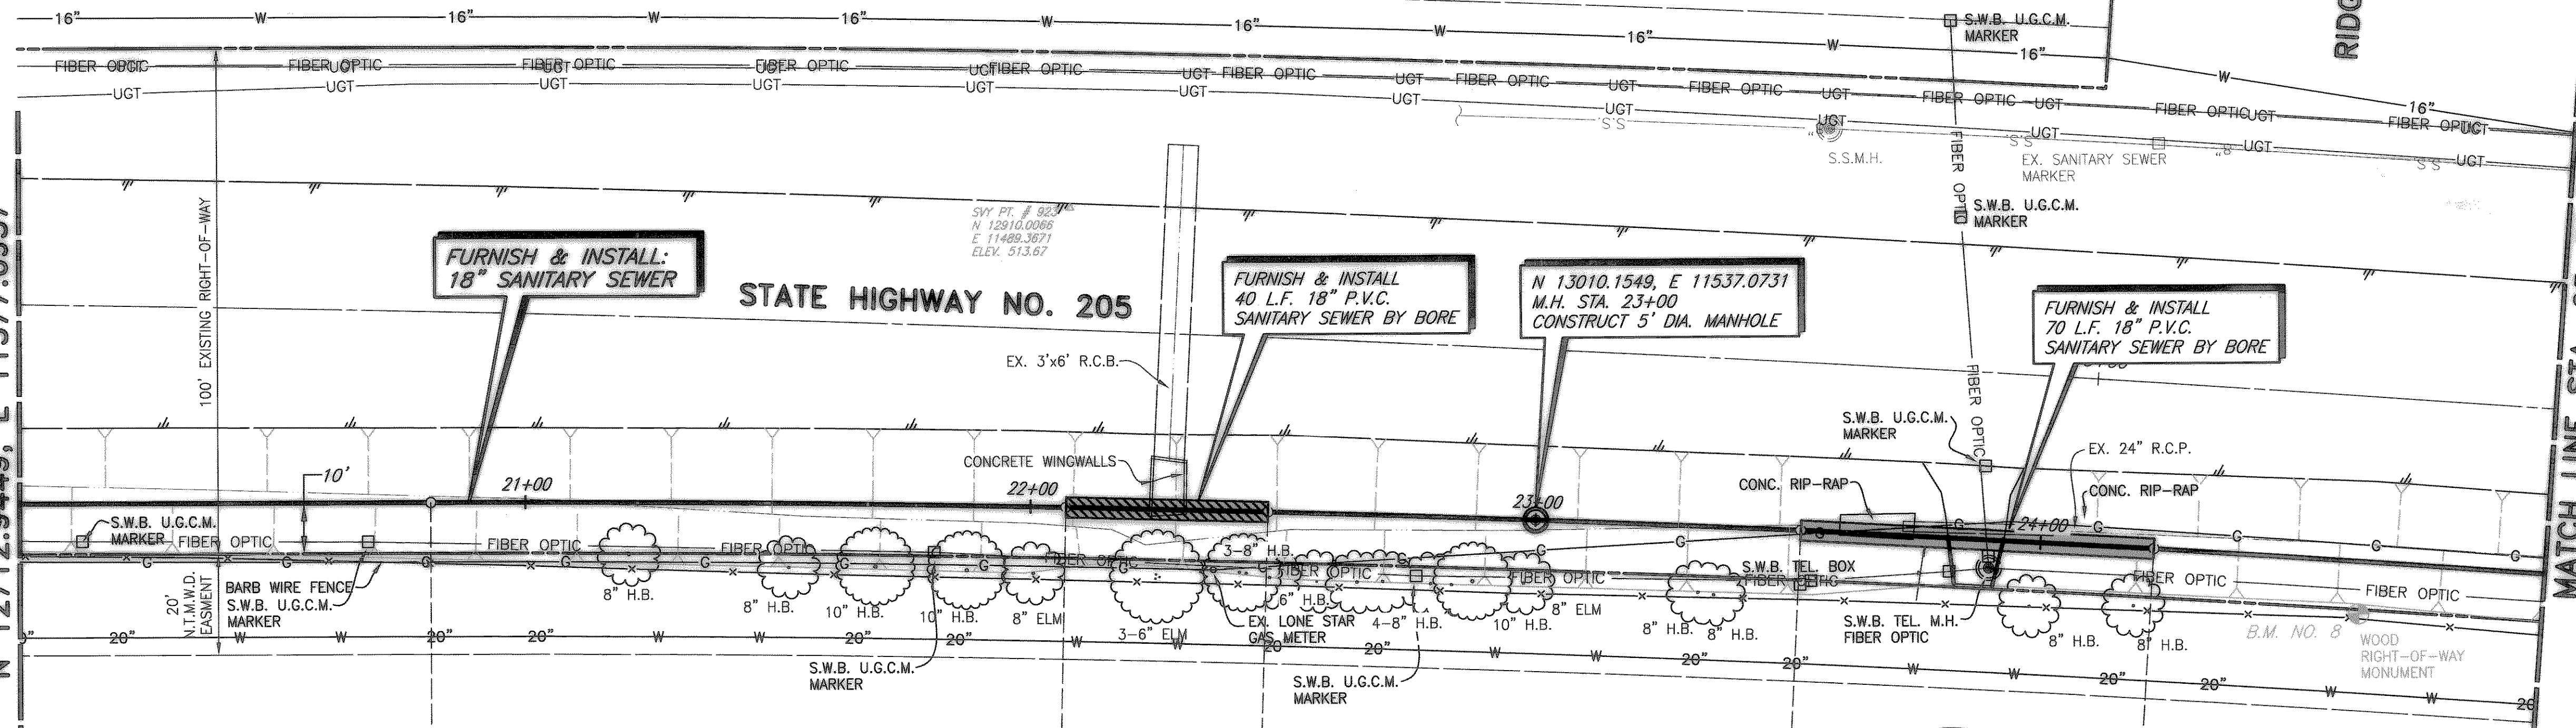


WARNING
S.W. BELL BURIED
TELEPHONE CABLE!
CALL ENTERPRISE 9800
72 HOURS PRIOR TO
EXCAVATION

WARNING
T.X.U. GAS LINE
NOTIFY T.X.U. GAS
72 HOURS PRIOR TO
EXCAVATION

Curve Data
P.C. STA. 20+81.30
P.I. STA. 21+44.15
P.T. STA. 22+07.00
 $\Delta = 01^{\circ}20'02''$ RT.
R = 5400.00'
T = 62.85'
L = 125.70'


ESTATE OF
W.W. CARUTH, JR.
W.T. DEWEESE SURVEY
ABSTRACT NO. 71

Curve Data
P.C. STA. 22+47.00
P.I. STA. 23+04.88
P.T. STA. 23+52.50
 $\Delta = 01^{\circ}07'10''$ RT.
R = 5400.00'
T = 52.75'
L = 105.50'

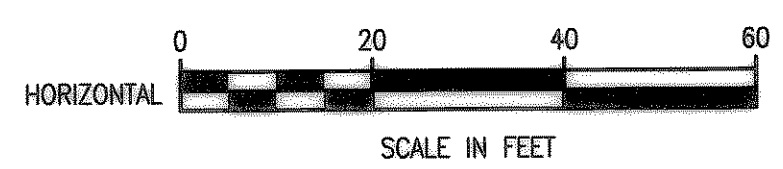

B.M. NO. 8
N 13174.0110, E 11531.9357
STA. 24+63.75, 10.87' RT.
WOOD RIGHT-OF-WAY MONUMENT
ELEV. 514.65

These plans and related specifications were prepared for construction of this specific project only. Reuse of these documents is not permitted without written authorization of Birkhoff, Hendricks, & Conway, L.L.P.

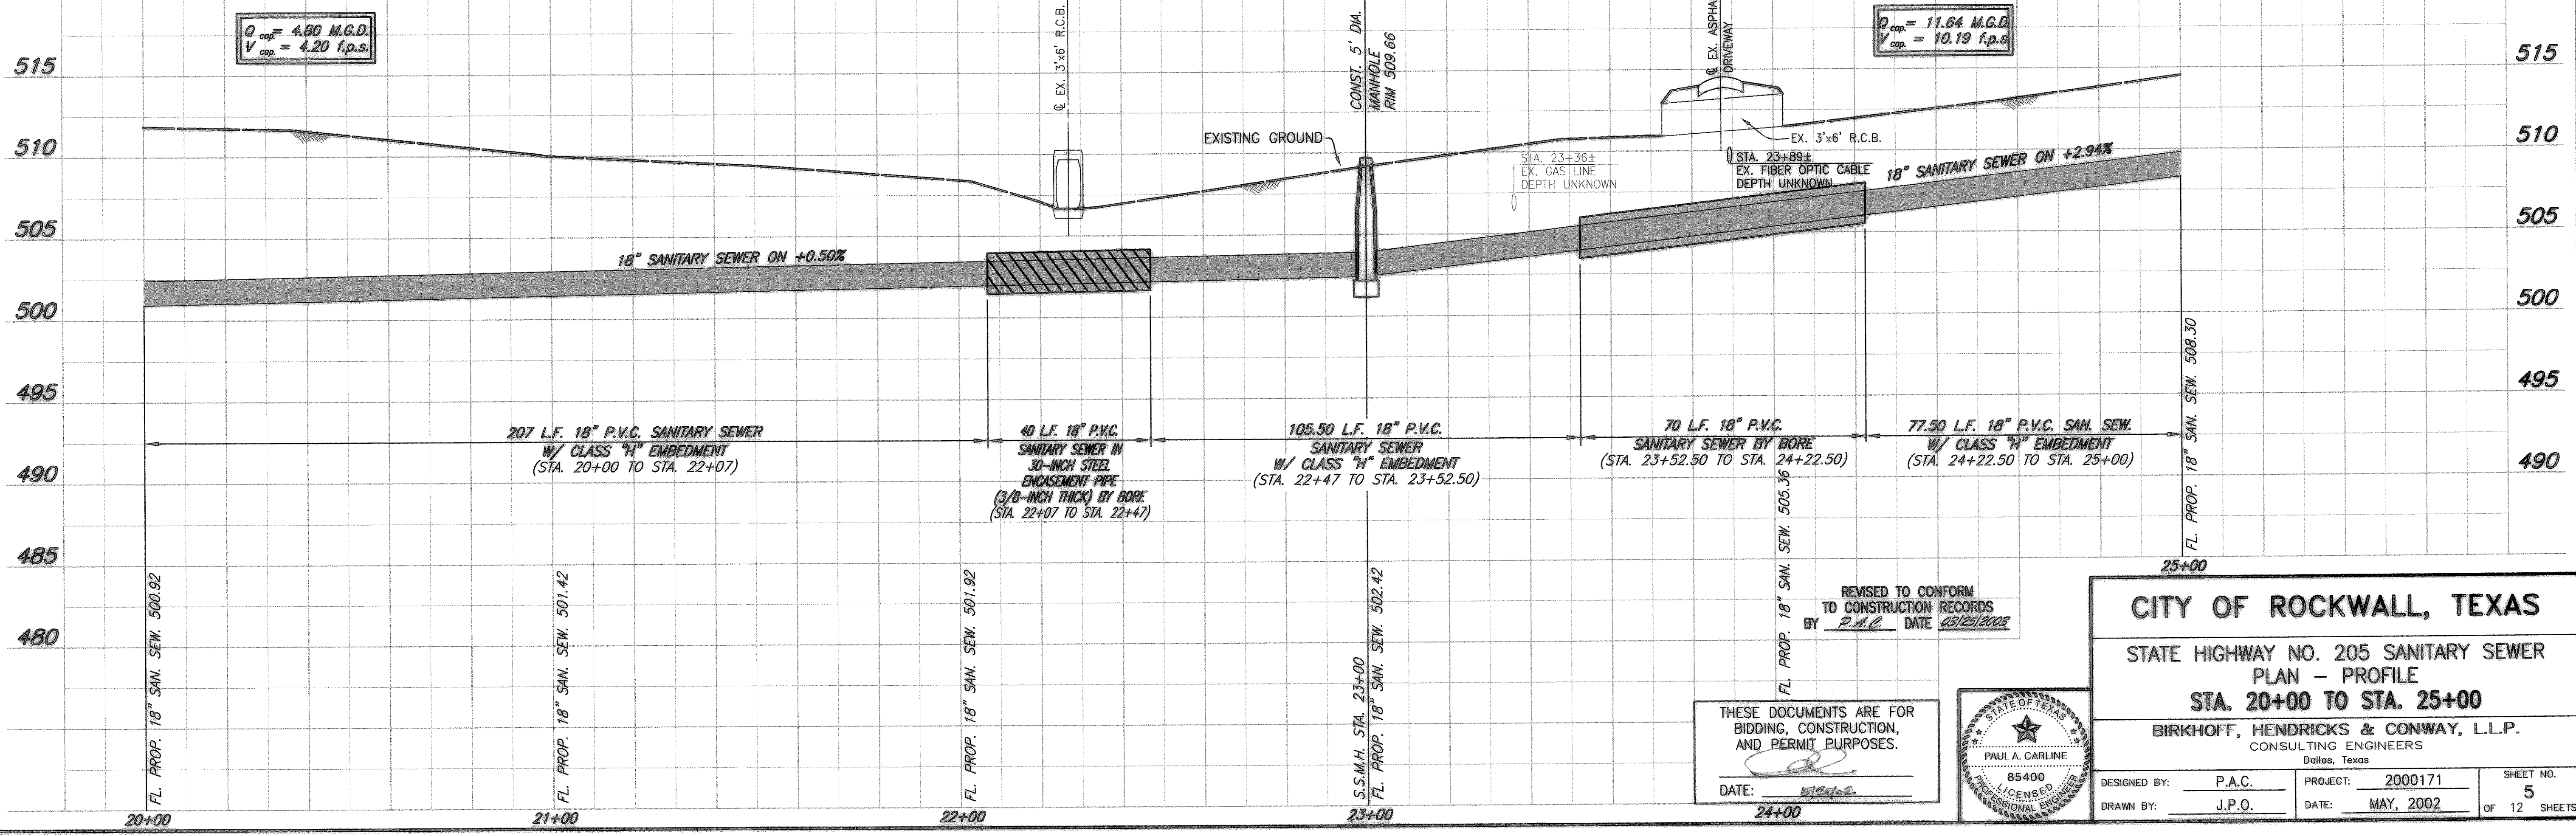


$Q_{cap} = 4.80$ M.G.D.
 $V_{cap} = 4.20$ f.p.s.

$Q_{cap} = 11.64$ M.G.D.
 $V_{cap} = 10.19$ f.p.s.

REVISED TO CONFORM
TO CONSTRUCTION RECORDS
BY P.A.C. DATE 05/12/2002

THESE DOCUMENTS ARE FOR
BIDDING, CONSTRUCTION,
AND PERMIT PURPOSES.
DATE: 5/12/02

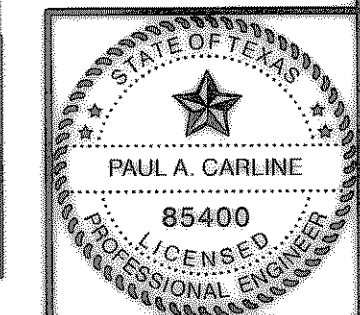

CITY OF ROCKWALL, TEXAS
STATE HIGHWAY NO. 205 SANITARY SEWER
PLAN - PROFILE
STA. 20+00 TO STA. 25+00
BIRKHOFF, HENDRICKS & CONWAY, L.L.P.
CONSULTING ENGINEERS
Dallas, Texas

DESIGNED BY: P.A.C.	PROJECT: 2000171	SHEET NO. 5
DRAWN BY: J.P.O.	DATE: MAY, 2002	OF 12 SHEETS

Reviset: 05/20/2002 KMB
 H:\Projects\Rockwall\2000171\Plans\Sheets\2000171-505.dwg
 Master: 171 - Master Profile