


MASON-STEED ADDITION

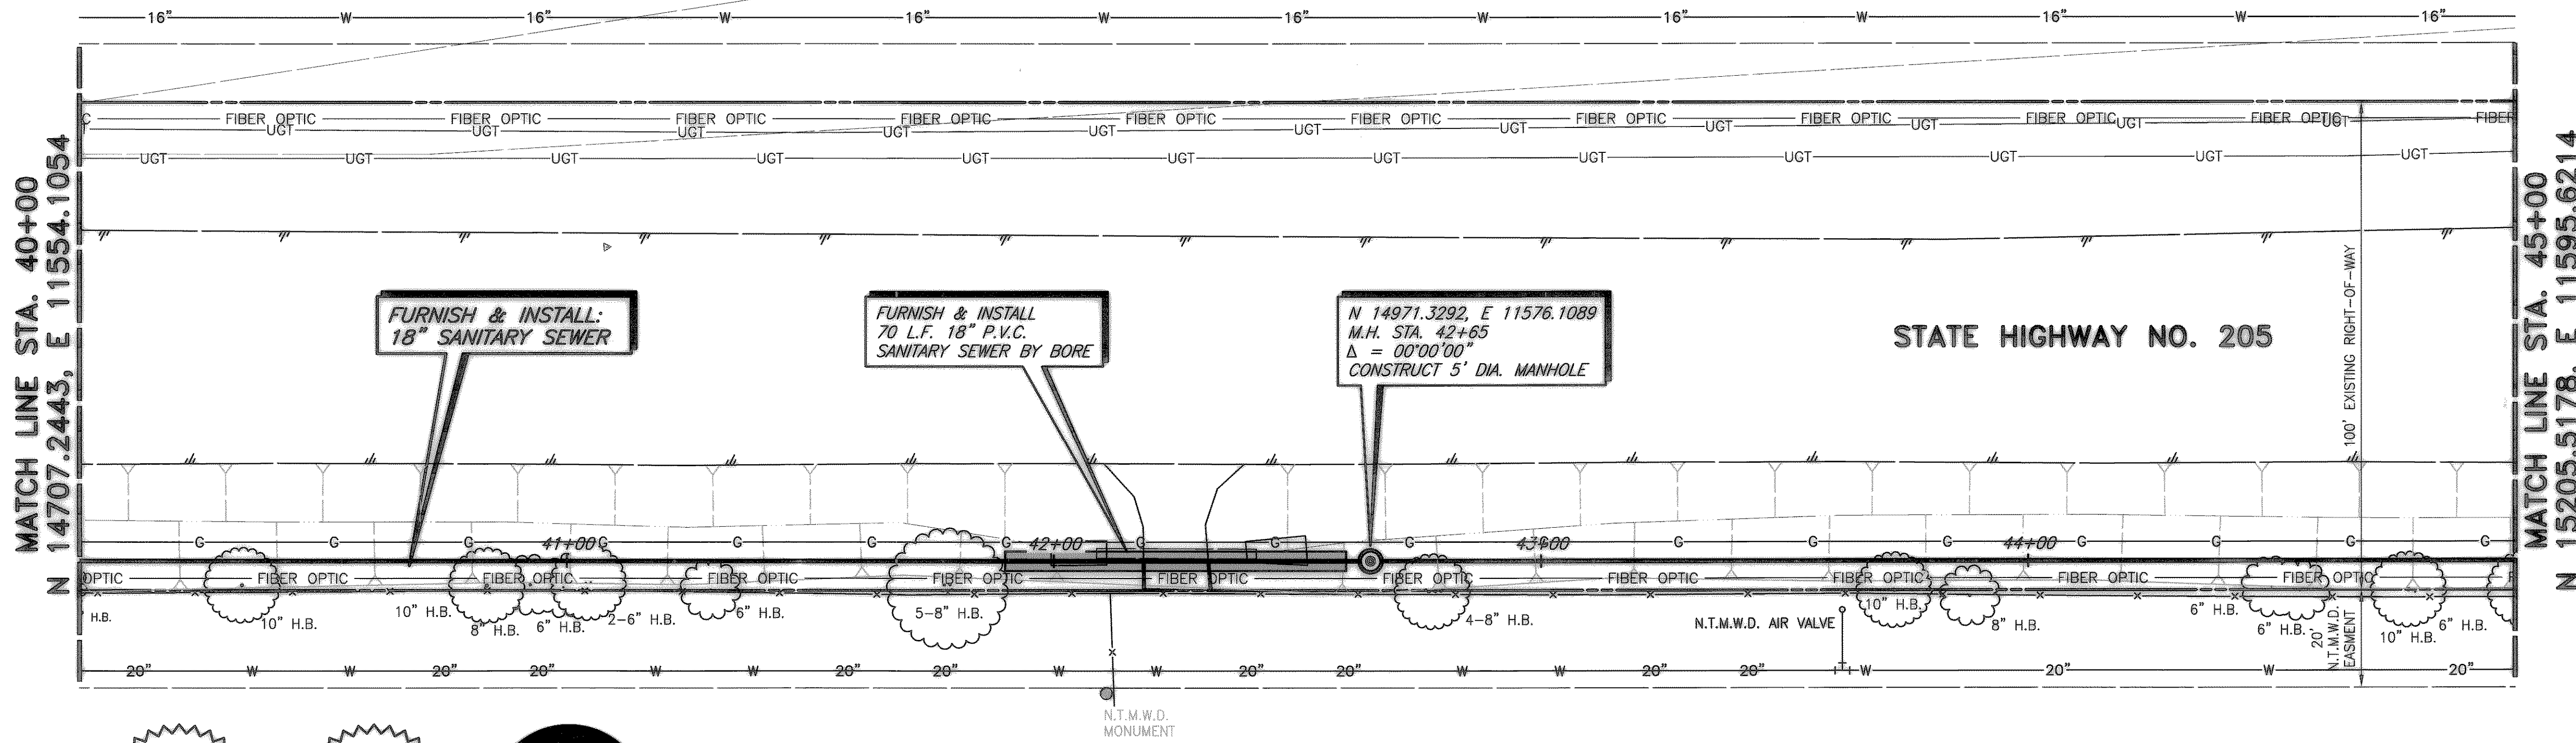

WARNING
S.W. BELL BURIED TELEPHONE CABLE CALL ENTERPRISE 9800 72 HOURS PRIOR TO EXCAVATION


WARNING
T.X.U. GAS LINE NOTIFY T.X.U. GAS 72 HOURS PRIOR TO EXCAVATION

CALL US BEFORE YOU DIG


B.M. NO. 11
N 14181.6781, E 11524.7660
STA. 34+73.40, 6.00' RT.
CONCRETE RIGHT-OF-WAY MONUMENT
ELEV. 538.74

B.M. NO. 12
N 14489.5262, E 11542.0831
STA. 37+82.04, 6.10' RT.
CONCRETE RIGHT-OF-WAY MONUMENT
ELEV. 545.04

ESTATE OF
W.W. CARUTH, JR.
W.T. DEWESE SURVEY
ABSTRACT NO. 71

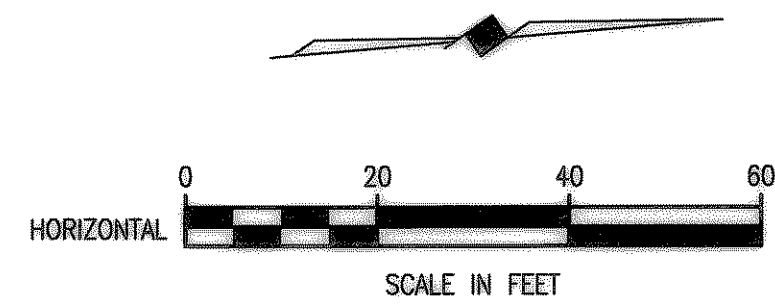


These plans and related specifications were prepared for construction of this specific project only. Reuse of these documents is not permitted without written authorization of Birkhoff, Hendricks, & Conway, L.L.P.

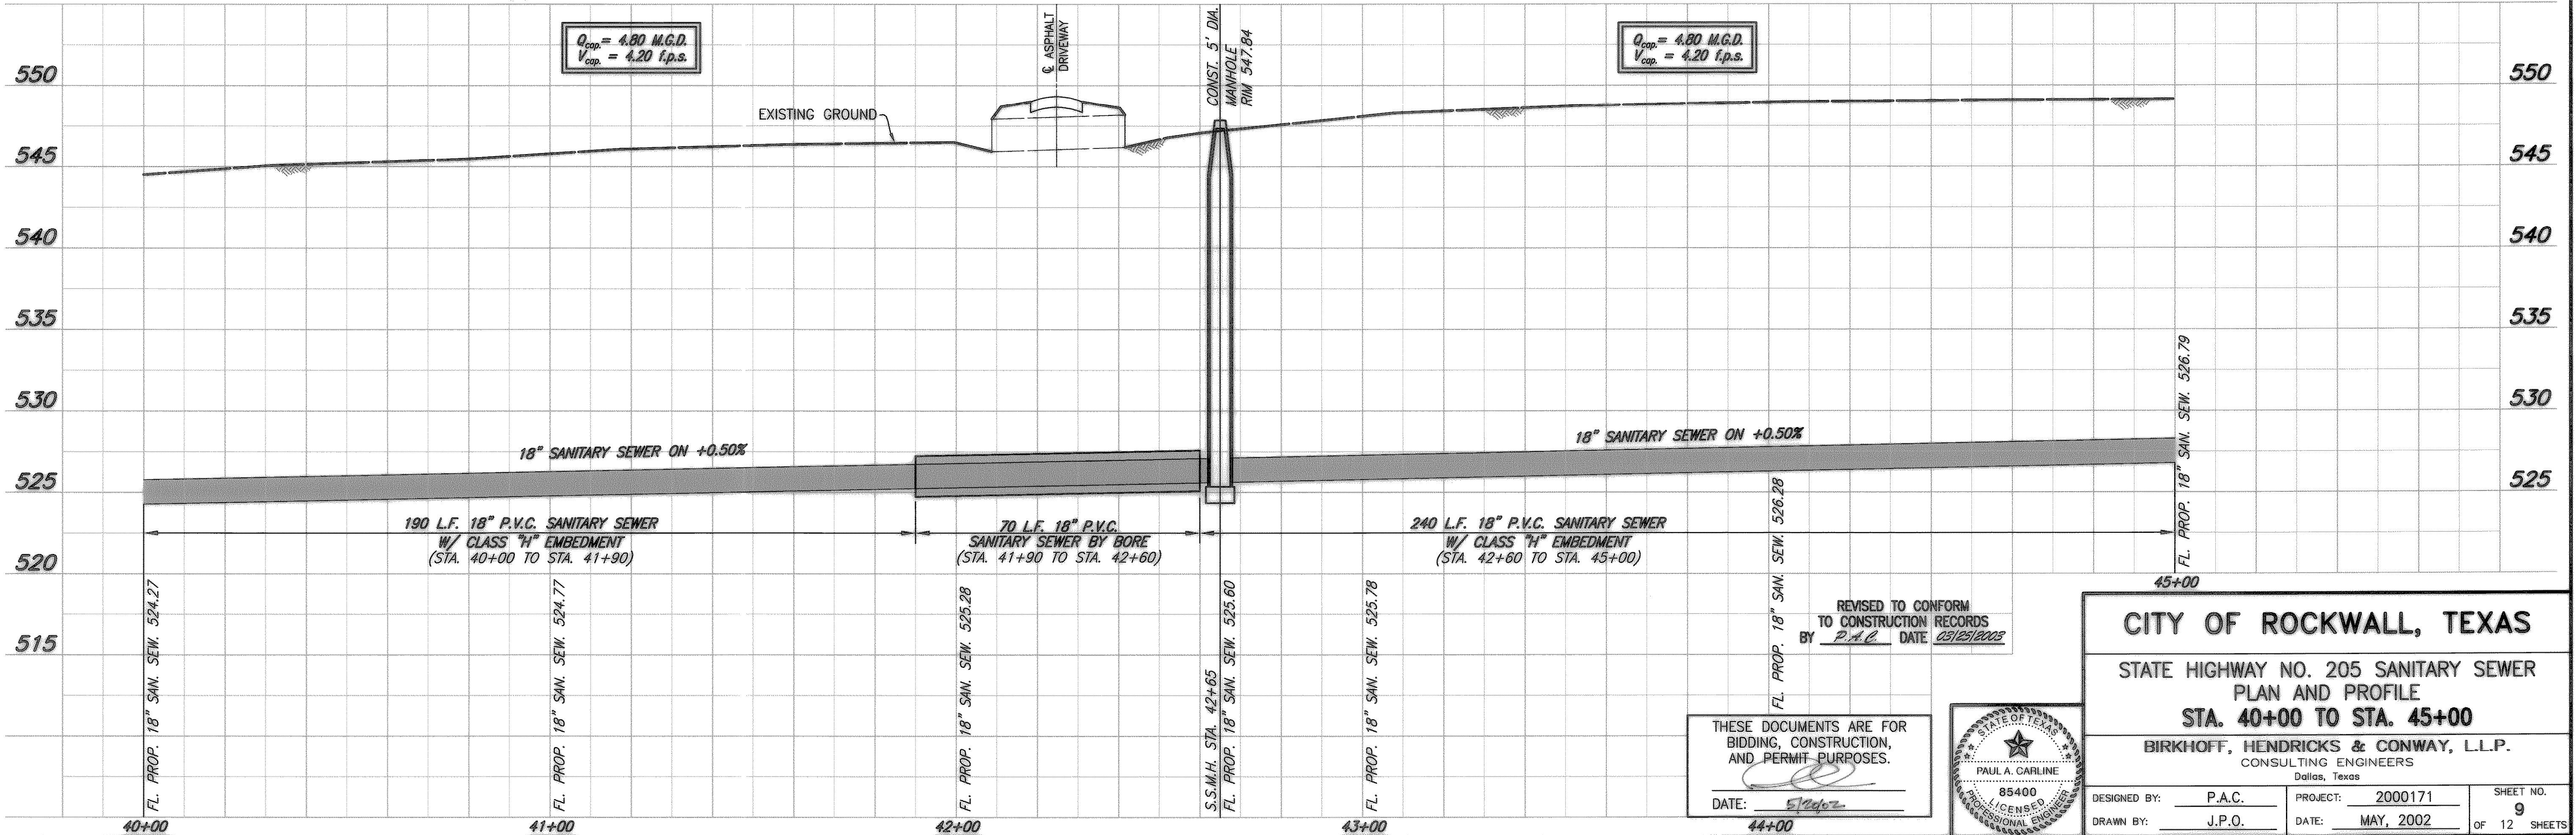

REVISED TO CONFORM TO CONSTRUCTION RECORDS BY P.A.C. DATE 05/25/2002

THESE DOCUMENTS ARE FOR BIDDING, CONSTRUCTION, AND PERMIT PURPOSES.

DATE: 5/20/02

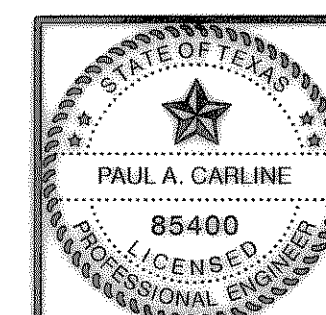

CITY OF ROCKWALL, TEXAS

STATE HIGHWAY NO. 205 SANITARY SEWER
PLAN AND PROFILE
STA. 40+00 TO STA. 45+00

BIRKHOFF, HENDRICKS & CONWAY, L.L.P.
CONSULTING ENGINEERS
Dallas, Texas

DESIGNED BY: P.A.C. PROJECT: 2000171 SHEET NO. 9
DRAWN BY: J.P.O. DATE: MAY, 2002 OF 12 SHEETS

Revised: 05/20/2002 KAB H:\Projects\Rockwall\2000171\Plans\Sheets\2000171-509.dwg Master 171, Revised Master Profile