


SYMBOL LEGEND

| | |
|----------|--------------------------|
| [Symbol] | POWER POLE |
| [Symbol] | OLEY WIRE |
| [Symbol] | TELEPHONE BOX |
| [Symbol] | IRON ROD |
| [Symbol] | WATER VALVE |
| [Symbol] | WATER METER |
| [Symbol] | IRRIGATION CONTROL VALVE |
| [Symbol] | MONUMENT |
| [Symbol] | SIGN |
| [Symbol] | ELECTRIC BOX |

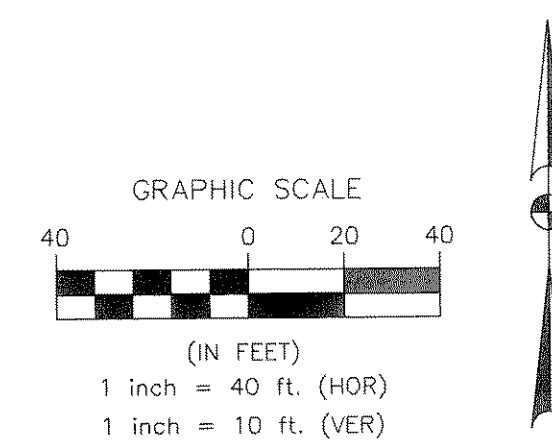

SH 276 WATERLINE IMPROVEMENTS
16" WATERLINE
ROCKWALL, TEXAS
CITY OF ROCKWALL
"THE NEW HORIZON"

DESIGNED: _____

DRAWN: ACAD

JOB NO. _____ DATE: 9/00 SHEET NO. 3 of 3

10/3/00 REVISED PER TxDOT COMMENTS