

ROCKWALL, TEXAS SH-66 SANITARY SEWER RECONSTRUCTION BY PIPE BURST (N. FANNIN AVE. TO N. CLARK AVE.)

MAYOR

DAVID SWEET

MAYOR PRO-TEM

MARK RUSSO

CITY COUNCIL

DAVID WHITE

BENNIE DANIELS


CLIFF SEVIER

MICHELLE SMITH

MARGO NIELSEN

CITY MANAGER

JULIE COUCH

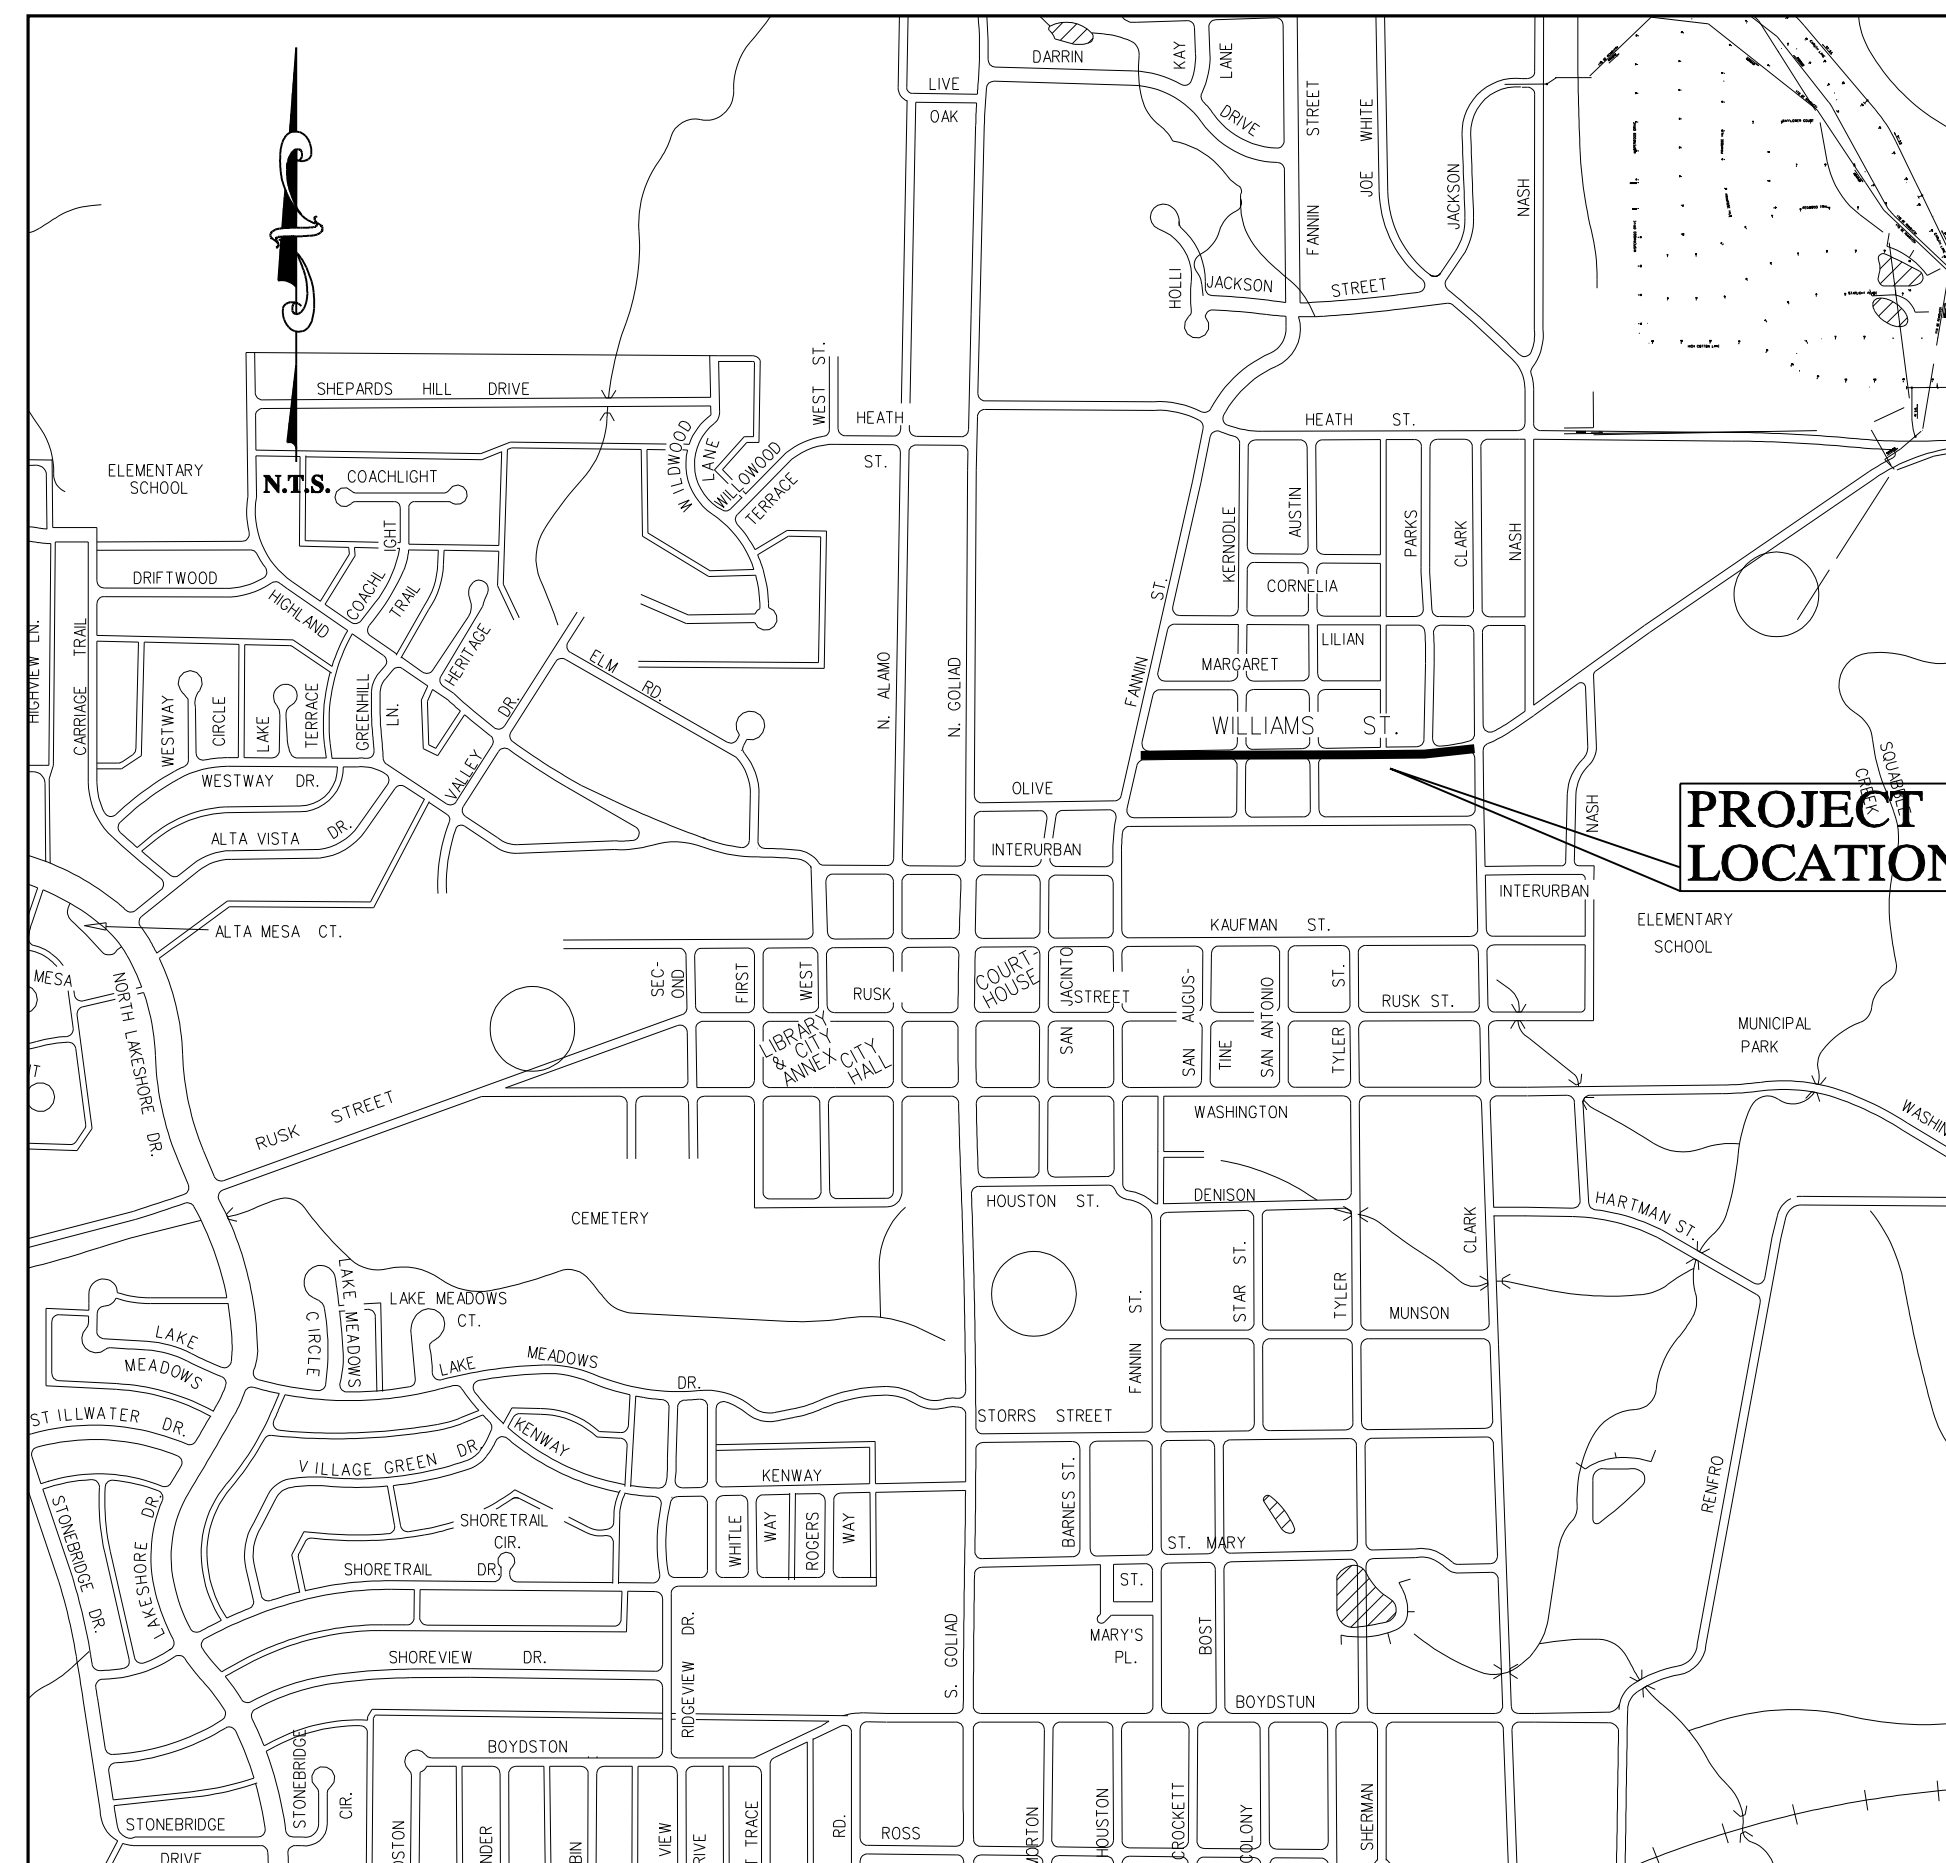

PROJECT LOCATION MAP

INDEX OF SHEETS

- SHEET 1 COVER SHEET
- SHEET 2 GENERAL NOTES & DETAILS
- SHEET 3 SANITARY SEWER PLAN SHEET
- SHEET 4 SANITARY SEWER PLAN SHEET

RECORD DRAWING

THIS RECORD DRAWING IS A COMPILATION OF A COPY OF THE SEALED ENGINEERING DRAWING FOR THIS PROJECT, MODIFIED BY ADDENDA, CHANGE ORDERS AND INFORMATION FURNISHED BY THE CONTRACTOR. THE INFORMATION SHOWN ON THE RECORD DRAWINGS THAT WAS PROVIDED BY THE CONTRACTOR OR OTHERS NOT ASSOCIATED WITH THE DESIGN ENGINEER CANNOT BE VERIFIED FOR ACCURACY OR COMPLETENESS. THE ORIGINAL SEALED DRAWINGS ARE ON FILE AT THE OFFICES OF BURGESS & NIPLE, INC., 11117 SHADY TRAIL DALLAS, TX 75229.
T&PE REGISTRATION NO. 10834
DATE OF RECORD DRAWING: 6-12-2012

ORIGINAL DRAWINGS FOR CONSTRUCTION WERE SEALED ON 9-20-2011 BY: **LOWELL D. DeGROOT, P.E., #93862.**
CONSTRUCTED BY: **PM CONSTRUCTION**

BURGESS & NIPLE
Engineers ■ Planners

11117 SHADY TRAIL
DALLAS, TEXAS 75229
Texas Board of Professional Engineers
Firm Registration No. 10834

SEPTEMBER 2011