


**CONSTRUCTION PHASING NOTES:**

1. THE CONTRACTOR MUST FOLLOW THE OUTLINED CONSTRUCTION PHASING TO INSURE PROPER CONSTRUCTION SEQUENCING WITH THE TXDOT SH-66 CONSTRUCTION AND FRANCHISE UTILITY RELOCATIONS.
2. CONTRACTOR MUST COORDINATE ALL WORK WITH THE CITY OF ROCKWALL, FRANCHISE UTILITY COMPANIES, TXDOT AND THE TXDOT SH-66 CONTRACTOR, TRAYLOR BROTHERS CONSTRUCTION.
3. SANITARY SEWER LINE "A" IS LOCATED IN THE CONSTRUCTION STAGING YARD FOR THE TXDOT SH-66 CONTRACTOR, TRAYLOR BROTHERS CONSTRUCTION. THE CONTRACTOR MUST COORDINATE THE CONSTRUCTION OF SANITARY SEWER LINE "A" WITH TXDOT AND TRAYLOR BROTHERS CONSTRUCTION.
4. THE 8" WATERLINE LOCATED ON THE NORTH SIDE OF WASHINGTON STREET FROM TXDOT CENTERLINE STATION 485+00 TO STATION 492+00 SHALL BE CONSTRUCTED BEHIND A RETAINING WALL TO BE CONSTRUCTED BY THE TXDOT SH-66 CONTRACTOR, TRAYLOR BROTHERS CONSTRUCTION. THE RETAINING WALL MUST BE COMPLETED PRIOR TO CONSTRUCTION OF THE 8" WATERLINE. THE CONTRACTOR MUST COORDINATE THE CONSTRUCTION OF THE 8" WATERLINE WITH TXDOT AND TRAYLOR BROTHERS CONSTRUCTION

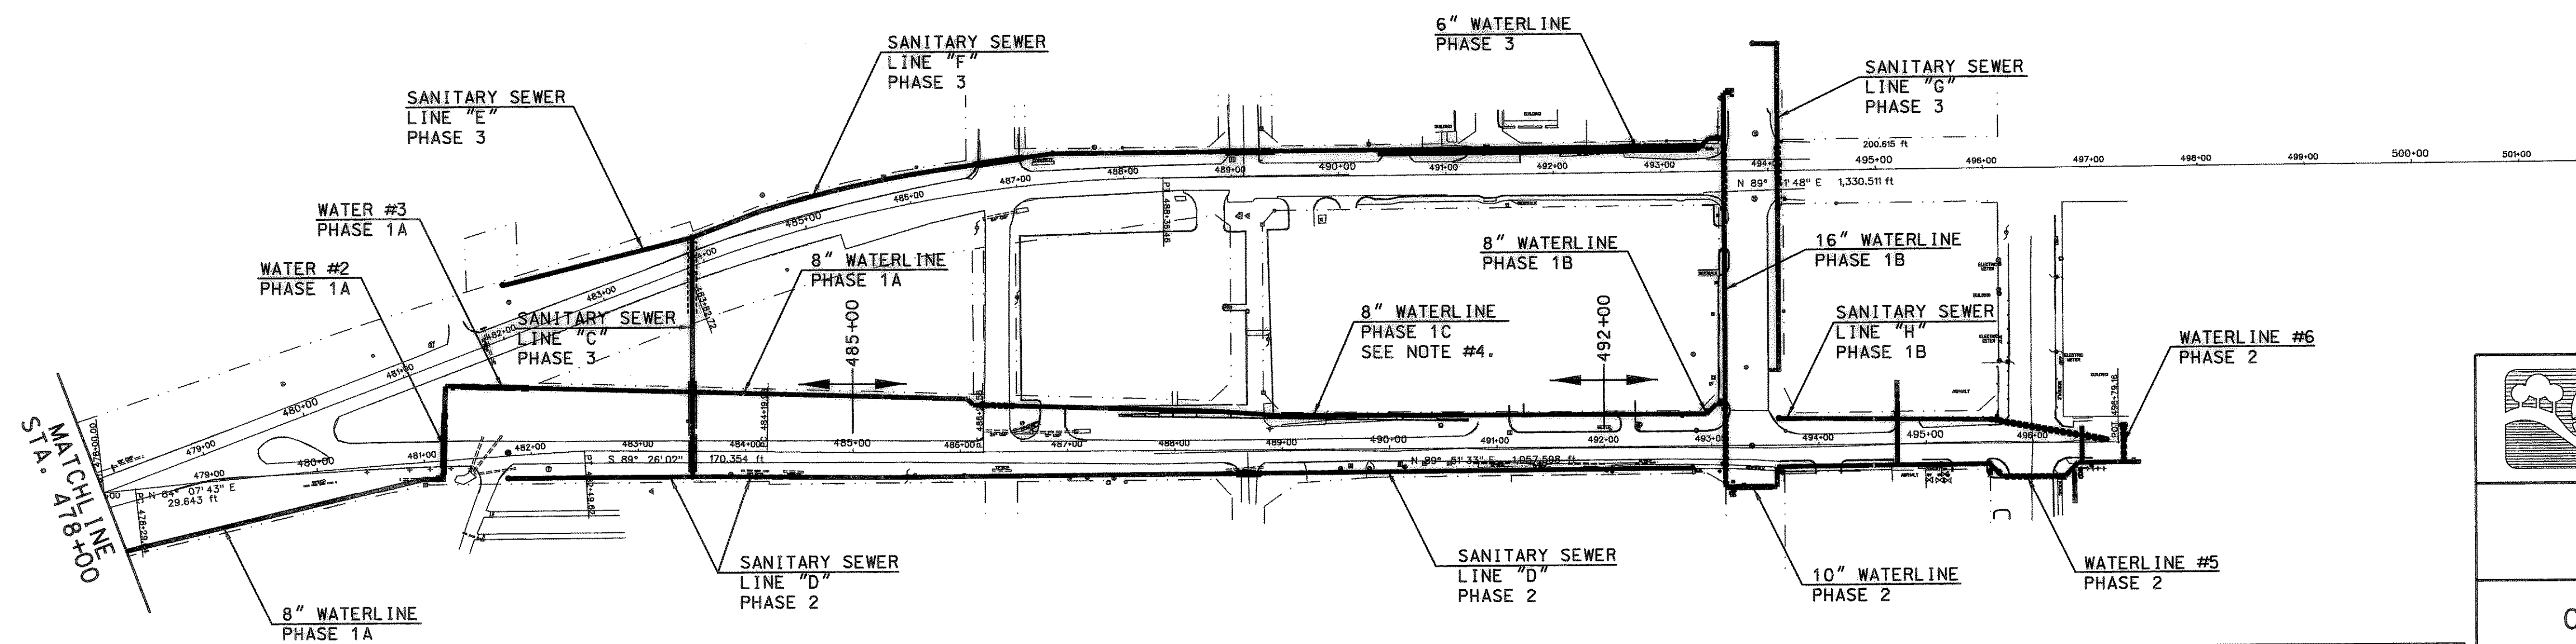

RECORD DRAWINGS

These record drawings have been prepared using information provided by the Construction Contractor and/or Owner. The seal and signature below only signifies that the plans have been revised in accordance with the information provided and does not guarantee that these plans accurately show every detail of the constructed project.

*T. Sugg* 12-10-02  
Signature Date

**CITY OF ROCKWALL**  
"THE NEW HORIZON"

S.H. 66  
UTILITY RELOCATIONS

CONSTRUCTION SEQUENCING

**TurnerCollie & Braden Inc.**  
ENGINEERS • PLANNERS • PROJECT MANAGERS

A123	Scale: Horiz. 1"=100' Vert.	Date	APRIL, 2001
Designed	VVS	Checked	TBS
Drawn	GBA	Approved	RCR
		Job No.	15-98925-300
		SHEET 2A OF 19	

*T. Sugg* 4-16-01