


UNDERGROUND UTILITIES


THE LOCATION OF EXISTING UTILITIES SHOWN ON THESE PLANS ARE APPROXIMATE AND BASED ON DATA FURNISHED BY UTILITY COMPANIES. IT IS THE RESPONSIBILITY OF THE CONTRACTOR TO LOCATE AND VERIFY ON-SITE THE UTILITIES THAT MAY CONFLICT WITH THE CONSTRUCTION.

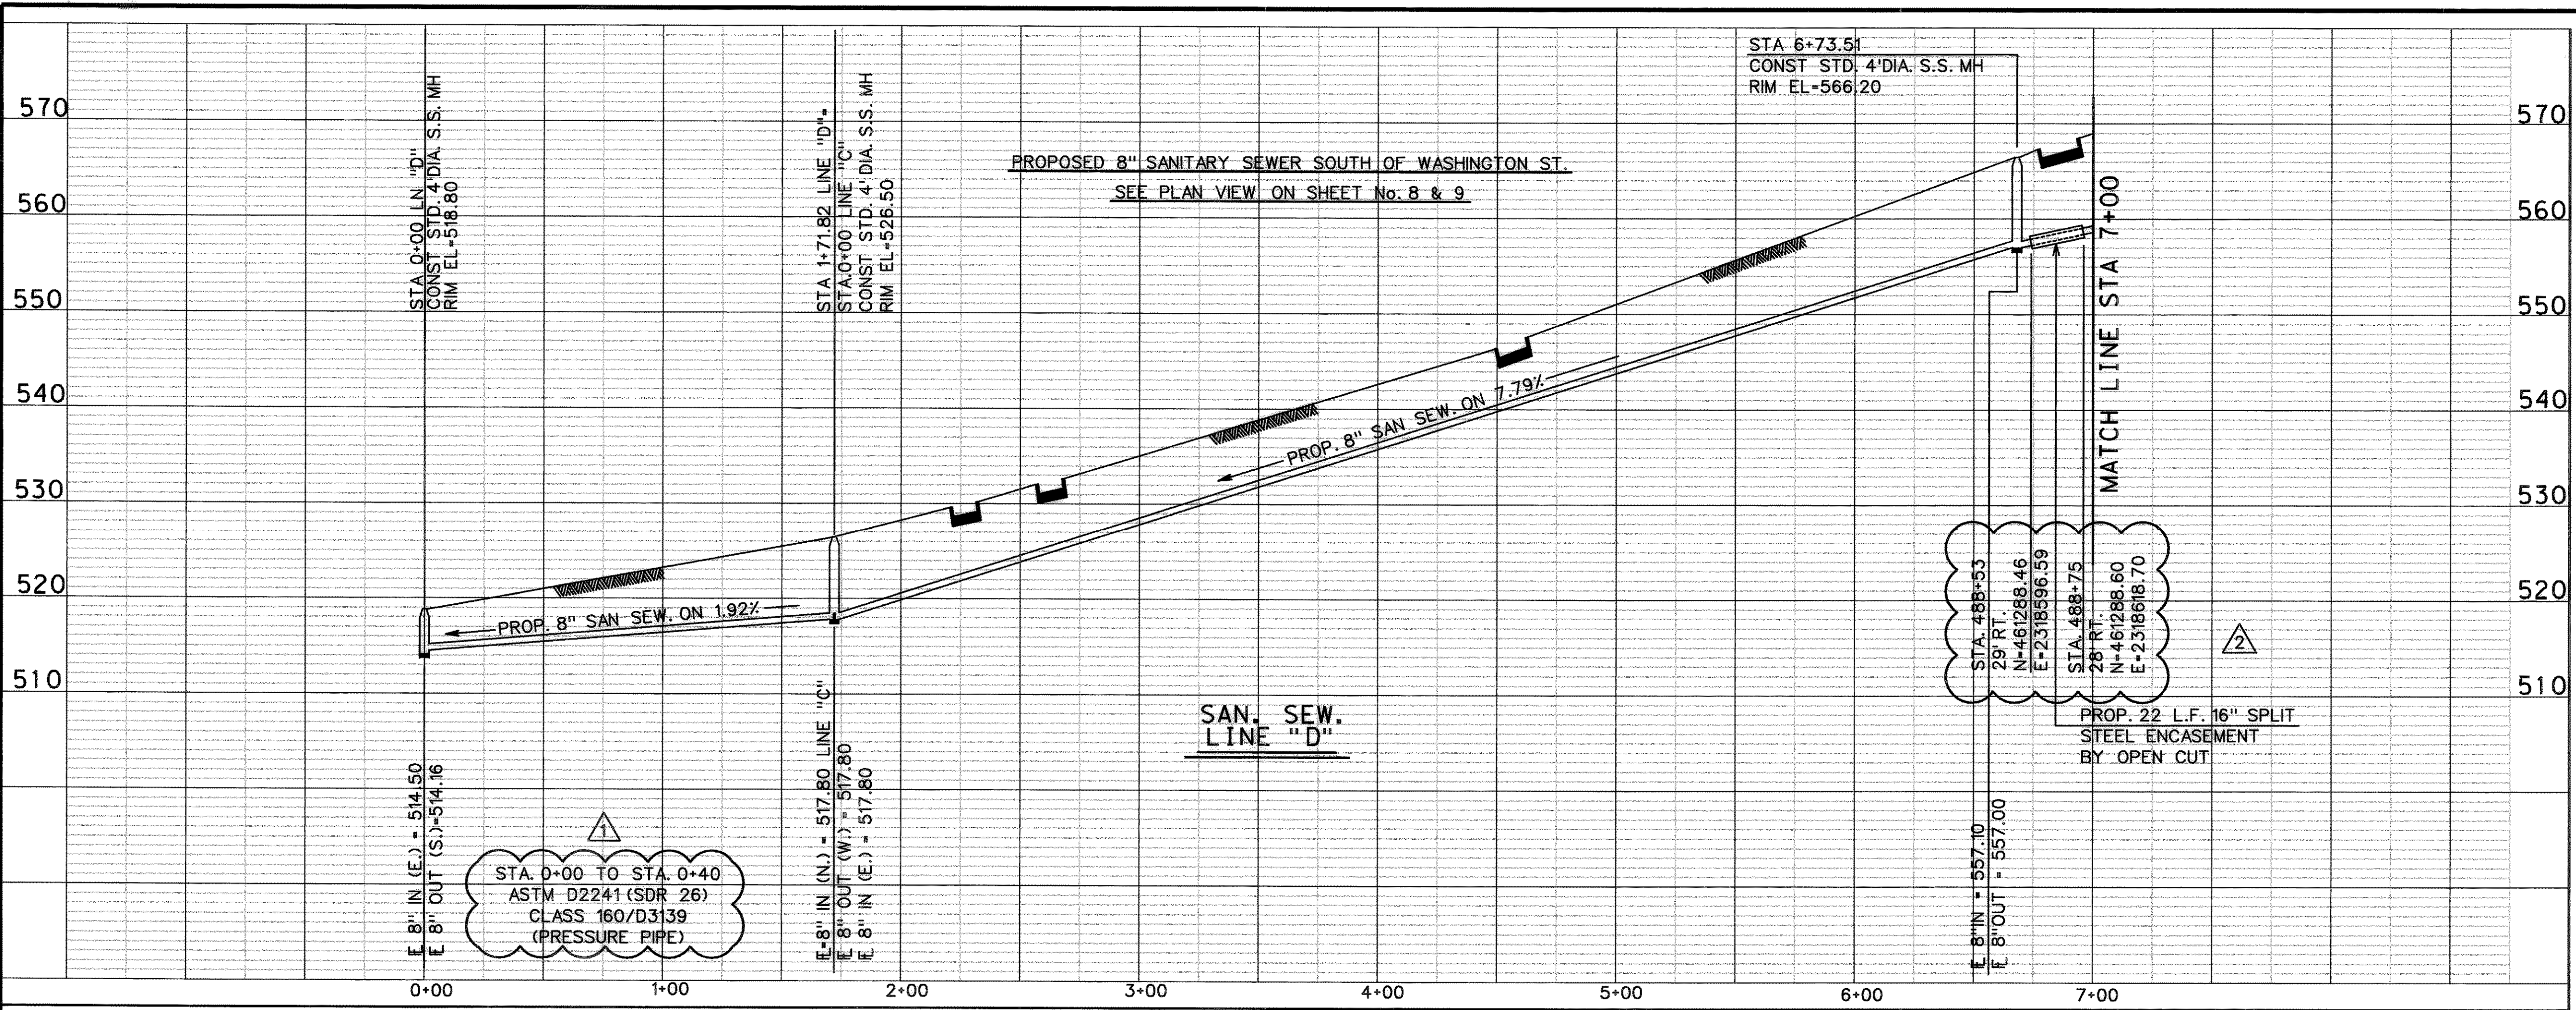

RECORD DRAWINGS

These record drawings have been prepared using information provided by the Construction Contractor and/or Owner. The seal and signature below only signifies that the plans have been revised in accordance with the information provided and does not guarantee that these plans accurately show every detail of the constructed project.

STATE OF TEXAS
 REGISTERED PROFESSIONAL ENGINEER
 TED B. SUGG
 82775
 Signature: *Ted Sugg* Date: 12-10-02

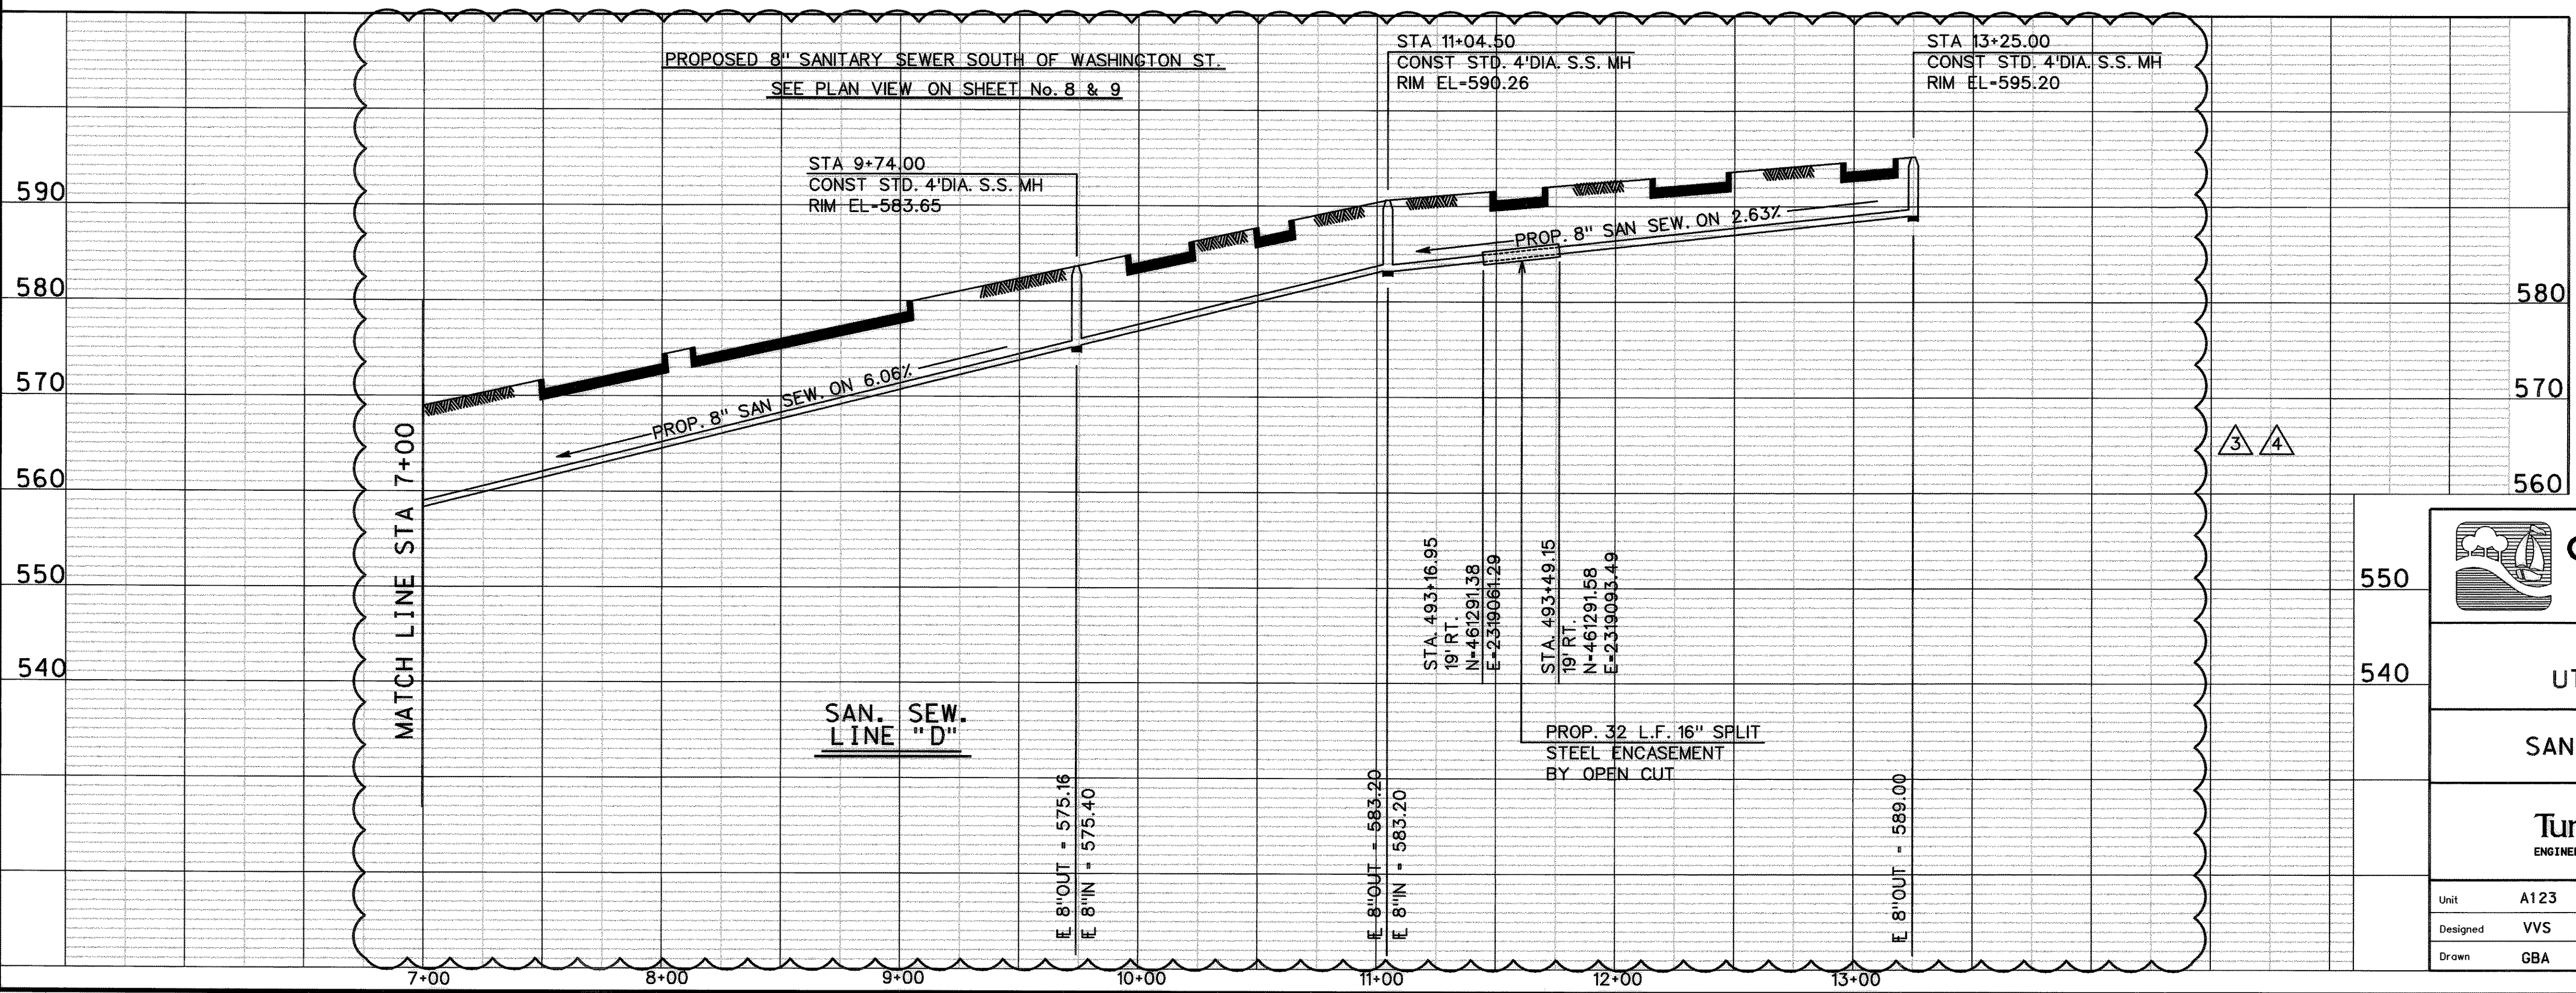

STATE OF TEXAS
 REGISTERED PROFESSIONAL ENGINEER
 VORANIQUE V. SIMON
 86381
 Signature: *Voranique V. Simon* Date: 12-3-01

REVISED	1	8/1	PRESSURE PIPE ADDED
REVISED	2	11/6	ADDED N. & E.
REVISED	3	11/16	CORRECTED PROFILE
REVISED	4	12/3	CORRECTED PROFILE

CITY OF ROCKWALL
 "THE NEW HORIZON"

S. H. 66
 UTILITY RELOCATIONS

SANITARY SEWER PROFILES

Turner Collie & Braden Inc.
 ENGINEERS • PLANNERS • PROJECT MANAGERS

Unit	A123	Scale:	Horz. 1"=40' Vert. 1"=10'	Date	APRIL, 2001
Designed	VVS	Checked	TBS	Job No.	15-98925-300
Drawn	GBA	Approved	RCR		SHEET 10 OF 19

p:\rockwall\sh66\drawings\sh66_xsec01.dgn