
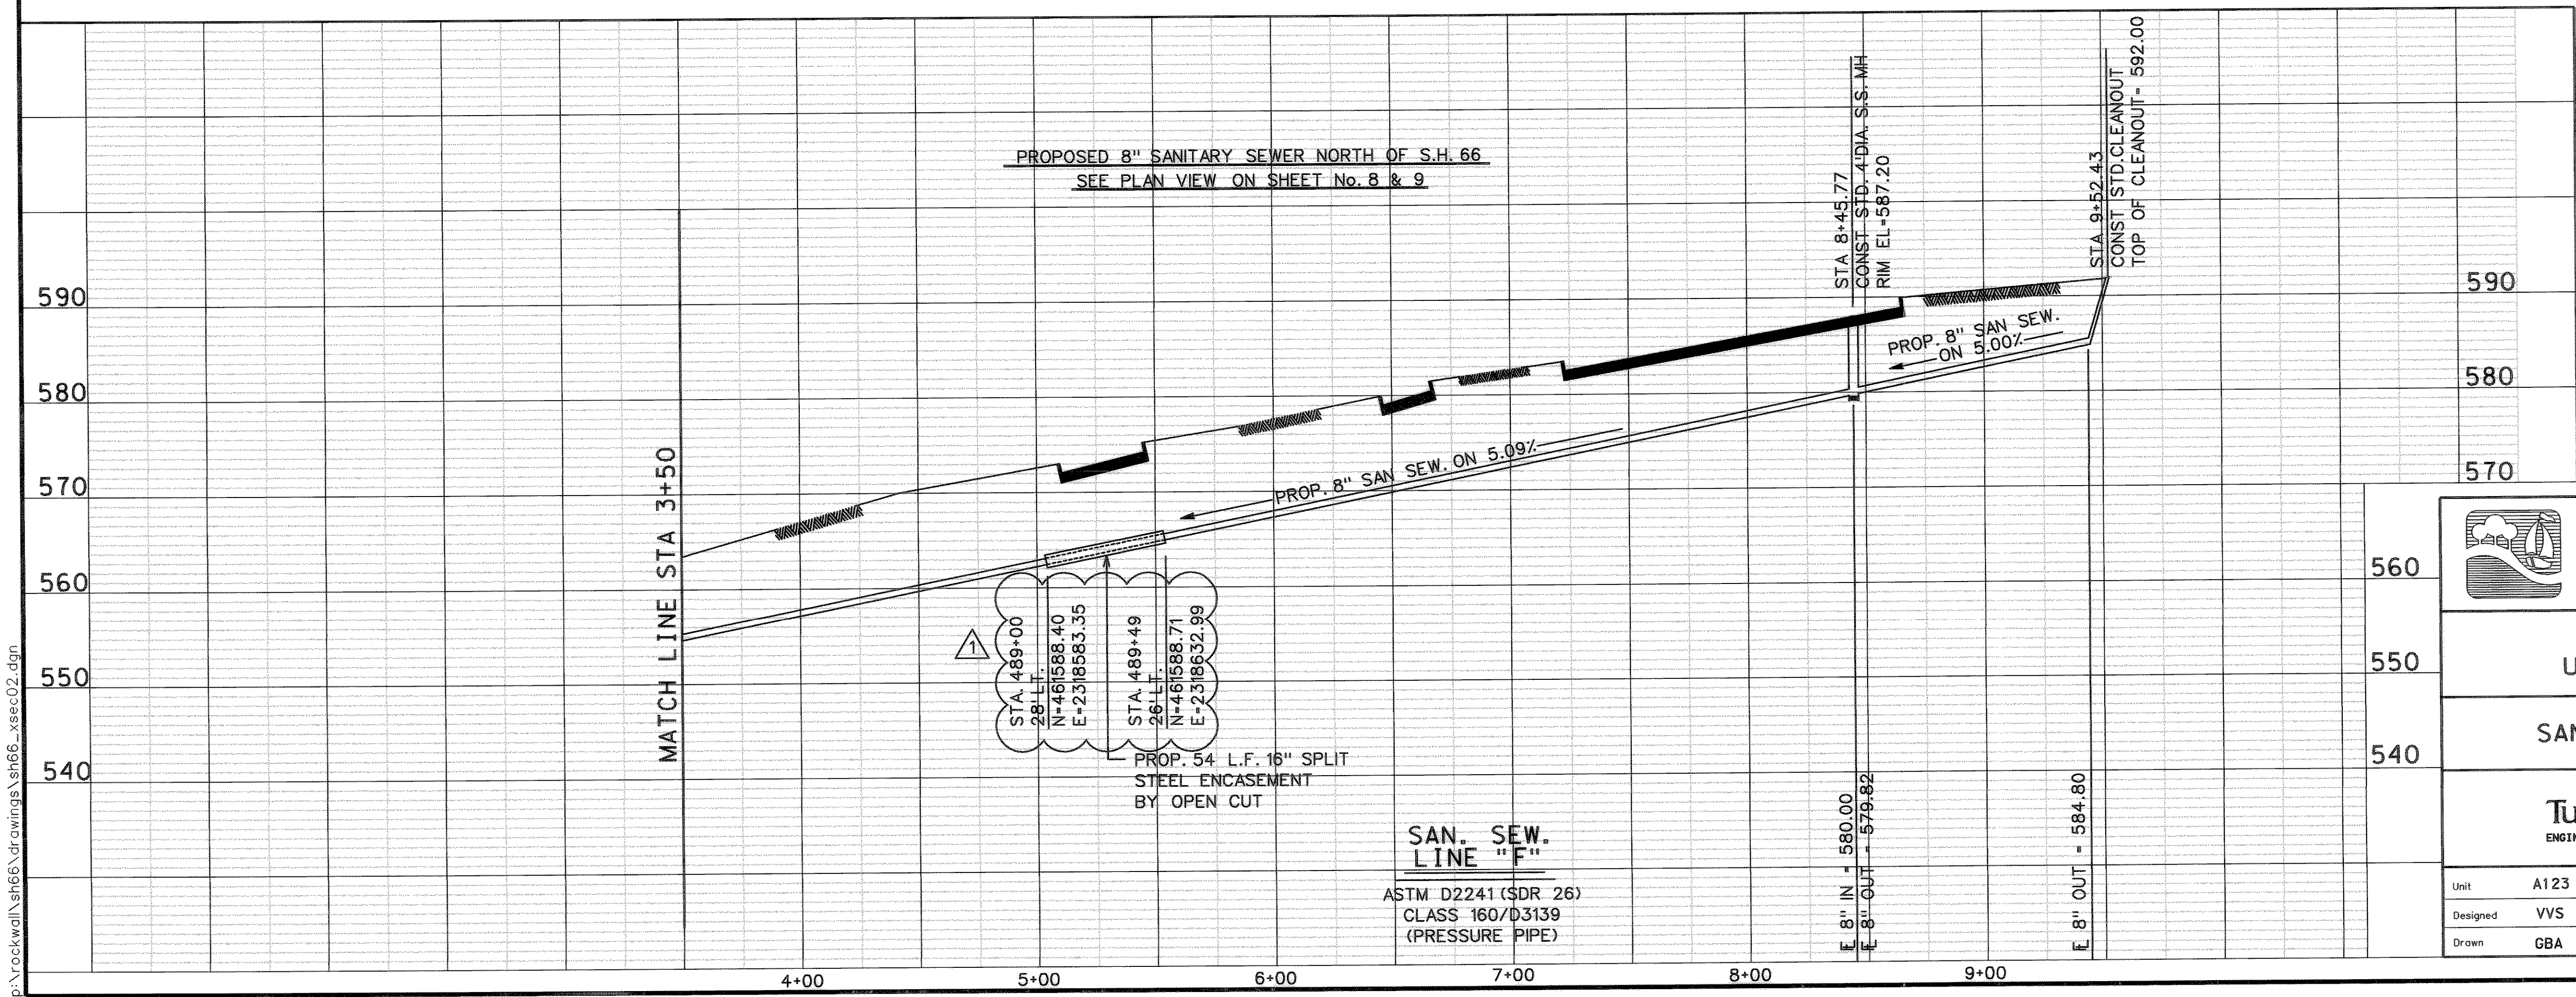


UNDERGROUND UTILITIES

THE LOCATION OF EXISTING UTILITIES SHOWN ON THESE PLANS ARE APPROXIMATE AND BASED ON DATA FURNISHED BY UTILITY COMPANIES. IT IS THE RESPONSIBILITY OF THE CONTRACTOR TO LOCATE AND VERIFY ON-SITE THE UTILITIES THAT MAY CONFLICT WITH THE CONSTRUCTION.

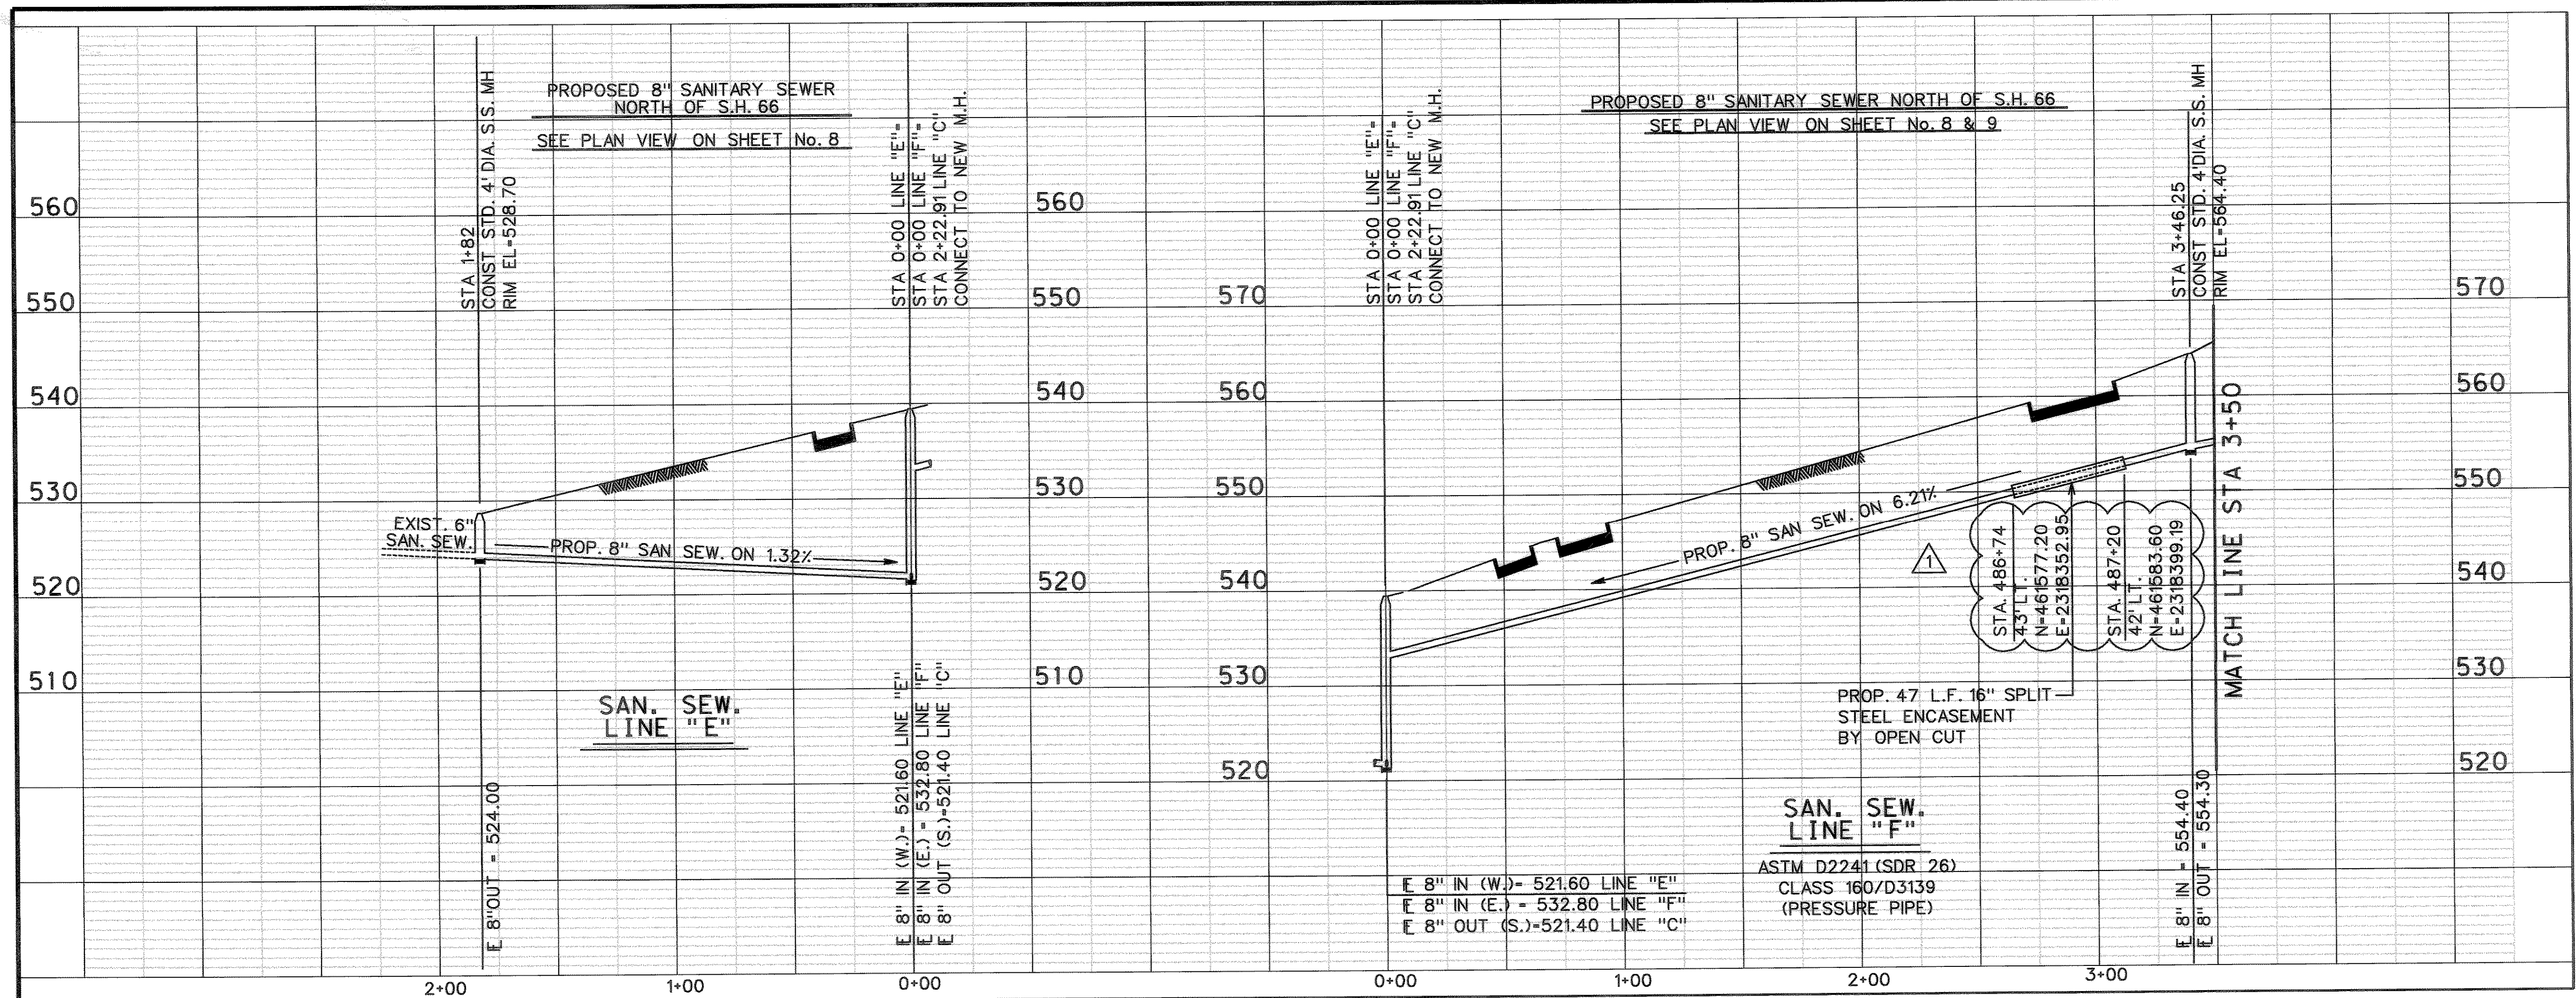

RECORD DRAWINGS

These record drawings have been prepared using information provided by the Construction Contractor and/or Owner. The seal and signature below only signifies that the plans have been revised in accordance with the information provided and does not guarantee that these plans accurately show every detail of the constructed project.

STATE OF TEXAS
TED S. SIMON
82775
REGISTERED PROFESSIONAL ENGINEER

Ted S. Simon
12-10-02
Date

STATE OF TEXAS
VORANIQUE V. SIMON
86381
REGISTERED PROFESSIONAL ENGINEER

Voranique V. Simon
11-6-01
Date

REVISED 1 11/8 ADDED N. & E.

CITY OF ROCKWALL
"THE NEW HORIZON"

S.H. 66
UTILITY RELOCATIONS

SANITARY SEWER PROFILES

Turner Collie & Braden Inc.
ENGINEERS • PLANNERS • PROJECT MANAGERS

Unit	A123	Scale	Horz. 1" = 40' Vert. 1" = 10'	Date	APRIL, 2001
Designed	VVS	Checked	TBS	Job No.	15-98925-300
Drawn	GBA	Approved	RCR		SHEET 11 OF 19

p:\rockwall\sh66\drawings\sh66_xsec02.dgn