


UNDERGROUND UTILITIES

THE LOCATION OF EXISTING UTILITIES SHOWN ON THESE PLANS ARE APPROXIMATE AND BASED ON DATA FURNISHED BY UTILITY COMPANIES. IT IS THE RESPONSIBILITY OF THE CONTRACTOR TO LOCATE AND VERIFY ON-SITE THE UTILITIES THAT MAY CONFLICT WITH THE CONSTRUCTION.

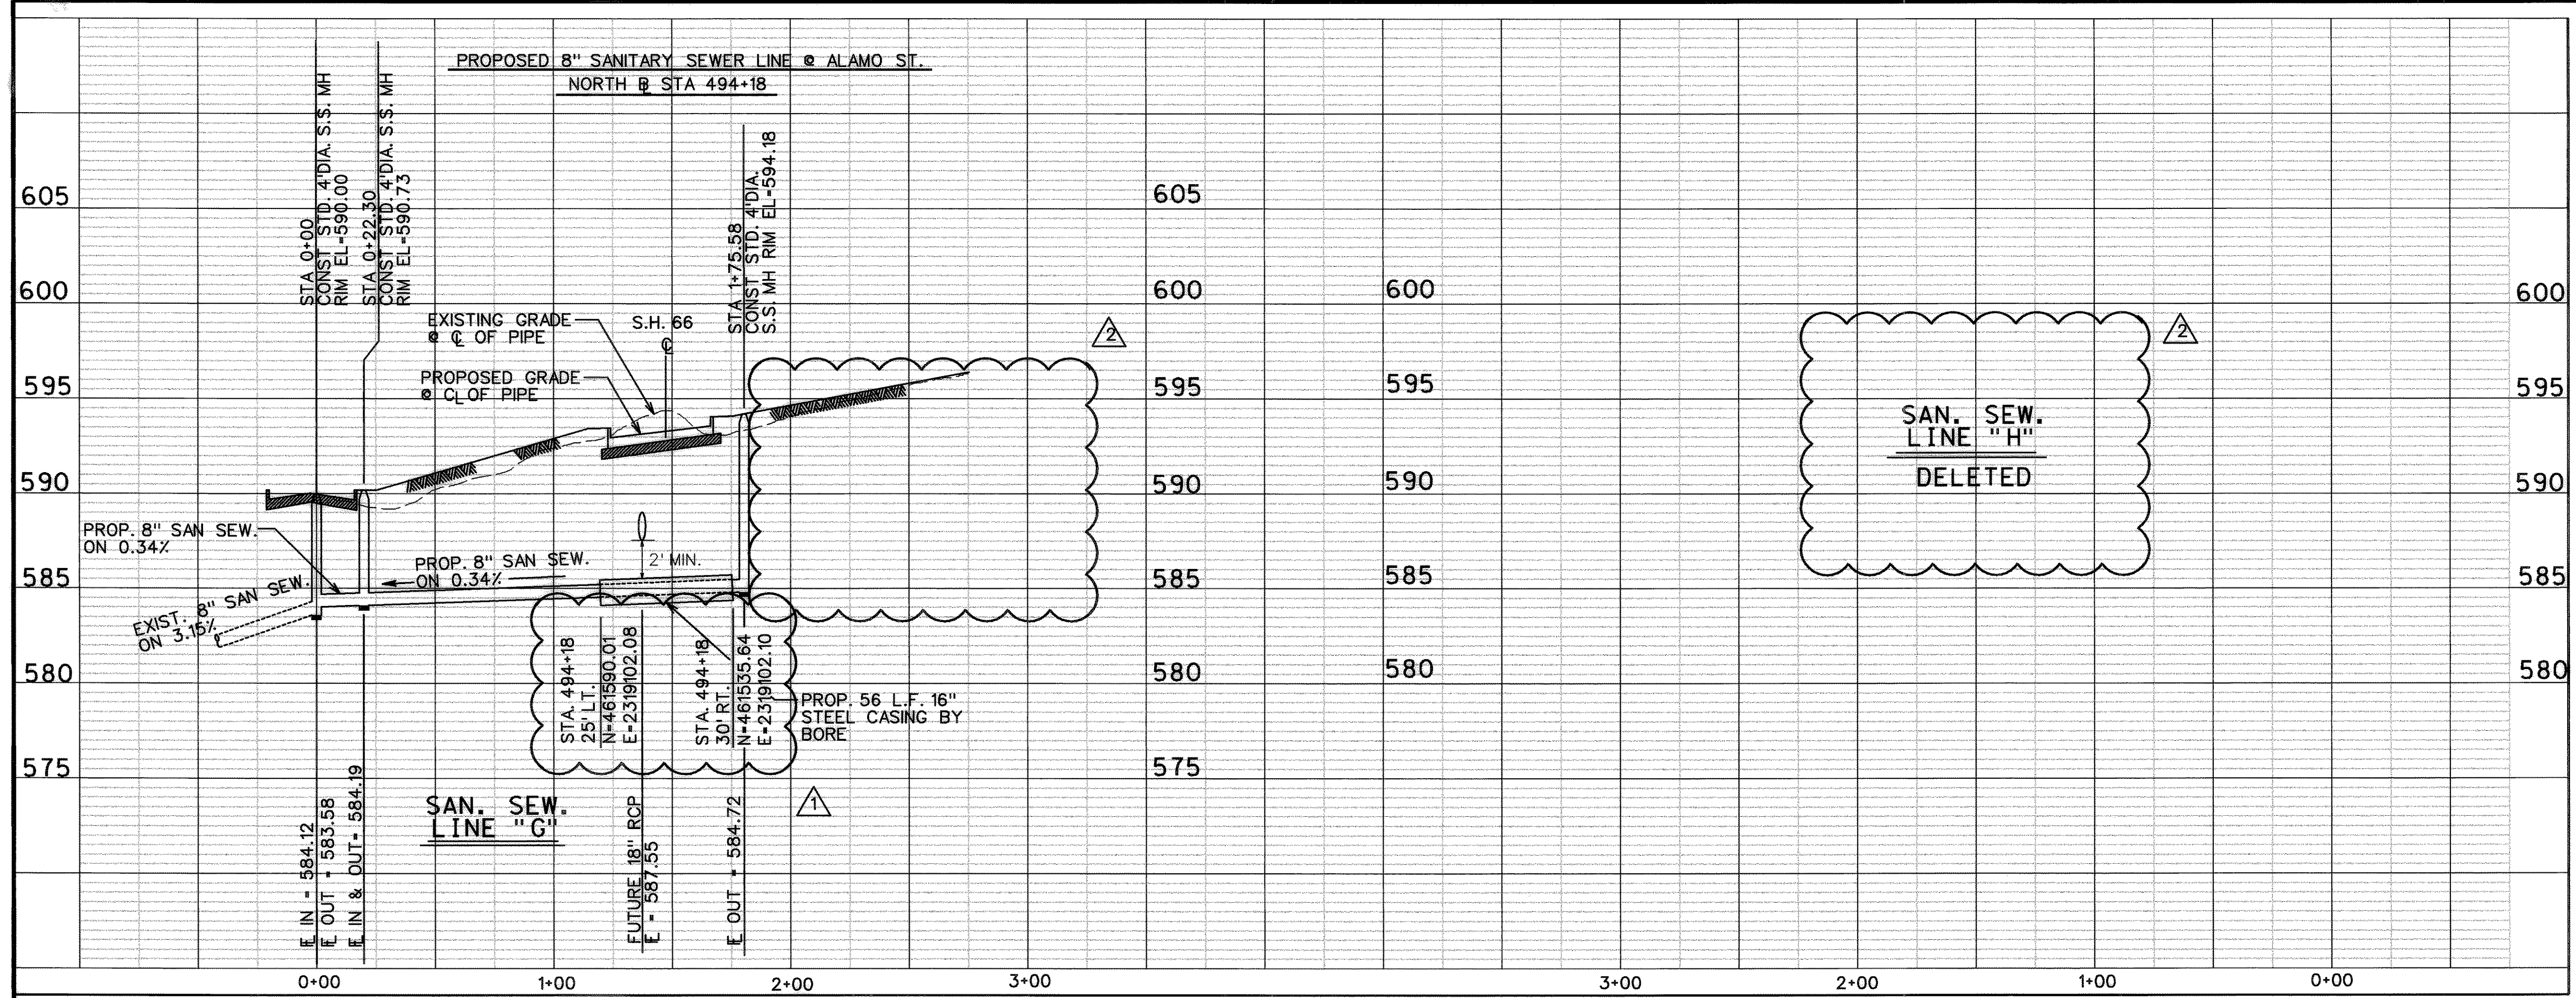

RECORD DRAWINGS

These record drawings have been prepared using information provided by the Contractor. The Contractor and/or Owner. The seal and signature below only signifies that the plans have been reviewed in accordance with the information provided. It does not guarantee that these plans show every detail of the project.

T.B. Sugg 12-00
 State Date

STATE OF TEXAS

VORANIQUE V. SIMON
 86381
 REGISTERED PROFESSIONAL ENGINEER

V. Simon 12-3-01

REVISED	1	11/6	ADDED N. & E.
REVISED	2	12/3	SANITARY SEWER LINE MODIFIED, DELETED

CITY OF ROCKWALL
 "THE NEW HORIZON"

S.H. 66
 UTILITY RELOCATIONS

SANITARY SEWER PROFILES

Turner Collie & Braden Inc.
 ENGINEERS • PLANNERS • PROJECT MANAGERS

Unit	A123	Scale: Horz. 1"=40' Vert. 1"=5'	Date	APRIL, 2001
Designed	VVS	Checked	TBS	Job No. 15-98925-300
Drawn	GBA	Approved	RCR	SHEET 12 OF 19

p:\rockwall\sh66\drawings\sh66_xsec03.dgn