
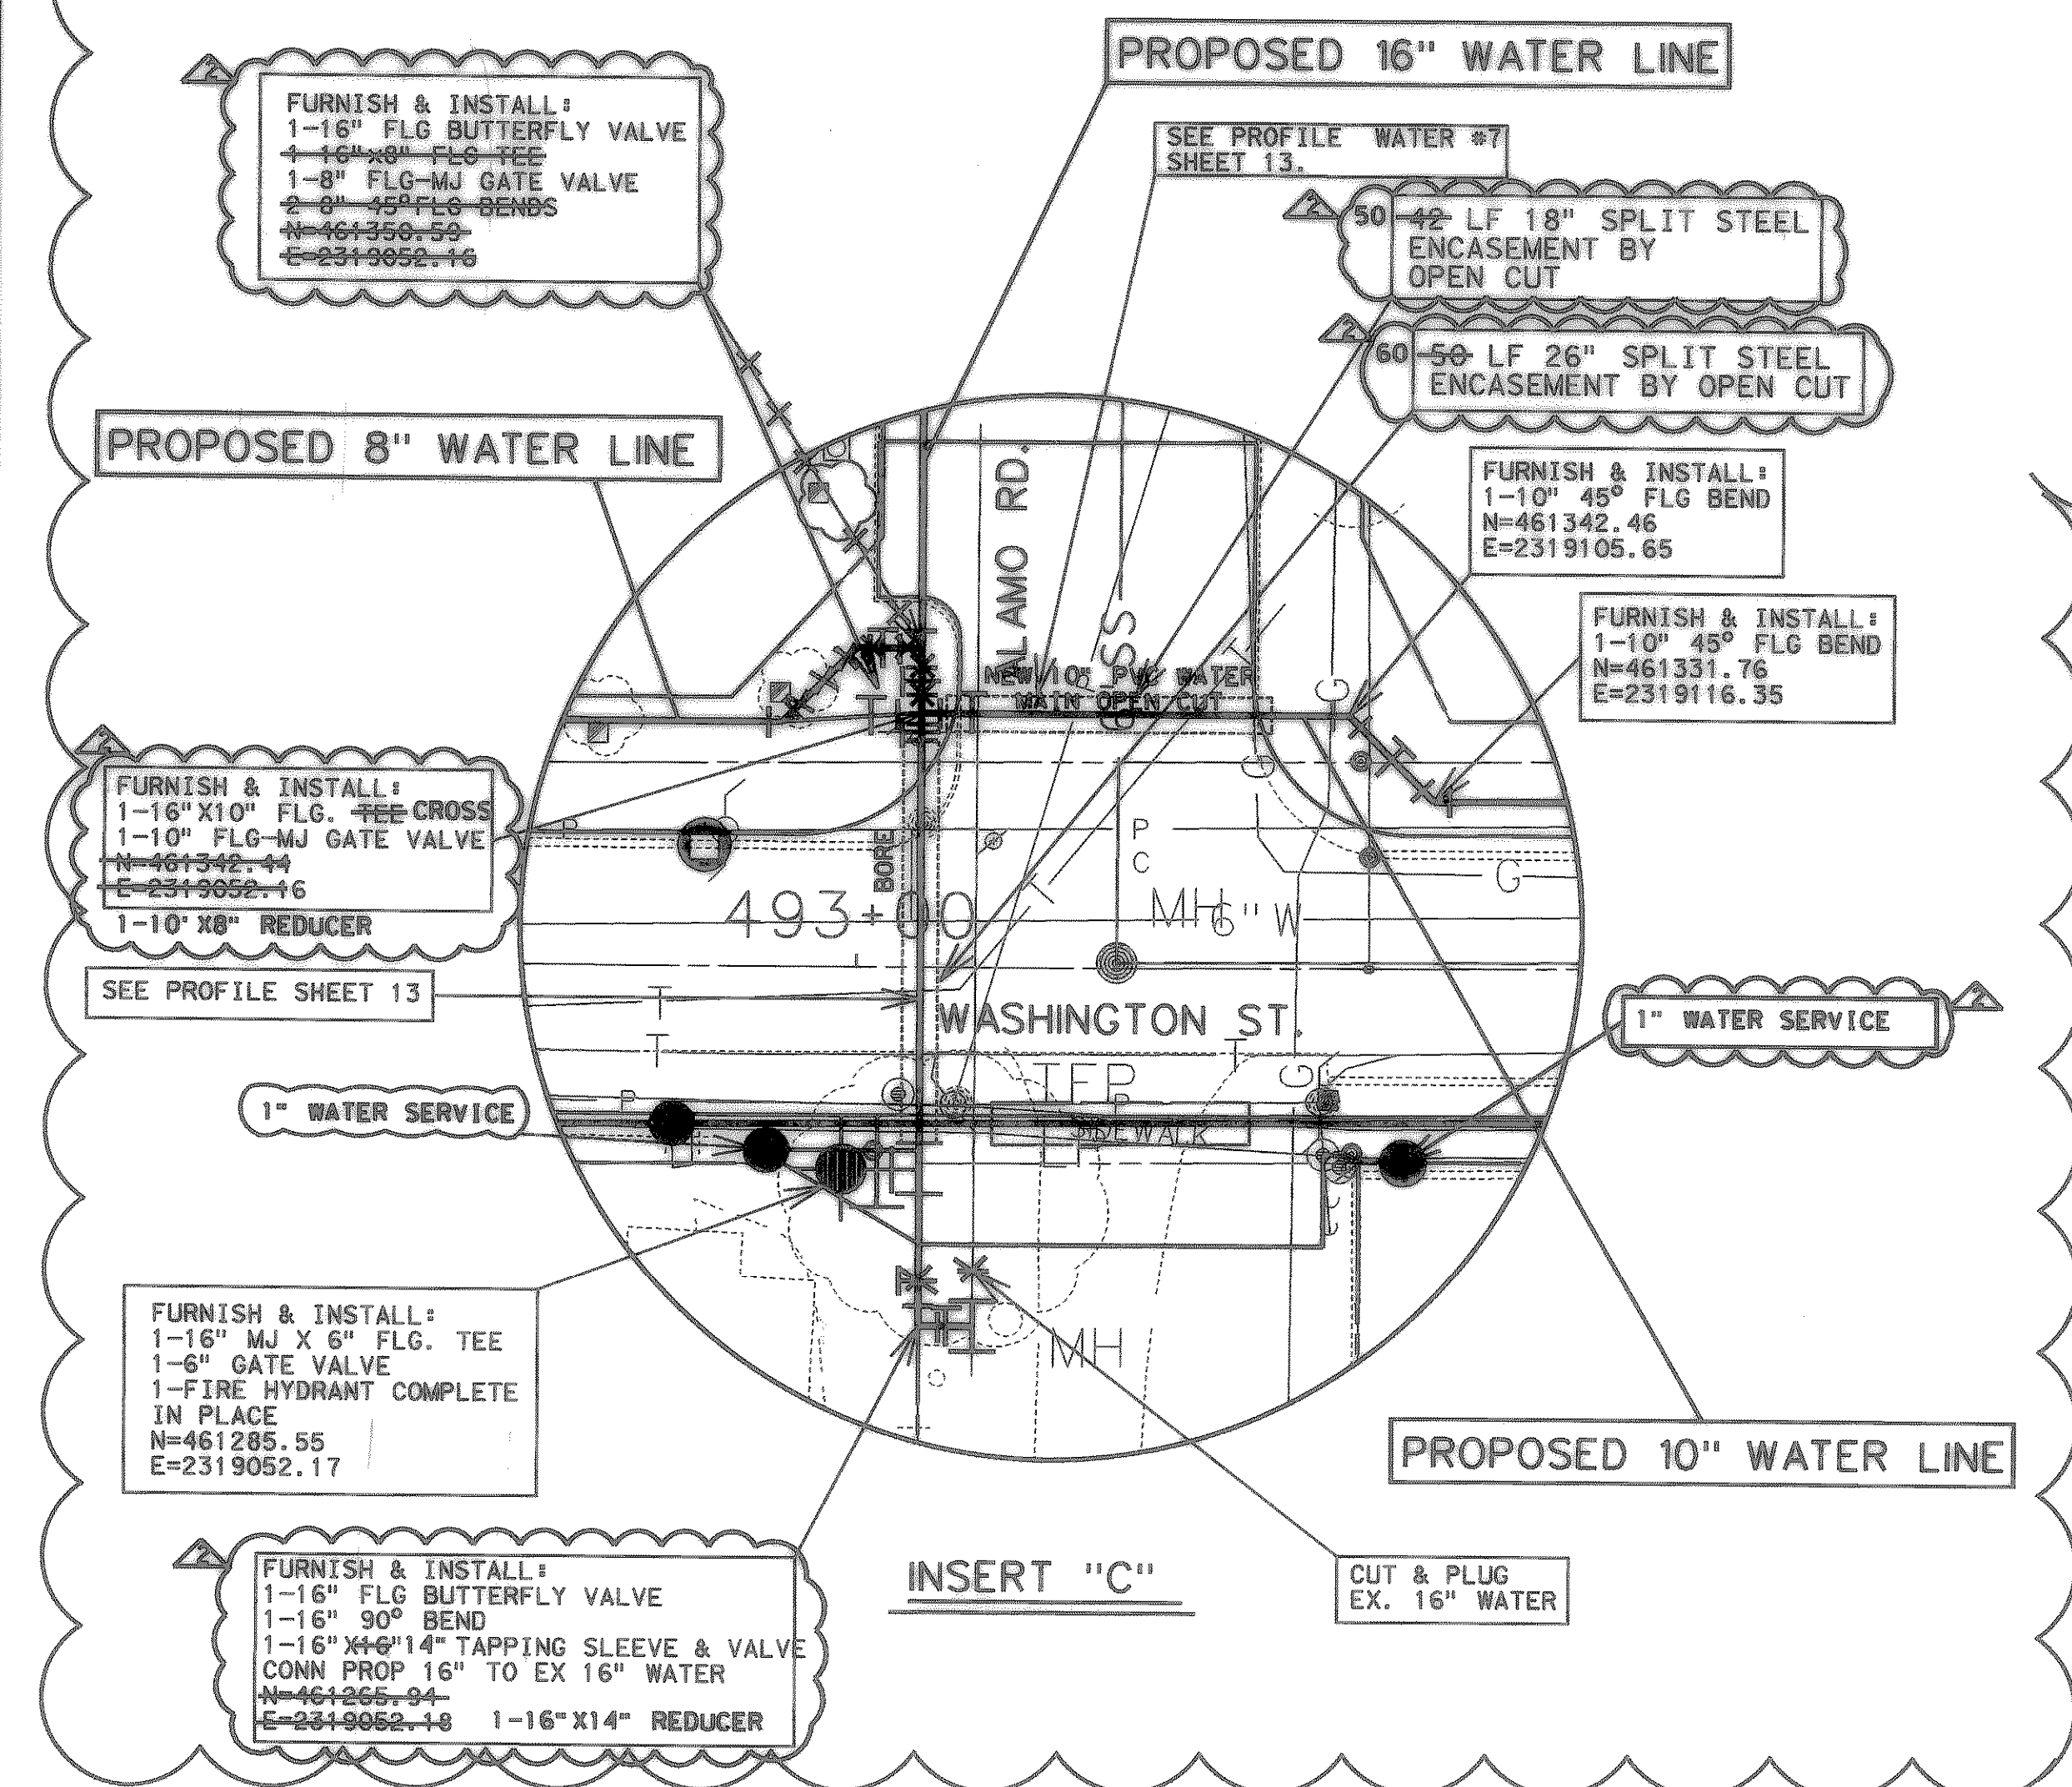


INSERT "B"
DELETED

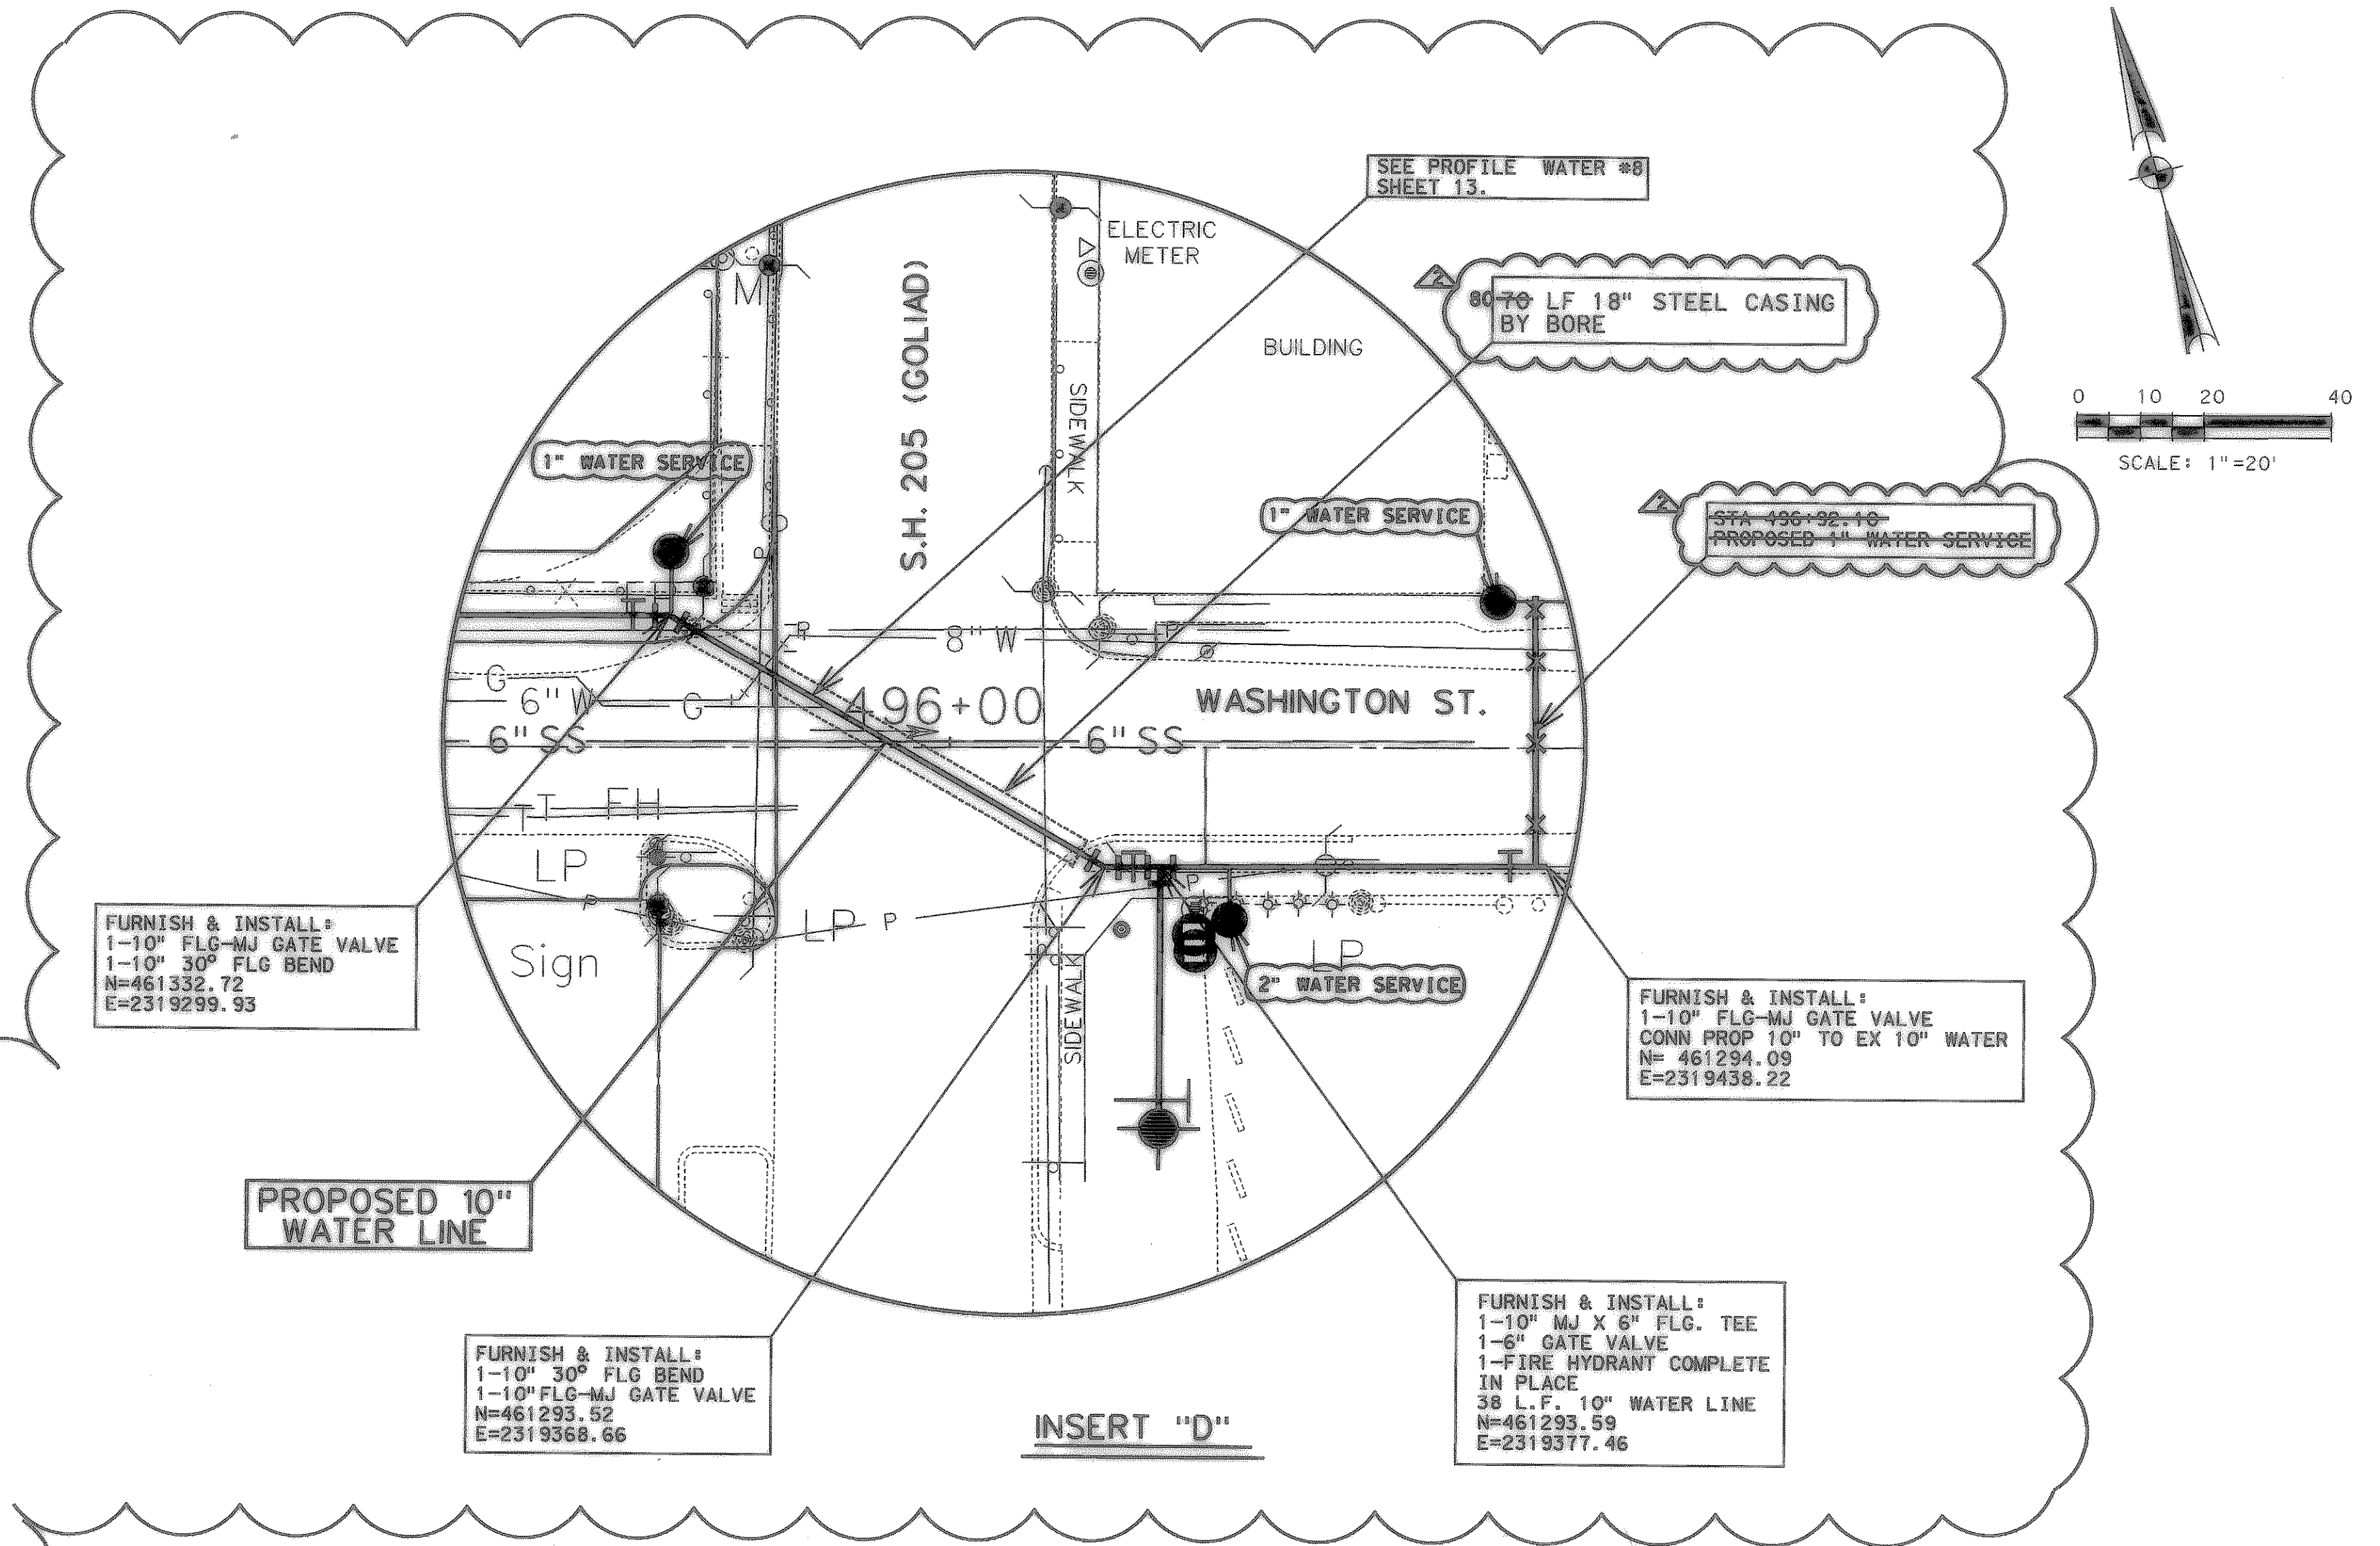

LEGEND

☐	POWER POLE
—	GUY WIRE
☐	TELEPHONE BOX
+	POST
⊕	SIGN
⊙	IRON ROD
⊕	FIRE HYDRANT
⊕	WATER METER
⊕	MAILBOX
⊕	WATER METER
⊕	IRRIGATION CONTROL VALVE
⊕	GUARD RAIL
⊕	GAS METER

LEGEND

⊕	GROUND LIGHT
⊕	CHAIN LINK FENCE
⊕	WOOD FENCE
⊕	ASH TREE
⊕	OAK TREE
⊕	CEDAR TREE
⊕	BARBED WIRE FENCE
⊕	REFLECTOR
⊕	APPROXIMATE TELEPHONE LINE
⊕	APPROXIMATE GAS LINE
⊕	APPROXIMATE WATER LINE
⊕	OVERHEAD POWER LINE
⊕	PINE TREE
⊕	PECAN TREE

RECORD DRAWINGS

These record drawings have been prepared using information provided by the Construction Contractor and/or Owner. The seal and signature below only signifies that the plans have been revised in accordance with the information provided and does not guarantee that these plans accurately show every detail of the project.

Ted B. Sugg 12-11-02
Signature Date

THE SEAL APPEARING ON THIS DOCUMENT WAS AUTHORIZED BY
VORANQUE V. SIMON, P.E. 86361
ON 3 DECEMBER 2001

REVISIONS
1 12/3 INSERT "C", "D"
2 9-02 REVISED RECORD DRAWINGS

UNDERGROUND UTILITIES

THE LOCATION OF EXISTING UTILITIES SHOWN ON THESE PLANS ARE APPROXIMATE AND BASED ON DATA FURNISHED BY UTILITY COMPANIES. IT IS THE RESPONSIBILITY OF THE CONTRACTOR TO LOCATE AND VERIFY ON-SITE THE UTILITIES THAT MAY CONFLICT WITH THE CONSTRUCTION.

CITY OF ROCKWALL
"THE NEW HORIZON"

S.H. 66
UTILITY RELOCATIONS

INSERTS - PROPOSED WATER LINES

TurnerCollie & Braden Inc.
ENGINEERS • PLANNERS • PROJECT MANAGERS

Unit	A123	Scale:	1"=20'	Date	APRIL, 2001
Designed	VVS	Checked	TBS	Job No.	15-98925-300
Drawn	GBA	Approved	RCR		SHEET 15 OF 19

D:\rockwall\SH66\dw\ings\sh66\insert2.dgn