

CAUTION I
UNDERGROUND GAS LINE IN AREA CONTACT LONG STAR GAS COMPANY & 1-800-822-4344 48 HRS. PRIOR TO CONSTRUCTION

$\Delta = 15^{\circ}34'27''$
 $R = 150.00'$
 $T = 20.51'$
 $L = 40.77'$

Exist. 4" Sewer Line to be Abandoned upon Completion of Prop. 6" Sewer Line

4+41.03 ~ Remove Exist. Manhole & Const. New 4.0' Manhole & Conn. Exist. Sewer Lateral to New M.H.

Out & Plug Exist. 4" Sewer Line upon Completion of Prop. 6" Sewer Line

CAUTION : 6" HYD. LEAD REMOVE & REPLACE

$\Delta = 13^{\circ}55'35''$
 $R = 150.00'$
 $T = 18.32'$
 $L = 36.46'$

0+00 ~ Conn. to Exist. 4.0' Manhole

0-21.98 ~ Conn. to Exist. 4.0' Manhole
Verify F.L. elevation in field

Saw-Cut, remove & replace 4.0' wide x 21 L.F. of Exist. 5" Reinf. Concrete Pvmnt.

CAUTION : 1" WATER SERVICE REMOVE & REPLACE


Saw-Cut, remove & replace 4.0' wide x 44 L.F. of Exist. 5" Reinf. Concrete Pvmnt.

CAUTION : 1" WATER SERVICE REMOVE & REPLACE

GENERAL NOTES

1. The Contractor shall be responsible for repair and replacement of any utility lines encountered during the course of construction.
2. It is the Contractors responsibility to verify the location of all existing underground utility lines.
3. The information contained on these drawings is furnished solely as the best information available at this time. It's accuracy is not guaranteed and it's use in no way relieves the Contractor of any responsibility for losses due to any inaccuracies.
4. The Contractor is responsible for jobsite conditions at all times during construction and shall defend, indemnify and hold harmless the Owner, his Agents, and the Engineer against any claims resulting from jobsite conditions during the course of construction.
5. The jobsite shall be maintained in a safe condition during and after work hours.

SCALE : 1" = 20' HORZ.
1" = 5' VERT.

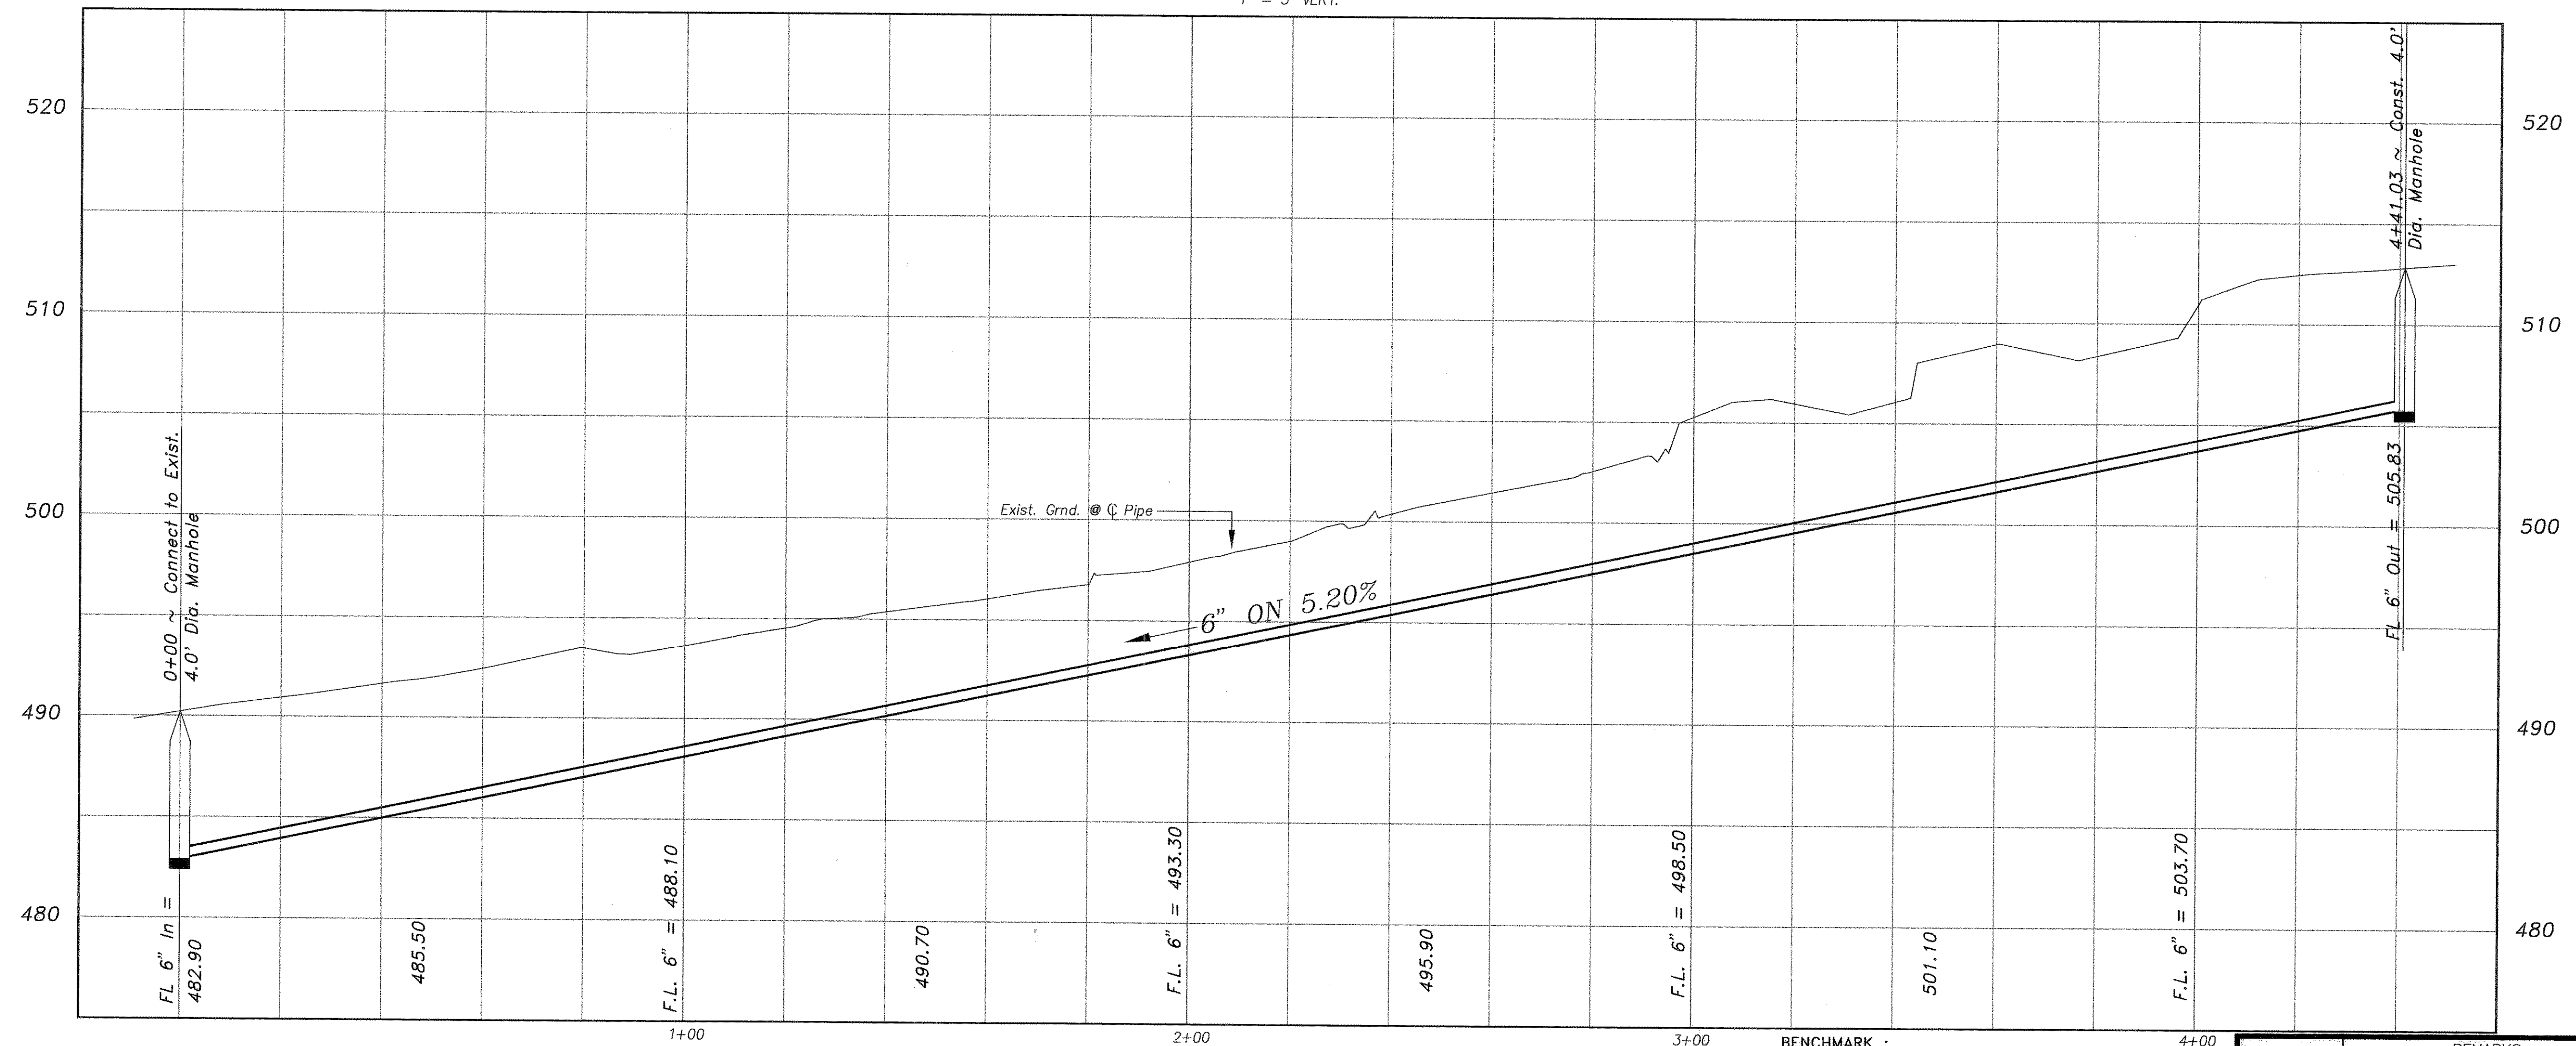

LEGEND

- Existing Gas Meter
- Telephone Pedestal
- Existing Water Valve
- Existing Guy Wire
- Existing Power Pole
- Existing Sani. Sewer M.H.
- Existing Water Meter
- Existing Fire Hydrant
- Street Sign

4
11

6" P.V.C. SANITARY SEWER
STATE HIGHWAY 66
ROCKWALL, TEXAS
CITY OF ROCKWALL
"THE NEW HORIZON"

BENCHMARK :
CITY OF ROCKWALL MONUMENT NO. 3
BRONZE DISK SET IN CONCRETE ON
THE SOUTH SIDE OF STATE HIGHWAY
NO. 66, WEST OF F.M. 1141 IN FRONT
OF J.W. WILLIAMS MIDDLE SCHOOL.
ELEV. = 529.29

REVISION NO.	REMARKS	DATE

DESIGNED: B.W.H.
DRAWN: ACAD
JOB NO. DATE: 2/11/95
SHEET NO. 1 of 1

