


NOTE:
ALL CONSTRUCTION TO CONFORM TO CITY OF ROCKWALL STANDARDS.

NOTE:
CONTRACTOR TO LOCATE & VERIFY LOCATION OF UNDERGROUND UTILITIES PRIOR TO INSTALLING STORM SEWER.

NOTE:
STORM SEWER PIPE TO BE CLASS III REINFORCED CONCRETE PIPE.

NOTE:
POWER POLES TO BE RELOCATED PRIOR TO STORM SEWER CONST.

NOTE:
INLETS ARE NOT STIPULATED IN DEPTH.

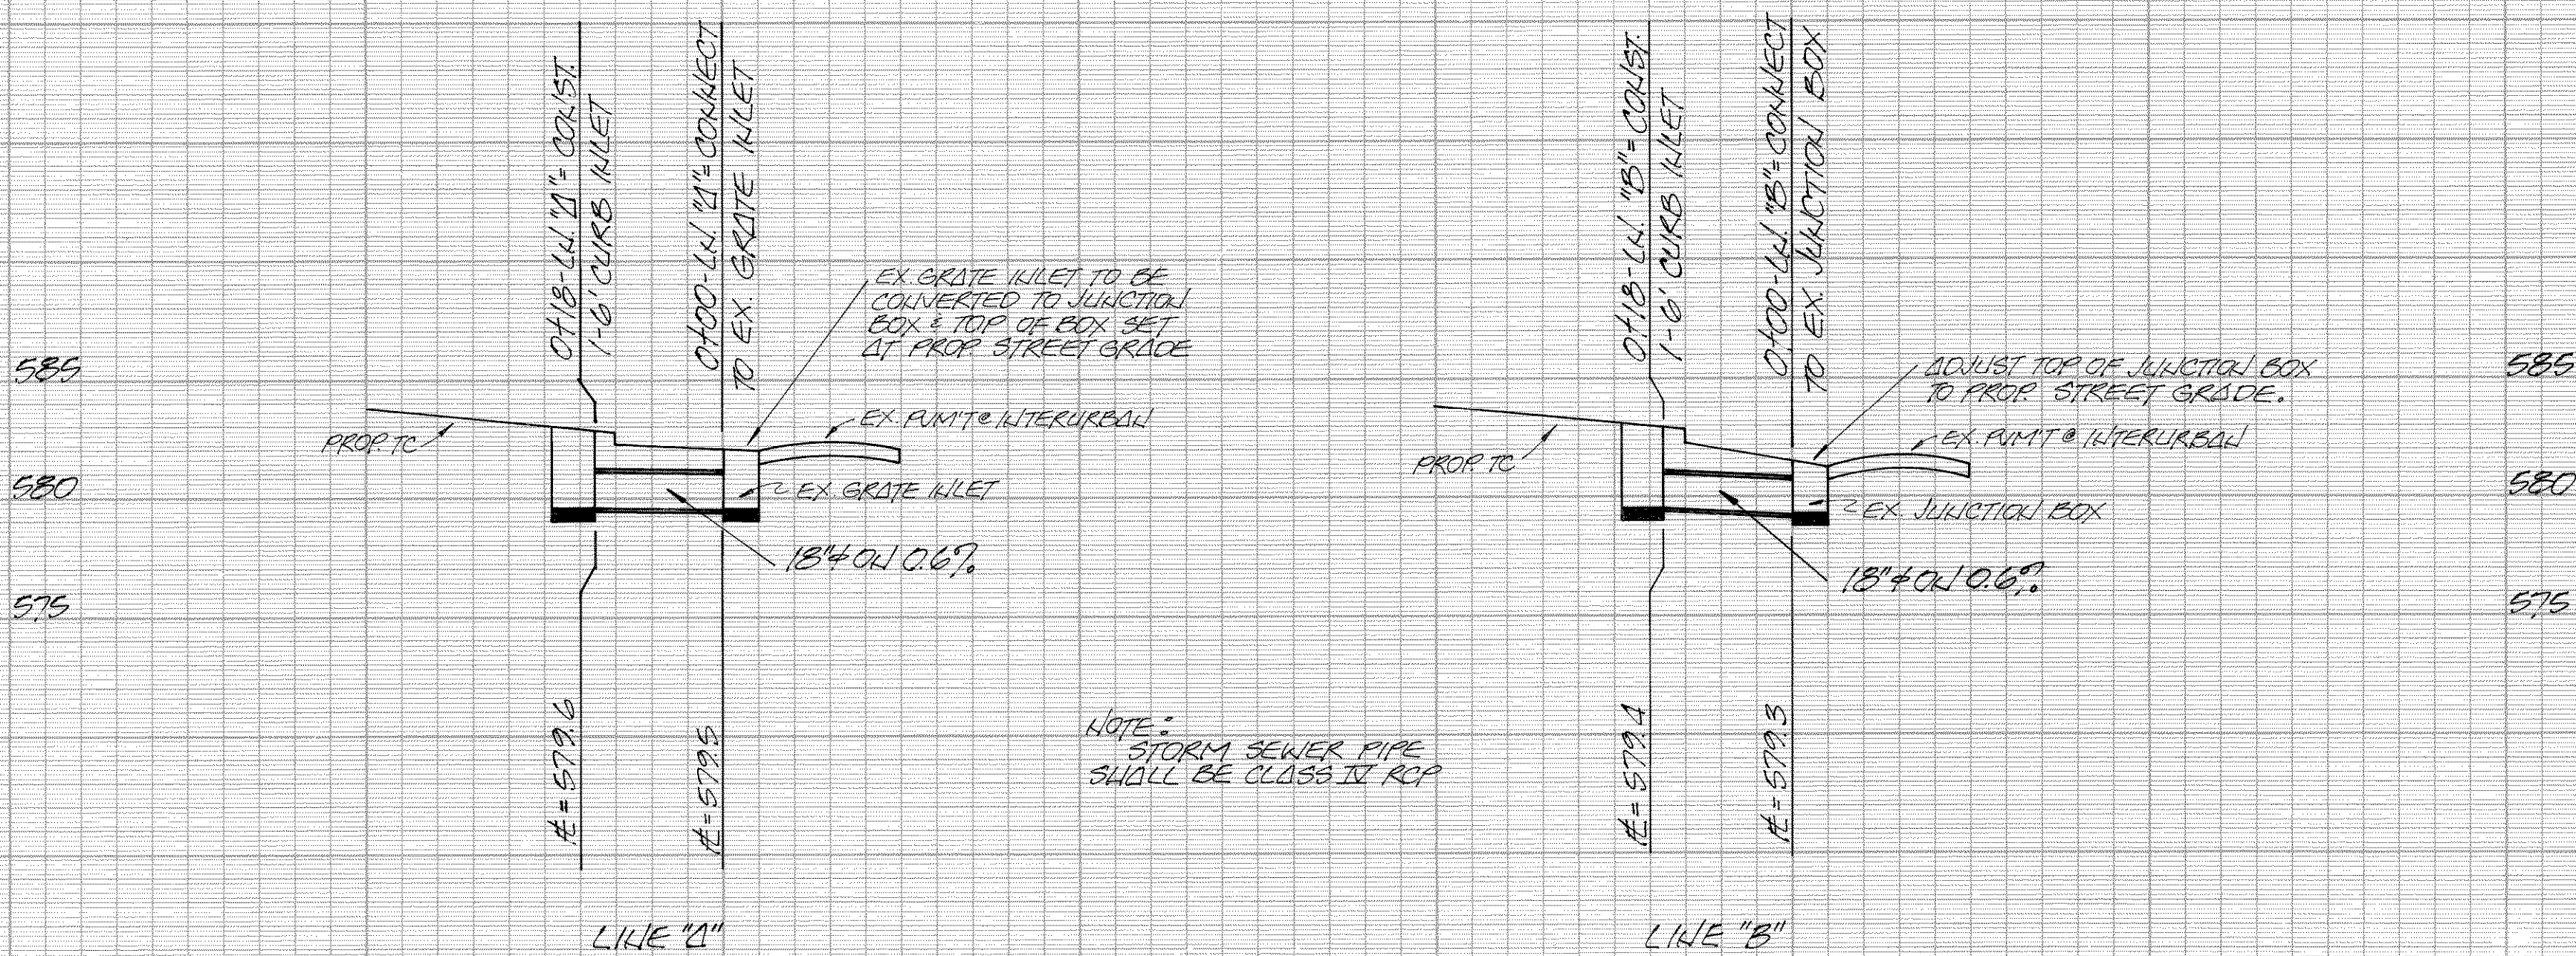

BEIICH MARK:
SET 1/4\"/>

SCALE: 1\"/>

REVISION NO.	REMARKS	DATE
DRAINAGE IMPROVEMENTS SAN JACINTO STREET		
CITY OF ROCKWALL, TEXAS 205 W. RUSK STREET 214-722-1111		
DESIGNED: W.L.D.	SCALE: NOTED	
DRAWN: W.L.D.	APPROVED: <i>W.L. Douphrate II</i>	
JOB NO. 87005	DATE: 3-87	
		SHEET NO. 47