

NOTE: DIVES SHALL BE CONSTRUCTED OF 6" 3000 P.S.I. CONCRETE REINFORCED W/ #3 BARS 24" O.C. BOTH WAYS

NOTE: ALL RACI ON DIVES WILL BE 5' EXCEPT AS NOTED ON PLANS

NOTE: ALL UNDERGROUND UTILITIES TO BE RELOCATED OR ADJUSTED TO NEW PAVEMENT OR PARKWAY GRADE PRIOR TO ANY PAVEMENT CONSTRUCTION

NOTE: SEE STORM SEWER DESIGN PLANS FOR DETAILS OF REMOVAL, REPLACING OR IMPROVING OF EXISTING DRAINAGE SYSTEMS

NOTE: POWER POLES & TELEPHONE BOXES TO BE RELOCATED BY OTHERS PRIOR TO CONSTRUCTION


NOTE: ALL CONSTRUCTION SHALL MEET CITY OF ROCKWALL SPECIFICATIONS

NOTE: STREET CONSTRUCTION - 6" 3000 P.S.I. CONCRETE W/ #3 BARS 24" O.C. EACH WAY ON 6" STABILIZED LIME SUBGRADE W/ A MIN. OF 7% LIME.

ALTERNATE - 6" H.M.A.C. (1" TYPE "B" & 2" TYPE "D") W/ 24" CURB & GUTTER (3000 P.S.I. CONCRETE - 6" HIGH CURB) ON 8" STABILIZED SUBGRADE W/ A MIN. OF 8% LIME.

- LEGEND**
- POWER POLE
 - TELEPHONE BOX
 - TELEPHONE M.H.
 - GAS METER
 - FIRE HYDRANT
 - WATER METER
 - WATER VALVE
 - SANIT. SEWER M.H.

NOTE: CONTRACTOR TO REPAIR BRICK SIDEWALK TO ITS ORIGINAL CONDITION OR BETTER

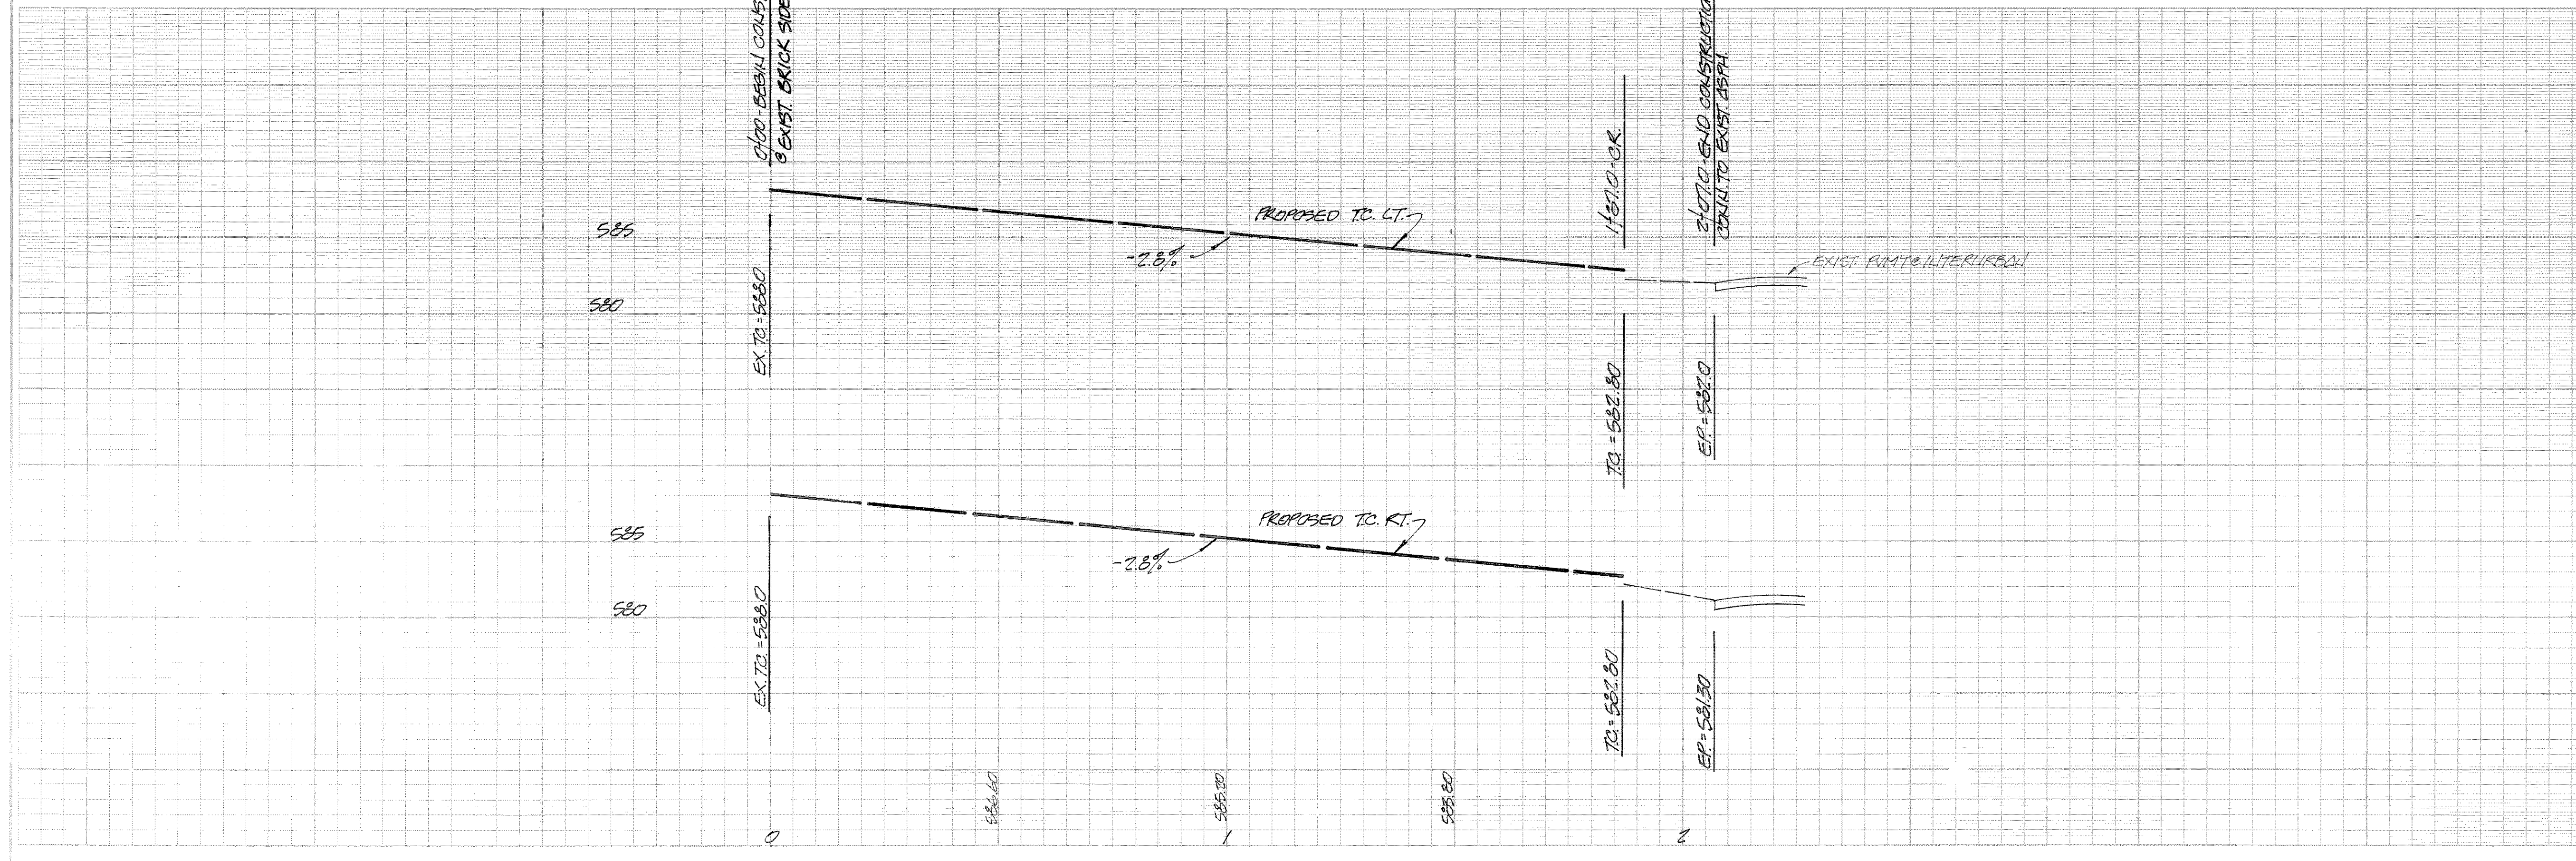

BENCH MARK:
SET 1/4" IN P.P. @ S.W. COR.
OF SAN JACINTO & INTERURBAN
ELEV. = 583.47

SCALE: 1" = 20' H,
1" = 5' V.

REVISION NO.	REMARKS	DATE
PAVING IMPROVEMENTS SAN JACINTO STREET		
CITY OF ROCKWALL, TEXAS 205 W. RUSK STREET 214-722-1111		
DESIGNED: W.L.D.	SCALE: NOTE	
DRAWN: W.L.D.	APPROVED: W.L. Doughton	
JOB NO. 87005	DATE 3-87	SHEET NO. 25