
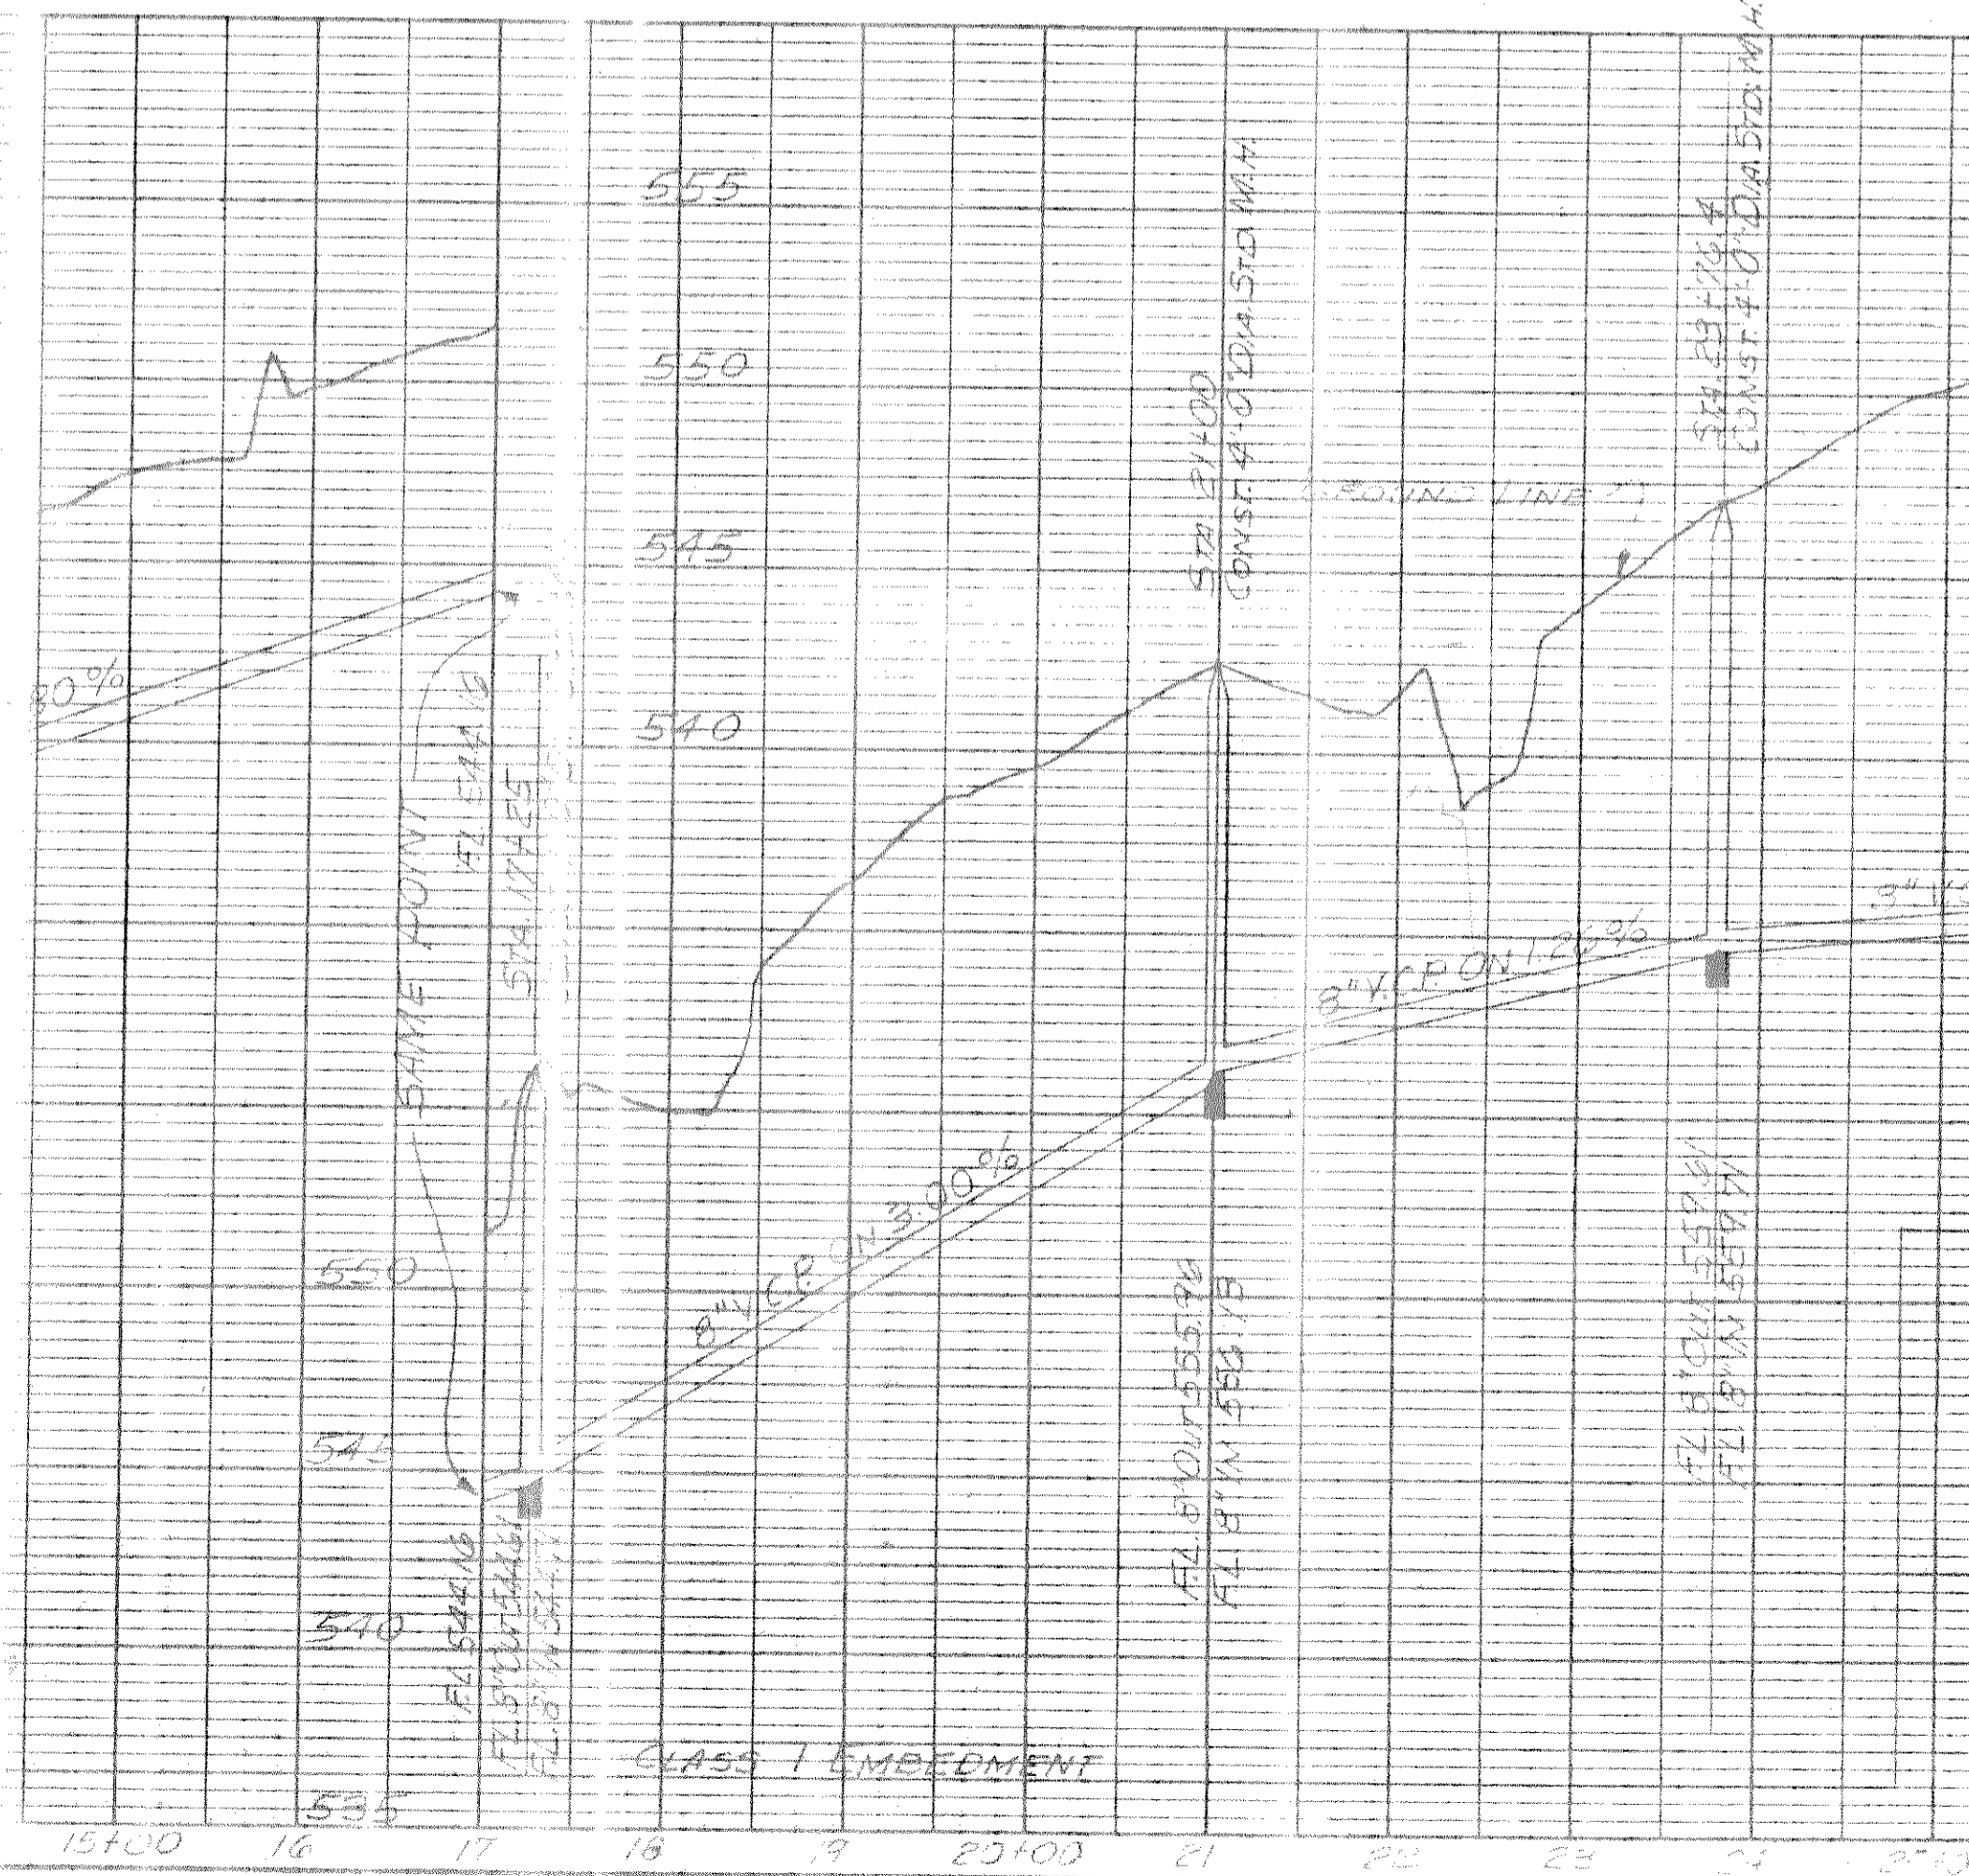


E.M. UNVEILED J. N.E. COR.
 1/4" DIA. MANHOLE CONVERT. TO RT. 21+40
 ELEV. 554.25

6" M. TOP OF 3/4" BOLT SW. COR. RP
 SIGNAL LIGHT BASE ON EAST SIDE
 TERRELL RD. ELEV. 557.15

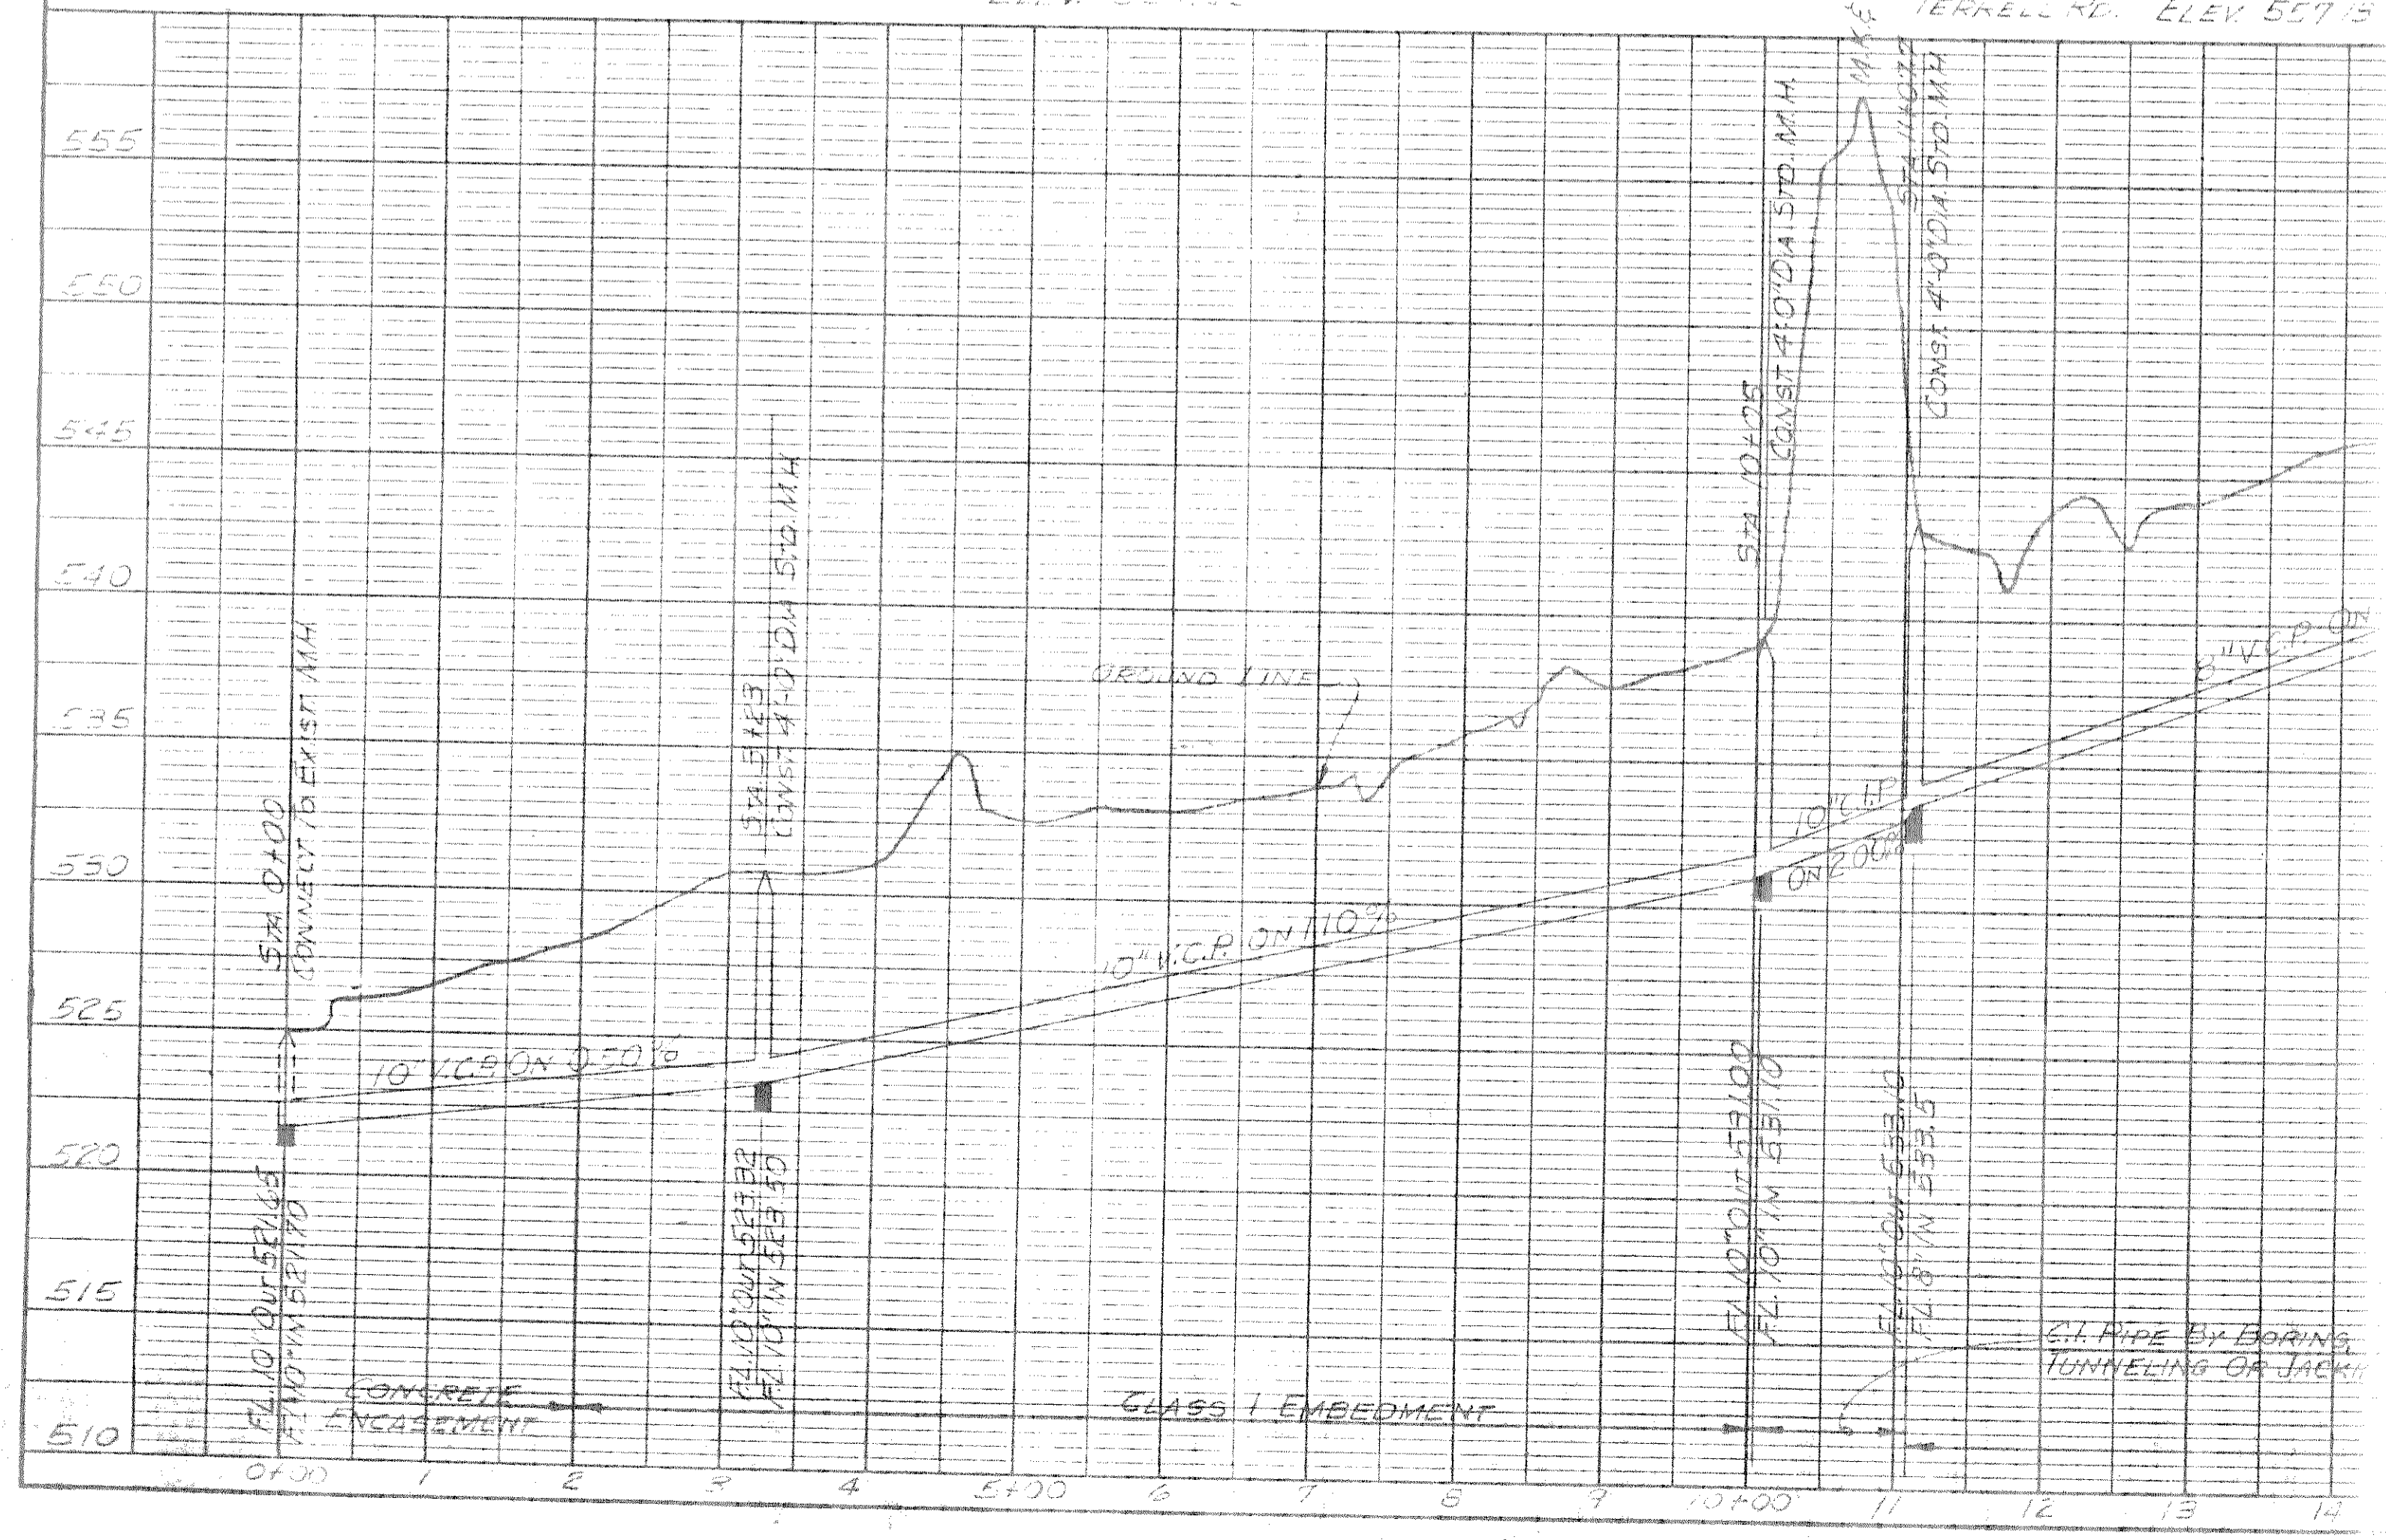

FORREST AND COTTON, INC.
 CONSULTING ENGINEERS
 DALLAS, TEXAS
 OCTOBER 1954

CITY OF ROCKWALL, TEXAS	
ADDITIONS TO WATER DISTRIBUTION AND SANITARY SEWER SYSTEMS	
SANITARY SEWER LINE TO NEW HIGH SCHOOL	
PLAN - PROFILE	STA. 0+00 TO STA. 21+00
FORREST AND COTTON, INC.	DALLAS, TEXAS
CONSULTING ENGINEERS	OCTOBER 1954
FILE NO.	DESIGNED BY: C.C.
515-14-02	DRAWN BY: B.J.
	CHECKED BY: R.L.J.