


SHADY DALE LANE

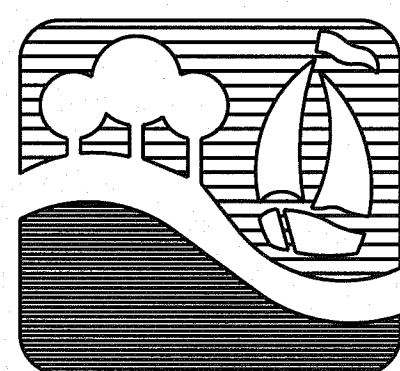


CITY OF ROCKWALL

"THE NEW HORIZON"

SEPTEMBER 2009

BILL CECIL * MAYOR
 DAVID SWEET
 MARK RUSSO
 GLEN FARRIS
 CLIFF SEVIER - MAYOR PRO-TEM
 MATT SCOTT
 MARGO NIELSEN
 CITY COUNCIL
 JULIE COUCH
 CITY MANAGER
 CHUCK TODD, P.E.
 DIRECTOR OF PUBLIC WORKS

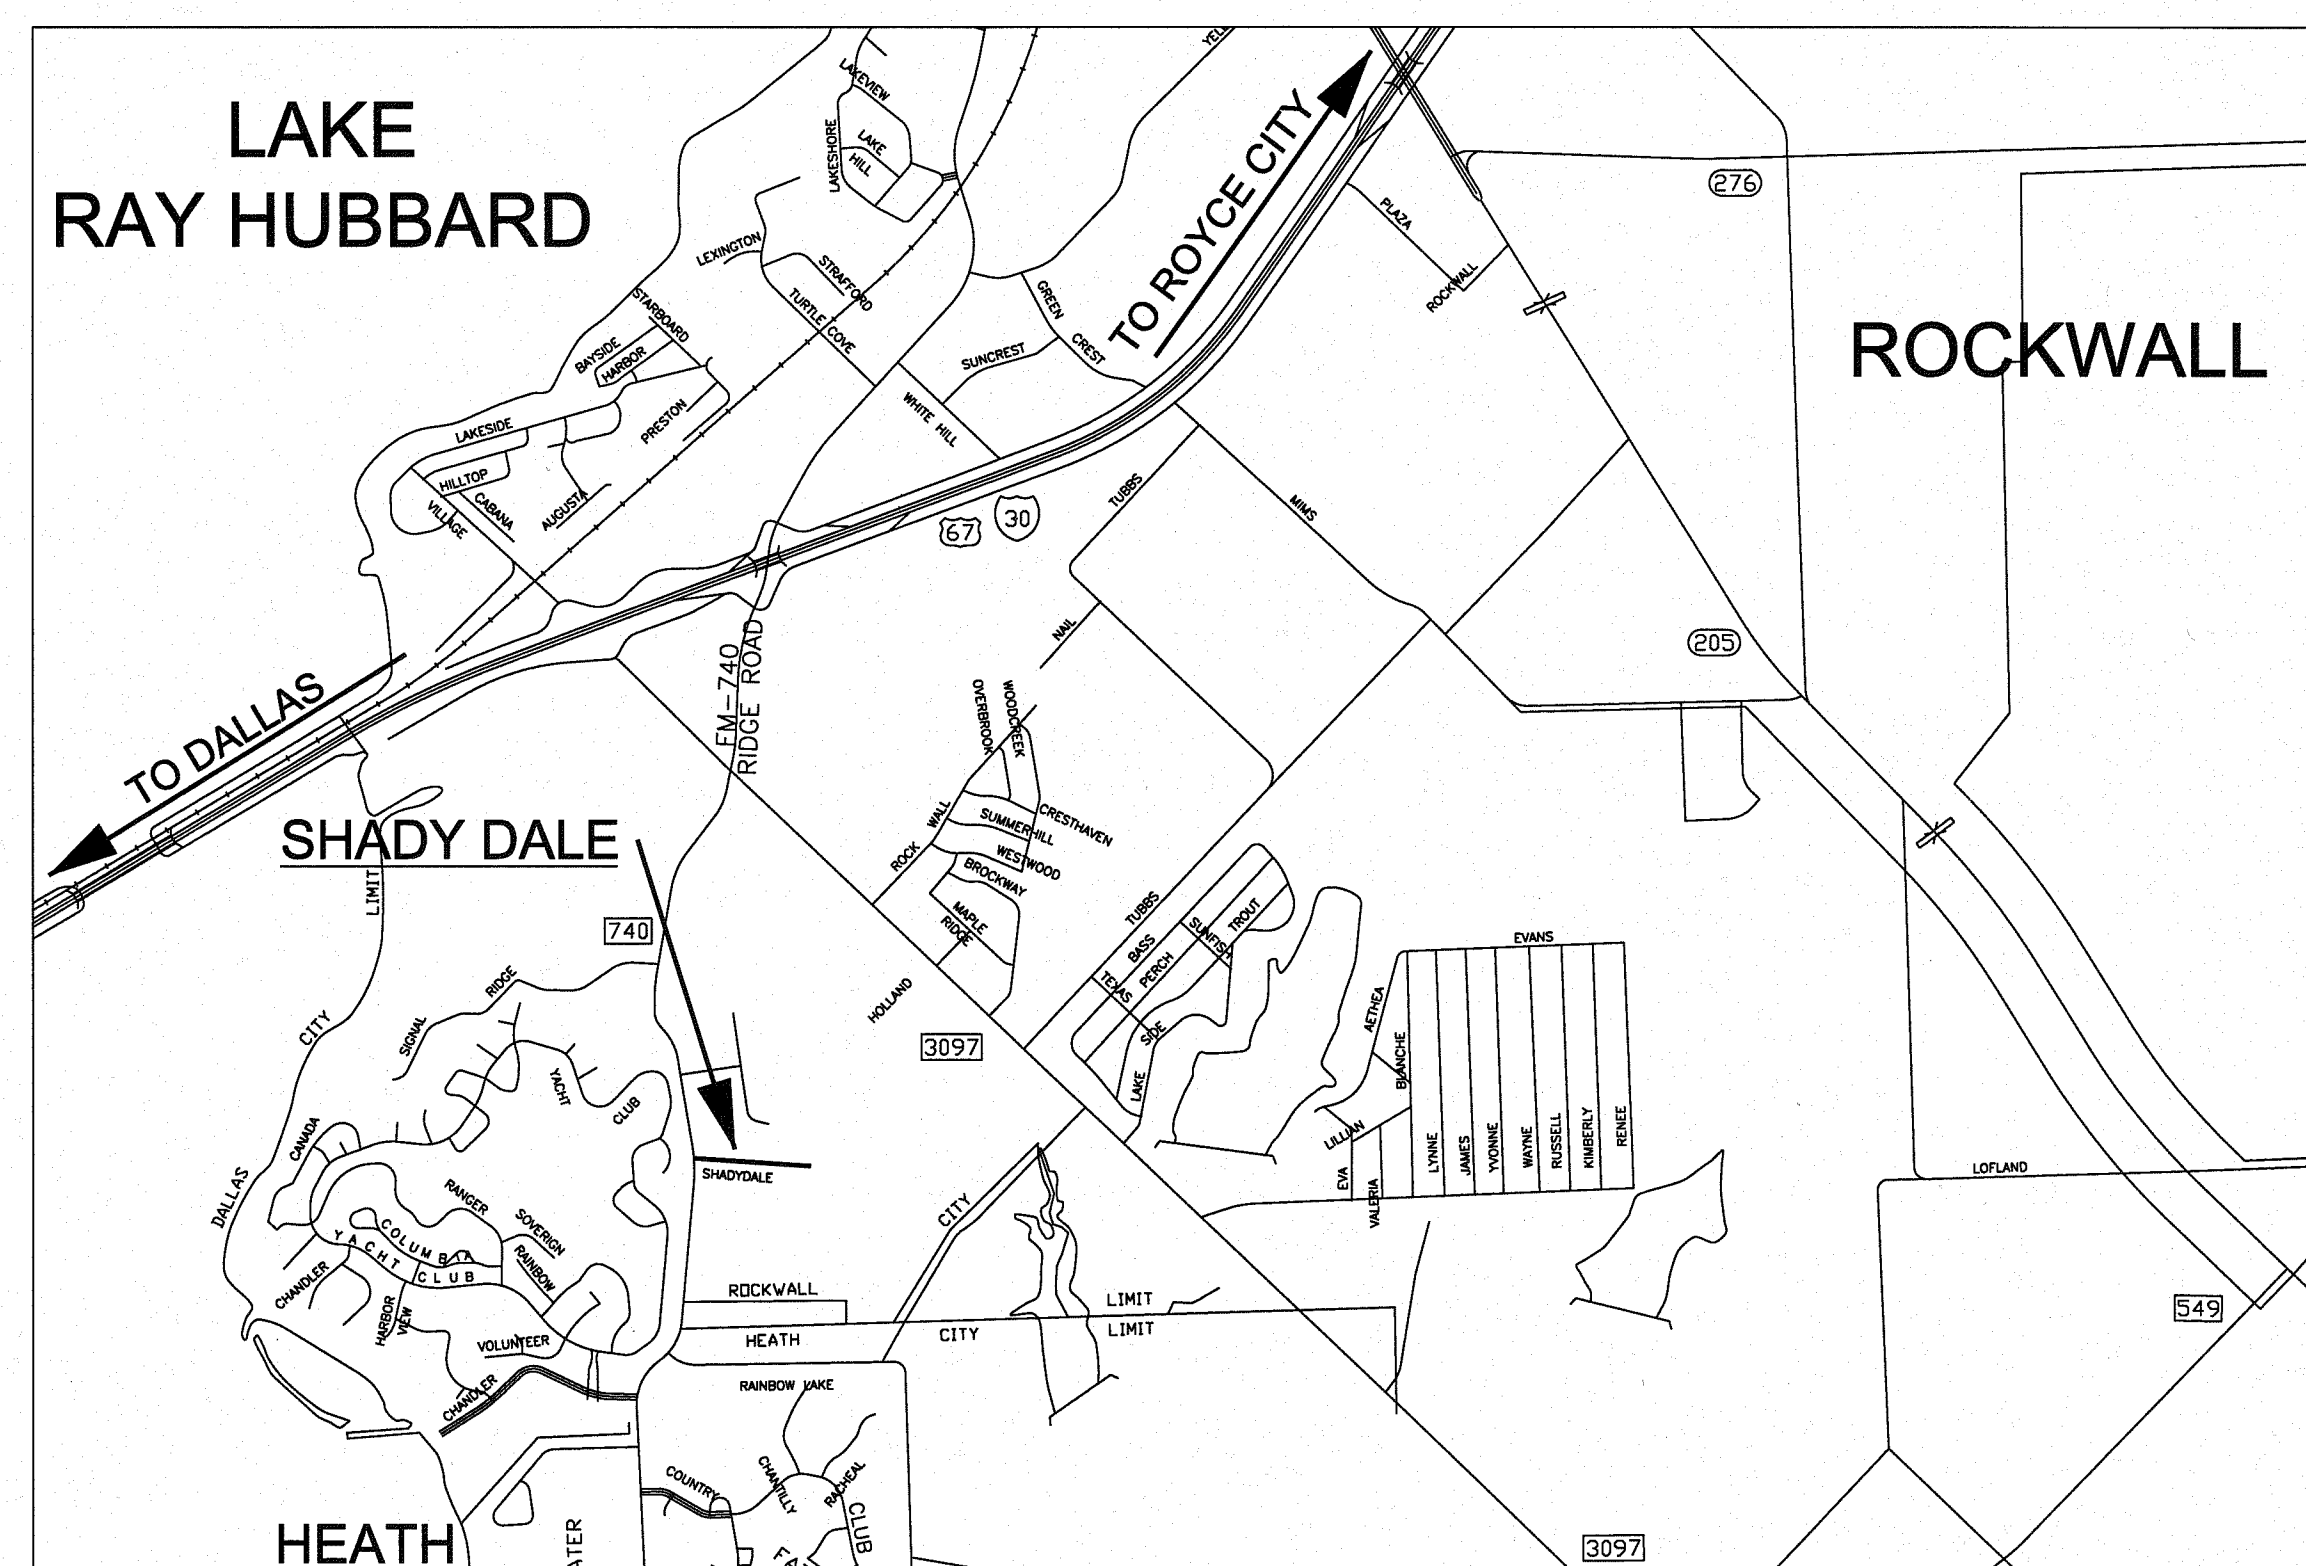

VICINITY MAP
 N.T.S.

SHEET INDEX

SHEET NO.	DESCRIPTION
GN-1	COVER SHEET
GN-2	GENERAL NOTES
GN-3	QUANTITY SUMMARY SHEET
GN-4	TYPICAL SECTIONS
SD-P1	SHADY DALE PAVING P&P STA 1+00 TO 6+00
SD-P2	SHADY DALE PAVING P&P STA 6+00 TO 11+00
SD-P3	SHADY DALE PAVING P&P STA 11+00 TO END
SD-D 1	SHADY DALE DRAINAGE AREA MAP & CALCULATIONS
SD-A 1	SHADY DALE STORM DRAIN P&P STA 0+00 TO 5+00
SD-A 2	SHADY DALE STORM DRAIN P&P STA 5+00 TO END
SD-W1	SHADY DALE WATERLINE STA 0+00 TO 5+00
SD-W2	SHADY DALE WATERLINE STA 5+00 TO 10+00
SD-W3	SHADY DALE WATERLINE STA 10+00 TO END
SD-EC1	SHADY DALE EROSION CONTROL
SD-XS1-XS5	SHADY DALE CROSS SECTIONS
EC-1	EROSION CONTROL NARRATIVE

RECORD DRAWING

THE SEAL THAT ORIGINALLY APPEARED ON THIS DOCUMENT WAS AUTHORIZED BY TED B. SUGG, TEXAS NO 82775 ON 10-1-09

THESE RECORD DRAWINGS WERE PREPARED BASED UPON AS CONSTRUCTED DRAWINGS PROVIDED BY THE CONTRACTOR WHO REPRESENTED THAT ALL FIELD CHANGES AND DEVIATIONS FROM THE APPROVED CONSTRUCTION DRAWINGS WERE INCLUDED ON APRIL 18, 2011.



TBPE REG. #F-474

18383 PRESTON ROAD, SUITE 110
 DALLAS, TEXAS 75252
 972-818-7275