


RECORD DRAWING
 THE SEAL THAT ORIGINALLY APPEARED ON THIS DRAWING IS HEREBY REVOKED.
 THESE RECORD DRAWINGS WERE PREPARED BY THE CONTRACTOR WHO PROVIDED ALL FIELD CHANGES AND DEVIATIONS FROM THE APPROVED RECORD DRAWINGS. DRAWINGS WERE INCLUDED ON APRIL 18, 2011.



CITY OF ROCKWALL
 SHADY DALE LANE
 SHADY DALE LANE
 CROSS SECTIONS

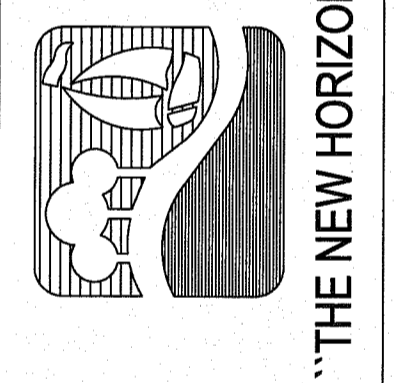

| NO. | REVISION | BY | DATE |
|-----|--------------------------|-----|---------|
| 1 | REVISED DRIVE @ STA 4-50 | TBS | 5/13/10 |

| | |
|-------------------|-----------------|
| DESIGN: CRH / TBS | CHECKED: PBS&J |
| DRAWN: CRH / TBS | APPROVED: PBS&J |

| | |
|---|----------------------|
| TYPE REG. #F-474 | DATE: SEPTEMBER 2009 |
| 18383 PRESTON ROAD SUITE 110 DALLAS, TEXAS 75262 972-818-7275 | FILE: #FILESS |
| PBS&J JOB NO.: 52091000 | |

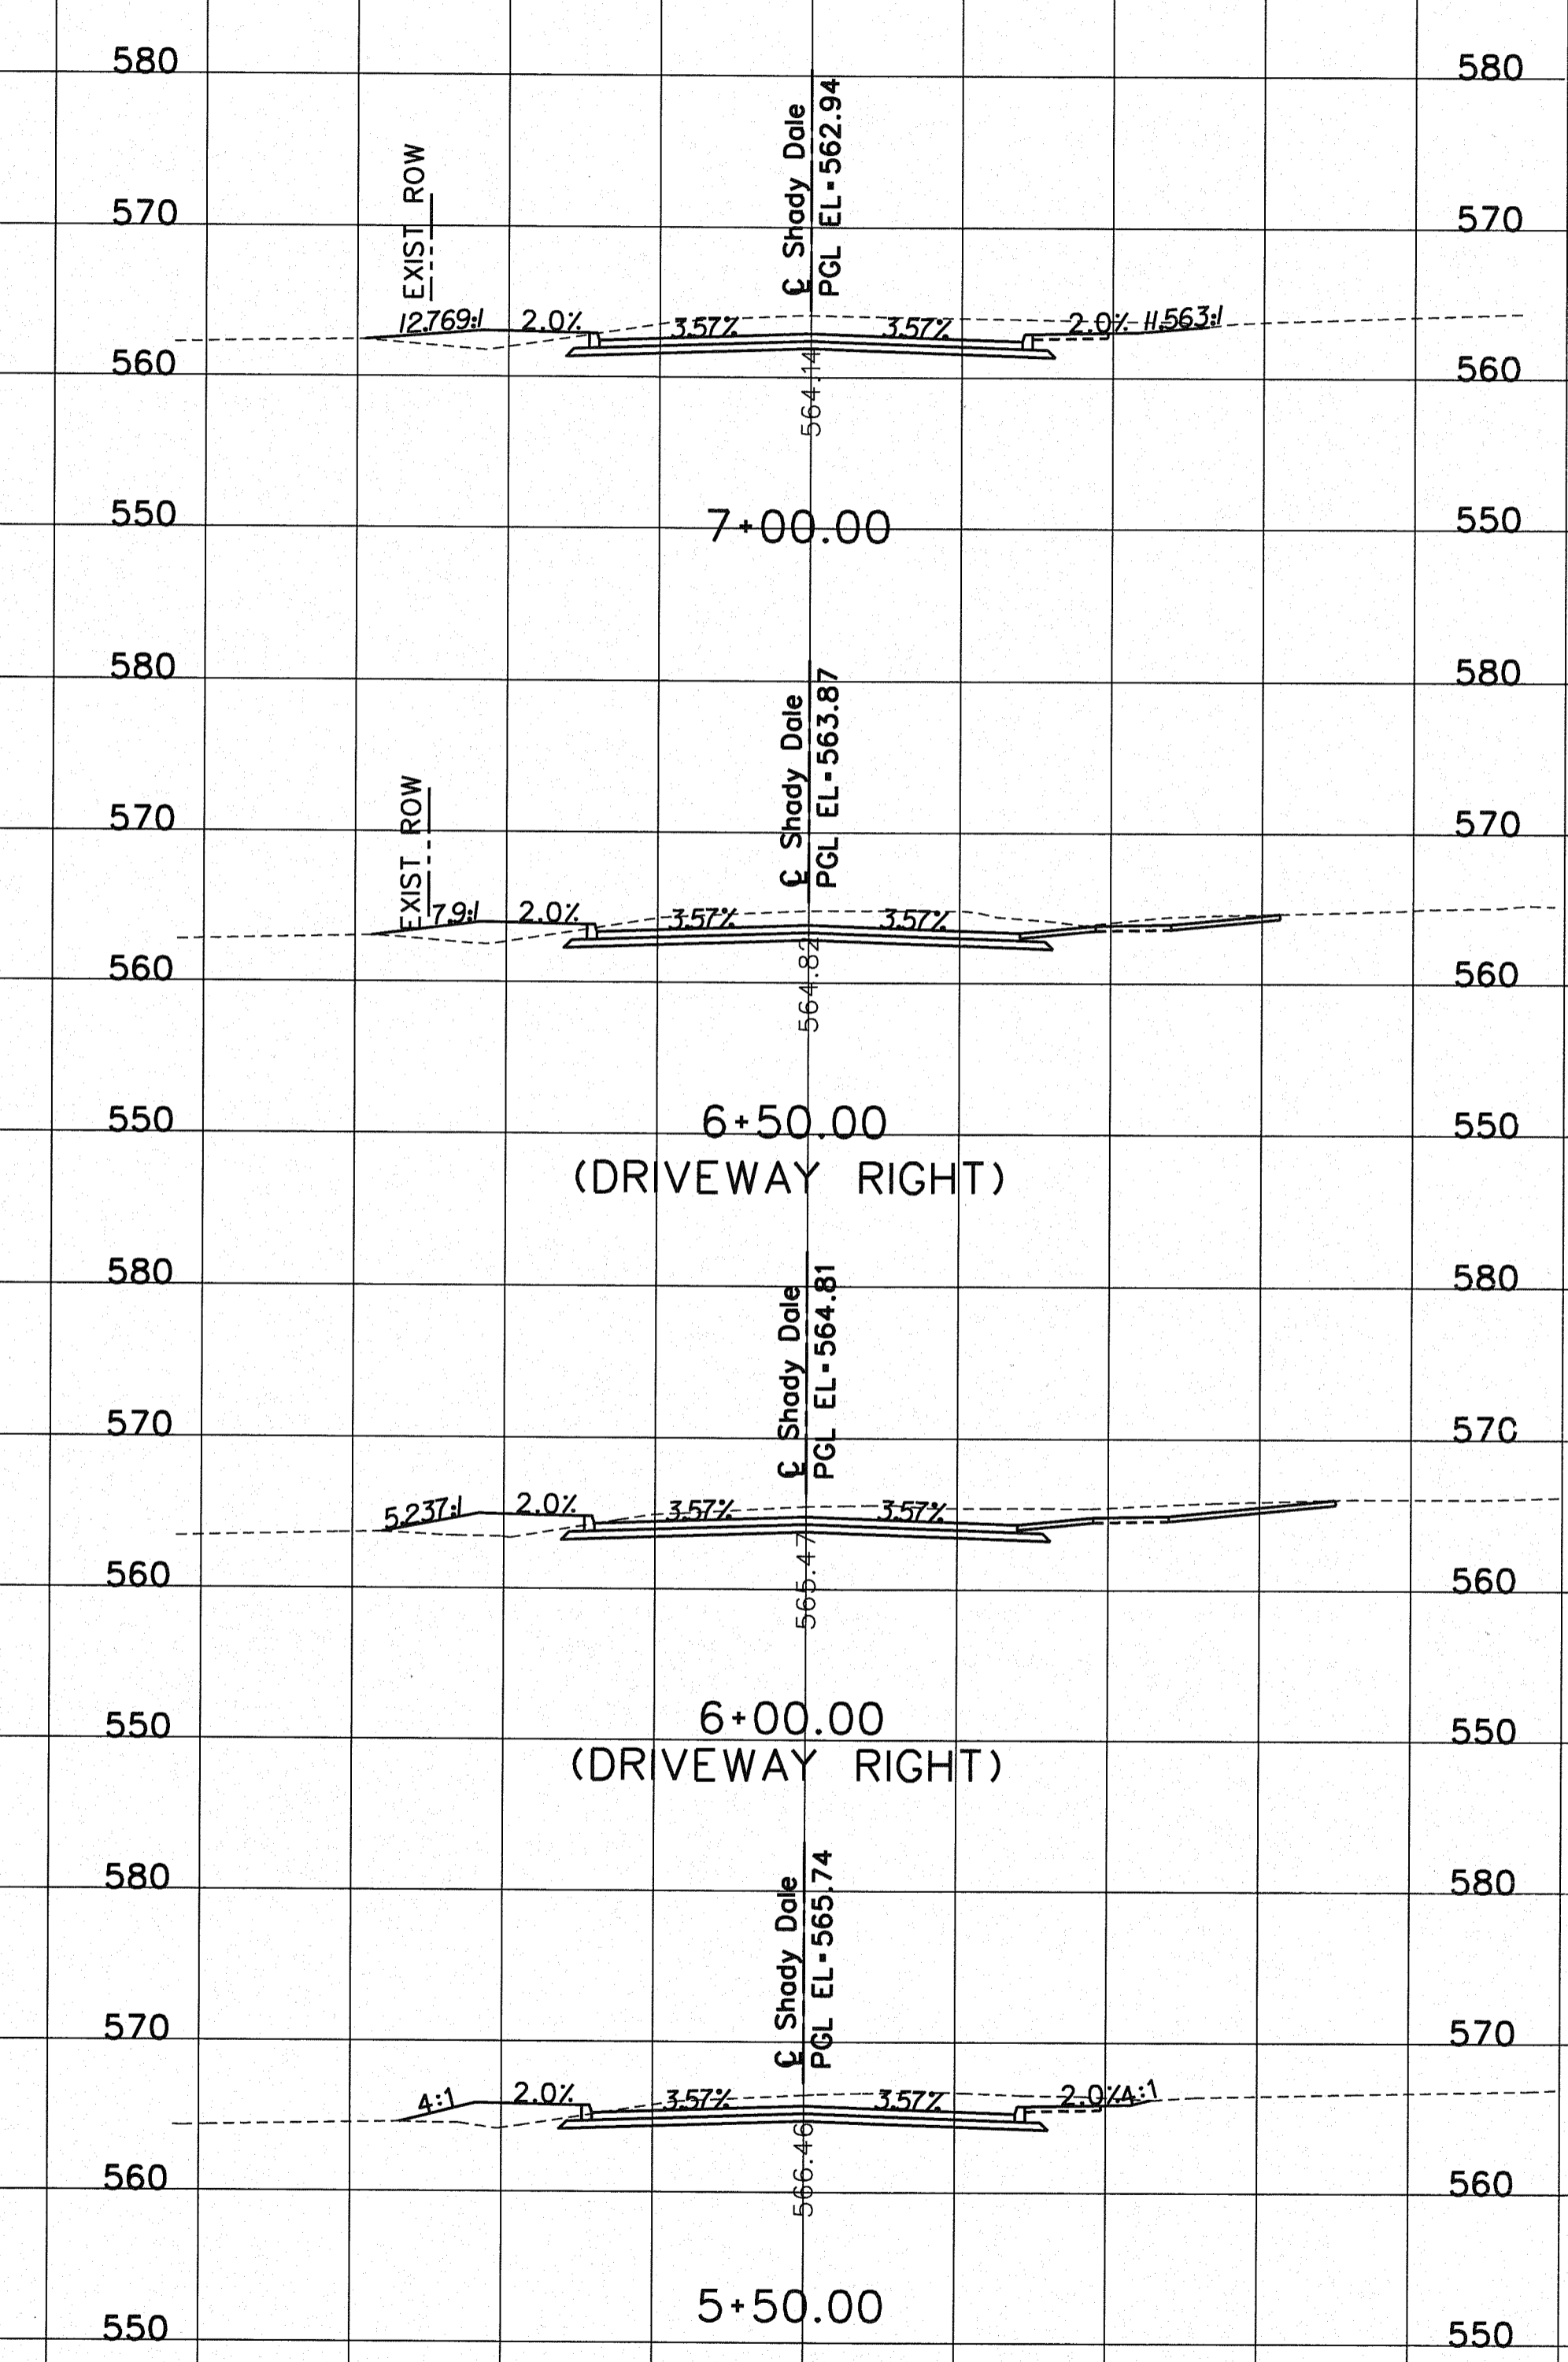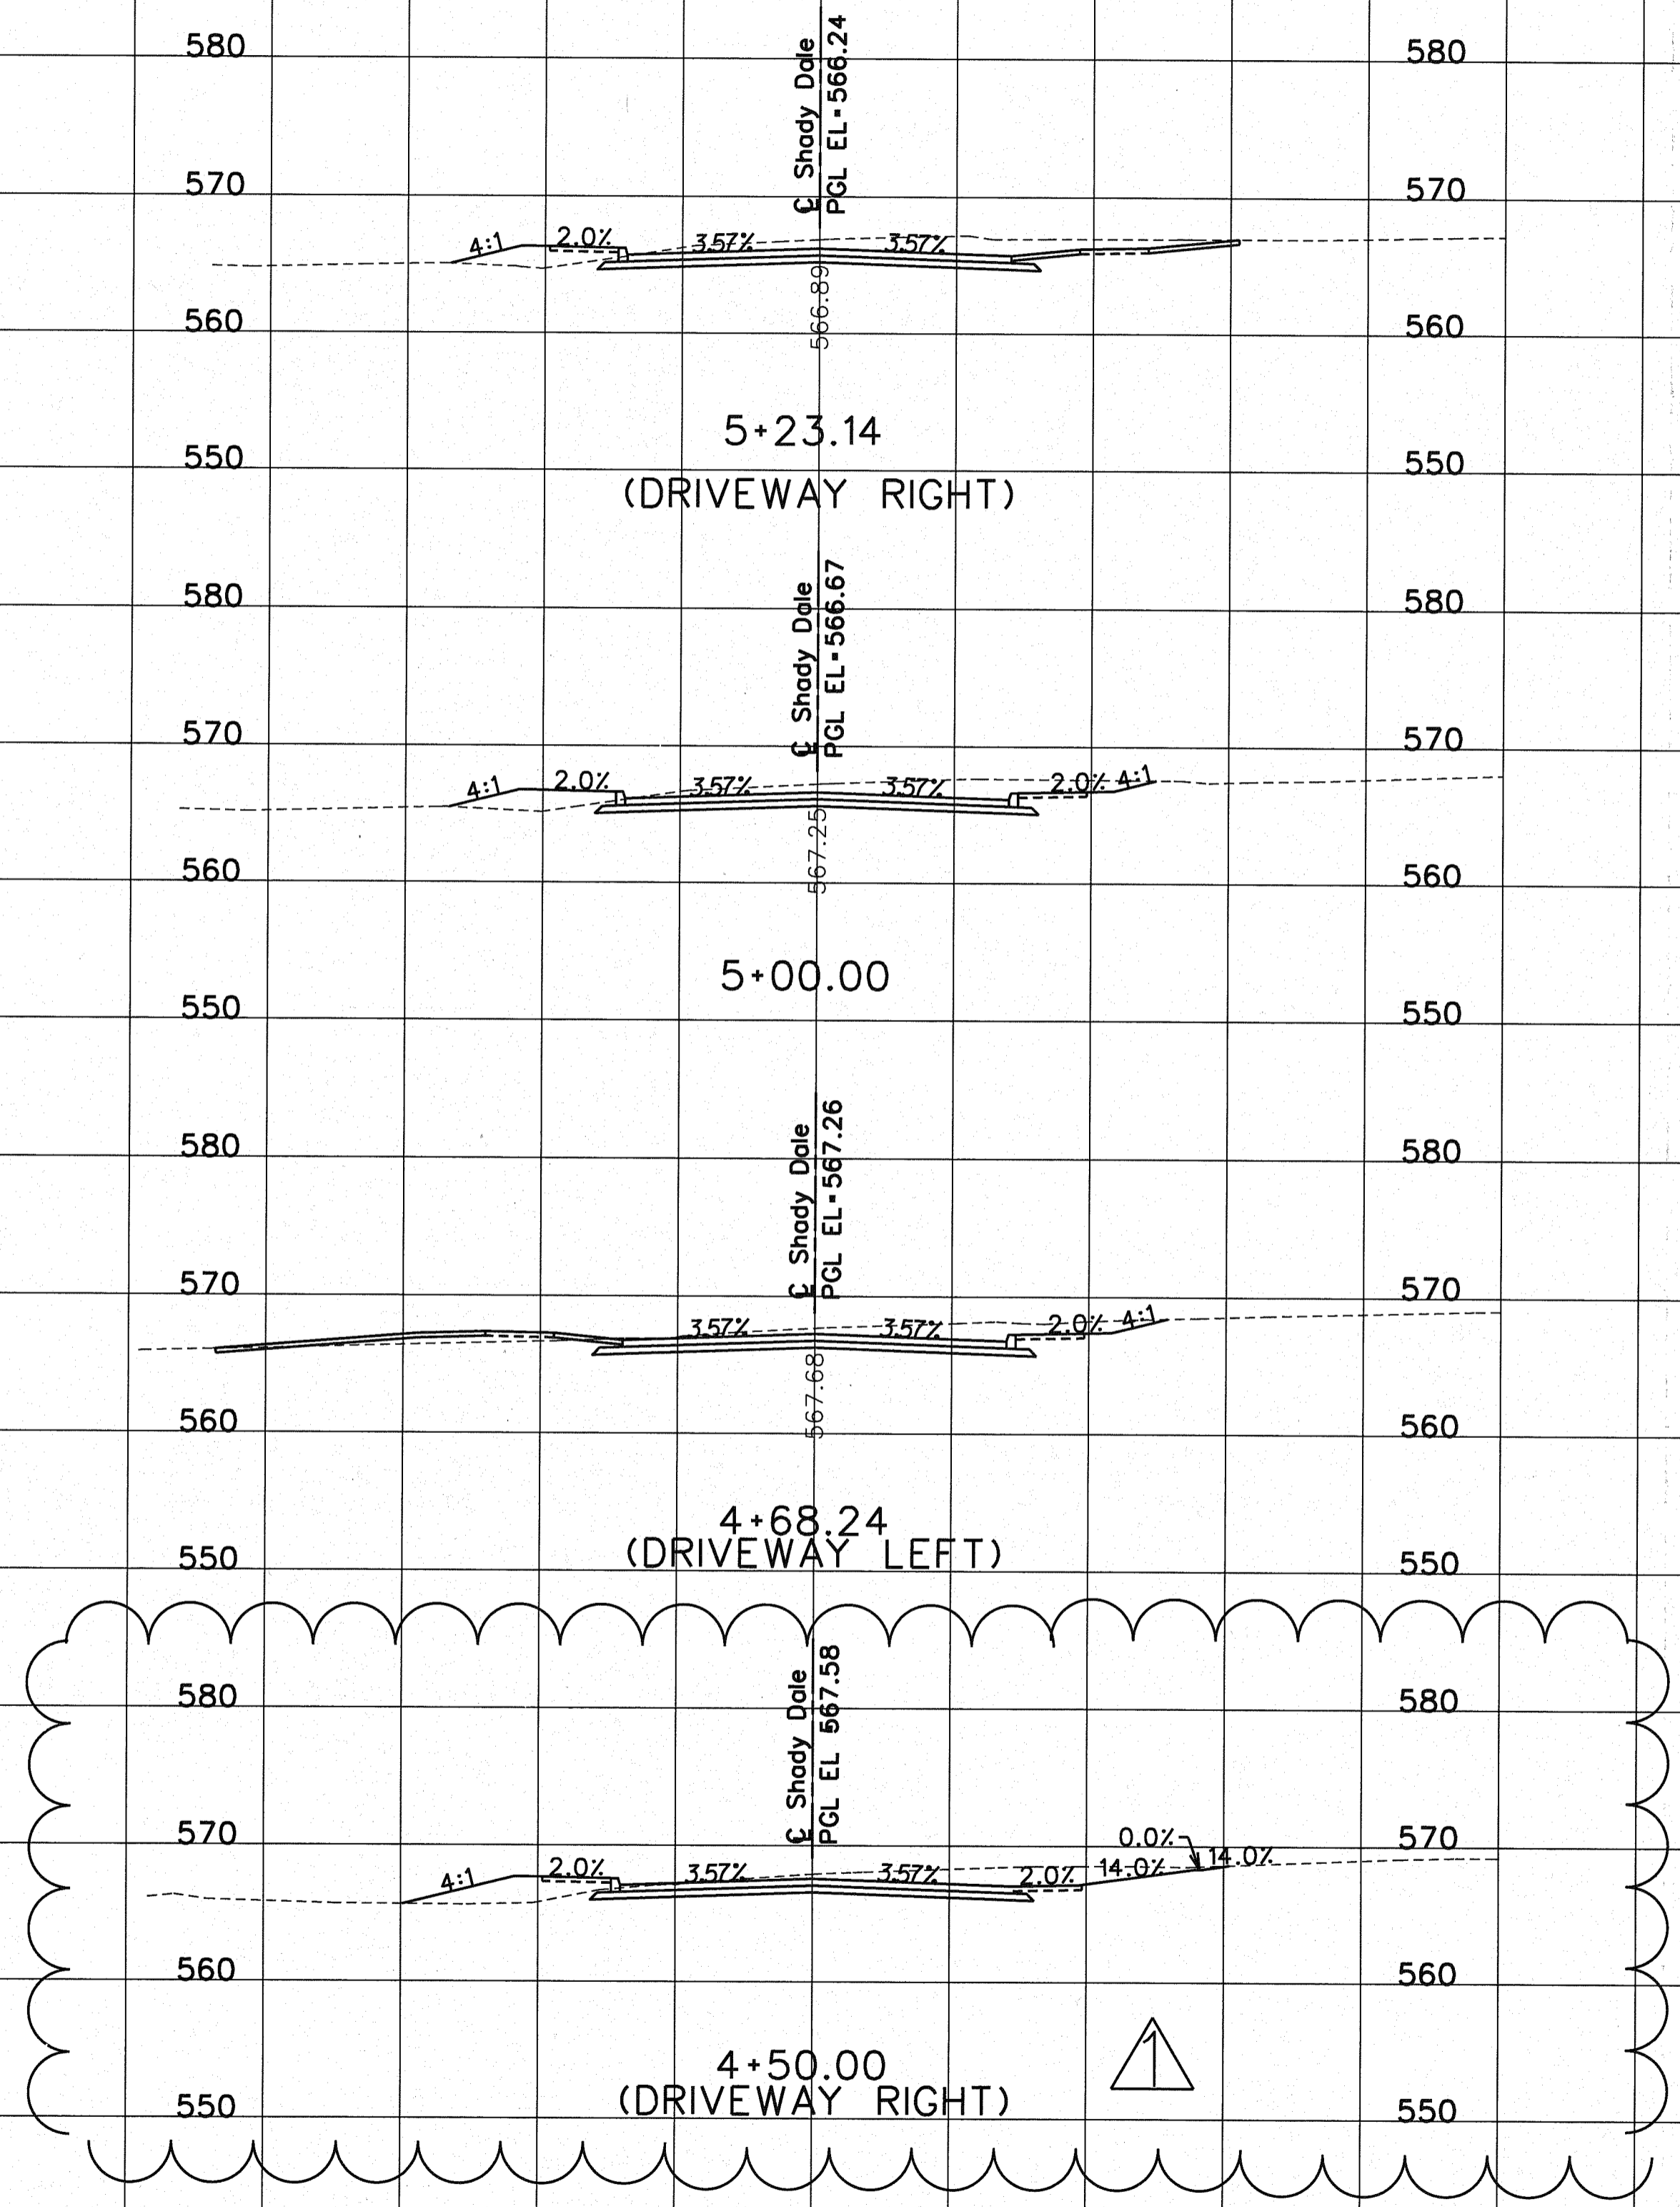

5 TIMES
 \$\$\$\$\$\$SYTIME\$\$\$\$\$\$
 \$\$\$\$\$\$DGN\$PC\$\$\$\$\$\$