




3 TIMES
 \$\$\$\$\$\$SYTIME\$\$\$\$\$\$
 \$\$\$\$\$\$SYTIME\$\$\$\$\$\$
 \$\$\$\$\$\$SYTIME\$\$\$\$\$\$

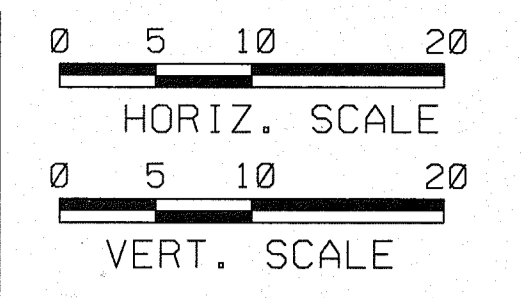

RECORD DRAWING
 THE SEAL THAT ORIGINALLY APPEARED ON THIS DRAWING IS HEREBY REVOKED.
 THESE RECORD DRAWINGS WERE PREPARED BY THE CONTRACTOR WHO HAS REPRESENTED THAT ALL FIELD CHANGES AND DEVIATIONS FROM THE APPROVED RECORD DRAWINGS WERE INCLUDED ON APRIL 18, 2011.

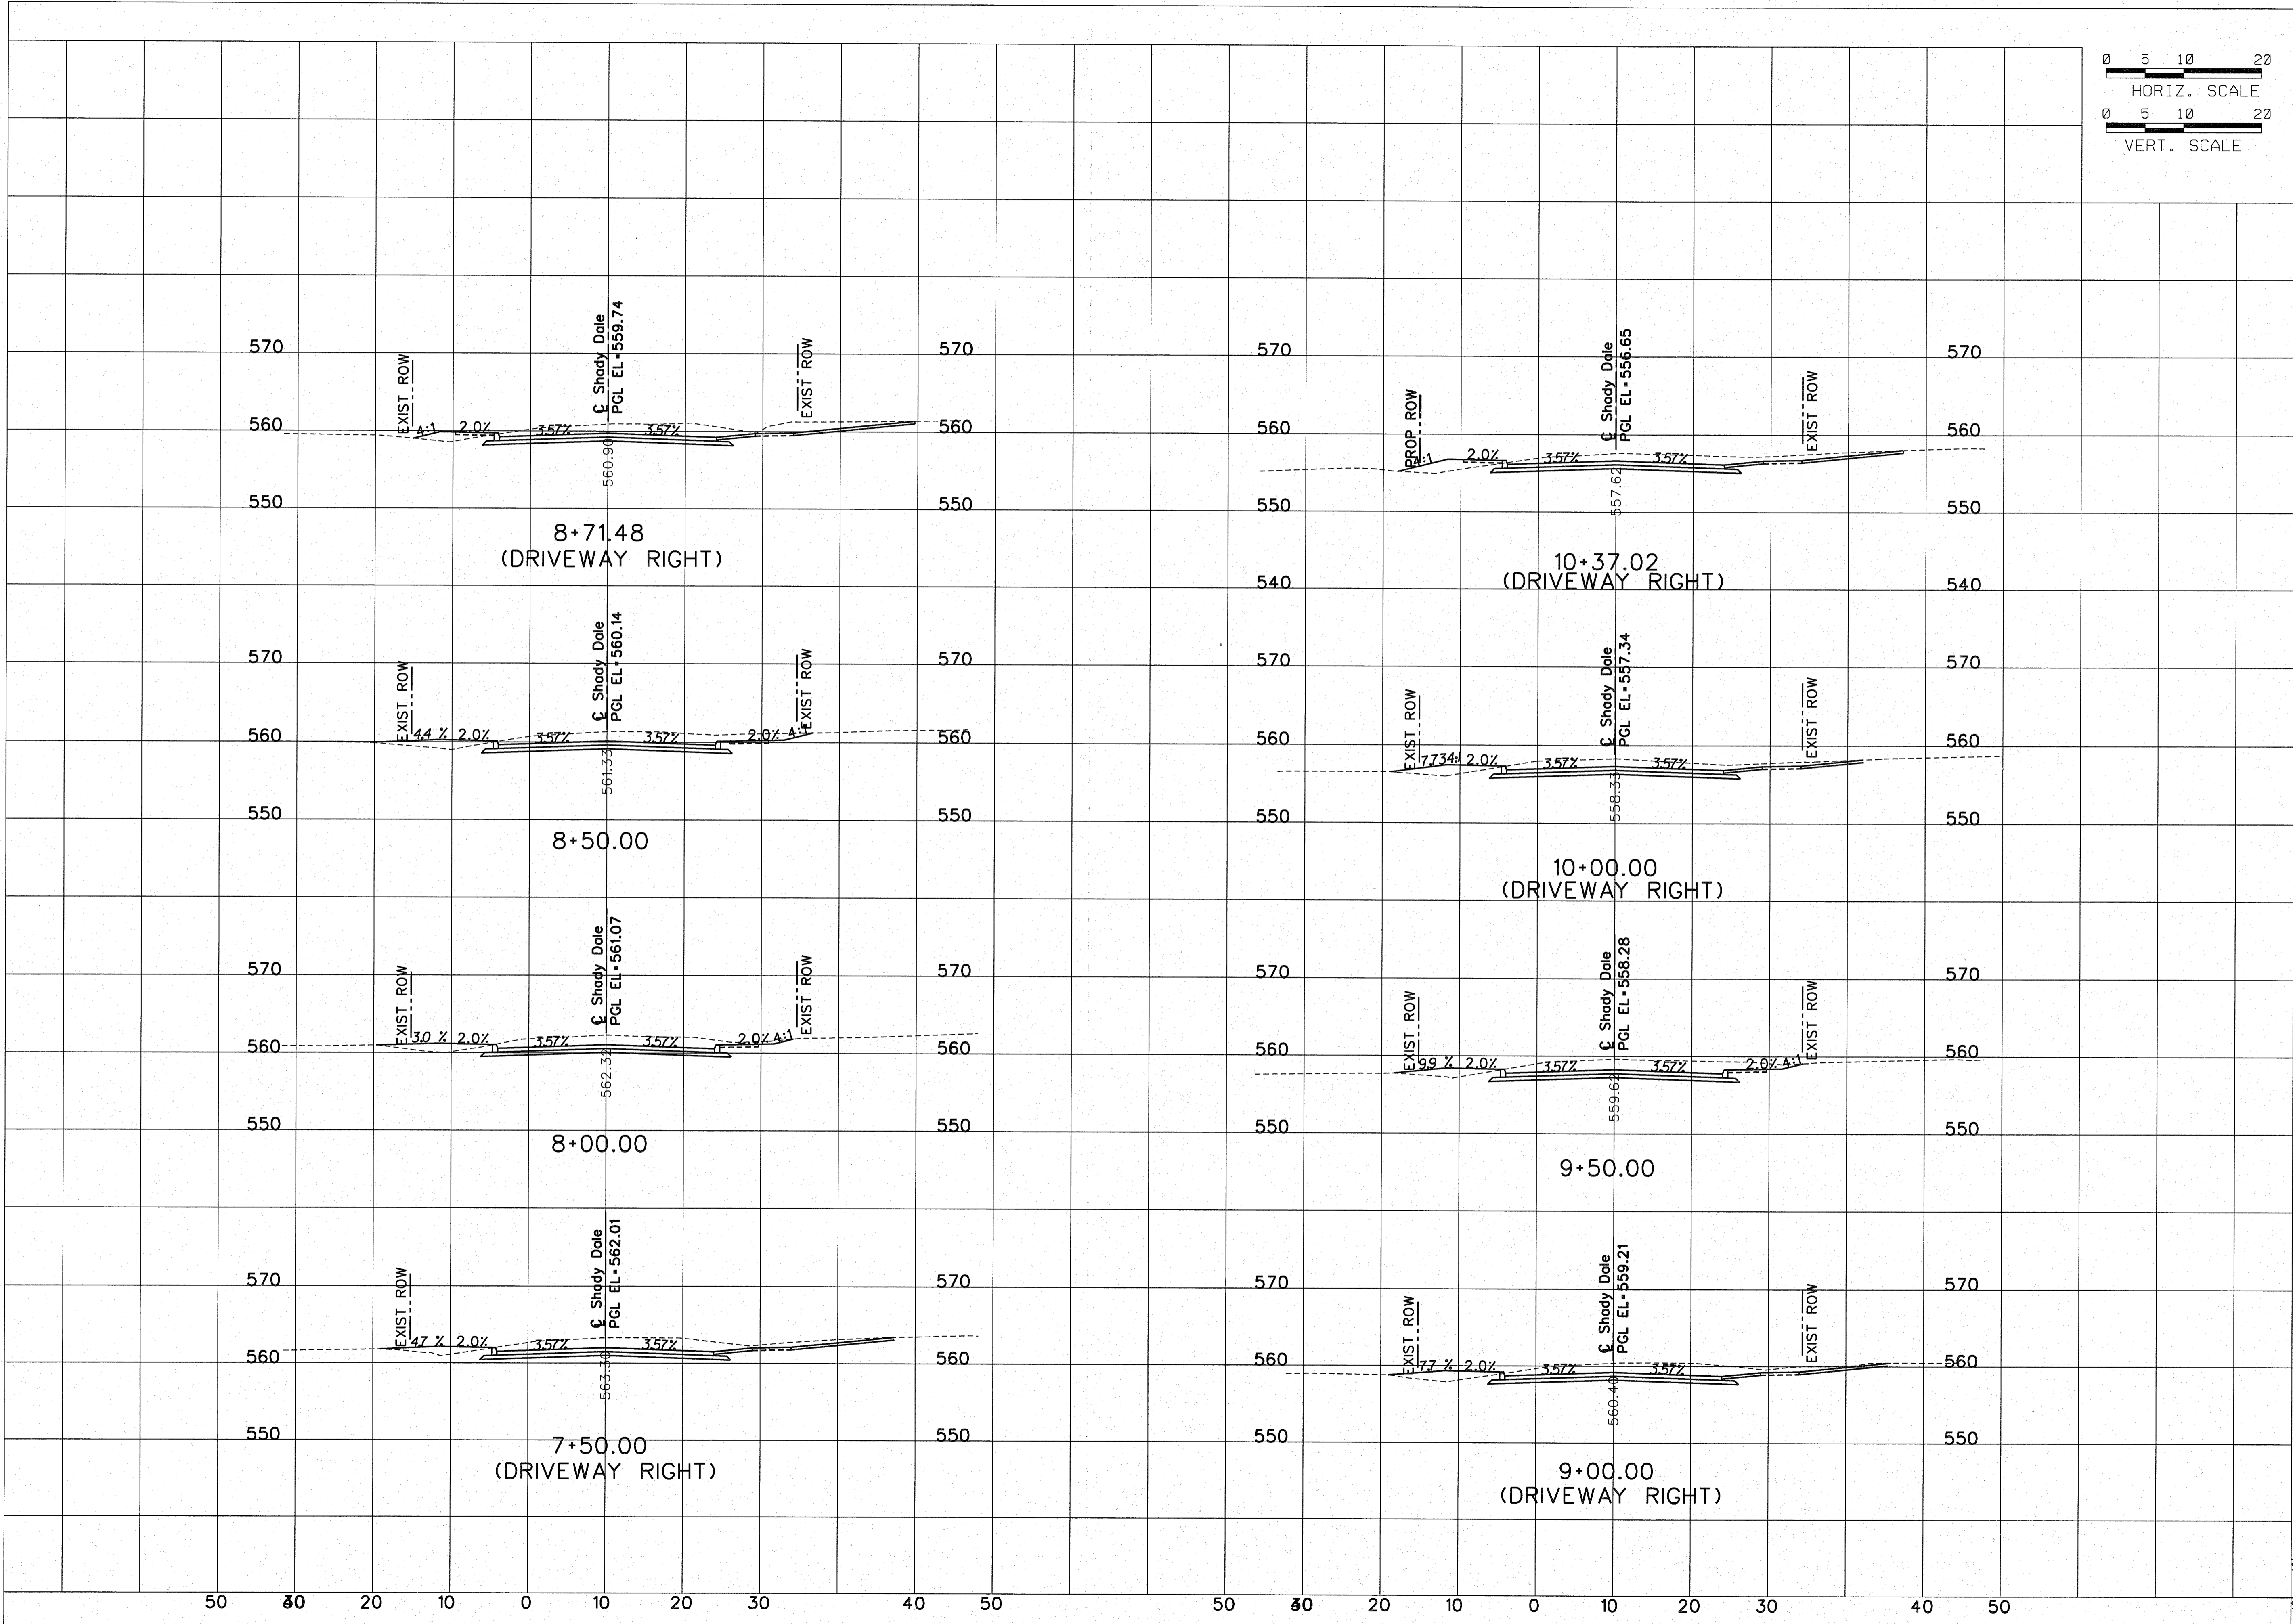

CITY OF ROCKWALL
 SHADY DALE LANE
 SHADY DALE LANE
 CROSS SECTIONS

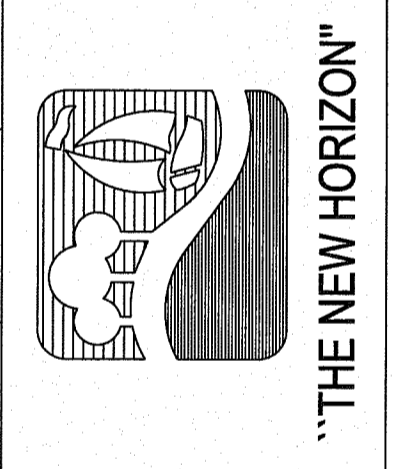

DATE	
BY	
REVISION	
NO.	
DESIGN: CRH / TBS	CHECKED: PBS&J
DRAWN: CRH / TBS	APPROVED: PBS&J
TYPE REG. # 474	
18383 PRESTON ROAD, SUITE 110 DALLAS, TEXAS 75232 972-388-7275	
PBS&J JOB NO.: 52091000	
DATE: SEPTEMBER 2009	
FILE: \$FILES\$	