


STIMES
 \$\$\$\$\$SYTIME\$\$\$\$\$\$
 \$\$\$\$\$\$\$\$\$\$\$\$\$\$\$\$\$\$

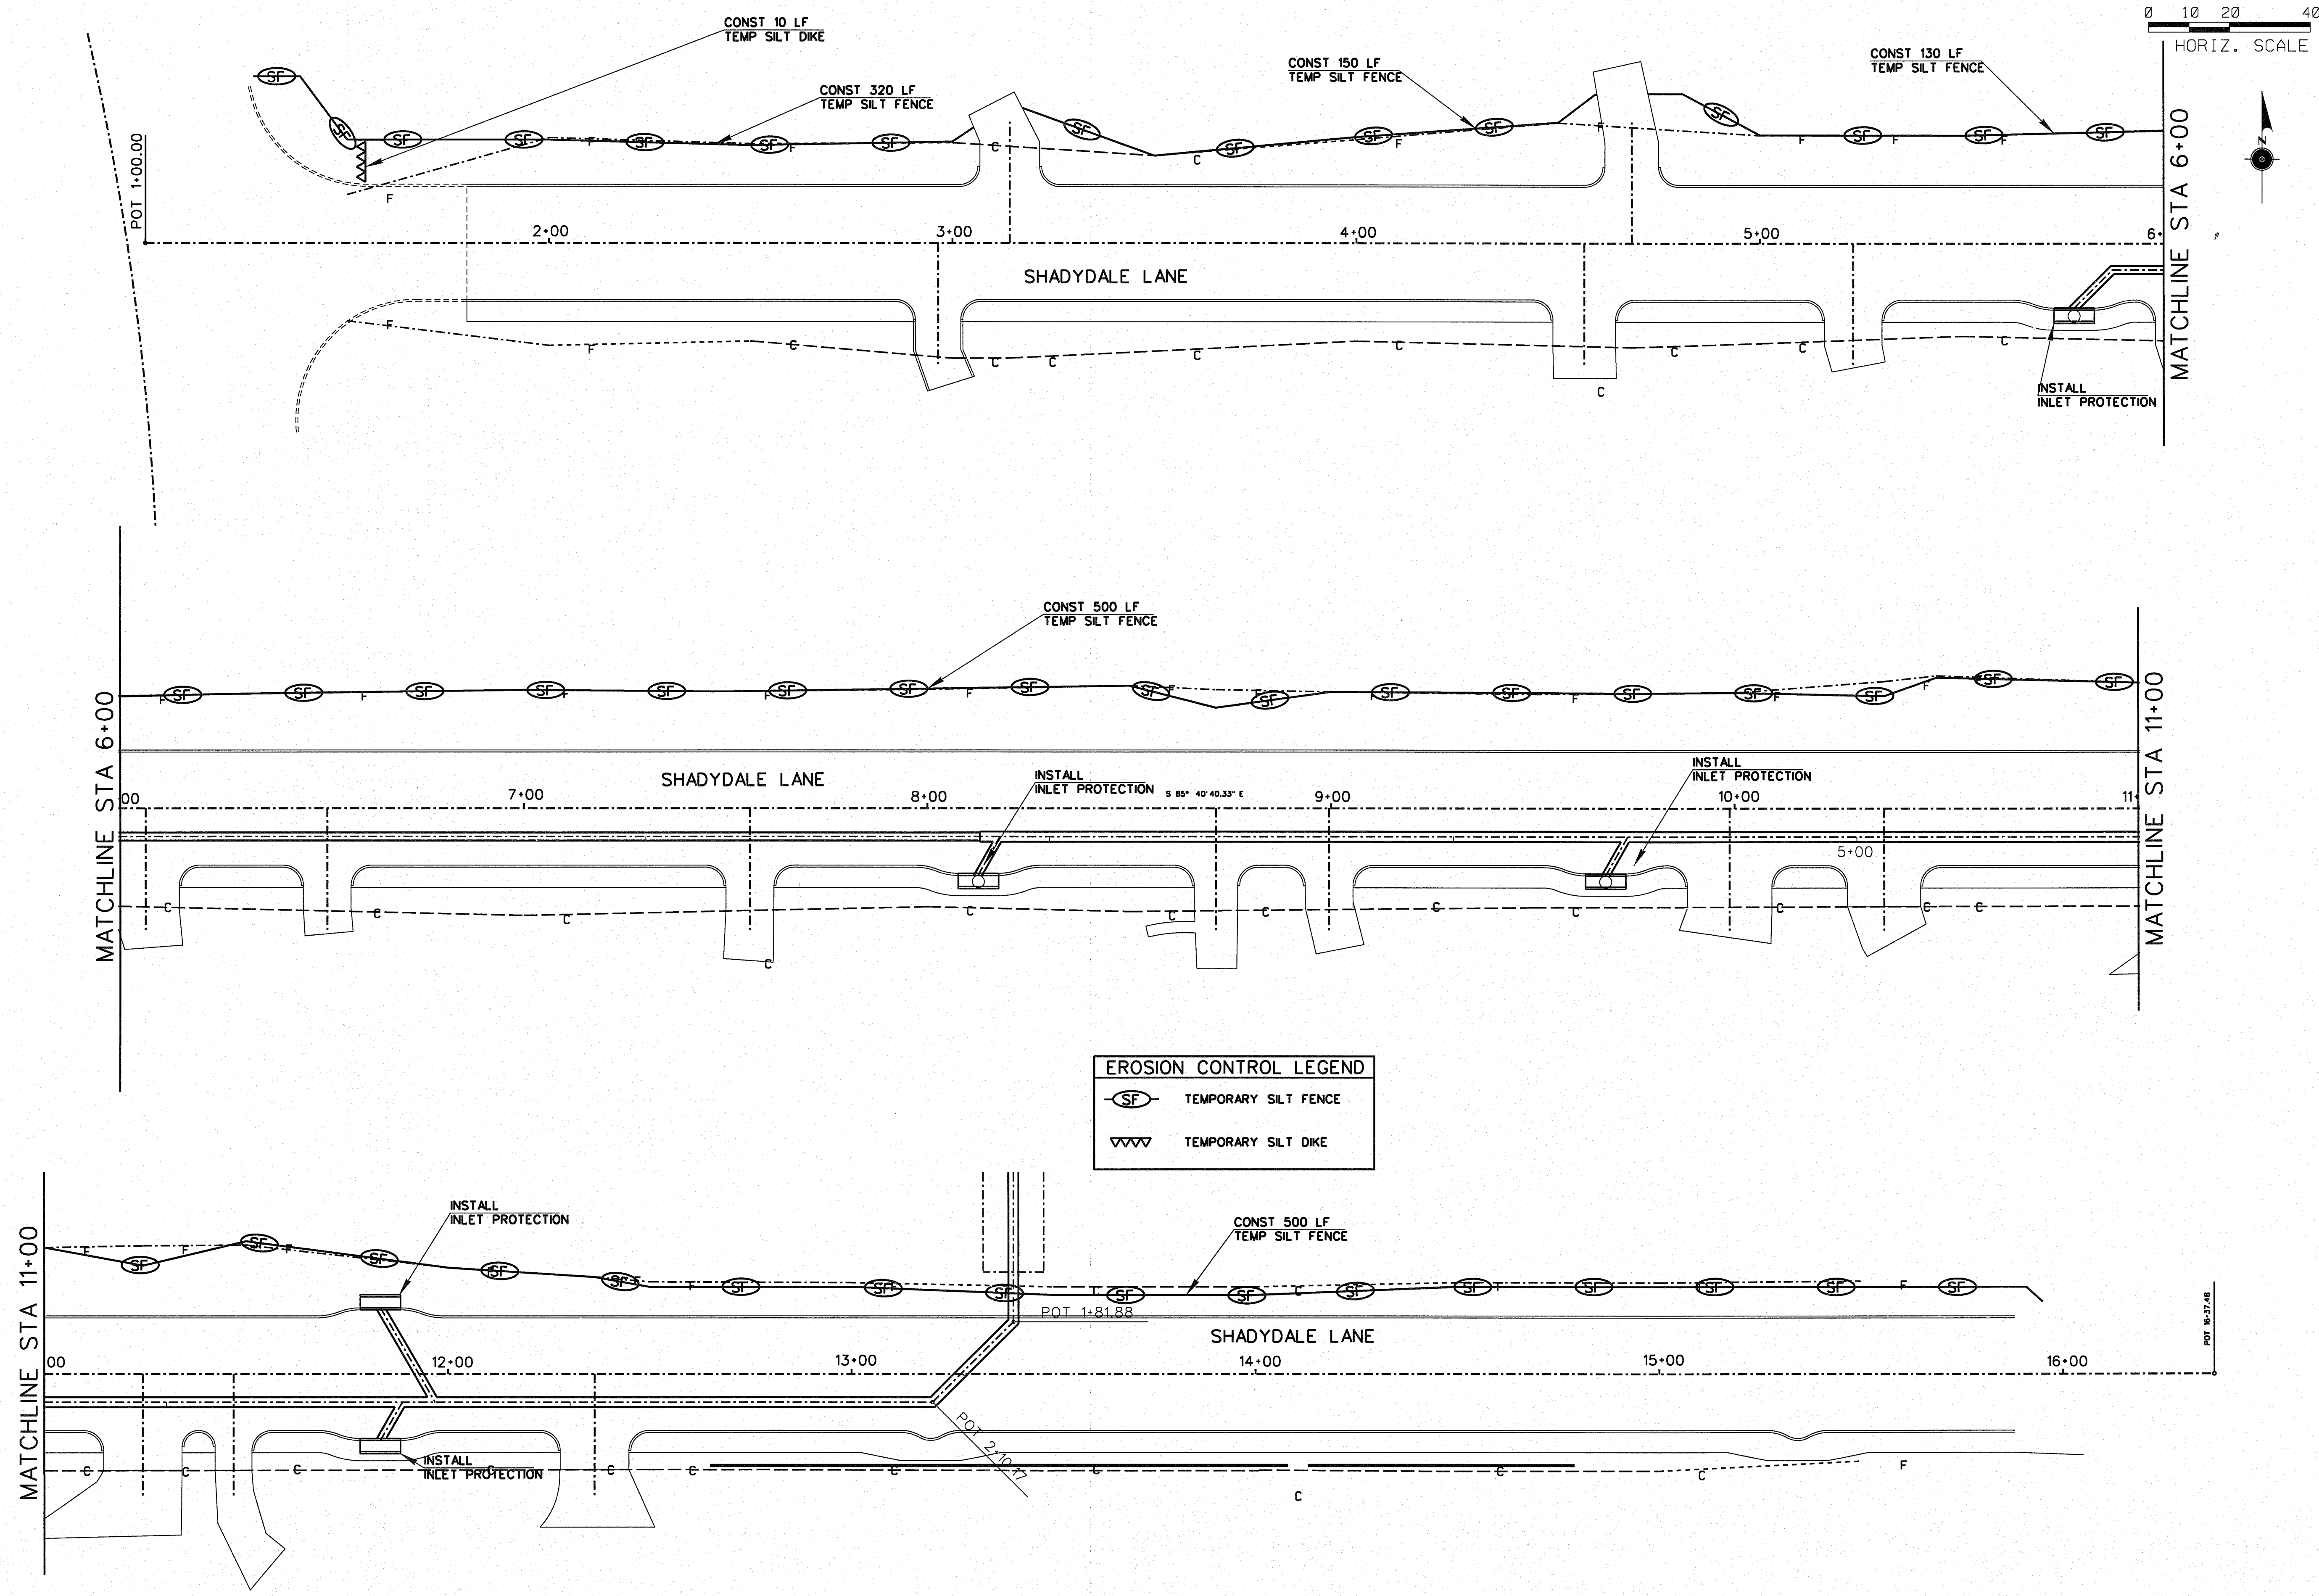


EROSION CONTROL LEGEND

	TEMPORARY SILT FENCE
	TEMPORARY SILT DIKE

RECORD DRAWING
 THE SEAL THAT ORIGINALLY APPEARED ON THIS DOCUMENT WAS AUTHORIZED BY TED B. SUGG, TEXAS NO 82775 ON 10-1-09. THESE RECORD DRAWINGS WERE PREPARED BASED UPON AS CONSTRUCTED DRAWINGS PROVIDED BY THE CONTRACTOR WHO REPRESENTED THAT ALL FIELD CHANGES AND CONSTRUCTION DRAWINGS WERE INCLUDED ON APRIL 18, 2011.

CITY OF ROCKWALL
 SHADY DALE LANE
 EROSION CONTROL PLAN
 SHADYDALE LANE

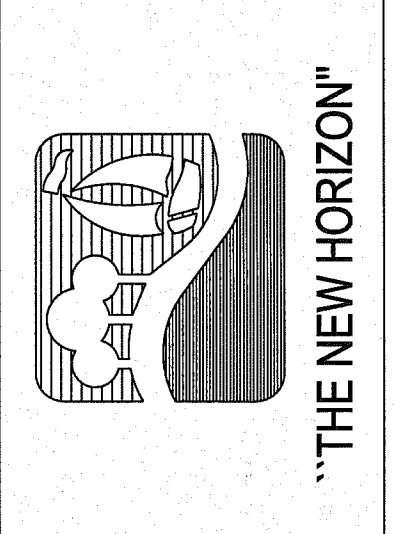

NO.	REVISION	BY	DATE

DESIGN: CRH / TBS
 DRAWING: CRH / TBS
 CHECKED: PBS&J
 APPROVED: PBS&J

TBPE REC. 4F-474
 8383 PRESTON ROAD, SUITE 110
 DALLAS, TX 75252
 PHONE: 972.818.7252
 FAX: 972.818.7275
 PHS&J JOB NO.: 52091000
 DATE: SEPTEMBER 2009
 FILE: #TLES\$