


QUANTITY SUMMARY SHEET

ITEM NO.	DESCRIPTION	UNIT	SDP01	SDP02	SDP03	SD WL 01	SD WL 02	SD WL 03	SD SD 01	SD SD 02	SD EC 01	ACTUAL TOTAL
PAVING												
100	Mobilization	LS										1
101	Prepare ROW, Including Tree Removal	STA	5	5	5							15
102	Remove & Dispose Existing Concrete Pavement, All Thicknesses	SY	231	112								343
103	Remove & Dispose Existing Asphalt Pavement, All Thicknesses	SY	949	1063	302							2314
104	Remove & Reset Existing Signs	EA		1								1
105	Remove & Reset Mailboxes	EA	3	2	2							7
106	Unclassified Street Excavation	CY										3027
107	Compacted Earth Fill	CY										427
108	6" Reinf. Concrete Pavement - Roadways	SY	1353	1611	1585							4549
109	6" Reinf. Concrete Pavement - Driveways	SY	166	234	162							562
110	6" 6% (27lbs/sy) Lime Stabilized Subgrade	SY	1540	1833	1790							5163
111	Lime	TON	20.79	24.75	24.17							70
112	6" Integral Curb	LF	786	897	930							2613
113	Concrete Sidewalk (4" Thick)	SF	1890	1989	2205							6084
114	Barrier Free Ramp	EA	7	13	5							25
115	Permanent Pavement Markings	LS										1
116	Sodding of ROW including 4" topsoil, watering, & Fertilizing	SY	682	727	691							2100
117	Traffic Control	LS										1
118	SWPPP	LS										1
119	6" Asphalt Transition (Connect FM 740 to Shadydale)	SY	205									205
120	Adjust Sanitary Sewer Manhole	EA			2							2
STORM SEWER SYSTEM												
200	24" RCP Storm Sewer	LF							38	255		293
201	30" RCP Storm Sewer	LF							489	217		706
202	10' Recessed Curb Inlet	EA							2	3		5
203	Headwall for 30" RCP (TxDOT Type CH-FW-0)	EA							1			1
204	Trench Safety & Support	LF							527	472		999
WATER & WASTEWATER UTILITIES												
300	8" C-900 Class 200 PVC Water Pipe	LF				445	505	525				1475
301	8" Gate Valve	EA				1	1					2
302	6" Tapping Sleeve & Valve	EA				1						1
303	Install Fire Hydrant Assembly including 6" Valve	EA				2	1	1				4
304	1" Service including Metering Box and Connection to Existing Service	EA				2	3	2				7
305	Connect to Existing 6" WL	EA				1		1				2
306	Ductile Iron Fittings	TON				0.06	0.08	0.03				0.17
	6" 45° Elbow	EA					2					2
	8" x 6" Reducer	EA						1				1
	8" x 6" Tee	EA				2	1	1				4
	6" Plug	EA										0
307	Trench Safety & Support	LF				445	505	525				1475

RECORD DRAWING
THE SEAL THAT ORIGINALLY APPEARED ON THIS DOCUMENT WAS AUTHORIZED BY TEO B. SUGG, TEXAS NO 82775 ON 10-1-09
THESE RECORD DRAWINGS WERE PREPARED BASED UPON AS CONSTRUCTED DRAWINGS PROVIDED BY THE CONTRACTOR WHO REPRESENTED THAT ALL FIELD CHANGES AND CONSTRUCTION DRAWINGS WERE INCLUDED ON APRIL 18, 2011.

CITY OF ROCKWALL
SHADY DALE LANE

QUANTITY
SUMMARY SHEET

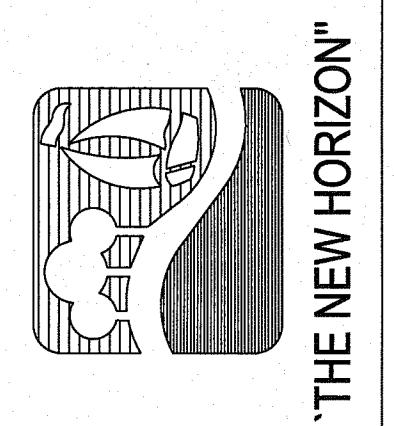

DATE					
BY					
REVISION					
NO.					
TYPE REC.	4-474				
	8383 PRESTON ROAD, SUITE 110				
	DALLAS, TEXAS 75252				
	972-816-7275				
PBS&J JOB NO.:	5209000				
DATE:	SEPTEMBER 2009				
FILE:	\$FILE\$\$				
CHECKED:	PBS&J				
APPROVED:	PBS&J				
DESIGN:	CRH / TBS				
DRAWN:	CRH / TBS				

\$TIMES
\$SYTIME\$
\$\$\$\$