

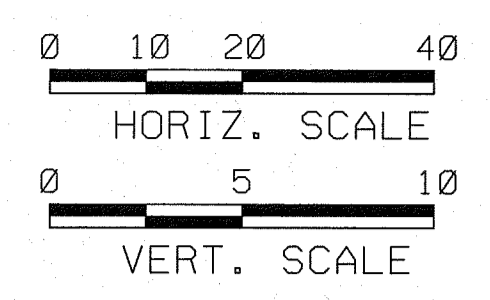


STIMES
 \$\$\$\$\$\$SYTIME\$\$\$\$\$\$
 \$\$\$\$\$\$SDGNSPEC\$\$\$\$\$\$\$\$\$\$\$\$\$\$\$\$

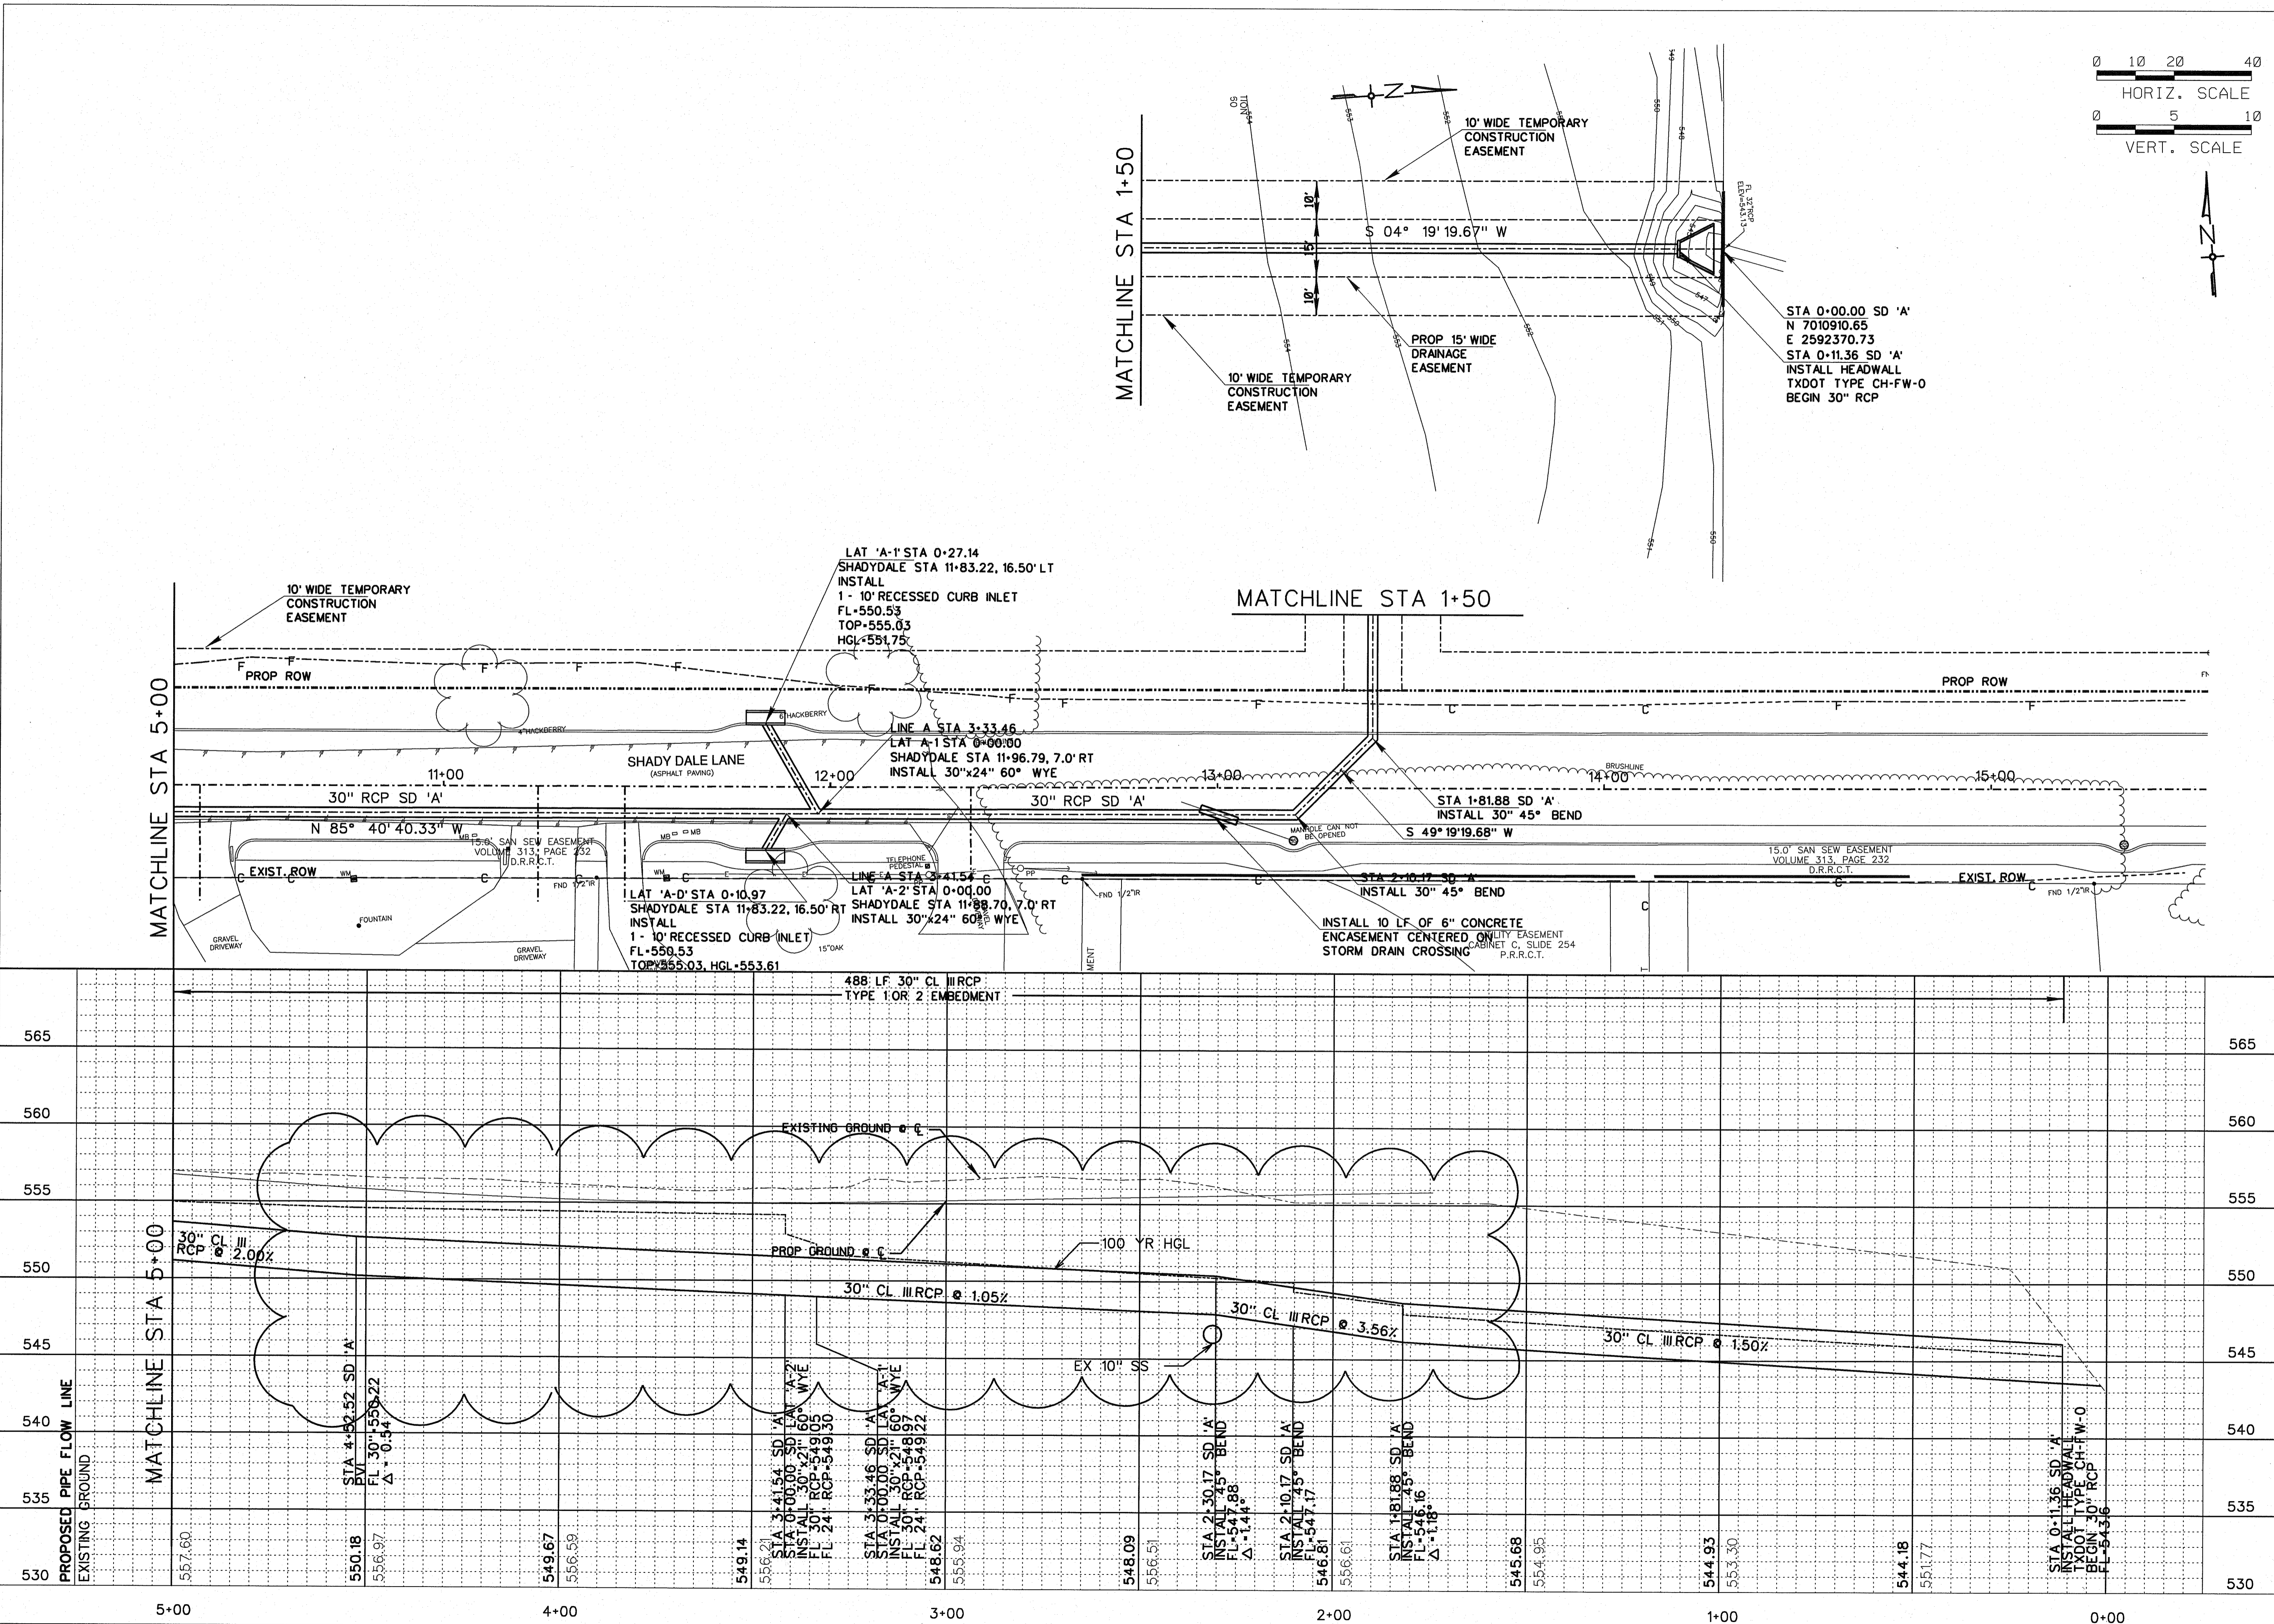

RECORD DRAWING
 THE SEAL THAT ORIGINALLY APPEARED ON THIS DOCUMENT WAS AUTHORIZED BY THE BOARD OF SURVEYORS, TEXAS NO. 82775 ON 10-1-09. THESE RECORD DRAWINGS WERE PREPARED BASED UPON AS CONSTRUCTED DRAWINGS PROVIDED BY THE CONTRACTOR WHO HAS AGREED TO CORRECT ANY CHANGES AND DEVIATIONS FROM THE APPROVED CONSTRUCTION DRAWINGS WERE INCLUDED ON APRIL 18, 2011.

CITY OF ROCKWALL
SHADY DALE LANE
SHADY DALE STORM DRAIN 'A'
STA 0+00 TO STA 5+00

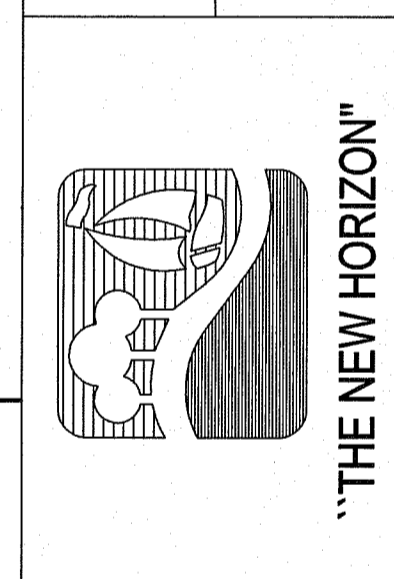

NO.	REVISION	BY	DATE
1	REVISE SD SLOPE FROM 4+52.52 TO 1+81.88	RKJ	12/1/09

DESIGN: CRH / TBS	CHECKED: PBS&J
DRAWN: CRH / TBS	APPROVED: PBS&J

TBPE REC. #F-474	DATE: SEPTEMBER 2009
18383 PRESTON ROAD, SUITE 110 DALLAS, TEXAS 75252 972-818-7275	FILE: \$FILESS