


BTIMES  
 \$\$\$\$\$\$YTIMES\$\$\$\$\$  
 \$\$\$\$\$\$DONSPEC\$\$\$\$\$

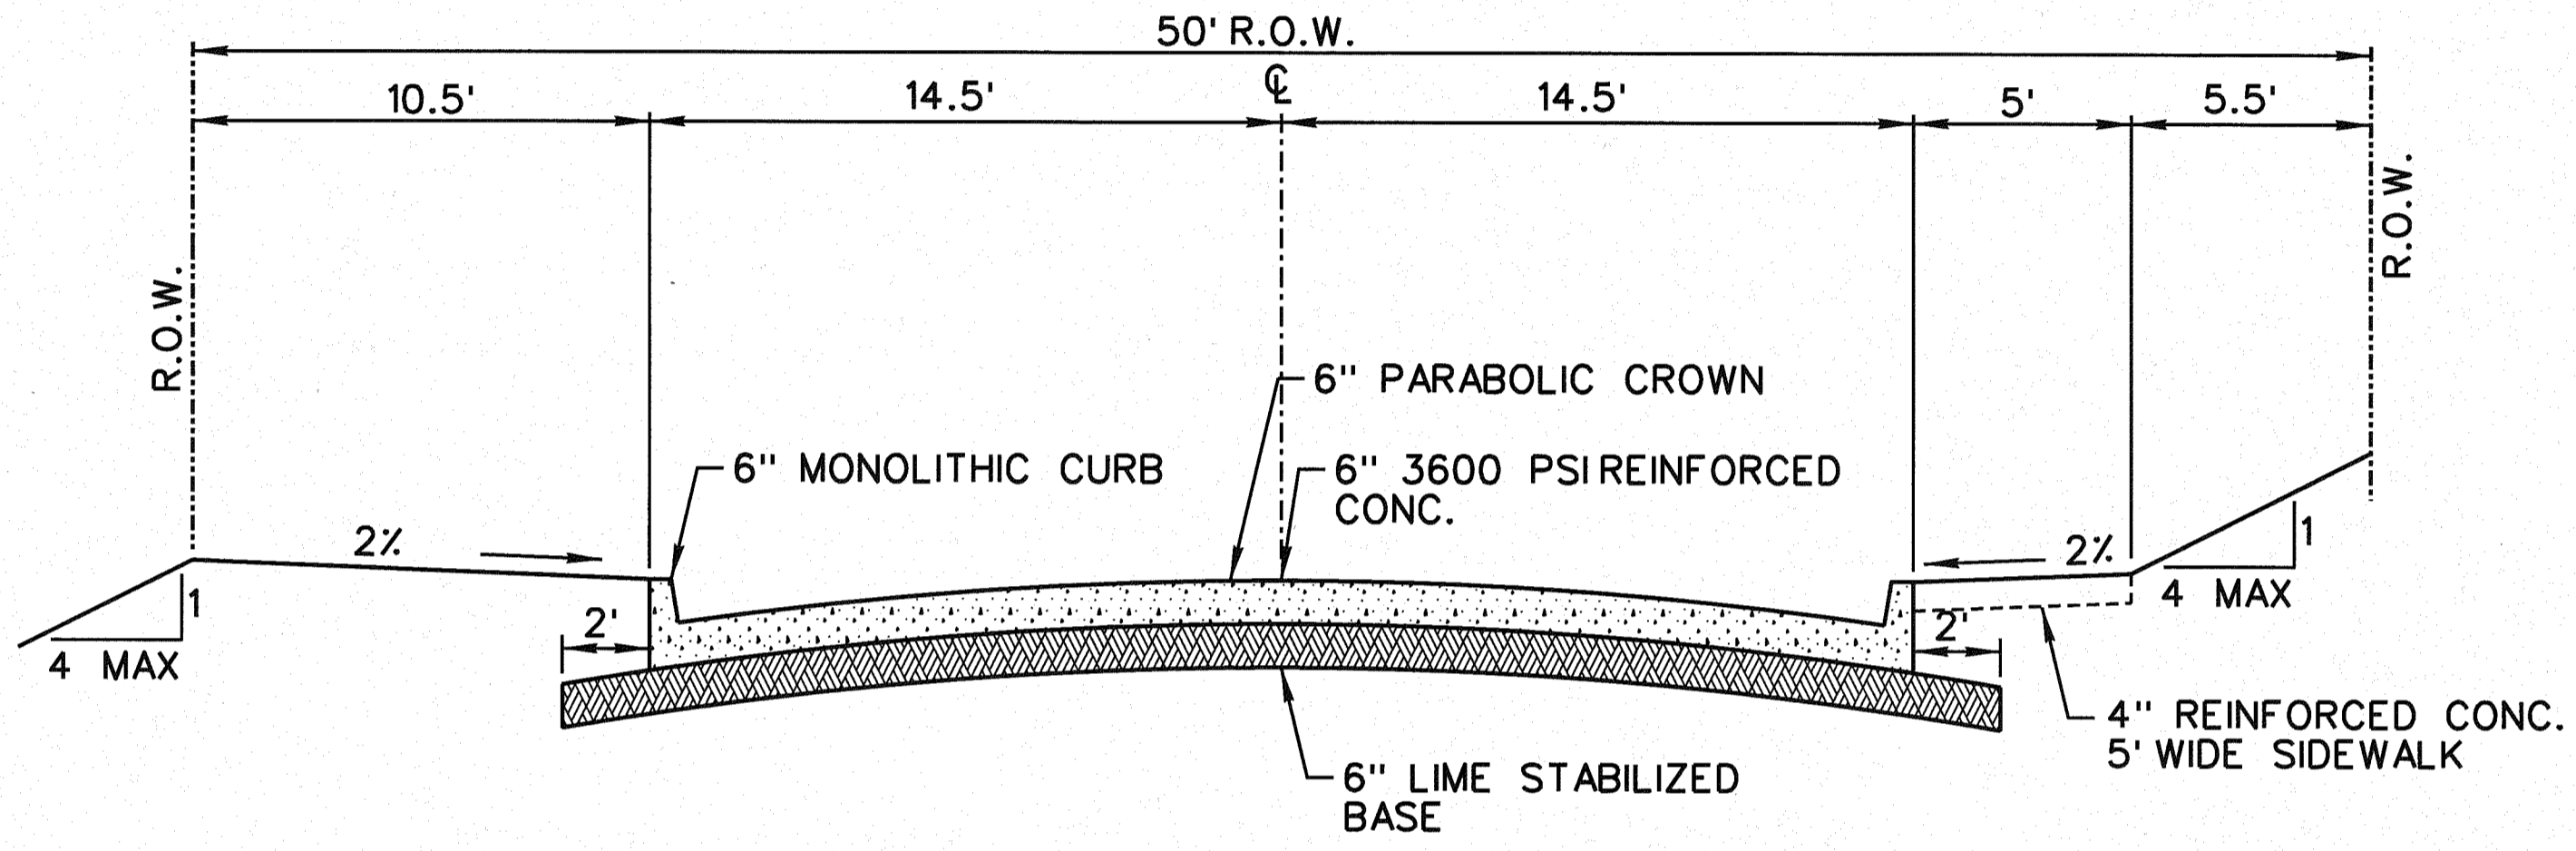


NOTE: CONCRETE SHALL BE REINFORCED W/ •3 BARS @ 24" C/C EW.

SHADYDALE LANE  
 TYPICAL PAVEMENT SECTION  
 29' B-B  
 NOT TO SCALE

**RECORD DRAWING**  
 THE SEAL WAS ORIGINALLY APPLIED ON THIS  
 DRAWING AND IS NOW VOID. APPROVED BY  
 TED B. SUGG, TEXAS NO. 82775 ON 10-1-09  
 THESE RECORD DRAWINGS WERE PREPARED  
 BY THE CONTRACTOR WHO HAS ASSUMED  
 RESPONSIBILITY FOR ALL FIELD CHANGES AND  
 DEVIATIONS FROM THE APPROVED  
 ORIGINAL DRAWINGS WERE INCLUDED ON  
 APRIL 18, 2011.

CITY OF ROCKWALL  
 SHADYDALE LANE

TYPICAL SECTION

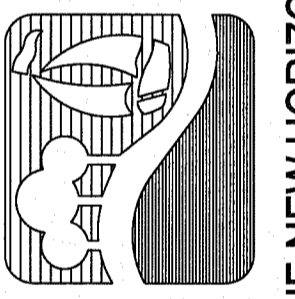

"THE NEW HORIZON"

NO.	REVISION	BY	DATE

**PBS&J** TYPE REC. 4-474  
 18383 PRESTON ROAD, SUITE 110  
 DALLAS, TEXAS 75252  
 972-618-7275  
 PBS&J JOB NO.: 52091000  
 DATE: SEPTEMBER 2009  
 FILE: \$FILES\$

SHEET  
 GN-4  
 SHEET